
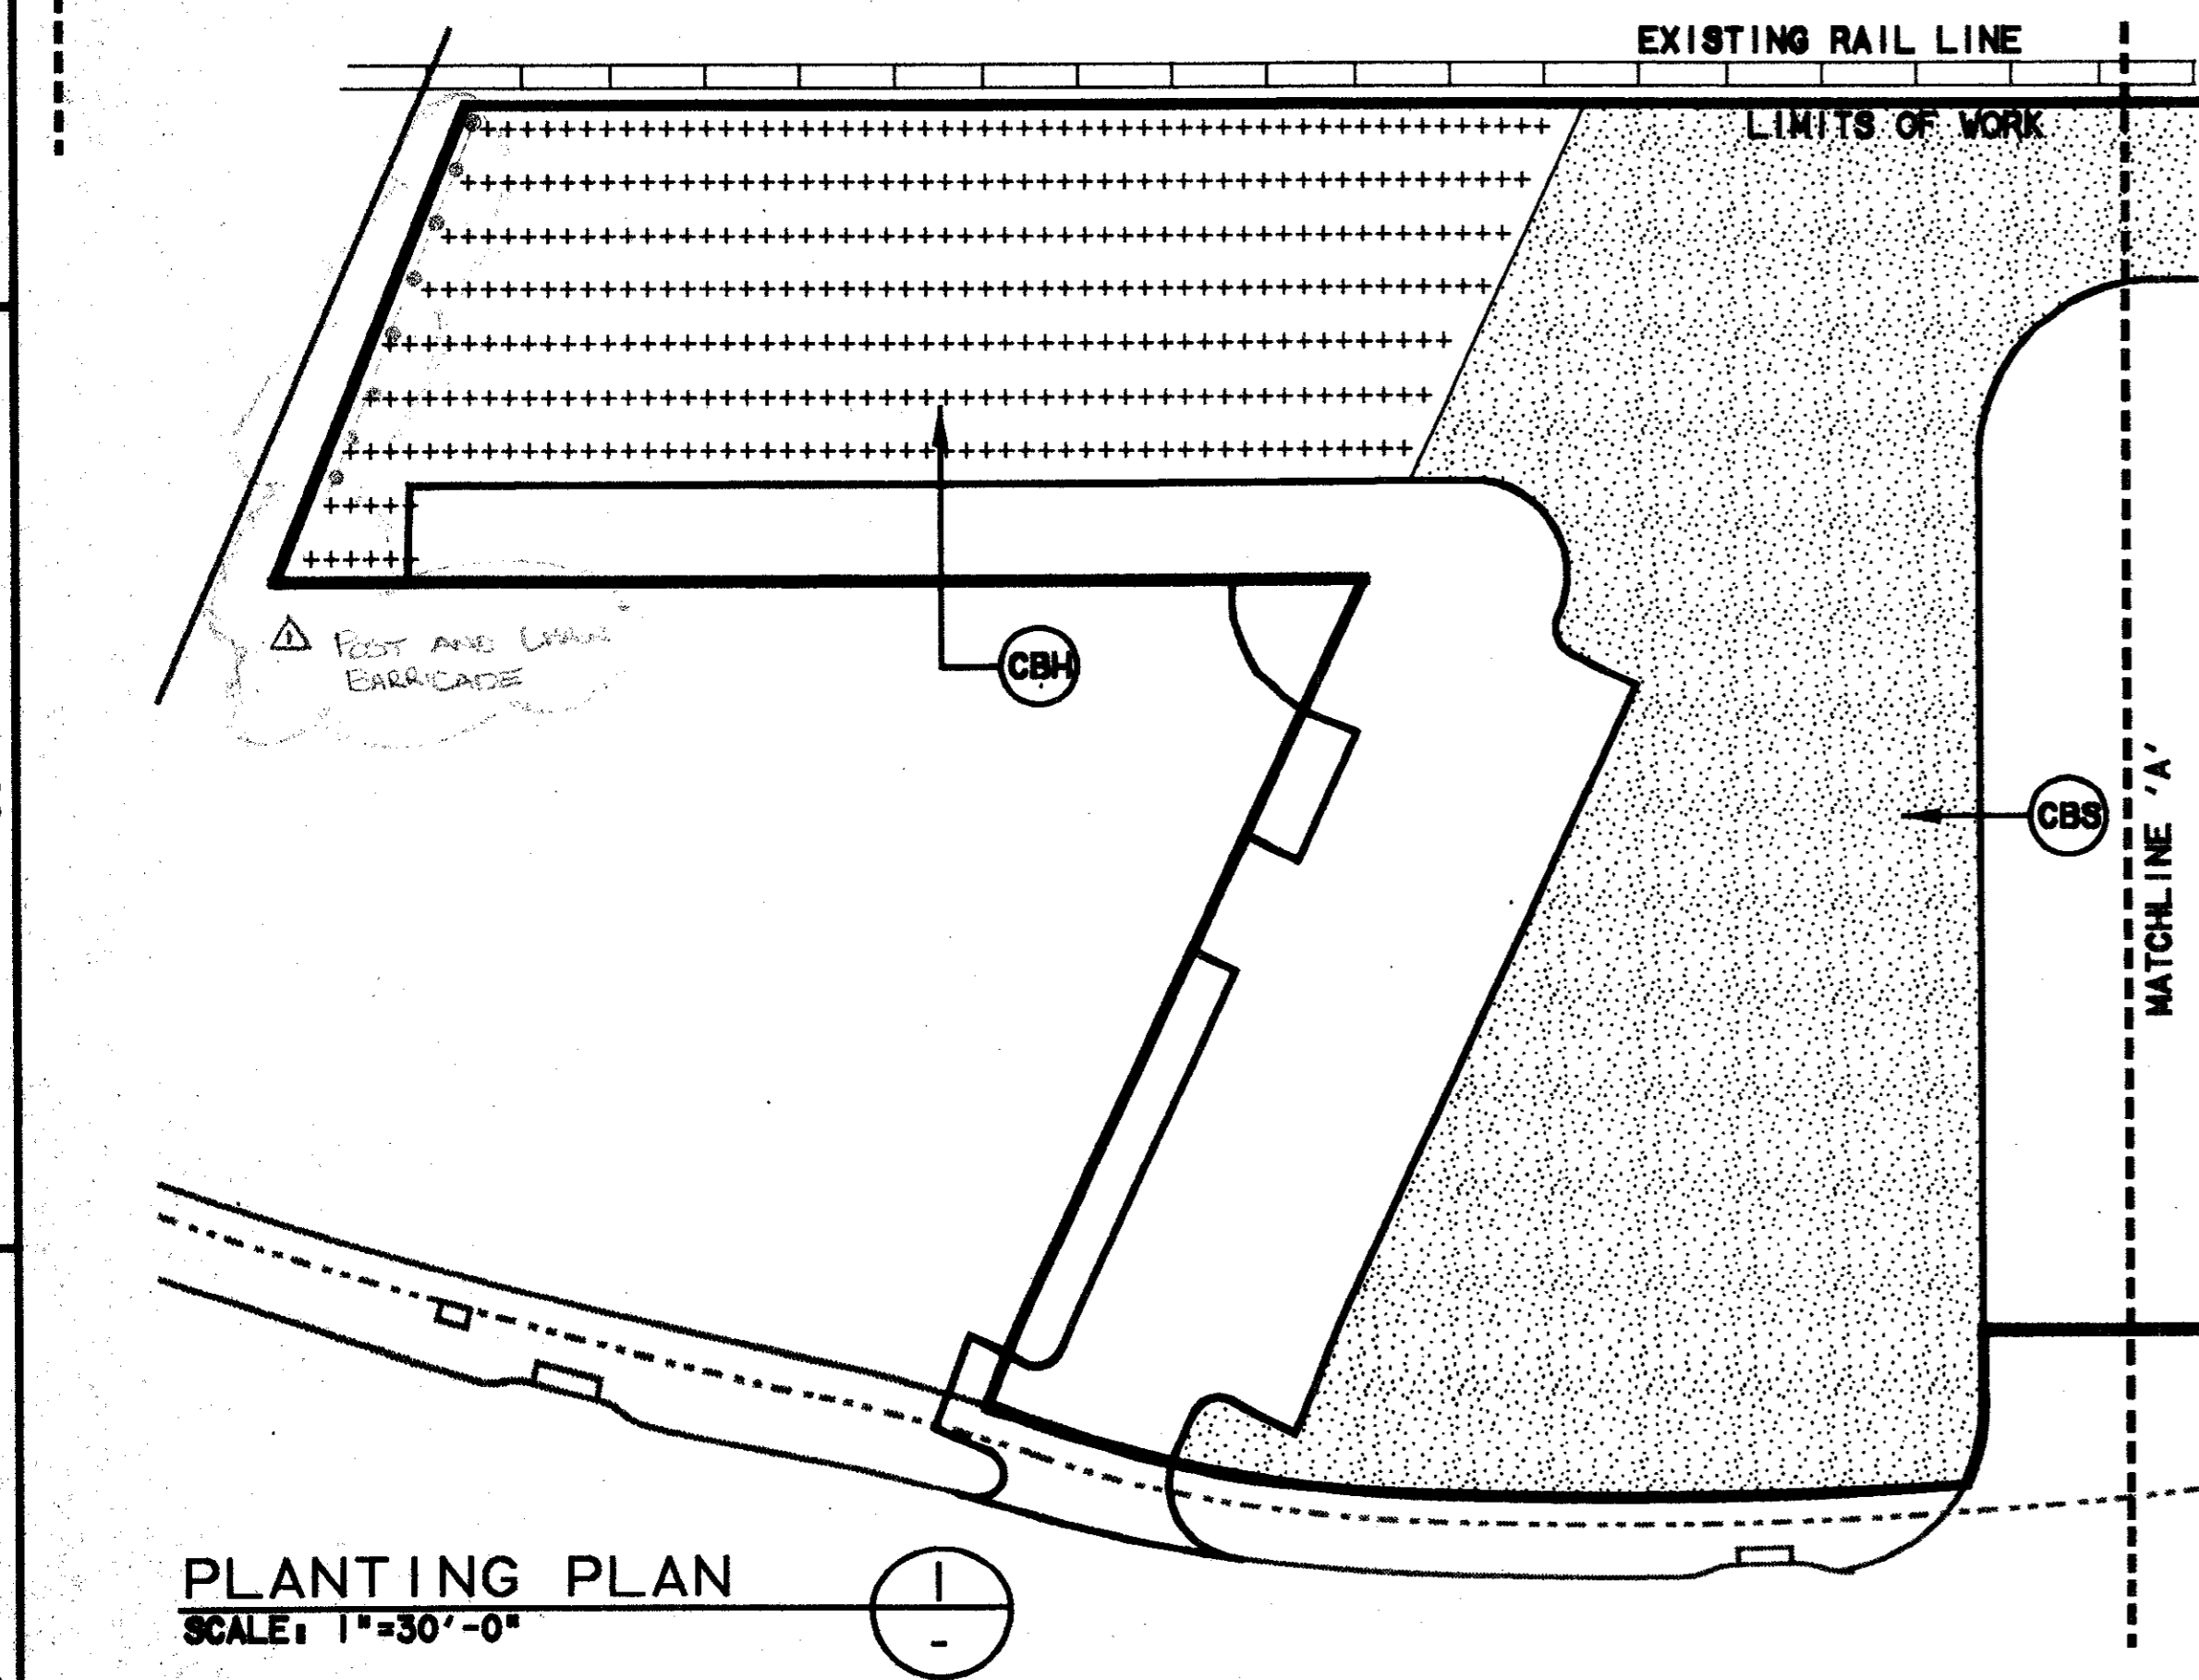


\$\$\$DGN\$SPECIFICATIONS\$\$\$
 \$\$\$SYTIME\$\$\$
 \$\$\$PRF\$\$\$
 \$\$\$SERNAME\$\$\$
 \$\$\$PRF ROT\$\$\$
 \$\$\$PEN\$\$\$
 \$\$\$SERNAME\$\$\$
 \$\$\$FILE6\$\$\$
 \$\$\$FILE7\$\$\$
 \$\$\$FILE8\$\$\$
 \$\$\$FILE9\$\$\$
 \$\$\$FILE10\$\$\$
 \$\$\$FILE1\$\$\$
 \$\$\$FILE2\$\$\$
 \$\$\$FILE3\$\$\$
 \$\$\$FILE4\$\$\$
 \$\$\$FILE5\$\$\$

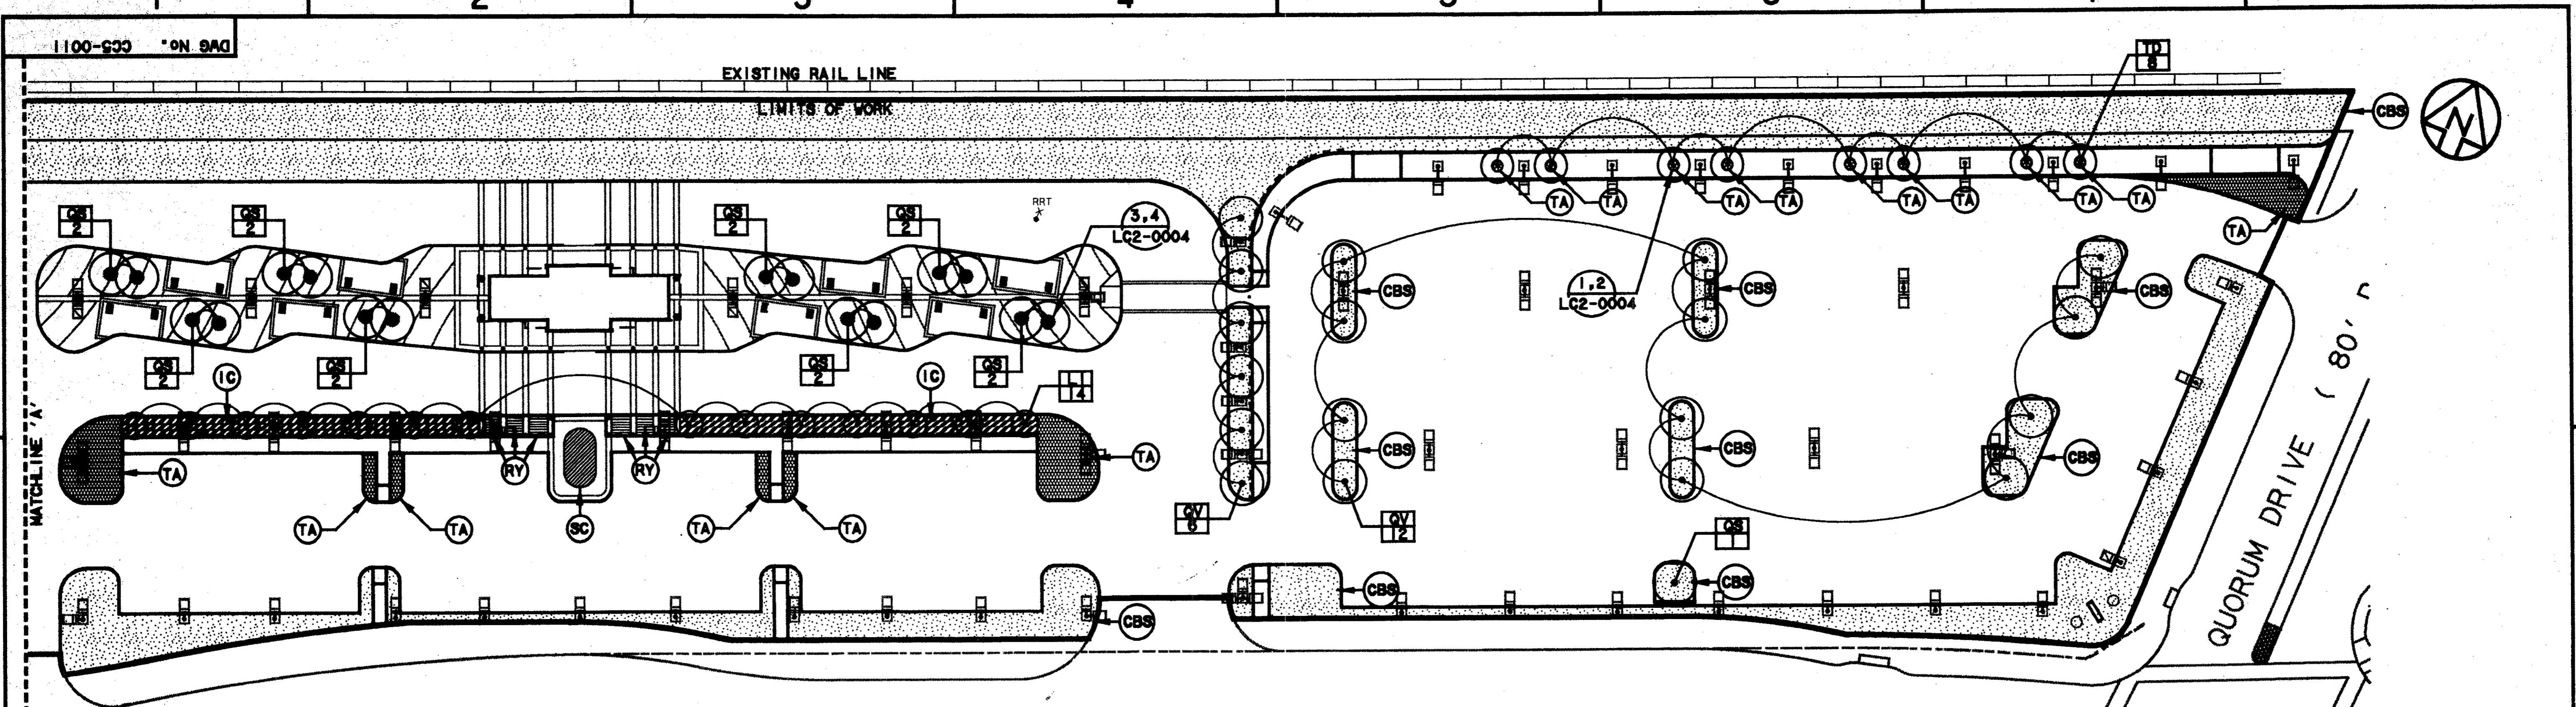

Planting Legend:

- Proposed Tree
- Proposed Tree Quantity
- Proposed Seasonal Color
- Proposed Shrub
- Proposed Groundcover
- Proposed Sod
- Proposed Hydroseed

Planting Notes:

1. All disturbed areas within the contract limit line shall be planted in either lawn, shrub or groundcover beds as indicated. Where no planting is indicated, Common Bermuda hydroseed shall be used.
2. All areas within the contract limit line shall be irrigated by means of an underground automatic irrigation system.
3. All trees shall be guyed.
4. All planting beds adjacent to lawn areas shall be bordered by 4" high steel edging.

Planting Schedule:

Sym.	Qty.	Botanical/Common Name	Cal.	Height	Spread	Rootball	Remarks
Trees:							
LI	14	Lagerstroemia indica / Grape-Myrtle 'tuskegee'	2"	10'	5'-6'	65 Gal.	Multi-Trunk, 3 - trunk min.
QS	17	Quercus shumardii / Shumard Red Oak	4"	16'-18'	8'-10'	100 Gal.	Full tree, matched
QV	18	Quercus virginiana / Live Oak	4"	16'-18'	8'-10'	100 Gal.	Full tree, matched
TD	8	Taxodium Disticum / Bald Cypress	4"	16'-18'	6'-8'	B&B	Full tree, matched
Shrubs / Groundcovers:							
IC		Ilex cornuta 'Burfordi' nana / Dwarf Burford Holly	5 Gal.	2'-3'	1.5'-2'	5 Gal.	Full plant, triang. spacing, 24" O.C.
RY		Hesperaloe Parviflora / Red Yucca	5 Gal.	20"-30"	1.5'	5 Gal.	Full plant, triang. spacing, 18" O.C.
TA		Trachelospermum asiaticum / Asian Jasmine				4" Pots	Full plant, 4-12" runners per plant, 8" O.C.
SC		Seasonal Color				4" Pots	Full plant, matched, owner to select species, triang. spacing, 6" O.C.
CBS		Common Bermuda Sod					Solid Sod Bermuda
CBH		Common Bermuda Hydroseed					Hydroseed Bermuda

PLANTING PLAN
SCALE: 1"=30'-0"

CONFORMED

CONTRACT SHEET No. 44 OF 95

REV	DATE	DESCRIPTION	BY	ENG	CHK	APP	REV	DATE	DESCRIPTION	BY	ENG	CHK	APP
△	8/30/99	RECORD (AS-BUILT) DRAWING					△						
△							△						
△							△						
SWA Group
2211 North Lamar
Dallas, Texas, 75202
214-954-0016
Landscape Architecture
Site Planning
Urban Design

WLA
WENDY LOPEZ & ASSOCIATES, INC.
ENGINEERING • SURVEYING • CONSTRUCTION SERVICES
1825 MARKET CENTER BLVD - SUITE 510
DALLAS, TEXAS 75207
(214) 748-7777

DART PROJECT

SCALE	1"=30'-0"
DRAWN	N. AVETON
DESIGNED	C. MILLER
CHECKED	C. MILLER
IN CHARGE	V. STEVENS
DATE	14 AUGUST 97

ADDISON TRANSIT CENTER PLANTING PLAN

CONTRACT C-97000136 DWS No. CC5-0011 REV 01