

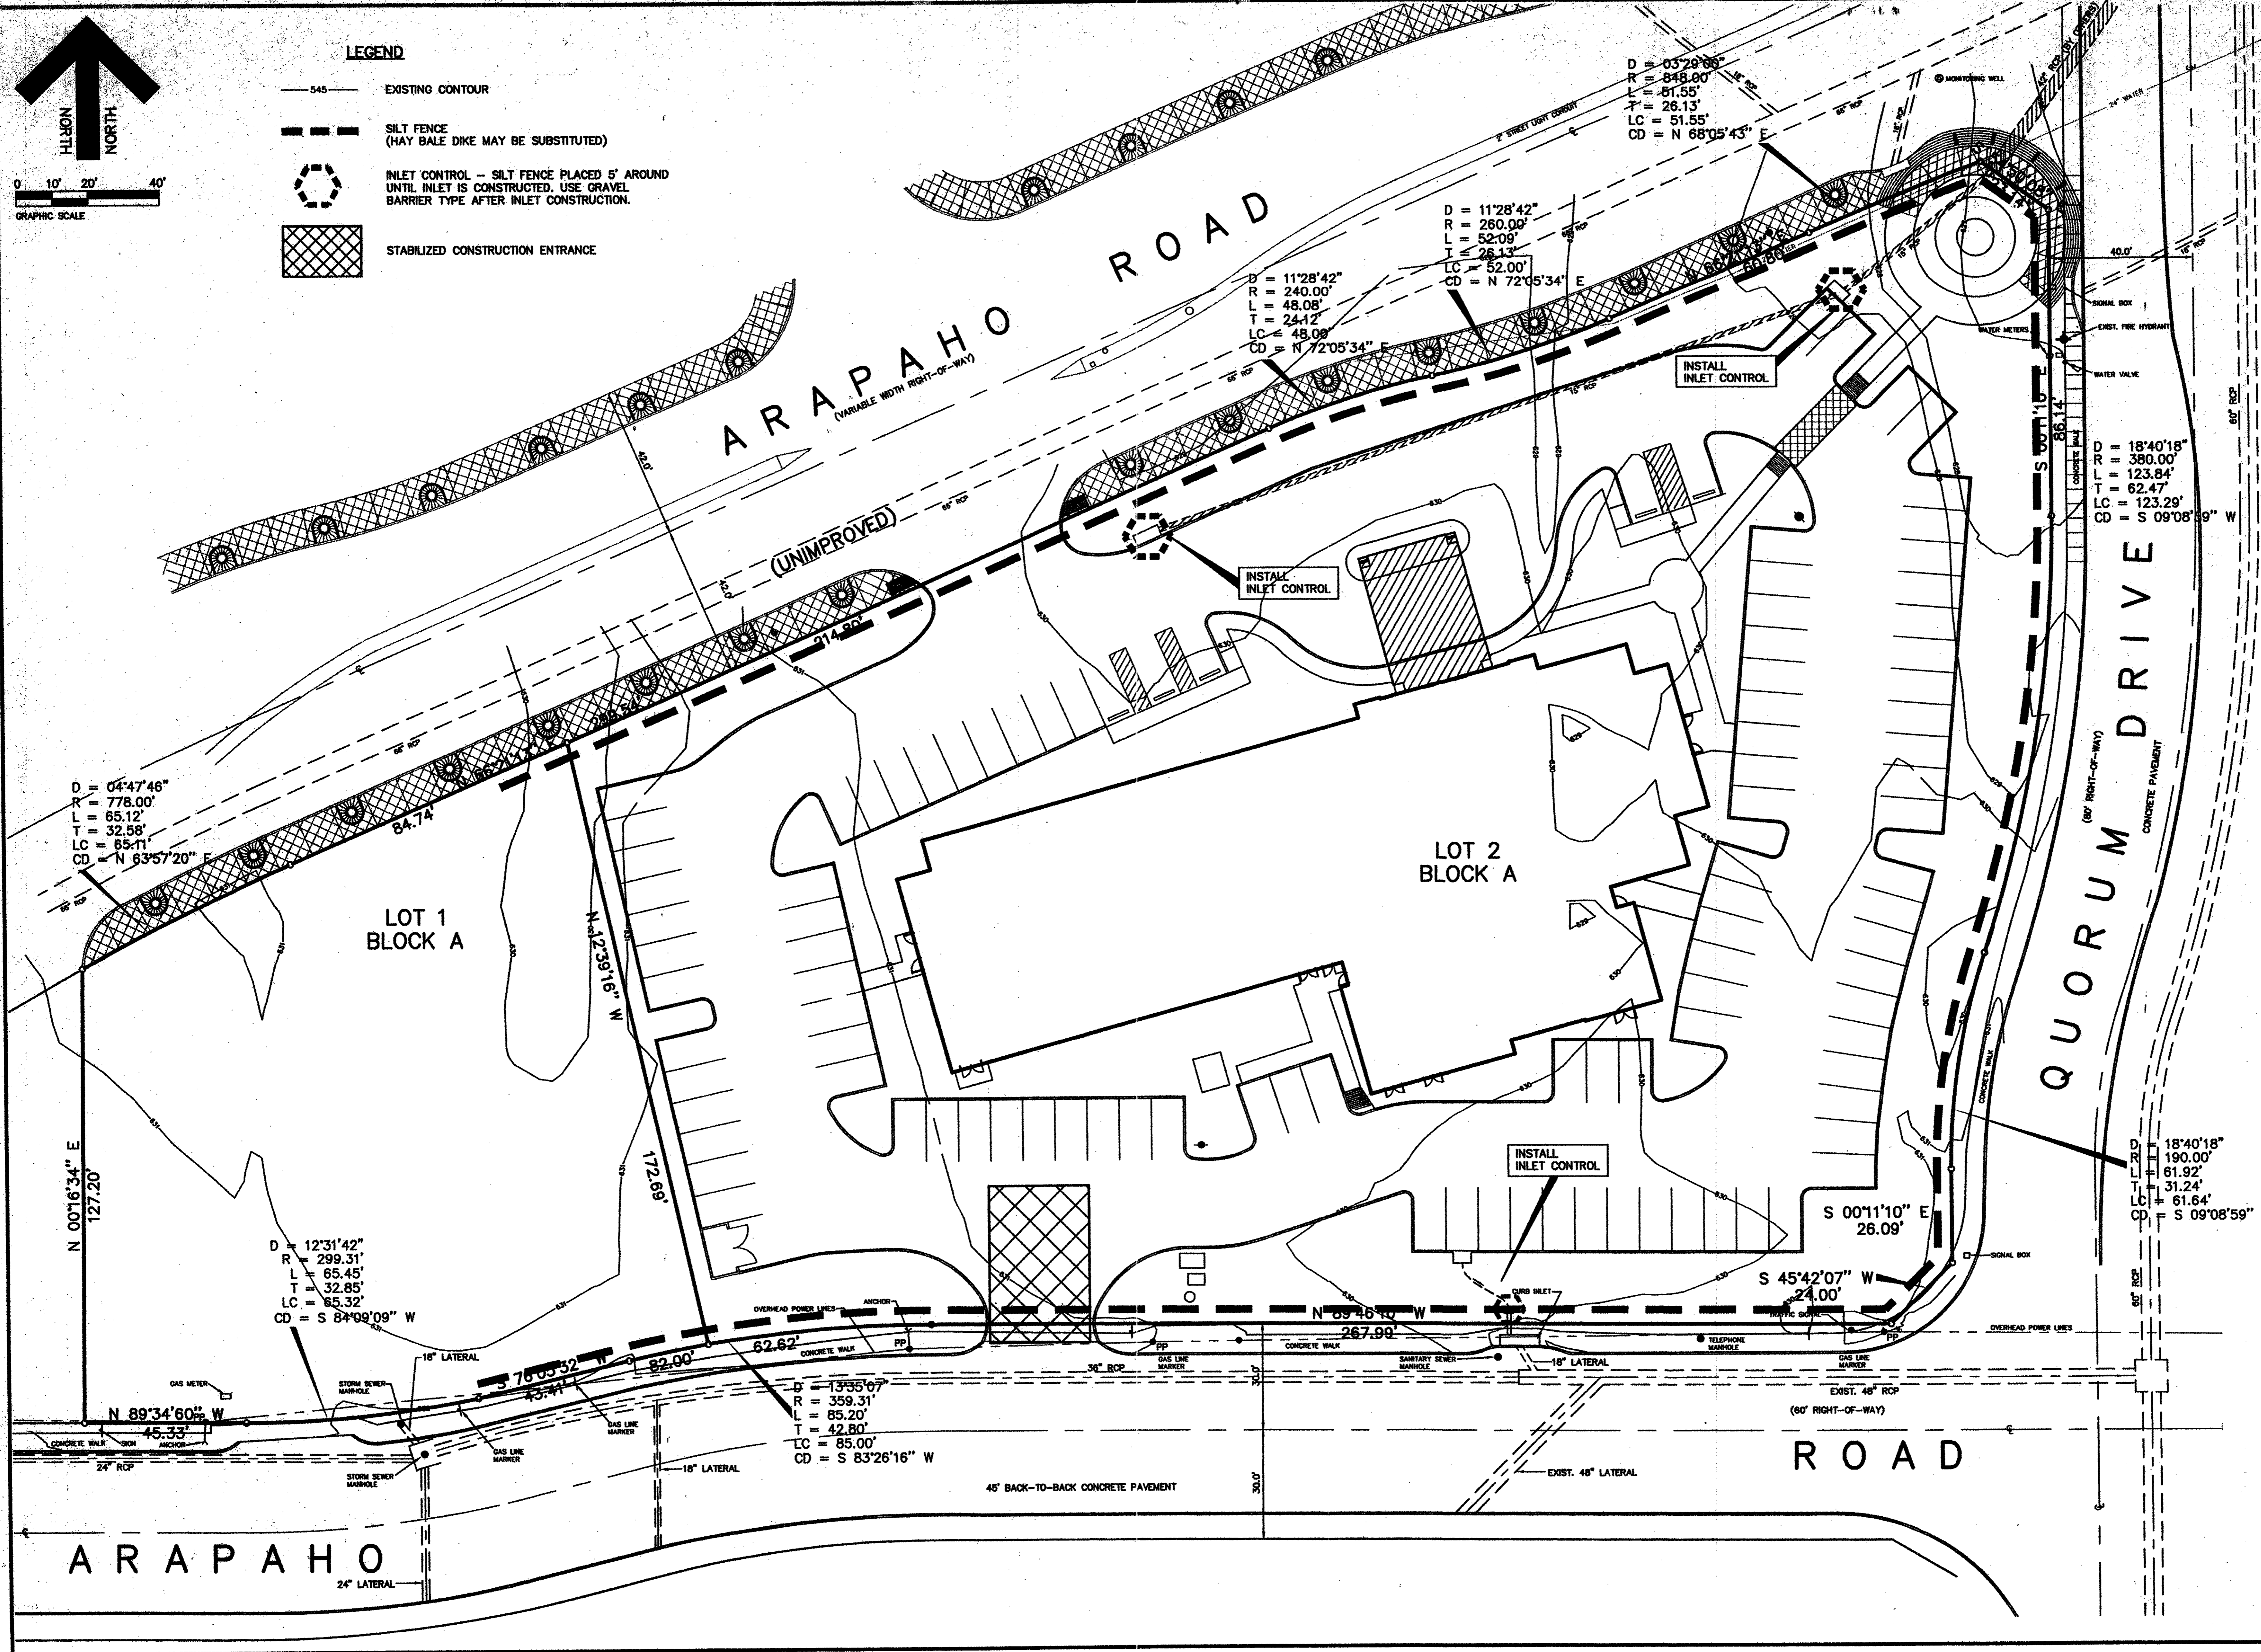


LEGEND

- 545 EXISTING CONTOUR
- SILT FENCE (HAY BALE DIKE MAY BE SUBSTITUTED)
- INLET CONTROL - SILT FENCE PLACED 5' AROUND UNTIL INLET IS CONSTRUCTED. USE GRAVEL BARRIER TYPE AFTER INLET CONSTRUCTION.
- STABILIZED CONSTRUCTION ENTRANCE

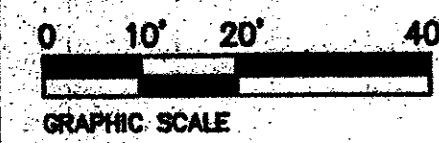

JDJR ENGINEERS & CONSULTANTS, INC.
 ENGINEERS - LAND PLANNERS - CAD DESIGN
 2505 Texas Drive, Suite 200, Irving, Texas 75039
 Tel: 972-992-0449 (CSX77) Fax: 972-975-9800

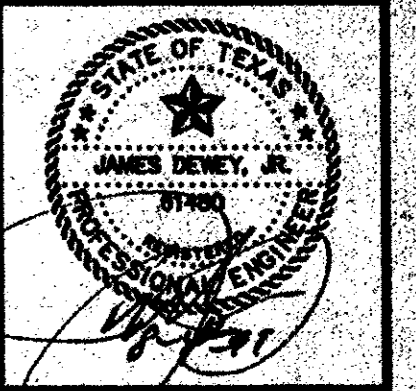

PROJECT: WINGATE INN
 ARAPAHO ROAD AT QUORUM DRIVE
 LOT 2 BLOCK A
 WINGATE INN OF ADDISON ADDITION
 ADDISON, TEXAS

REVISIONS:

DATE	REVISION
6/22/98	CITY COMMENTS
7/06/98	CITY COMMENTS
7/20/98	REVISE LINE 'A'
8/3/98	UPDATE SET

SHEET TITLE:
EROSION CONTROL PLAN

DATE: 5-22-98
 SCALE: 1" = 20'
 DRAWN BY: J.N.M.
 CHECKED BY: JDJR
 SHEET NO.
C5 of 9
 JDJR FILE NO. 98-022