

PLANS FOR THE CONSTRUCTION OF
PAVING, STORMWATER, WATER, WASTEWATER,
SIGNALIZATION AND STREETScape IMPROVEMENTS FOR

ARAPAHO ROAD

FROM ADDISON ROAD TO DALLAS NORTH TOLLWAY




T O W N O F
ADDISON

RECORD DOCUMENTS 6/9/2000

THESE RECORD DOCUMENTS HAVE BEEN PREPARED BASED ON INFORMATION PROVIDED BY OTHERS. THE CONSULTANT HAS NOT VERIFIED THE ACCURACY AND/OR COMPLETENESS OF THIS INFORMATION AND SHALL NOT BE RESPONSIBLE FOR ANY ERRORS OR OMISSIONS THAT MAY BE INCORPORATED AS A RESULT OF ERRONEOUS INFORMATION PROVIDED BY OTHERS.

SHEET NO.	INDEX OF DRAWINGS
	COVER SHEET
Q-1 to Q-4	QUANTITY SHEETS
R-1 to R-3	RIGHT-OF-WAY PLANS
D-1 to D-3	DEMOLITION PLANS
CS-1 to CS-7	CONSTRUCTION SEQUENCING PLANS
P-1 to P-2	PAVING TYPICAL SECTIONS
P-3 to P-14	PAVING PLANS, PROFILES & DETAILS
P-15	RETAINING WALL PLAN, PROFILE & DETAIL
P-16 to P-19	STRIPING PLANS
ST-1	DRAINAGE AREA MAP
ST-2 to ST-5	STORMWATER CALCULATIONS
ST-6 to ST-17	STORMWATER PLANS, PROFILES & DETAILS
W-1 to W-11	WATER & WASTEWATER PLAN/PROF. & DET.
S-1 to S-14	SIGNALIZATION PLANS & DETAILS
X-1 to X-10	CROSS SECTIONS
LA-1 to LA-7	LANDSCAPE LAYOUT PLANS
LC-1 to LC-4	LANDSCAPE CONSTRUCTION DETAILS
PL-1 to PL-7	PLANTING PLANS & DETAILS
IR-1 to IR-6	IRRIGATION PLANS
SE-1 to SE-6	SITE-ELECTRICAL PLANS

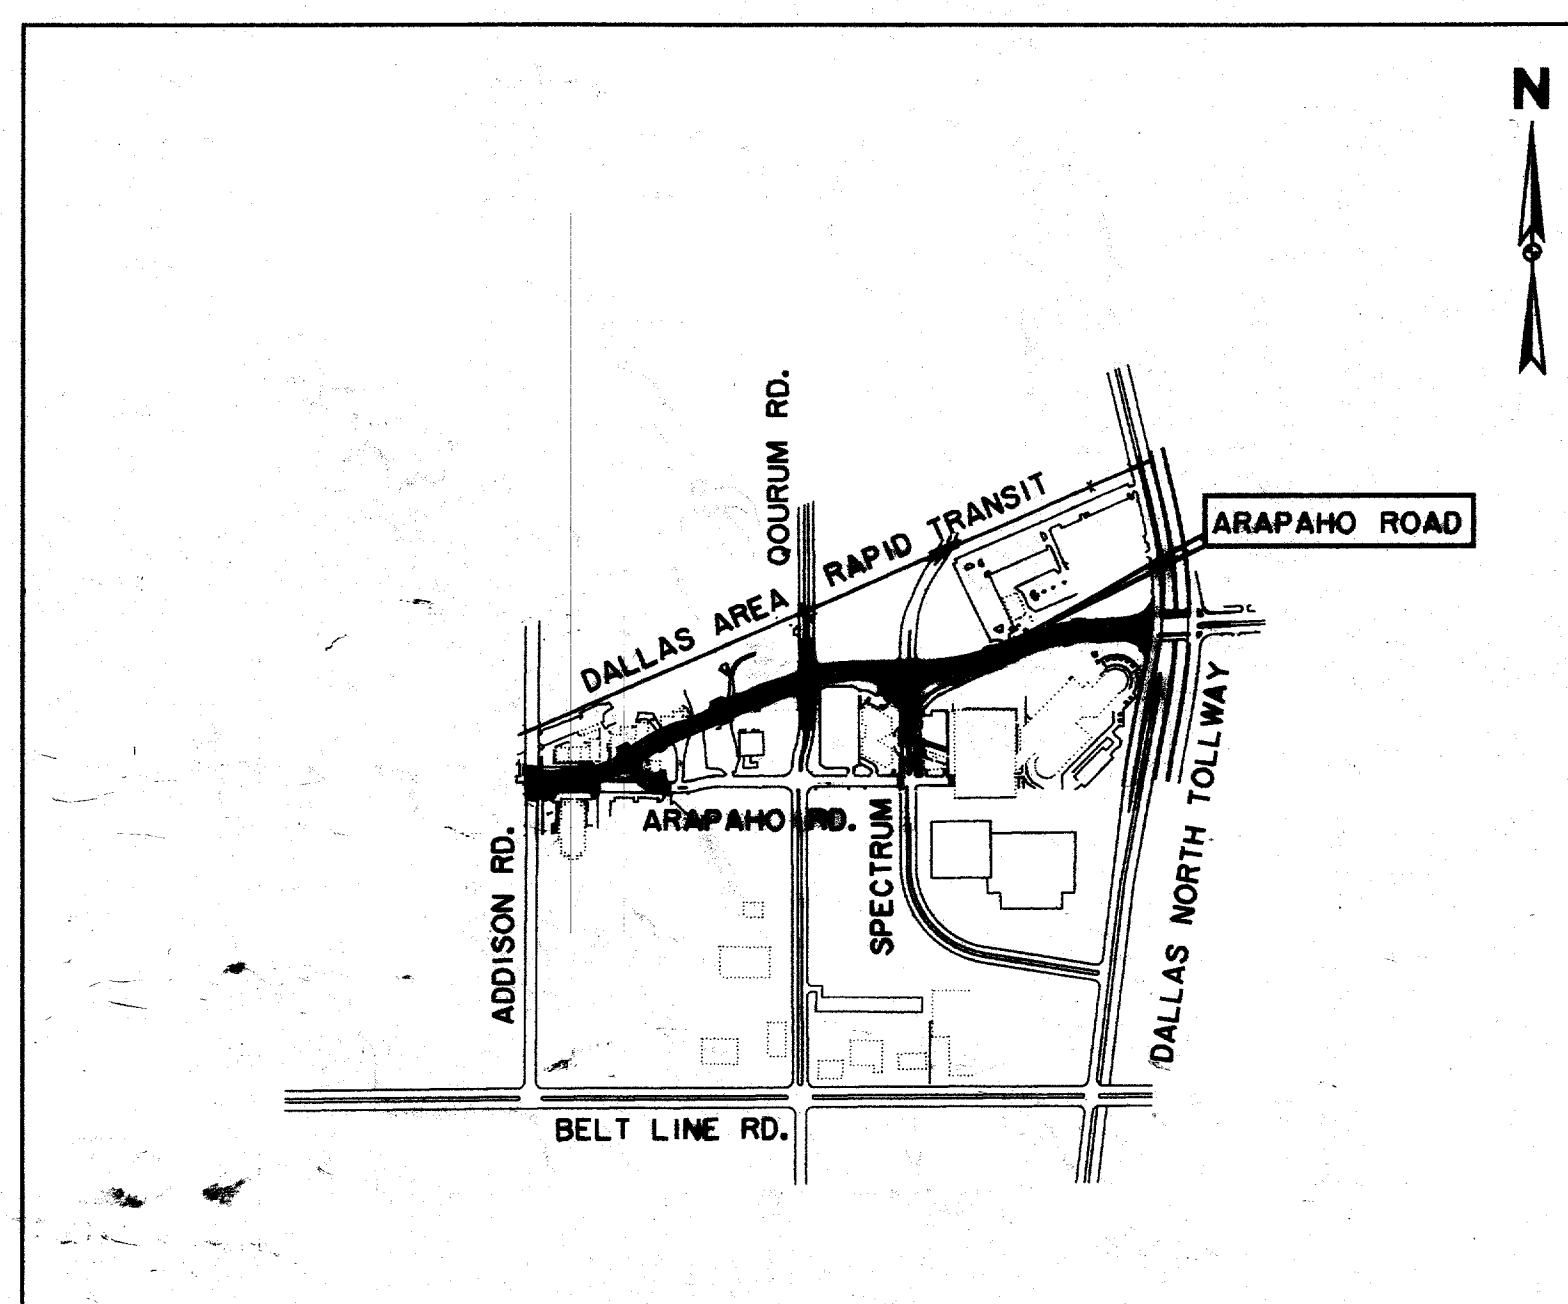


LOCATION MAP

OWNER:
TOWN OF ADDISON
DEPARTMENT OF PUBLIC WORKS
16801 WESTGROVE
P.O. BOX 144
ADDISON, TEXAS 75001
(972) 450-7018


ENGINEER:
HUITT-ZOLLARS, INC.
3131 MCKINNEY AVE., SUITE 600
DALLAS, TEXAS 75204
(214) 871-3311

LANDSCAPE ARCHITECT:
MESA DESIGN GROUP
3100 MCKINNON ST., SUITE 905
DALLAS, TEXAS 75201
(214) 871-0568


THE SEAL APPEARING ON THIS DOCUMENT WAS AUTHORIZED BY KENNETH A. ROBERTS, P.E. 55446 ON OCTOBER 24, 1997.

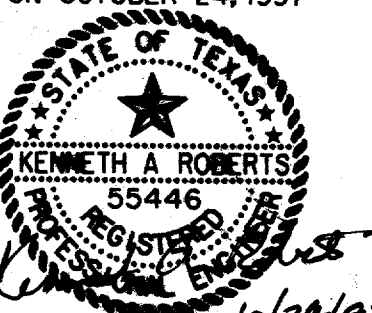

ARAPAHO ROAD

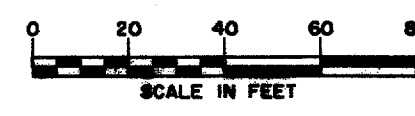


BUILDING CORNERS	C/L STATION	OFFSET	
1	42+26.97	40.50'	LT.
2	42+56.28	129.42'	LT.
3	42+72.23	27.13'	LT.
4	43+15.85	48.31'	LT.
5	43+41.80	3.94'	RT.
6	43+57.84	132.48'	LT.
7	43+63.44	44.07'	RT.
8	44+07.17	67.86'	RT.
9	44+16.07	130.93'	LT.
10	44+73.24	73.23'	RT.
11	45+80.36	92.51'	LT.
12	46+13.63	45.58'	LT.
13	46+34.36	90.89'	LT.
14	47+14.27	57.57'	RT.
15	47+34.92	44.79'	LT.

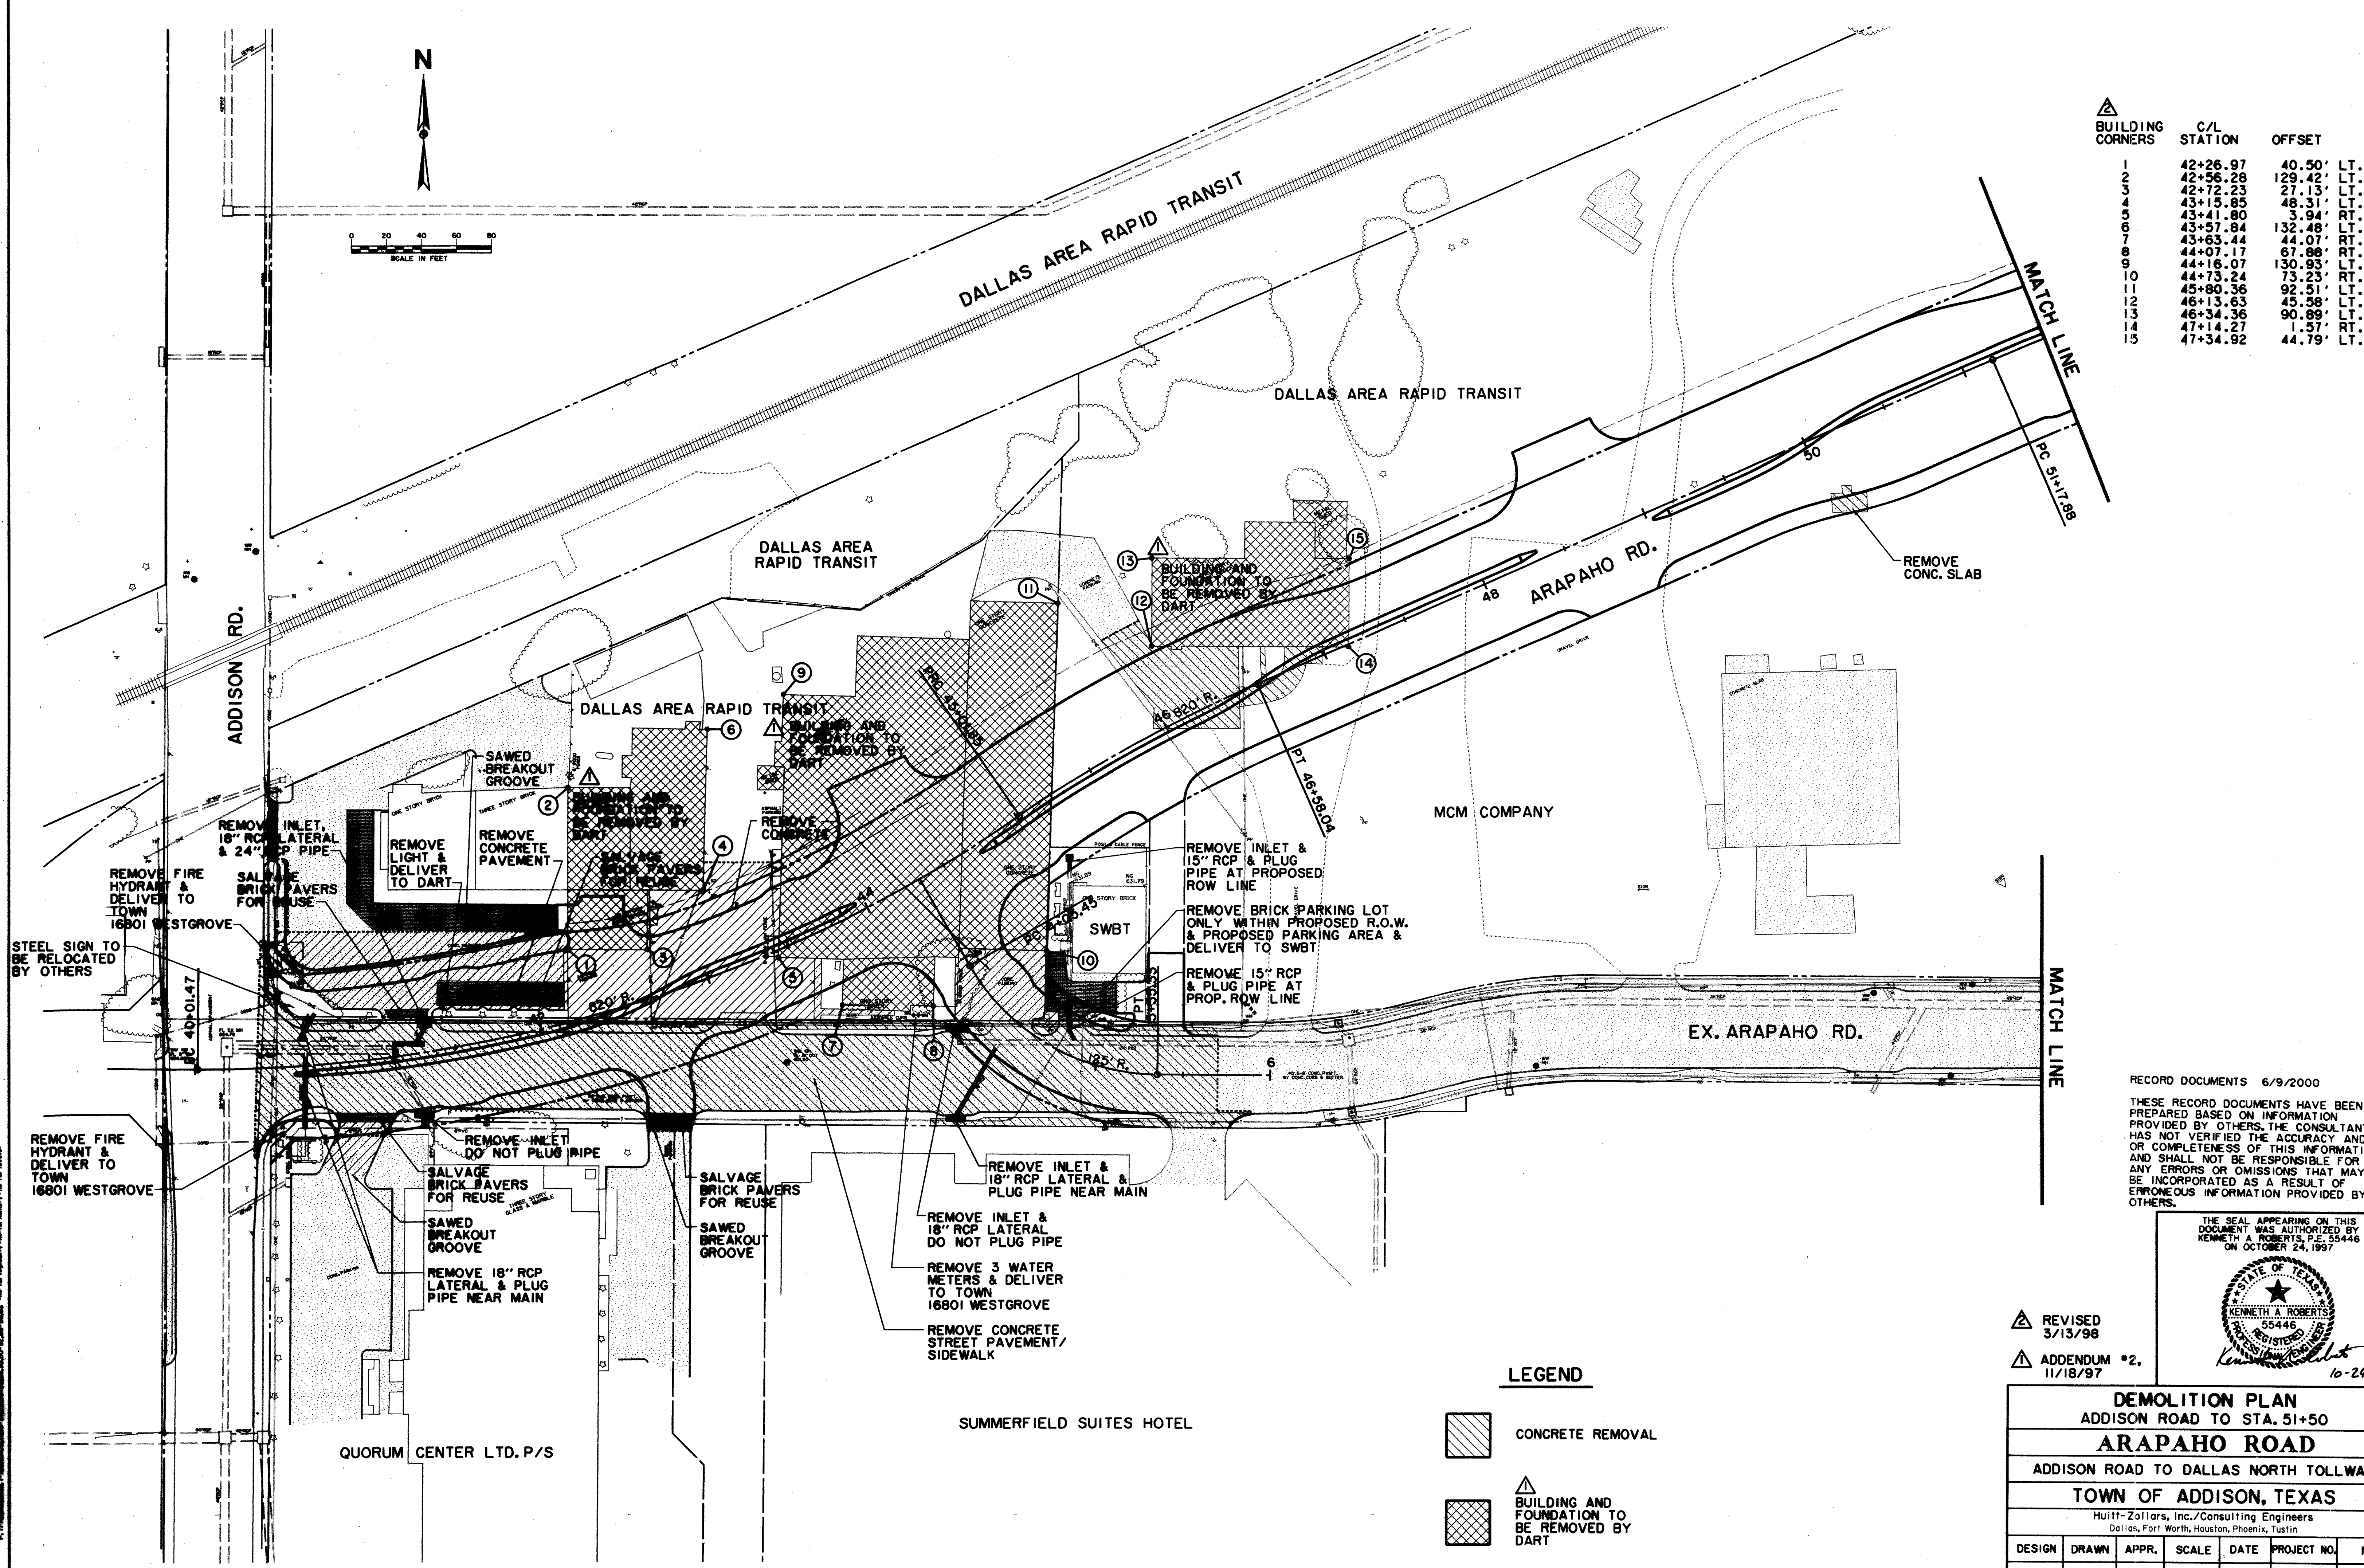

RECORD DOCUMENTS 6/9/2000

THESE RECORD DOCUMENTS HAVE BEEN PREPARED BASED ON INFORMATION PROVIDED BY OTHERS. THE CONSULTANT HAS NOT VERIFIED THE ACCURACY AND/OR COMPLETENESS OF THIS INFORMATION AND SHALL NOT BE RESPONSIBLE FOR ANY ERRORS OR OMISSIONS THAT MAY BE INCORPORATED AS A RESULT OF ERRONEOUS INFORMATION PROVIDED BY OTHERS.

THE SEAL APPEARING ON THIS DOCUMENT WAS AUTHORIZED BY KENNETH A. ROBERTS, P.E. 55446 ON OCTOBER 24, 1997

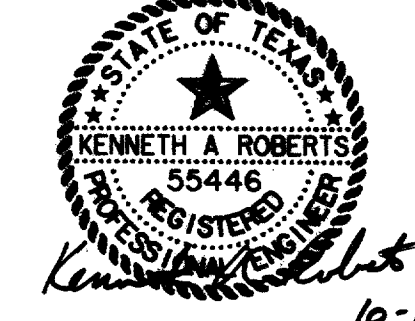

REVISD 3/13/98



ADDENDUM #2. 11/18/97

LEGEND

- CONCRETE REMOVAL
- BUILDING AND FOUNDATION TO BE REMOVED BY DART


DEMOLITION PLAN						
ADDISON ROAD TO STA. 51+50						
ARAPAHO ROAD						
ADDISON ROAD TO DALLAS NORTH TOLLWAY						
TOWN OF ADDISON, TEXAS						
<small>Hull-201ars, Inc./Consulting Engineers Dallas, Fort Worth, Houston, Phoenix, Tustin</small>						
DESIGN	DRAWN	APPR.	SCALE	DATE	PROJECT NO.	NO.
HZI	HZI	KAR	1"=40'	OCT 97	1772-01	D-1

N

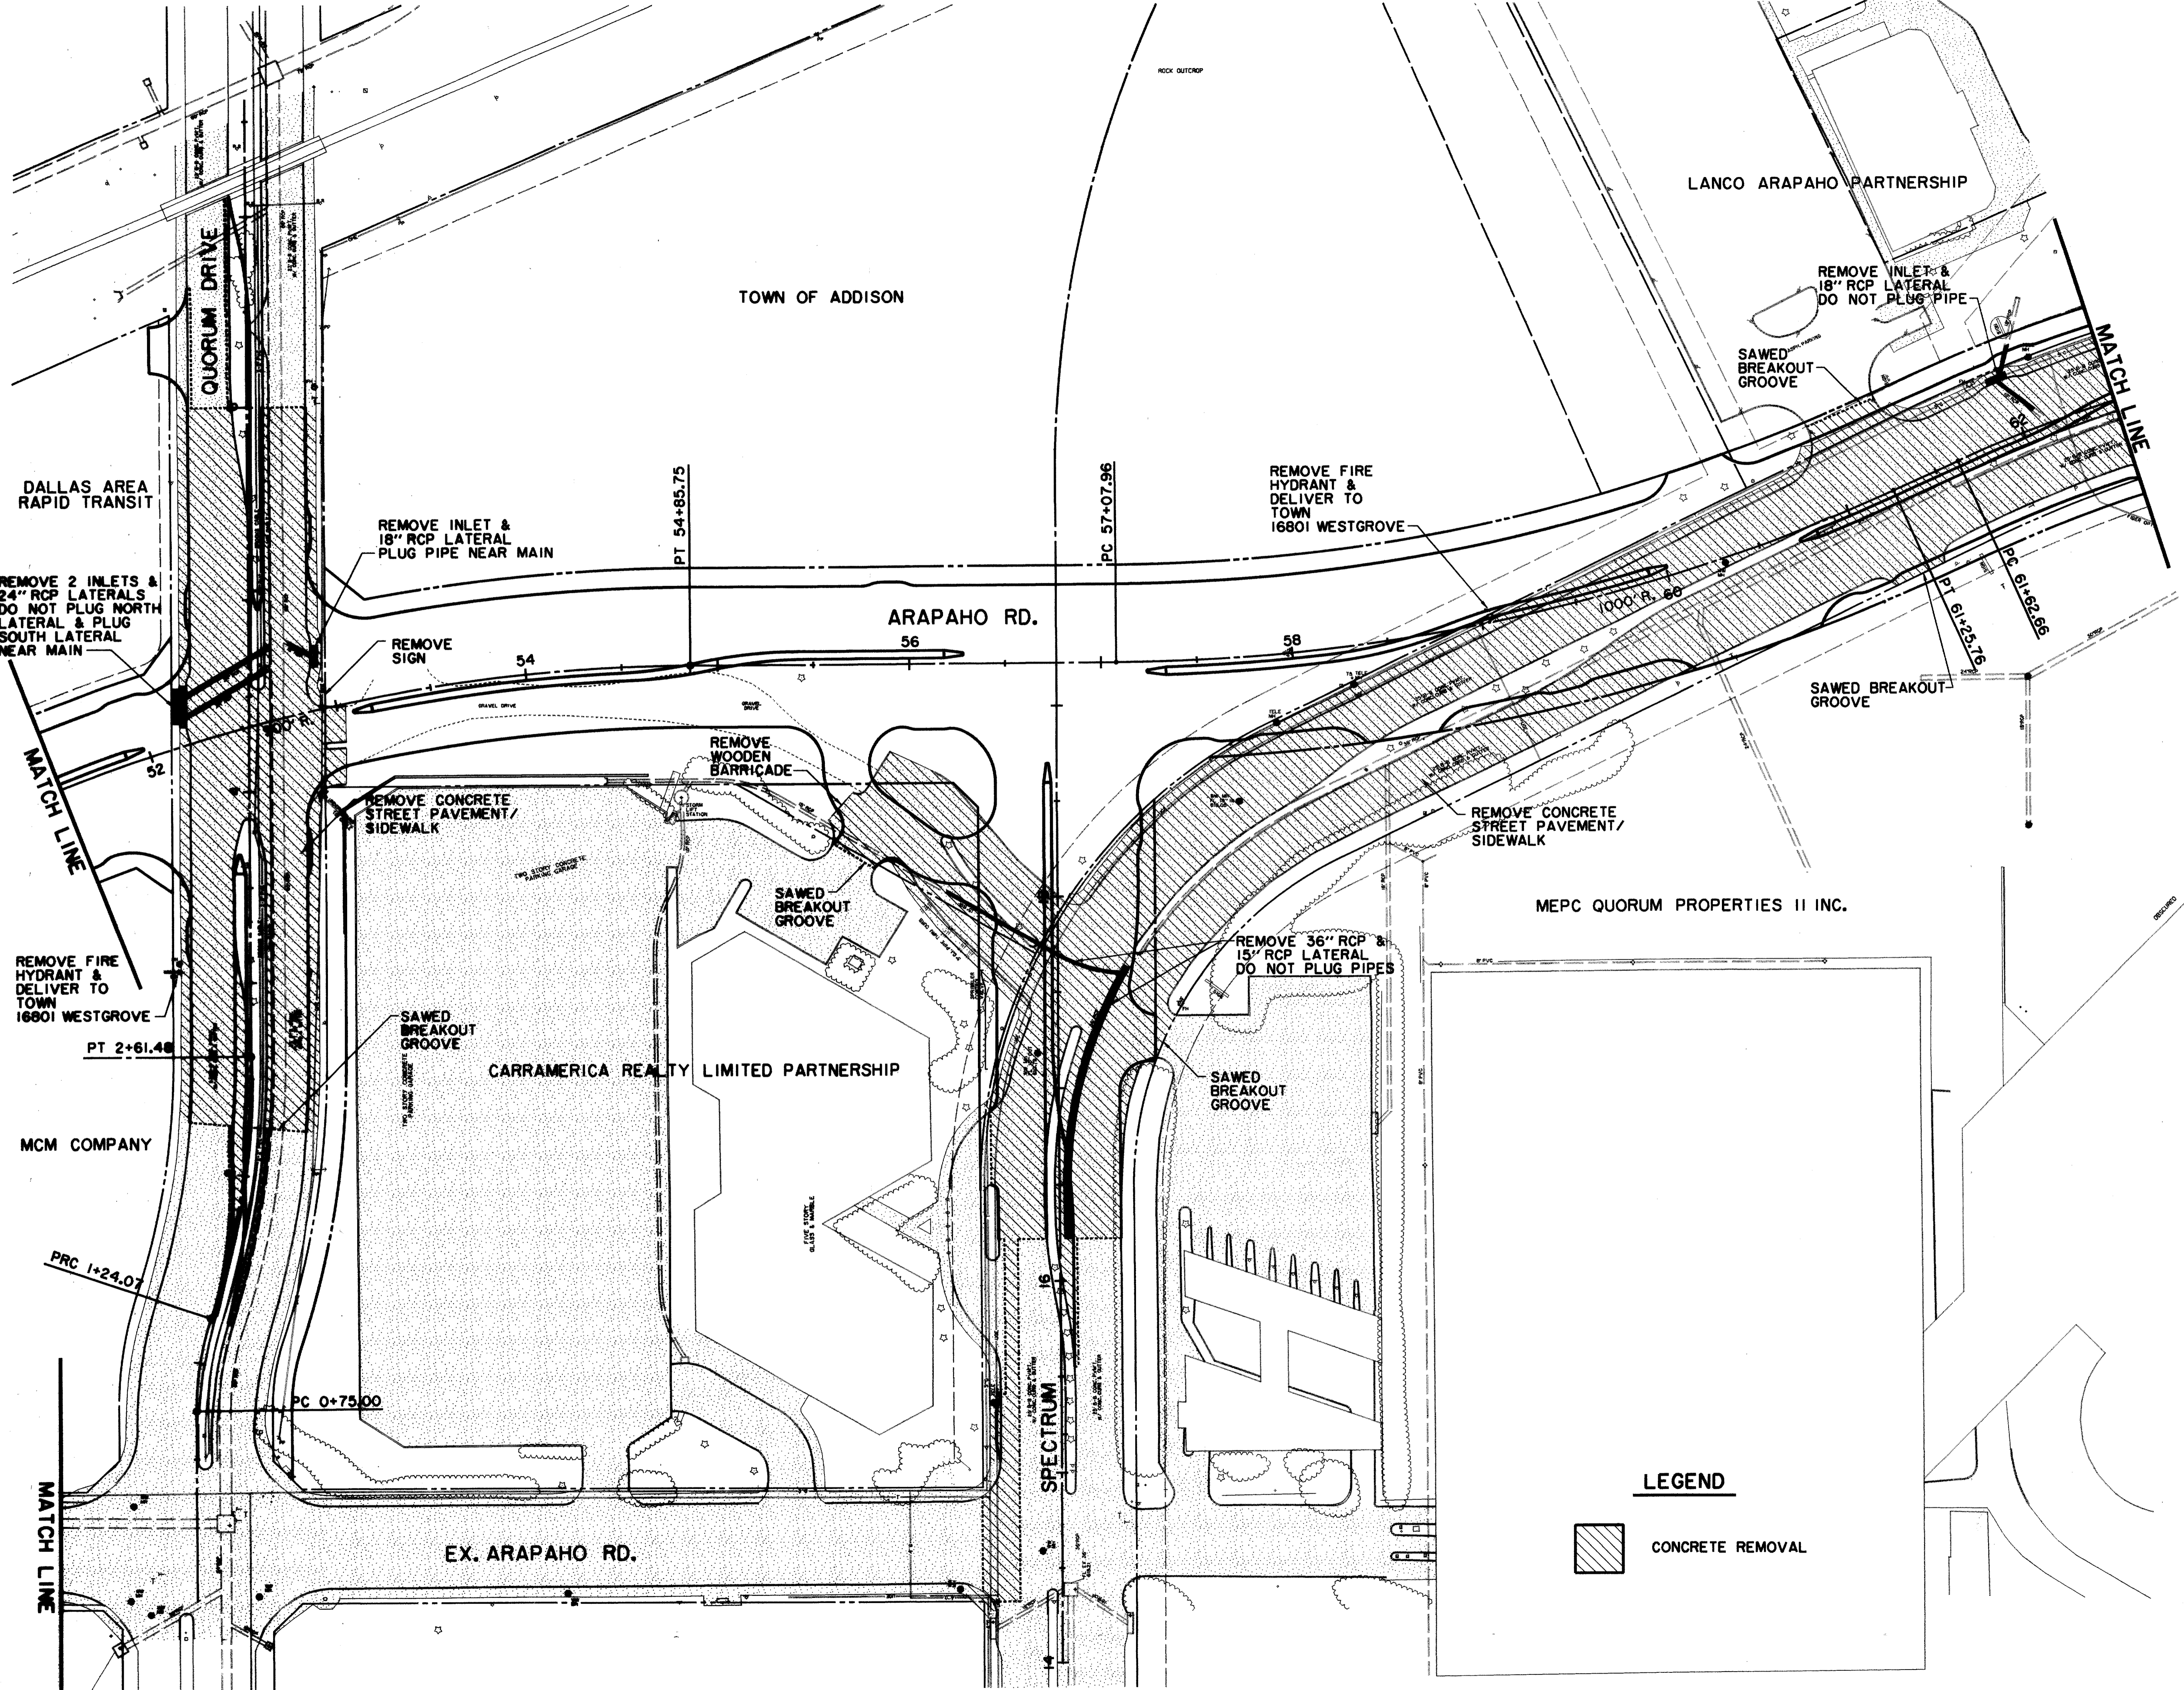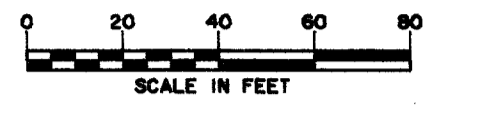

RECORD DOCUMENTS 6/9/2000
 THESE RECORD DOCUMENTS HAVE BEEN PREPARED BASED ON INFORMATION PROVIDED BY OTHERS. THE CONSULTANT HAS NOT VERIFIED THE ACCURACY AND/OR COMPLETENESS OF THIS INFORMATION AND SHALL NOT BE RESPONSIBLE FOR ANY ERRORS OR OMISSIONS THAT MAY BE INCORPORATED AS A RESULT OF ERRONEOUS INFORMATION PROVIDED BY OTHERS.


THE SEAL APPEARING ON THIS DOCUMENT WAS AUTHORIZED BY KENNETH A. ROBERTS, P.E. 55446 ON OCTOBER 24, 1997

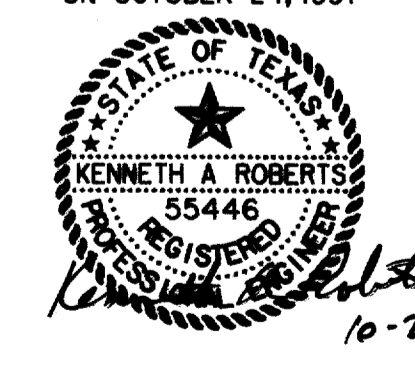

LEGEND

CONCRETE REMOVAL

DEMOLITION PLAN STA. 51+50 TO STA. 62+50						
ARAPAHO ROAD						
ADDISON ROAD TO DALLAS NORTH TOLLWAY						
TOWN OF ADDISON, TEXAS						
Huitt-Zollars, Inc./Consulting Engineers Dallas, Fort Worth, Houston, Phoenix, Tustin						
DESIGN	DRAWN	APPR.	SCALE	DATE	PROJECT NO.	NO.
HZI	HZI	KAR	1"=40'	OCT 97	1772-01	D-2

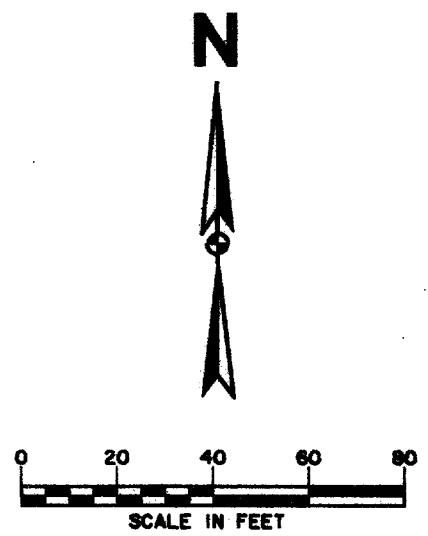

LANCO ARAPAHO PARTNERSHIP

CHATTAHOOCHEE LEASING CORPORATION

MATCH LINE

REMOVE CONCRETE STREET PAVEMENT/SIDEWALK

ARAPAHO RD.

REMOVE INLET & 18" RCP LATERAL DO NOT PLUG PIPE

REMOVE FIRE HYDRANT & DELIVER TO TOWN 16801 WESTGROVE

PC 66+51.52

PT 66+85.39

SAWED BREAKOUT GROOVE

68

REMOVE INLET DO NOT PLUG PIPE

PT 64+35.91


REMOVE INLET & 21" RCP LATERAL DO NOT PLUG PIPE

REMOVE INLET & 18" RCP LATERAL PLUG PIPE NEAR MAIN

DALLAS NORTH TOLLWAY

MEPC QUORUM PROPERTIES II INC.

RECORD DOCUMENTS 6/9/2000
 THESE RECORD DOCUMENTS HAVE BEEN PREPARED BASED ON INFORMATION PROVIDED BY OTHERS. THE CONSULTANT HAS NOT VERIFIED THE ACCURACY AND/OR COMPLETENESS OF THIS INFORMATION AND SHALL NOT BE RESPONSIBLE FOR ANY ERRORS OR OMISSIONS THAT MAY BE INCORPORATED AS A RESULT OF ERRONEOUS INFORMATION PROVIDED BY OTHERS.

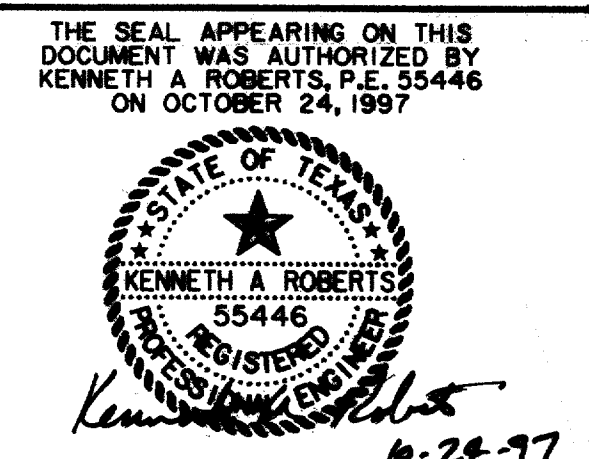

LEGEND

CONCRETE REMOVAL


DEMOLITION PLAN						
STA. 62+50 TO DALLAS NORTH TOLLWAY						
ARAPAHO ROAD						
ADDISON ROAD TO DALLAS NORTH TOLLWAY						
TOWN OF ADDISON, TEXAS						
Huitt-Zollars, Inc./Consulting Engineers Dallas, Fort Worth, Houston, Phoenix, Tustin						
DESIGN	DRAWN	APPR.	SCALE	DATE	PROJECT NO.	NO.
HZI	HZI	KAR	1"=40'	OCT 97	1772-01	D-3

ITEM NO	DESCRIPTION	UNIT	SHEET SUMMARY																		ITEM NO.	PROJ. TOTAL
			D-1	D-2	D-3	P-3	P-4	P-5	P-6	P-7	P-8	P-9	P-10	P-11	P-12	P-15	P-16	P-17	P-18			
	PAVING IMPROVEMENTS																					
101	BARRICADES AND TRAFFIC CONTROL	MONTH				14															101	14
102	PREPARING RIGHT-OF-WAY	STA				4.65	5	5	5	5	2.35	1.75	2.5	2	3.75						102	37
103	REMOVE EX. CONCRETE PAVEMENT	SY	2,963	5,832	3,969																103	12,764
104	REMOVE EX. CONCRETE SIDEWALK	SF	2,890	4,621	2,172																104	9,683
105	UNCLASSIFIED STREET EXCAVATION	CY				1,243	2,299	2,732	2,957	1,336	1,485	175	150	150	600						105	13,127
106	10" 650 PSI FLEX REINF. CONC. PAVEMENT	SY				4,261	3,943	4,776	4,649	4,465	2,687	980	797	700	2,174						106	29,432
107	6" 650 PSI FLEX REINF. CONC. PAVEMENT	SY				619	35		129	260		204		74	388						107	1,709
108	6" LIME STAB. COMP. SUBGRADE/PROOFROLLING	SY				5,078	4,182	4,999	4,979	4,916	2,736	1,231	870	829	2,689						108	32,509
109	HYDRATED LIME (30 LBS./SY)	TON				76	63	75	75	74	41	18	13	12	41						109	488
110	6" INTEGRAL CONCRETE CURB	LF				1,785	1,835	2,001	1,817	1,714	1,423	431	657	493	1,140						110	13,296
111	MONOLITHIC MEDIAN NOSE	EA				3	2	2	3	1	1		1	1	1						111	15
112	650 PSI FLEX REINF. CONC. ISLAND	SY														85					112	85
113	4" 3000 PSI REINF. CONC. SIDEWALK	SF														1,480				1,332	113	2,812
114	6" THICK HMAC FOR DETOURS,	SY									350	350	200								114	1,700
115	REINF. CONC. STREET HEADER	LF											45	56	56	50					115	207
116	4" REFL. PAVEMENT MARKER TYPE I-C	EA															252	424	304		116	980
117	4" REFL. PAVEMENT MARKER TYPE II-A-A	EA															32				117	32
118	CERAMIC 6"x6" REFL. JIGGLE BAR	EA															115	117	79		118	311
119	8" DIA. TWO-WAY DUAL REFL. PVMT MARKER (YEL)	EA																	246		119	246
120	4" REFL. FIRE HYDRANT MARKER (BLUE)	EA															10	4	3		120	17
121	24" REFL. STOP BAR (WHITE)	LF															288	243	44		121	575
122	PVMT. ADVISORY MARKER (WHITE)	EA															9	10	7		122	26
123	4" REFL. TEMP. LANE STRIPE	LF				1,000				2,000	2,000	1,000	2,000	1,600	1,600	1,600					123	12,800
124	2" PVC SCH. 40 STREET LIGHT CONDUIT	LF				490	500	500	500	500	265		387	322	236						124	3,700
125	STREET LIGHT FOUNDATION	EA				4	3	3	3	3	1		1	1	1						125	20
126	STREET LIGHT PULL BOX	EA				3	2	2	3	1	1		2	2	2						126	18
127	MISCELLANEOUS EXCAVATION	CY						4,133	2,067												127	6,200
128	6"x12" REINFORCED CONCRETE BAND	LF											65								128	65
129	3600 PSI REINF. CONC. RET. WALL/SIDEWALK	CY																	8		129	8
130	3600 PSI REINF. CONC. RETAINING WALL	SF																		3,300	130	3,300



RECORD DOCUMENTS 6/9/2000

THESE RECORD DOCUMENTS HAVE BEEN PREPARED BASED ON INFORMATION PROVIDED BY OTHERS. THE CONSULTANT HAS NOT VERIFIED THE ACCURACY AND/OR COMPLETENESS OF THIS INFORMATION AND SHALL NOT BE RESPONSIBLE FOR ANY ERRORS OR OMISSIONS THAT MAY BE INCORPORATED AS A RESULT OF ERRONEOUS INFORMATION PROVIDED BY OTHERS.

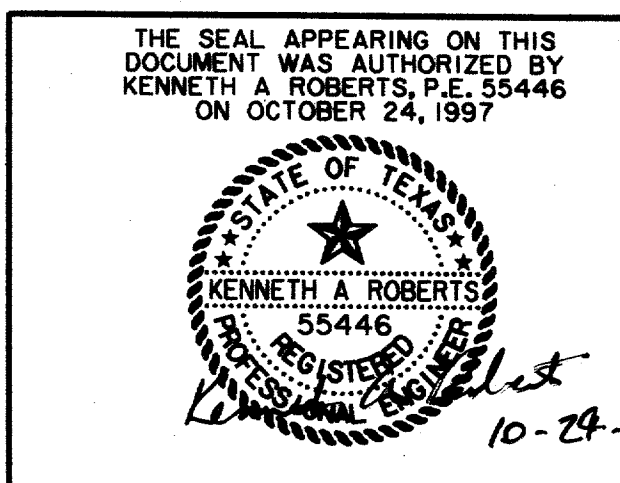

UPDATED 1/16/98


QUANTITY SUMMARY SHEET						
ARAPAHO ROAD						
ADDISON ROAD TO DALLAS NORTH TOLLWAY						
TOWN OF ADDISON, TEXAS						
Huitt-Zollars, Inc./Consulting Engineers Dallas, Fort Worth, Houston, Phoenix, Tustin						
DESIGN	DRAWN	APPR.	SCALE	DATE	PROJECT NO.	NO.
HZ1	HZ1	KAR	N.T.S.	OCT 97	1772-01	Q-1

H:\PROJ\177201\DRAW\17720101.DWG
 17720101.DWG
 10/24/97
 K. A. ROBERTS
 REGISTERED PROFESSIONAL ENGINEER
 STATE OF TEXAS
 NO. 55446

ITEM NO	DESCRIPTION	UNIT	SHEET SUMMARY																	ITEM NO.	PROJ. TOTAL		
			D-1	D-2	D-3	ST-6	ST-7	ST-8	ST-9	ST-10	ST-11	ST-12	ST-13	ST-14	W-1	W-2	W-3	W-4	W-5			W-6	W-7
STORMWATER IMPROVEMENTS																							
201	15" PVC SDR35, FITTINGS & CLEANOUT	LF												46								201	46
202	15" CLASS III RCP	LF												34								202	34
203	18" CLASS III RCP	LF				101	123	96	104	20	158			125								203	727
204	21" CLASS III RCP	LF				85							71									204	156
205	24" CLASS III RCP	LF				460		123	192													205	775
206	36" CLASS III RCP	LF								468	61											206	529
207	39" CLASS III RCP	LF								97	368											207	465
208	42" CLASS III RCP	LF						162														208	162
209	TYPE 'A' MANHOLE	EA				1																209	1
210	TYPE 'B' MANHOLE	EA								2	1											210	3
211	DBL TYPE 'B' HEADWALL (42" RCP)	EA								1												211	1
212	2' THICK STONE RIPRAP, TYPE 'A'	SY										290										212	290
213	SOLID SOD BERMUDA GRASS	SY										156										213	156
214	HYDROMULCH BERMUDA GRASS	SY										1,435										214	1,435
215	6' STANDARD INLET	EA				1																215	1
216	14' STANDARD INLET	EA											1									216	1
217	6' RECESSED INLET	EA					2															217	2
218	8' RECESSED INLET	EA					1															218	1
219	10' RECESSED INLET	EA				3		6	1		2		4	1								219	17
220	12' RECESSED INLET	EA							2													220	2
221	14' RECESSED INLET	EA				2				2												221	4
222	4'x4' 'Y' INLET	EA							1													222	1
223	REMOVE PIPE	LF	162	405	65																	223	632
224	REMOVE INLET	EA	5	3	4																	224	12
225	UNCLASSIFIED CHANNEL EXCAVATION	CY										1,545										225	1,545
226	TRENCH SAFETY DESIGN (ALL UTILITIES)	LS				1																226	1
227	TRENCH SAFETY - STORMWATER	LF				646	123	381	296	665	587		125	71								227	2,894
228	INLET PROTECTION	EA				6	3	6	4	2	2		4	2								228	29
229	STRAW BALE DIKE	LF							65													229	125
230	ROCK BERM	LF												20								230	20
231	SILT FENCE	LF											1,050									231	1,050
232	STABILIZED CONSTR. ENTRY/EXIT	EA					1	2					1									232	4
WATER IMPROVEMENTS																							
301	4" P.V.C. WATER, CL 'A' EMBEDMENT	LF													20							301	20
302	6" P.V.C. WATER, CL 'A' EMBEDMENT	LF													87	17	55	25	15	19		302	218
303	8" P.V.C. WATER, CL 'A' EMBEDMENT	LF												249	580	391						303	1,220
304	4" GATE VALVE / BOX	EA													1							304	1
305	6" GATE VALVE / BOX	EA												1	3	2	1					305	7
306	8" GATE VALVE / BOX	EA												2	4	2						306	8
307	FIRE HYDRANT ASSEMBLY	EA												2	4	3	1	2	1	1		307	14
308	CONCRETE ENCASUREMENT	LF												40								308	40
309	8"x6" TAPPING SLEEVE & VALVE/BOX	EA												1								309	1
310	24"x8" TAPPING SLEEVE & VALVE/BOX	EA														2						310	2
311	12"x6" TAPPING SLEEVE & VALVE/BOX	EA																		1		311	1
312	WATER METER/VAULT/BACKFLOW PREVENTER	EA												1								312	1
313	WATER METER/BOX/BACKFLOW PREVENTER	EA												2								313	2
314	ADJUST EXISTING WATER VALVE COVER & STACK	EA														2		2	1			314	5
315	ADJUST EXISTING WATER METER BOX	EA														2						315	2
316	RECONNECT EXISTING SERVICES	EA													3							316	3
317	CONNECT TO EXISTING WATER	EA												1			1	2	1			317	5
318	TRENCH SAFETY - WATER	LF												249	687	408	55	25	15	19		318	1,458
319	WATER TEST	LS												1								319	1
328	2" IRRIGATION TAP/VALVE/BOX	EA													1							328	2
WASTEWATER IMPROVEMENTS																							
320	8" P.V.C. SDR35 WASTEWATER, CL '4' EMBEDMENT	LF												194			290	13				320	497
321	CONSTRUCT 4' DIA. MANHOLE	EA															1					321	1
322	CONNECT TO EX. MANHOLE	EA												1			1					322	2
323	ADJUST MANHOLE TOP	EA																2	1	1		323	4
324	CONCRETE ENCASUREMENT	LF															20					324	20
325	TRENCH SAFETY - WASTEWATER	LF												194			290	13				325	497
326	T.V. INSPECTION WASTEWATER MAIN	LF												194			290	13				326	497
327	WASTEWATER LINE & MANHOLE TEST	LS												1								327	1

RECORD DOCUMENTS 6/9/2000

THESE RECORD DOCUMENTS HAVE BEEN PREPARED BASED ON INFORMATION PROVIDED BY OTHERS. THE CONSULTANT HAS NOT VERIFIED THE ACCURACY AND/OR COMPLETENESS OF THIS INFORMATION AND SHALL NOT BE RESPONSIBLE FOR ANY ERRORS OR OMISSIONS THAT MAY BE INCORPORATED AS A RESULT OF ERRONEOUS INFORMATION PROVIDED BY OTHERS.

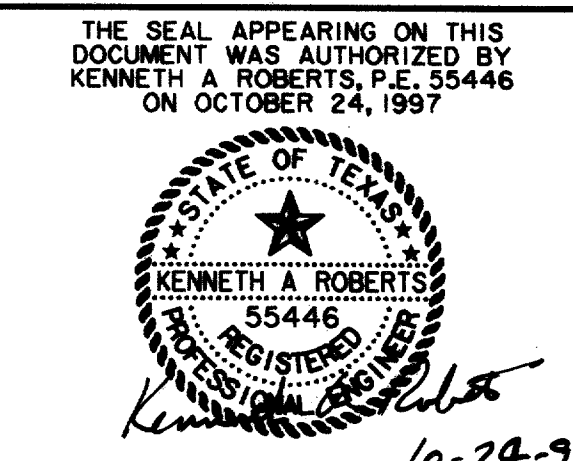


△ UPDATED 1/16/98

QUANTITY SUMMARY SHEET						
ARAPAHO ROAD						
ADDISON ROAD TO DALLAS NORTH TOLLWAY						
TOWN OF ADDISON, TEXAS						
Huitt-Zollars, Inc./Consulting Engineers Dallas, Fort Worth, Houston, Phoenix, Tustin						
DESIGN	DRAWN	APPR.	SCALE	DATE	PROJECT NO.	NO.
HZI	HZI	KAR	N.T.S.	OCT 97	1772-01	Q-2


ITEM NO	DESCRIPTION	UNIT	SHEET SUMMARY																ITEM NO.	PROJ. TOTAL
			TOTALS																	
STREETSCAPE IMPROVEMENTS																				
501	BRICK PAVER/DROP SLAB/ARAPAHO/QUORUM	SF	3,950														501	3,950		
502	SANDBLAST CONC PVMT/ARAPAHO/QUORUM	SF	9,800														502	9,800		
503	CONCRETE CROSSWALKS SANDBLAST FINISH	SF	3,490														503	3,490		
504	BRICK PAVING/CONCRETE SIDEWALK/QUORUM	SF	4,000														504	4,000		
505	DOUBLE ROW BRICK BAND ON CONCRETE SLAB	SF	8,763														505	8,763		
506	SPEC. SIDEWALK/DIAG. SAWCUTS/SANDBLAST	SF	44,288														506	44,288		
507	1/4" FIBEROUS EXPANSION JOINT	LF	9,780														507	9,780		
508	1' CONCRETE EDGER ACROSS MEDIAN	LF	385														508	385		
509	BEGA LIGHT FIXTURE/POLE/FOUNDATION	EA	77														509	77		
510	3/4" SCH 40 PVC ELEC. CONDUIT	LF	3,500														510	3,500		
511	1" SCH 40 PVC ELEC. CONDUIT	LF	4,000														511	4,000		
512	2" SCH 40 PVC ELEC. CONDUIT	LF	1,200														512	1,200		
513	*6 AWG ELEC. WIRE WITH TERMINATIONS	LF	4,000														513	4,000		
514	*8 AWG ELEC. WIRE WITH TERMINATIONS	LF	10,000														514	10,000		
515	*10 AWG ELEC. WIRE WITH TERMINATIONS	LF	2,800														515	2,800		
516	CAST IRON ELECTRICAL JUNCTION BOX	EA	12														516	12		
517	60" TREE GRATE W/CONC. EDGE & BEAM	EA	113														517	113		
518	LIGHTED BOLLARD/CONDUIT/WIRING	EA	16														518	16		
519	4" PERFORATED PVC FRENCH DRAIN	LF	700														519	700		
520	NON-PERF. PVC CONNECTED TO INLETS	LF	4,500														520	4,500		
521	RED OAK TREE / 100 GAL. / 4" CAL.	EA	125														521	125		
522	FOSTER HOLLY / 12 FT. HEIGHT	EA	132														522	132		
523	ASIAN JASMINE / 4" POT / 9" O.C. IN QUORUM	SF	504														523	504		
524	BERMUDA SOD (TEX TURF 10)/6" TOPSOIL	SF	21,862														524	21,862		
525	ASIAN JASMINE / 4" POT / 9" O.C. IN MEDIAN	SF	2,275														525	2,275		
526	1 1/2" HERSEY WATER METER & VALVE	EA	2														526	2		
527	FEBCO 805-Y DOUBLE CHECK VALVE	EA	2														527	2		
528	RAINMASTER EVOLUTION DX-2 CONTROLLER	EA	1														528	1		
529	ELEC. SERVICE CONNECTION FOR IRRIGATION	LS	1														529	1		
530	RAIN BIRD 1402 BUBBLER FOR TREE WELL	EA	214														530	214		
531	TORO 57DZ-40 - 4" POP-UP FOR LAWNS	EA	318														531	318		
532	TORO 5702 - 12" POP-UP FOR PLANTING BED	EA	227														532	227		
533	4" SCH. 40 PVC SLEEVES FOR IRRIGATION	LF	1,160														533	1,160		
534	2 1/2" SCH. 40 PVC SLEEVES FOR IRRIGATION	LF	5,260														534	5,260		
535	WEATHERMATIC 1" ELEC. CONTROL VALVE	EA	3														535	3		
536	WEATHERMATIC 1 1/2" ELEC. CONTROL VALVE	EA	7														536	7		
537	WEATHERMATIC 2" ELEC. CONTROL VALVE	EA	8														537	8		
538	14 GA. ELECTRIC VALVE WIRING	LF	18,100														538	18,100		
539	2" SCH 40 BELLED PVC MAIN LINE	LF	350														539	350		
540	SPEARS 2" BALL VALVE	EA	18														540	18		
541	BUCKNER QUICK CONNECT VALVE	EA	4														541	4		
542	2 1/2" CLASS 200 PVC PIPE & FITTINGS	LF	80														542	80		
543	2" CLASS 200 PVC PIPE & FITTINGS	LF	1,120														543	1,120		
544	1 1/2" CLASS 200 PVC PIPE & FITTINGS	LF	1,360														544	1,360		
545	1 1/4" CLASS 200 PVC PIPE & FITTINGS	LF	3,220														545	3,220		
546	1" CLASS 200 PVC PIPE & FITTINGS	LF	4,000														546	4,000		
547	3/4" CLASS 200 PVC PIPE & FITTINGS	LF	3,400														547	3,400		
ALTERNATES																				
548	60" GRATE W/METAL FRAME-NEENAH(DEDUCT)	EA	109														548	109		
549	SW W/BASE & BASE TREE GRATE(DEDUCT)	EA	109														549	109		
550	3/4" SCH 40 PVC ELEC. CONDUIT & FITTINGS	LF	1,750														550	1,750		

RECORD DOCUMENTS 6/9/2000
 THESE RECORD DOCUMENTS HAVE BEEN PREPARED BASED ON INFORMATION PROVIDED BY OTHERS. THE CONSULTANT HAS NOT VERIFIED THE ACCURACY AND/OR COMPLETENESS OF THIS INFORMATION AND SHALL NOT BE RESPONSIBLE FOR ANY ERRORS OR OMISSIONS THAT MAY BE INCORPORATED AS A RESULT OF ERRONEOUS INFORMATION PROVIDED BY OTHERS.

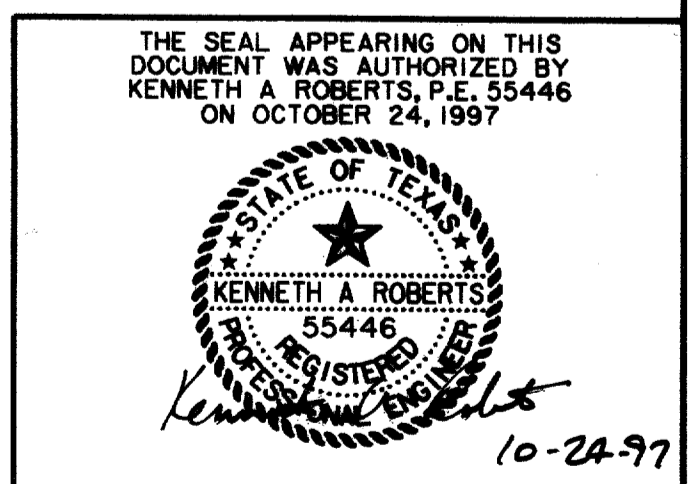

UPDATED 1/16/98

QUANTITY SUMMARY SHEET						
ARAPAHO ROAD						
ADDISON ROAD TO DALLAS NORTH TOLLWAY						
TOWN OF ADDISON, TEXAS						
Huitt-Zollars, Inc./Consulting Engineers Dallas, Fort Worth, Houston, Phoenix, Tustin						
DESIGN	DRAWN	APPR.	SCALE	DATE	PROJECT NO.	NO.
HZI	HZI	KAR	N.T.S.	OCT 97	1772-01	Q-4

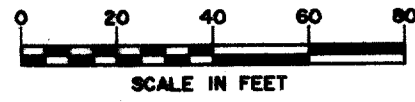

DALLAS AREA RAPID TRANSIT PROPERTY ACQUISITION
VOL. 910088 PG. 1390

DALLAS AREA RAPID TRANSIT
VOL. 96899 PG. 05197

DALLAS AREA RAPID TRANSIT
VOL. 96169 PG. 04485

JOSEPH H. JONES, BETH BRANDEBERRY,
CAROLYN PERKINS SHIMER MERRITT AND
SAMUEL THOMAS PERKINS, CO-TRUSTEES OF
THE MARY CORFIELD TRUST, THE EVELYN C.
JONES TRUST, THE BETH BRANDEBERRY TRUST
AND THE CORINNE SHIMER TRUST AND
A BEN PINNELL, JR.
VOL. 97109 PG. 03158

MCM COMPANY
VOL. 76212 PG. 3704
VOL. 82179 PG. 1556
VOL. 82179 PG. 1559
VOL. 84008 PG. 1944
VOL. 84153 PG. 0532

INTERNATIONAL GUARANTY CORP.
VOL. 92001 PG. 0617

QUORUM CENTER LTD. P/S
VOL. 42038 PG. 0247


QUORUM CENTRE ADDITION
VOL. 84067 PG. 5718

QUORUM CENTRE ADDITION
VOL. 84067 PG. 5718

QUORUM CENTRE - EAST NO. 2 ADDITION
VOL. 96187 PG. 01867

RECORD DOCUMENTS 6/9/2000
THESE RECORD DOCUMENTS HAVE BEEN PREPARED BASED ON INFORMATION PROVIDED BY OTHERS. THE CONSULTANT HAS NOT VERIFIED THE ACCURACY AND/OR COMPLETENESS OF THIS INFORMATION AND SHALL NOT BE RESPONSIBLE FOR ANY ERRORS OR OMISSIONS THAT MAY BE INCORPORATED AS A RESULT OF ERRONEOUS INFORMATION PROVIDED BY OTHERS.

THE SEAL APPEARING ON THIS DOCUMENT WAS AUTHORIZED BY KENNETH A. ROBERTS, P.E. 55446 ON OCTOBER 24, 1997

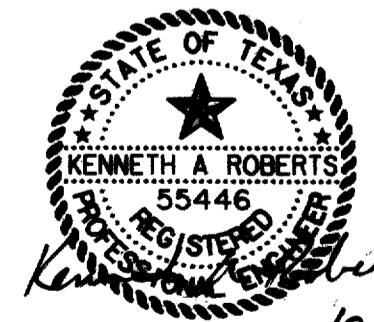

REVISOR 1/16/98


RIGHT-OF-WAY MAP						
ARAPAHO ROAD						
ADDISON ROAD TO DALLAS NORTH TOLLWAY						
TOWN OF ADDISON, TEXAS						
Huitt-Zollars, Inc./Consulting Engineers Dallas, Fort Worth, Houston, Phoenix, Tustin						
DESIGN	DRAWN	APPR.	SCALE	DATE	PROJECT NO.	NO.
HZI	HZI	KAR	1"=40'	OCT 97	1772-01	R-1

THIS MAP IS THE PROPERTY OF HUIIT-ZOLLARS, INC. AND IS LOANED TO YOU FOR YOUR CONVENIENCE. IT IS NOT TO BE REPRODUCED OR COPIED IN ANY MANNER WITHOUT THE WRITTEN PERMISSION OF HUIIT-ZOLLARS, INC.

THIS MAP IS THE PROPERTY OF HUIIT-ZOLLARS, INC. AND IS LOANED TO YOU FOR YOUR CONVENIENCE. IT IS NOT TO BE REPRODUCED OR COPIED IN ANY MANNER WITHOUT THE WRITTEN PERMISSION OF HUIIT-ZOLLARS, INC.

ADDISON CAR CARE ADDITION
VOL. 87111 PG. 0286

EDWARD COOK SURVEY ABSTRACT NO. 362
G.W. FISHER SURVEY ABSTRACT NO. 482

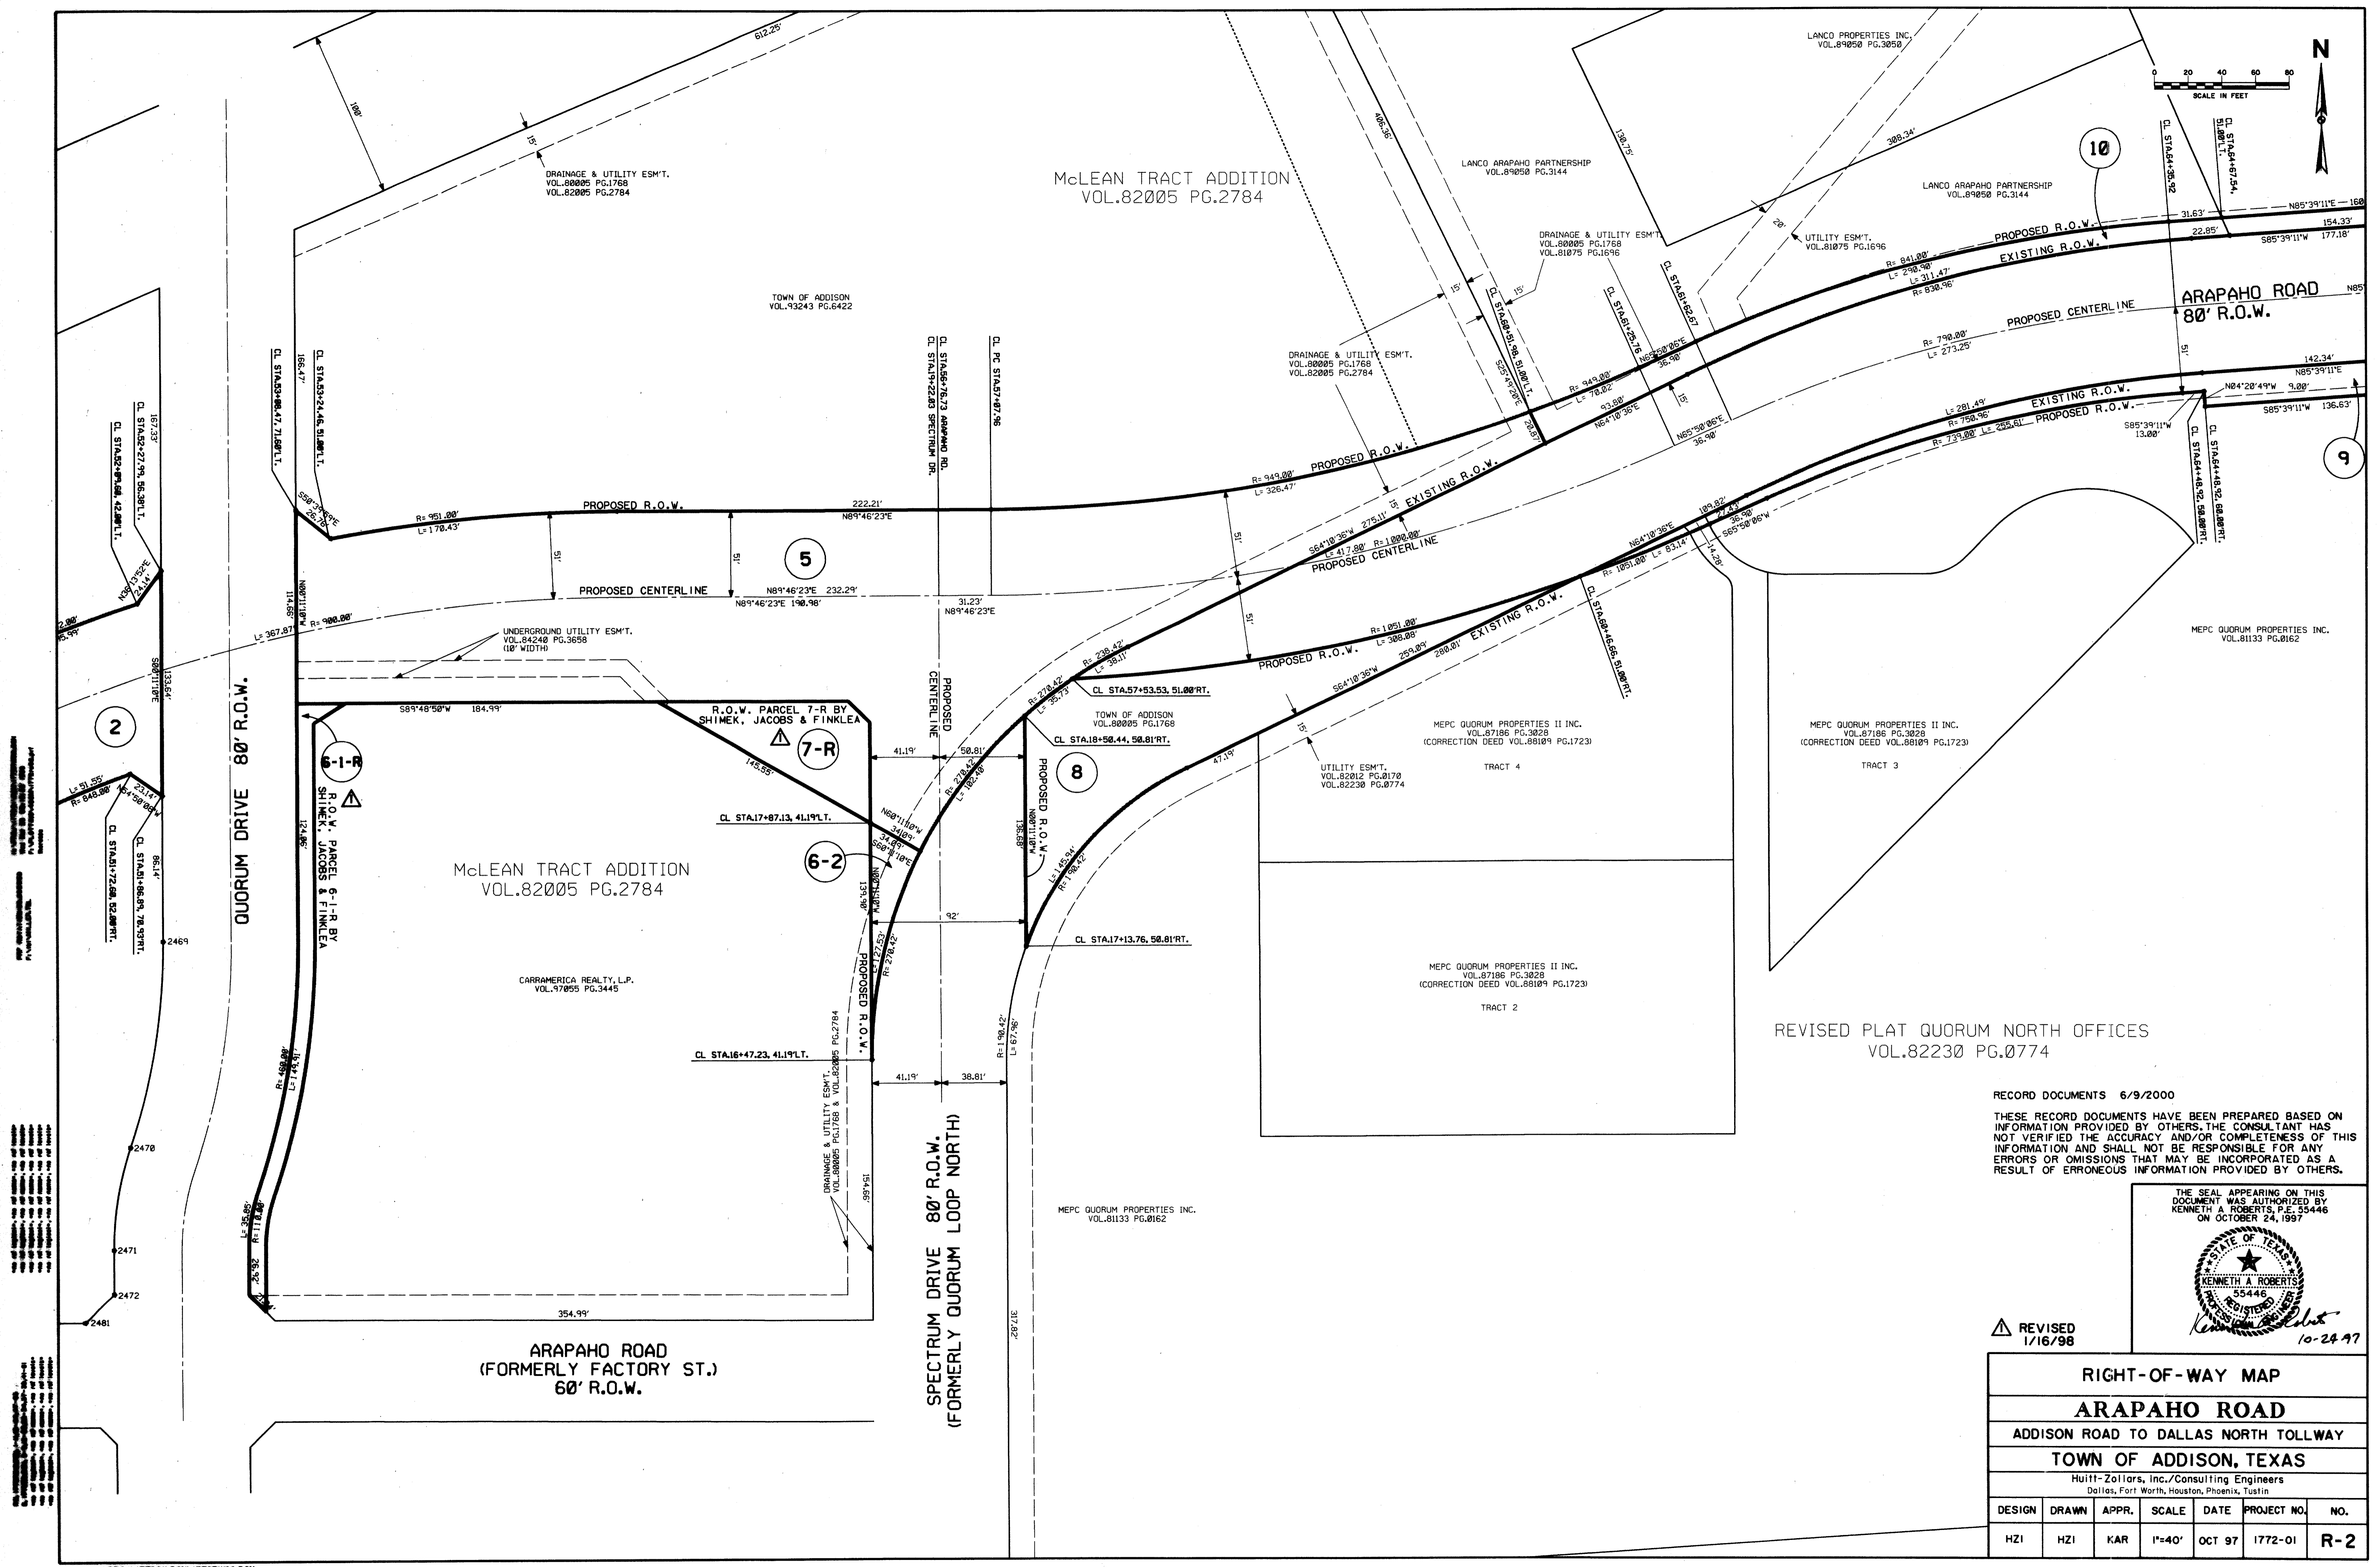

RECORD DOCUMENTS 6/9/2000
 THESE RECORD DOCUMENTS HAVE BEEN PREPARED BASED ON INFORMATION PROVIDED BY OTHERS. THE CONSULTANT HAS NOT VERIFIED THE ACCURACY AND/OR COMPLETENESS OF THIS INFORMATION AND SHALL NOT BE RESPONSIBLE FOR ANY ERRORS OR OMISSIONS THAT MAY BE INCORPORATED AS A RESULT OF ERRONEOUS INFORMATION PROVIDED BY OTHERS.


THE SEAL APPEARING ON THIS DOCUMENT WAS AUTHORIZED BY KENNETH A. ROBERTS, P.E. 55446 ON OCTOBER 24, 1997

10-24-97

REVISÉ
1/16/98

RIGHT-OF-WAY MAP						
ARAPAHO ROAD						
ADDISON ROAD TO DALLAS NORTH TOLLWAY						
TOWN OF ADDISON, TEXAS						
Hult-Zollars, Inc./Consulting Engineers Dallas, Fort Worth, Houston, Phoenix, Tustin						
DESIGN	DRAWN	APPR.	SCALE	DATE	PROJECT NO.	NO.
HZI	HZI	KAR	1"=40'	OCT 97	1772-01	R-2

DALLAS AREA RAPID TRANSIT PROPERTY ACQUISITION
VOL. 91800 PG. 1398

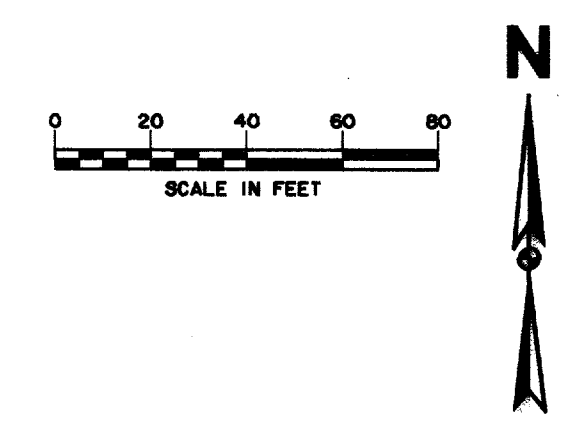

TOWN OF ADDISON
VOL. 93243 PG. 6422

McLEAN TRACT ADDITION
VOL. 82005 PG. 2784

LANCO ARAPAHO PARTNERSHIP
VOL. 89050 PG. 3144

ADLESTEIN ADDITION
VOL. 81075 PG. 1696

CHATTAHOOCHEE LEASING CORPORATION
VOL. 95191 PG. 06172

LANCO PROPERTIES INC.
VOL. 89050 PG. 3050

LANCO ARAPAHO PARTNERSHIP
VOL. 89050 PG. 3144

LANCO ARAPAHO PARTNERSHIP
VOL. 89050 PG. 3144

DRAINAGE & UTILITY ESMT.
VOL. 80005 PG. 1768
VOL. 81075 PG. 1696


UTILITY ESMT.
VOL. 81075 PG. 1696

DRAINAGE & UTILITY ESMT.
VOL. 80005 PG. 1768
VOL. 82005 PG. 2784

ARAPAHO ROAD
80' R.O.W.

DALLAS NORTH TOLLWAY
(VARIABLE WIDTH)

SEE PREVIOUS SHEET
FOR THIS AREA

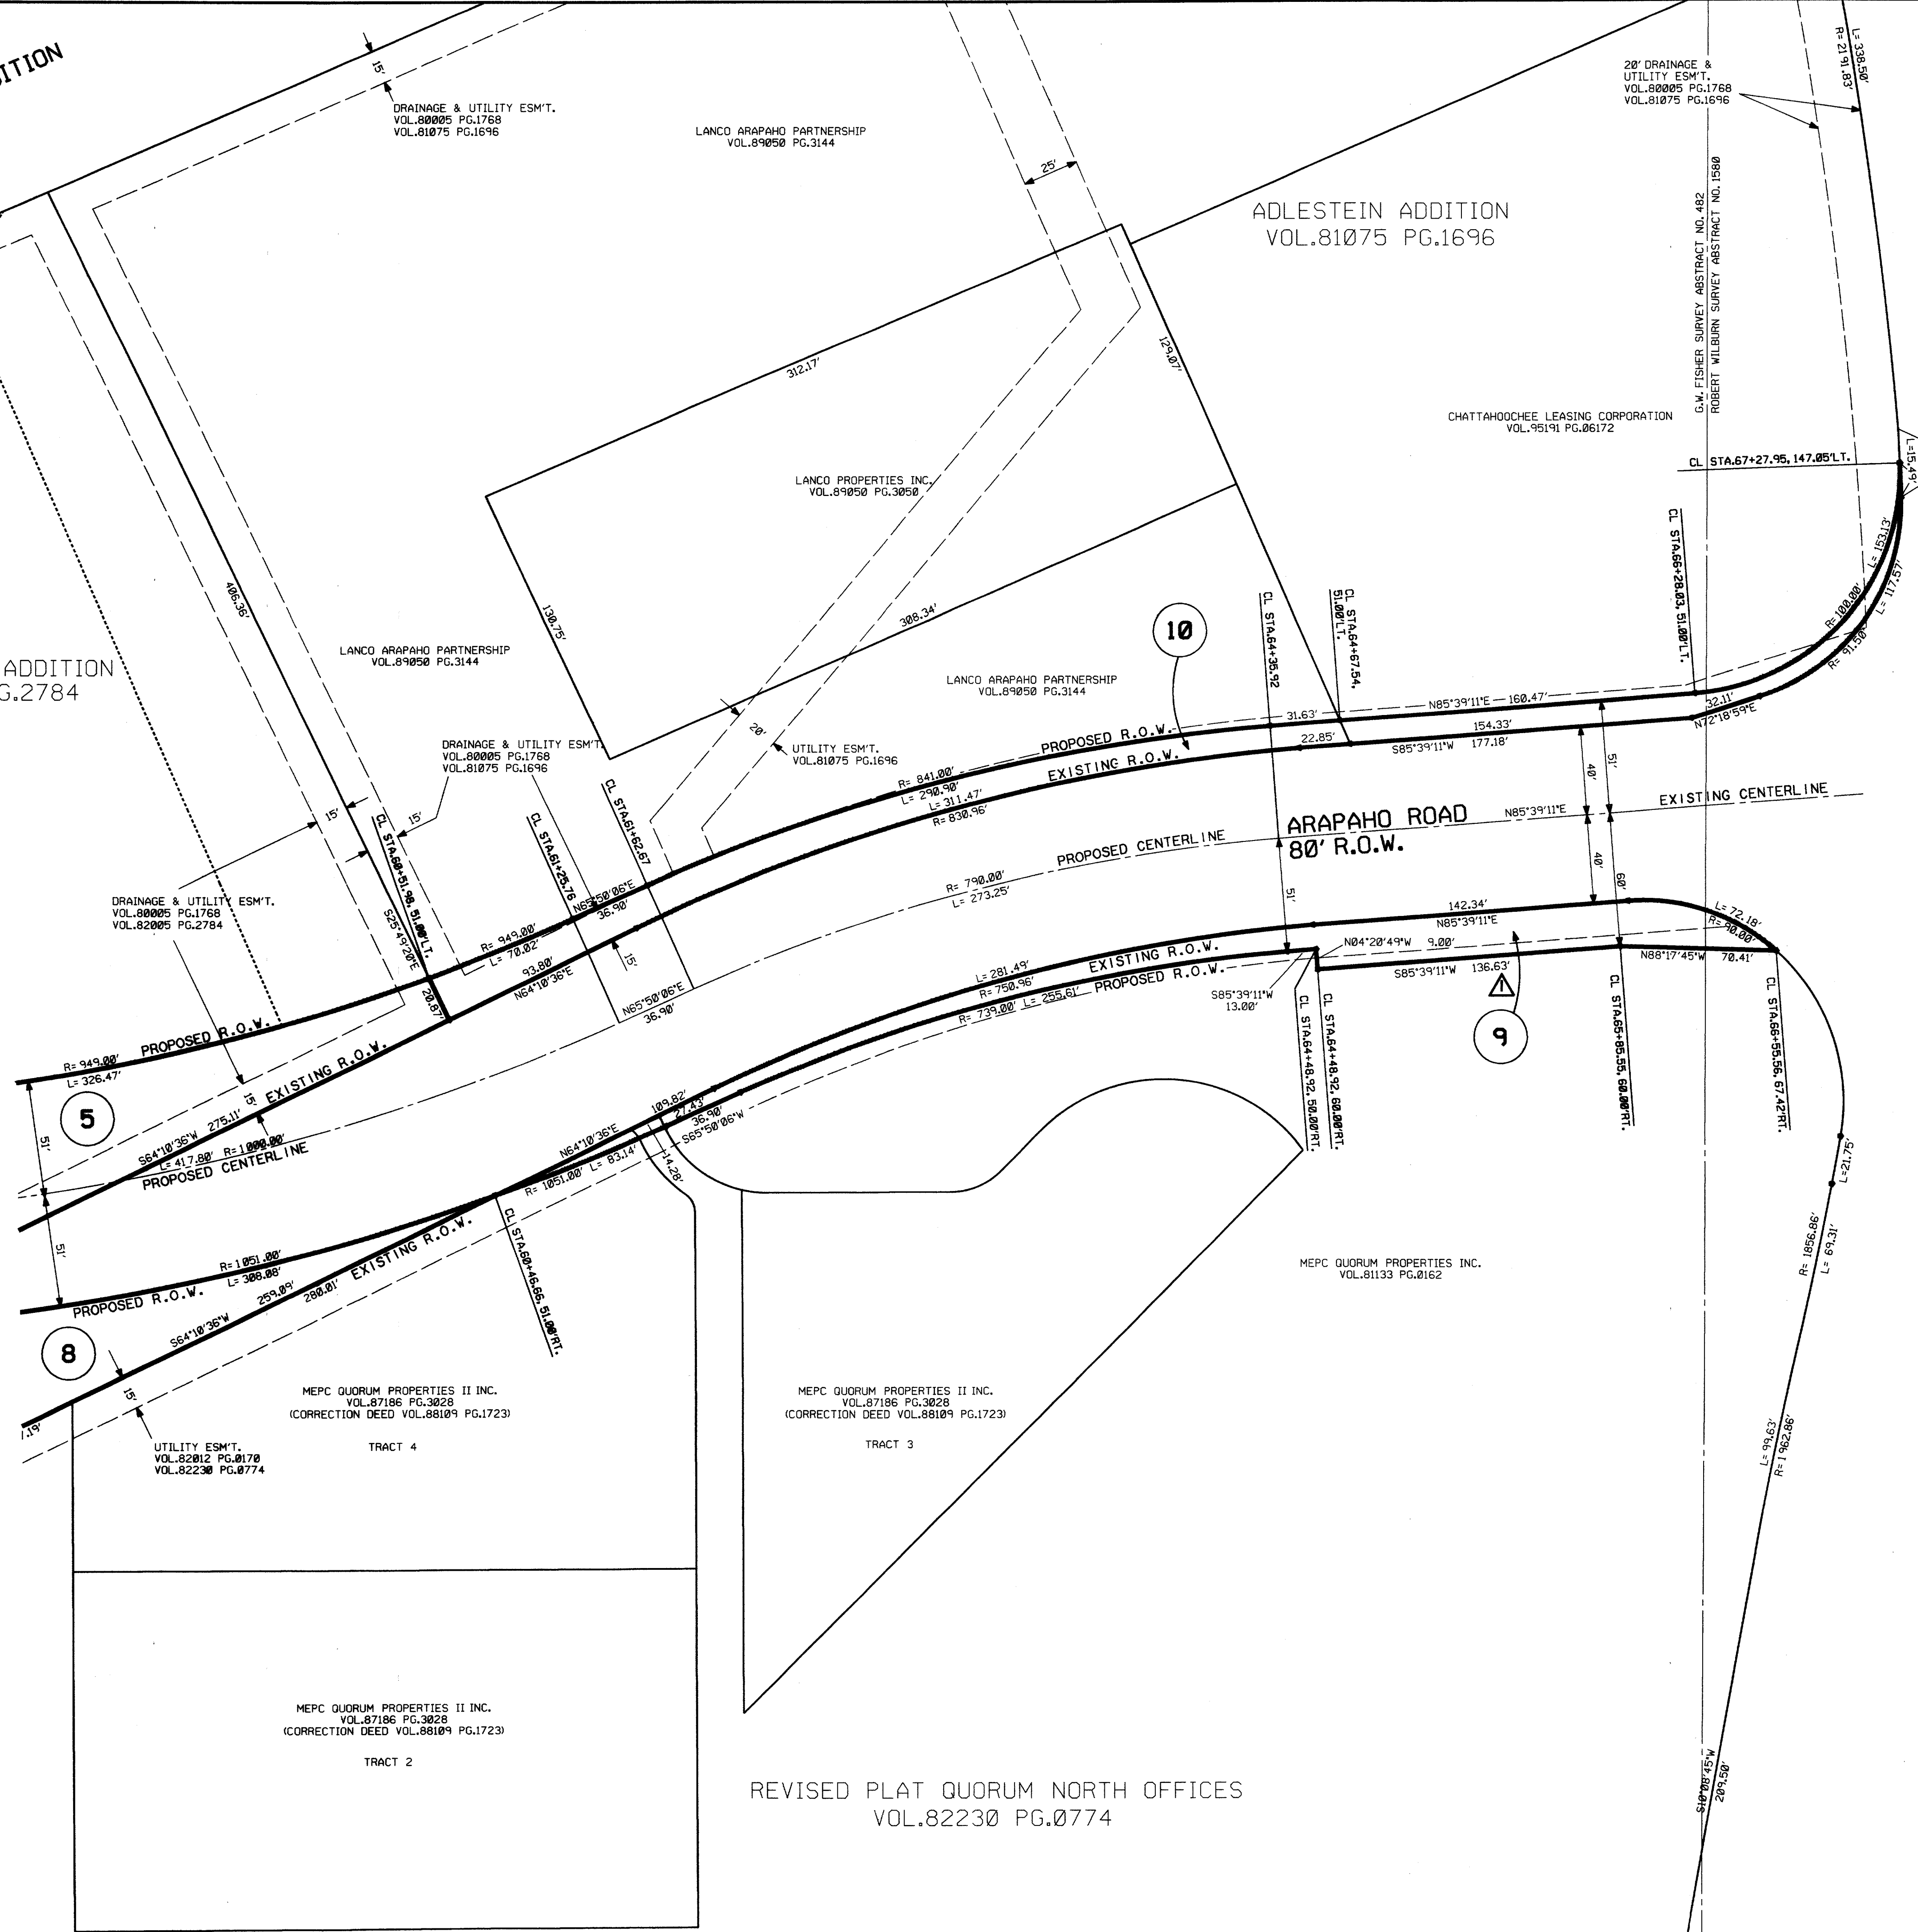

MEPC QUORUM PROPERTIES II INC.
VOL. 87186 PG. 3028
(CORRECTION DEED VOL. 88109 PG. 1723)

MEPC QUORUM PROPERTIES II INC.
VOL. 87186 PG. 3028
(CORRECTION DEED VOL. 88109 PG. 1723)

UTILITY ESMT.
VOL. 82012 PG. 0170
VOL. 82230 PG. 0774

MEPC QUORUM PROPERTIES II INC.
VOL. 87186 PG. 3028
(CORRECTION DEED VOL. 88109 PG. 1723)

REVISED PLAT QUORUM NORTH OFFICES
VOL. 82230 PG. 0774

RECORD DOCUMENTS 6/9/2000

THESE RECORD DOCUMENTS HAVE BEEN PREPARED BASED ON INFORMATION PROVIDED BY OTHERS. THE CONSULTANT HAS NOT VERIFIED THE ACCURACY AND/OR COMPLETENESS OF THIS INFORMATION AND SHALL NOT BE RESPONSIBLE FOR ANY ERRORS OR OMISSIONS THAT MAY BE INCORPORATED AS A RESULT OF ERRONEOUS INFORMATION PROVIDED BY OTHERS.



THE SEAL APPEARING ON THIS DOCUMENT WAS AUTHORIZED BY KENNETH A. ROBERTS, P.E. 55446 ON OCTOBER 24, 1997



REVISOR
3/16/98

RIGHT-OF-WAY MAP						
ARAPAHO ROAD						
ADDISON ROAD TO DALLAS NORTH TOLLWAY						
TOWN OF ADDISON, TEXAS						
Huitl-Zollars, Inc./Consulting Engineers Dallas, Fort Worth, Houston, Phoenix, Tustin						
DESIGN	DRAWN	APPR.	SCALE	DATE	PROJECT NO.	NO.
HZI	HZI	KAR	1"=40'	OCT 97	1772-01	R-3


AREA B-26 IS DRAINAGE AREA FOR EXISTING STORM SEWER IN ADDISON RD. AND CLARA ST. NORTH OF RAILROAD
 $t_c = 16.13$ MIN.
 $C = 0.90$
 $i_{100} = 7.4$ in/hr

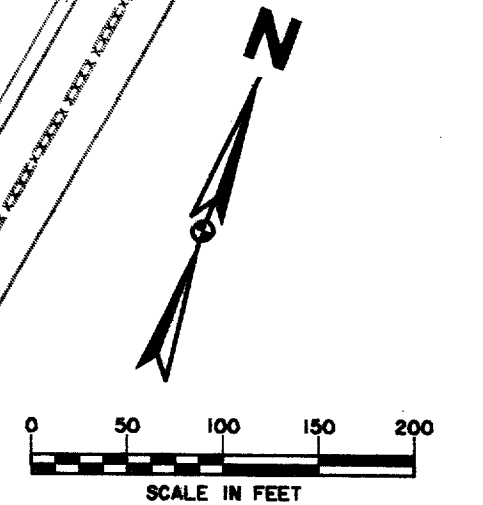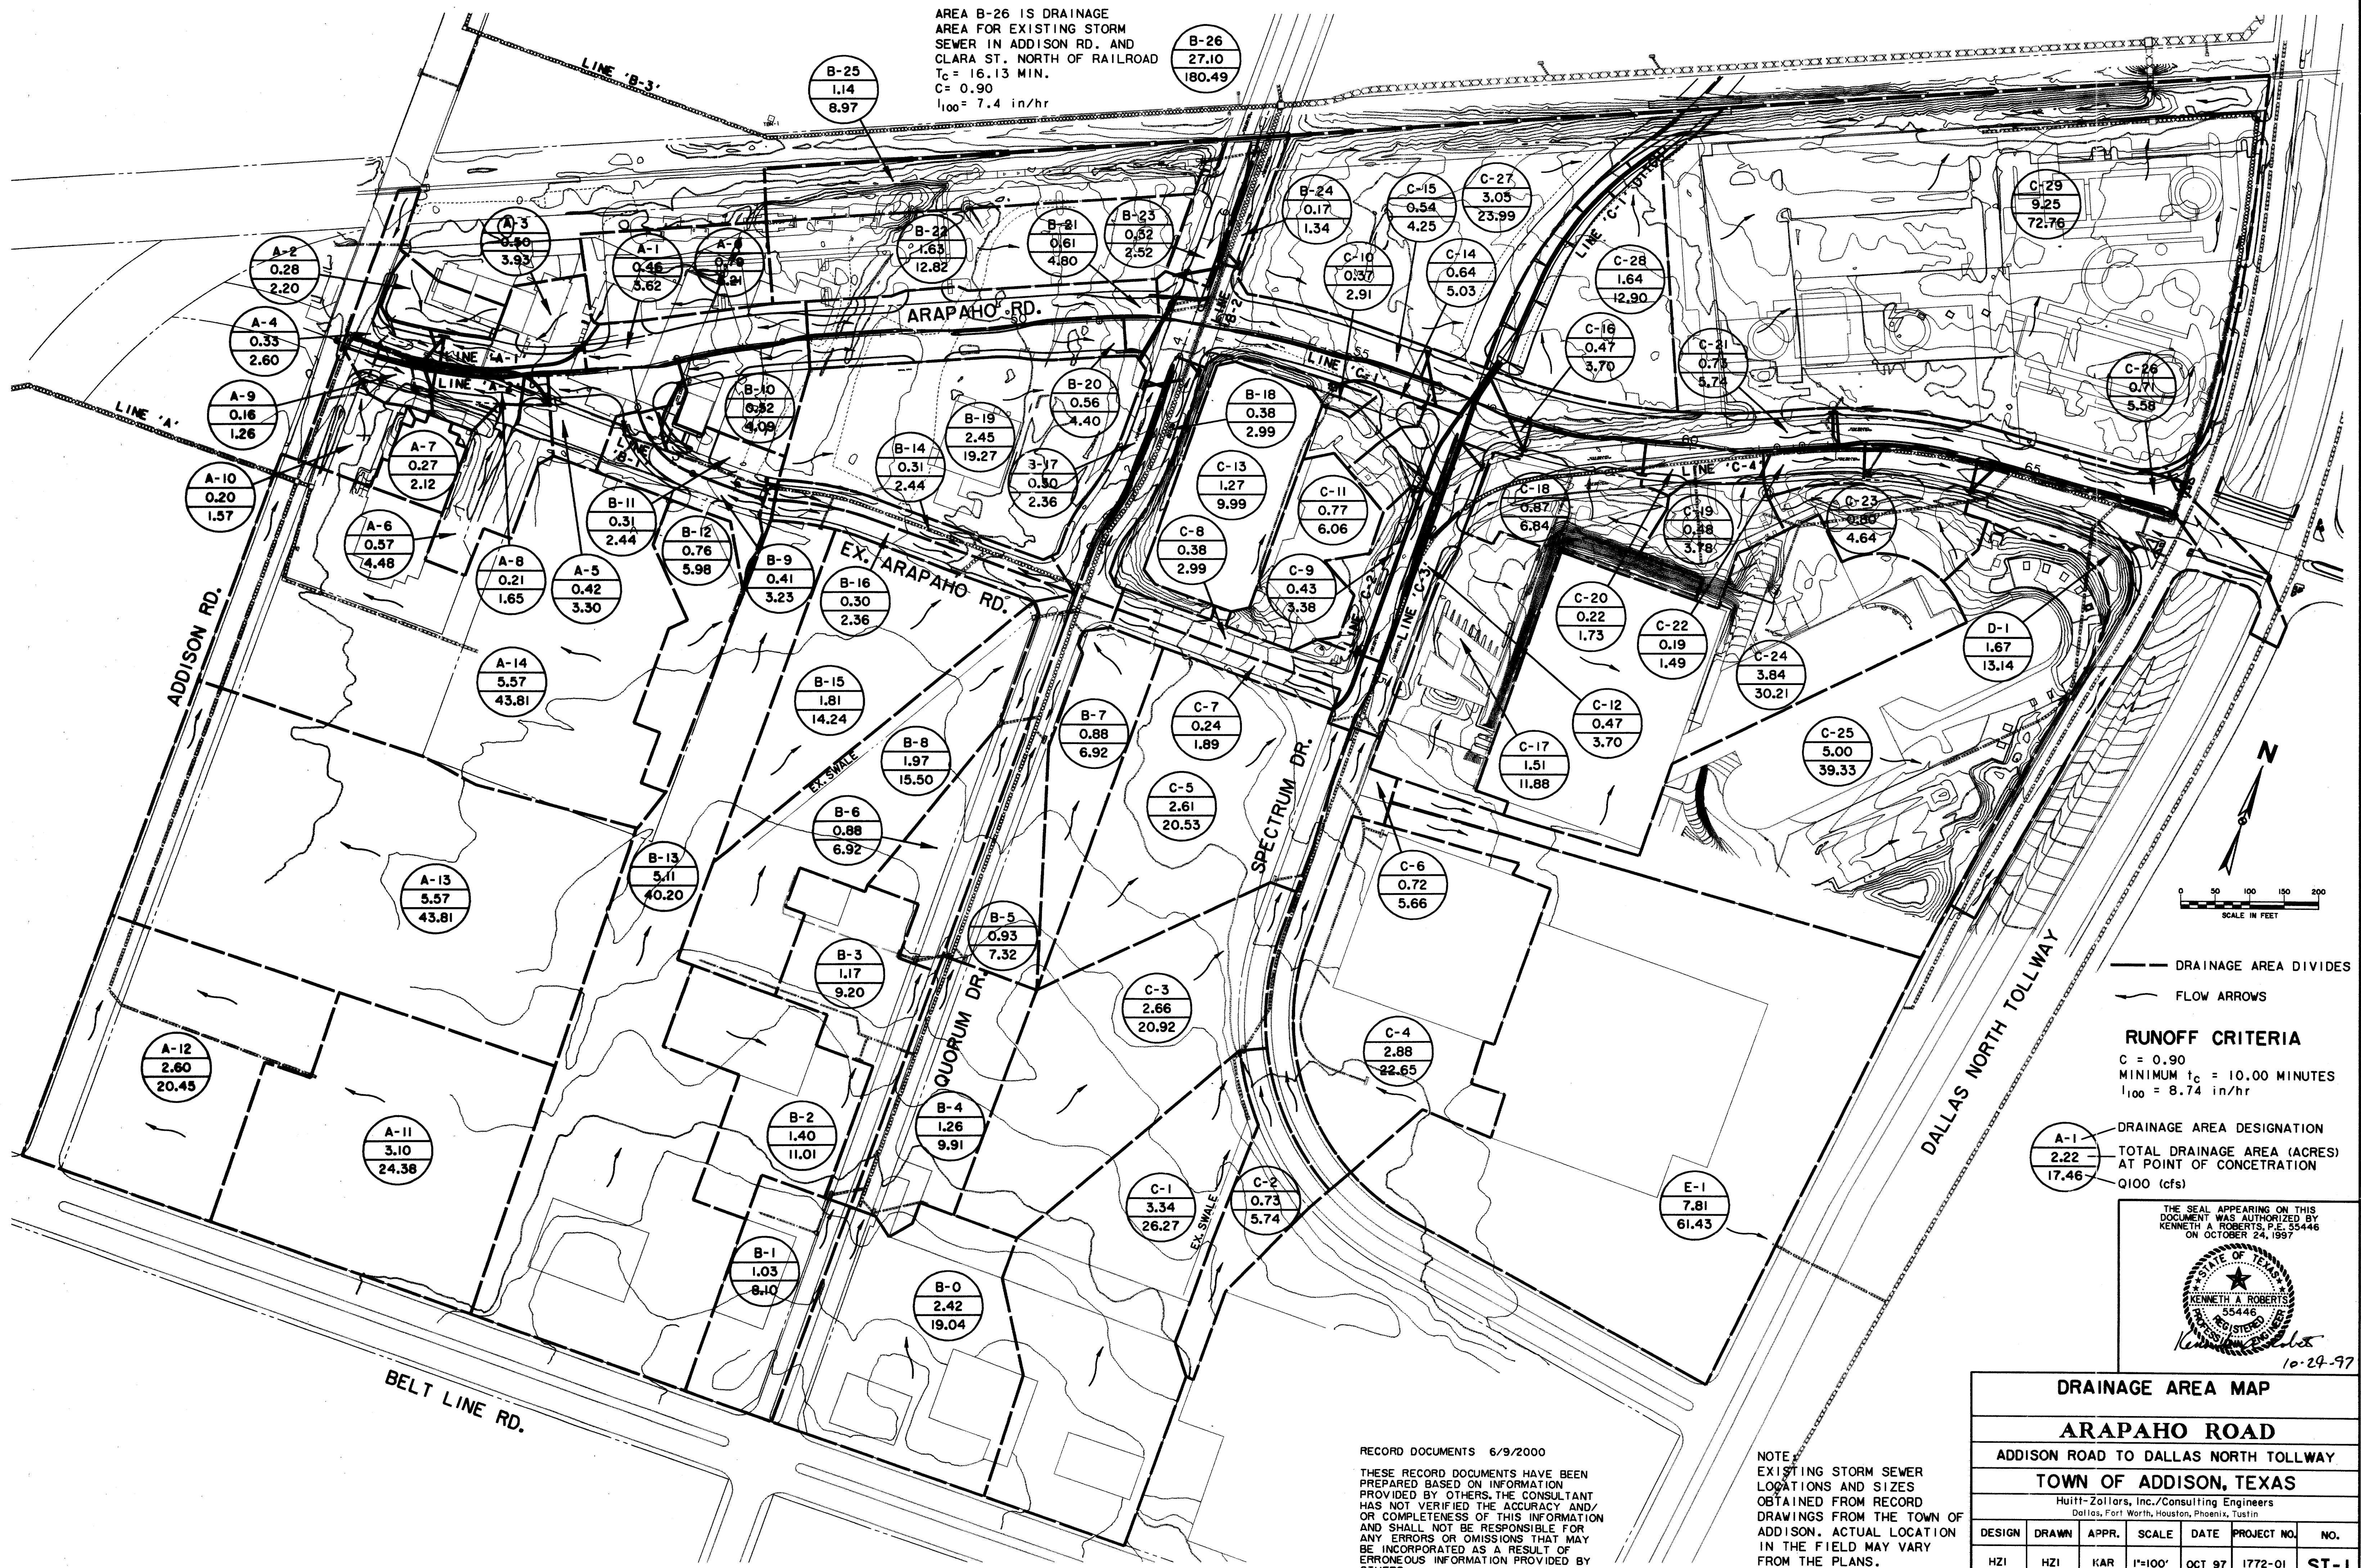

— DRAINAGE AREA DIVIDES
 — FLOW ARROWS

RUNOFF CRITERIA
 $C = 0.90$
 MINIMUM $t_c = 10.00$ MINUTES
 $i_{100} = 8.74$ in/hr

A-1
 2.22
 17.46
 DRAINAGE AREA DESIGNATION
 TOTAL DRAINAGE AREA (ACRES) AT POINT OF CONCENTRATION
 Q100 (cfs)

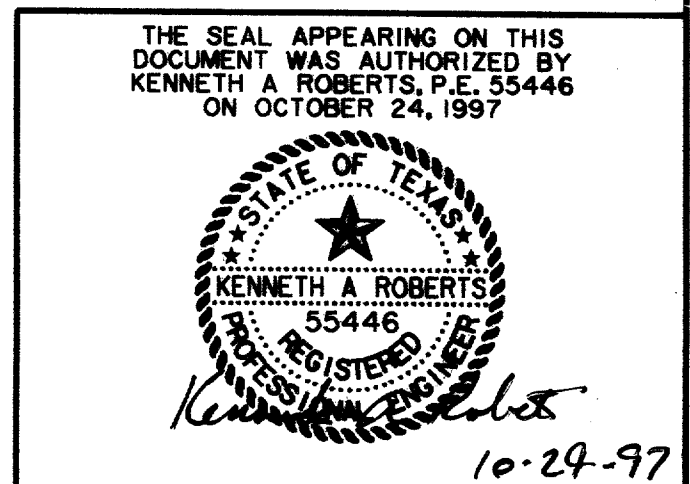

DRAINAGE AREA MAP						
ARAPAHO ROAD						
ADDISON ROAD TO DALLAS NORTH TOLLWAY						
TOWN OF ADDISON, TEXAS						
Huitt-Zollars, Inc./Consulting Engineers Dallas, Fort Worth, Houston, Phoenix, Tustin						
DESIGN	DRAWN	APPR.	SCALE	DATE	PROJECT NO.	NO.
HZI	HZI	KAR	1"=100'	OCT 97	1772-01	ST-1

RECORD DOCUMENTS 6/9/2000
 THESE RECORD DOCUMENTS HAVE BEEN PREPARED BASED ON INFORMATION PROVIDED BY OTHERS. THE CONSULTANT HAS NOT VERIFIED THE ACCURACY AND/OR COMPLETENESS OF THIS INFORMATION AND SHALL NOT BE RESPONSIBLE FOR ANY ERRORS OR OMISSIONS THAT MAY BE INCORPORATED AS A RESULT OF ERRONEOUS INFORMATION PROVIDED BY OTHERS.

NOTE:
 EXISTING STORM SEWER LOCATIONS AND SIZES OBTAINED FROM RECORD DRAWINGS FROM THE TOWN OF ADDISON. ACTUAL LOCATION IN THE FIELD MAY VARY FROM THE PLANS.

ARAPAHO ROAD
RUNOFF CALCULATIONS - SEPTEMBER 9, 1997

ARAPAHO ROAD
INLET CALCULATIONS - SEPTEMBER 9, 1997

AREA NO.	Tc (MIN.)	RUNOFF COEFF. "C"	INTENSITY "1-25" (IN./HR)	INTENSITY "1-100" (IN./HR)	AREA "A" (ACRES)	STORM RUNOFF "Q-25"	STORM RUNOFF "Q-100"
A-1	10.00	0.90	7.29	8.74	0.46	3.02	3.62
A-2	10.00	0.90	7.29	8.74	0.28	1.84	2.20
A-3	10.00	0.90	7.29	8.74	0.50	3.28	3.93
A-4	10.00	0.90	7.29	8.74	0.33	2.17	2.60
A-5	10.00	0.90	7.29	8.74	0.42	2.76	3.30
A-6	10.00	0.90	7.29	8.74	0.57	3.74	4.48
A-7	10.00	0.90	7.29	8.74	0.27	1.77	2.12
A-8	10.00	0.90	7.29	8.74	0.21	1.38	1.65
A-9	10.00	0.90	7.29	8.74	0.16	1.05	1.26
A-10	10.00	0.90	7.29	8.74	0.20	1.31	1.57
A-11	10.00	0.90	7.29	8.74	3.10	20.34	24.38
A-12	10.00	0.90	7.29	8.74	2.60	17.06	20.45
A-13	10.00	0.90	7.29	8.74	5.57	36.54	43.81
A-14	10.00	0.90	7.29	8.74	5.57	36.54	43.81
B-0	10.00	0.90	7.29	8.74	2.42	15.88	19.04
B-1	10.00	0.90	7.29	8.74	1.03	6.76	8.10
B-2	10.00	0.90	7.29	8.74	1.40	9.19	11.01
B-3	10.00	0.90	7.29	8.74	1.17	7.68	9.20
B-5	10.00	0.90	7.29	8.74	0.93	6.10	7.32
B-6	10.00	0.90	7.29	8.74	0.88	5.77	6.92
B-7	10.00	0.90	7.29	8.74	0.88	5.77	6.92
B-8	10.00	0.90	7.29	8.74	1.97	12.93	15.50
B-9	10.00	0.90	7.29	8.74	0.41	2.69	3.23
B-10	10.00	0.90	7.29	8.74	0.52	3.41	4.09
B-11	10.00	0.90	7.29	8.74	0.31	2.03	2.44
B-12	10.00	0.90	7.29	8.74	0.76	4.99	5.98
B-13	10.00	0.90	7.29	8.74	5.11	33.53	40.20
B-14	10.00	0.90	7.29	8.74	0.31	2.03	2.44
B-15	10.00	0.90	7.29	8.74	1.81	11.88	14.24
B-16	10.00	0.90	7.29	8.74	0.30	1.97	2.36
B-17	10.00	0.90	7.29	8.74	0.30	1.97	2.36
B-18	10.00	0.90	7.29	8.74	0.38	2.49	2.99
B-19	10.00	0.90	7.29	8.74	2.45	16.07	19.27
B-20	10.00	0.90	7.29	8.74	0.56	3.67	4.40
B-21	10.00	0.90	7.29	8.74	0.61	4.00	4.80
B-22	10.00	0.90	7.29	8.74	1.63	10.69	12.82
B-23	10.00	0.90	7.29	8.74	0.32	2.10	2.52
B-24	10.00	0.90	7.29	8.74	0.17	1.12	1.34
B-25	10.00	0.90	7.29	8.74	1.14	7.48	8.97
B-26	16.13	0.90	6.10	7.40	27.10	148.78	180.49
C-1	10.00	0.90	7.29	8.74	3.34	21.91	26.27
C-2	10.00	0.90	7.29	8.74	0.73	4.79	5.74
C-3	10.00	0.90	7.29	8.74	2.66	17.45	20.92
C-4	10.00	0.90	7.29	8.74	2.88	18.90	22.65
C-5	10.00	0.90	7.29	8.74	2.61	17.12	20.53
C-6	10.00	0.90	7.29	8.74	0.72	4.72	5.66
C-7	10.00	0.90	7.29	8.74	0.24	1.57	1.89
C-8	10.00	0.90	7.29	8.74	0.38	2.49	2.99
C-9	10.00	0.90	7.29	8.74	0.43	2.82	3.38
C-10	10.00	0.90	7.29	8.74	0.37	2.43	2.91
C-11	10.00	0.90	7.29	8.74	0.77	5.05	6.06
C-12	10.00	0.90	7.29	8.74	0.47	3.08	3.70
C-13	10.00	0.90	7.29	8.74	1.27	8.33	9.99
C-14	10.00	0.90	7.29	8.74	0.64	4.20	5.03
C-15	10.00	0.90	7.29	8.74	0.54	3.54	4.25
C-16	10.00	0.90	7.29	8.74	0.47	3.08	3.70
C-17	10.00	0.90	7.29	8.74	1.51	9.91	11.88
C-18	10.00	0.90	7.29	8.74	0.87	5.71	6.84
C-19	10.00	0.90	7.29	8.74	0.48	3.15	3.78
C-20	10.00	0.90	7.29	8.74	0.22	1.44	1.73
C-21	10.00	0.90	7.29	8.74	0.73	4.79	5.74
C-22	10.00	0.90	7.29	8.74	0.19	1.25	1.49
C-23	10.00	0.90	7.29	8.74	0.80	5.25	6.29
C-24	10.00	0.90	7.29	8.74	3.84	25.19	30.21
C-25	10.00	0.90	7.29	8.74	5.00	32.81	39.33
C-26	10.00	0.90	7.29	8.74	0.71	4.66	5.58
C-27	10.00	0.90	7.29	8.74	3.05	20.01	23.99
C-28	10.00	0.90	7.29	8.74	1.64	10.76	12.90
C-29	10.00	0.90	7.29	8.74	9.25	60.69	72.76
D-1	10.00	0.90	7.29	8.74	1.67	10.96	13.14
E-1	10.00	0.90	7.29	8.74	7.81	51.24	61.43
B-27	10.00	0.90	7.29	8.74	2.00	13.12	15.73
B-28	10.00	0.90	7.29	8.74	1.76	11.55	13.84
B-29	10.00	0.90	7.29	8.74	0.98	6.43	7.71
B-30	10.00	0.90	7.29	8.74	1.04	6.82	8.18
B-31	10.00	0.90	7.29	8.74	1.94	12.73	15.26
B-32	10.00	0.90	7.29	8.74	1.23	8.07	9.68
B-33	10.00	0.90	7.29	8.74	1.66	10.89	13.06
B-34	10.00	0.90	7.29	8.74	0.11	0.72	0.87
B-35	10.00	0.90	7.29	8.74	0.21	1.38	1.65
B-36	10.00	0.90	7.29	8.74	2.74	17.98	21.55
B-37	10.00	0.90	7.29	8.74	0.66	4.33	5.19
B-38	10.00	0.90	7.29	8.74	2.86	18.76	22.50
B-39	10.00	0.90	7.29	8.74	0.40	2.62	3.15
B-40	10.00	0.90	7.29	8.74	1.16	7.61	9.12
B-41	10.00	0.90	7.29	8.74	4.53	29.72	35.63
B-42	10.00	0.90	7.29	8.74	3.82	25.06	30.05

LINE	INLET NO.	INLET LOCATION	DESIGN STORM FREQUENCY (YRS)	TIME OF CONC. "Tc" (MIN.)	AREA RUNOFF INTENSITY "1-100" (INCHES/ HOUR)	COEFF. "C"	AREA NO.	AREA "A" (ACRES)	"Q-100" FOR AREA (CFS)	CARRY-OVER FROM UPSTREAM (CFS)	TOTAL GUTTER FLOW (CFS)	GUTTER CAPACITY ONE DRY LANE (CFS)	DEPTH OF FLOW ONE DRY LANE (FT)	GUTTER SLOPE (FT/FT)	STREET CROSS SLOPE (FT/FT)	ACTUAL DEPTH OF FLOW (FT.)	CAPACITY PER FOOT OF INLET (CFS)	REQUIRED LENGTH OF INLET (FT.)	SELECTED LENGTH OF INLET (FT.)	TYPE OF INLET	GUTTER FLOW PICKED UP (CFS)	CARRY-OVER TO DOWNSTREAM (CFS)
LINE "A" - PROPOSED ARAPAHO ROAD AT ADDISON ROAD																						
A-0	DART		100	10.00	8.74	0.90	A-0	0.79	6.21	0.00	6.21	NA	NA	NA	NA	NA	NA	NA	8	STD-SAG	6.21	0.00
A-1	43+60 LT. A		100	10.00	8.74	0.90	A-1	0.46	3.62	0.00	3.62	4.00	0.27	0.0050	0.0182	0.26	0.55	6.53	10	REC-GR	3.62	0.00
A-2	41+31.48 LT. A		100	10.00	8.74	0.90	A-2	0.28	2.20	0.00	2.20	9.21	0.45	0.0050	0.0300	0.26	1.37	1.61	6	STD-SAG	2.20	0.00
A-3	41+54 LT. A		100	10.00	8.74	0.90	A-3&4	0.83	6.53	0.00	6.53	38.39	0.64	0.0050	0.0182	0.33	1.60	4.08	14	REC-SAG	6.53	0.00
A-5	43+10 RT. A		100	10.00	8.74	0.90	A-5	0.42	3.30	0.00	3.30	5.00	0.31	0.0050	0.0208	0.27	0.56	5.92	10	REC-GR	3.30	0.00
A-6	42+69.87 RT. A		100	10.00	8.74	0.90	A-6	0.59	4.64	0.00	4.64	7.74	0.31	0.0120	0.0208	0.26	0.55	8.46	10	REC-GR	4.64	0.00
A-7	QUORUM CENTER		100	10.00	8.74	0.90	A-7	0.27	2.12	0.00	2.12	NA	NA	NA	NA	NA	NA	NA	SUMP	EX SAG	2.12	0.00
A-8	41+50 RT. A		100	10.00	8.74	0.90	A-8&9	0.37	2.91	0.00	2.91	5.00	0.31	0.0050	0.0208	0.25	1.34	2.17	14	REC-SAG	2.91	0.00
LINE "A" - EXISTING ADDISON ROAD SOUTH OF PROPOSED ARAPAHO ROAD																						
A-10	QUORUM CENTER		100	10.00	8.74	0.90	A-10	0.20	1.57	0.00	1.57	NA	NA	NA	NA	NA	NA	NA	5	EX STD-SAG	1.57	0.00
LINE "B" - EXISTING QUORUM DRIVE SOUTH OF EXISTING ARAPAHO																						
B-0	9+40 LT. Q		100	10.00	8.74	0.90	B-0	2.42	19.04	0.00	19.04	6.47	0.27	0.0180	0.0208	0.40	0.69	27.51	10&10	REC-GR/SAG	19.04	0.00
B-1	9+40 RT. Q		100	10.00	8.74	0.90	B-1	1.03	8.10	0.00	8.10	6.47	0.27	0.0180	0.0208	0.29	0.58	13.89	10&10	REC-GR/SAG	8.10	0.00
B-2	7+40 RT.		100	10.00	8.74	0.90	B-2	1.40	11.01	0.00	11.01	NA	NA	NA	NA	NA	NA	NA	10	EX STD-SAG	11.01	0.00
B-3	5+82.50 RT. Q		100	10.00	8.74	0.90	B-3	1.17	9.20	0.00	9.20	6.47	0.27	0.0180	0.0208	0.31	0.60	15.42	10&10	REC-GR/SAG	9.20	0.00
B-4	5+50 LT. Q		100	10.00	8.74	0.90	B-4	1.26	9.91	0.00	9.91	6.47	0.27	0.0180	0.0208	0.32	0.61	16.38	10	EX REC-GR	6.10	3.81
B-5	2+13 LT. Q		100	10.00	8.74	0.90	B-5	0.93	7.32	3.81	11.13	3.41	0.27	0.0050	0.0208	0.42	1.95	5.70	10	EX REC-SAG	11.13	0.00
B-6	2+11 RT. Q		100	10.00	8.74	0.90	B-6	0.88	6.92	0.00	6.92	3.41	0.27	0.0050	0.0208	0.35	1.69	4.10	10	EX REC-SAG	6.92	0.00
B-7	0+50 LT. Q		100	10.00	8.74	0.90	B-7	0.88	6.92	0.00	6.92	NA	NA	NA	NA	NA	NA	NA	12	EX DROP-SAG	6.92	0.00
B-8	0+50 RT. Q		100	10.00	8.74	0.90	B-8	1.97	15.50	0.00	15.50	NA	NA	NA	NA	NA	NA	NA	12	EX DROP-SAG	15.50	0.00
LINE "B" - EXISTING ARAPAHO ROAD AT PROPOSED ARAPAHO ROAD																						
B-9	4+21 RT. EA		100	10.00	8.74	0.90	B-9	0.41	3.23	0.00	3.23	3.92	0.38	0.0068	PARABOLIC	0.35	0.64	5.05	6	REC-GR	3.23	0.00
B-10	44+98 RT. A		100	10.00	8.74	0.90	B-10	0.52	4.09	0.00	4.09	5.00	0.31	0.0050	0.0208	0.29	0.58	7.07	8	REC-GR	4.09	0.00
B-11	4+27 LT. EA		100	10.00	8.74	0.90	B-11	0.31	2.44	0.00	2.44	3.59	0.38	0.0057	PARABOLIC	0.34	0.63	3.88	6	REC-GR	2.44	0.00
LINE "B" - EXISTING ARAPAHO ROAD WEST OF QUORUM DRIVE																						
B-12	SUMMERFIELD		100	10.00	8.74	0.90	B-12	0.76	5.98	0.00	5.98	NA	NA	NA	NA	NA	NA	NA	5	EX STD-SAG	5.98	0.00
B-13	7+20 RT. EA		100	10.00	8.74	0.90	B-13	5.11	40.20	0.00	40.20	NA	NA	NA	NA	NA	NA	NA	12	EX DROP-SAG	40.20	0.00
B-14	9+58 LT. EA		100	10.00	8.74	0.90	B-14	0.31	2.44	0.00	2.44	3.36	0.38	0.0050	PARABOLIC	0.34	1.63	1.50	10	EX REC-SAG	2.44	

ARAPAHO ROAD
STORMWATER PIPE CALCULATIONS - SEPTEMBER 16, 1997


COLLECTION POINT UPSTREAM STATION	COLLECTION POINT DOWNSTREAM STATION	DISTANCE BETWEEN COLLECTION POINTS	AREA NO.	AREA A (ACRES)	INCREMENTAL RUNOFF COEFF. C	DRAINAGE AREA INCREM. CA	ACCUM. CA	TIME @ UPSTREAM STATION (MIN.)	DESIGN STORM FREQUENCY (YEAR)	RAINFALL INTENSITY I (IN./HR)	STORM WATER RUNOFF Q (CFS)	SLOPE OF HYDRAULIC GRADIENT S (FT/FT)	PIPE SIZE (INCHES)	VELOCITY IN STORM SEWER V (FPS)	HEAD LOSS COEFF. KJ	HEAD LOSS AT UPSTREAM WYE STATION (FT)	FLOW TIME IN PIPE (MIN)	TIME @ DOWNSTREAM STATION (MIN)	DESIGN Q (CFS)	VELOCITY HEAD Hv (FT)	H.G. AT UPSTREAM STATION (FT)	H.G. AT DOWNSTREAM STATION (FT)	REMARKS
LINE "A" EXISTING ADDISON ROAD SOUTH OF ARAPAHO ROAD - 100 YEAR DESIGN																							
1200.00	1030.00	170.00	A-11	3.10	0.90	2.79	2.79	10.00	100	8.74	24.38	0.0062	27	6.13	1.25	0.58	0.46	10.46	24.38	0.58	637.98	636.93	FUTURE PIPE
1030.00	850.00	180.00				2.79	2.79	10.46	100	8.74	24.38	0.0062	27	6.13	0.50	0.29	0.49	10.95	24.38	0.58	636.64	635.52	FUTURE PIPE
850.00	540.00	310.00	A-12	2.60	0.90	2.34	5.13	10.95	100	8.50	43.61	0.0113	30	8.88	0.60	0.88	0.58	11.53	43.61	1.23	634.65	631.14	EX 30" RCP
540.00	440.00	100.00				5.13	5.13	11.53	100	8.50	43.61	0.0019	42	4.53	0.60	-0.42	0.37	11.90	43.61	0.32	631.56	631.37	EX 42" RCP
440.00	300.00	140.00	A-13	5.57	0.90	5.01	10.14	11.90	100	8.25	83.68	0.0069	42	8.70	0.60	0.98	0.27	12.17	83.68	1.17	630.39	629.42	EX 42" RCP
300.00	0.00	300.00	A-14	5.57	0.90	5.01	15.16	12.17	100	8.20	124.28	0.0075	48	9.89	0.60	0.81	0.51	12.67	124.28	1.52	628.61	626.36	EX 48" RCP AT JUNCT. BOX
LINE "A" EXISTING ADDISON ROAD SOUTH OF ARAPAHO ROAD - 25 YEAR DESIGN																							
1200.00	1030.00	170.00	A-11	3.10	0.90	2.79	2.79	10.00	25	7.29	20.34	0.0043	27	5.12	1.25	0.41	0.55	10.55	20.34	0.41	633.10	632.36	FUTURE PIPE
1030.00	850.00	180.00				2.79	2.79	10.55	25	7.29	20.34	0.0043	27	5.12	0.50	0.20	0.59	11.14	20.34	0.41	632.16	631.38	FUTURE PIPE
850.00	540.00	310.00	A-12	2.60	0.90	2.34	5.13	11.14	25	7.00	35.91	0.0077	30	7.32	0.60	0.59	0.71	11.85	35.91	0.83	630.80	628.42	EX 30" RCP
540.00	440.00	100.00				5.13	5.13	11.85	25	7.00	35.91	0.0013	42	3.73	0.60	-0.28	0.45	12.29	35.91	0.22	628.70	628.58	EX 42" RCP
440.00	300.00	140.00	A-13	5.57	0.90	5.01	10.14	12.29	25	6.75	68.47	0.0046	42	7.12	0.60	0.66	0.33	12.62	68.47	0.79	627.92	627.27	EX 42" RCP
300.00	0.00	300.00	A-14	5.57	0.90	5.01	15.16	12.62	25	6.70	101.55	0.0050	48	8.08	0.60	0.54	0.62	13.24	101.55	1.01	626.73	625.23	EX 48" RCP AT JUNCT. BOX
LINE "A" EXISTING OUTFALL WEST OF ADDISON ROAD - 100 YEAR DESIGN																							
1981.00	1757.00	224.00	A-10	0.20	0.90	0.18	3.77	12.07	100	8.20	30.92	0.0057	30	6.30	0.50	0.31	0.59	12.66	30.92	0.62	627.91	626.64	EX 30" RCP AT JUNCT. BOX
1757.00	1347.00	410.00	A-11-14	16.84	0.90	15.16	18.93	12.67	100	8.10	153.31	0.0035	60	7.81	0.50	0.47	0.88	13.55	153.31	0.95	626.17	624.75	EX 60" OUTFALL AT JUNCT BOX
1347.00	1037.00	310.00				18.93	18.93	13.55	100	8.10	153.31	0.0035	60	7.81	0.25	0.24	0.66	14.21	153.31	0.95	624.51	623.44	EX 60" OUTFALL WEST
1037.00	1007.00	30.00				18.93	18.93	14.21	100	8.10	153.31	0.0035	60	7.81	0.35	0.33	0.06	14.27	153.31	0.95	623.10	623.00	EX 60" OUTFALL WEST
LINE "A" EXISTING OUTFALL WEST OF ADDISON ROAD - 25 YEAR DESIGN																							
1981.00	1757.00	224.00	A-10	0.20	0.90	0.18	3.77	12.50	25	6.75	25.45	0.0038	30	5.18	0.50	0.21	0.72	13.22	25.45	0.42	626.28	625.42	EX 30" RCP AT JUNCT. BOX
1757.00	1347.00	410.00	A-11-14	16.84	0.90	15.16	18.93	13.24	25	6.60	124.92	0.0023	60	6.36	0.50	0.31	1.07	14.31	124.92	0.63	625.10	624.16	EX 60" OUTFALL AT JUNCT BOX
1347.00	1037.00	310.00				18.93	18.93	14.31	25	6.60	124.92	0.0023	60	6.36	0.25	0.16	0.81	15.13	124.92	0.63	624.00	623.29	EX 60" OUTFALL WEST
1037.00	1007.00	30.00				18.93	18.93	15.13	25	6.60	124.92	0.0023	60	6.36	0.35	0.22	0.08	15.20	124.92	0.63	623.07	623.00	EX 60" OUTFALL WEST
LINE "A-1" NORTH - ARAPAHO ROAD AT ADDISON ROAD - 100 YEAR DESIGN																							
2389.32	2322.32	67.00	A-0	0.79	0.90	0.71	0.71	10.00	100	8.74	6.21	0.0035	18	3.51	1.25	0.24	0.32	10.32	6.21	0.19	629.73	629.50	FUTURE BY DART
2322.32	2202.26	120.06	A-1	0.46	0.90	0.41	1.13	10.32	100	8.65	9.73	0.0018	24	3.10	0.50	0.15	0.65	10.96	9.73	0.15	629.35	629.13	FUTURE BY DART
2202.26	2093.66	108.60				1.13	1.13	10.96	100	8.65	9.73	0.0015	24	2.76	1.00	-0.03	0.66	11.62	8.68	0.12	629.16	629.00	PIPE EQUALIZER
2093.66	2071.00	22.66	A-2-4	1.11	0.90	1.00	2.12	11.62	100	8.35	17.74	0.0044	24	4.77	0.60	0.28	0.08	11.70	15.00	0.35	628.72	628.62	LAT A-3
2071.00	1981.00	90.00				2.12	2.12	11.70	100	8.35	17.74	0.0044	24	4.77	1.00	0.00	0.31	12.01	15.00	0.35	628.62	628.22	PIPE EQUALIZER
LINE "A-1" NORTH - ARAPAHO ROAD AT ADDISON ROAD - 25 YEAR DESIGN																							
2389.32	2322.32	67.00	A-0	0.79	0.90	0.71	0.71	10.00	25	7.29	5.18	0.0024	18	2.93	1.25	0.17	0.38	10.38	5.18	0.13	627.60	627.44	FUTURE BY DART
2322.32	2202.26	120.06	A-1	0.46	0.90	0.41	1.13	10.38	25	7.15	8.04	0.0013	24	2.56	0.50	0.10	0.78	11.16	8.04	0.10	627.33	627.18	FUTURE BY DART
2202.26	2093.66	108.60				1.13	1.13	11.16	25	7.15	8.04	0.0010	24	2.28	1.00	-0.02	0.79	11.96	7.16	0.08	627.09	627.09	PIPE EQUALIZER
2093.66	2071.00	22.66	A-2-4	1.11	0.90	1.00	2.12	11.96	25	6.80	14.44	0.0029	24	3.89	0.60	0.19	0.10	12.05	12.21	0.23	626.91	626.84	LAT A-3
2071.00	1981.00	90.00				2.12	2.12	12.05	25	6.80	14.44	0.0029	24	3.89	1.00	0.00	0.39	12.44	12.21	0.23	626.84	626.58	PIPE EQUALIZER
LINE "A-2" SOUTH - ARAPAHO ROAD AT ADDISON ROAD - 100 YEAR DESIGN																							
2288.63	2241.29	47.34	A-5	0.42	0.90	0.38	0.38	10.00	100	8.74	3.30	0.0002	24	1.05	1.25	0.02	0.75	10.75	3.30	0.02	629.43	629.42	LAT A-6
2241.29	2204.06	37.23	A-6	0.57	0.90	0.51	0.89	10.75	100	8.55	7.62	0.0011	24	2.43	0.60	0.05	0.26	11.01	7.62	0.09	629.37	629.32	PIPE EQUALIZER
2204.06	2092.00	112.06				0.89	0.89	11.01	100	8.55	7.62	0.0015	24	2.76	1.00	0.03	0.68	11.68	8.67	0.12	629.30	629.13	PIPE EQUALIZER
2092.00	2074.00	18.00	A-8 & 9	0.37	0.90	0.33	1.22	11.68	100	8.35	10.22	0.0044	24	4.77	0.60	0.28	0.06	11.75	14.99	0.35	628.85	628.77	LAT A-8
2074.00	2071.00	3.00	A-7	0.27	0.90	0.24	1.47	11.68	100	8.35	12.25	0.0044	24	4.77	0.60	0.14	0.01	11.76	14.99	0.35	628.63	628.62	PIPE EQUALIZER
2071.00	1981.00	90.00				1.47	1.47	11.76	100	8.35	12.25	0.0044	24	4.77	1.00	0.00	0.31	12.07	14.99	0.35	628.62	628.22	PIPE EQUALIZER
LINE "A-2" SOUTH - ARAPAHO ROAD AT ADDISON ROAD - 25 YEAR DESIGN																							
2288.63	2241.29	47.34	A-5	0.42	0.90	0.38	0.38	10.00	25	7.29	2.76	0.0001	24	0.88	1.25	0.01	0.90	10.90	2.76	0.01	627.39	627.38	LAT A-6
2241.29	2204.06	37.23	A-6	0.57	0.90	0.51	0.89	10.90	25	7.05	6.28	0.0008	24	2.00	0.60	0.04	0.31	11.21	6.28	0.06	627.34	627.31	LAT A-6
2204.06	2092.00	112.06				0.89	0.89	11.21	25	7.05	6.28	0.0010	24	2.28	1.00	0.02	0.82	12.03	7.16	0.08	627.30	627.18	PIPE EQUALIZER
2092.00	2074.00	18.00	A-8 & 9	0.37	0.90	0.33	1.22	12.03	25	6.80	8.32	0.0029	24	3.89	0.60	0.19	0.08	12.11	12.21	0.23	627.00	626.94	LAT A-8
2074.00	2071.00	3.00	A-7	0.27	0.90	0.24	1.47	12.11	25	6.80	9.98	0.0029	24	3.89	0.60	0.09	0.01	12.12	12.21	0.23	626.85	626.84	PIPE EQUALIZER
2071.00	1981.00	90.00				1.47	1.47	12.12	25	6.80	9.98	0.0029	24	3.89	1.00	0.00	0.39	12.50	12.21	0.23	626.84	626.58	PIPE EQUALIZER
LAT "A-2"																							
23.82	0.00	23.82	A-2	0.28	0.90	0.25	0.25	10.00	100	8.74	2.20	0.0004	18	1.24	1.25	0.03	0.32	10.32	2.20	0.02	629.22	629.21	LAT A-2
LAT "A-3"																							
42.36	24.24	18.12	A-3 & 4	0.83	0.90	0.75	0.75	10.00	100	8.74	6.53	0.0017	21	2.71	1.25	0.14	0.11	10.11	6.53	0.11	629.19	629.16	LAT A-2
24.24	0.00	24.24	A-2	0.28	0.90	0.25	1.00	10.11	100	8.70	8.69	0.0030	21	3.61	0.60	0.13	0.11	10.22	8.69	0.20	629.02	628.95	LAT A-2
LAT "A-6"																							
60.48	0.00	60.48	A-6	0.59	0.90	0.57	0.57	10.00	100	8.74	4.98	0.0022	18	2.82	1.25	0.15	0.36	10.36	4.98	0.12	629.53	629.39	LAT A-6
LAT "A-8"																							
42.12	0.00	42.12	A-8 & 9	0.37	0.90	0.33	0.33	10.00	100	8.74	2.91	0.0003	21	1.21	1.25	0.03	0.58	10.58	2.91	0.02	629.20	629.19	LAT A-8
LINE "B - 1" EXISTING ARAPAHO ROAD WEST OF QUORUM DRIVE - 100 YEAR DESIGN																							
704.98	641.98	63.00	B-9	0.41	0.90	0.37	0.37	10.00	100	8.74	3.23	0.0002	24	1.03	0.60	0.02	1.02	11.02	3.23	0.02	630.43	630.42	EX 24" RCP - LAT B-9
641.98	484.23	157.75	B-10 & 11	0.83	0.90	0.75	1.12	10.75	100	8.55	9.54	0.0018	24	3.04	0.60	0.13	0.87	11.62	9.54	0.14	630.28	630.00	EX 24" RCP - LAT B-10
484.23	403.23	81.00	B-12	0.76	0.9																		

ARAPAHO ROAD
STORMWATER PIPE CALCULATIONS - SEPTEMBER 16, 1997

COLLECTION POINT UPSTREAM STATION	COLLECTION POINT DOWNSTREAM STATION	DISTANCE BETWEEN COLLECTION POINTS	AREA NO.	INCREMENTAL RUNOFF COEFF. C	DRAINAGE AREA INCR. CA	ACCUM. CA	TIME @ UPSTREAM STATION (MIN.)	DESIGN STORM FREQUENCY (YEAR)	RAINFALL INTENSITY I (IN./HR)	STORM WATER RUNOFF Q (CFS)	SLOPE OF HYDRAULIC GRADIENT S (FT/FT)	PIPE SIZE (INCHES)	VELOCITY IN STORM SEWER V (FPS)	HEAD LOSS COEFF. KJ	HEAD LOSS AT UPSTREAM WYE (FT)	FLOW TIME IN PIPE (MIN)	TIME @ DOWNSTREAM STATION (MIN)	DESIGN Q (CFS)	VELOCITY HEAD H _v (FT)	H.G. AT UPSTREAM STATION (FT)	H.G. AT DOWNSTREAM STATION (FT)	REMARKS
LINE "B - 2" EXISTING QUORUM DRIVE FROM BELT LINE ROAD TO RAILROAD NORTH OF PROPOSED ARAPAHO ROAD - 25 YEAR STORM																						
2019.61	1929.61	90.00	B-0	2.42	0.90	2.18	10.00	25	7.29	15.88	0.0152	18	7.32	1.25	1.04	0.20	10.20	12.94	0.83	627.54	626.17	EX 18" RCP
1929.61	1912.29	17.32				2.18	10.20	25	7.29	15.88	0.0006	36	2.25	0.60	-0.42	0.13	10.33	15.88	0.08	626.59	626.58	EX 36" RCP
1912.29	1702.29	210.00	B-1	1.03	0.90	3.11	10.33	25	7.20	22.36	0.0011	36	3.16	0.60	0.11	1.11	11.44	22.36	0.16	626.47	626.24	EX 36" RCP
1702.29	1554.79	147.50	B-2	1.40	0.90	4.51	11.44	25	6.95	30.34	0.0021	36	4.29	0.60	0.19	0.57	12.01	30.34	0.29	626.04	625.74	EX 36" RCP
1554.79	1539.61	15.18	B-3	1.17	0.90	5.68	12.01	25	6.80	36.84	0.0013	42	3.83	0.60	0.06	0.07	12.08	36.84	0.23	625.68	625.66	EX 42" RCP
1539.61	1202.61	337.00	B-4	1.26	0.90	6.94	12.08	25	6.80	44.55	0.0020	42	4.63	0.60	0.20	1.21	13.29	44.55	0.33	625.47	624.81	EX 42" RCP
1202.61	1183.21	19.40	B-5	0.93	0.90	7.87	13.29	25	6.60	48.77	0.0012	48	3.88	0.60	0.03	0.08	13.37	48.77	0.23	624.77	624.75	EX 48" RCP
1183.21	1036.72	146.49	B-6	0.88	0.90	8.75	13.37	25	6.60	53.99	0.0014	48	4.30	0.60	0.15	0.57	13.94	53.99	0.29	624.60	624.40	EX 48" RCP
1036.72	1019.40	17.32	B-7	0.88	0.90	9.63	13.94	25	6.50	58.32	0.0009	54	3.67	0.60	0.04	0.08	14.02	58.32	0.21	624.36	624.34	EX 54" RCP
1019.40	990.00	29.40	B-8	1.97	0.90	11.60	14.02	25	6.45	69.31	0.0012	54	4.36	0.50	0.19	1.11	14.13	69.31	0.29	624.15	624.12	EX 60" RCP
990.00	652.47	337.53	B-9-16	9.53	0.90	21.13	14.37	25	6.40	123.67	0.0023	60	6.30	0.60	0.44	0.89	15.26	123.67	0.62	623.68	622.92	EX 60" RCP
652.47	625.31	27.16	B-9-17	9.53	0.90	20.18	15.26	25	6.25	122.46	0.0022	60	6.24	0.60	0.23	0.07	15.34	122.46	0.60	622.68	622.62	EX 60" RCP - LAT B-17
625.31	482.29	143.08	B-18	0.38	0.90	20.56	15.34	25	6.25	124.59	0.0023	60	6.35	0.60	0.26	0.26	15.59	124.59	0.63	622.36	622.13	EX 60" RCP - LAT B-18
482.29	459.96	22.63	B-22 & 23	1.95	0.90	22.51	15.72	25	6.15	153.43	0.0021	66	6.46	0.60	0.31	0.06	15.78	153.43	0.65	621.56	621.51	EX 66" RCP - LAT B-23
459.96	308.05	151.91	B-24	0.17	0.90	22.68	15.78	25	6.15	154.37	0.0021	66	6.50	0.60	0.27	0.39	16.17	154.37	0.66	621.24	620.92	EX 66" RCP - LAT B-24
308.05	228.05	80.00	B-25	1.14	0.90	23.82	16.17	25	6.10	159.37	0.0023	66	6.71	0.60	0.31	0.20	16.36	159.37	0.70	620.62	620.44	EX 66" RCP - LAT B-25
228.05	188.05	40.00	B-26	27.10	0.90	24.39	17.55	25	5.95	300.58	0.0050	72	10.63	0.60	1.34	0.06	17.61	300.58	1.75	619.10	618.90	EX 72"-JUNCTION BOX N OF RR
LINE "B - 3" EXISTING ADDISON ROAD NORTH OF RAILROAD - 100 YEAR DESIGN																						
3980.00	3750.00	230.00	B-29	2.00	0.90	1.80	10.00	100	8.74	15.73	0.0224	18	8.90	1.25	1.54	0.43	10.43	15.73	1.23	663.72	658.57	EX 18" RCP
3750.00	3627.00	123.00	B-30	1.76	0.90	3.58	10.43	100	8.65	29.27	0.0051	30	5.96	0.75	-0.37	0.34	10.77	29.27	0.55	658.94	658.31	EX 30" RCP
3627.00	3497.00	130.00	B-31	0.98	0.90	4.56	10.77	100	8.55	36.47	0.0079	30	7.43	0.75	0.44	0.29	11.07	36.47	0.86	657.87	656.84	EX 30" RCP
3497.00	3254.00	243.00	B-32	1.04	0.90	5.60	11.07	100	8.45	43.96	0.0115	30	8.96	0.75	0.60	0.45	11.52	43.96	1.25	656.24	653.45	EX 30" RCP
3254.00	3100.00	154.00	B-33	1.94	0.90	7.54	11.52	100	8.35	58.02	0.0200	30	11.82	0.75	1.24	0.22	11.74	58.02	2.17	652.21	649.13	EX 30" RCP
3100.00	2800.00	300.00	B-34	1.23	0.90	8.77	11.74	100	8.30	66.86	0.0100	36	9.46	0.75	-0.24	0.53	12.26	66.86	1.39	649.37	646.35	EX 36" RCP
2800.00	2750.00	50.00	B-35	1.66	0.90	10.43	12.26	100	8.20	78.30	0.0138	36	11.08	0.50	1.21	0.08	12.34	78.30	1.91	645.14	644.45	EX 36" RCP
2750.00	2657.00	93.00	B-36	0.11	0.90	11.54	12.34	100	8.20	79.11	0.0141	36	11.19	0.50	0.99	0.14	12.48	79.11	1.94	643.46	642.15	EX 36" RCP
2657.00	2500.00	157.00	B-37	0.21	0.90	12.75	12.48	100	8.15	80.17	0.0063	42	8.33	0.60	-0.09	0.71	13.19	80.17	1.08	642.24	639.97	EX 42" RCP
2500.00	2218.00	282.00	B-38	2.74	0.90	15.49	13.19	100	8.00	98.42	0.0096	42	10.23	0.50	1.09	0.13	13.33	98.42	1.62	638.89	638.10	EX 42" RCP
2218.00	1860.00	358.00	B-39	0.66	0.90	16.15	13.33	100	7.95	102.53	0.0104	42	10.66	0.50	0.95	0.56	13.89	102.53	1.76	637.15	633.44	EX 42" RCP
1860.00	1810.00	50.00	B-40	2.86	0.90	19.01	13.89	100	7.85	121.45	0.0146	42	12.62	0.75	1.15	0.07	13.95	121.45	2.47	632.28	631.56	EX 42" RCP
1810.00	1730.00	80.00	B-41	0.40	0.90	20.41	13.95	100	7.85	124.27	0.0153	42	12.92	0.75	0.73	0.10	14.05	124.27	2.59	630.82	629.60	EX 42" RCP
1730.00	910.00	820.00	B-42	1.16	0.90	21.57	14.05	100	7.80	131.63	0.0084	48	10.47	0.50	0.85	1.30	15.36	131.63	1.70	628.75	621.86	EX 48" RCP
910.00	647.00	263.00	B-43	4.53	0.90	26.10	15.36	100	7.80	131.63	0.0026	60	6.70	1.00	-1.01	0.65	16.01	131.63	0.70	622.87	622.20	EX 60" RCP
647.00	590.00	57.00	B-43	4.53	0.90	20.95	16.01	100	7.45	156.09	0.0036	60	7.95	0.60	0.56	0.12	16.13	156.09	0.98	621.63	621.43	QUORUM JUNCT BOX N OF RR
LINE "B - 3" EXISTING ADDISON ROAD NORTH OF RAILROAD - 25 YEAR DESIGN																						
3980.00	3750.00	230.00	B-29	2.00	0.90	1.80	10.00	25	7.29	13.12	0.0156	18	7.42	1.25	1.07	0.52	10.52	13.12	0.86	647.06	643.47	EX 18" RCP
3750.00	3627.00	123.00	B-30	1.76	0.90	3.58	10.52	25	7.15	24.20	0.0035	30	4.93	0.75	-0.26	0.42	10.93	24.20	0.58	643.74	643.31	EX 30" RCP
3627.00	3497.00	130.00	B-31	0.98	0.90	4.56	10.93	25	7.05	30.08	0.0054	30	6.13	0.75	0.30	0.35	11.29	30.08	0.58	643.01	642.31	EX 30" RCP
3497.00	3254.00	243.00	B-32	1.04	0.90	5.60	11.29	25	6.95	36.15	0.0078	30	7.36	0.75	0.40	0.55	11.84	36.15	0.84	641.90	640.02	EX 30" RCP
3254.00	3100.00	154.00	B-33	1.94	0.90	7.54	11.84	25	6.85	47.59	0.0135	30	9.69	0.75	0.83	0.26	12.10	47.59	1.46	639.19	637.12	EX 30" RCP
3100.00	2800.00	300.00	B-34	1.23	0.90	8.77	12.10	25	6.80	54.77	0.0067	36	7.75	0.75	-0.16	0.65	12.75	54.77	0.93	637.28	635.26	EX 36" RCP
2800.00	2750.00	50.00	B-35	1.66	0.90	10.43	12.75	25	6.70	63.98	0.0092	36	9.05	0.50	0.81	0.09	12.84	63.98	1.27	634.45	633.99	EX 36" RCP
2750.00	2657.00	93.00	B-36	0.11	0.90	11.54	12.84	25	6.65	64.16	0.0093	36	9.08	0.50	0.64	0.17	13.01	64.16	1.28	633.35	632.49	EX 36" RCP
2657.00	2500.00	157.00	B-37	0.21	0.90	12.75	13.01	25	6.65	65.42	0.0042	42	8.80	0.60	-0.05	0.88	13.88	65.42	0.72	632.54	631.03	EX 42" RCP
2500.00	2300.00	200.00	B-38	2.74	0.90	15.49	13.88	25	6.50	79.97	0.0063	42	8.31	0.50	0.71	0.16	14.05	79.97	1.07	630.31	629.79	EX 42" RCP
2300.00	2218.00	82.00	B-39	0.66	0.90	16.15	14.05	25	6.35	81.90	0.0066	42	8.51	0.50	0.59	0.70	14.75	81.90	1.13	629.21	626.83	EX 42" RCP
2218.00	1860.00	358.00	B-40	2.86	0.90	19.01	14.75	25	6.30	97.47	0.0094	42	10.13	0.75	0.75	0.08	14.83	97.47	1.59	626.08	625.61	EX 42" RCP
1860.00	1730.00	80.00	B-41	0.40	0.90	20.41	14.83	25	6.30	99.74	0.0098	42	10.37	0.75	0.47	0.13	14.96	99.74	1.67	625.14	624.36	EX 42" RCP
1730.00	910.00	820.00	B-42	1.16	0.90	21.57	14.96	25	6.26													

ARAPAHO ROAD
STORMWATER PIPE CALCULATIONS - SEPTEMBER 16, 1997

COLLECTION POINT UPSTREAM STATION	COLLECTION POINT DOWNSTREAM STATION	DISTANCE BETWEEN COLLECTION POINTS	AREA NO.	AREA (ACRES)	INCREMENTAL RUNOFF COEFF. C	DRAINAGE A INCR. CA	ACCUM. CA	TIME @ UPSTREAM STATION (MIN.)	DESIGN STORM FREQUENCY (YEAR)	RAINFALL INTENSITY (IN./HR)	STORM WATER RUNOFF Q (CFS)	SLOPE OF HYDRAULIC GRADIENT S (FT/FT)	PIPE SIZE (INCHES)	VELOCITY IN STORM SEWER V (FPS)	HEAD LOSS COEFF. K _J	HEAD LOSS AT UPSTREAM WYE STATION (FT)	FLOW TIME IN PIPE (MIN)	TIME @ DOWNSTREAM STATION (MIN)	DESIGN Q (CFS)	VELOCITY HEAD (FT)	H.G. AT UPSTREAM STATION (FT)	H.G. AT DOWNSTREAM STATION (FT)	REMARKS
LINE "C - 3" EXISTING SYSTEM IN SPECTRUM DRIVE AT PROP. ARAPAHO ROAD, PROPOSED CHANGES - 25 YEAR DESIGN																							
2368.12	2263.12	105.00	PART C-1	1.34	0.90	1.21	1.21	10.00	100	7.29	8.79	0.0015	24	2.80	1.25	0.15	0.63	10.63	8.79	0.12	625.00	624.84	EX. 24"-1.00 AC TO C-3/C-5
2263.12	2198.12	65.00	C-2	0.73	0.90	0.66	1.86	10.63	100	7.10	13.23	0.0159	18	7.49	0.50	0.81	0.14	10.77	13.24	0.87	624.03	623.00	EX. 18" RCP
2198.12	1998.12	200.00	PART C-1	1.00	0.90	0.90	2.76	10.77	100	7.05	19.48	0.0074	24	6.20	0.60	0.07	0.54	11.31	19.48	0.60	622.93	621.44	EX. 24"-FUT. CONN. FROM C-1
1998.12	1856.12	142.00	PART C-3	1.00	0.90	0.90	3.66	11.31	100	6.95	25.46	0.0039	30	5.19	0.60	0.06	0.46	11.76	25.46	0.42	621.38	620.84	EX. 30"-1.66 AC TO C/5 LN "C-2"
1856.12	1751.12	105.00	C-4	2.88	0.90	2.59	6.26	11.76	100	6.85	42.85	0.0109	30	8.73	0.60	0.93	0.20	11.96	42.85	1.18	619.90	618.76	EX. 30" RCP
1751.12	1567.72	183.40	PART C-3 & 6	1.72	0.90	1.55	7.80	11.96	100	6.85	53.45	0.0064	36	7.56	0.60	0.18	0.40	12.37	53.45	0.89	618.58	617.40	EX. 36" RCP
1567.72	1330.36	237.36					7.80	12.37	100	6.85	53.45	0.0042	39	6.44	1.00	-0.24	0.61	12.98	53.45	0.64	617.65	616.65	PROP.39" RCP
1330.36	1227.49	102.87	C-12	0.47	0.90	0.42	8.23	12.98	100	6.65	54.70	0.0044	39	6.59	0.60	0.29	0.26	13.24	54.70	0.68	616.36	615.91	PROP.39" RCP-LAT C-12
1227.49	1200.00	27.49	C-16	0.47	0.90	0.42	8.65	13.24	100	6.60	57.08	0.0048	39	6.88	0.60	0.33	0.07	13.31	57.08	0.74	615.58	615.45	PROP.39" RCP-LAT C-16
LINE "C - 4" EXISTING SYSTEM IN ARAPAHO ROAD DRAINING TO TOLLWAY - 100 YEAR DESIGN																							
1643.00	1538.00	105.00	C-17	1.51	0.90	1.36	1.36	10.00	100	8.74	11.88	0.0003	36	1.68			1.04	11.04	11.88	0.04	612.53	612.49	EX. 36" RCP-EX. LAT C-17
1538.00	1355.00	183.00	C-18	0.87	0.90	0.78	2.14	11.04	100	8.50	18.21	0.0007	36	2.58	0.60	0.08	1.18	12.23	18.21	0.10	612.42	612.28	EX. 36" RCP-LAT C-18
1355.00	1250.00	105.00	C-19 & 20	0.70	0.90	0.63	2.77	12.23	100	8.20	22.73	0.0012	36	3.22	0.60	0.10	0.54	12.77	22.73	0.16	612.18	612.06	EX. 36" RCP-LAT C-20
1250.00	1190.00	60.00	C-21	0.73	0.90	0.66	3.43	12.77	100	8.10	27.77	0.0008	42	2.89	0.60	0.03	0.35	13.12	27.77	0.13	612.03	611.98	EX. 42" RCP-LAT C-21
1190.00	1027.00	163.00	C-22	0.19	0.90	0.17	3.60	13.12	100	8.00	28.80	0.0008	42	2.99	0.60	0.06	0.91	14.02	28.80	0.14	611.92	611.78	EX. 42" RCP-LAT C-22
1027.00	1000.00	27.00	C-23	0.80	0.90	0.72	4.32	14.02	100	7.80	33.70	0.0011	42	3.50	0.60	0.11	0.13	14.15	33.70	0.19	611.68	611.65	EX. 42" RCP-LAT C-23
1000.00	840.00	160.00	C-24	3.84	0.90	3.46	7.78	14.15	100	7.80	60.65	0.0010	54	3.81	0.60	0.11	0.70	14.85	60.65	0.23	611.54	611.38	EX. 54" RCP-EX. LAT C-24
840.00	773.27	66.73	C-25	5.00	0.90	4.50	12.28	14.85	100	7.60	93.30	0.0023	54	5.87	0.60	0.40	0.19	15.04	93.30	0.53	610.98	610.83	EX. 54" RCP-EX. LAT C-25
773.27	713.53	59.74					12.28	15.04	100	7.60	93.30	0.0013	60	4.75	0.50	0.18	0.21	15.25	93.30	0.35	610.66	610.58	EX. 60" RCP
713.53	170.00	543.53	C-26	0.71	0.90	0.64	12.92	15.25	100	7.50	96.86	0.0014	60	4.93	0.50	0.17	1.84	17.09	96.86	0.38	609.86	609.66	EX. 60" RCP
170.00	5.00	165.00					12.92	17.09	100	7.50	96.86	0.0014	60	4.93	0.50	0.19	0.56	17.64	96.86	0.38	609.47	609.25	EX. 60" RCP
5.00	0.00	5.00					12.92	17.64	100	7.50	96.86	0.0014	60	4.93	0.50	0.19	0.02	17.66	96.86	0.38	609.06	609.05	EX. 60" RCP
0.00	-110.00	110.00	C-1-16&27-29	32.46	0.90	29.21	42.13	17.66	100	7.15	301.22	0.0012	95	6.15	1.00	0.21	0.30	17.96	301.22	0.59	605.76	605.63	EX. 7'x7' BOX UNDER RR
LINE "C - 4" EXISTING SYSTEM IN ARAPAHO ROAD DRAINING TO TOLLWAY - 25 YEAR DESIGN																							
1643.00	1538.00	105.00	C-17	1.51	0.90	1.36	1.36	10.00	100	7.29	9.91	0.0002	36	1.40			1.25	11.25	9.91	0.03	611.34	611.32	EX. 36" RCP-EX. LAT C-17
1538.00	1355.00	183.00	C-18	0.87	0.90	0.78	2.14	11.25	100	7.00	14.99	0.0005	36	2.12	0.60	0.05	1.44	12.69	14.99	0.07	611.27	611.17	EX. 36" RCP-LAT C-18
1355.00	1250.00	105.00	C-19 & 20	0.70	0.90	0.63	2.77	12.69	100	6.70	18.57	0.0008	36	2.63	0.60	0.07	0.67	13.35	18.57	0.11	611.11	611.03	EX. 36" RCP-LAT C-20
1250.00	1190.00	60.00	C-21	0.73	0.90	0.66	3.43	13.35	100	6.55	22.46	0.0005	42	2.33	0.60	0.02	0.43	13.78	22.46	0.08	611.01	610.98	EX. 42" RCP-LAT C-21
1190.00	1027.00	163.00	C-22	0.19	0.90	0.17	3.60	13.78	100	6.50	23.40	0.0005	42	2.43	0.60	0.04	1.12	14.90	23.40	0.09	610.94	610.85	EX. 42" RCP-LAT C-22
1027.00	1000.00	27.00	C-23	0.80	0.90	0.72	4.32	14.90	100	6.30	27.22	0.0007	42	2.83	0.60	0.07	0.16	15.06	27.22	0.12	610.78	610.76	EX. 42" RCP-LAT C-23
1000.00	840.00	160.00	C-24	3.84	0.90	3.46	7.78	15.06	100	6.25	48.60	0.0006	54	3.06	0.60	0.07	0.87	15.93	48.60	0.14	610.69	610.59	EX. 54" RCP-EX. LAT C-24
840.00	773.27	66.73	C-25	5.00	0.90	4.50	12.28	15.93	100	6.15	75.50	0.0015	54	4.75	0.60	0.26	0.23	16.16	75.50	0.35	610.33	610.23	EX. 54" RCP-EX. LAT C-25
773.27	713.53	59.74					12.28	16.16	100	6.15	75.50	0.0008	60	3.85	0.50	0.11	0.26	16.42	75.50	0.23	610.12	610.06	EX. 60" RCP
713.53	170.00	543.53	C-26	0.71	0.90	0.64	12.92	16.42	100	6.10	78.78	0.0009	60	4.01	0.60	0.11	2.26	18.68	78.78	0.25	609.95	609.46	EX. 60" RCP-LAT C-26
170.00	5.00	165.00					12.92	18.68	100	6.10	78.78	0.0009	60	4.01	0.50	0.12	0.69	19.37	78.78	0.25	609.33	609.18	EX. 60" RCP
5.00	0.00	5.00					12.92	19.37	100	6.10	78.78	0.0009	60	4.01	0.50	0.12	0.02	19.39	78.78	0.25	609.05	609.05	EX. 60" RCP
0.00	-110.00	110.00	C-1-16&27-29	32.46	0.90	29.21	42.13	19.39	100	5.70	240.14	0.0007	95	4.90	1.00	0.12	0.37	19.76	240.14	0.37	605.71	605.63	EX. 7'x7' BOX UNDER RR
LAT "C-8"																							
9.78	0.00	9.78	C-7 & 8	0.62	0.90	0.56	0.56	10.00	100	8.74	4.88	0.0022	18	2.76	1.25	0.15	0.06	10.06	4.88	0.12	621.39	621.37	
LAT "C-9"																							
9.81	0.00	9.81	C-9	0.43	0.90	0.39	0.39	10.00	100	8.74	3.38	0.0010	18	1.91	1.25	0.07	0.09	10.09	3.38	0.06	620.31	620.30	
LAT "C-10"																							
225.34	0.00	225.34	C-10 & 11	1.14	0.90	1.03	1.03	10.00	100	8.74	8.97	0.0193	15	7.31	0.00	0.00	0.51	10.51	8.97	0.83	622.40	618.06	EX 15" RCP
LAT "C-12"																							
46.01	0.00	46.01	C-12	0.47	0.90	0.42	0.42	10.00	100	8.74	3.70	0.0012	18	2.09	1.25	0.09	0.37	10.37	3.70	0.07	617.86	617.80	
LAT "C-14"																							
9.82	0.00	9.82	C-14	0.64	0.90	0.58	0.58	10.00	100	8.74	5.03	0.0023	18	2.85	1.25	0.16	0.06	10.06	5.03	0.13	618.06	618.04	
LAT "C-15"																							
79.10	0.00	79.10	C-15	0.54	0.90	0.49	0.49	10.00	100	8.74	4.25	0.0016	18	2.41	1.25	0.11	0.55	10.55	4.25	0.09	618.01	617.88	
LAT "C-16"																							
112.26	0.00	112.26	C-16	0.47	0.90	0.42	0.42	10.00	100	8.74	3.70	0.0014	18	2.22	1.25	0.10	0.84	10.84	3.93	0.08	616.87	616.71	
LAT "C-18"																							
9.72	0.00	9.72	C-18	0.87	0.90	0.78	0.78	10.00	100	8.74	6.84	0.0035	18	3.51	1.25	0.24	0.05	10.05	6.20	0.19	616.21	616.18	
LAT "C-20"																							
36.67	0.00	36.67	C-19 & 20	0.70	0.90	0.63	0.63	10.00	100	8.74	5.51	0.0034	18	3.48	1.25	0.24	0.18	10.18	6.15	0.19	614.85	614.72	
LAT "C-21"																							
54.21	0.00	54.21	C-																				

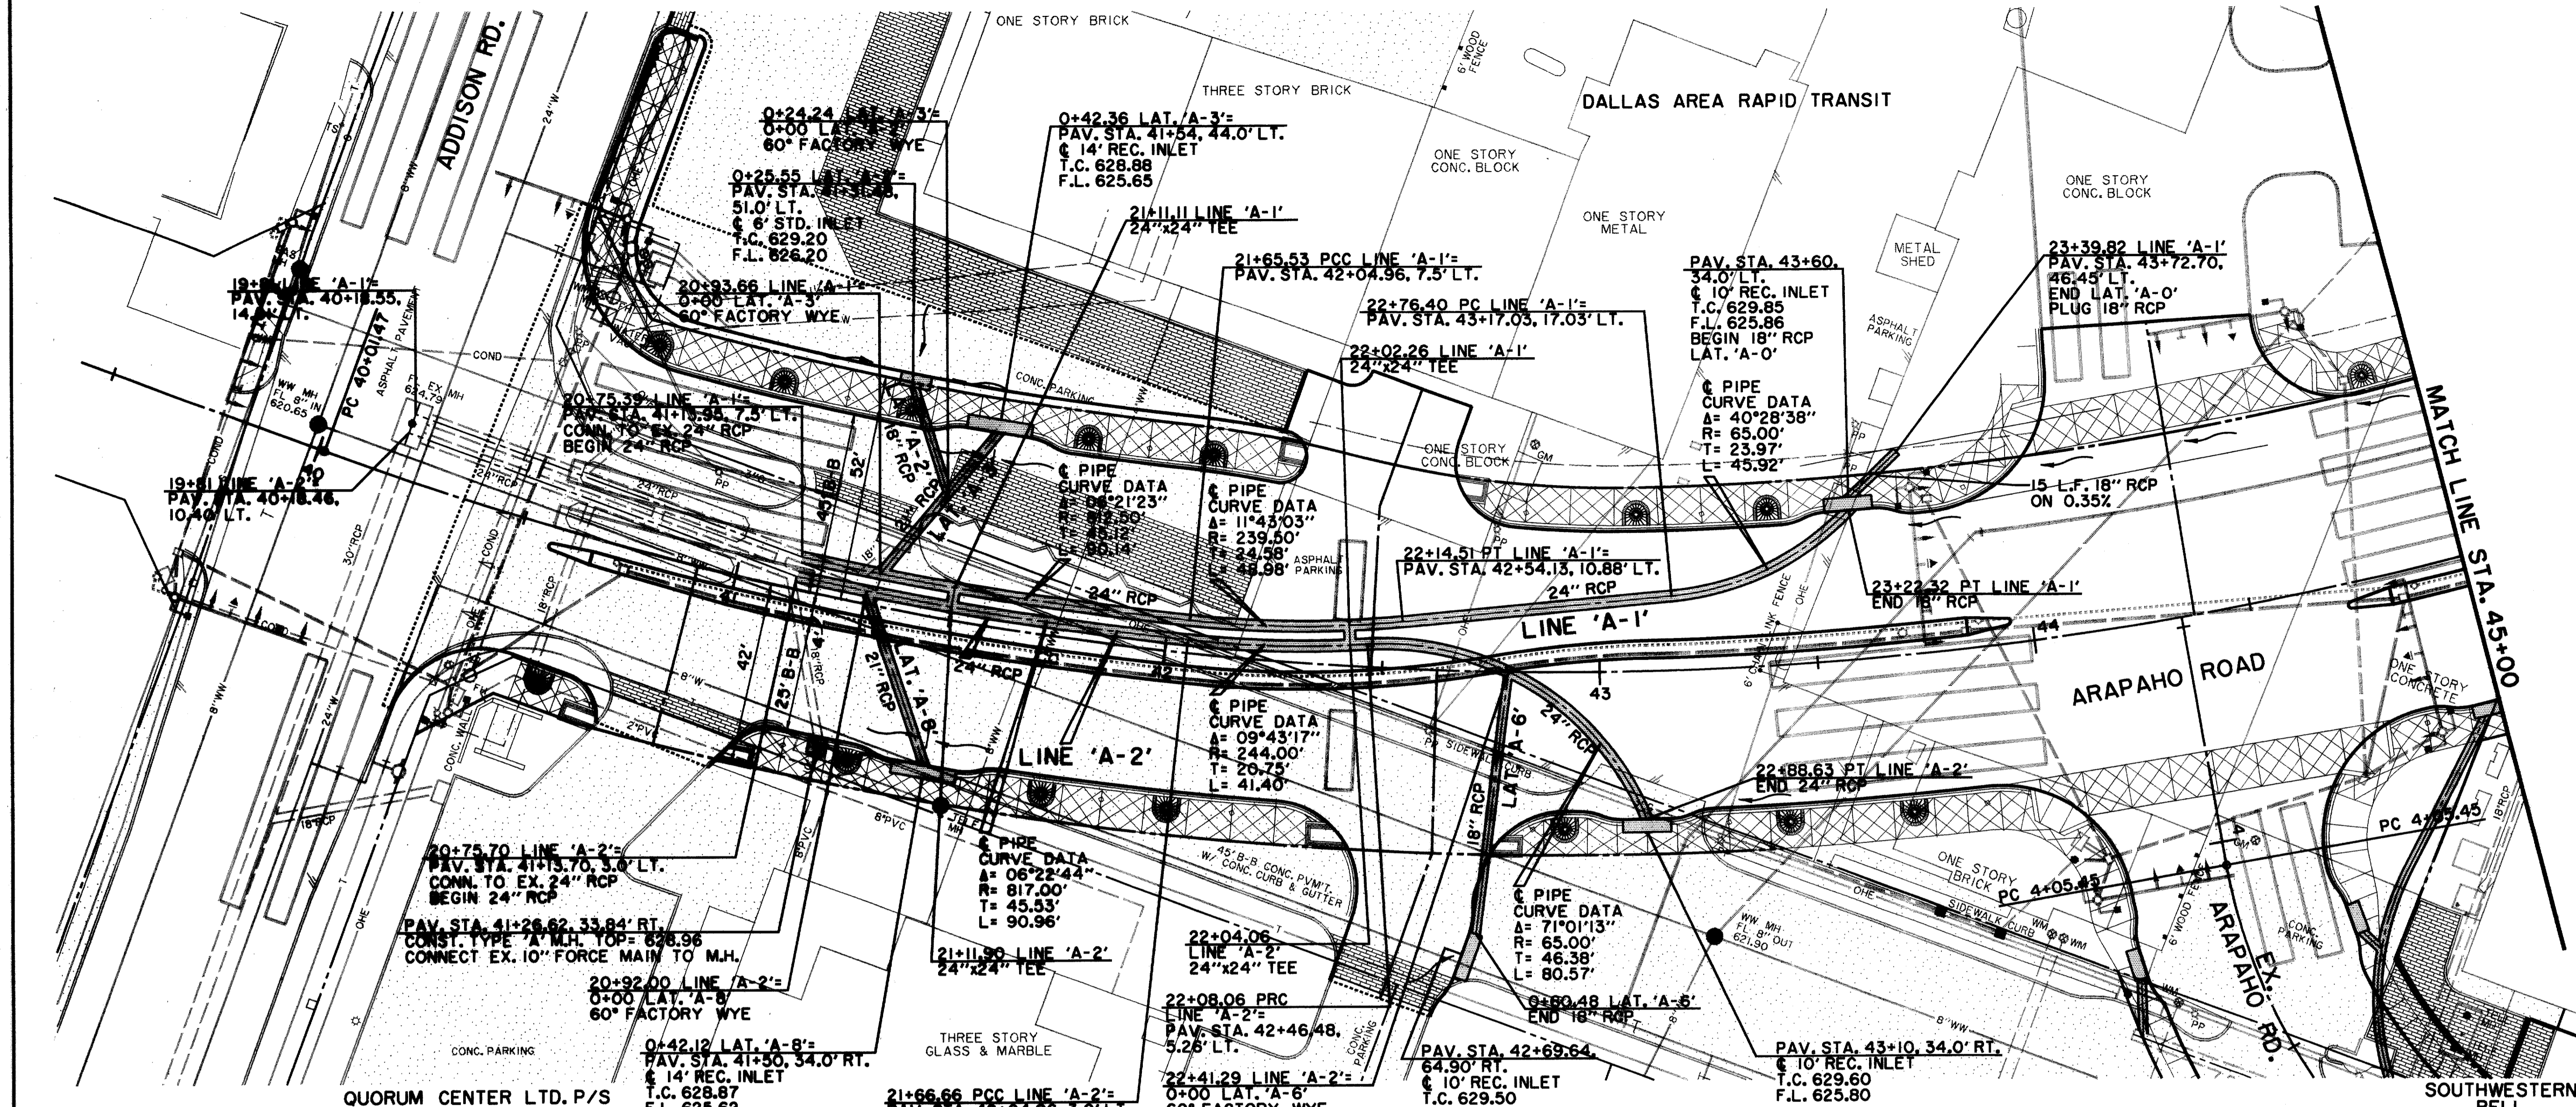


NOTE:
VERIFY LOCATION, HORIZONTAL
& VERTICAL, OF ALL UTILITIES
PRIOR TO CONSTRUCTION OF
STORMWATER INLETS & PIPES

RECORD DOCUMENTS 6/9/2000
THESE RECORD DOCUMENTS HAVE BEEN
PREPARED BASED ON INFORMATION
PROVIDED BY OTHERS. THE CONSULTANT
HAS NOT VERIFIED THE ACCURACY AND/
OR COMPLETENESS OF THIS INFORMATION
AND SHALL NOT BE RESPONSIBLE FOR
ANY ERRORS OR OMISSIONS THAT MAY
BE INCORPORATED AS A RESULT OF
ERRONEOUS INFORMATION PROVIDED BY
OTHERS.

LEGEND

ELECTRIC — ONE	WATER — W
○ LIGHT POLE	FH FIRE HYDRANT
PP POWER POLE	WM METER
— GUY WIRE	T WATER VALVE
TELEPHONE — T	MISC.
● TELEPHONE MANHOLE	48" RCP R.C.P. REMOVAL
○ TELEPHONE PEDESTAL	— CHAIN LINK FENCE
TS TELEPHONE SIGN	— WOOD FENCE
GAS — G	— EXISTING ASPHALT
GM GAS METER	— EXISTING DIRT OR GRAVEL
GS GAS SIGN	— EX. CONCRETE
LAND USE	— TREE/TREE LINE
R.R. RAILROAD SIGN	— EXISTING CURB
⊕ SIGN	— PROP. CURB
SURVEY	— EX. PROPERTY LINE
I.R. FOUND IRON ROD	— PROP. CENTERLINE
⊕ TEMP BENCHMARK	— PROP. R.O.W.
WASTEWATER — WW	— PROP. INLET
WM WASTEWATER MANHOLE	— TOP OF PAVEMENT
CO CLEANOUT	T.C. TOP OF CURB
	C.R. CURB RETURN

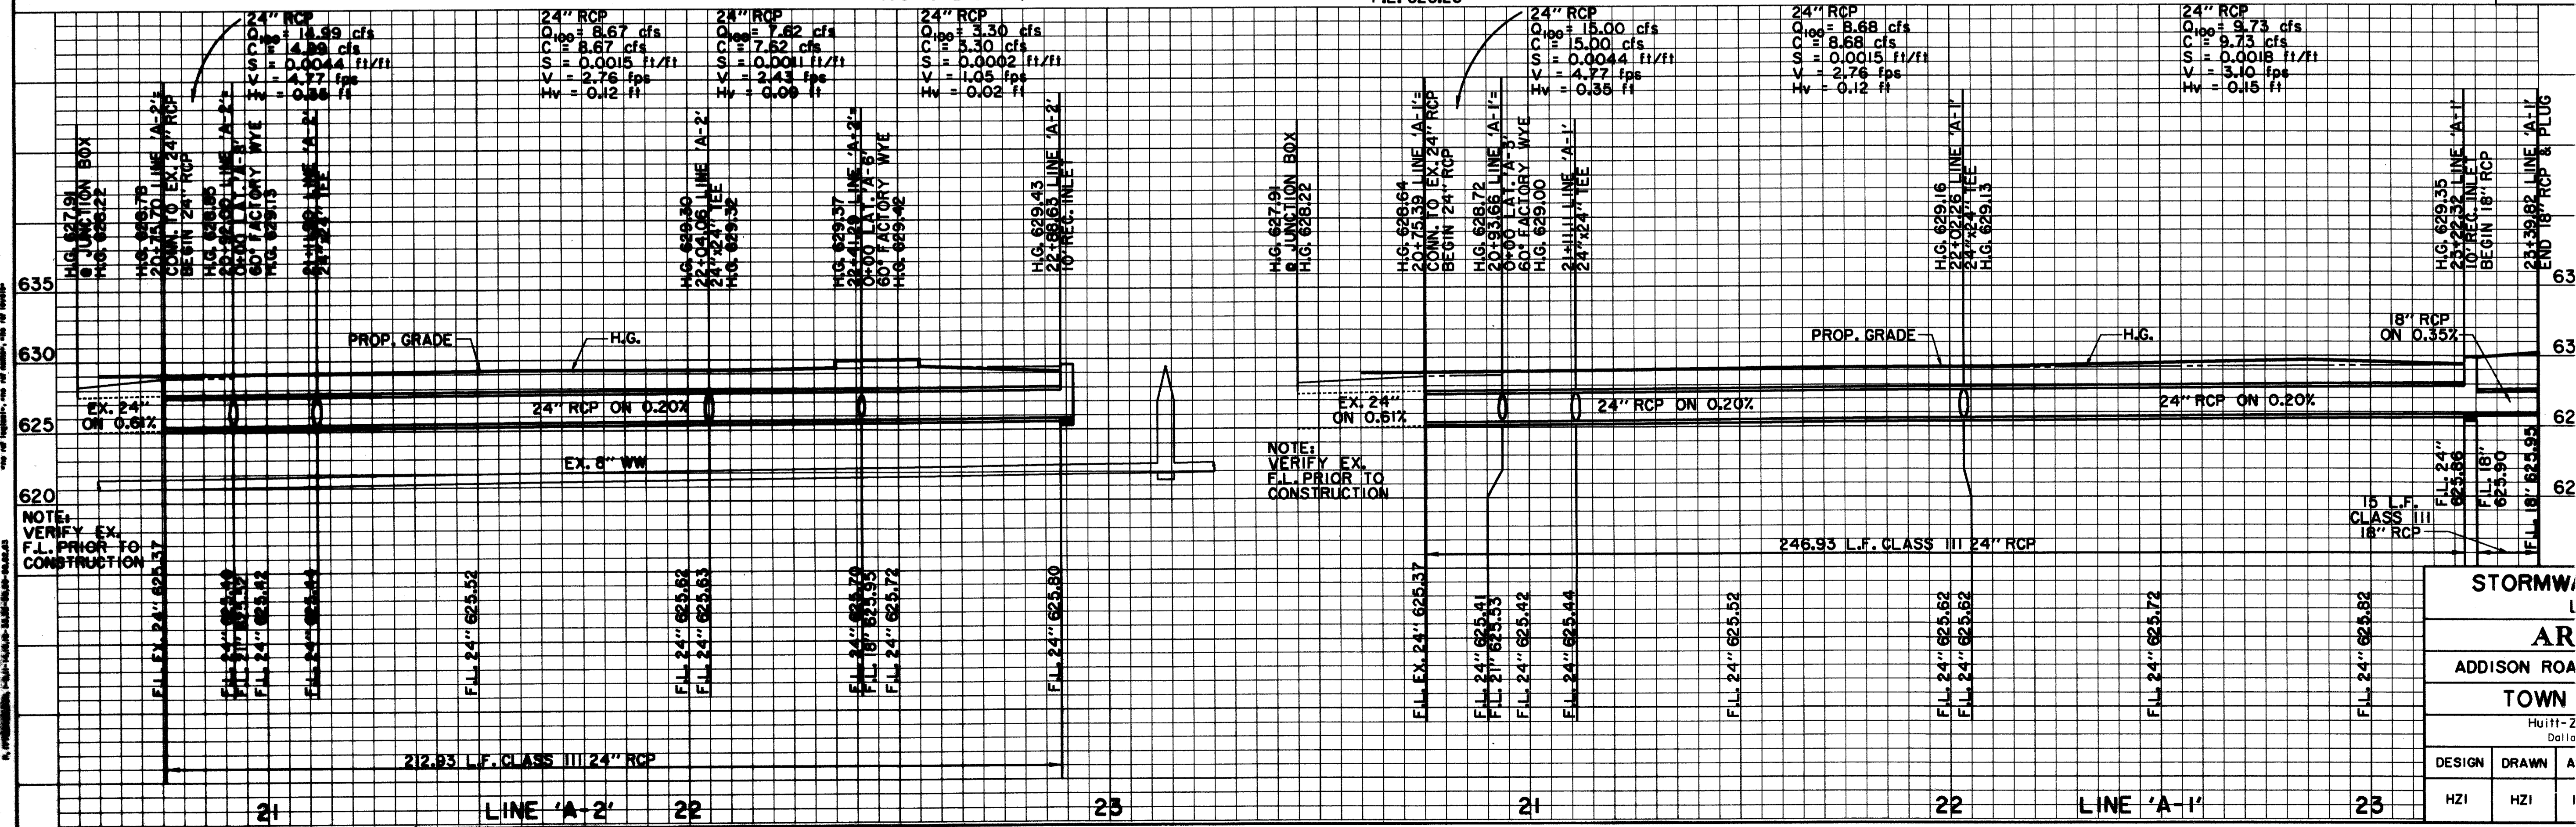

BENCHMARKS:
USC & GS E-921 DISK IN BRICK
WALL OF OLD ADDISON SCHOOL
HOUSE (MAGIC TIME MACHINE
RESTAURANT) ON SOUTH WALL,
4' EAST OF CENTER OF THE
ENTRANCE, 4.7' ABOVE THE
GROUND.
ELEV. 650.61



"□" ON SOUTHEAST CORNER OF
CONCRETE WALK AT FRONT
ENTRANCE TO 4805 ARAPAHO
ROAD.
ELEV. 630.61

THE SEAL APPEARING ON THIS
DOCUMENT WAS AUTHORIZED BY
KENNETH A. ROBERTS, P.E. 55446
ON OCTOBER 24, 1997

10-29-97

STORMWATER PLAN & PROFILE	
LINES 'A-1' & 'A-2'	
ARAPAHO ROAD	
ADDISON ROAD TO DALLAS NORTH TOLLWAY	
TOWN OF ADDISON, TEXAS	
Hull-Zollars, Inc./Consulting Engineers Dallas, Fort Worth, Houston, Phoenix, Tustin	
DESIGN	HZ1
DRAWN	HZ1
APPR.	KAR
SCALE	H ₁ "=20' V ₁ "=6'
DATE	OCT 97
PROJECT NO.	1772-01
NO.	ST-6

NOTES:
1. VERIFY EX. UTILITIES PRIOR TO CONSTRUCTION.
2. VERIFY EX. F.L. PRIOR TO CONSTRUCTION.
3. VERIFY EX. CURB PRIOR TO CONSTRUCTION.
4. VERIFY EX. PROPERTY LINE PRIOR TO CONSTRUCTION.
5. VERIFY EX. CENTERLINE PRIOR TO CONSTRUCTION.
6. VERIFY EX. R.O.W. PRIOR TO CONSTRUCTION.
7. VERIFY EX. INLET PRIOR TO CONSTRUCTION.
8. VERIFY EX. TOP OF CURB PRIOR TO CONSTRUCTION.
9. VERIFY EX. CURB RETURN PRIOR TO CONSTRUCTION.
10. VERIFY EX. TREE/TREE LINE PRIOR TO CONSTRUCTION.
11. VERIFY EX. CHAIN LINK FENCE PRIOR TO CONSTRUCTION.
12. VERIFY EX. WOOD FENCE PRIOR TO CONSTRUCTION.
13. VERIFY EX. ASPHALT PRIOR TO CONSTRUCTION.
14. VERIFY EX. DIRT OR GRAVEL PRIOR TO CONSTRUCTION.
15. VERIFY EX. CONCRETE PRIOR TO CONSTRUCTION.
16. VERIFY EX. PROPERTY LINE PRIOR TO CONSTRUCTION.
17. VERIFY EX. CENTERLINE PRIOR TO CONSTRUCTION.
18. VERIFY EX. R.O.W. PRIOR TO CONSTRUCTION.
19. VERIFY EX. INLET PRIOR TO CONSTRUCTION.
20. VERIFY EX. TOP OF PAVEMENT PRIOR TO CONSTRUCTION.
21. VERIFY EX. T.C. PRIOR TO CONSTRUCTION.
22. VERIFY EX. CURB RETURN PRIOR TO CONSTRUCTION.

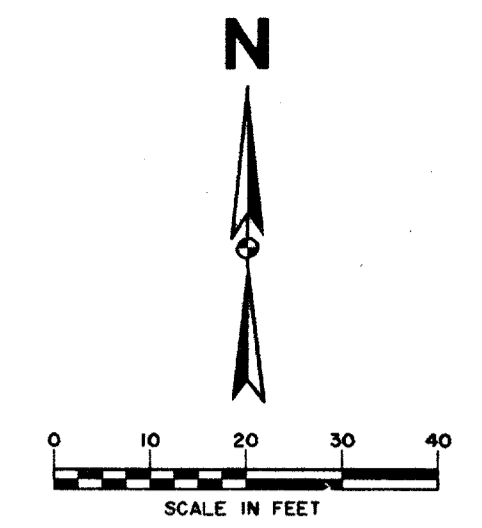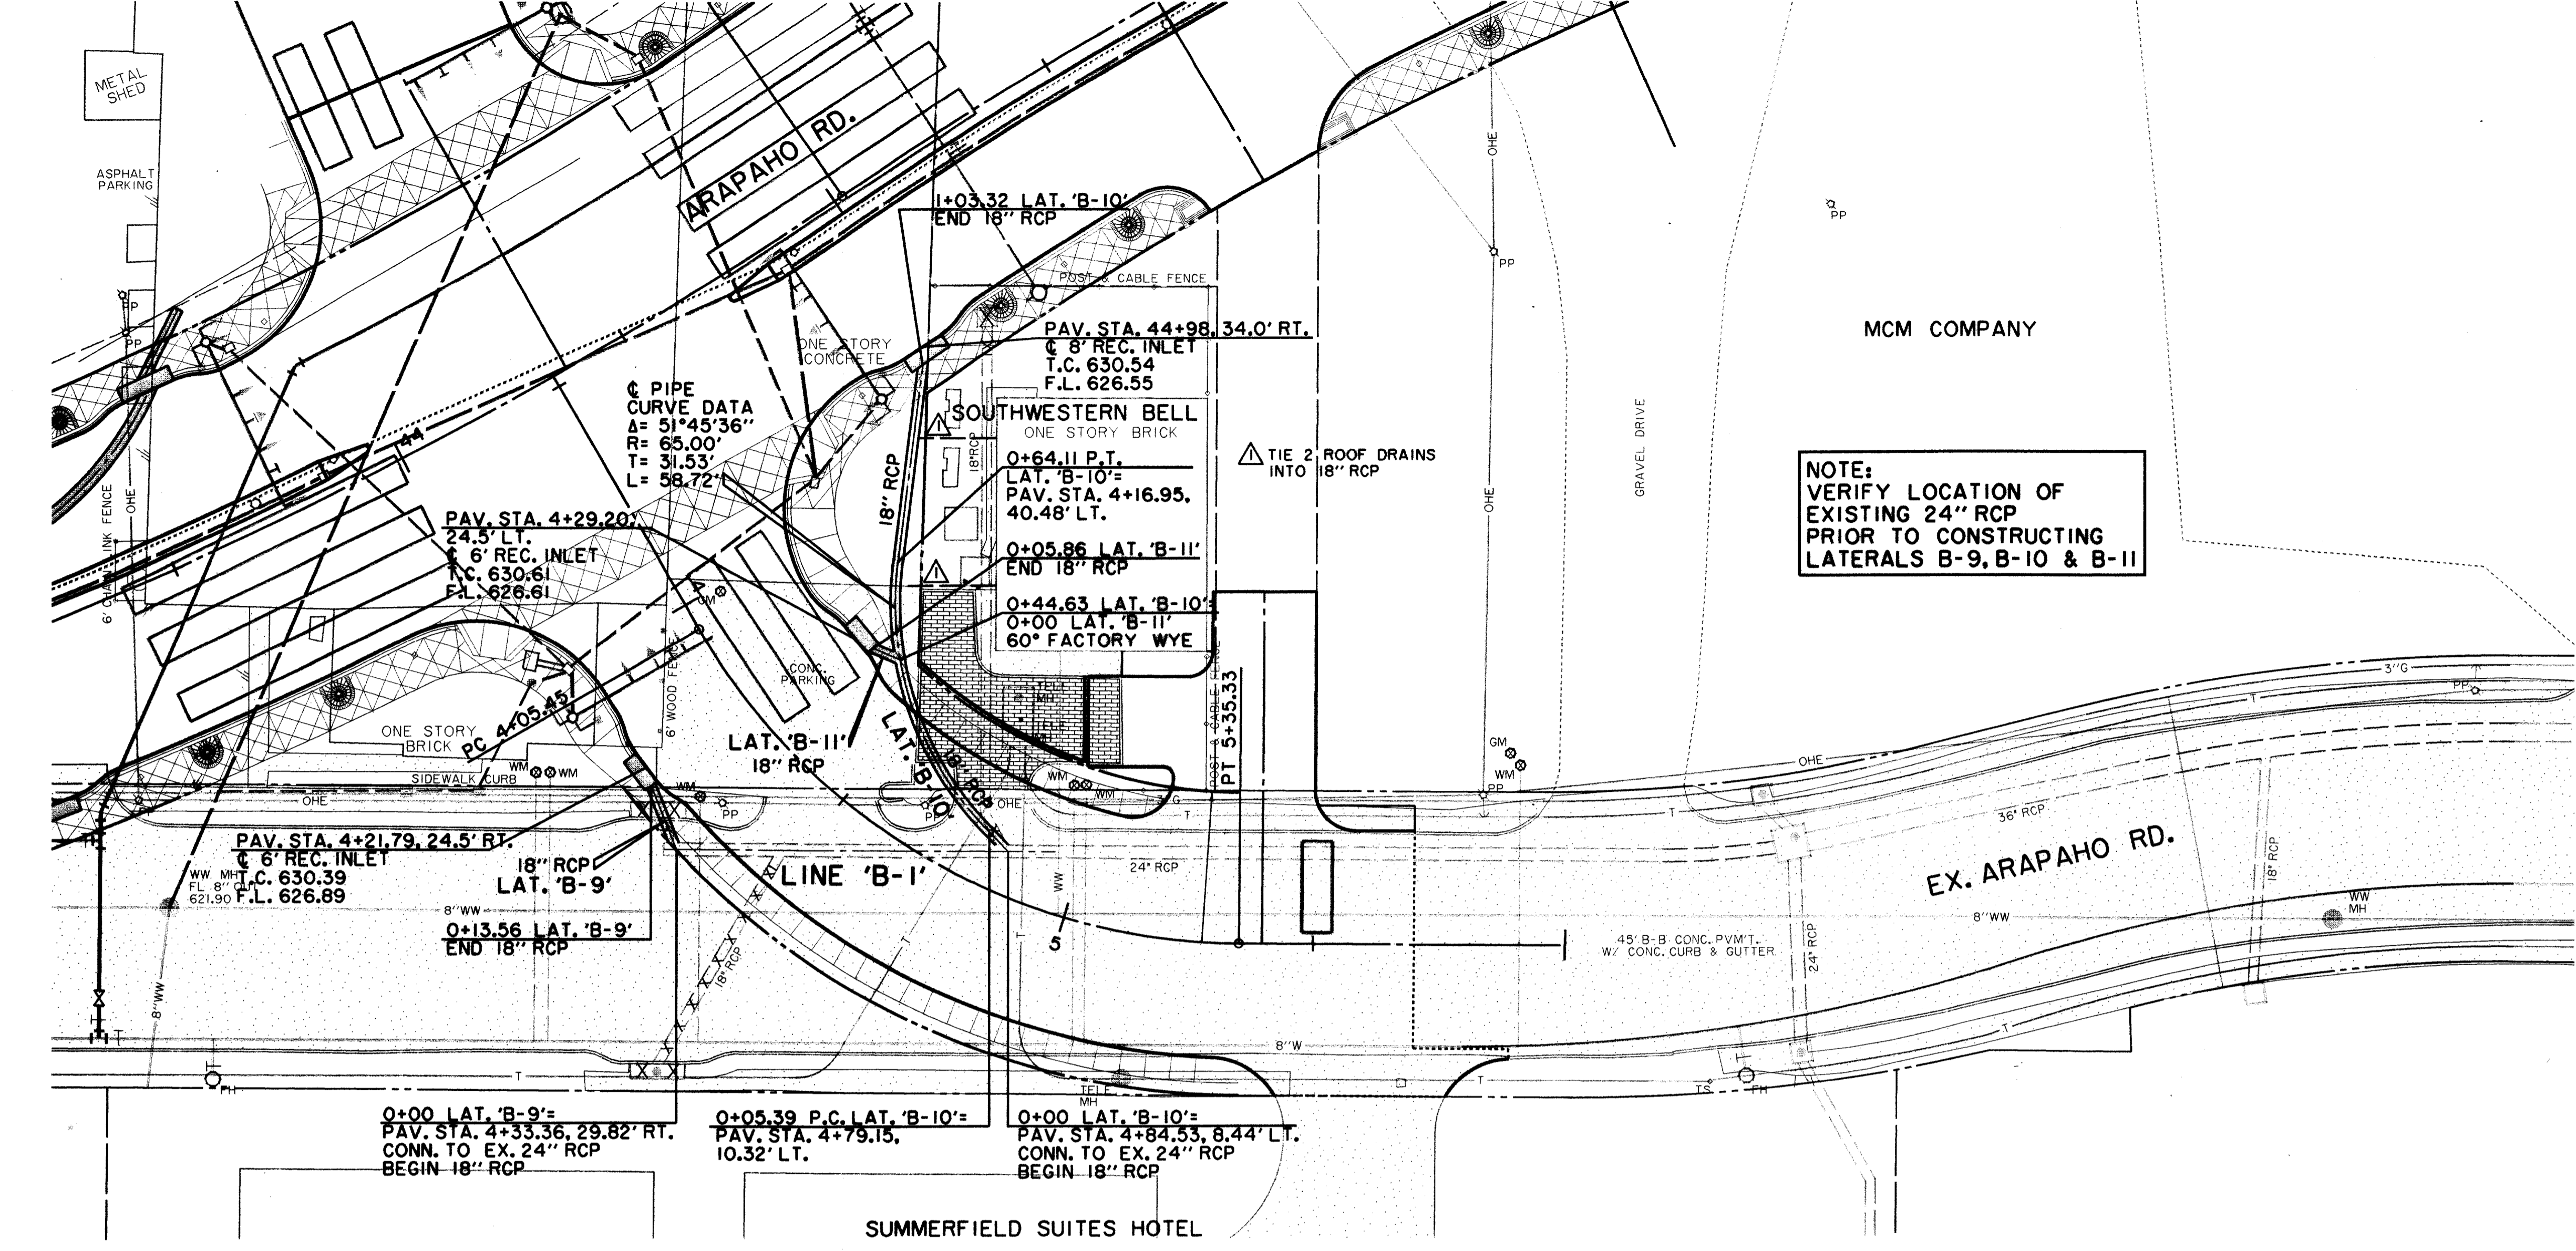

NOTE: VERIFY LOCATION, HORIZONTAL & VERTICAL, OF ALL UTILITIES PRIOR TO CONSTRUCTION OF STORMWATER INLETS & PIPES

NOTE: VERIFY LOCATION OF EXISTING 24" RCP PRIOR TO CONSTRUCTING LATERALS B-9, B-10 & B-11


THESE RECORD DOCUMENTS HAVE BEEN PREPARED BASED ON INFORMATION PROVIDED BY OTHERS. THE CONSULTANT HAS NOT VERIFIED THE ACCURACY AND/OR COMPLETENESS OF THIS INFORMATION AND SHALL NOT BE RESPONSIBLE FOR ANY ERRORS OR OMISSIONS THAT MAY BE INCORPORATED AS A RESULT OF ERRONEOUS INFORMATION PROVIDED BY OTHERS.

LEGEND

	ELECTRIC — OHE —		WATER — W —
	LIGHT POLE		FIRE HYDRANT
	POWER POLE		METER
	GUY WIRE		WATER VALVE
	TELEPHONE — T —		48" RCP
	TELEPHONE MANHOLE		R.C.P. REMOVAL
	TELEPHONE PEDESTAL		CHAIN LINK FENCE
	TELEPHONE SIGN		WOOD FENCE
	GAS — G —		EXISTING ASPHALT
	GAS METER		EXISTING DIRT OR GRAVEL
	GAS SIGN		EX. CONCRETE
	LAND USE		TREE/TREE LINE
	RAILROAD SIGN		EXISTING CURB
	SIGN		PROP. CURB
	SURVEY		EX. PROPERTY LINE
	FOUND IRON ROD		PROP. CENTERLINE
	TEMP BENCHMARK		PROP. R.O.W.
	WASTEWATER — WW —		PROP. INLET
	WASTEWATER MANHOLE		PROP. R.O.W.
	CLEANOUT		P.V.M.T. TOP OF PAVEMENT
			T.C. TOP OF CURB
			C.R. CURB RETURN

THE SEAL APPEARING ON THIS DOCUMENT WAS AUTHORIZED BY KENNETH A. ROBERTS, P.E. 55446 ON OCTOBER 24, 1997


THE SEAL APPEARING ON THIS DOCUMENT WAS AUTHORIZED BY KENNETH A. ROBERTS, P.E. 55446 ON OCTOBER 24, 1997

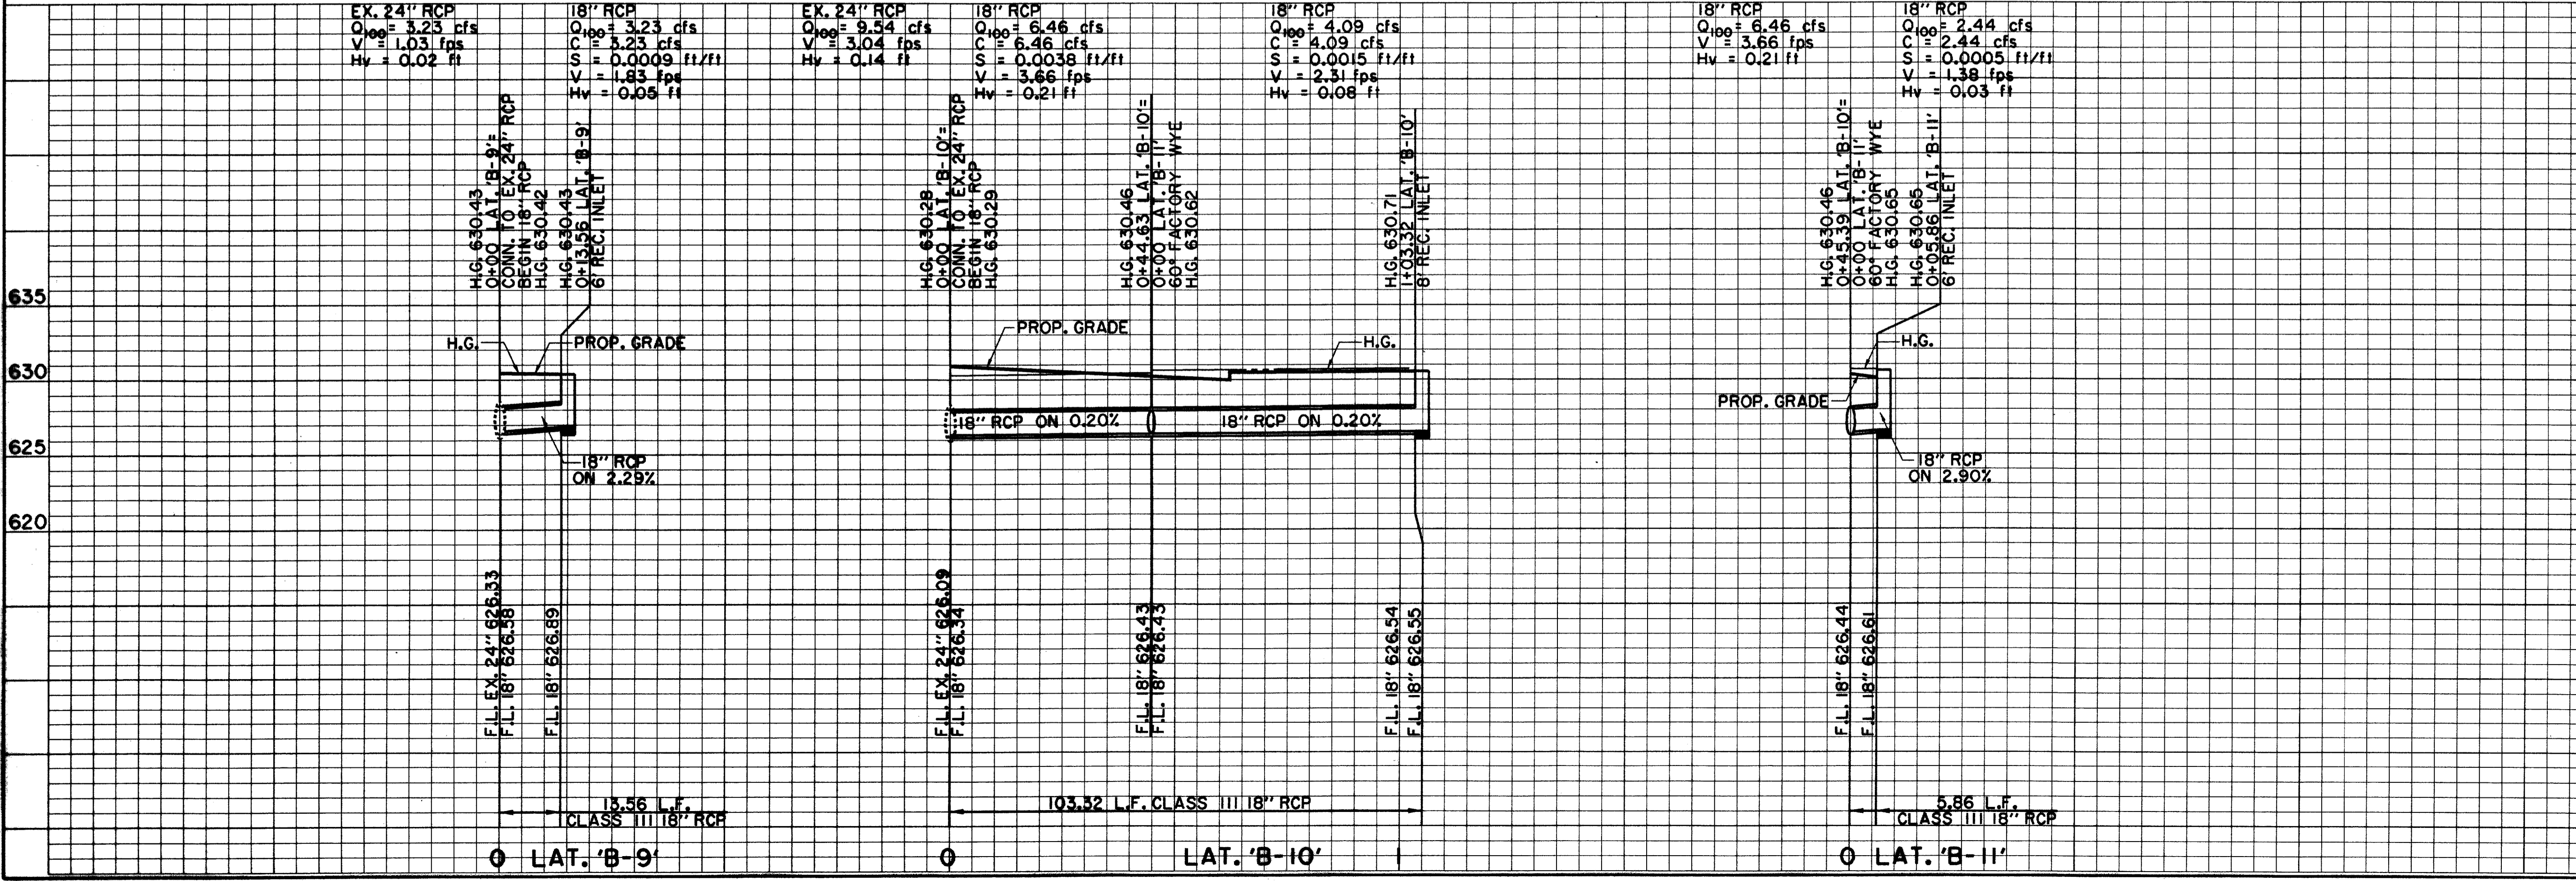

BENCHMARKS:

USC & GS E-921 DISK IN BRICK WALL OF OLD ADDISON SCHOOL HOUSE (MAGIC TIME MACHINE RESTAURANT) ON SOUTH WALL, 4' EAST OF CENTER OF THE ENTRANCE, 4.7' ABOVE THE GROUND. ELEV. 650.61


"I" ON SOUTHEAST CORNER OF CONCRETE WALK AT FRONT ENTRANCE TO 4805 ARAPAHO ROAD. ELEV. 630.61

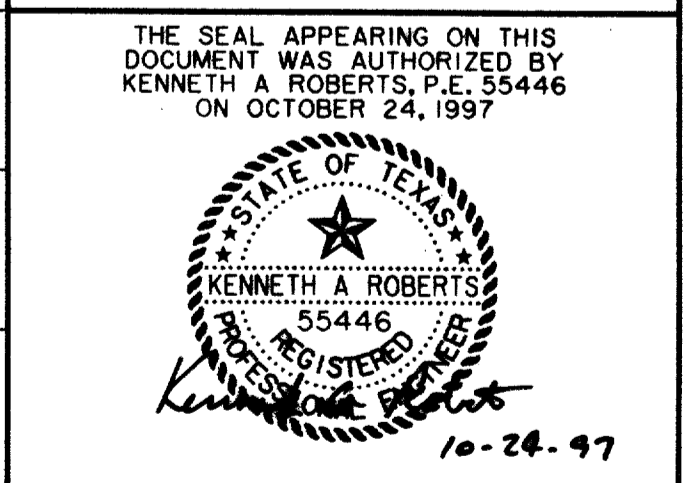

RECORD DOCUMENTS
6/9/2000

STORMWATER PLAN & PROFILE						
ARAPAHO ROAD						
ADDISON ROAD TO DALLAS NORTH TOLLWAY						
TOWN OF ADDISON, TEXAS						
Hutti-Zollars, Inc./Consulting Engineers Dallas, Fort Worth, Houston, Phoenix, Tustin						
DESIGN	DRAWN	APPR.	SCALE	DATE	PROJECT NO.	NO.
HZI	HZI	KAR	H ₁ 1"=20' V ₁ 1"=6'	OCT 97	1772-01	ST-7

THESE RECORD DOCUMENTS HAVE BEEN PREPARED BASED ON INFORMATION PROVIDED BY OTHERS. THE CONSULTANT HAS NOT VERIFIED THE ACCURACY AND/OR COMPLETENESS OF THIS INFORMATION AND SHALL NOT BE RESPONSIBLE FOR ANY ERRORS OR OMISSIONS THAT MAY BE INCORPORATED AS A RESULT OF ERRONEOUS INFORMATION PROVIDED BY OTHERS.

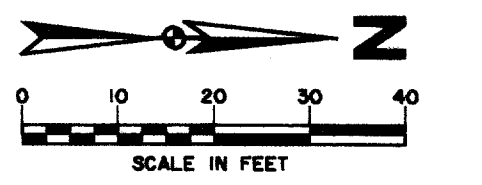

MCM COMPANY

0+91.75 LAT. 'B-19'=
0+00 LAT. 'B-20'
60° FACTORY WYE

PAV. STA. 51+47.44, 0' RT. PC 51+17.88
10' REC. INLET
T.C. 625.97
F.L. 621.97

0+28.98 LAT. 'B-20'
END 24" RCP

1+03.84 LAT. 'B-19'
END 42" RCP & PLUG

0+55.40 LAT. 'B-17'=
PAV. STA. 3+23.50,
32.0' LT.
10' REC. INLET
T.C. 625.61
F.L. 622.61

CARRAMERICA REALTY
LIMITED PARTNERSHIP

0+19.71 LAT. 'B-18'=
PAV. STA. 3+78.86, 32.0' RT.
10' REC. INLET
T.C. 625.70
F.L. 621.70

0+00 LAT. 'B-18'=
PAV. STA. 3+78.86, 15.0' RT.
CONN. TO EX. 60" RCP
BEGIN 18" RCP

PAV. STA. 51+95.34' LT.
10' REC. INLET
T.C. 625.68
F.L. 621.68

0+81.27 LAT. 'B-21'
END 24" RCP

0+57.68 LAT. 'B-21'
END 42" RCP
BEGIN 24" RCP

0+52.67 LAT. 'B-21'=
0+00 LAT. 'B-19'
60° FACTORY WYE

0+17.50 LAT. 'B-21'=
PAV. STA. 52+61.69, 34.00' LT.
P.I.

PAV. STA. 4+86.06, 49.04' LT.
END LAT. 'B-22'
PLUG 24" RCP
F.L. 621.82

LAT. 'B-22'
15 L.F. 24" RCP
ON 0.40%

NOTE:
VERIFY LOCATION OF
EXISTING 60" & 66" RCP
PRIOR TO CONSTRUCTING
LATERALS B-17, B-18, B-19
B-20, B-21, B-23 & B-24

0+55.14 LAT. 'B-23'=
PAV. STA. 4+96.50, 32.0' LT.
10' REC. INLET
T.C. 625.72
F.L. 621.72
BEGIN 24" RCP
LAT. 'B-22'
F.L. 621.76

0+00 LAT. 'B-23'=
PAV. STA. 5+24.07, 15.0' RT.
CONN. TO EX. 66" RCP
BEGIN 24" RCP

0+00 LAT. 'B-21'=
PAV. STA. 4+77.87, 15.0' RT.
CONN. TO EX. 66" RCP
BEGIN 42" RCP

0+00 LAT. 'B-24'=
PAV. STA. 5+45.70, 15.0' RT.
CONN. TO EX. 66" RCP
BEGIN 18" RCP

0+20.40 LAT. 'B-24'=
PAV. STA. 5+35.50, 32.0' RT.
10' REC. INLET
T.C. 625.40
F.L. 621.40

TOWN OF ADDISON

NOTE:
VERIFY LOCATION, HORIZONTAL
& VERTICAL, OF ALL UTILITIES
PRIOR TO CONSTRUCTION OF
STORMWATER INLETS & PIPES

MCI BURIED CABLE. CONTACT
ADRIAN THEBAU 972/554-4127
48 HOURS PRIOR TO ANY
CONSTRUCTION IN THIS AREA.

BROOKS BURIED CABLE. CONTACT
THERESA HARDIN 972/753-1900
48 HOURS PRIOR TO ANY
CONSTRUCTION IN THIS AREA

LEGEND

ELECTRIC — OHE	WATER — W
○ LIGHT POLE	○ F.H. FIRE HYDRANT
□ POWER POLE	○ WM METER
— GUY WIRE	— T WATER VALVE
TELEPHONE — T	MISC.
○ TELEPHONE MANHOLE	X X X 48" RCP, REMOVAL
□ TELEPHONE PEDESTAL	— CHAIN LINK FENCE
○ TELEPHONE SIGN	— WOOD FENCE
GAS — G	— EXISTING ASPHALT
○ GAS METER	— EXISTING DIRT OR GRAVEL
○ GAS SIGN	— EX. CONCRETE
LAND USE	— TREE/TREE LINE
R.R. RAILROAD SIGN	— EXISTING CURB
○ SIGN	— PROP. CURB
SURVEY	— EX. PROPERTY LINE
I.R. FOUND IRON ROD	— PROP. CENTERLINE
□ TEMP BENCHMARK	— PROP. R.O.W.
WASTEWATER — WW	— PROP. INLET
○ WASTEWATER MANHOLE	— P.V.M.T. TOP OF PAVEMENT
○ CLEANOUT	— T.C. TOP OF CURB
	— C.R. CURB RETURN

BENCHMARKS:
USC & GS E-921 DISK IN BRICK
WALL OF OLD ADDISON SCHOOL
HOUSE (MAGIC TIME MACHINE
RESTAURANT) ON SOUTH WALL,
4' EAST OF CENTER OF THE
ENTRANCE, 4.7' ABOVE THE
GROUND.
ELEV. 650.61

"I" ON SOUTHEAST CORNER OF
CONCRETE WALK AT FRONT
ENTRANCE TO 4805 ARAPAHO
ROAD.
ELEV. 630.61


THE SEAL APPEARING ON THIS
DOCUMENT WAS AUTHORIZED BY
KENNETH A. ROBERTS, P.E. 55446
ON OCTOBER 24, 1997

10-20-97

STORMWATER PLAN & PROFILE
LINE 'B-2'
ARAPAHO ROAD
ADDISON ROAD TO DALLAS NORTH TOLLWAY
TOWN OF ADDISON, TEXAS

Hutt-Zollars, Inc./Consulting Engineers
Dallas, Fort Worth, Houston, Phoenix, Tucson


DESIGN	DRAWN	APPR.	SCALE	DATE	PROJECT NO.	NO.
HZI	HZI	KAR	H ₁ "=20' V ₁ "=6'	OCT 97	1772-01	ST-8

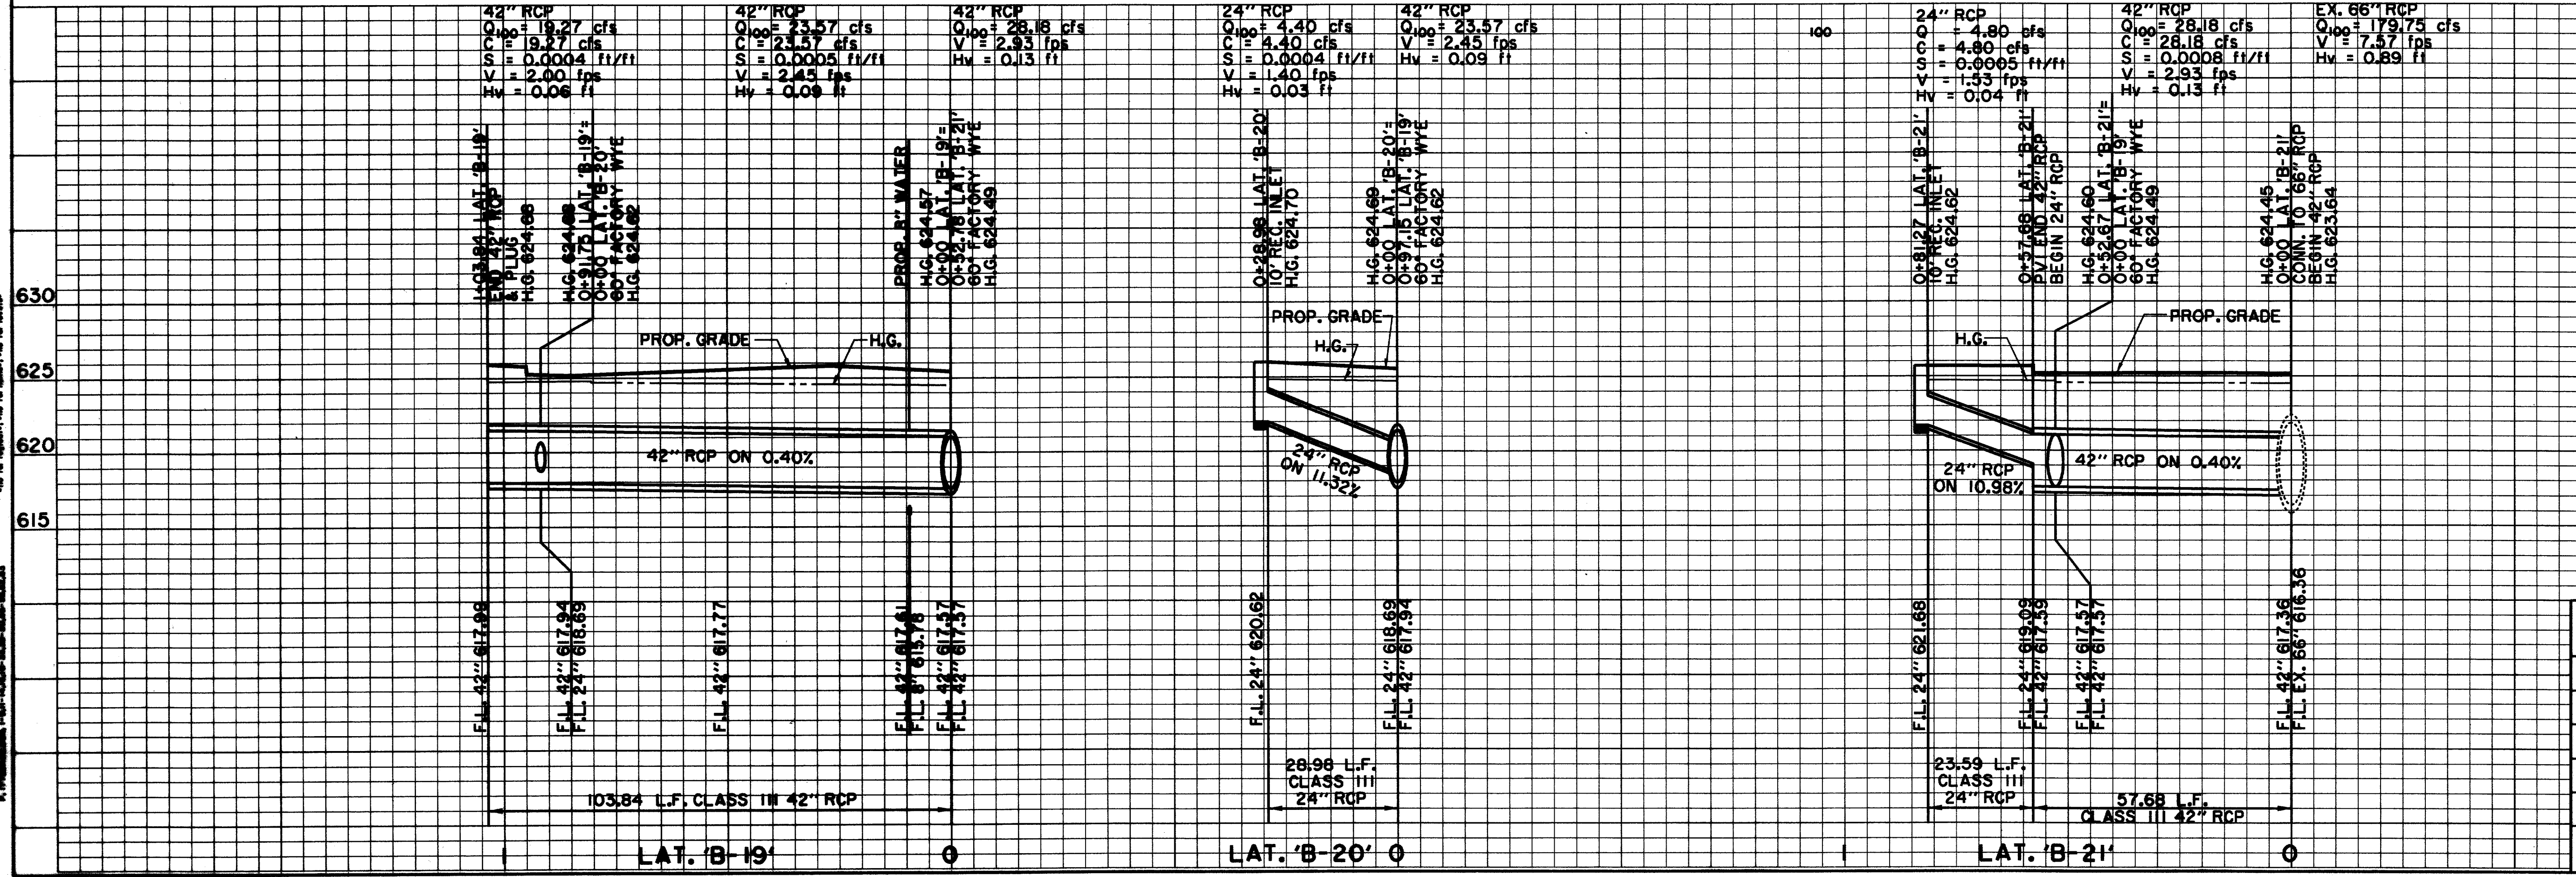

Vertical text on the left margin containing project details and dates.


TOWN OF ADDISON

TOWN OF ADDISON

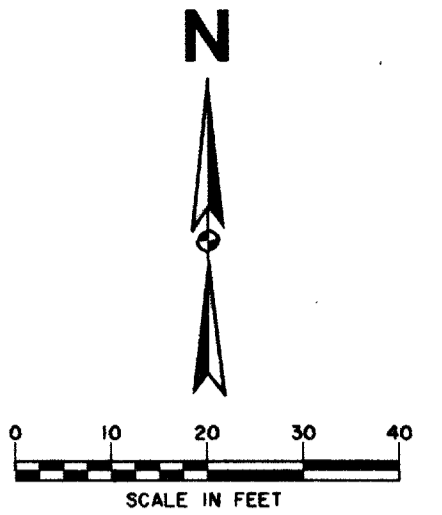


NOTE: VERIFY LOCATION, HORIZONTAL & VERTICAL, OF ALL UTILITIES PRIOR TO CONSTRUCTION OF STORMWATER INLETS & PIPES

THESE RECORD DOCUMENTS HAVE BEEN PREPARED BASED ON INFORMATION PROVIDED BY OTHERS. THE CONSULTANT HAS NOT VERIFIED THE ACCURACY AND/OR COMPLETENESS OF THIS INFORMATION AND SHALL NOT BE RESPONSIBLE FOR ANY ERRORS OR OMISSIONS THAT MAY BE INCORPORATED AS A RESULT OF ERRONEOUS INFORMATION PROVIDED BY OTHERS.

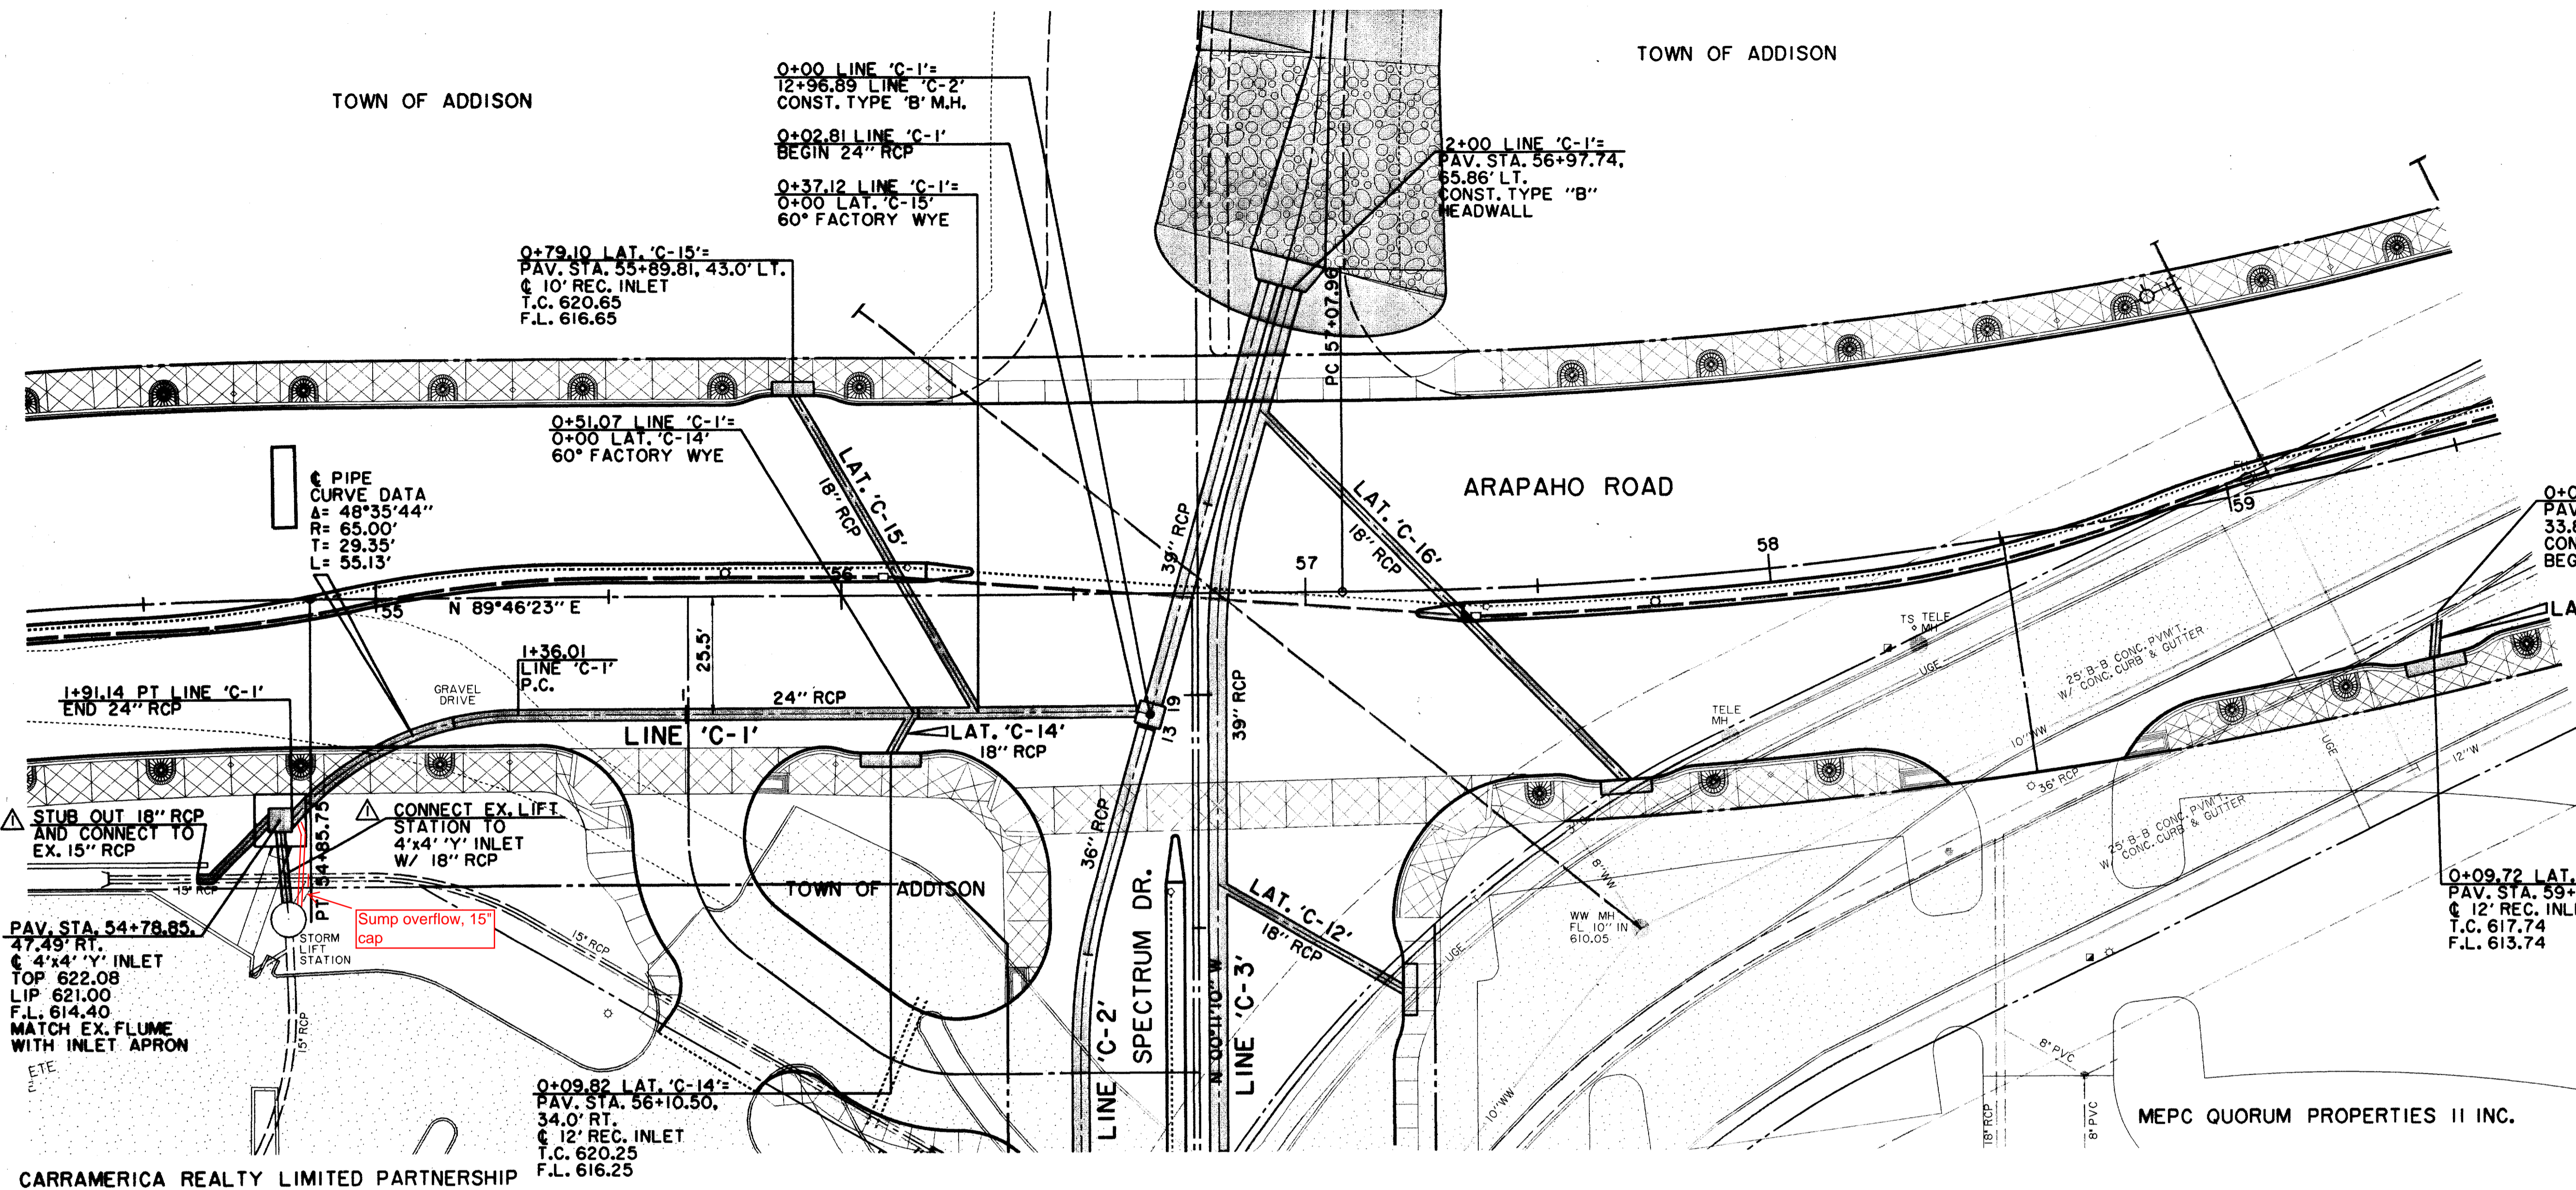

LEGEND table with symbols for Electric, Telephone, Land Use, Survey, Wastewater, Water, and Misc. items.

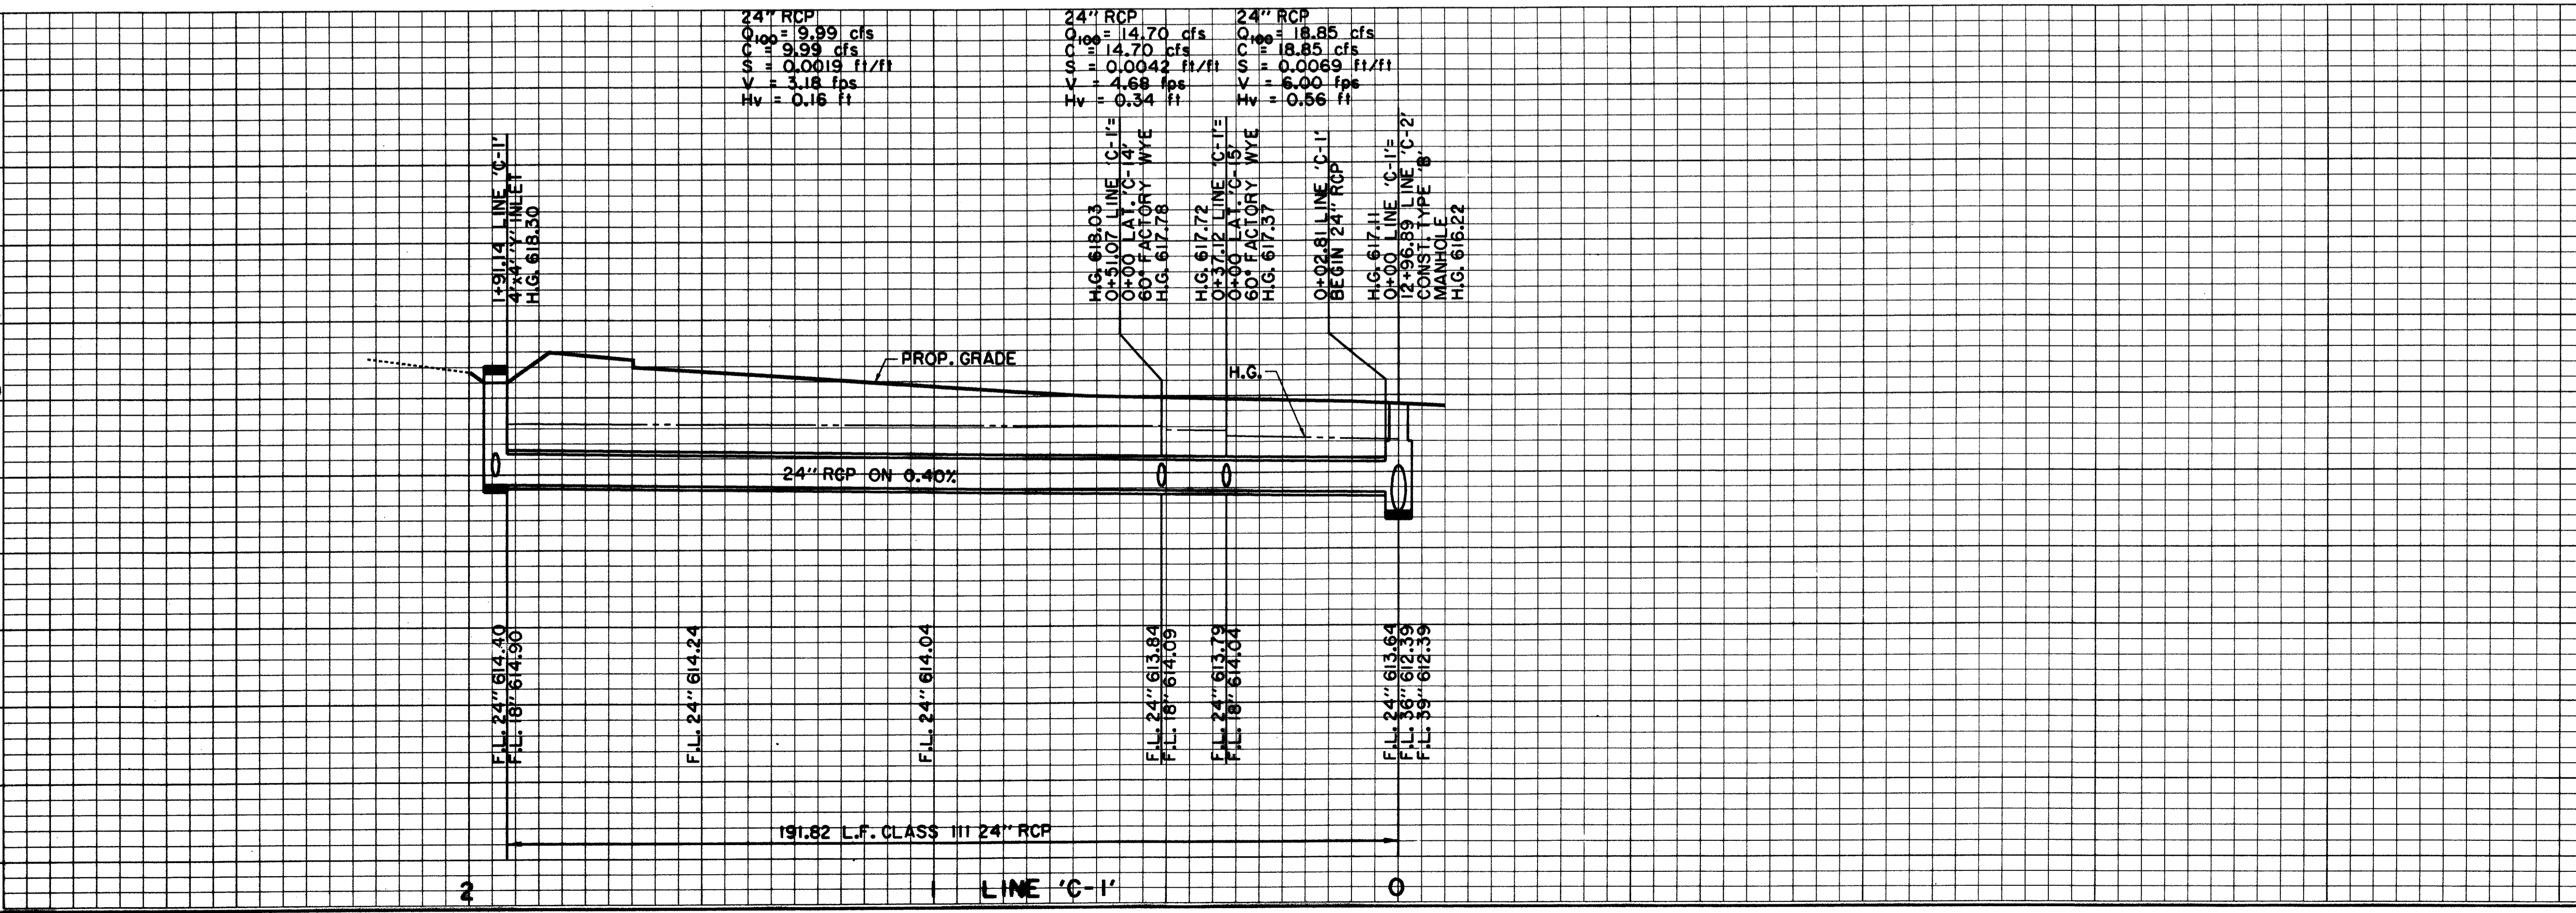


BENCHMARKS: USC & GS E-921 DISK IN BRICK WALL OF OLD ADDISON SCHOOL HOUSE... 'C' ON SOUTHEAST CORNER OF CONCRETE WALK AT FRONT ENTRANCE TO 4805 ARAPAHO ROAD.

THE SEAL APPEARING ON THIS DOCUMENT WAS AUTHORIZED BY KENNETH A. ROBERTS, P.E. 55446 ON OCTOBER 24, 1997. Includes professional seal and signature.


Project information table including title 'STORMWATER PLAN & PROFILE ARAPAHO ROAD', designer 'Hull-Zollars, Inc.', and project number 'ST-9'.

Vertical text on the left margin containing project details and dates.

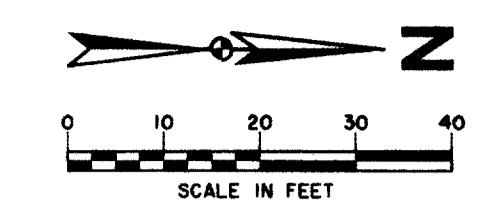


NOTE: VERIFY LOCATION, HORIZONTAL & VERTICAL, OF ALL UTILITIES PRIOR TO CONSTRUCTION OF STORMWATER INLETS & PIPES

THESE RECORD DOCUMENTS HAVE BEEN PREPARED BASED ON INFORMATION PROVIDED BY OTHERS. THE CONSULTANT HAS NOT VERIFIED THE ACCURACY AND/OR COMPLETENESS OF THIS INFORMATION AND SHALL NOT BE RESPONSIBLE FOR ANY ERRORS OR OMISSIONS THAT MAY BE INCORPORATED AS A RESULT OF ERRONEOUS INFORMATION PROVIDED BY OTHERS.

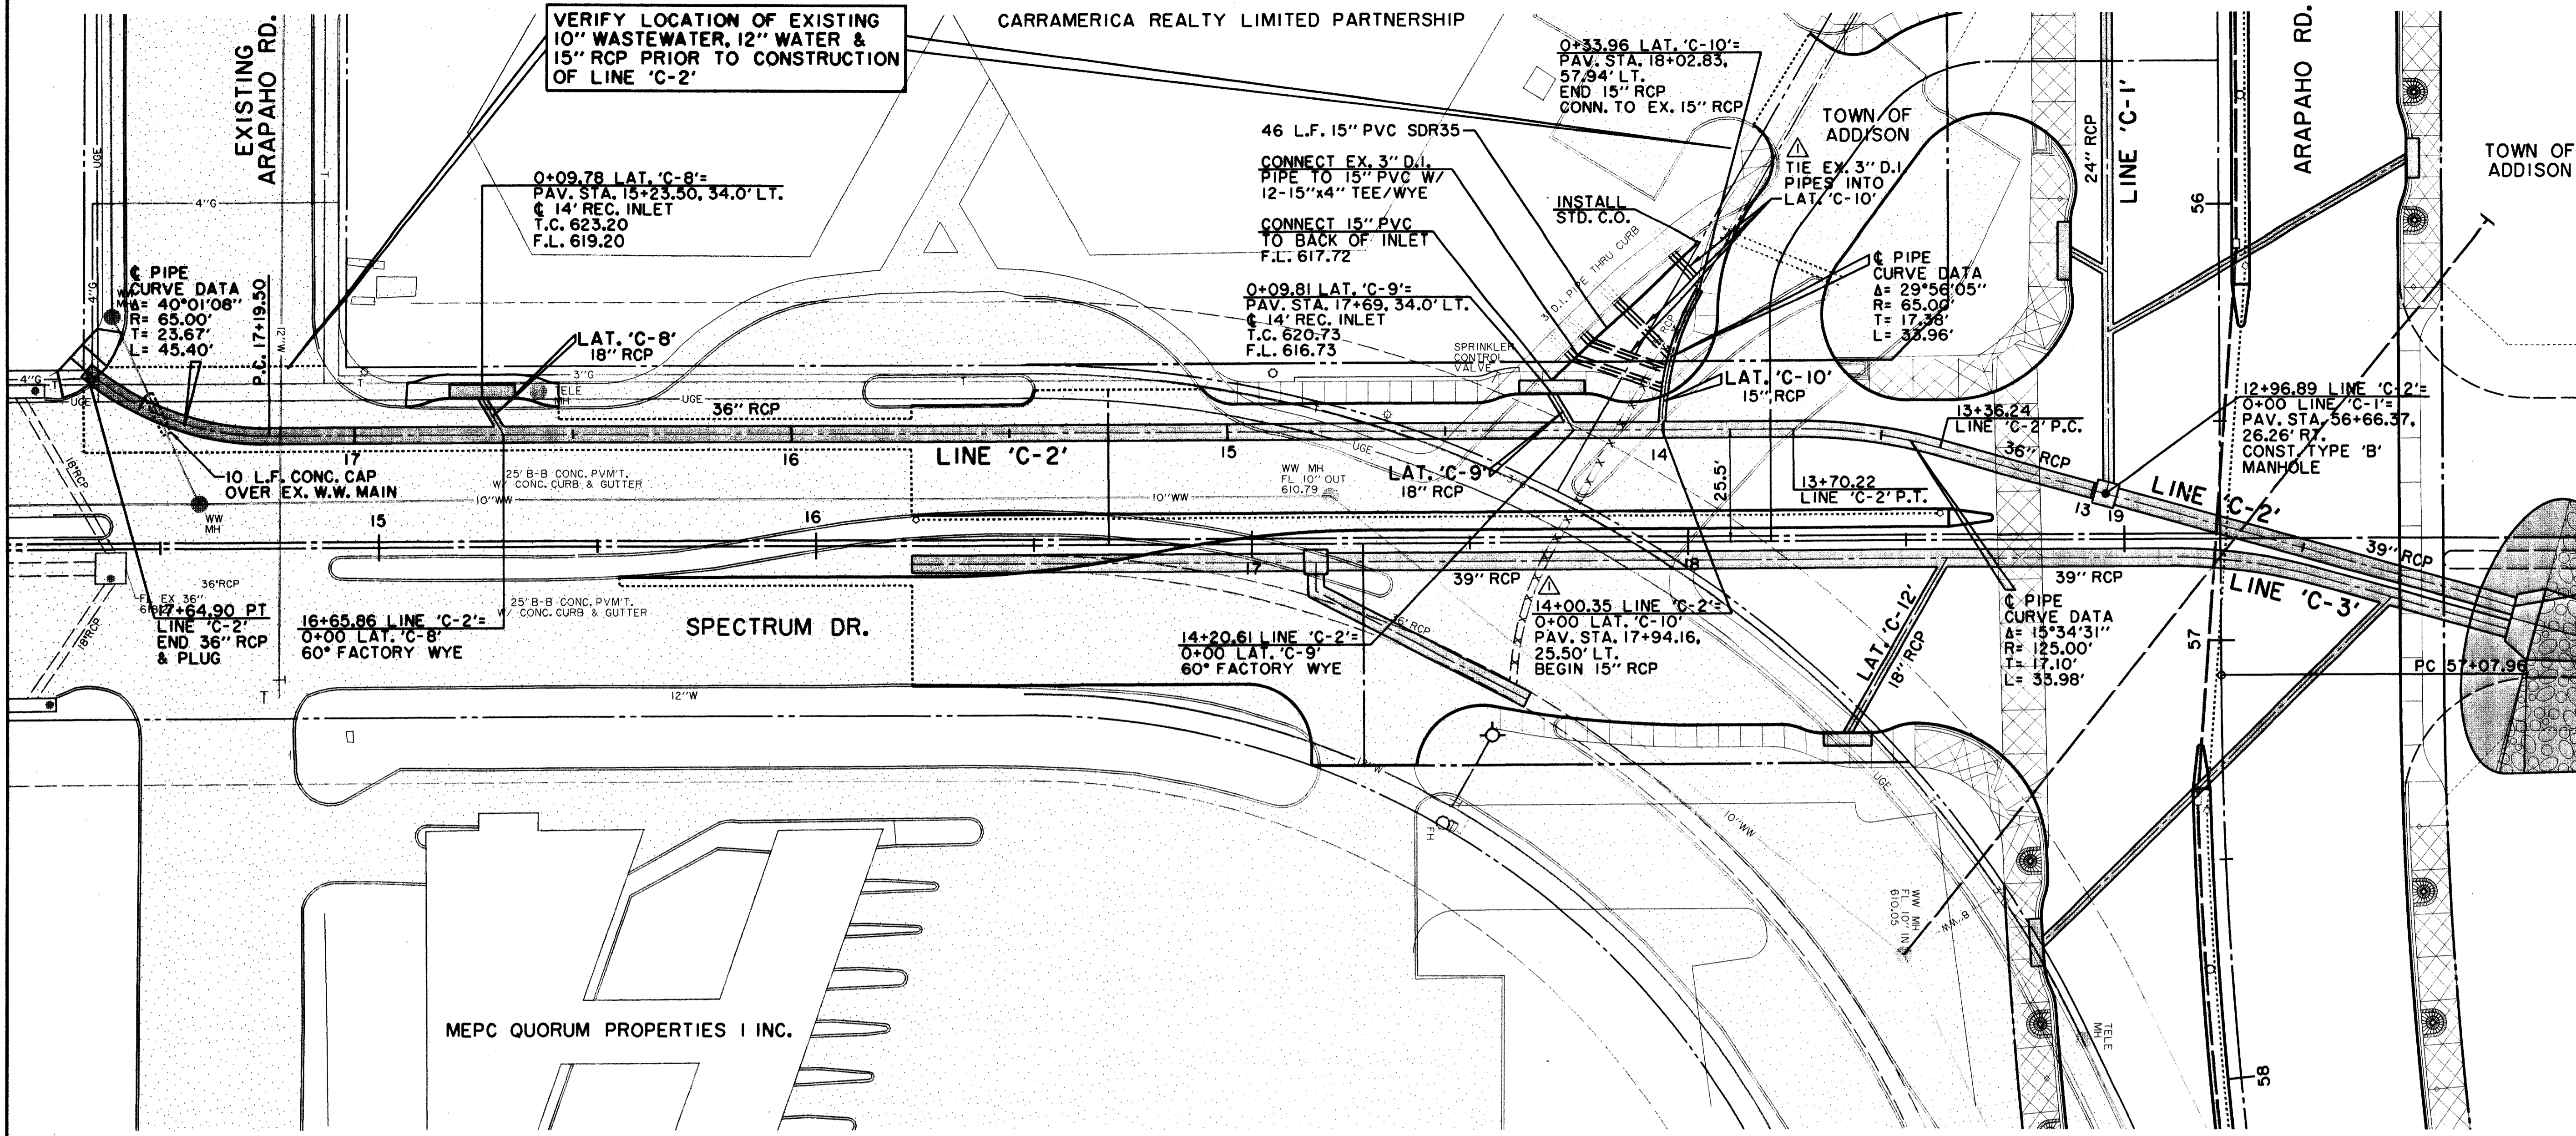


LEGEND

ELECTRIC — OH —	WATER — W —
○ LIGHT POLE	FH FIRE HYDRANT
PP POWER POLE	WM METER
— GUY WIRE	T WATER VALVE
TELEPHONE — T —	MISC.
TELEPHONE MANHOLE	X R.C.P. REMOVAL
TELEPHONE PEDESTAL	— CHAIN LINK FENCE
TELEPHONE SIGN	— WOOD FENCE
GAS — G —	— EXISTING ASPHALT
GAS METER	— EXISTING DIRT OR GRAVEL
GAS SIGN	— EX. CONCRETE
LAND USE	— TREE/TREE LINE
RAILROAD SIGN	— EXISTING CURB
SURVEY	— PROP. CURB
FOUND IRON ROD	— PROP. PROPERTY LINE
TEMP BENCHMARK	— PROP. CENTERLINE
WASTEWATER — WW —	— PROP. R.O.W.
WASTEWATER MANHOLE	— PROP. INLET
CLEANOUT	PVMT TOP OF PAVEMENT
	T.C. TOP OF CURB
	C.R. CURB RETURN

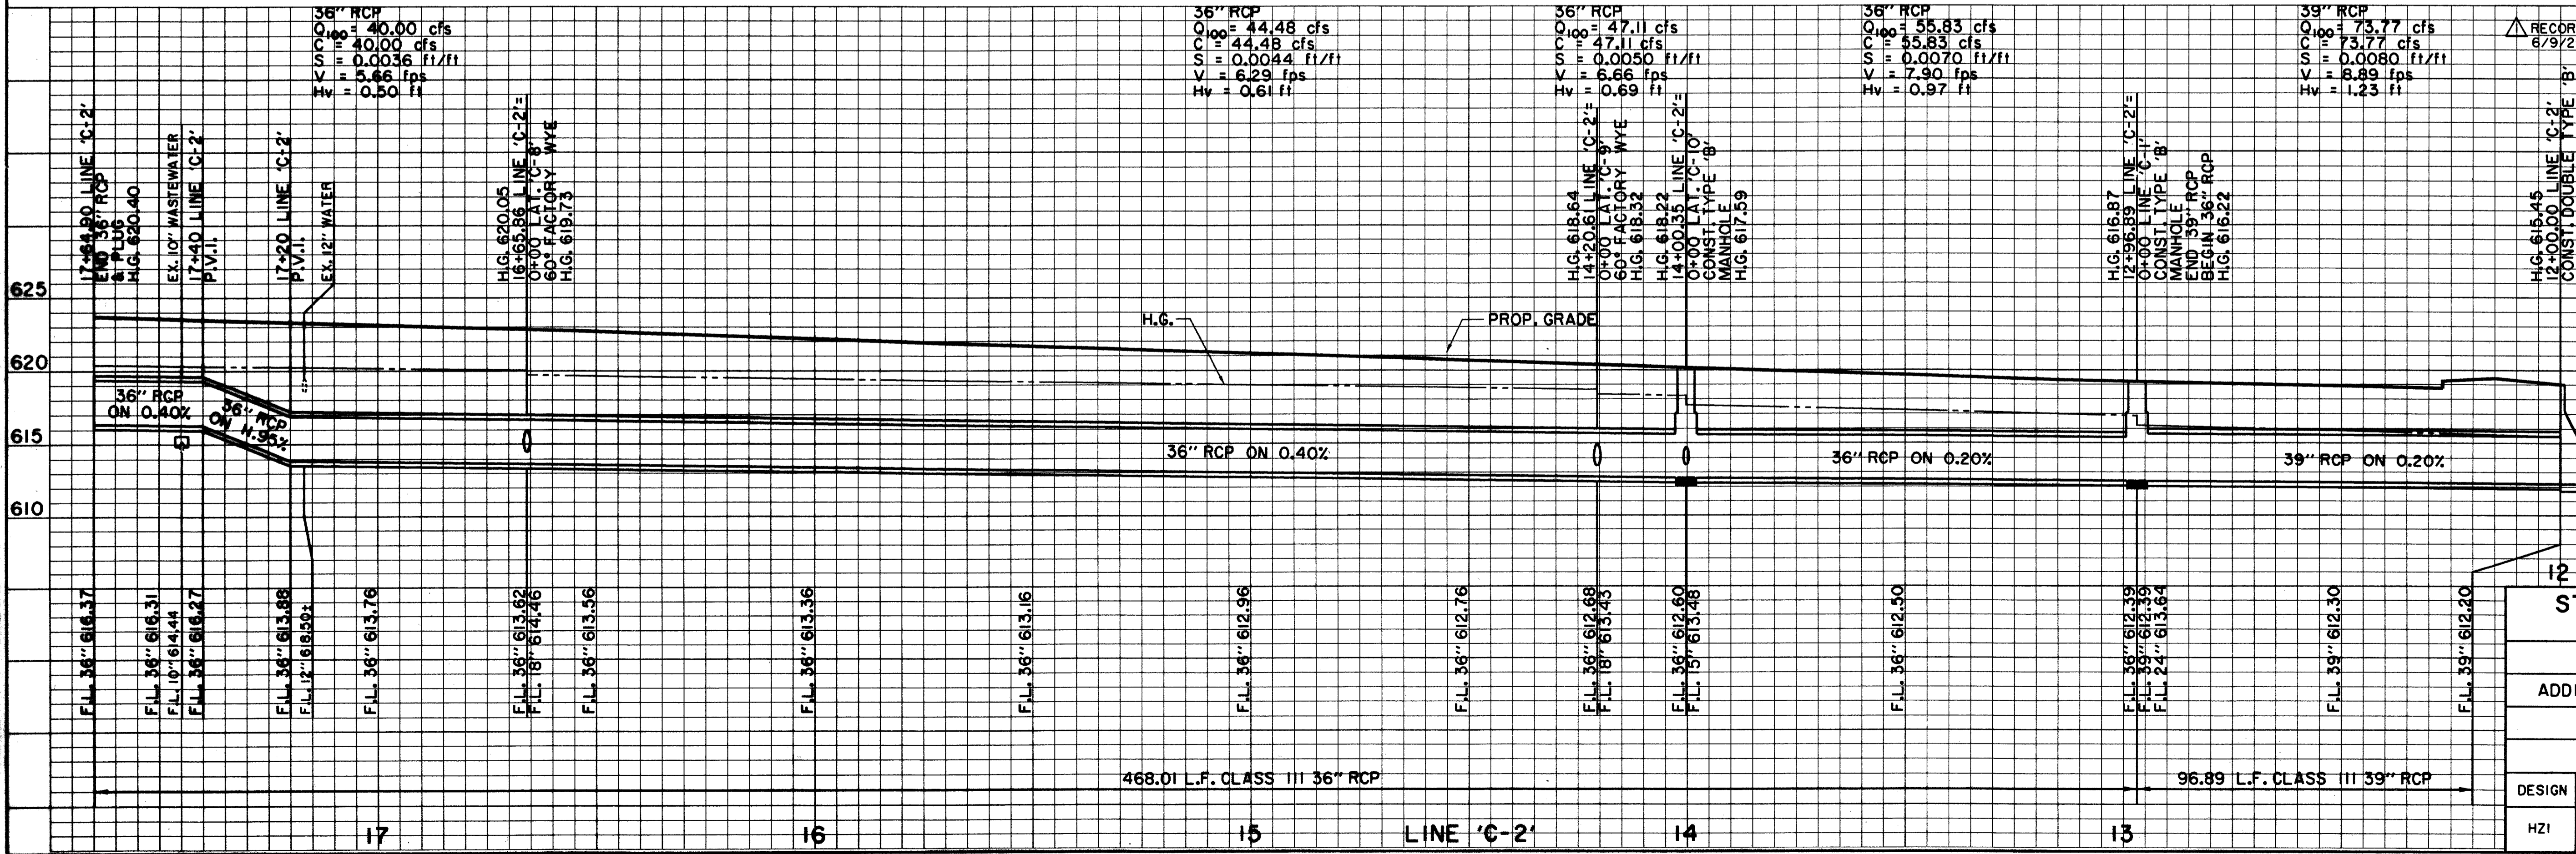


RECORD DOCUMENTS 6/9/2000

BENCHMARKS:
 USC & GS E-921 DISK IN BRICK WALL OF OLD ADDISON SCHOOL HOUSE (MAGIC TIME MACHINE RESTAURANT) ON SOUTH WALL, 4' EAST OF CENTER OF THE ENTRANCE, 4.7' ABOVE THE GROUND. ELEV. 650.61
 "I" ON SOUTHEAST CORNER OF CONCRETE WALK AT FRONT ENTRANCE TO 4805 ARAPAHO ROAD. ELEV. 630.61

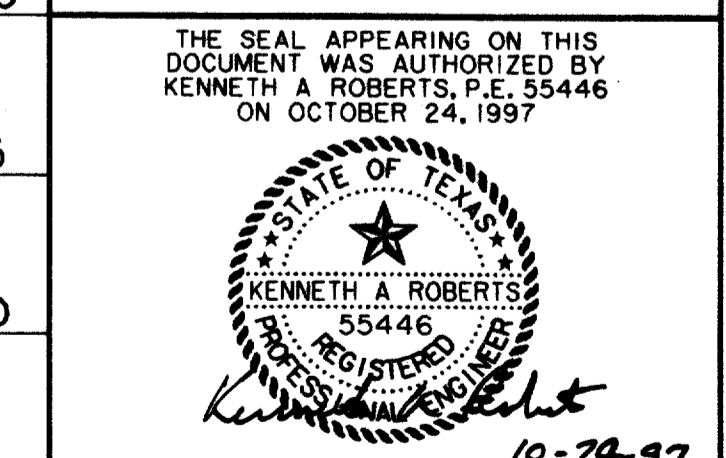

STORMWATER PLAN & PROFILE						
ARAPAHO ROAD						
ADDISON ROAD TO DALLAS NORTH TOLLWAY						
TOWN OF ADDISON, TEXAS						
Huitt-Zollers, Inc./Consulting Engineers Dallas, Fort Worth, Houston, Phoenix, Tustin						
DESIGN	DRAWN	APPR.	SCALE	DATE	PROJECT NO.	NO.
HZI	HZI	KAR	H ₁ 1"=20' V ₁ 1"=6'	OCT 97	1772-01	ST-10

PROJECT: 177201.dgn 17720605.DWG
 DATE: 10/24/97
 DRAWN BY: HZI
 CHECKED BY: HZI
 APPR. BY: KAR
 SCALE: H₁ 1"=20', V₁ 1"=6'
 DATE: OCT 97
 PROJECT NO.: 1772-01
 SHEET NO.: ST-10

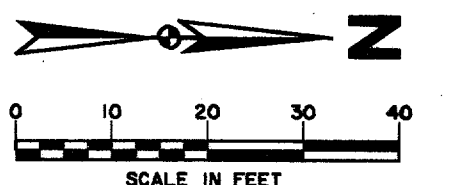

NOTE:
VERIFY LOCATION, HORIZONTAL & VERTICAL, OF ALL UTILITIES PRIOR TO CONSTRUCTION OF STORMWATER INLETS & PIPES

RECORD DOCUMENTS 6/9/2000

THESE RECORD DOCUMENTS HAVE BEEN PREPARED BASED ON INFORMATION PROVIDED BY OTHERS. THE CONSULTANT HAS NOT VERIFIED THE ACCURACY AND/OR COMPLETENESS OF THIS INFORMATION AND SHALL NOT BE RESPONSIBLE FOR ANY ERRORS OR OMISSIONS THAT MAY BE INCORPORATED AS A RESULT OF ERRONEOUS INFORMATION PROVIDED BY OTHERS.

12+27.49 LINE 'C-3'=
0+00 LAT. 'C-16'
60° FACTORY WYE

12+45.26
LINE 'C-3'
P.C.



12+00.00 LINE 'C-3'=
PAV. STA. 56+97.67, 65.60' LT.
CONST. DOUBLE TYPE 'B'
HEADWALL FOR 42" RCP

LEGEND

ELECTRIC — ONE	WATER — W
○ LIGHT POLE	FH FIRE HYDRANT
pp POWER POLE	WM METER
← GUY WIRE	T WATER VALVE
TELEPHONE — T	MISC.
● TELEPHONE MANHOLE	48" RCP R.C.P. REMOVAL
□ TELEPHONE PEDESTAL	— CHAIN LINK FENCE
TS TELEPHONE SIGN	— WOOD FENCE
GM GAS METER	— EXISTING ASPHALT
GS GAS SIGN	— EXISTING DIRT OR GRAVEL
LAND USE	— EX. CONCRETE
R.R. RAILROAD SIGN	— TREE/TREE LINE
□ SIGN	— EXISTING CURB
SURVEY	— PROP. CURB
I.R. FOUND IRON ROD	— EX. PROPERTY LINE
□ TEMP BENCHMARK	— PROP. CENTERLINE
WASTEWATER — WW	— PROP. R.O.W.
WM WASTEWATER MANHOLE	— PROP. INLET
CO CLEANOUT	— TOP OF PAVEMENT
	T.C. TOP OF CURB
	C.R. CURB RETURN

PIPE CURVE DATA
A = 15°34'31"
R = 125.00'
T = 17.10'
L = 33.98'

VERIFY LOCATION OF EXISTING 10" WASTEWATER & 36" RCP PRIOR TO CONSTRUCTION OF LINE 'C-3'

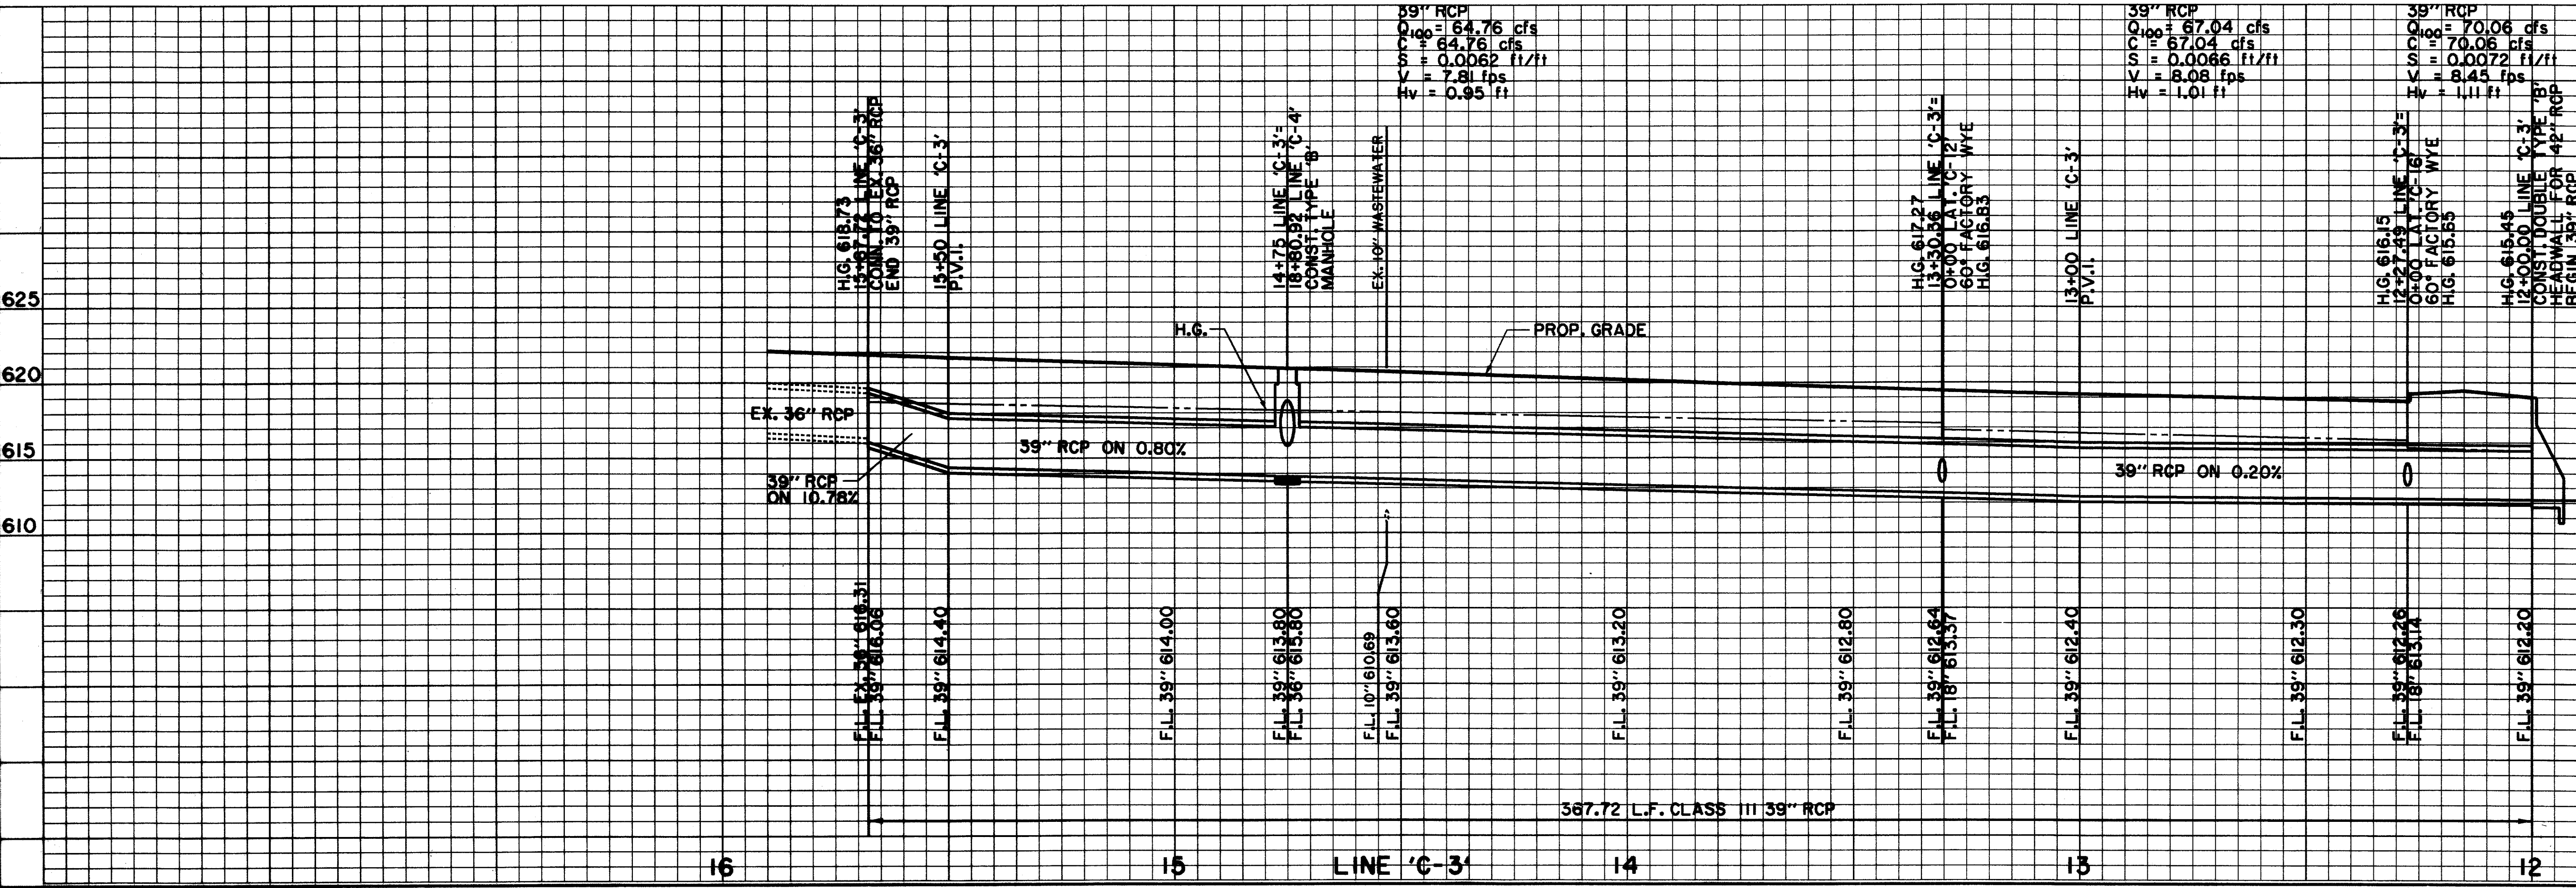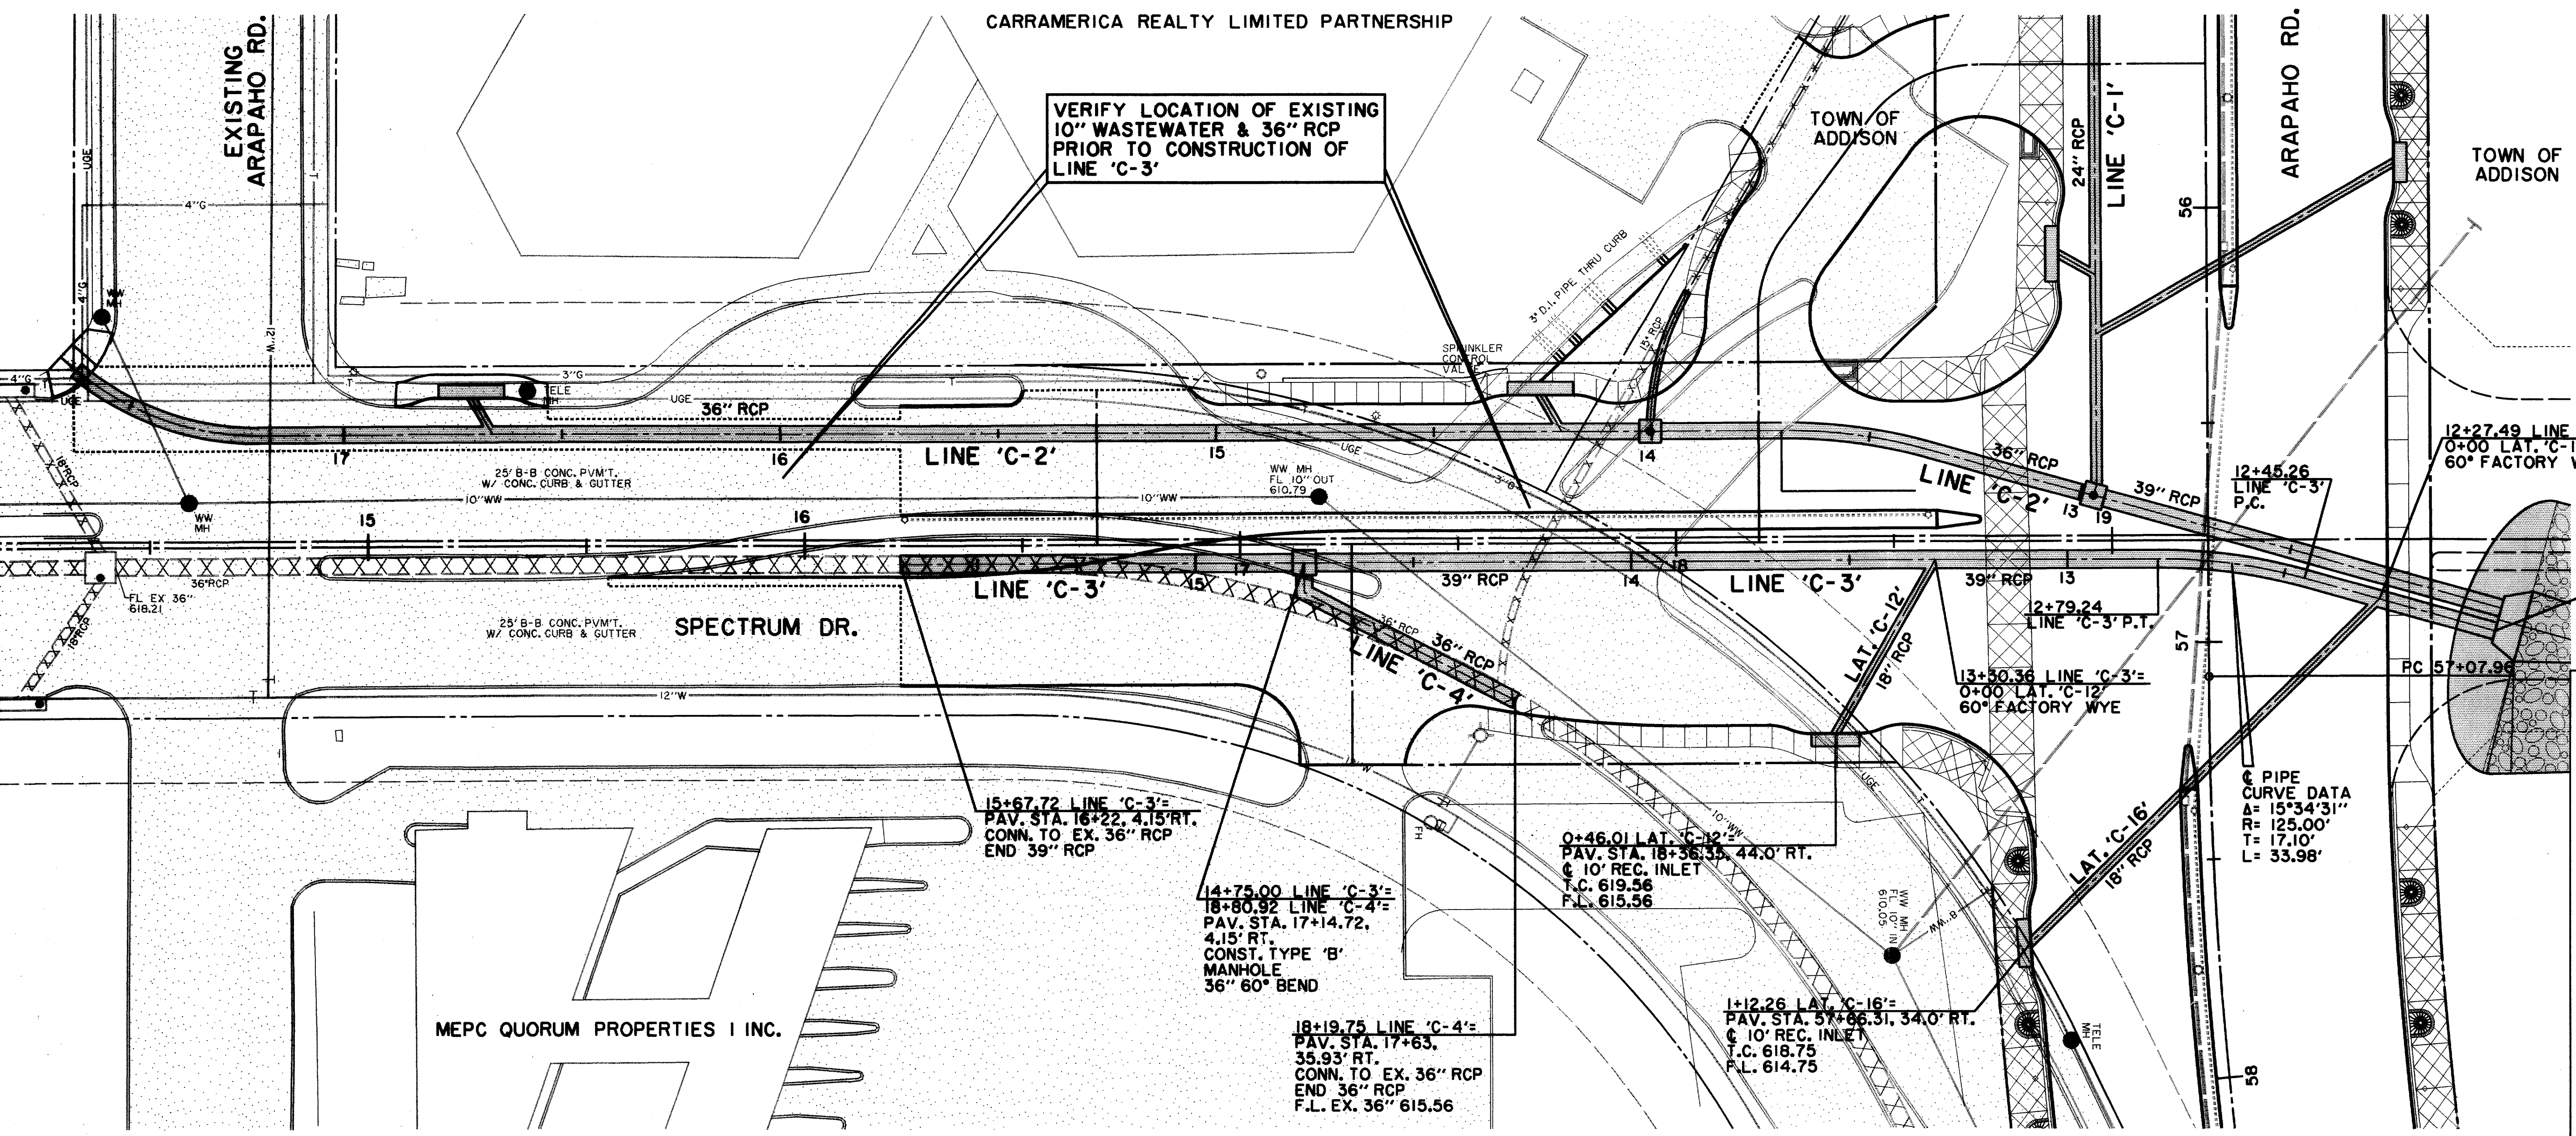

BENCHMARKS:

USC & GS E-921 DISK IN BRICK WALL OF OLD ADDISON SCHOOL HOUSE (MAGIC TIME MACHINE RESTAURANT) ON SOUTH WALL, 4' EAST OF CENTER OF THE ENTRANCE, 4.7' ABOVE THE GROUND, ELEV. 650.61

"□" ON SOUTHEAST CORNER OF CONCRETE WALK AT FRONT ENTRANCE TO 4805 ARAPAHO ROAD, ELEV. 630.61




THE SEAL APPEARING ON THIS DOCUMENT WAS AUTHORIZED BY KENNETH A. ROBERTS, P.E. 55446 ON OCTOBER 24, 1997

10-28-97

STORMWATER PLAN & PROFILE
LINE 'C-3'
ARAPAHO ROAD
ADDISON ROAD TO DALLAS NORTH TOLLWAY
TOWN OF ADDISON, TEXAS
Huitt-Zollars, Inc./Consulting Engineers
Dallas, Fort Worth, Houston, Phoenix, Austin

DESIGN	DRAWN	APPR.	SCALE	DATE	PROJECT NO.	NO.
HZI	HZI	KAR	H _v 1"=20' V _v 1"=6'	OCT 97	1772-01	ST-11


PROJECT: 177201.DGN/177201-01.DWG
 DATE: 10/28/97
 DRAWN BY: HZI
 CHECKED BY: HZI
 APPR. BY: KAR
 SCALE: H_v 1"=20', V_v 1"=6'
 DATE: OCT 97
 PROJECT NO.: 1772-01
 SHEET NO.: ST-11

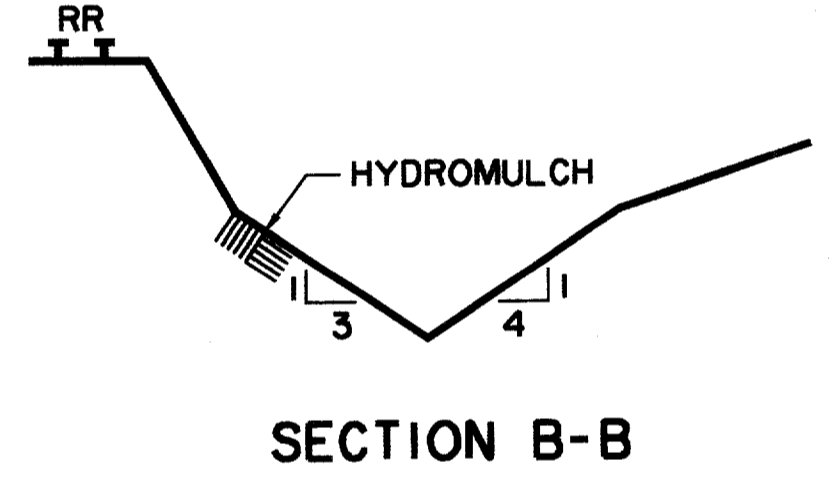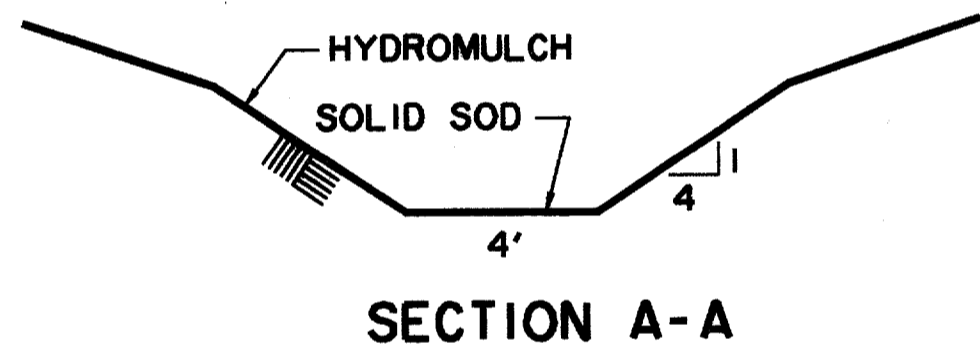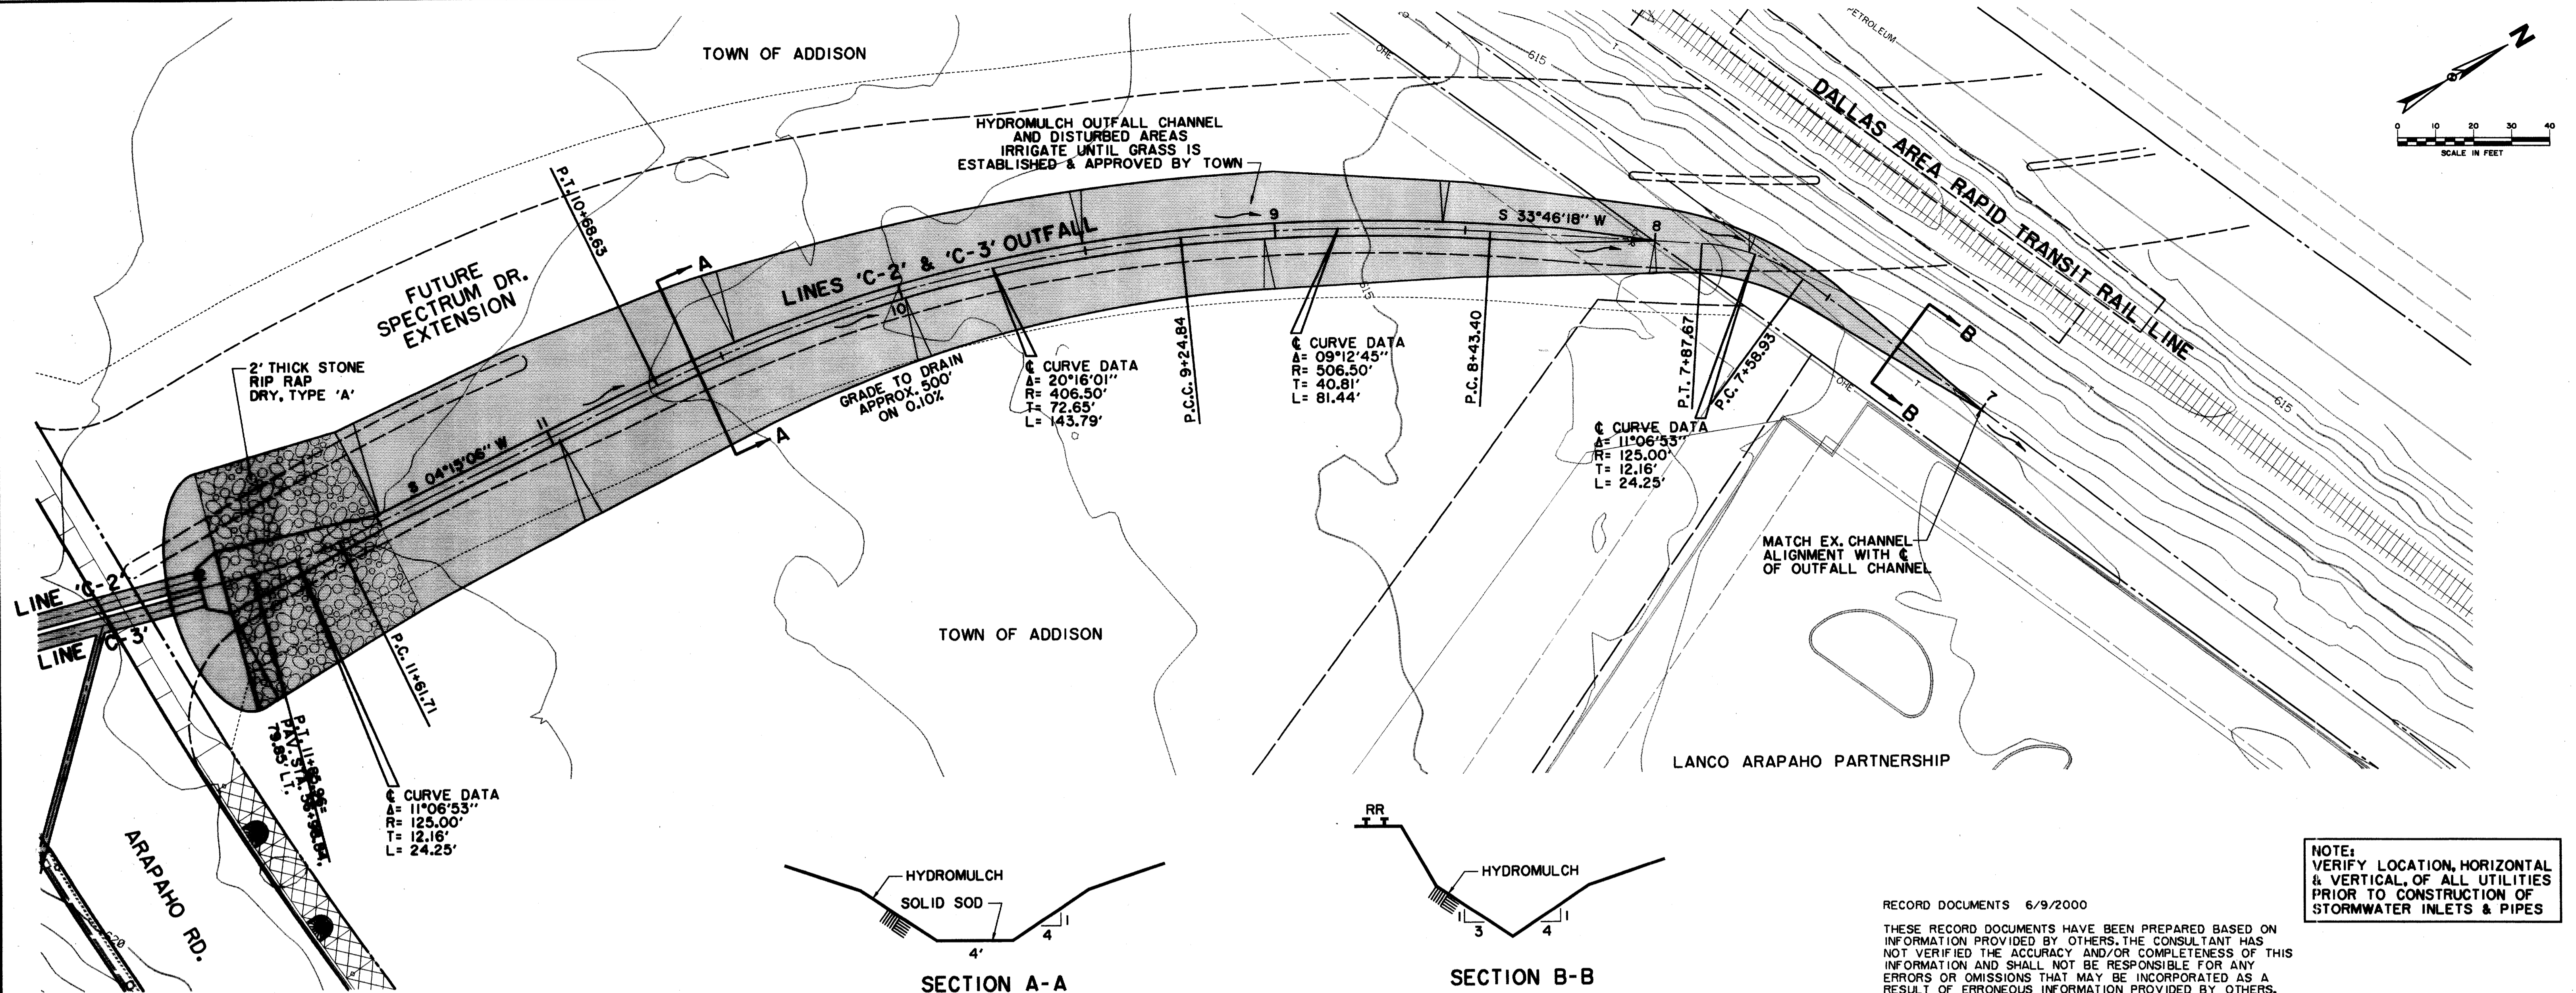

RECORD DOCUMENTS 6/9/2000

THESE RECORD DOCUMENTS HAVE BEEN PREPARED BASED ON INFORMATION PROVIDED BY OTHERS. THE CONSULTANT HAS NOT VERIFIED THE ACCURACY AND/OR COMPLETENESS OF THIS INFORMATION AND SHALL NOT BE RESPONSIBLE FOR ANY ERRORS OR OMISSIONS THAT MAY BE INCORPORATED AS A RESULT OF ERRONEOUS INFORMATION PROVIDED BY OTHERS.

NOTE:
 VERIFY LOCATION, HORIZONTAL & VERTICAL, OF ALL UTILITIES PRIOR TO CONSTRUCTION OF STORMWATER INLETS & PIPES

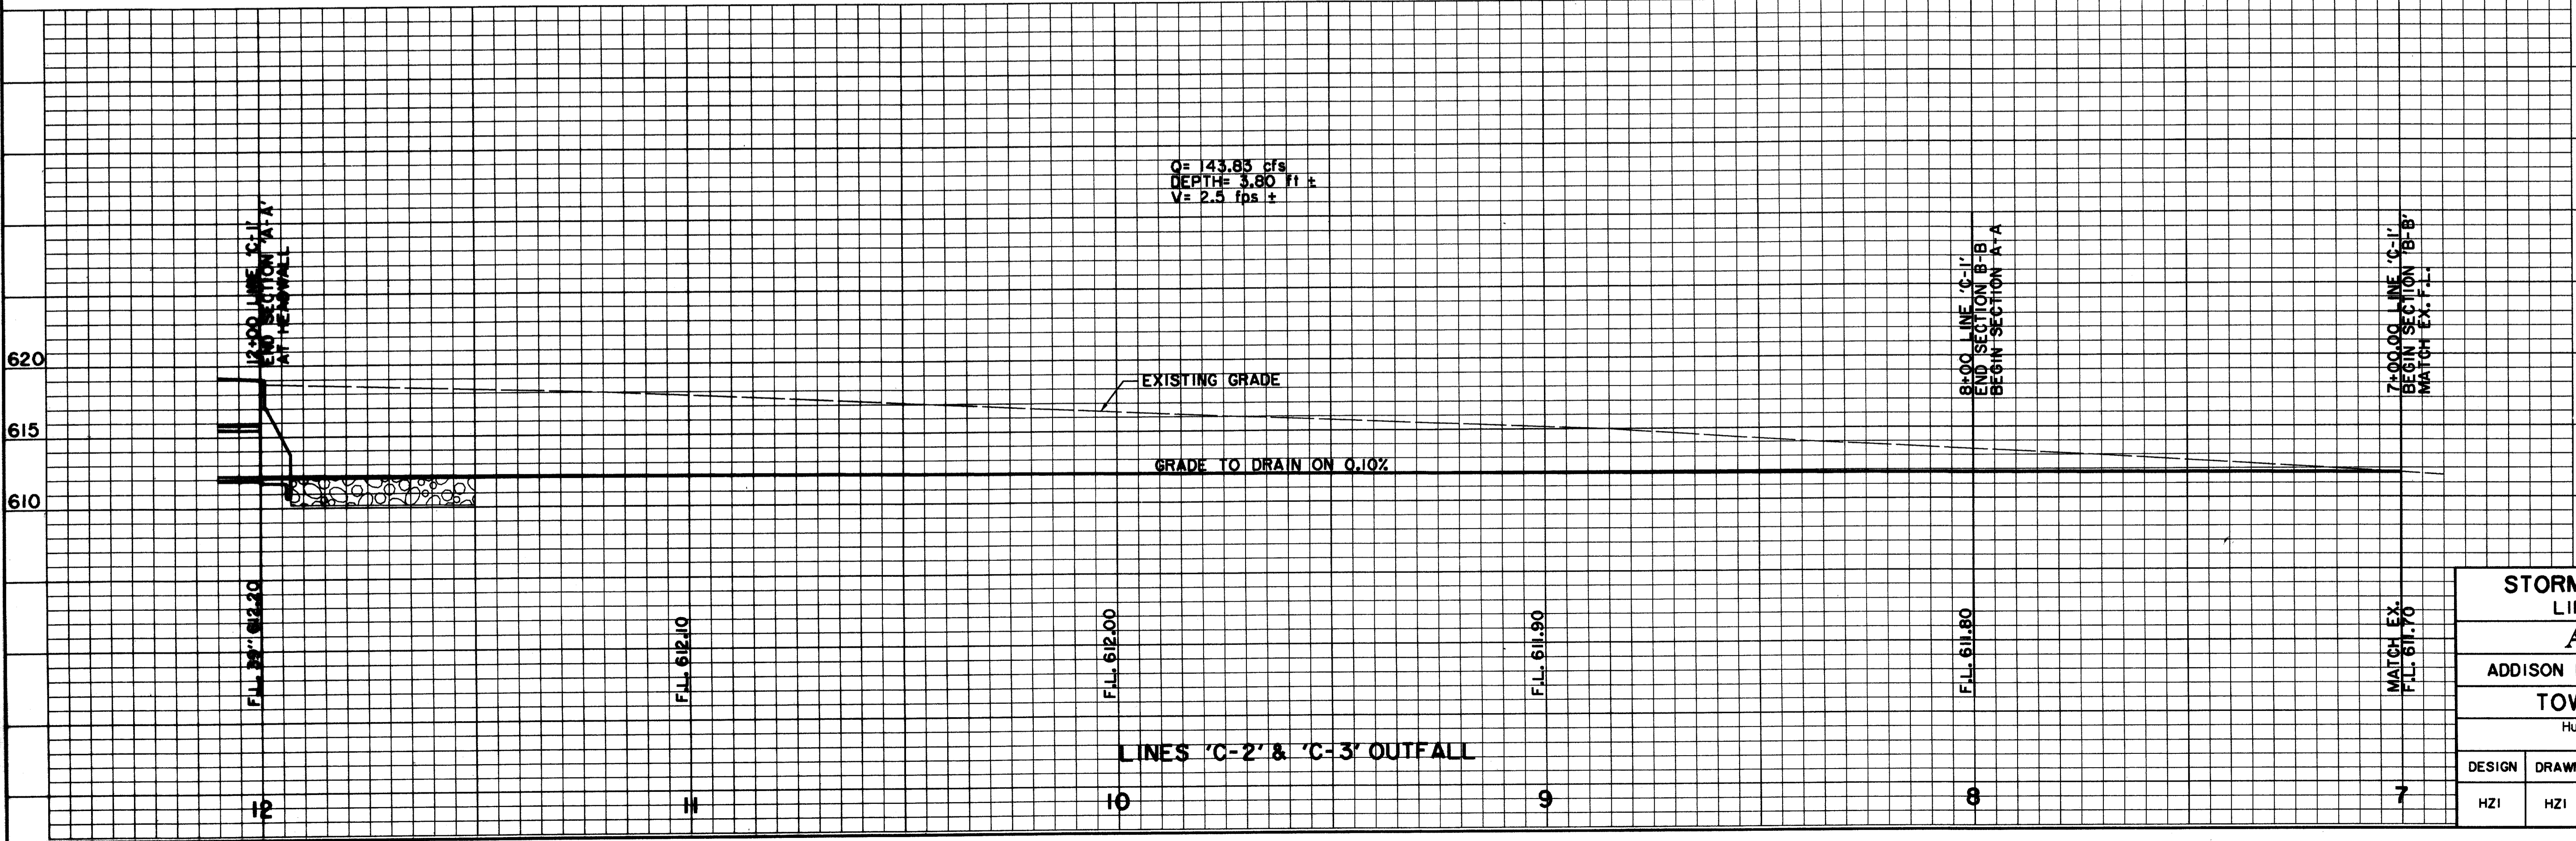

BENCHMARKS:
 USC & GS E-921 DISK IN BRICK WALL OF OLD ADDISON SCHOOL HOUSE (MAGIC TIME MACHINE RESTAURANT) ON SOUTH WALL, 4' EAST OF CENTER OF THE ENTRANCE, 4.7' ABOVE THE GROUND. ELEV. 650.61

"I" ON SOUTHEAST CORNER OF CONCRETE WALK AT FRONT ENTRANCE TO 4805 ARAPAHO ROAD. ELEV. 630.61

THE SEAL APPEARING ON THIS DOCUMENT WAS AUTHORIZED BY KENNETH A. ROBERTS, P.E. 55446 ON OCTOBER 24, 1997

STORMWATER PLAN & PROFILE						
LINES 'C-2' & 'C-3' OUTFALL						
ARAPAHO ROAD						
ADDISON ROAD TO DALLAS NORTH TOLLWAY						
TOWN OF ADDISON, TEXAS						
Huff-Zollars, Inc./Consulting Engineers Dallas, Fort Worth, Houston, Phoenix, Tustin						
DESIGN	DRAWN	APPR.	SCALE	DATE	PROJECT NO.	NO.
HZI	HZI	KAR	H _v 1"=20' V _v 1"=6'	OCT 97	1772-01	ST-12


CONSTRUCTION OF THIS PROJECT IS SUBJECT TO THE APPROVAL OF THE TOWN OF ADDISON AND THE LANCOS ARAPAHO PARTNERSHIP.

THESE RECORD DOCUMENTS HAVE BEEN PREPARED BASED ON INFORMATION PROVIDED BY OTHERS. THE CONSULTANT HAS NOT VERIFIED THE ACCURACY AND/OR COMPLETENESS OF THIS INFORMATION AND SHALL NOT BE RESPONSIBLE FOR ANY ERRORS OR OMISSIONS THAT MAY BE INCORPORATED AS A RESULT OF ERRONEOUS INFORMATION PROVIDED BY OTHERS.


LANCO ARAPAHO PARTNERSHIP

CHATAHOOCHEE LEASING CORPORATION

MEPC QUORUM PROPERTIES II INC.

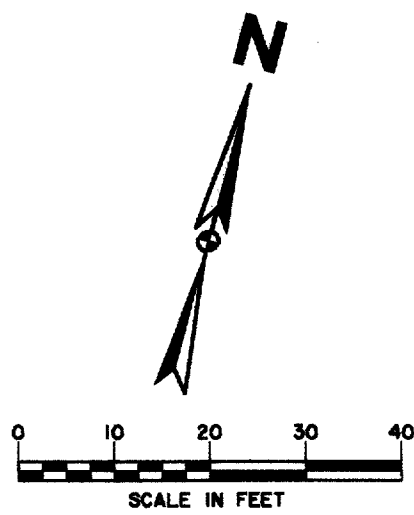

NOTE: VERIFY LOCATION, HORIZONTAL & VERTICAL, OF ALL UTILITIES PRIOR TO CONSTRUCTION OF STORMWATER INLETS & PIPES

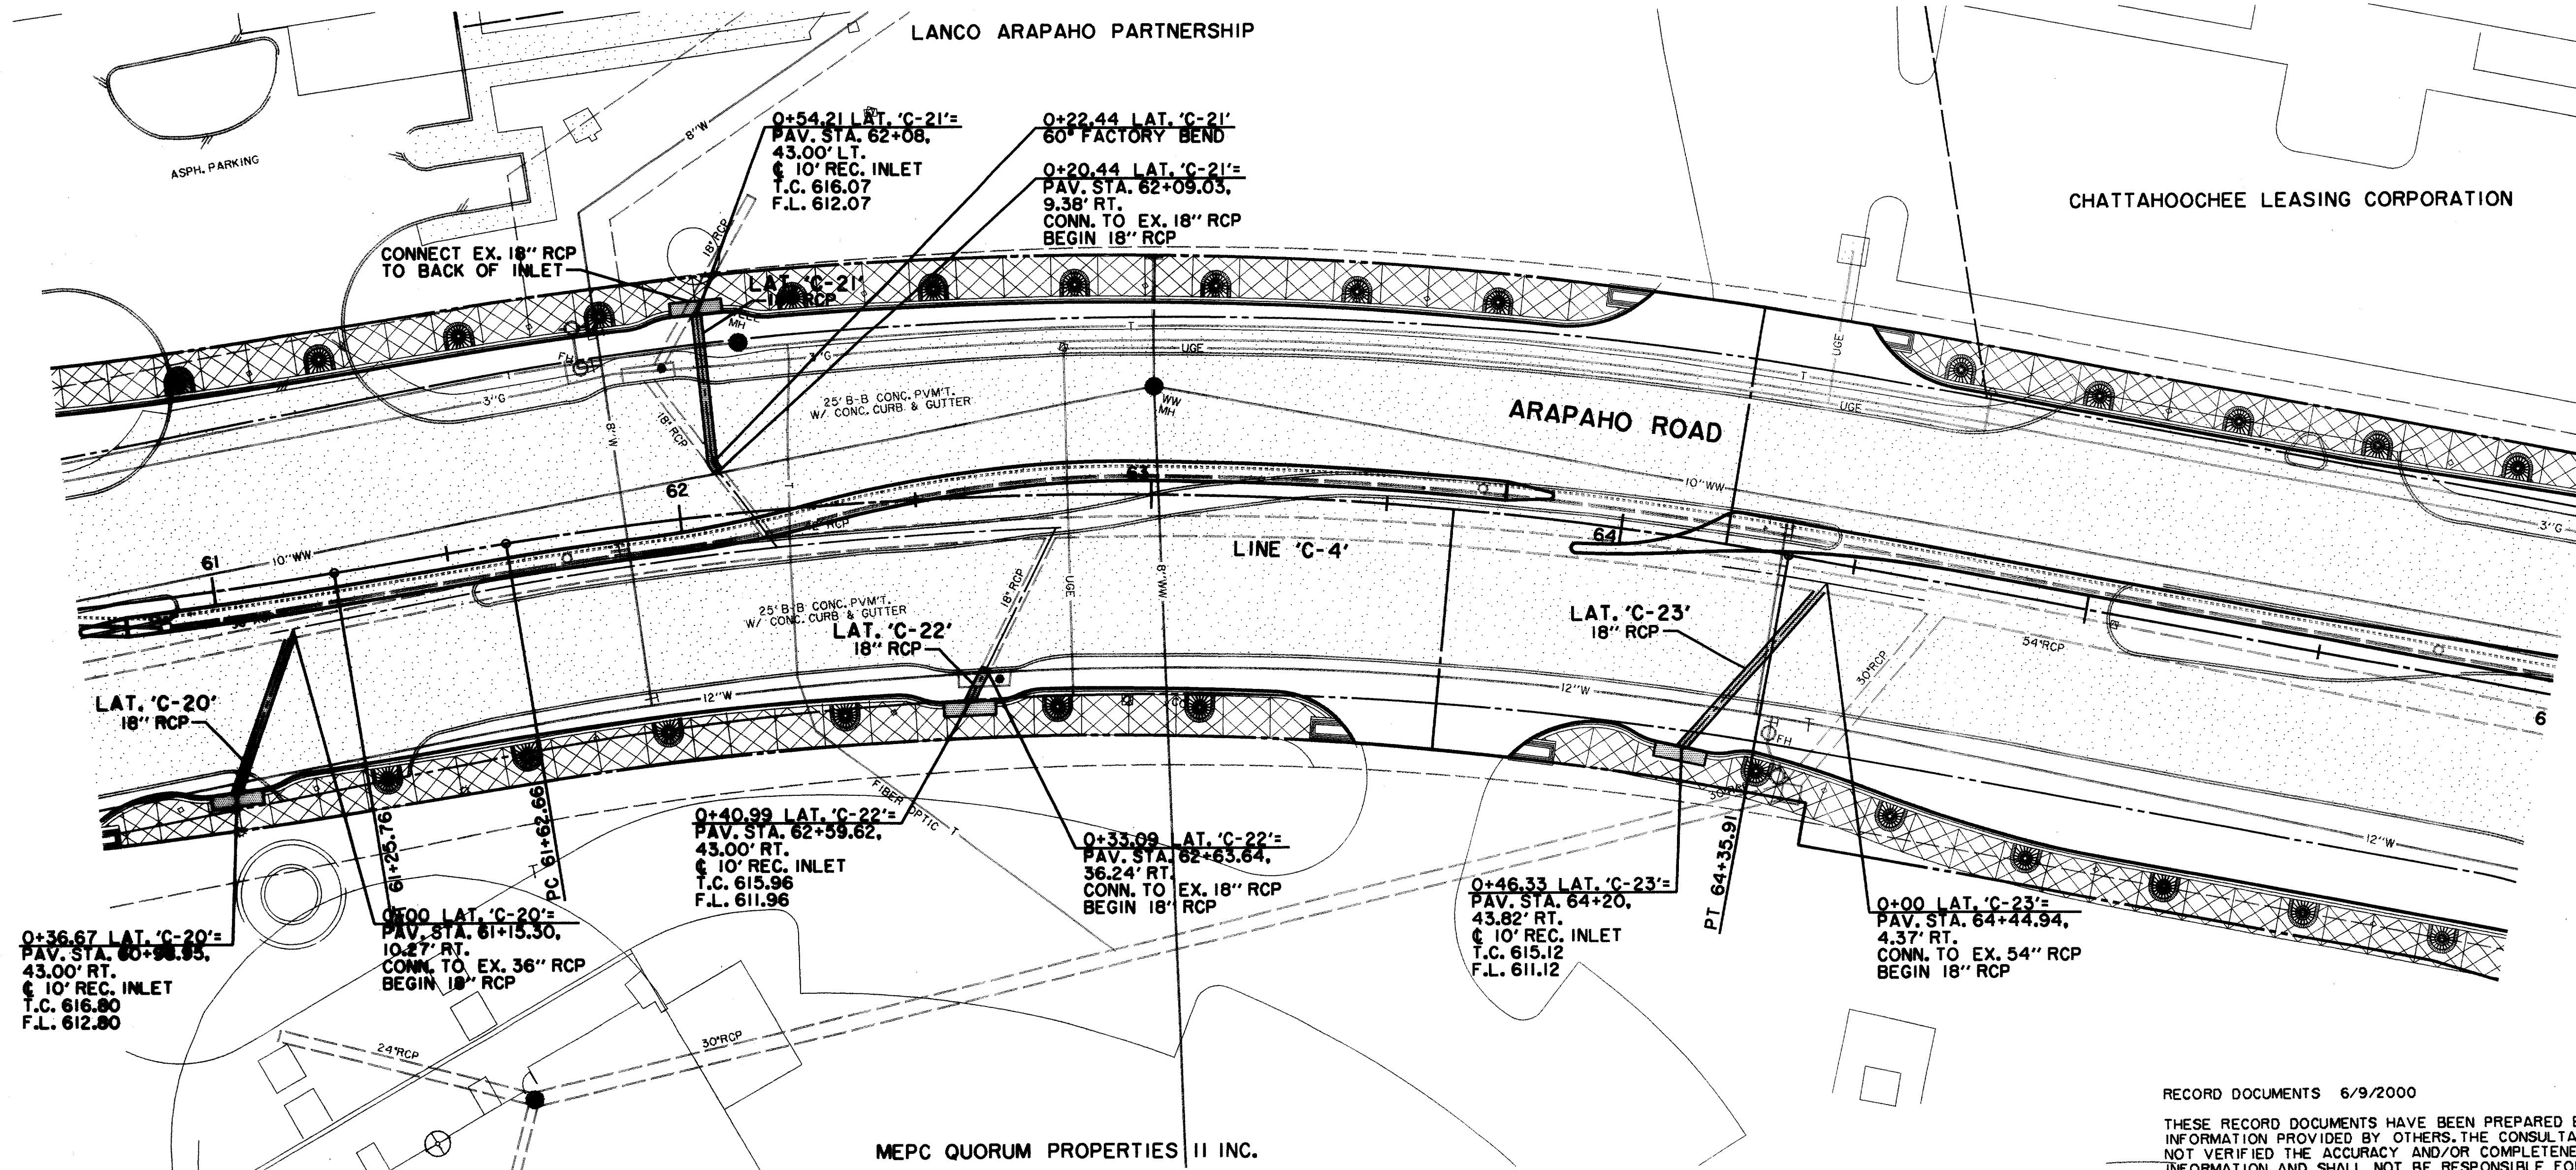

LEGEND

ELECTRIC — OHE	WATER — W
○ LIGHT POLE	FH ○ FIRE HYDRANT
PP ○ POWER POLE	WM ○ METER
— GUY WIRE	T WATER VALVE
TELE — T	MISC.
MH ● TELEPHONE MANHOLE	48" RCP X X X R.C.P. REMOVAL
TELEPHONE PEDESTAL	CHAIN LINK FENCE
TS ○ TELEPHONE SIGN	WOOD FENCE
GAS — G	EXISTING ASPHALT
GM ○ GAS METER	EXISTING DIRT OR GRAVEL
GS ○ GAS SIGN	EX. CONCRETE
LAND USE	TREE/TREE LINE
R/R RAILROAD SIGN	EXISTING CURB
○ SIGN	PROP. CURB
SURVEY	EX. PROPERTY LINE
I.R. FOUND IRON ROD	PROP. CENTERLINE
□ TEMP BENCHMARK	PROP. R.O.W.
WASTE	PROP. INLET
MH ● WASTE MANHOLE	PVMT TOP OF PAVEMENT
CO ○ CLEANOUT	T.C. TOP OF CURB
	C.R. CURB RETURN


RECORD DOCUMENTS 6/9/2000
THESE RECORD DOCUMENTS HAVE BEEN PREPARED BASED ON INFORMATION PROVIDED BY OTHERS. THE CONSULTANT HAS NOT VERIFIED THE ACCURACY AND/OR COMPLETENESS OF THIS INFORMATION AND SHALL NOT BE RESPONSIBLE FOR ANY ERRORS OR OMISSIONS THAT MAY BE INCORPORATED AS A RESULT OF ERRONEOUS INFORMATION PROVIDED BY OTHERS.

LATERALS NOT PROFILED

BENCHMARKS:
USC & GS E-921 DISK IN BRICK WALL OF OLD ADDISON SCHOOL HOUSE (MAGIC TIME MACHINE RESTAURANT) ON SOUTH WALL, 4' EAST OF CENTER OF THE ENTRANCE, 4.7' ABOVE THE GROUND, ELEV. 650.61

625 "I" ON SOUTHEAST CORNER OF CONCRETE WALK AT FRONT ENTRANCE TO 4805 ARAPAHO ROAD, ELEV. 630.61

620 THE SEAL APPEARING ON THIS DOCUMENT WAS AUTHORIZED BY KENNETH A. ROBERTS, P.E. 55446 ON OCTOBER 24, 1997

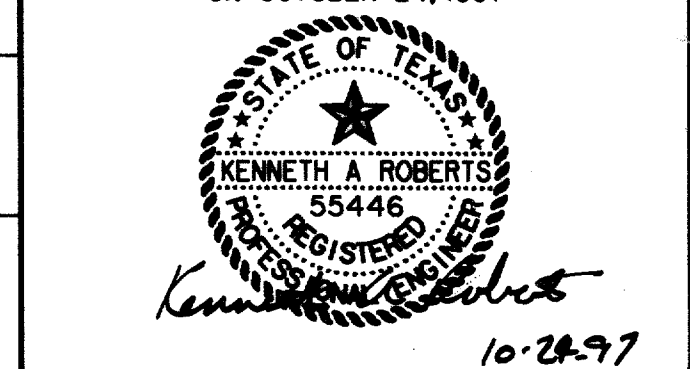

STORMWATER PLAN & PROFILE
LINE 'C-4'
ARAPAHO ROAD
ADDISON ROAD TO DALLAS NORTH TOLLWAY
TOWN OF ADDISON, TEXAS
Huitt-Zollars, Inc./Consulting Engineers
Dallas, Fort Worth, Houston, Phoenix, Tustin

DESIGN	DRAWN	APPR.	SCALE	DATE	PROJECT NO.	NO.
HZI	HZI	KAR	H:V = 20':1" = 6'	OCT 97	1772-01	ST-13

CHATAHOOCHEE LEASING CORPORATION

0+00 LAT. 'C-26'
PAV. STA. 67+14.39
53.96' LT.
CONN. TO EX. 60" RCP
BEGIN 21" RCP

0+56.12 LAT. 'C-26'
END 21" RCP
PAV. STA. 66+55
47.57' LT.
10' REC. INLET
T.C. 613.40
F.L. 609.40

LAT. 'C-26'
21" RCP

ARAPAHO ROAD

LINE 'C-4'

LAT. 'D-1'
21" RCP


PAV. STA. 66+63.48
59.96' RT.
14' STD. INLET
T.C. 613.65
F.L. 610.15

0+56.90 LAT. 'D-1'
END 21" RCP

0+44.27 LAT. 'D-1'
45' FACTORY BEND

0+42.27 LAT. 'D-10'
PAV. STA. 66+80.15
54.33' RT.
CONN. TO EX. 21" RCP
BEGIN 21" RCP

DALLAS NORTH
TOLLWAY

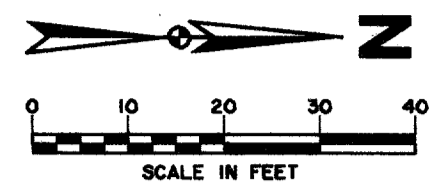

NOTE:
VERIFY LOCATION, HORIZONTAL
& VERTICAL, OF ALL UTILITIES
PRIOR TO CONSTRUCTION OF
STORMWATER INLETS & PIPES

LEGEND

	ELECTRIC — OHE		WATER — W
	LIGHT POLE		FIRE HYDRANT
	POWER POLE		METER
	GUY WIRE		WATER VALVE
	TELEPHONE — T		MISC.
	TELEPHONE MANHOLE		CHAIN LINK FENCE
	TELEPHONE PEDESTAL		WOOD FENCE
	TELEPHONE SIGN		EXISTING ASPHALT
	GAS — G		EXISTING DIRT OR GRAVEL
	GAS METER		EX. CONCRETE
	GAS SIGN		TREE/TREE LINE
	LAND USE		EXISTING CURB
	RAILROAD SIGN		PROP. CURB
	SIGN		EX. PROPERTY LINE
	SURVEY		PROP. CENTERLINE
	FOUND IRON ROD		PROP. R.O.W.
	TEMP BENCHMARK		PROP. INLET
	WASTEWATER — WW		TOP OF PAVEMENT
	WASTEWATER MANHOLE		TOP OF CURB
	CLEANOUT		CURB RETURN

RECORD DOCUMENTS 6/9/2000

THESE RECORD DOCUMENTS HAVE BEEN PREPARED BASED ON INFORMATION PROVIDED BY OTHERS. THE CONSULTANT HAS NOT VERIFIED THE ACCURACY AND/OR COMPLETENESS OF THIS INFORMATION AND SHALL NOT BE RESPONSIBLE FOR ANY ERRORS OR OMISSIONS THAT MAY BE INCORPORATED AS A RESULT OF ERRONEOUS INFORMATION PROVIDED BY OTHERS.

LATERALS NOT PROFILED

BENCHMARKS:

USC & GS E-921 DISK IN BRICK WALL OF OLD ADDISON SCHOOL HOUSE (MAGIC TIME MACHINE RESTAURANT) ON SOUTH WALL, 4' EAST OF CENTER OF THE ENTRANCE, 4.7' ABOVE THE GROUND. ELEV. 650.61

'D' ON SOUTHEAST CORNER OF CONCRETE WALK AT FRONT ENTRANCE TO 4805 ARAPAHO ROAD. ELEV. 630.61


625

620

615

610

THE SEAL APPEARING ON THIS DOCUMENT WAS AUTHORIZED BY KENNETH A. ROBERTS, P.E. 55446 ON OCTOBER 24, 1997

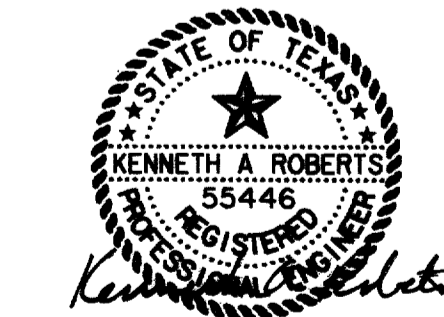

10-24-97

REVISED
11/16/98

STORMWATER PLAN & PROFILE
LINE 'C-4'


ARAPAHO ROAD

ADDISON ROAD TO DALLAS NORTH TOLLWAY


TOWN OF ADDISON, TEXAS

Huitl-Zollars, Inc./Consulting Engineers
Dallas, Fort Worth, Houston, Phoenix, Tustin


DESIGN	DRAWN	APPR.	SCALE	DATE	PROJECT NO.	NO.
HZI	HZI	KAR	H _v 1"=20' V _v 1"=6'	OCT 97	1772-01	ST-14

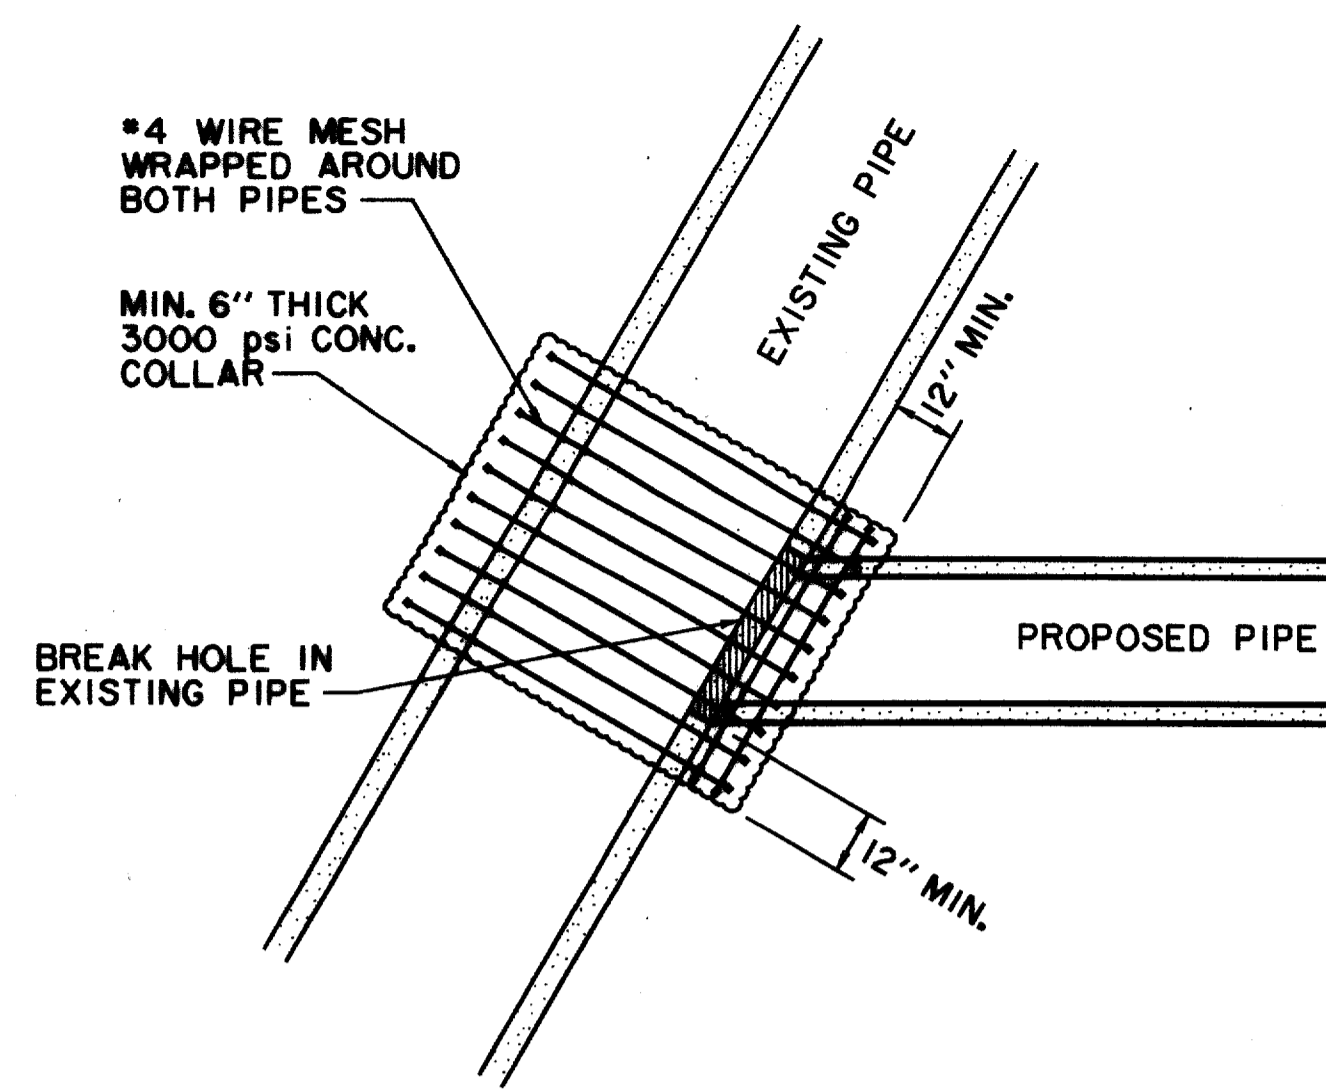

PROPOSED PIPE TO EXISTING PIPE WYE CONNECTION
N.T.S.

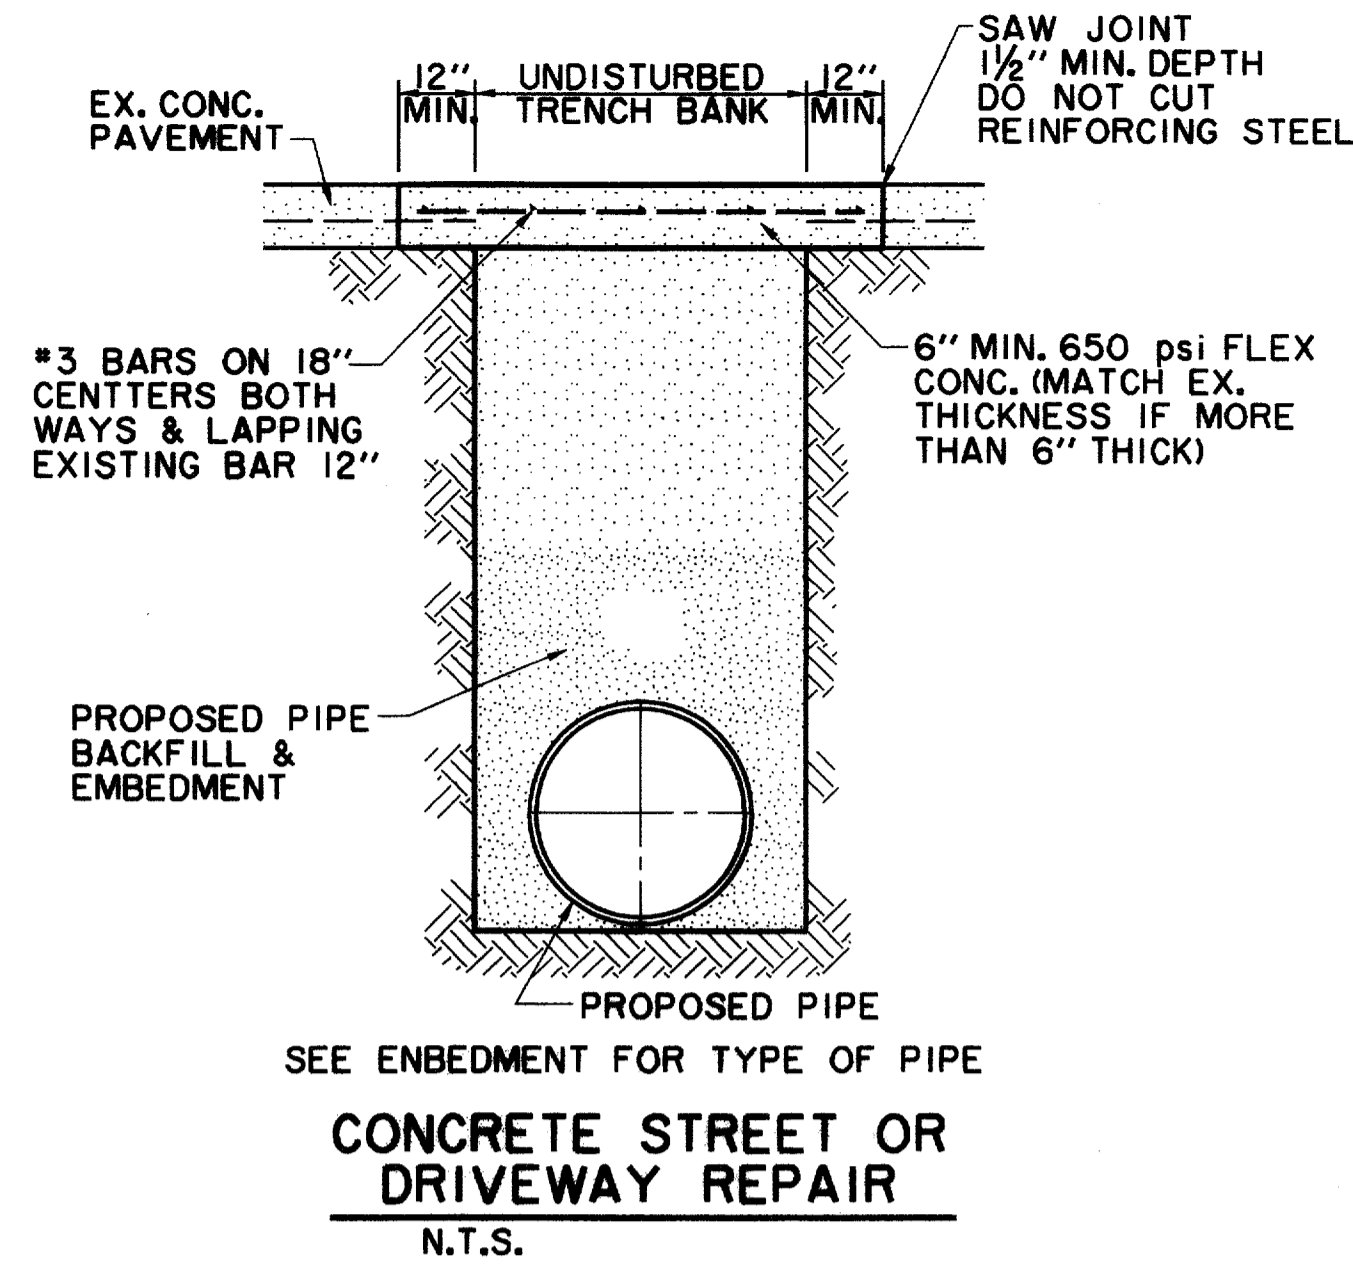

CONCRETE STREET OR DRIVEWAY REPAIR
N.T.S.

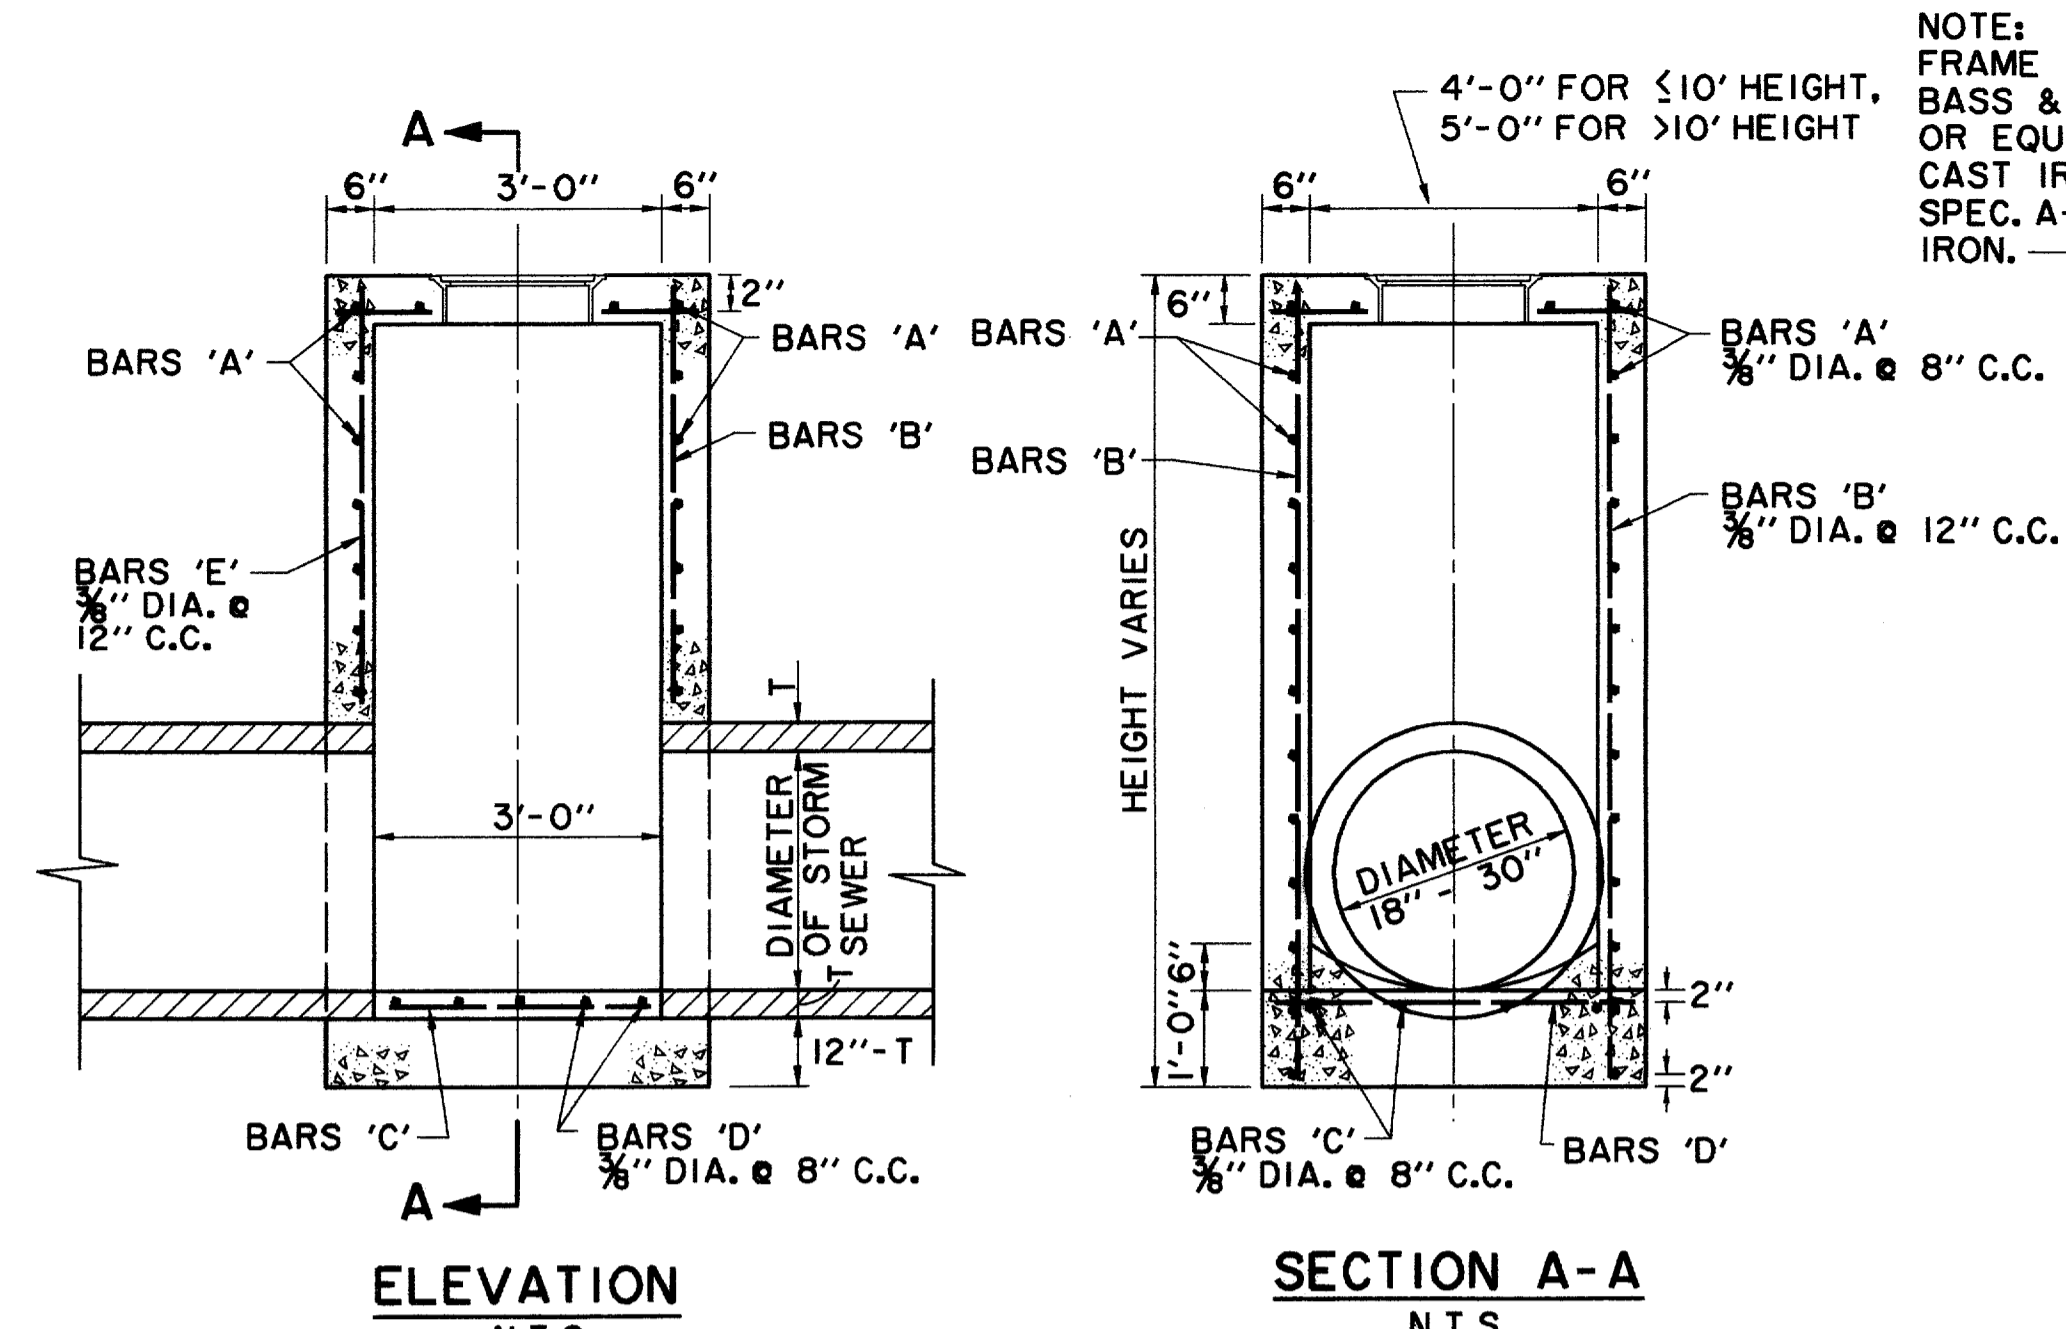


ELEVATION SECTION A-A
N.T.S. N.T.S.
TYPE A STORM SEWER MANHOLE
(FOR PIPE 18" TO 30" IN DIAMETER)

TOP PLAN TYPE A & TYPE B STORM SEWER MANHOLE
N.T.S.
NOTE: MAXIMUM PIPE SIZE TO BE USED 78"


NOTE: MANHOLES AND INLETS GREATER THAN 4' IN DEPTH SHALL HAVE BASS AND HAYES MODEL MA STEPS OR APPROVED EQUAL

NOTE: FRAME AND COVER SHALL BE BASS & HAYS PATTERN NO. 400-24 OR EQUAL AND SHALL BE OF GRAY CAST IRON CONFORMING TO A.S.T.M. SPEC. A-48 FOR CLASS 30 CAST IRON.
PROVIDE 3/4" PREMOLED EXPANSION JOINT BETWEEN MANHOLE AND CONCRETE PAVEMENT AND SEAL WITH SILICONE JOINT SEALANT

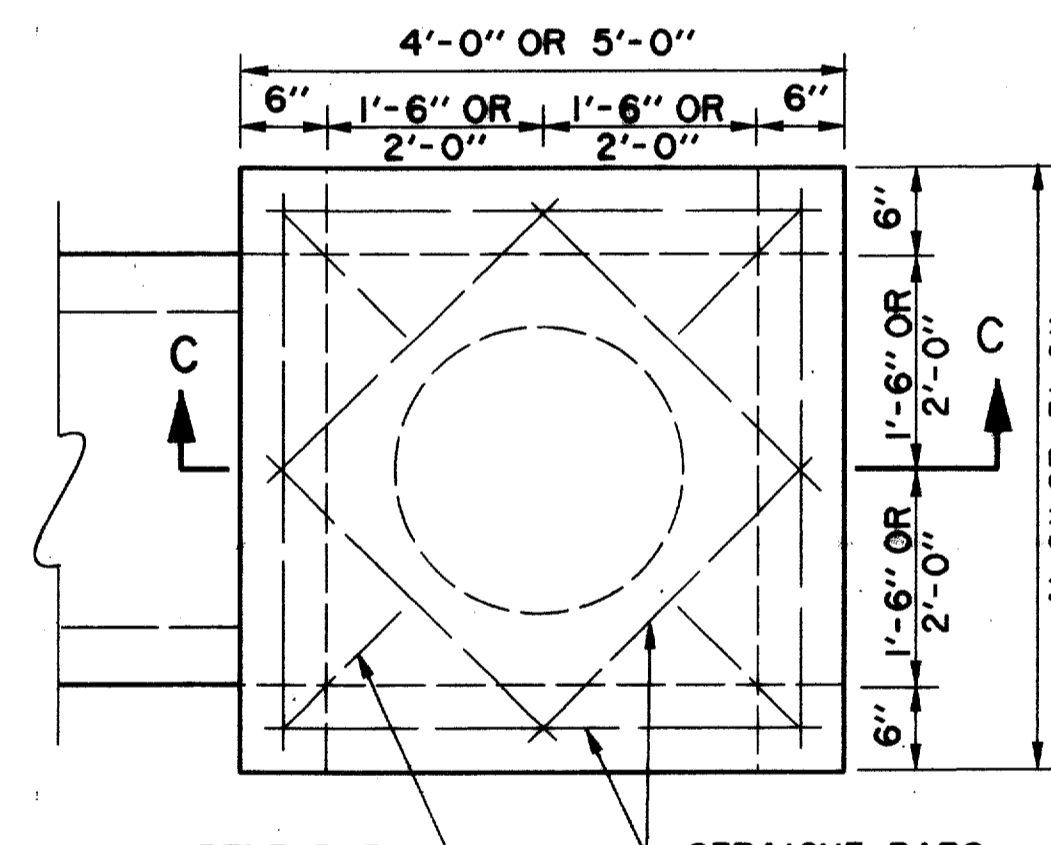


STANDARD TYPE "Y" INLET
N.T.S.


NOTE: ALL "Y" INLETS TO HAVE CONCRETE APRON AROUND INLET

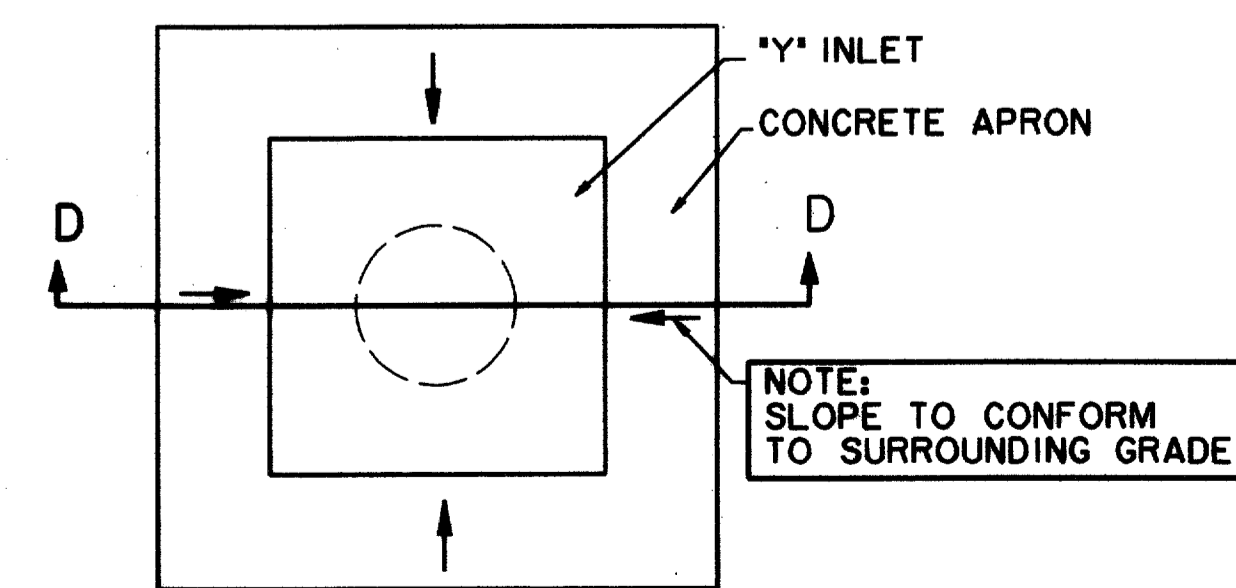


"Y" INLET CONCRETE APRON PLAN
N.T.S.

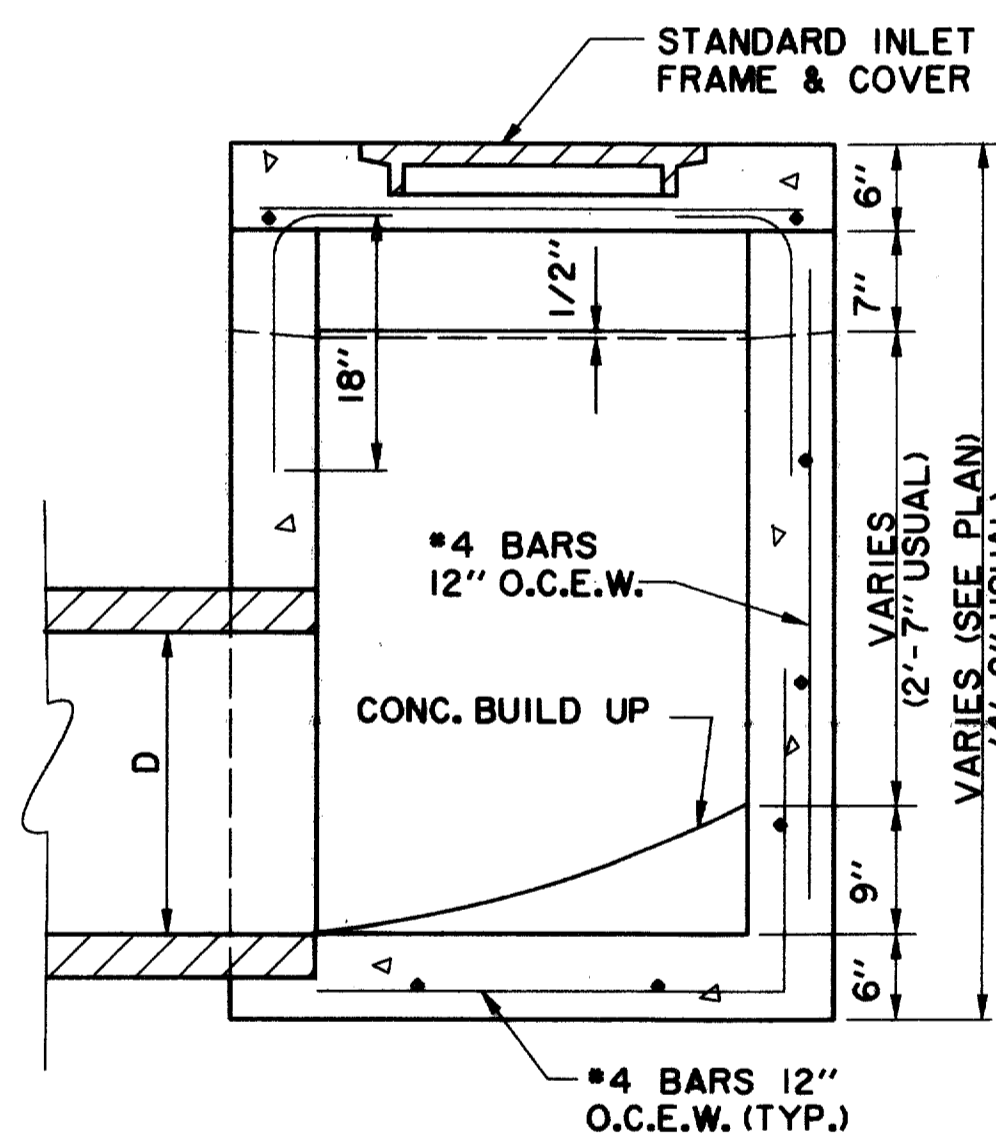

SECTION C-C
N.T.S.

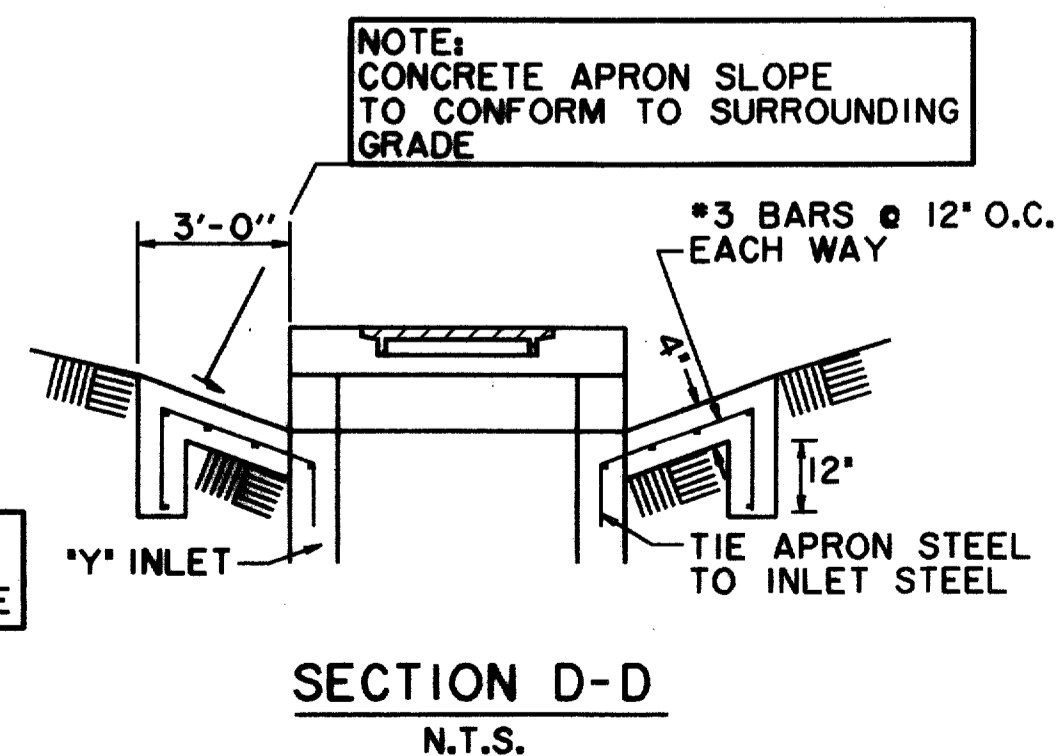


SECTION D-D
N.T.S.

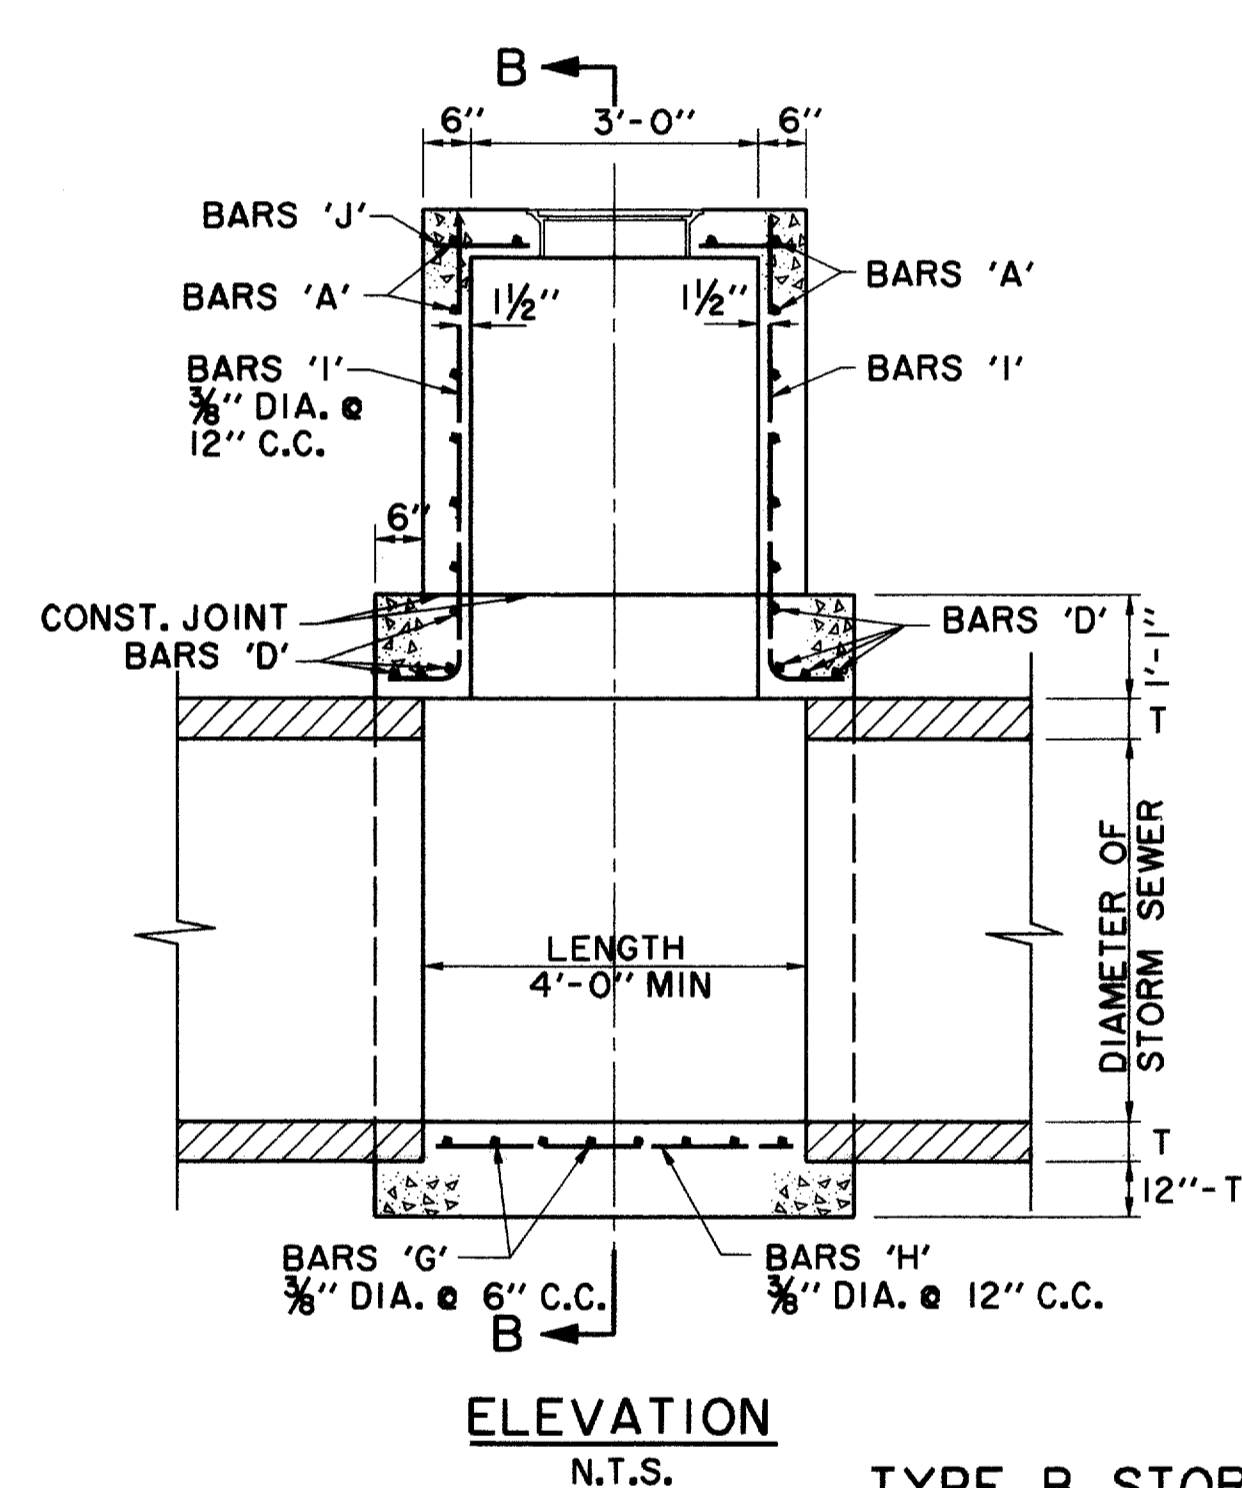


ELEVATION
N.T.S.

TYPE B STORM SEWER MANHOLE
(FOR PIPE 33" TO 78" IN DIAMETER)

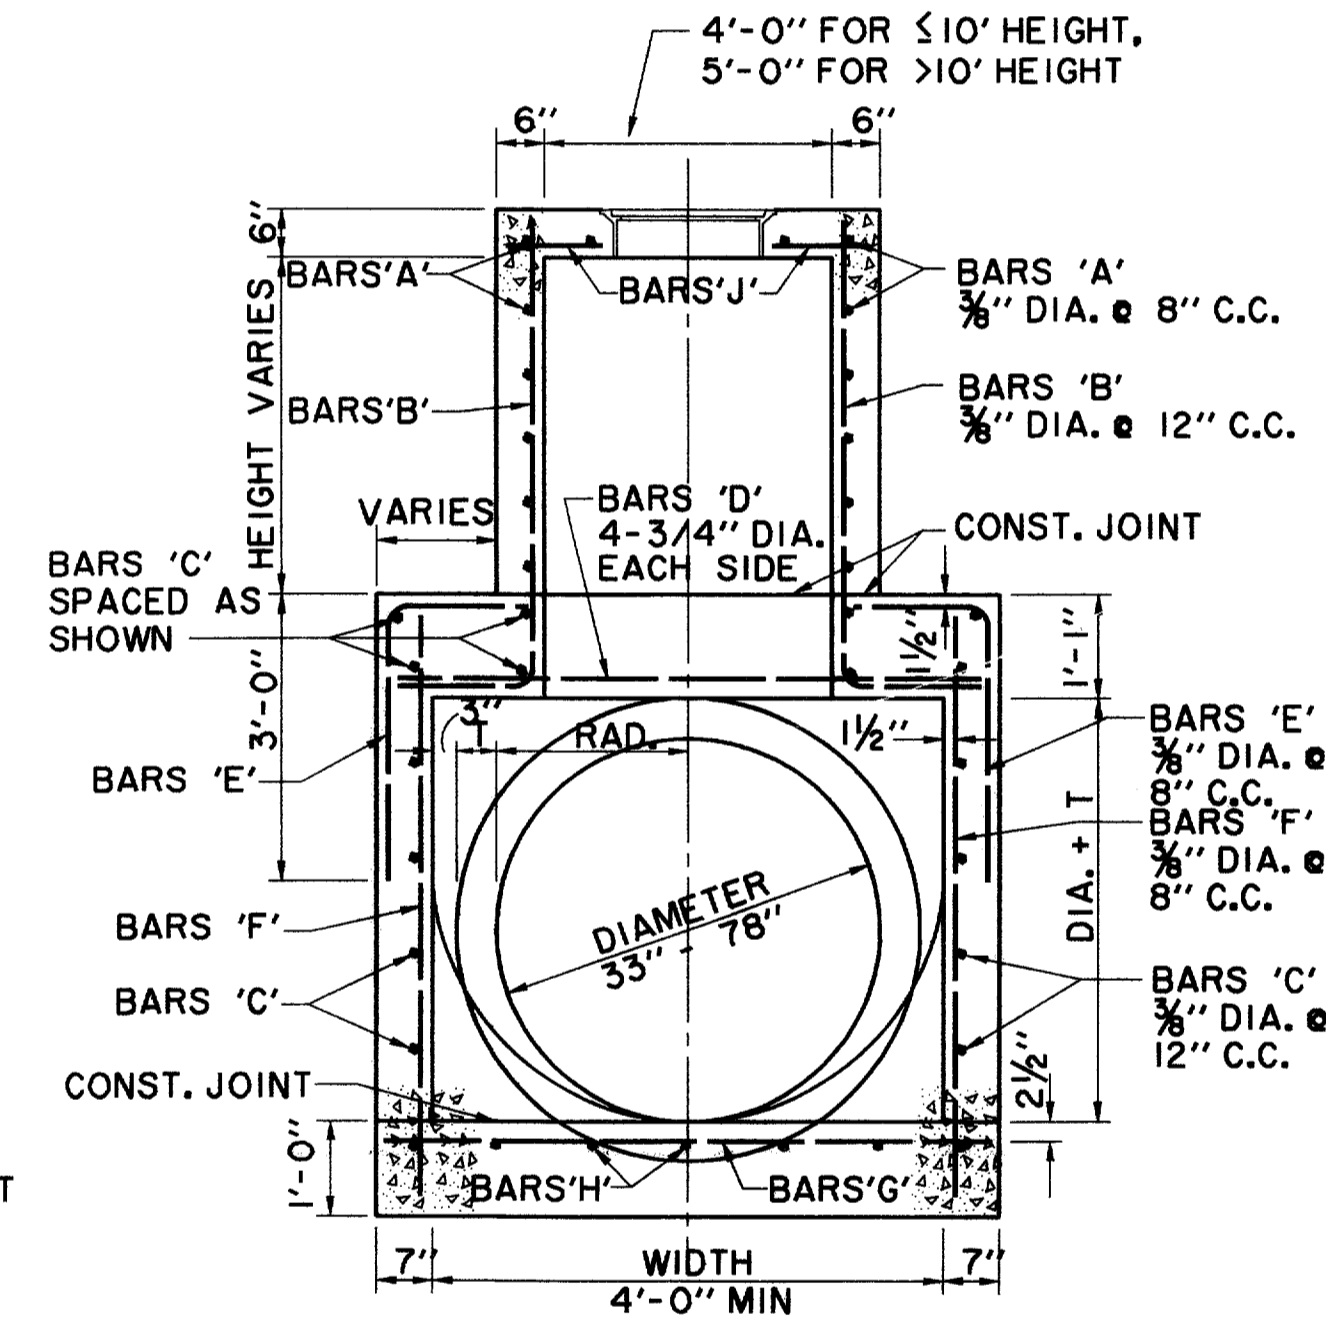

SECTION B-B
N.T.S.

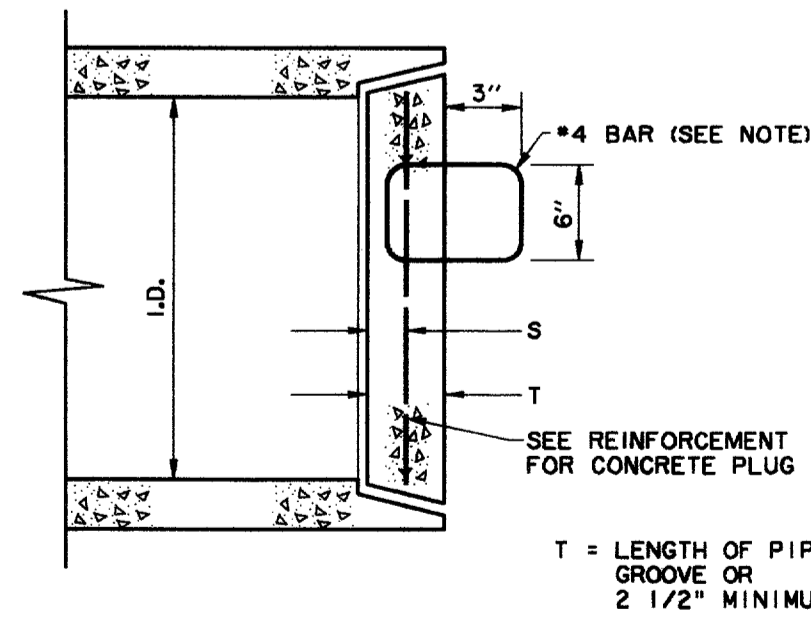


REINFORCEMENT FOR CONCRETE PLUG


PIPE SIZE	REINF. BAR	DISTANCE (C-C)	S
18"-39"	#3	12" BOTH WAYS	1/2 T
42"-54"	#3	12" BOTH WAYS	1/3 T
60"-72"	#4	12" BOTH WAYS	1/4 T

NOTE: STEEL HANDLE FOR REINFORCED CONCRETE PIPE PLUG SHALL BE LOCATED 1/4 I.D. ABOVE CENTER POINT OF PLUG. TWO STEEL HANDLES WILL BE REQUIRED ON PLUGS OF 36" PIPES OR LARGER AND SHALL BE PLACED 1/4 I.D. ABOVE CENTER OF PLUG.

CONCRETE PLUG DETAIL

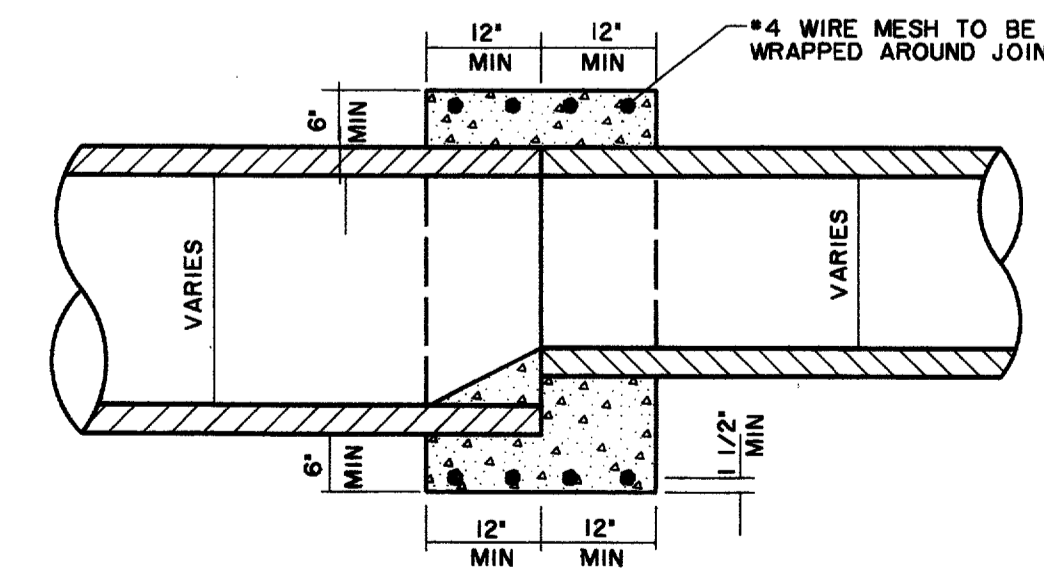

DETAIL OF CONCRETE COLLAR FOR END TO END EXTENSIONS

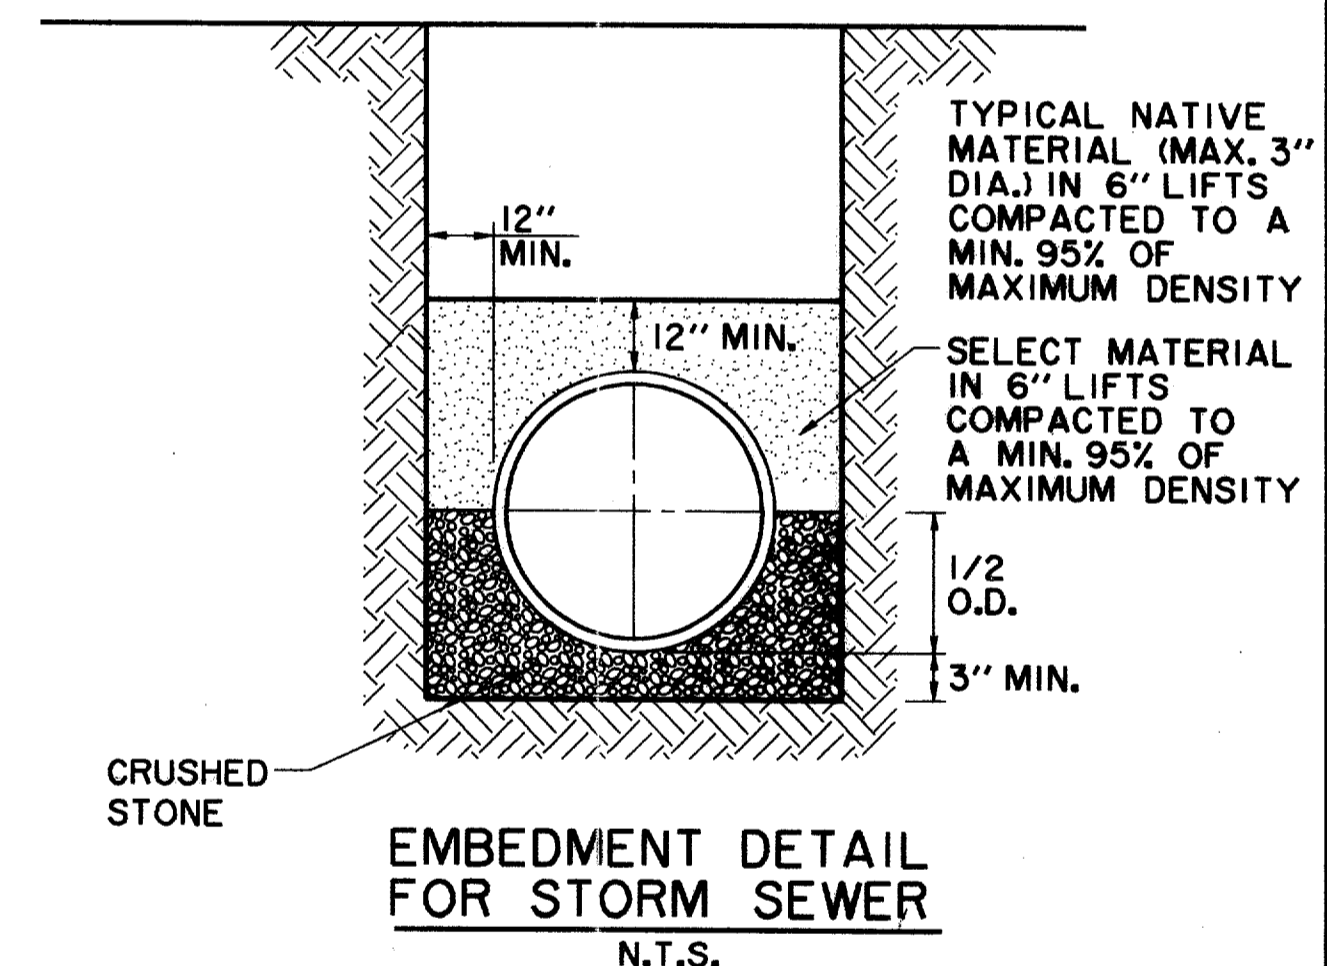


EMBEDMENT DETAIL FOR STORM SEWER
N.T.S.

RECORD DOCUMENTS 6/9/2000

THESE RECORD DOCUMENTS HAVE BEEN PREPARED BASED ON INFORMATION PROVIDED BY OTHERS. THE CONSULTANT HAS NOT VERIFIED THE ACCURACY AND/OR COMPLETENESS OF THIS INFORMATION AND SHALL NOT BE RESPONSIBLE FOR ANY ERRORS OR OMISSIONS THAT MAY BE INCORPORATED AS A RESULT OF ERRONEOUS INFORMATION PROVIDED BY OTHERS.

THE SEAL APPEARING ON THIS DOCUMENT WAS AUTHORIZED BY KENNETH A. ROBERTS, P.E. 55446 ON OCTOBER 24, 1997




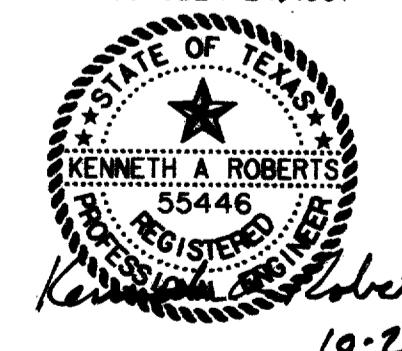


STORMWATER DETAILS
ARAPAHO ROAD
ADDISON ROAD TO DALLAS NORTH TOLLWAY
TOWN OF ADDISON, TEXAS





Huilt-Zollers, Inc./Consulting Engineers
Dallas, Fort Worth, Houston, Phoenix, Tustin

DESIGN	DRAWN	APPR.	SCALE	DATE	PROJECT NO.	NO.
HZI	HZI	KAR	N.T.S.	OCT 97	1772-01	ST-15


NOTE:
PIPES SHALL CONNECT TO THE
ENDS OR SIDES OF INLETS.
CONNECTION SHALL NOT BE
MADE AT CORNER OR BOTTOM.

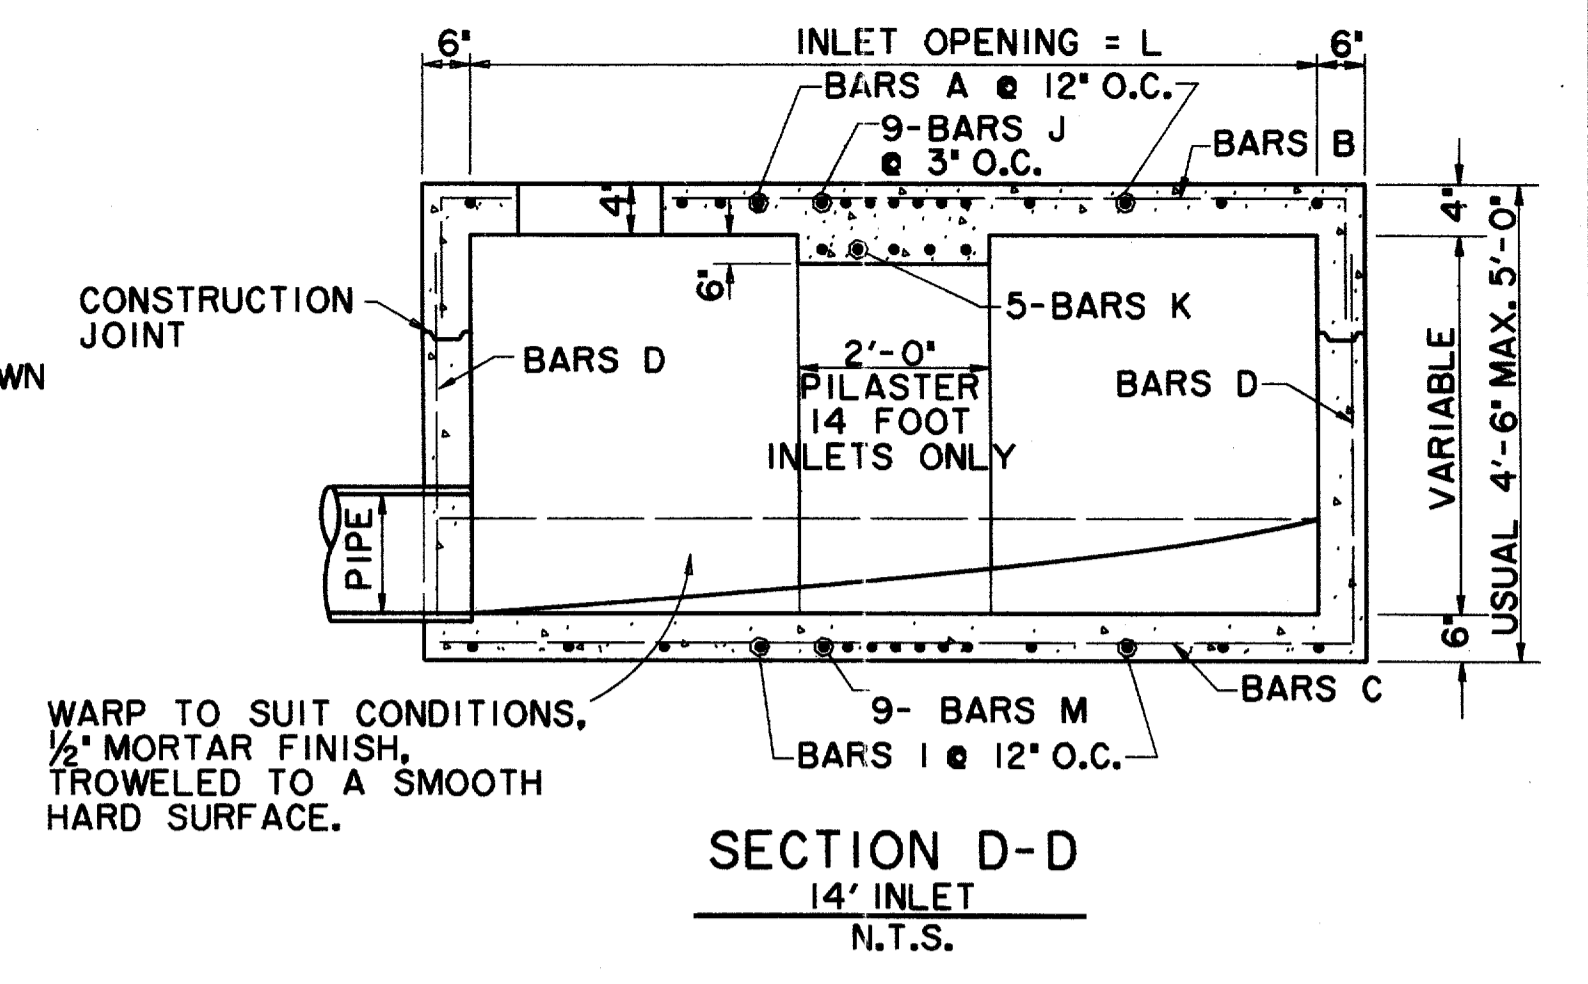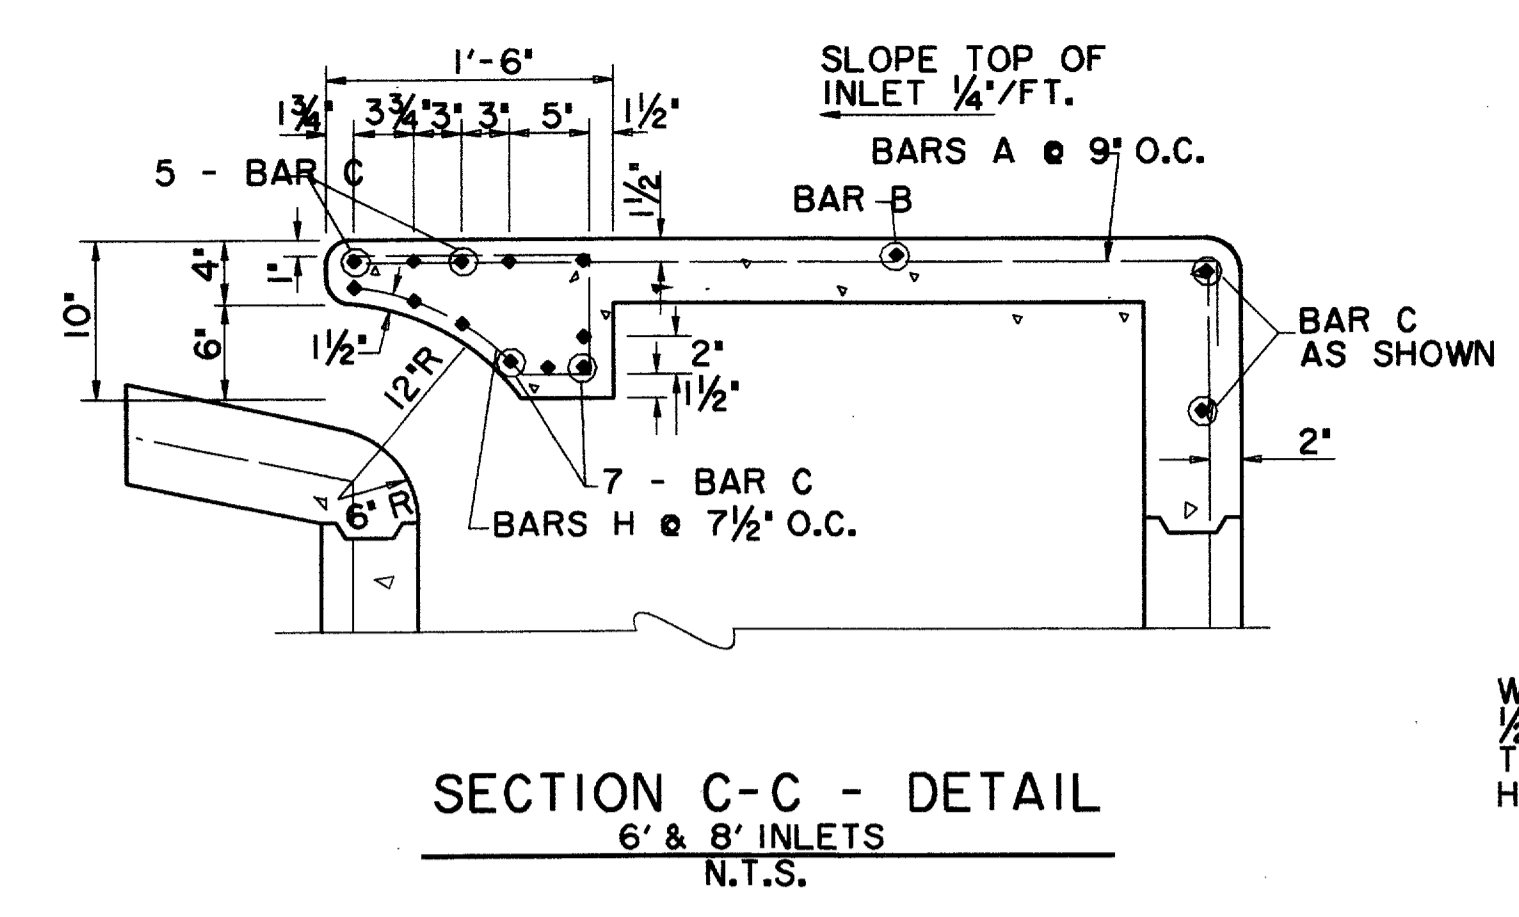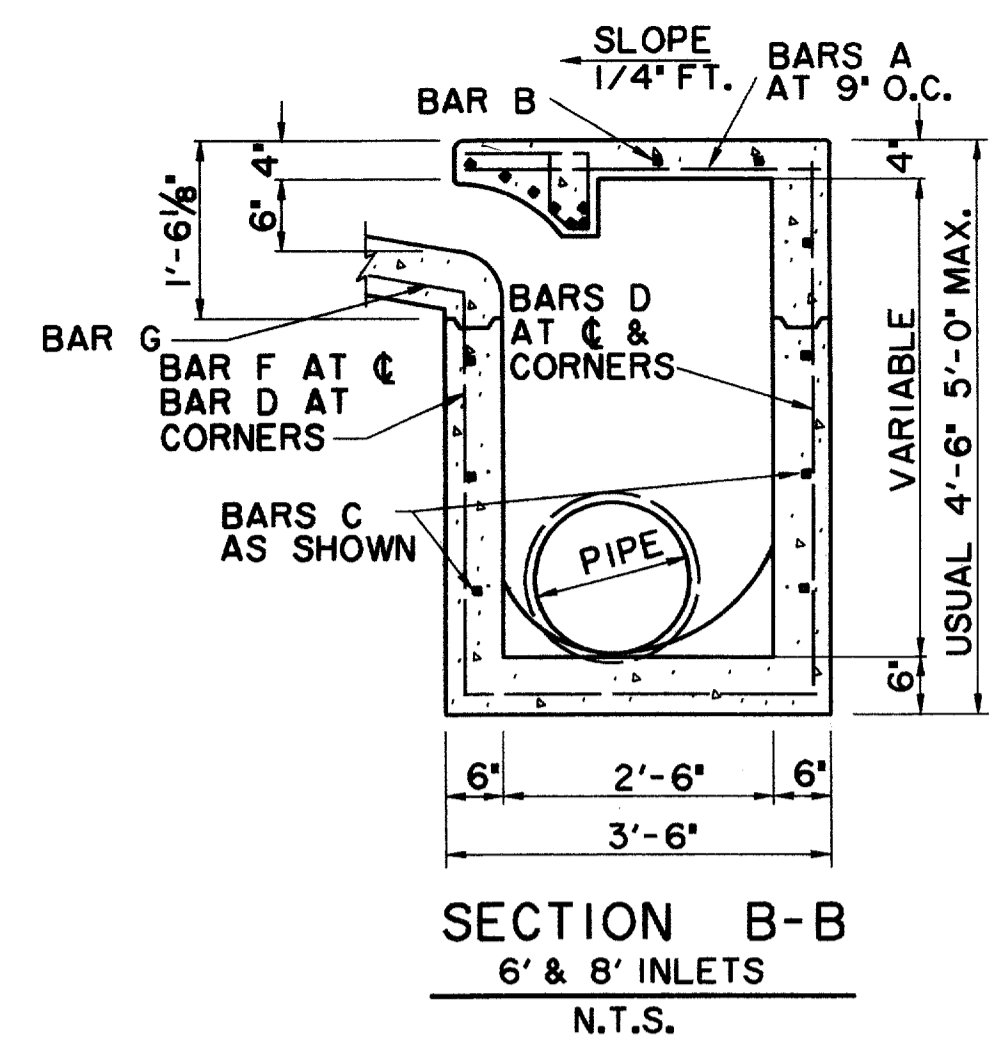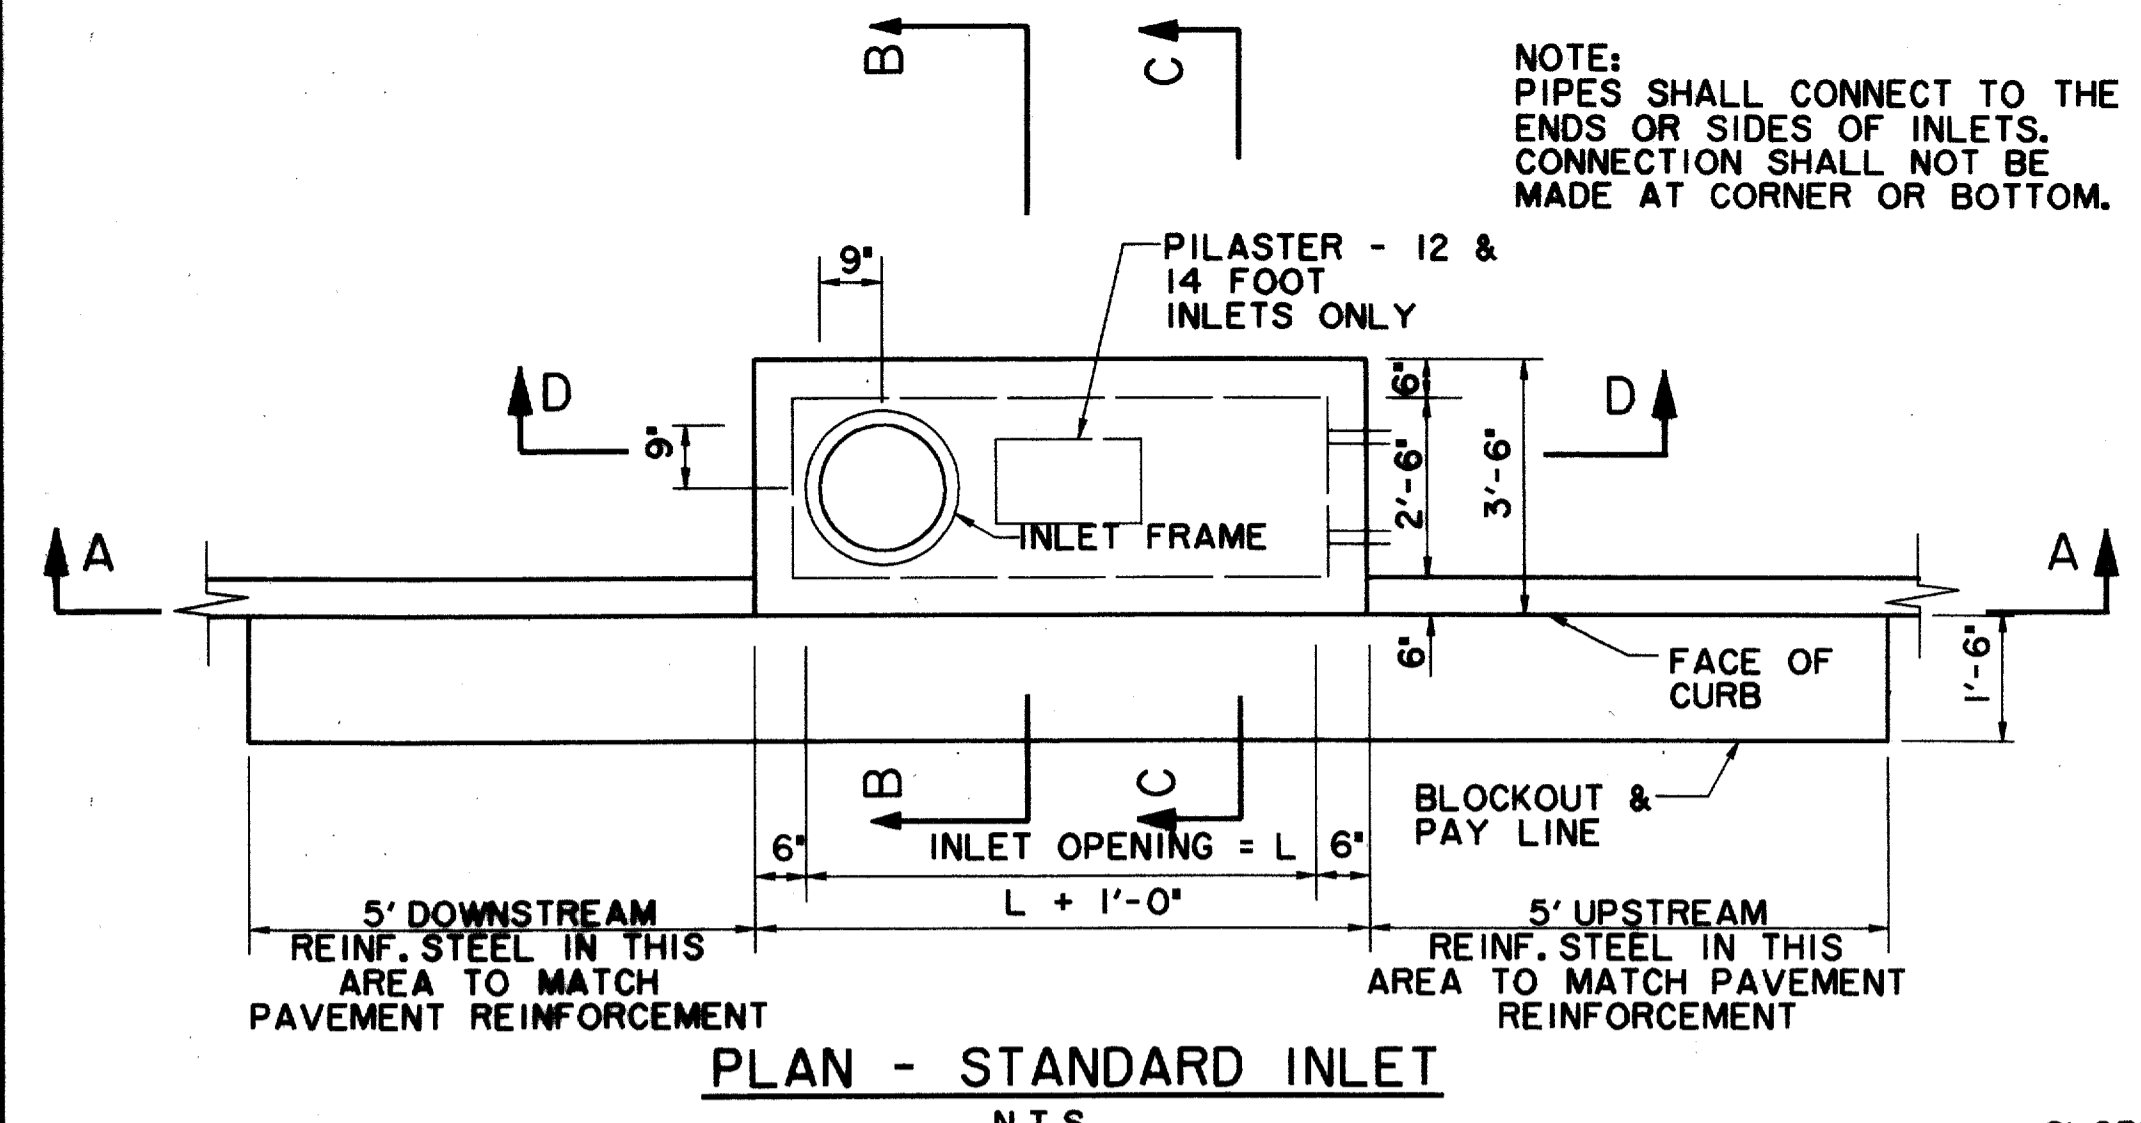

WARP TO SUIT CONDITIONS,
1/2" MORTAR FINISH,
TROWELED TO A SMOOTH
HARD SURFACE.

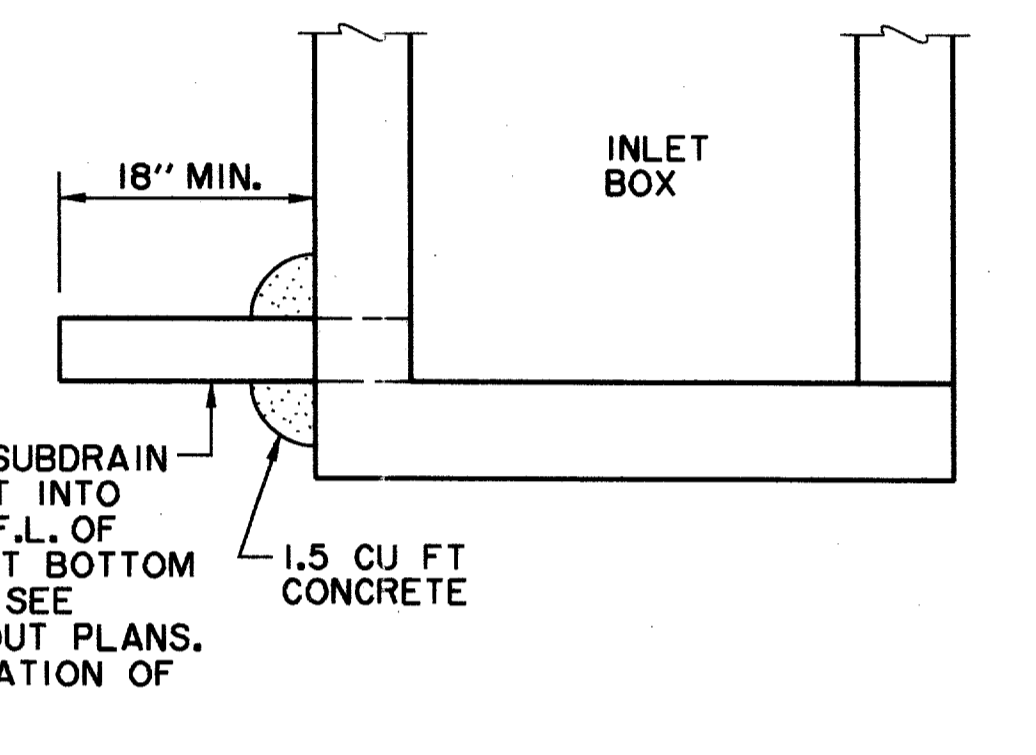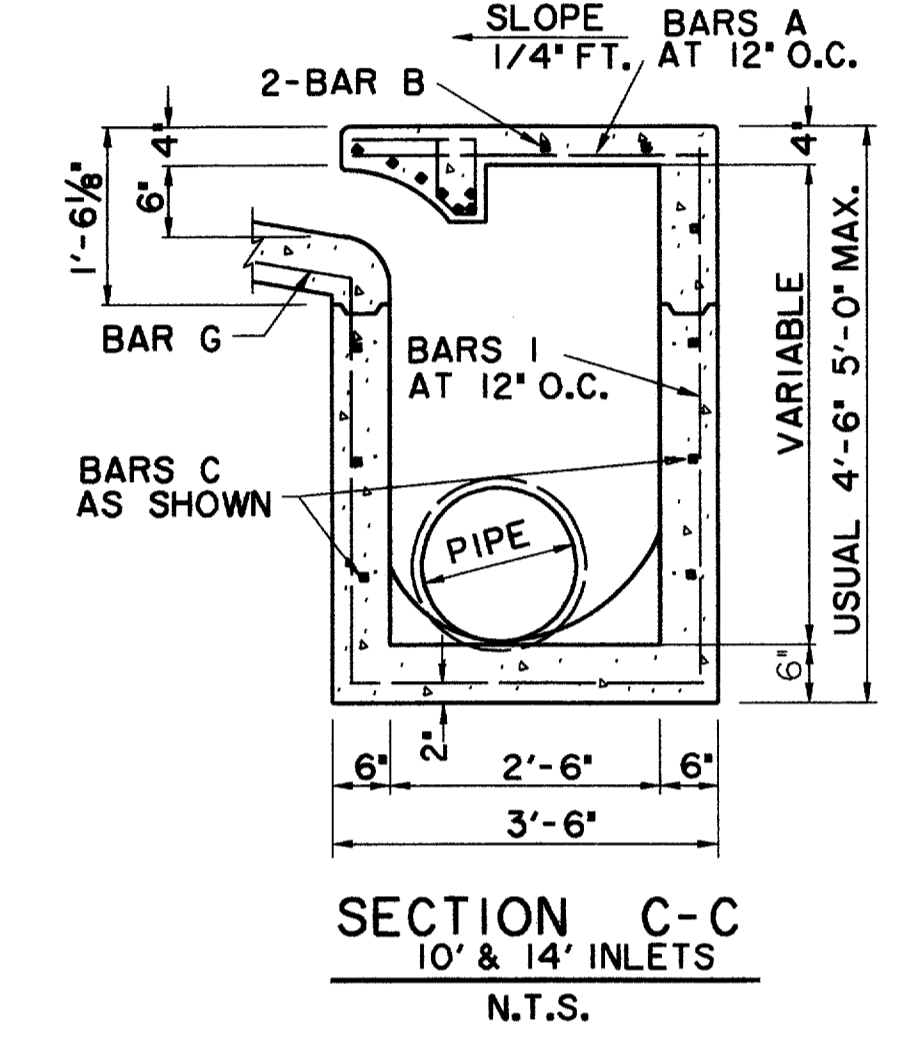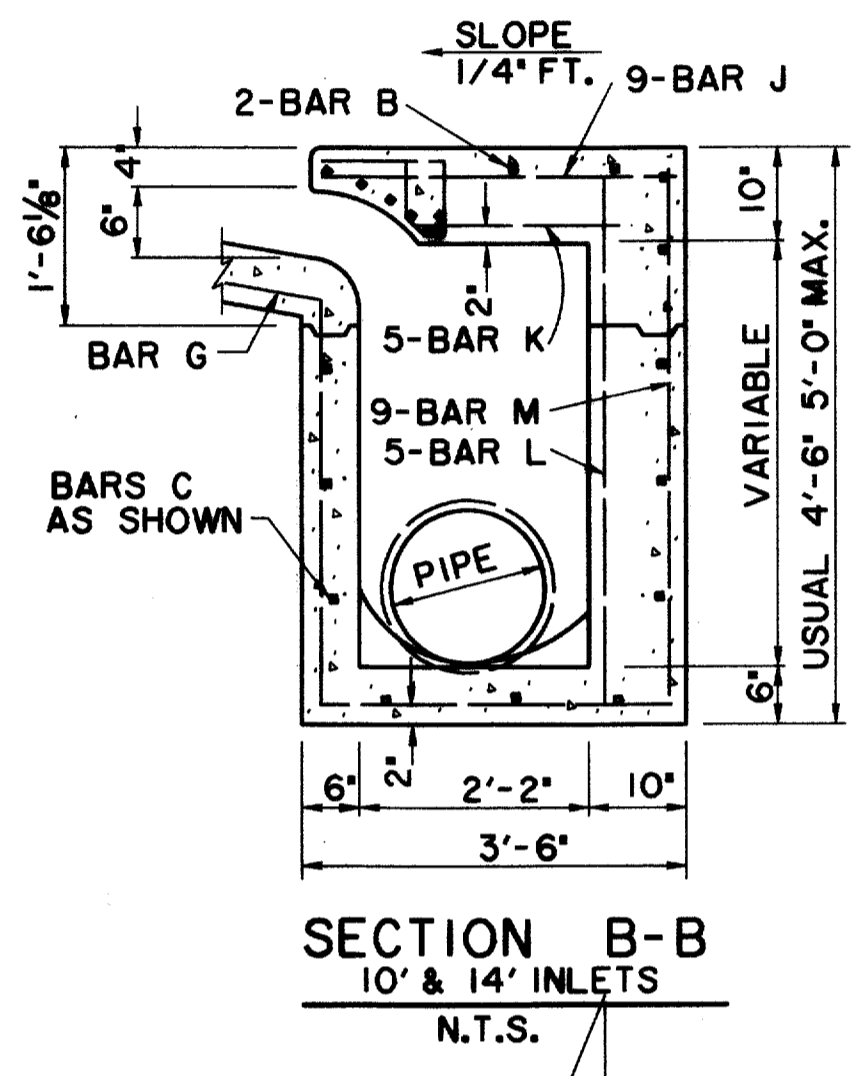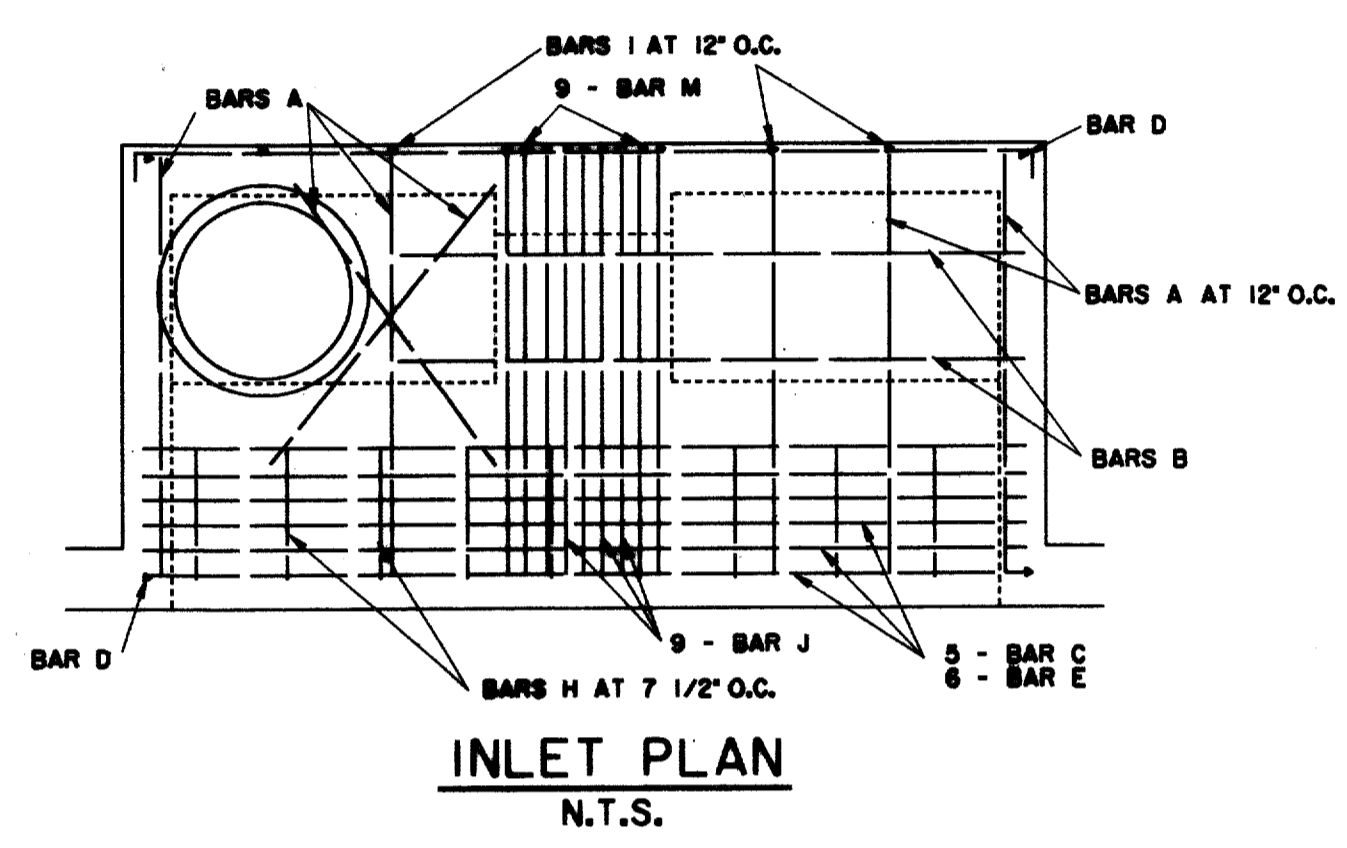

4" PVC SCH 40 SUBDRAIN
PIPE TO BE CAST INTO
INLET WALL AT F.L. OF
INLET WHEN INLET BOTTOM
IS CONSTRUCTED. SEE
LANDSCAPE LAYOUT PLANS.
COORDINATE LOCATION OF
CONNECTION.

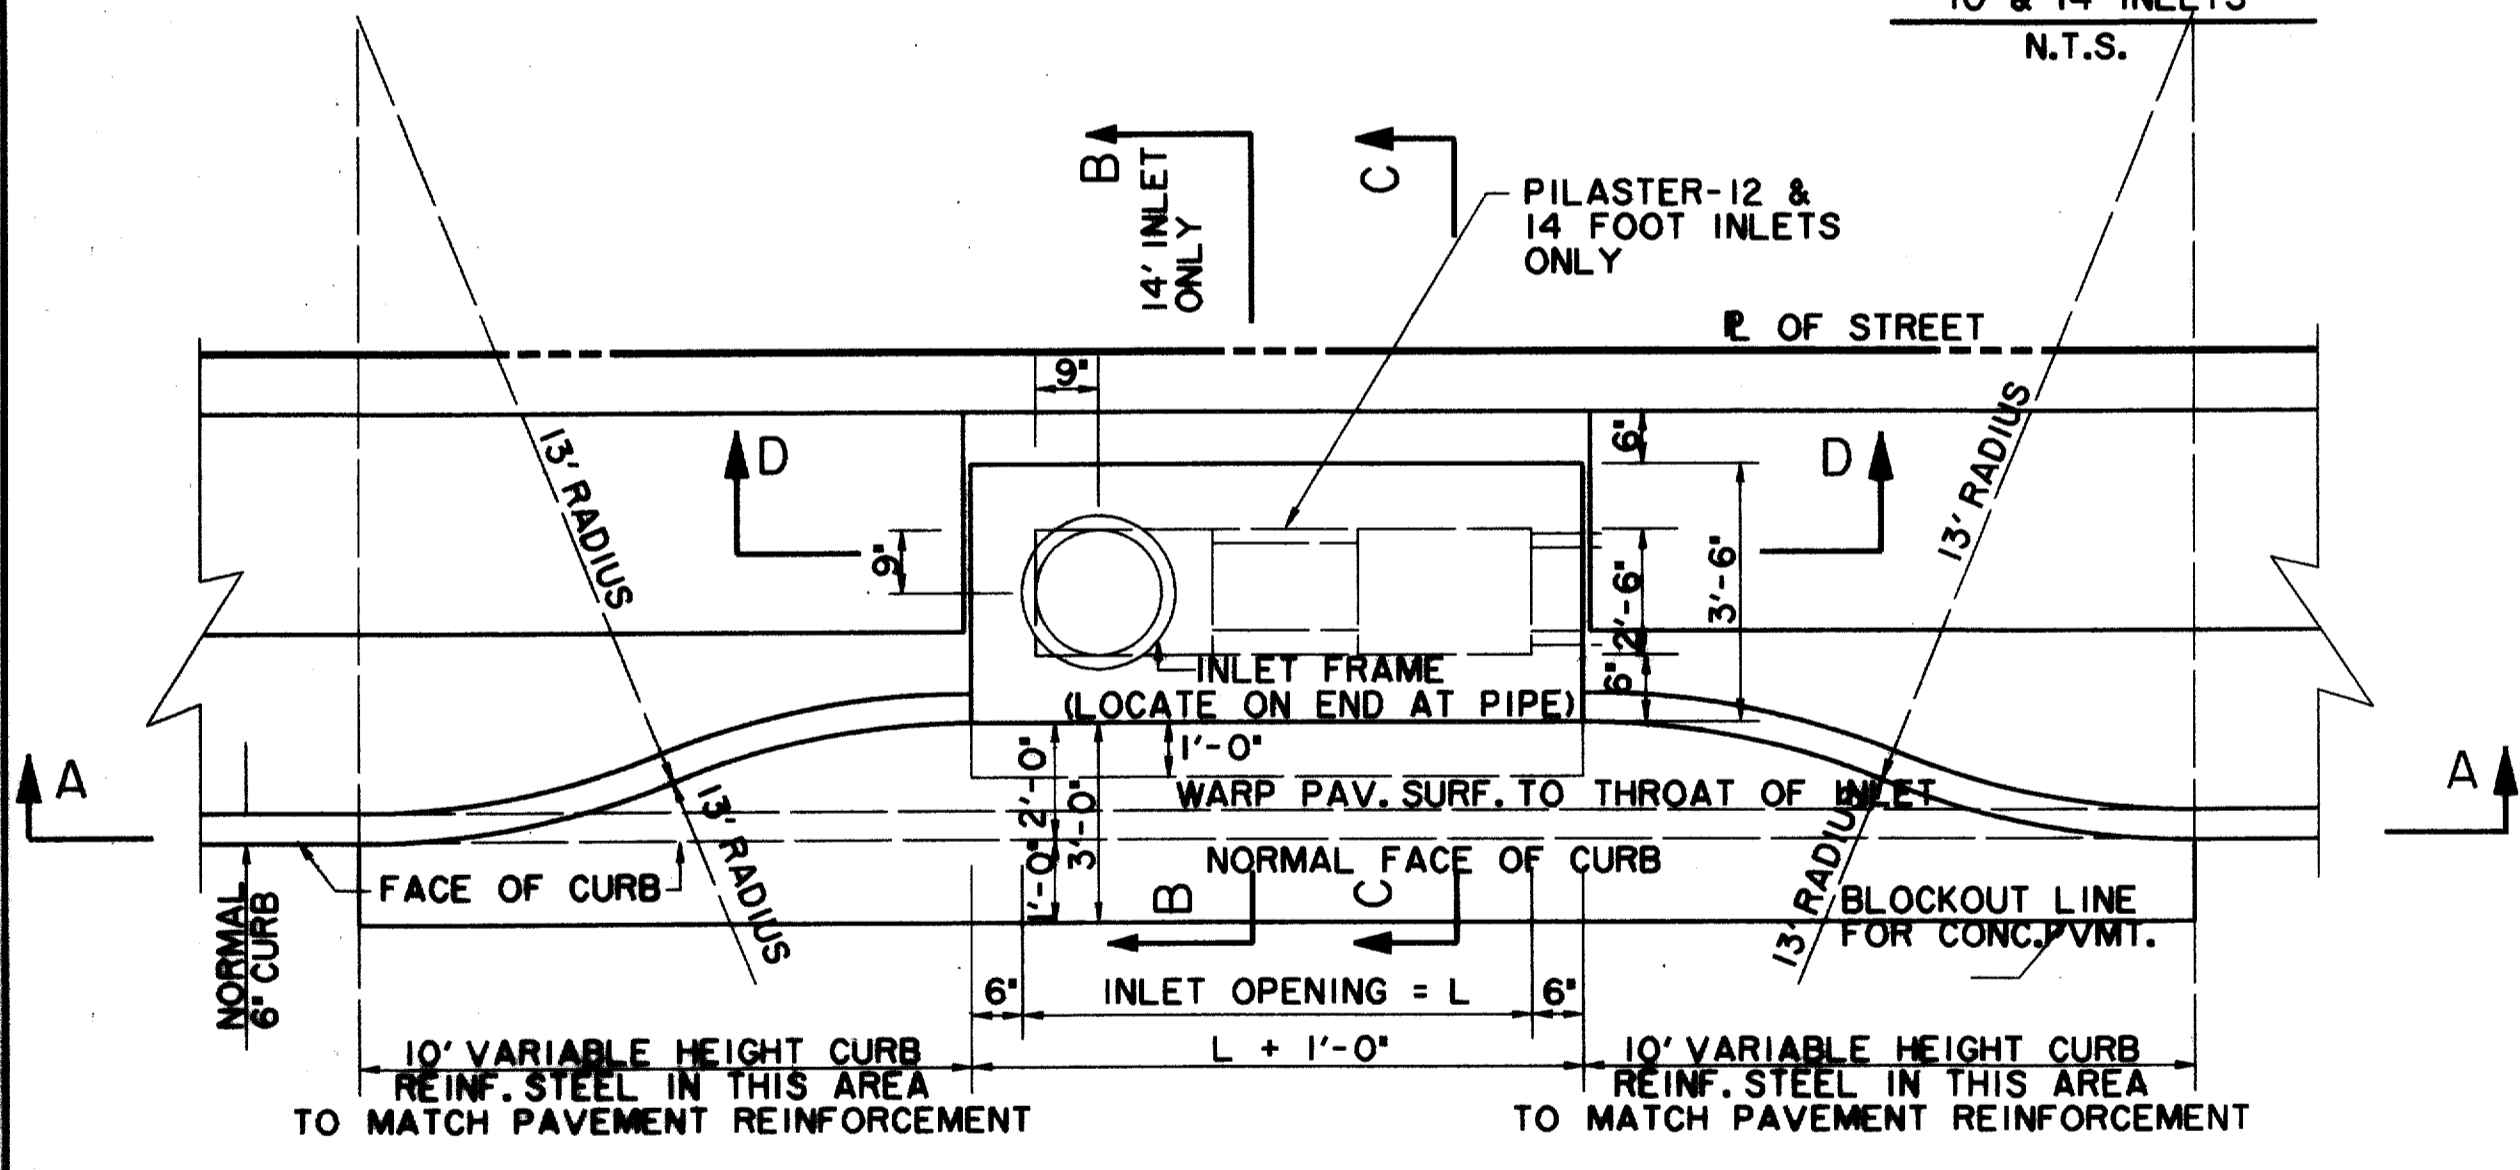


REINFORCING STEEL SCHEDULE

DIMENSION SHOWN ARE FOR MAXIMUM SIZE INLETS


INLET LENGTH	BAR TYPE	BAR DIA. (1/8 IN)	NO. REQ'D	BAR DIMENSIONS		
				A	B	C
6	A	3	9	3'-2"	0'-3"	
	B	3	1	4'-10"		
	C	4	15	6'-8"	0'-6"	
	D	4	5	4'-8"		
	F	4	1	3'-2"		
	G	3	5	2'-0"	1'-3"	
	H	6	8			
	N	3	3	3'-2"	3'-2"	3'-2"
8	A	3	12	3'-2"	0'-3"	
	B	3	1	6'-10"		
	C	4	15	8'-8"	0'-6"	
	D	4	5	4'-8"		
	F	4	1	3'-2"		
	G	3	5	2'-0"	1'-3"	
	H	6	8			
	N	3	3	3'-2"	3'-2"	3'-2"
10	A	3	10	3'-2"	0'-3"	
	B	3	2	8'-10"		
	C	4	16	10'-8"	0'-6"	
	D	4	4	4'-8"		
	E	5	6	10'-8"		
	G	3	5	2'-0"	1'-3"	
	H	3	15			
	I	4	8	4'-8"	3'-2"	3'-2"
	L	4	5	4'-3"		
12	A	3	12	3'-2"	0'-3"	
	C	4	16	10'-10"	0'-6"	
	D	4	4	4'-8"		
	E	5	6	12'-8"		
	G	3	5	2'-0"	1'-3"	
	H	3	18			
	I	4	10	4'-8"	3'-2"	3'-2"
	J	5	9	3'-2"	1'-3"	
	K	4	5	2'-3"		
	L	4	5	4'-3"		
14	A	3	14	3'-2"	0'-3"	
	B	3	2	10'-10"		
	C	4	16	14'-8"	0'-6"	
	D	4	4	4'-8"		
	E	5	6	14'-8"		
	G	3	5	2'-0"	1'-3"	
	H	3	21			
	I	4	12	4'-8"	3'-2"	3'-2"
	J	5	9	3'-2"	1'-3"	
	K	4	5	2'-3"		
	L	4	5	4'-3"		
	M	5	9	4'-3"	3'-2"	3'-9"

BAR DIAGRAMS

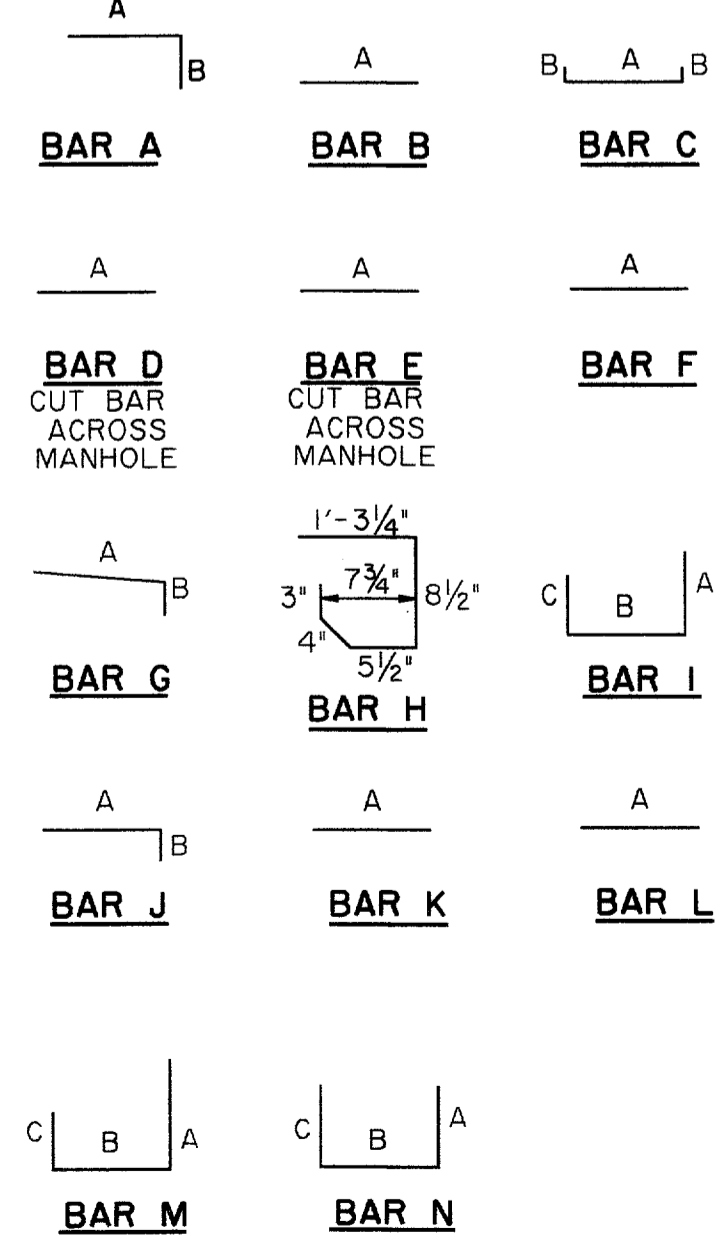

RECORD DOCUMENTS 6/9/2000



THESE RECORD DOCUMENTS HAVE BEEN PREPARED BASED ON INFORMATION PROVIDED BY OTHERS. THE CONSULTANT HAS NOT VERIFIED THE ACCURACY AND/OR COMPLETENESS OF THIS INFORMATION AND SHALL NOT BE RESPONSIBLE FOR ANY ERRORS OR OMISSIONS THAT MAY BE INCORPORATED AS A RESULT OF ERRONEOUS INFORMATION PROVIDED BY OTHERS.

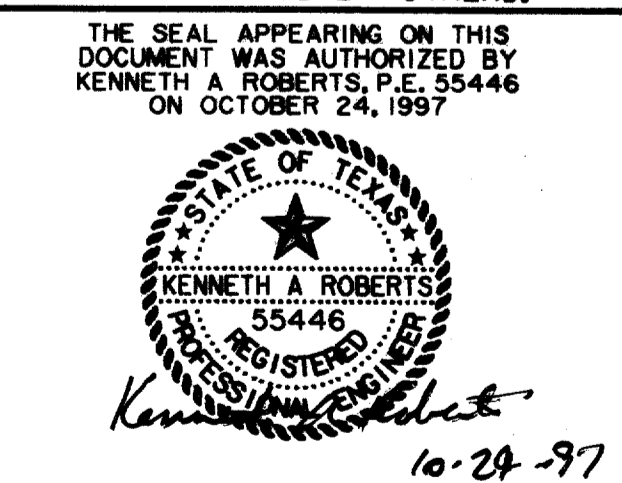

△ ADDENDUM #5, 1/9/98


STORMWATER DETAILS						
ARAPAHO ROAD						
ADDISON ROAD TO DALLAS NORTH TOLLWAY						
TOWN OF ADDISON, TEXAS						
Hult-Zollars, Inc./Consulting Engineers Dallas, Fort Worth, Houston, Phoenix, Tustin						
DESIGN	DRAWN	APPR.	SCALE	DATE	PROJECT NO.	NO.
HZI	HZI	KAR	N.T.S.	OCT 97	1772-01	ST-16

SEE DIAGRAM FOR DIMENSIONS

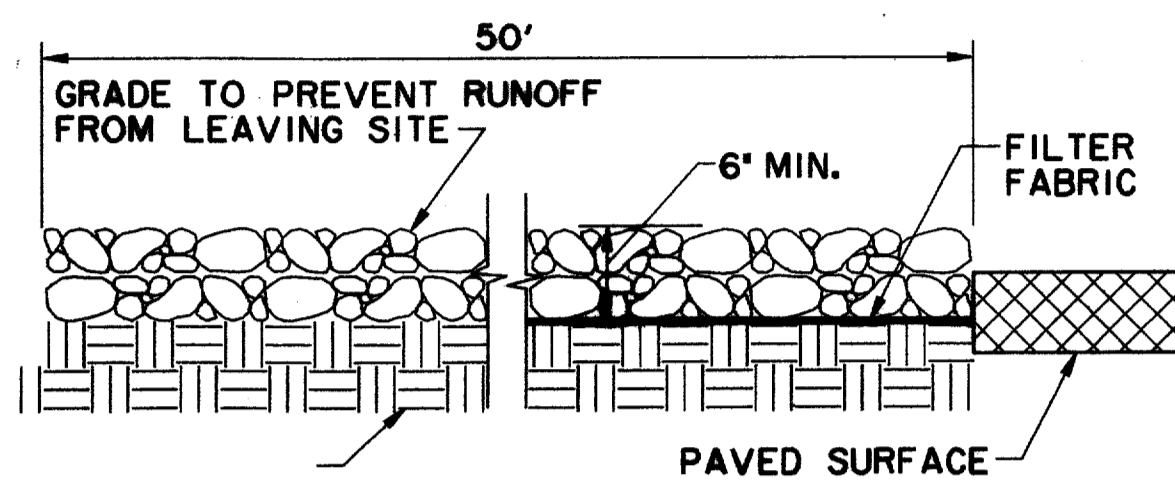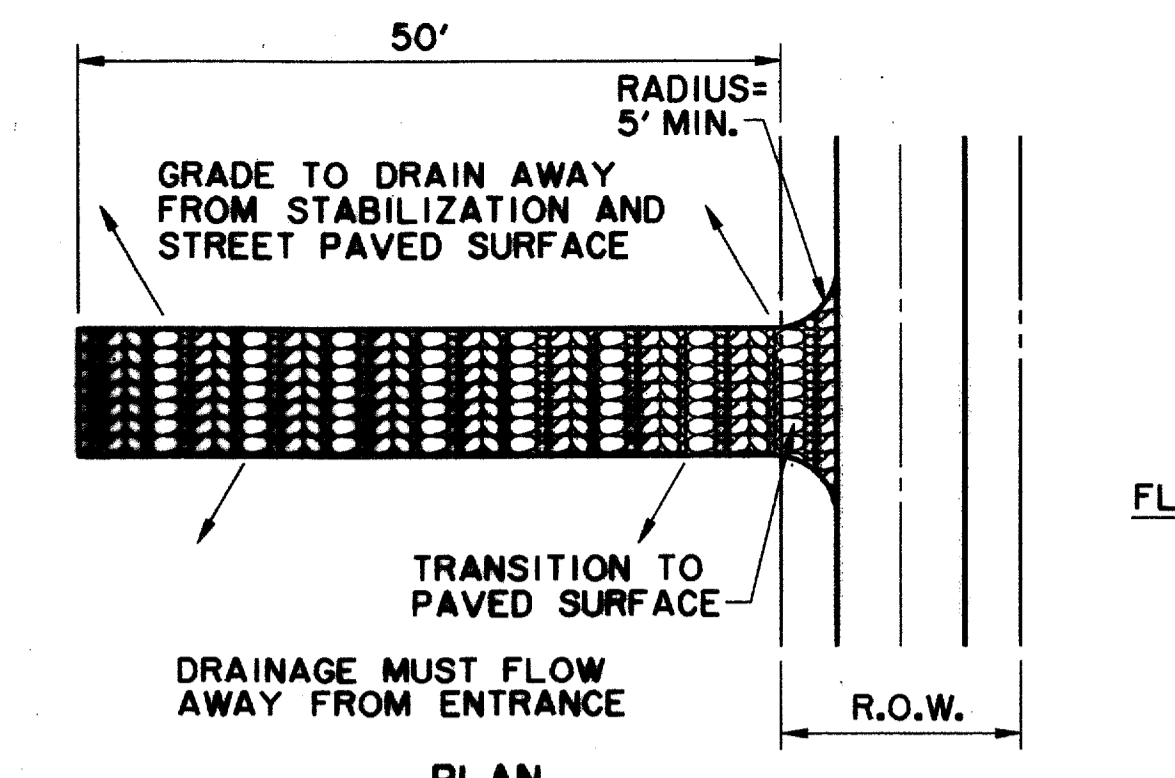


STABILIZED CONSTRUCTION ENTRANCE / EXIT
NCTCOG 02270.G
STORMWATER QUALITY
BEST MANAGEMENT PRACTICES
FOR CONSTRUCTION ACTIVITIES

DETAIL 'A'
N.T.S.

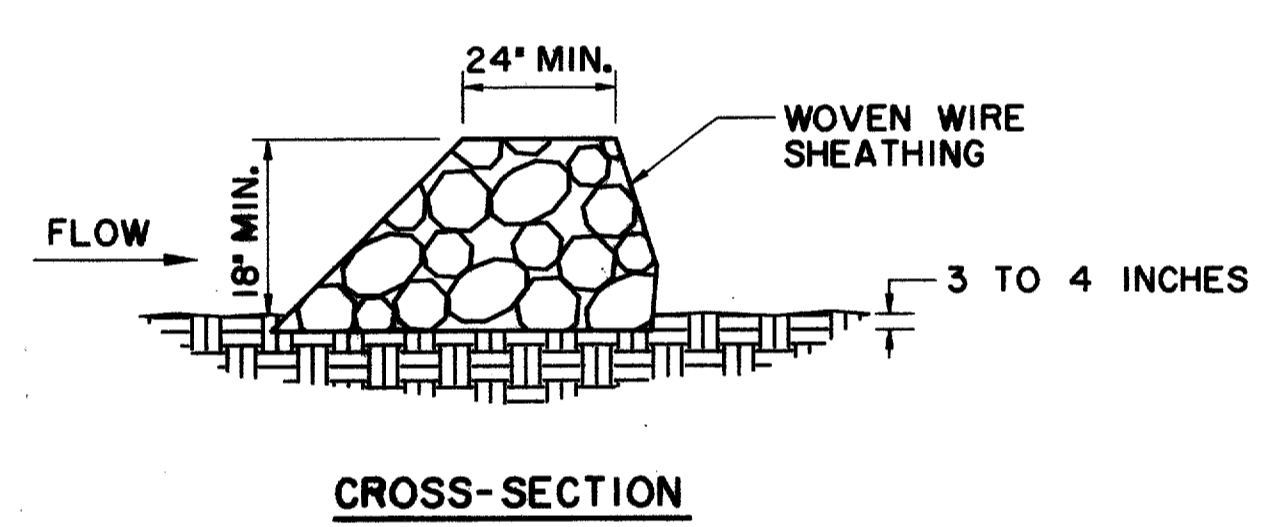

ROCK BERM
NCTCOG 02270.F
STORMWATER QUALITY
BEST MANAGEMENT PRACTICES
FOR CONSTRUCTION ACTIVITIES


DETAIL 'D'
N.T.S.

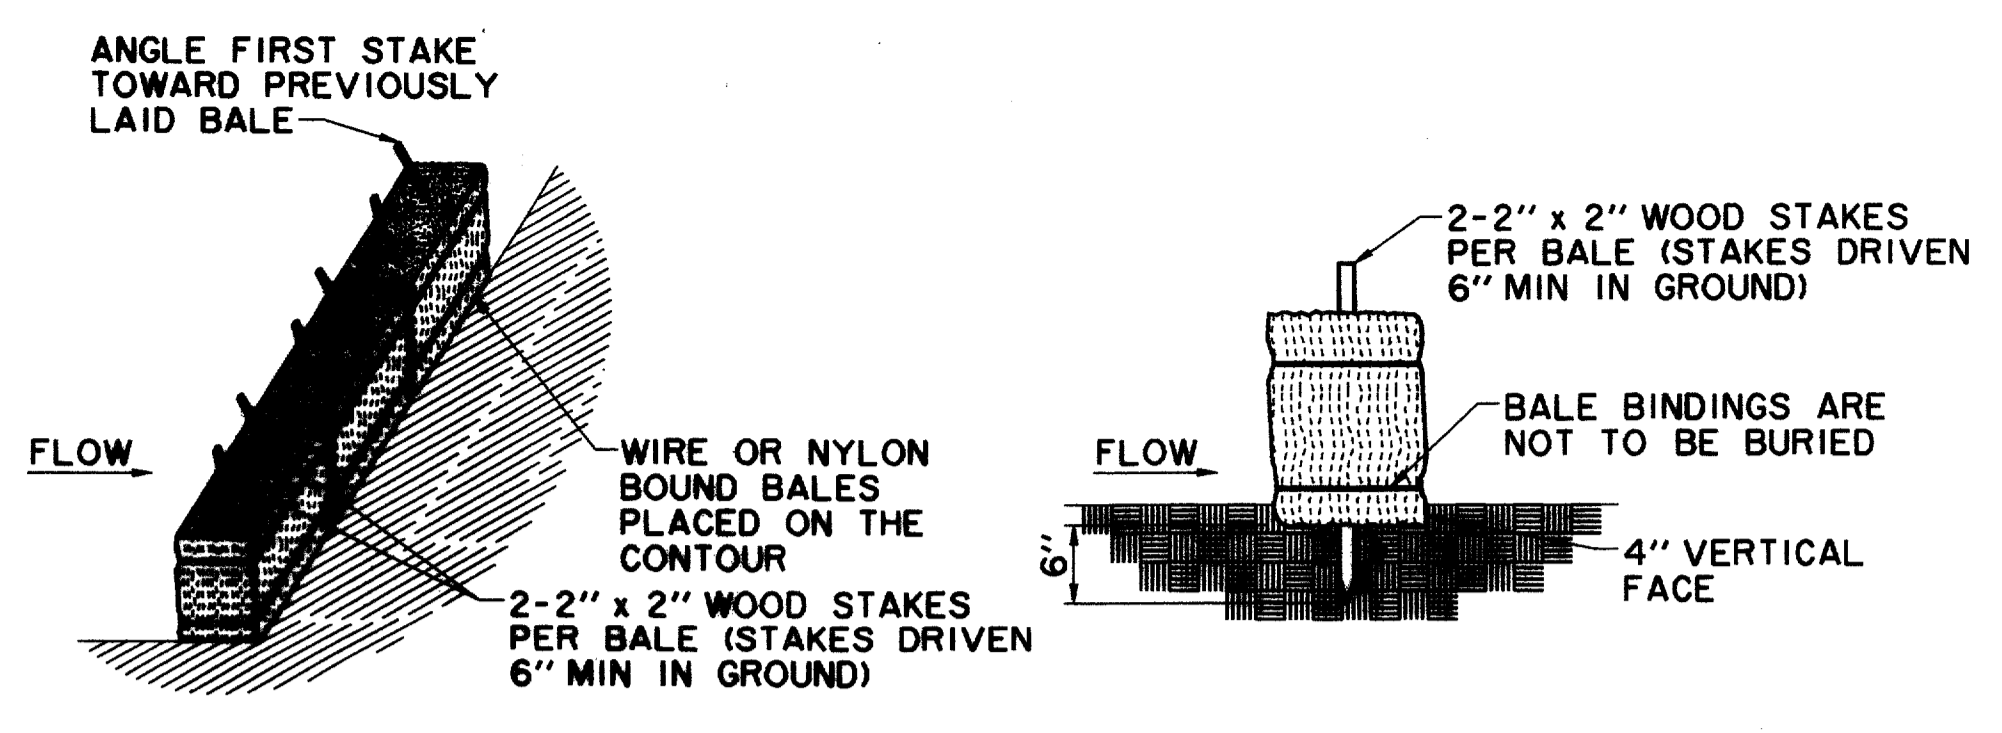

DETAIL 'C'
TEMPORARY STRAW BALE DIKE (CHECK DAM)
NCTCOG 02270.A
STORMWATER QUALITY
BEST MANAGEMENT PRACTICES
FOR CONSTRUCTION ACTIVITIES
N.T.S.



STRAW BALES SHALL BE PLACED IN A ROW WITH TIGHTLY ABUTTING ENDS. EMBED BALES IN THE SOIL A MINIMUM OF FOUR INCHES. STRAW BALES SHALL BE REPLACED IF THEY ARE DAMAGED OR HAVE DEGRADED TO A POINT OF INEFFECTIVENESS. REPLACEMENT OF STRAW BALES SHALL OCCUR NO LESS OFTEN THAN 90 DAYS, UNLESS NOTIFIED BY ENGINEER.

NOTE: HAY BALES TO BE PLACED AROUND ALL INLETS DURING CONSTRUCTION.

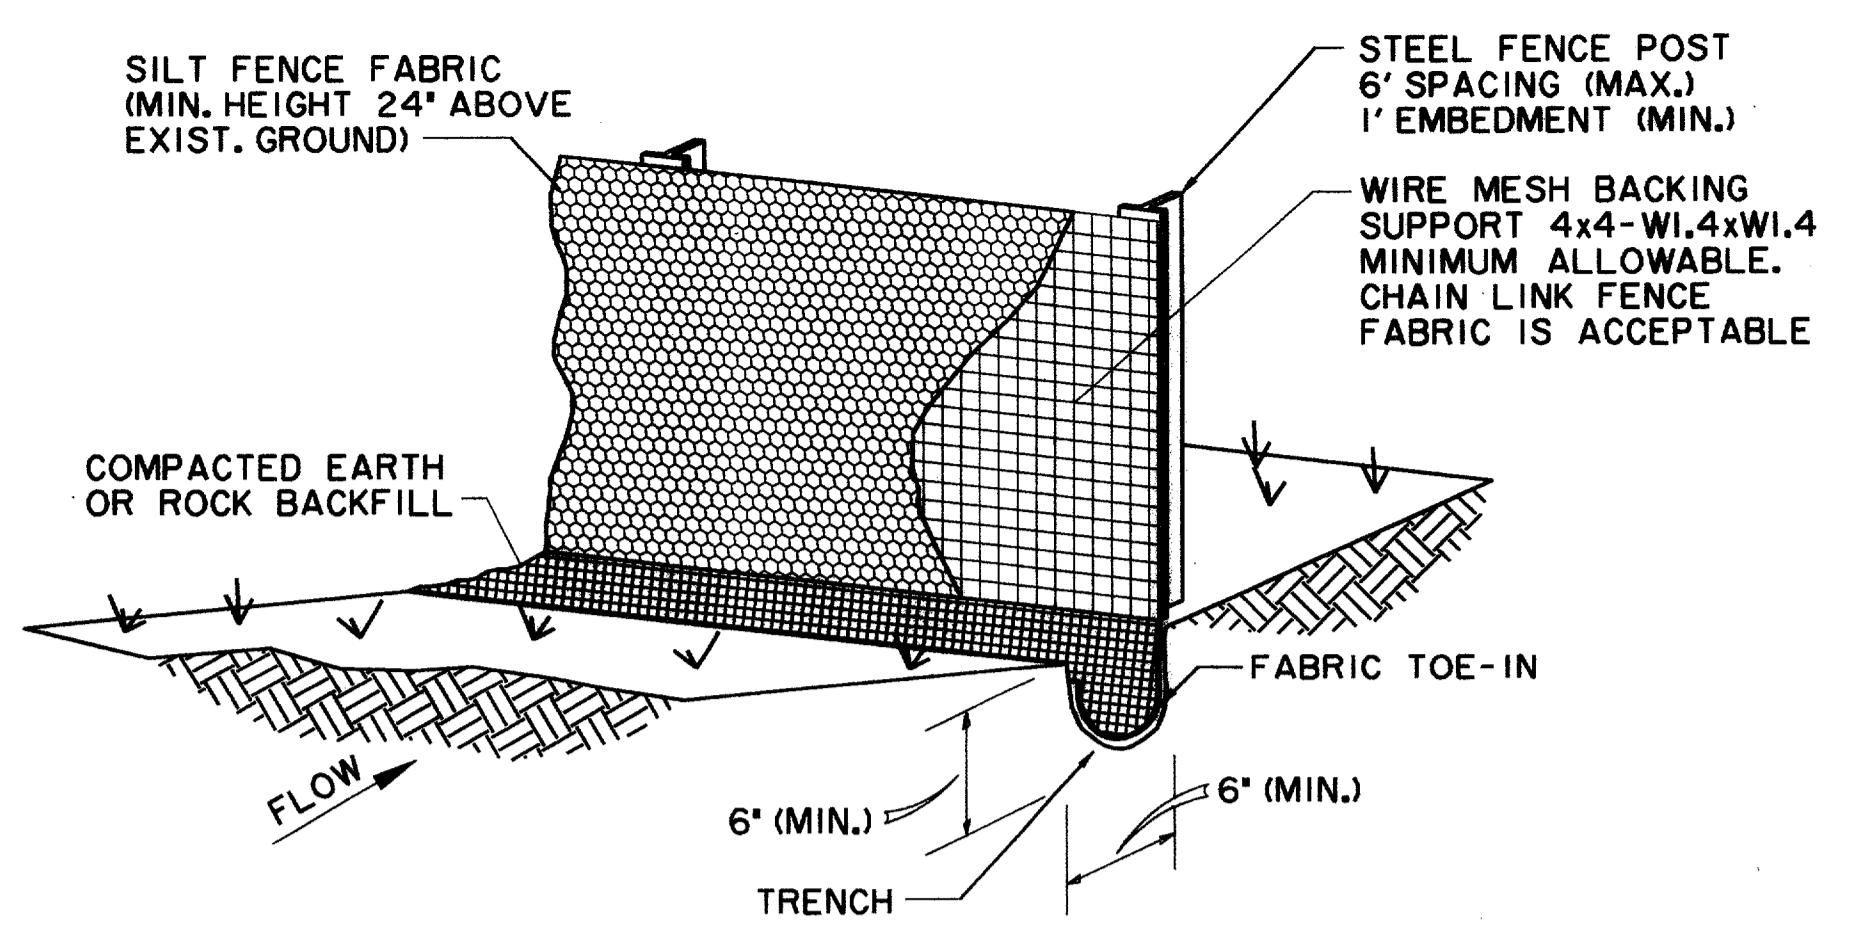


SILT FENCE
NCTCOG 02270.B
STORMWATER QUALITY
BEST MANAGEMENT PRACTICES
FOR CONSTRUCTION ACTIVITIES

SILT FENCE SHOULD BE SECURELY FASTENED TO BACKING SUPPORT AND POSTS.

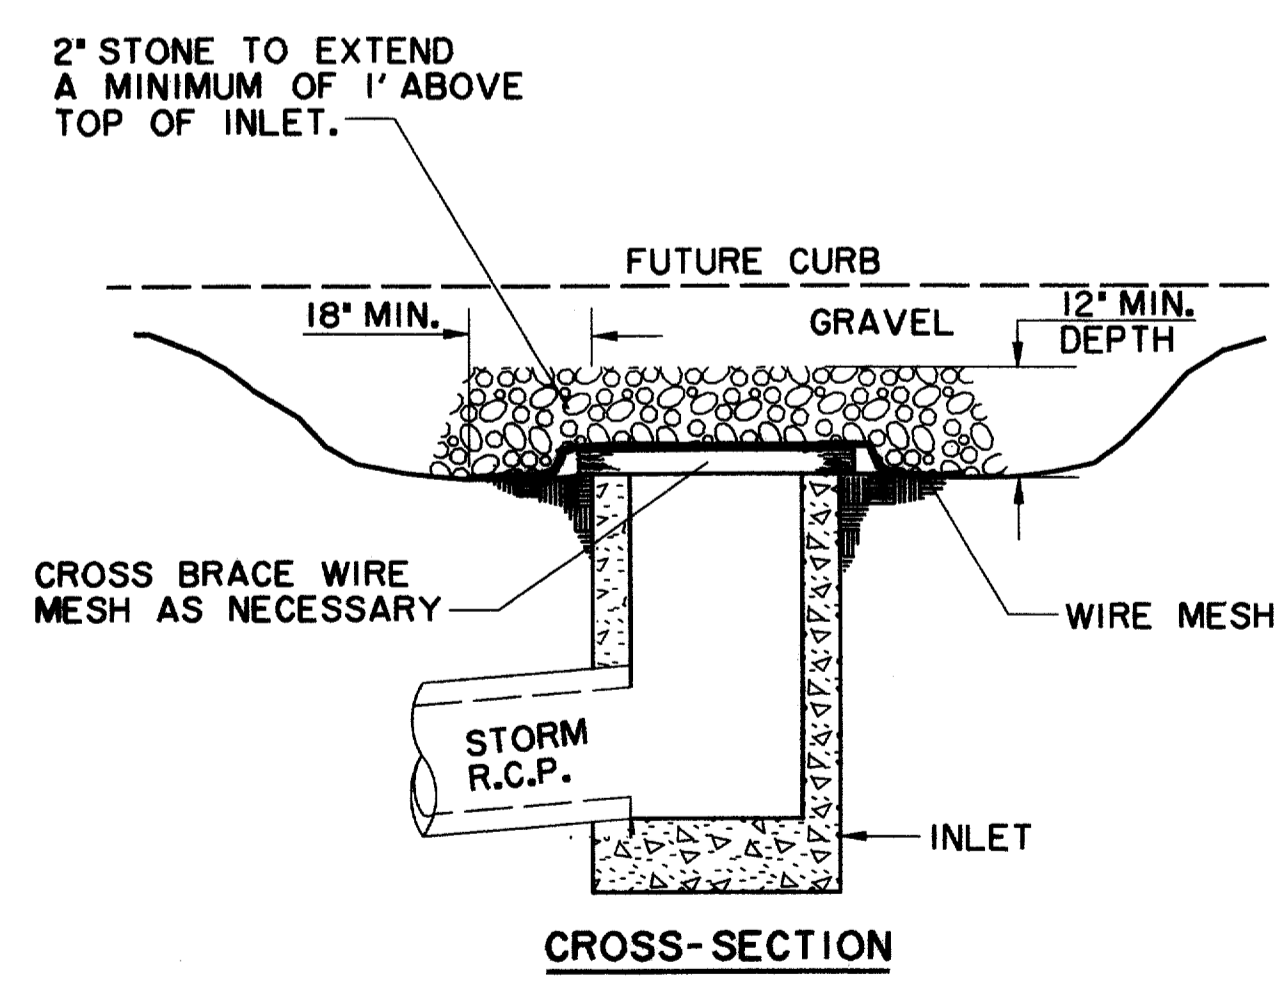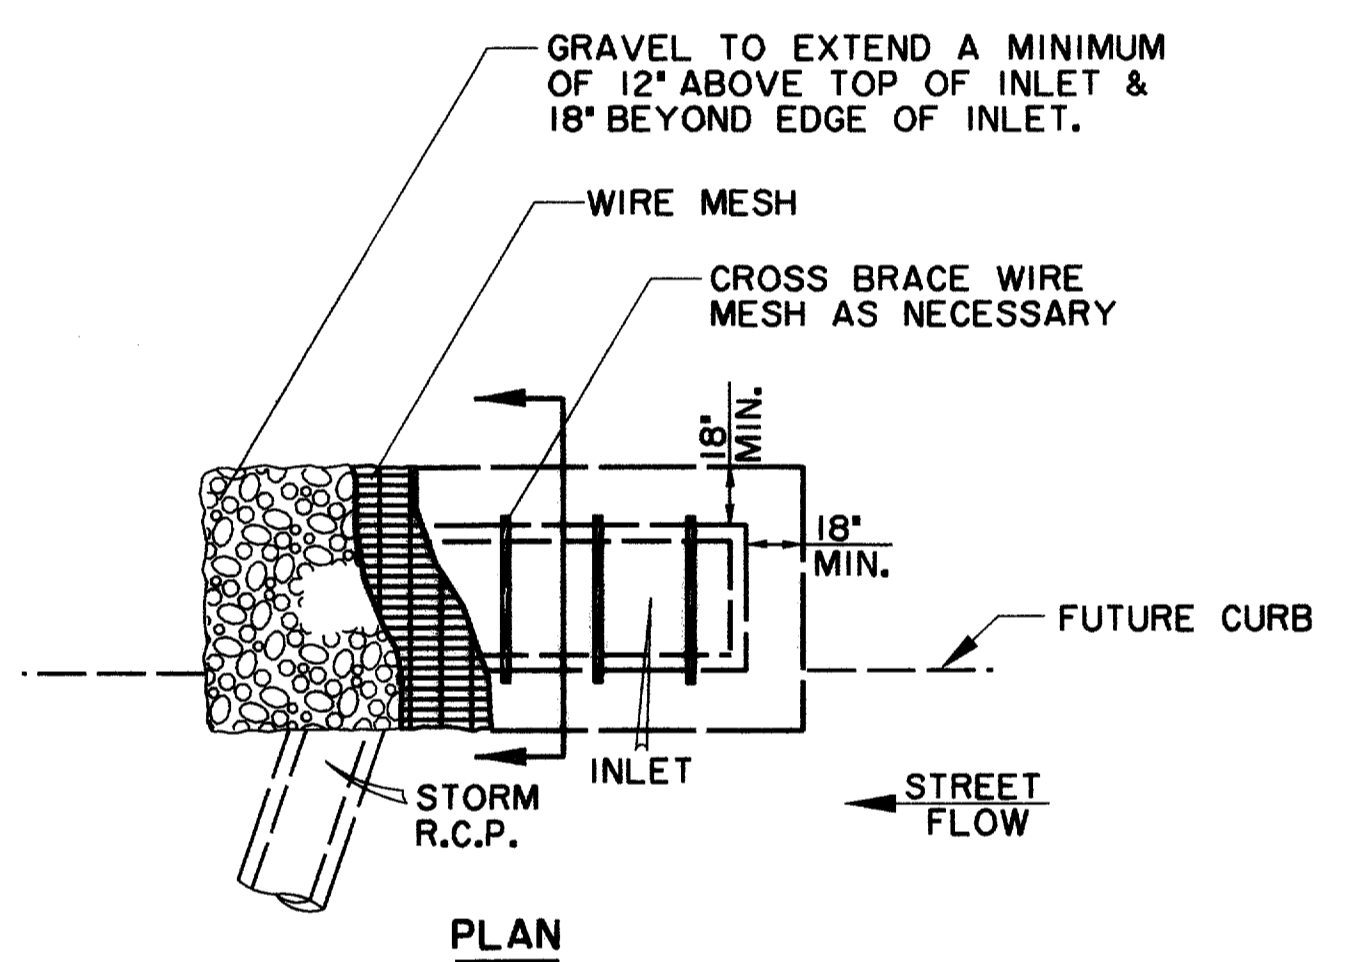


INLET PROTECTION WIRE MESH & GRAVEL
NCTCOG 02270.G
STORMWATER QUALITY
BEST MANAGEMENT PRACTICES
FOR CONSTRUCTION ACTIVITIES

DETAIL 'E'
N.T.S.

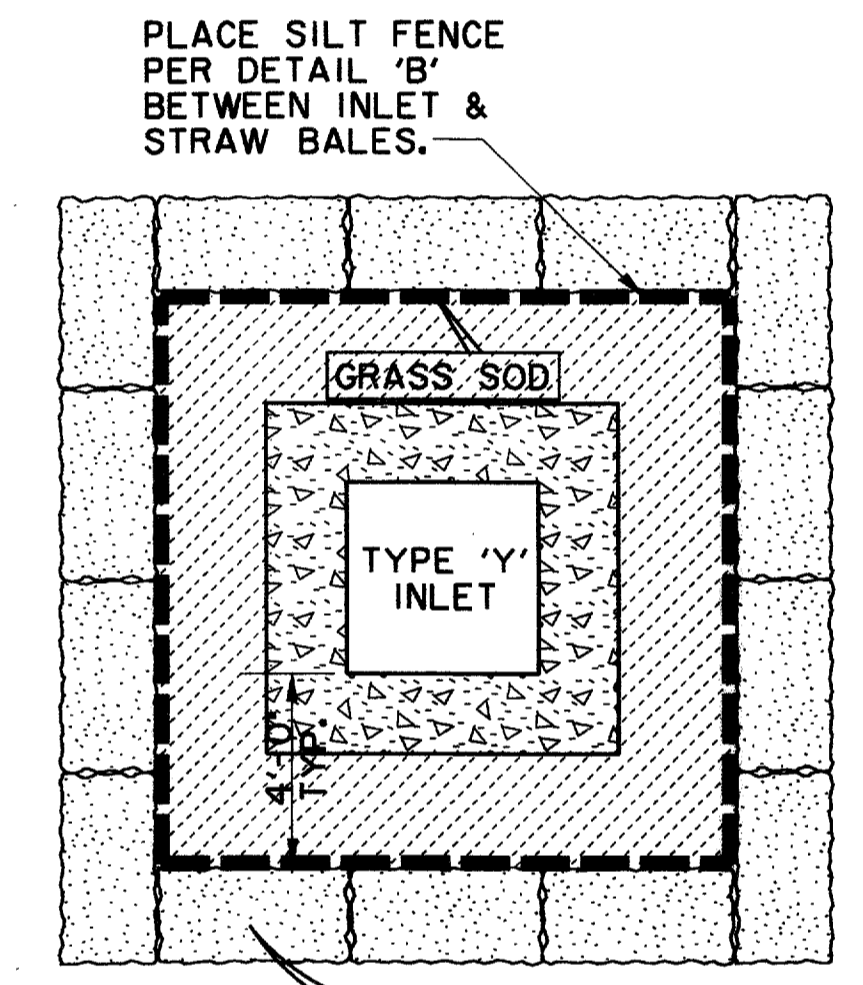

TYPE 'Y' PROTECTION (TYP.)
DETAIL 'F'
N.T.S.

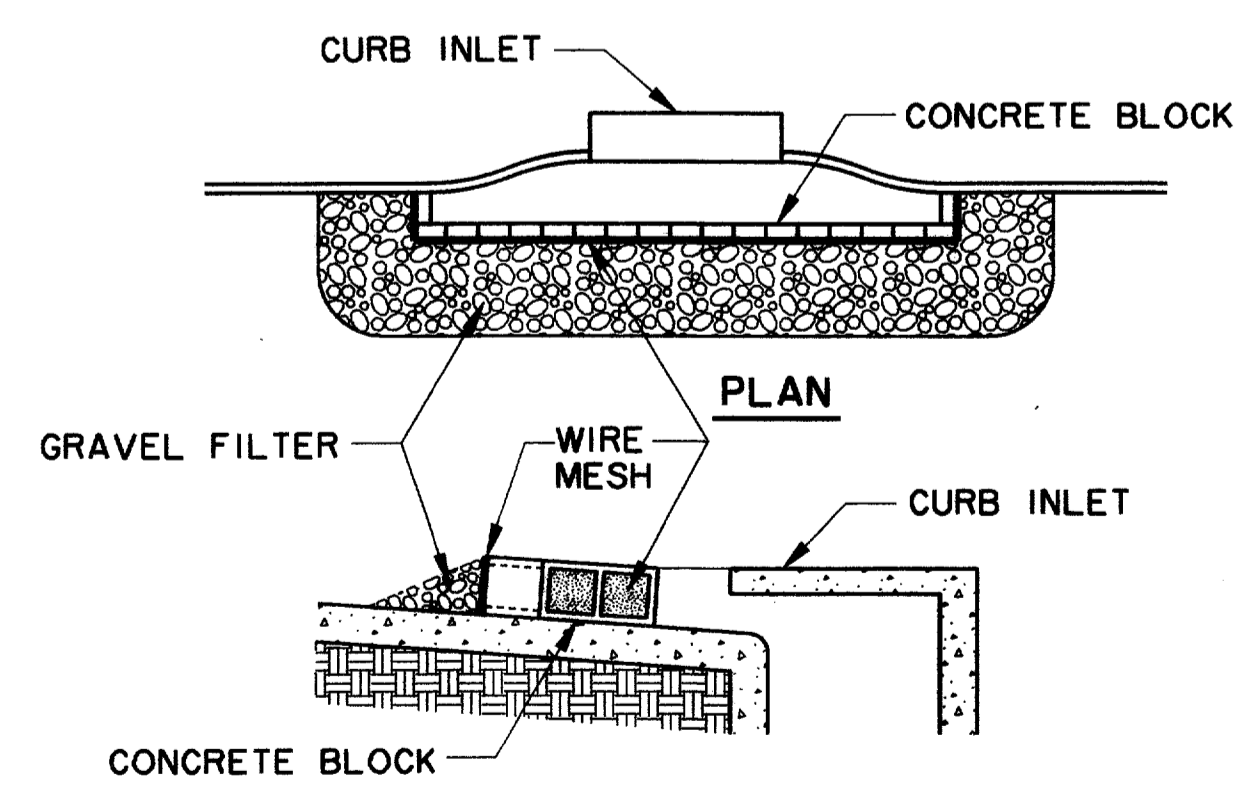


INLET PROTECTION BLOCK & GRAVEL
NCTCOG 02270.G
STORMWATER QUALITY
BEST MANAGEMENT PRACTICES
FOR CONSTRUCTION ACTIVITIES

DETAIL 'G'
N.T.S.


- NOTES:**
1. THE CONTRACTOR SHALL BE RESPONSIBLE FOR THE PREPARATION OF THE SWPPP. THE SWPPP IS NOT A SEPARATE BID ITEM BUT IS SUBSIDIARY TO THE PROJECT. A NOTICE OF INTENT (N.O.I.) WILL BE PREPARED BY THE CONTRACTOR FOR THIS PROJECT IN ACCORDANCE WITH THE REQUIREMENTS OF THE N.P.D.E.S. GENERAL PERMIT FOR STORMWATER DISCHARGES ASSOCIATED WITH CONSTRUCTION.
 2. ALL CONTRACTORS WILL COMPLY WITH THE REQUIREMENTS AND INTENT OF THE N.P.D.E.S. GENERAL PERMIT FOR STORMWATER DISCHARGES.
 3. EACH CONTRACTOR SHALL SUBMIT A NOTICE OF INTENT (N.O.I.) FOR STORMWATER DISCHARGE PERMIT COVERAGE. THIS SUBMITTAL SHALL BE COORDINATED WITH THE TOWN AND SHALL OCCUR NO LESS THAN 48 HOURS PRIOR TO THE COMMENCEMENT OF ANY CONSTRUCTION ACTIVITY.
 4. EACH CONTRACTOR SHALL OBTAIN AND SUBMIT TO TOWN A POLLUTION PREVENTION CERTIFICATION FROM EACH SUBCONTRACTOR WHOSE WORK IMPACTS THE STORMWATER POLLUTION PREVENTION PLAN (S.W.P.P.P.) PRIOR TO THE PERFORMANCE OF ANY WORK BY SAID SUBCONTRACTOR. THESE CERTIFICATIONS SHALL BECOME A PART OF THE STORMWATER POLLUTION PREVENTION PLAN.
 5. CONTRACTOR SHALL INSTALL EROSION CONTROL MEASURES, AS INDICATED ON THE PLANS AND AS FIELD CONDITIONS WARRANT, PRIOR TO COMMENCING ANY CONSTRUCTION ACTIVITY. REPAIRS OR MODIFICATIONS TO THE MEASURES WILL BE MADE BY THE CONTRACTOR IF THE CONTROL MEASURES PROVE INEFFECTIVE OR IF ADDITIONAL CONTROL MEASURES ARE NECESSARY.
 6. CONTRACTOR SHALL TAKE APPROPRIATE MEASURES TO PREVENT TRACKING OF MUD AND/OR SOILS ONTO EXISTING AND/OR NEW PAVEMENT. ANY TRACKING THAT OCCURS SHALL BE REMOVED IMMEDIATELY BY THE CONTRACTOR.
 7. CONTRACTOR SHALL CONSTRUCT INLET PROTECTION FOR ALL INCOMPLETE CURB INLETS AND SHALL TAKE EVERY MEASURE TO KEEP SOILS AND SEDIMENTS FROM ENTERING THE STORM SEWER SYSTEM.
 8. CONTRACTOR SHALL CONSTRUCT DROP INLET PROTECTION FOR ALL INCOMPLETE DROP INLETS AND SHALL TAKE EVERY MEASURE TO KEEP SOILS AND SEDIMENTS FROM ENTERING THE STORM SEWER SYSTEM.
 9. AT A MINIMUM, PERIMETER CONTROLS SUCH AS SILT FENCE OR STRAW BALES SHALL BE INSTALLED AT ALL DOWN SLOPE BOUNDARIES AND AS WARRANTED WHERE PAVEMENT REMOVAL, UTILITY CONSTRUCTION, GRADING, OR OTHER CONSTRUCTION ACTIVITIES ARE TO BE PERFORMED. THE CONTRACTOR SHALL AT ALL TIMES TAKE SUCH MEASURES AS NECESSARY TO MINIMIZE OFFSITE TRACKING OR TRANSPORT OF SEDIMENT AND DEBRIS.
 10. DAMAGE TO ADJACENT PROPERTY AND/OR TO RECEIVING WATERS CAUSED BY IMPROPERLY INSTALLED OR POORLY MAINTAINED EROSION CONTROL MEASURES WILL BE THE RESPONSIBILITY OF THE CONTRACTOR.
 11. THE CONTRACTOR SHALL BE RESPONSIBLE FOR THE REMOVAL AND DISPOSAL OF ANY SILTATION CAUSED BY HIS OPERATIONS AND/OR FAILURE OF THE EROSION CONTROL MEASURES.
 12. CONTRACTOR SHALL REMOVE AND PROPERLY DISPOSE OF ACCUMULATED SILT AND SEDIMENT FROM EROSION CONTROL MEASURES WHEN IT REACHES A DEPTH OF SIX (6) INCHES OR IMPAIRS THE EFFECTIVENESS OF THE MEASURES.
 13. THE TOWN'S REPRESENTATIVE WILL INSPECT THE PROJECT EVERY SEVEN DAYS, AT A MINIMUM, AND AFTER EVERY RAINFALL OF ONE-HALF INCHES OR GREATER TO DETERMINE THE INTEGRITY AND EFFECTIVENESS OF THE EROSION CONTROL MEASURES. A WRITTEN INSPECTION REPORT WILL BE FILED WITH THE POLLUTION PREVENTION PLAN. THIS INSPECTION DOES NOT RELIEVE THE CONTRACTOR'S RESPONSIBILITY FOR INSPECTION AND MAINTENANCE OF THE EROSION CONTROL MEASURES OR HIS DUTY TO COMPLY WITH THE INTENT AND CONDITIONS OF THE N.P.D.E.S. GENERAL PERMIT.
 14. ALL STOCKPILED SOILS WILL BE SURROUNDED BY A STRAW BALE DIKE, SILT FENCE, SEDIMENT CONTROL SWALE, OR EQUIVALENT MEASURE TO PROPERLY CONTROL SEDIMENT RUNOFF, AS APPROVED BY THE TOWN.
 15. CONTRACTOR SHALL STABILIZE ANY AREA WHERE CONSTRUCTION ACTIVITY IS TO BE TEMPORARILY OR PERMANENTLY CEASED FOR MORE THAN 14 DAYS.

RECORD DOCUMENTS 6/9/2000

THESE RECORD DOCUMENTS HAVE BEEN PREPARED BASED ON INFORMATION PROVIDED BY OTHERS. THE CONSULTANT HAS NOT VERIFIED THE ACCURACY AND/OR COMPLETENESS OF THIS INFORMATION AND SHALL NOT BE RESPONSIBLE FOR ANY ERRORS OR OMISSIONS THAT MAY BE INCORPORATED AS A RESULT OF ERRONEOUS INFORMATION PROVIDED BY OTHERS.

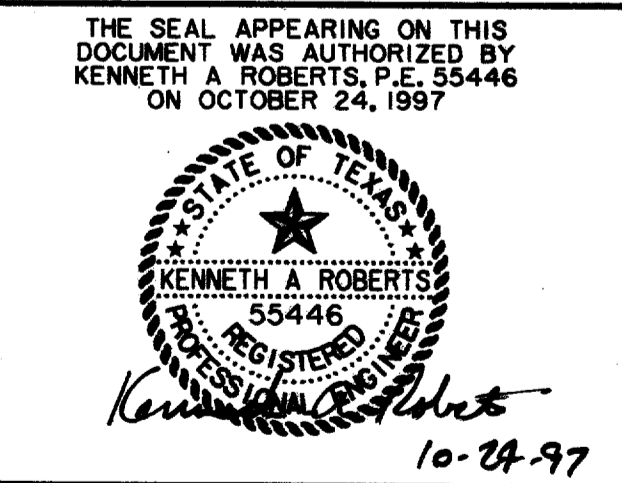

POLLUTION CONTROL DETAILS						
ARAPAHO ROAD						
ADDISON ROAD TO DALLAS NORTH TOLLWAY						
TOWN OF ADDISON, TEXAS						
Hultt-Zollars, Inc./Consulting Engineers Dallas, Fort Worth, Houston, Phoenix, Tustin						
DESIGN	DRAWN	APPR.	SCALE	DATE	PROJECT NO.	NO.
HZI	HZI	KAR	N.T.S.	OCT 97	1772-01	ST-17

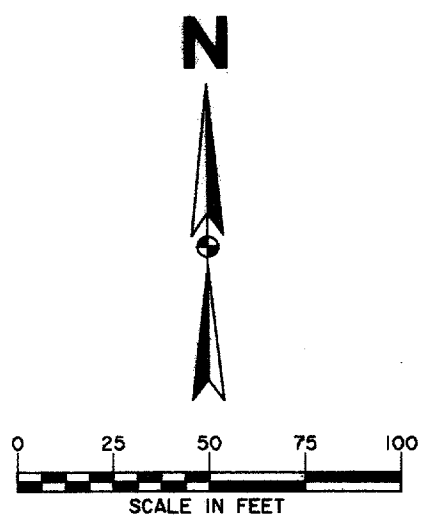

SEQUENCE OF CONSTRUCTION
(For Bidding Purposes Only)

GENERAL:

1. THE SEQUENCE OF CONSTRUCTION SHOWN ON THE PLANS IS FOR THE PREPARATION AND COMPARISON OF BIDS ONLY. PRIOR TO THE START OF WORK, THE CONTRACTOR SHALL DEVELOP, IN DETAIL, A CONSTRUCTION SCHEDULE AND SEQUENCE OF CONSTRUCTION THAT SHALL CAUSE MINIMUM INTERFERENCE WITH TRAFFIC ALONG, ACROSS AND ADJACENT TO THE PROJECT DURING CONSTRUCTION. IF THE SCHEDULE OR SEQUENCE BECOMES UNWORKABLE OR UNSATISFACTORY AS WORK PROCEEDS, ADJUSTMENTS SHALL BE MADE. TWO LANES OF TRAFFIC ON ARAPAHO ROAD (ONE IN EACH DIRECTION) AND ACCESS TO ALL SIDE STREETS AND DRIVEWAYS MUST BE MAINTAINED AT ALL TIMES UNLESS OTHERWISE AUTHORIZED IN WRITING BY THE TOWN OF ADDISON.
2. DURING ALL PHASES OF CONSTRUCTION, TWO LANES OF TRAFFIC (22' MIN. PAVEMENT WIDTH INCLUDING DETOUR PAVEMENT) ON ARAPAHO ROAD (ONE IN EACH DIRECTION) AND ACCESS TO ALL SIDE STREETS AND DRIVEWAYS MUST BE MAINTAINED AT ALL TIMES UNLESS OTHERWISE AUTHORIZED IN WRITING BY THE TOWN OF ADDISON.
3. LIGHTED BARRICADES, TEMPORARY PAVEMENT MARKINGS, AND CHANNELIZING DEVICES CONFORMING TO THE CURRENT EDITION OF THE M.U.T.C.D. SHALL BE USED DURING ALL STAGES OF CONSTRUCTION TO CONTROL TRAFFIC FLOW THROUGH THE WORK ZONES.
4. MAINTAIN A MINIMUM RADIUS OF 20 FEET ON ALL STREET CONNECTIONS AND 10 FEET ON ALL DRIVEWAY CONNECTIONS DURING CONSTRUCTION OF ARAPAHO ROAD TO ACCOMMODATE THE TRAFFIC USING THE ROADWAY DURING CONSTRUCTION.
5. POLLUTION CONTROL DEVICES MUST BE PROPERLY INSTALLED AND MAINTAINED DURING ALL STAGES OF CONSTRUCTION.
6. VERIFY THE LOCATION OF ALL EXISTING UTILITIES AND RELOCATE, IF NECESSARY, PRIOR TO THE START OF ANY STAGE OF CONSTRUCTION, AND INSTALL STORMWATER TO THE EXTENT POSSIBLE.
7. DRIVEWAY CONSTRUCTION MAY BE DONE DURING ONE PHASE OF CONSTRUCTION INSTEAD OF TWO PHASES (1/2 DRIVE - 1/2 DRIVE) WITH THE PERMISSION OF THE AFFECTED PROPERTY OWNER. CONTACT THE AFFECTED PROPERTY OWNER A MINIMUM 48 HOURS PRIOR TO BEGINNING CONSTRUCTION OF ANY DRIVEWAYS.
8. IT IS ASSUMED THAT ALL FRANCHISED UTILITIES HAVE BEEN RELOCATED BY OTHERS PRIOR TO THE COMMENCEMENT OF CONSTRUCTION.
9. THE CONTRACTOR SHALL VERIFY THE LOCATION OF ALL EXISTING UTILITIES PRIOR TO THE COMMENCEMENT OF CONSTRUCTION AND NOTIFY THE TOWN OF ADDISON AND RELATIVE UTILITY COMPANY IMMEDIATELY IF A CONFLICT IS FOUND TO EXIST.
10. CONTRACTOR SHALL COORDINATE & COOPERATE WITH THE DART CONTRACTOR WHO IS CONSTRUCTING THE DART STATION AT THE NORTHWEST CORNER OF QUORUM DRIVE & PROPOSED ARAPAHO ROAD.

NOTE:
CONTRACTOR SHALL COMPLETE THE SECTION OF ARAPAHO ROAD FROM ADDISON ROAD TO QUORUM DRIVE BY SEPTEMBER 30, 1998.

RECORD DOCUMENTS 6/9/2000

THESE RECORD DOCUMENTS HAVE BEEN PREPARED BASED ON INFORMATION PROVIDED BY OTHERS. THE CONSULTANT HAS NOT VERIFIED THE ACCURACY AND/OR COMPLETENESS OF THIS INFORMATION AND SHALL NOT BE RESPONSIBLE FOR ANY ERRORS OR OMISSIONS THAT MAY BE INCORPORATED AS A RESULT OF ERRONEOUS INFORMATION PROVIDED BY OTHERS.

THE SEAL APPEARING ON THIS DOCUMENT WAS AUTHORIZED BY KENNETH A. ROBERTS, P.E. 55446 ON OCTOBER 24, 1997



CONSTRUCTION SEQUENCING PLAN
PHASE I

ARAPAHO ROAD


ADDISON ROAD TO DALLAS NORTH TOLLWAY

TOWN OF ADDISON, TEXAS

Huitt-Zollars, Inc./Consulting Engineers
Dallas, Fort Worth, Houston, Phoenix, Tustin

DESIGN	DRAWN	APPR.	SCALE	DATE	PROJECT NO.	NO.
HZI	HZI	KAR	1"=50'	OCT 97	1772-01	CS-1


	TEMPORARY DETOUR (ASPHALT)
	UNDER CONSTRUCTION
	COMPLETED CONSTRUCTION
	TRAFFIC FLOW DURING CONSTRUCTION

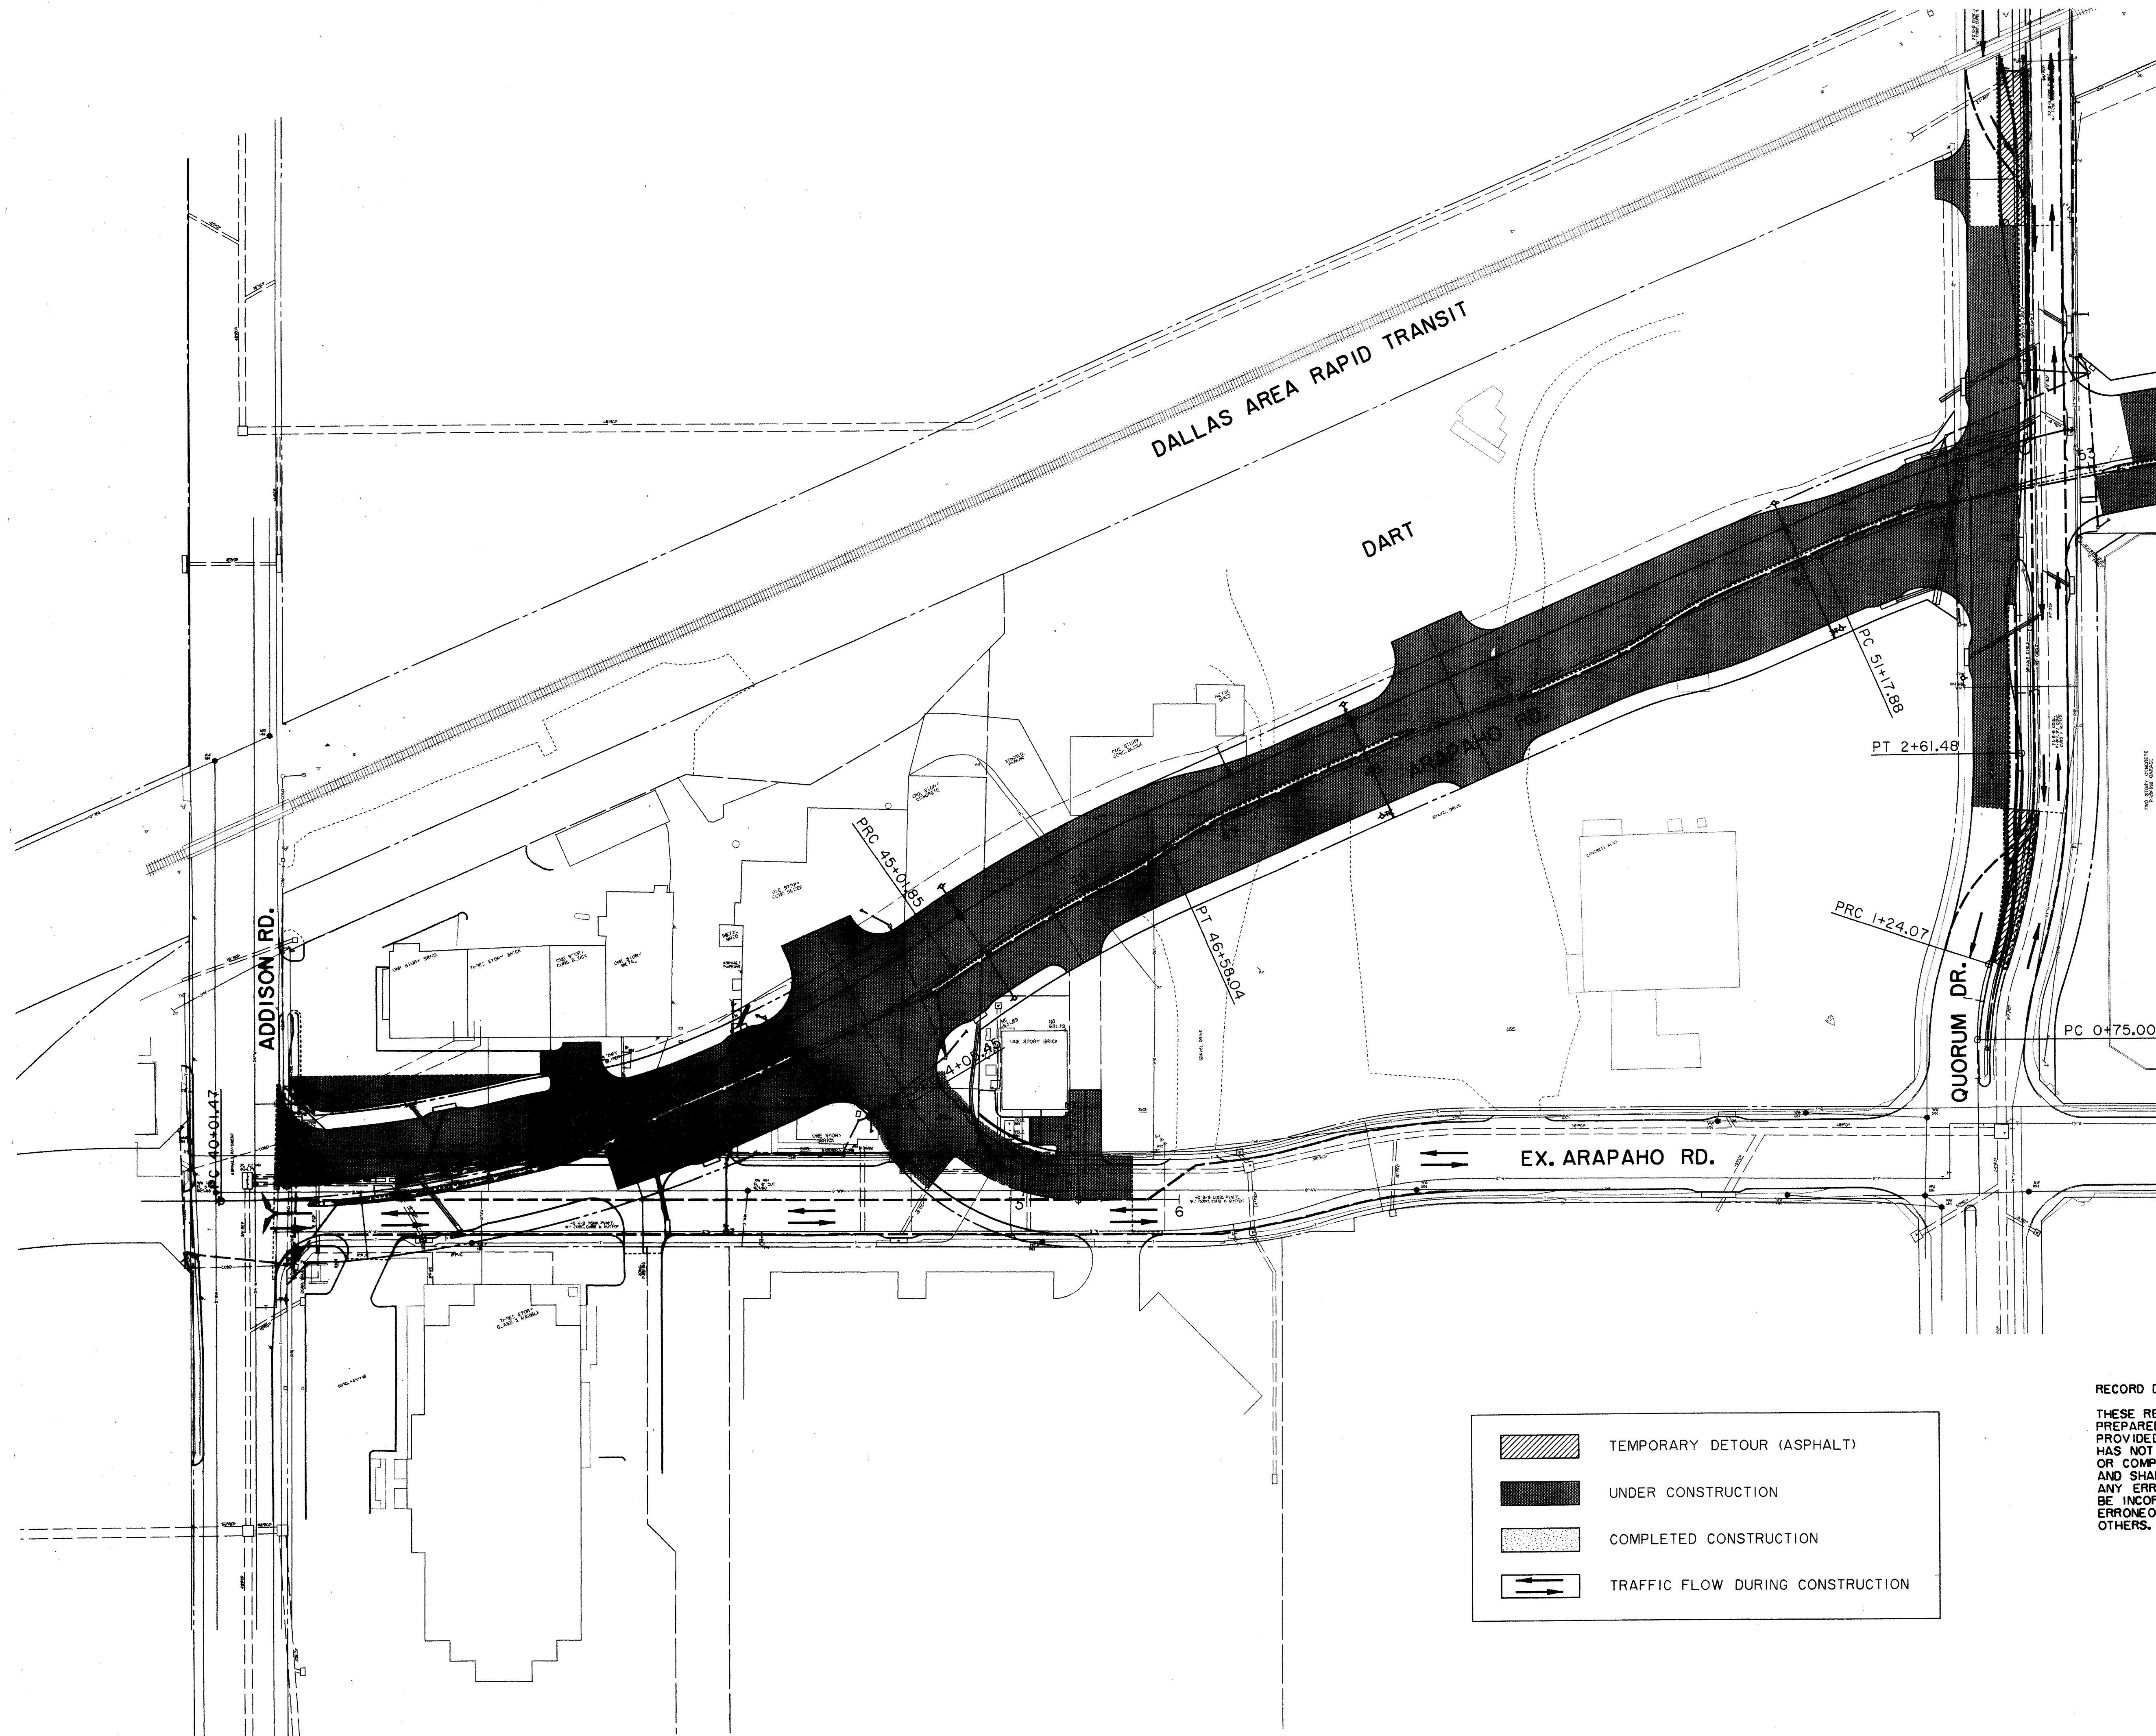

THESE RECORD DOCUMENTS HAVE BEEN PREPARED BASED ON INFORMATION PROVIDED BY OTHERS. THE CONSULTANT HAS NOT VERIFIED THE ACCURACY AND/OR COMPLETENESS OF THIS INFORMATION AND SHALL NOT BE RESPONSIBLE FOR ANY ERRORS OR OMISSIONS THAT MAY BE INCORPORATED AS A RESULT OF ERRONEOUS INFORMATION PROVIDED BY OTHERS.

THESE RECORD DOCUMENTS HAVE BEEN PREPARED BASED ON INFORMATION PROVIDED BY OTHERS. THE CONSULTANT HAS NOT VERIFIED THE ACCURACY AND/OR COMPLETENESS OF THIS INFORMATION AND SHALL NOT BE RESPONSIBLE FOR ANY ERRORS OR OMISSIONS THAT MAY BE INCORPORATED AS A RESULT OF ERRONEOUS INFORMATION PROVIDED BY OTHERS.

DALLAS AREA RAPID TRANSIT

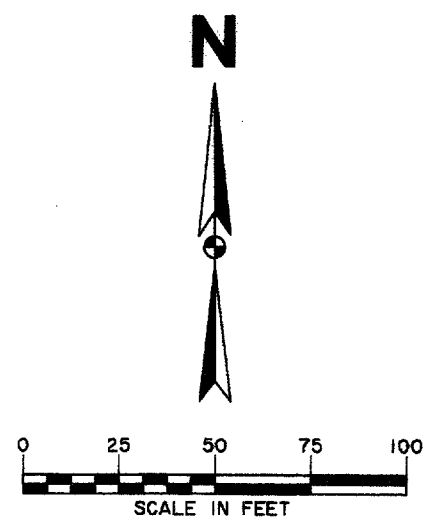

MATCH LINE

PT 54+85.75

PC 57+07.96

PT 61+25.76

PC 61+62.66

PT 64+35.91

PC 66+51.52

PT 66+65.39

68

69

DALLAS NORTH TOLLWAY


EX. ARAPAHO RD.

SPECTRUM



	TEMPORARY DETOUR (ASPHALT)
	UNDER CONSTRUCTION
	COMPLETED CONSTRUCTION
	TRAFFIC FLOW DURING CONSTRUCTION

RECORD DOCUMENTS 6/9/2000
 THESE RECORD DOCUMENTS HAVE BEEN PREPARED BASED ON INFORMATION PROVIDED BY OTHERS. THE CONSULTANT HAS NOT VERIFIED THE ACCURACY AND/OR COMPLETENESS OF THIS INFORMATION AND SHALL NOT BE RESPONSIBLE FOR ANY ERRORS OR OMISSIONS THAT MAY BE INCORPORATED AS A RESULT OF ERRONEOUS INFORMATION PROVIDED BY OTHERS.

THE SEAL APPEARING ON THIS DOCUMENT WAS AUTHORIZED BY KENNETH A. ROBERTS, P.E. 55446 ON OCTOBER 24, 1997

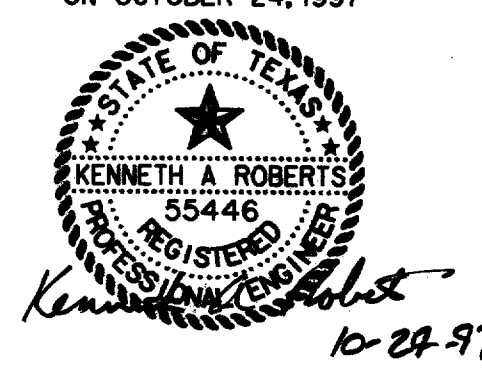

CONSTRUCTION SEQUENCING PLAN						
PHASE I						
ARAPAHO ROAD						
ADDISON ROAD TO DALLAS NORTH TOLLWAY						
TOWN OF ADDISON, TEXAS						
Hultt-Zollars, Inc./Consulting Engineers Dallas, Fort Worth, Houston, Phoenix, Tustin						
DESIGN	DRAWN	APPR.	SCALE	DATE	PROJECT NO.	NO.
HZI	HZI	KAR	1"=50'	OCT 97	1772-01	CS-2

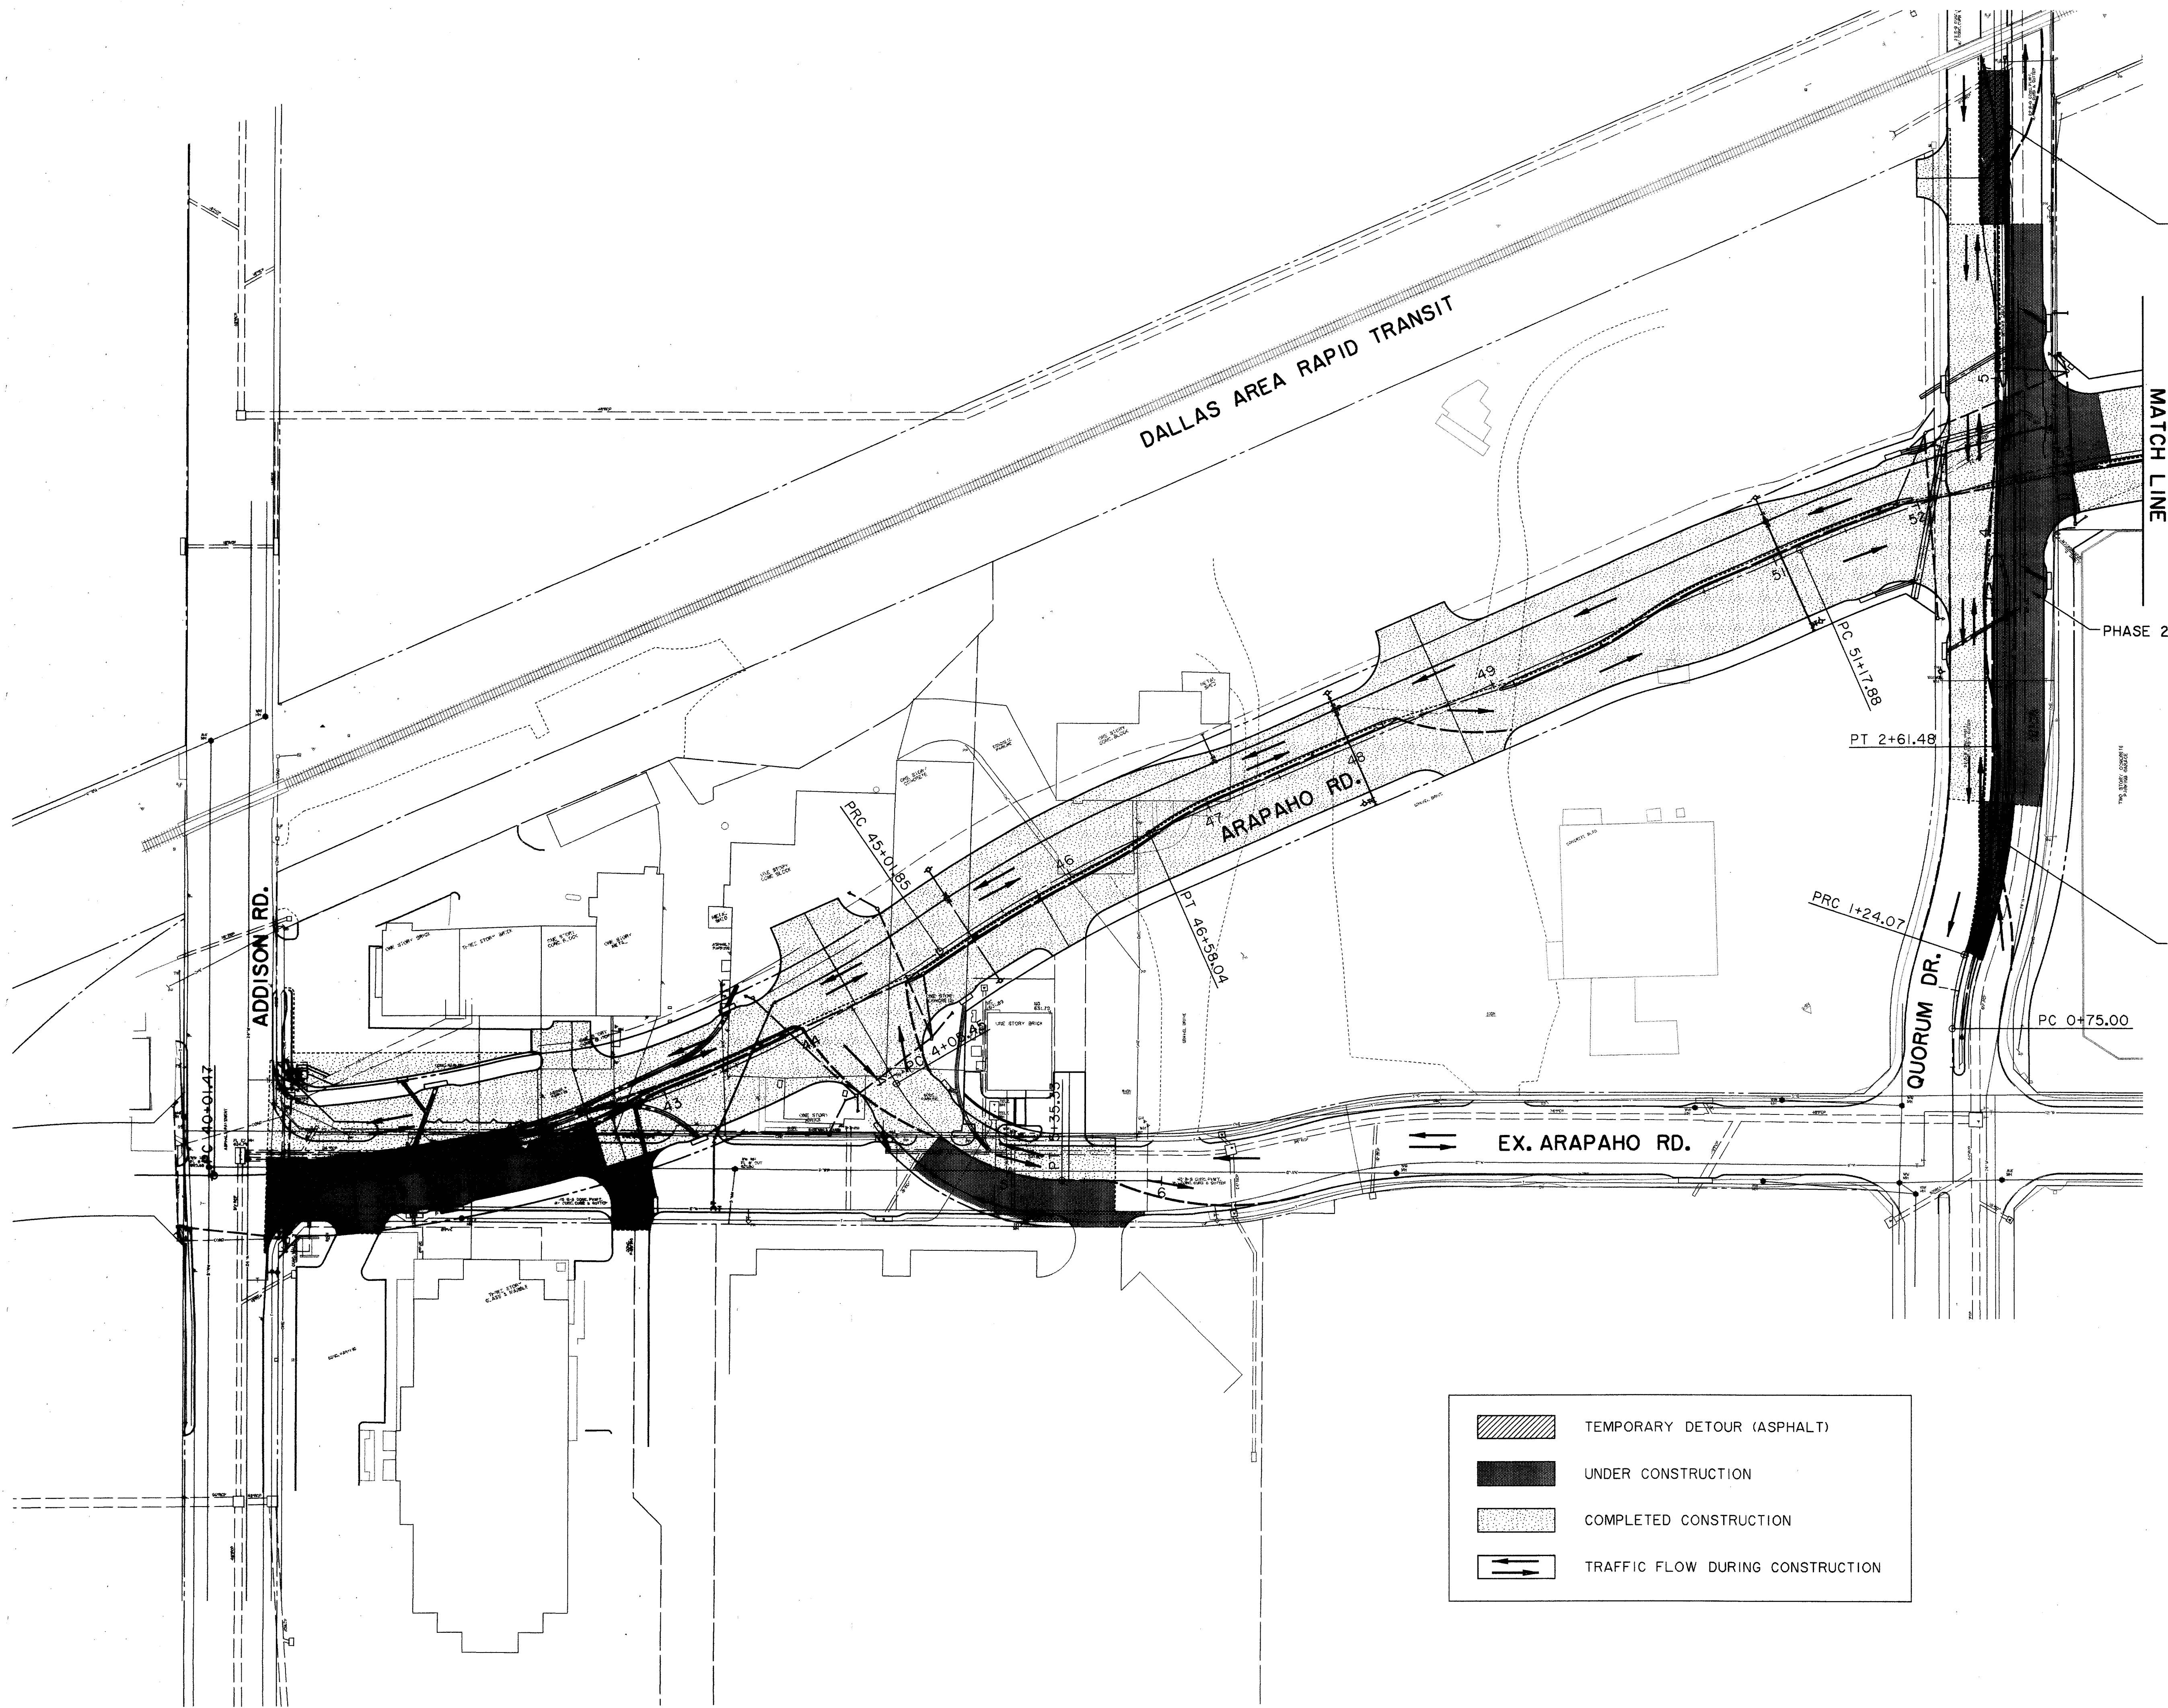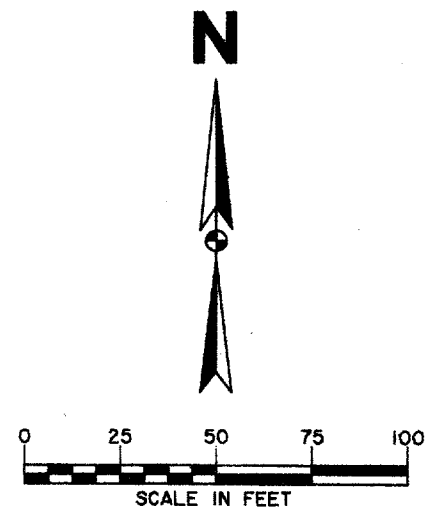


PHASE 2-B
COMPLETE TURN LANE CONSTRUCTION
AFTER QUORUM DRIVE MAIN LANES
ARE COMPLETE.

MATCH LINE

PHASE 2-A

PHASE 2-B
COMPLETE TURN LANE CONSTRUCTION
AFTER QUORUM DRIVE MAIN LANES
ARE COMPLETE.



RECORD DOCUMENTS 6/9/2000
THESE RECORD DOCUMENTS HAVE BEEN
PREPARED BASED ON INFORMATION
PROVIDED BY OTHERS. THE CONSULTANT
HAS NOT VERIFIED THE ACCURACY AND/
OR COMPLETENESS OF THIS INFORMATION
AND SHALL NOT BE RESPONSIBLE FOR
ANY ERRORS OR OMISSIONS THAT MAY
BE INCORPORATED AS A RESULT OF
ERRONEOUS INFORMATION PROVIDED BY
OTHERS.

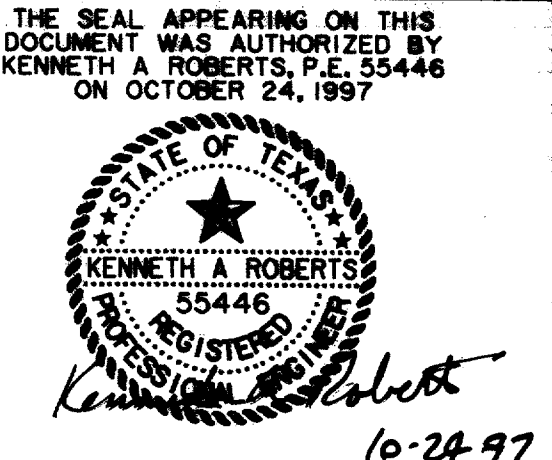

- TEMPORARY DETOUR (ASPHALT)
- UNDER CONSTRUCTION
- COMPLETED CONSTRUCTION
- TRAFFIC FLOW DURING CONSTRUCTION


CONSTRUCTION SEQUENCING PLAN						
PHASE 2						
ARAPAHO ROAD						
ADDISON ROAD TO DALLAS NORTH TOLLWAY						
TOWN OF ADDISON, TEXAS						
Huitt-Zollars, Inc./Consulting Engineers Dallas, Fort Worth, Houston, Phoenix, Tustin						
DESIGN	DRAWN	APPR.	SCALE	DATE	PROJECT NO.	NO.
HZI	HZI	KAR	1"=50'	OCT 97	1772-01	CS-3

ALL INFORMATION CONTAINED HEREIN IS THE PROPERTY OF HUIITT-ZOLLARS, INC. IT IS TO BE USED ONLY FOR THE PROJECT AND SITE SPECIFICALLY IDENTIFIED HEREIN. NO PART OF THIS DOCUMENT IS TO BE REPRODUCED OR TRANSMITTED IN ANY FORM OR BY ANY MEANS, ELECTRONIC OR MECHANICAL, INCLUDING PHOTOCOPYING, RECORDING, OR BY ANY INFORMATION STORAGE AND RETRIEVAL SYSTEM, WITHOUT THE WRITTEN PERMISSION OF HUIITT-ZOLLARS, INC.

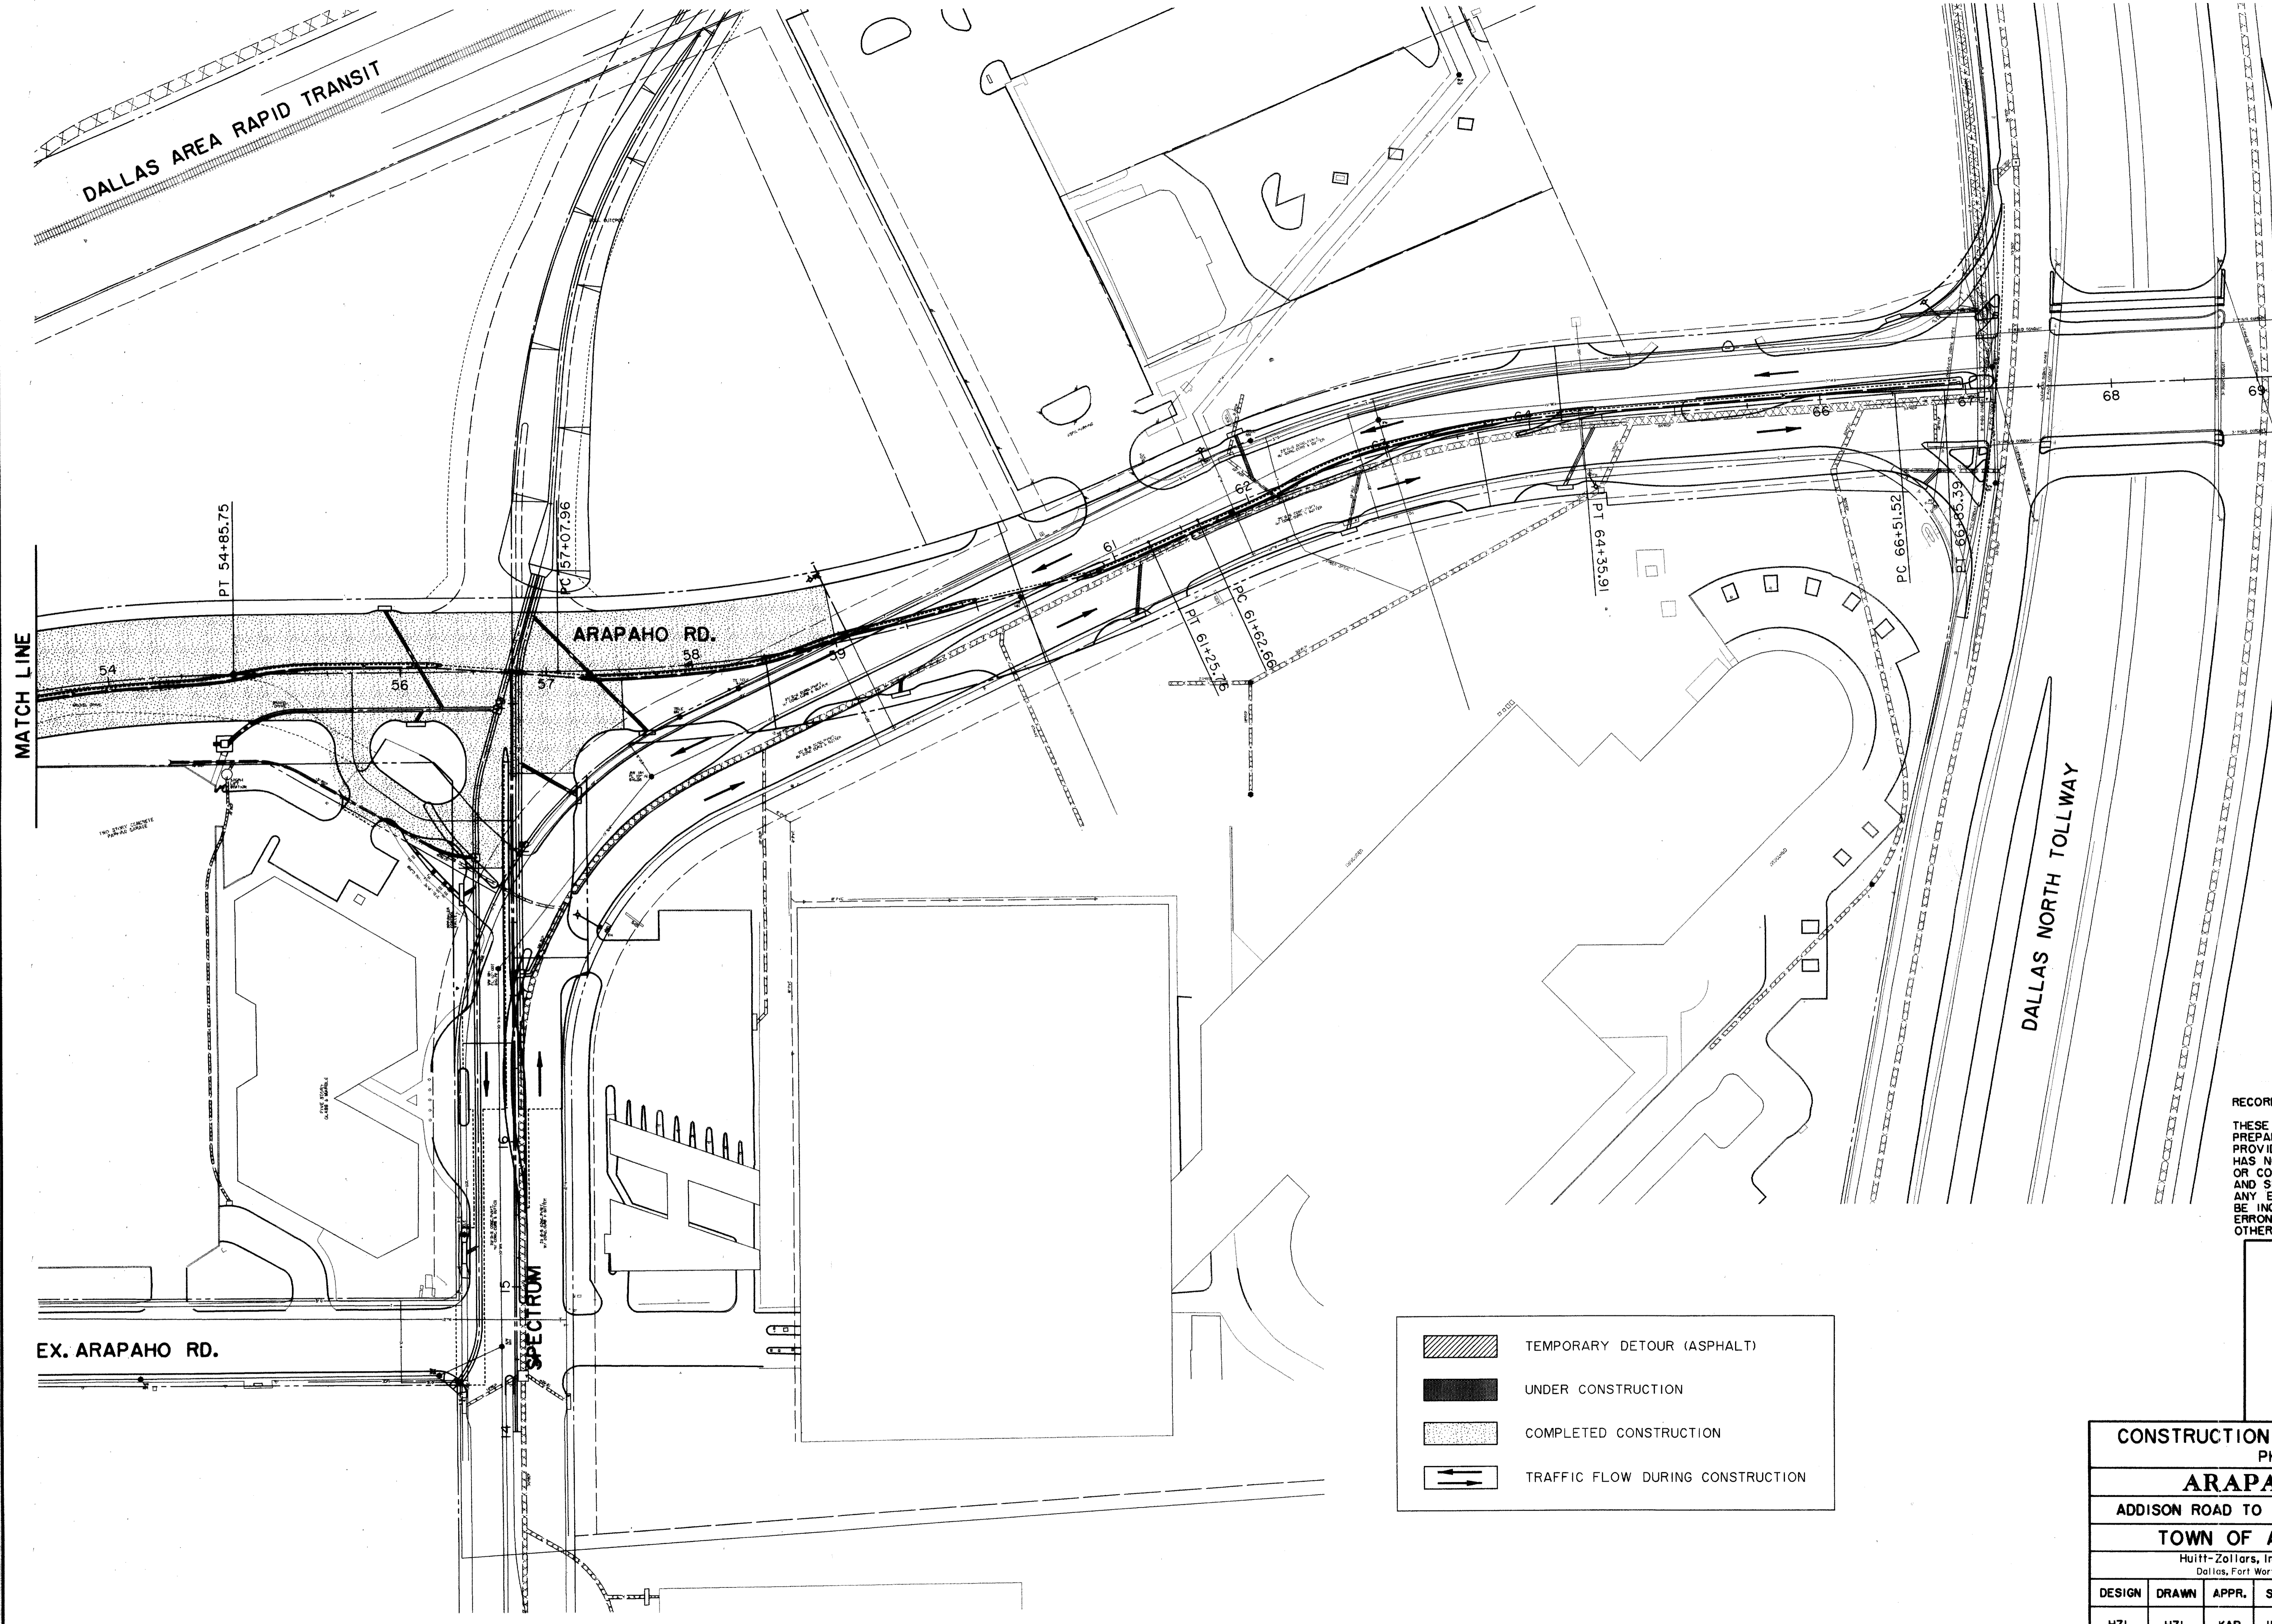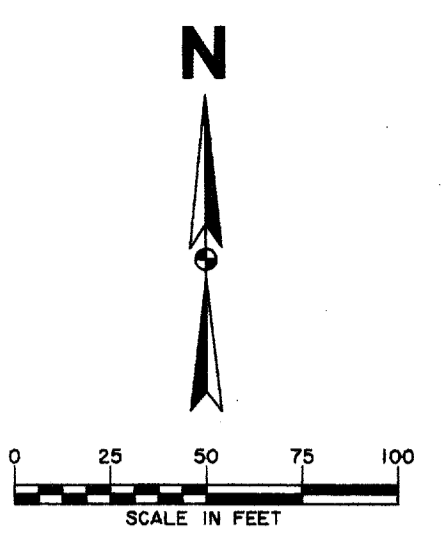



ALL DIMENSIONS ARE IN FEET UNLESS OTHERWISE NOTED.
 ALL CONSTRUCTION SHALL BE IN ACCORDANCE WITH THE LATEST EDITIONS OF THE STANDARD SPECIFICATIONS FOR CONSTRUCTION OF PUBLIC WORKS, TEXAS DEPARTMENT OF TRANSPORTATION, AND THE LATEST EDITIONS OF THE STANDARD SPECIFICATIONS FOR CONSTRUCTION OF HIGHWAYS, TEXAS DEPARTMENT OF TRANSPORTATION.

RECORD DOCUMENTS 6/9/2000
 THESE RECORD DOCUMENTS HAVE BEEN PREPARED BASED ON INFORMATION PROVIDED BY OTHERS. THE CONSULTANT HAS NOT VERIFIED THE ACCURACY AND/OR COMPLETENESS OF THIS INFORMATION AND SHALL NOT BE RESPONSIBLE FOR ANY ERRORS OR OMISSIONS THAT MAY BE INCORPORATED AS A RESULT OF ERRONEOUS INFORMATION PROVIDED BY OTHERS.

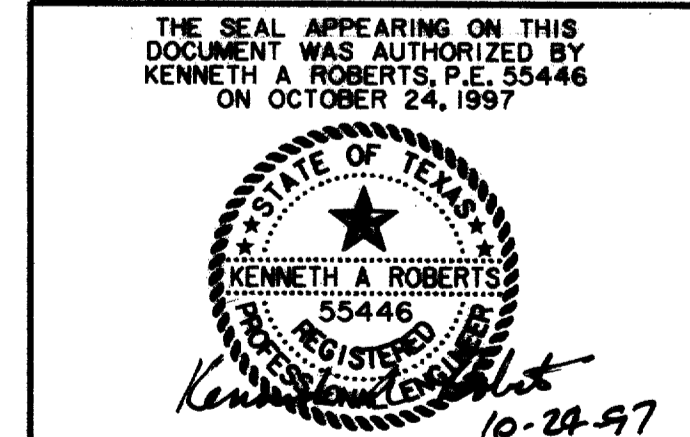

	TEMPORARY DETOUR (ASPHALT)
	UNDER CONSTRUCTION
	COMPLETED CONSTRUCTION
	TRAFFIC FLOW DURING CONSTRUCTION

CONSTRUCTION SEQUENCING PLAN						
PHASE 2						
ARAPAHO ROAD						
ADDISON ROAD TO DALLAS NORTH TOLLWAY						
TOWN OF ADDISON, TEXAS						
Huitt-Zollars, Inc./Consulting Engineers Dallas, Fort Worth, Houston, Phoenix, Tustin						
DESIGN	DRAWN	APPR.	SCALE	DATE	PROJECT NO.	NO.
HZI	HZI	KAR	1"=50'	OCT 97	1772-01	CS-4

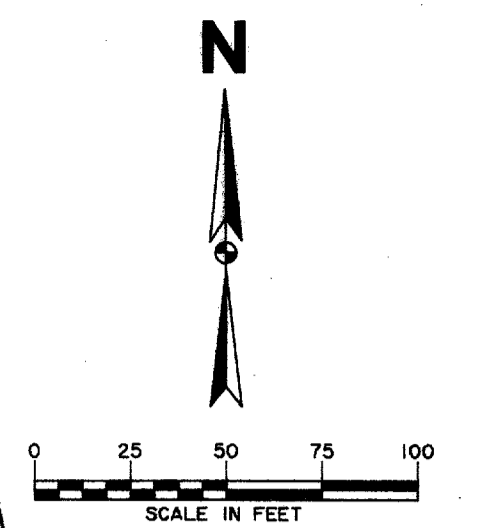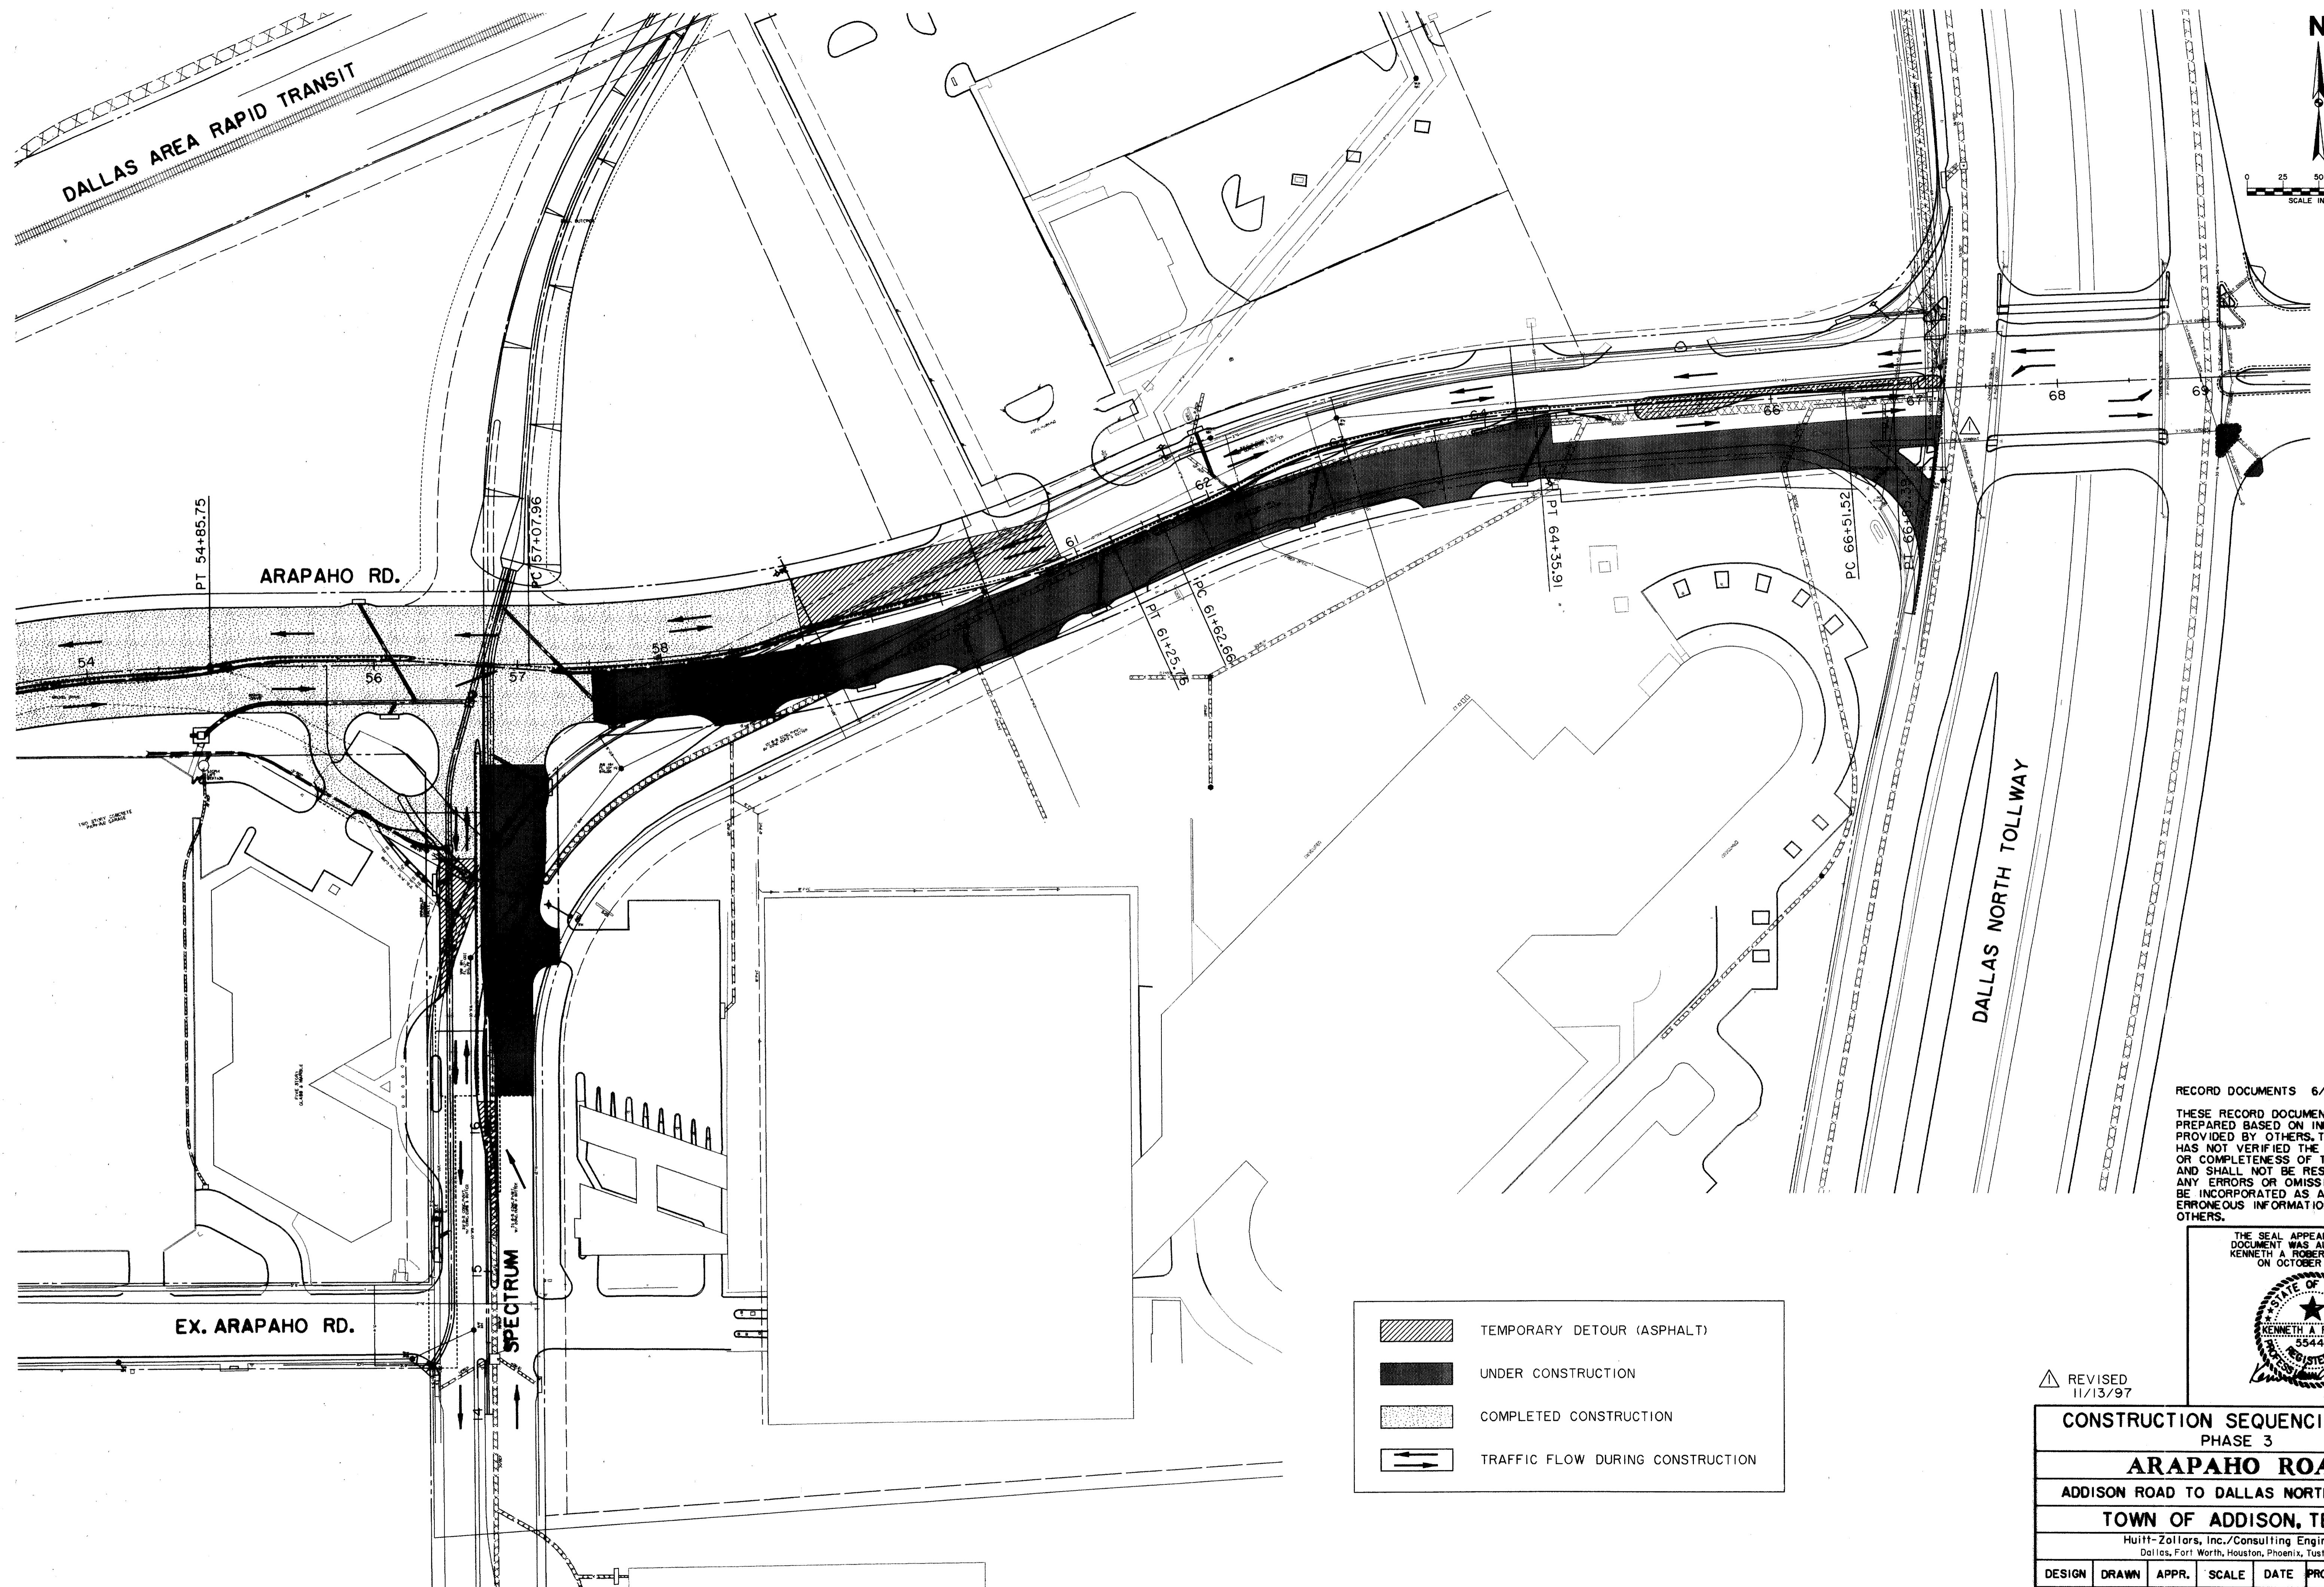

RECORD DOCUMENTS 6/9/2000
 THESE RECORD DOCUMENTS HAVE BEEN PREPARED BASED ON INFORMATION PROVIDED BY OTHERS. THE CONSULTANT HAS NOT VERIFIED THE ACCURACY AND/OR COMPLETENESS OF THIS INFORMATION AND SHALL NOT BE RESPONSIBLE FOR ANY ERRORS OR OMISSIONS THAT MAY BE INCORPORATED AS A RESULT OF ERRONEOUS INFORMATION PROVIDED BY OTHERS.

THE SEAL APPEARING ON THIS DOCUMENT WAS AUTHORIZED BY KENNETH A. ROBERTS, P.E. 55446 ON OCTOBER 24, 1997



	TEMPORARY DETOUR (ASPHALT)
	UNDER CONSTRUCTION
	COMPLETED CONSTRUCTION
	TRAFFIC FLOW DURING CONSTRUCTION

REVISOR 11/13/97

CONSTRUCTION SEQUENCING PLAN						
PHASE 3						
ARAPAHO ROAD						
ADDISON ROAD TO DALLAS NORTH TOLLWAY						
TOWN OF ADDISON, TEXAS						
Huitt-Zollars, Inc./Consulting Engineers Dallas, Fort Worth, Houston, Phoenix, Tustin						
DESIGN	DRAWN	APPR.	SCALE	DATE	PROJECT NO.	NO.
HZI	HZI	KAR	1"=50'	OCT 97	1772-01	CS-5



DALLAS AREA RAPID TRANSIT

ARAPAHO RD.

EX. ARAPAHO RD.

SPECTRUM


DALLAS NORTH TOLLWAY

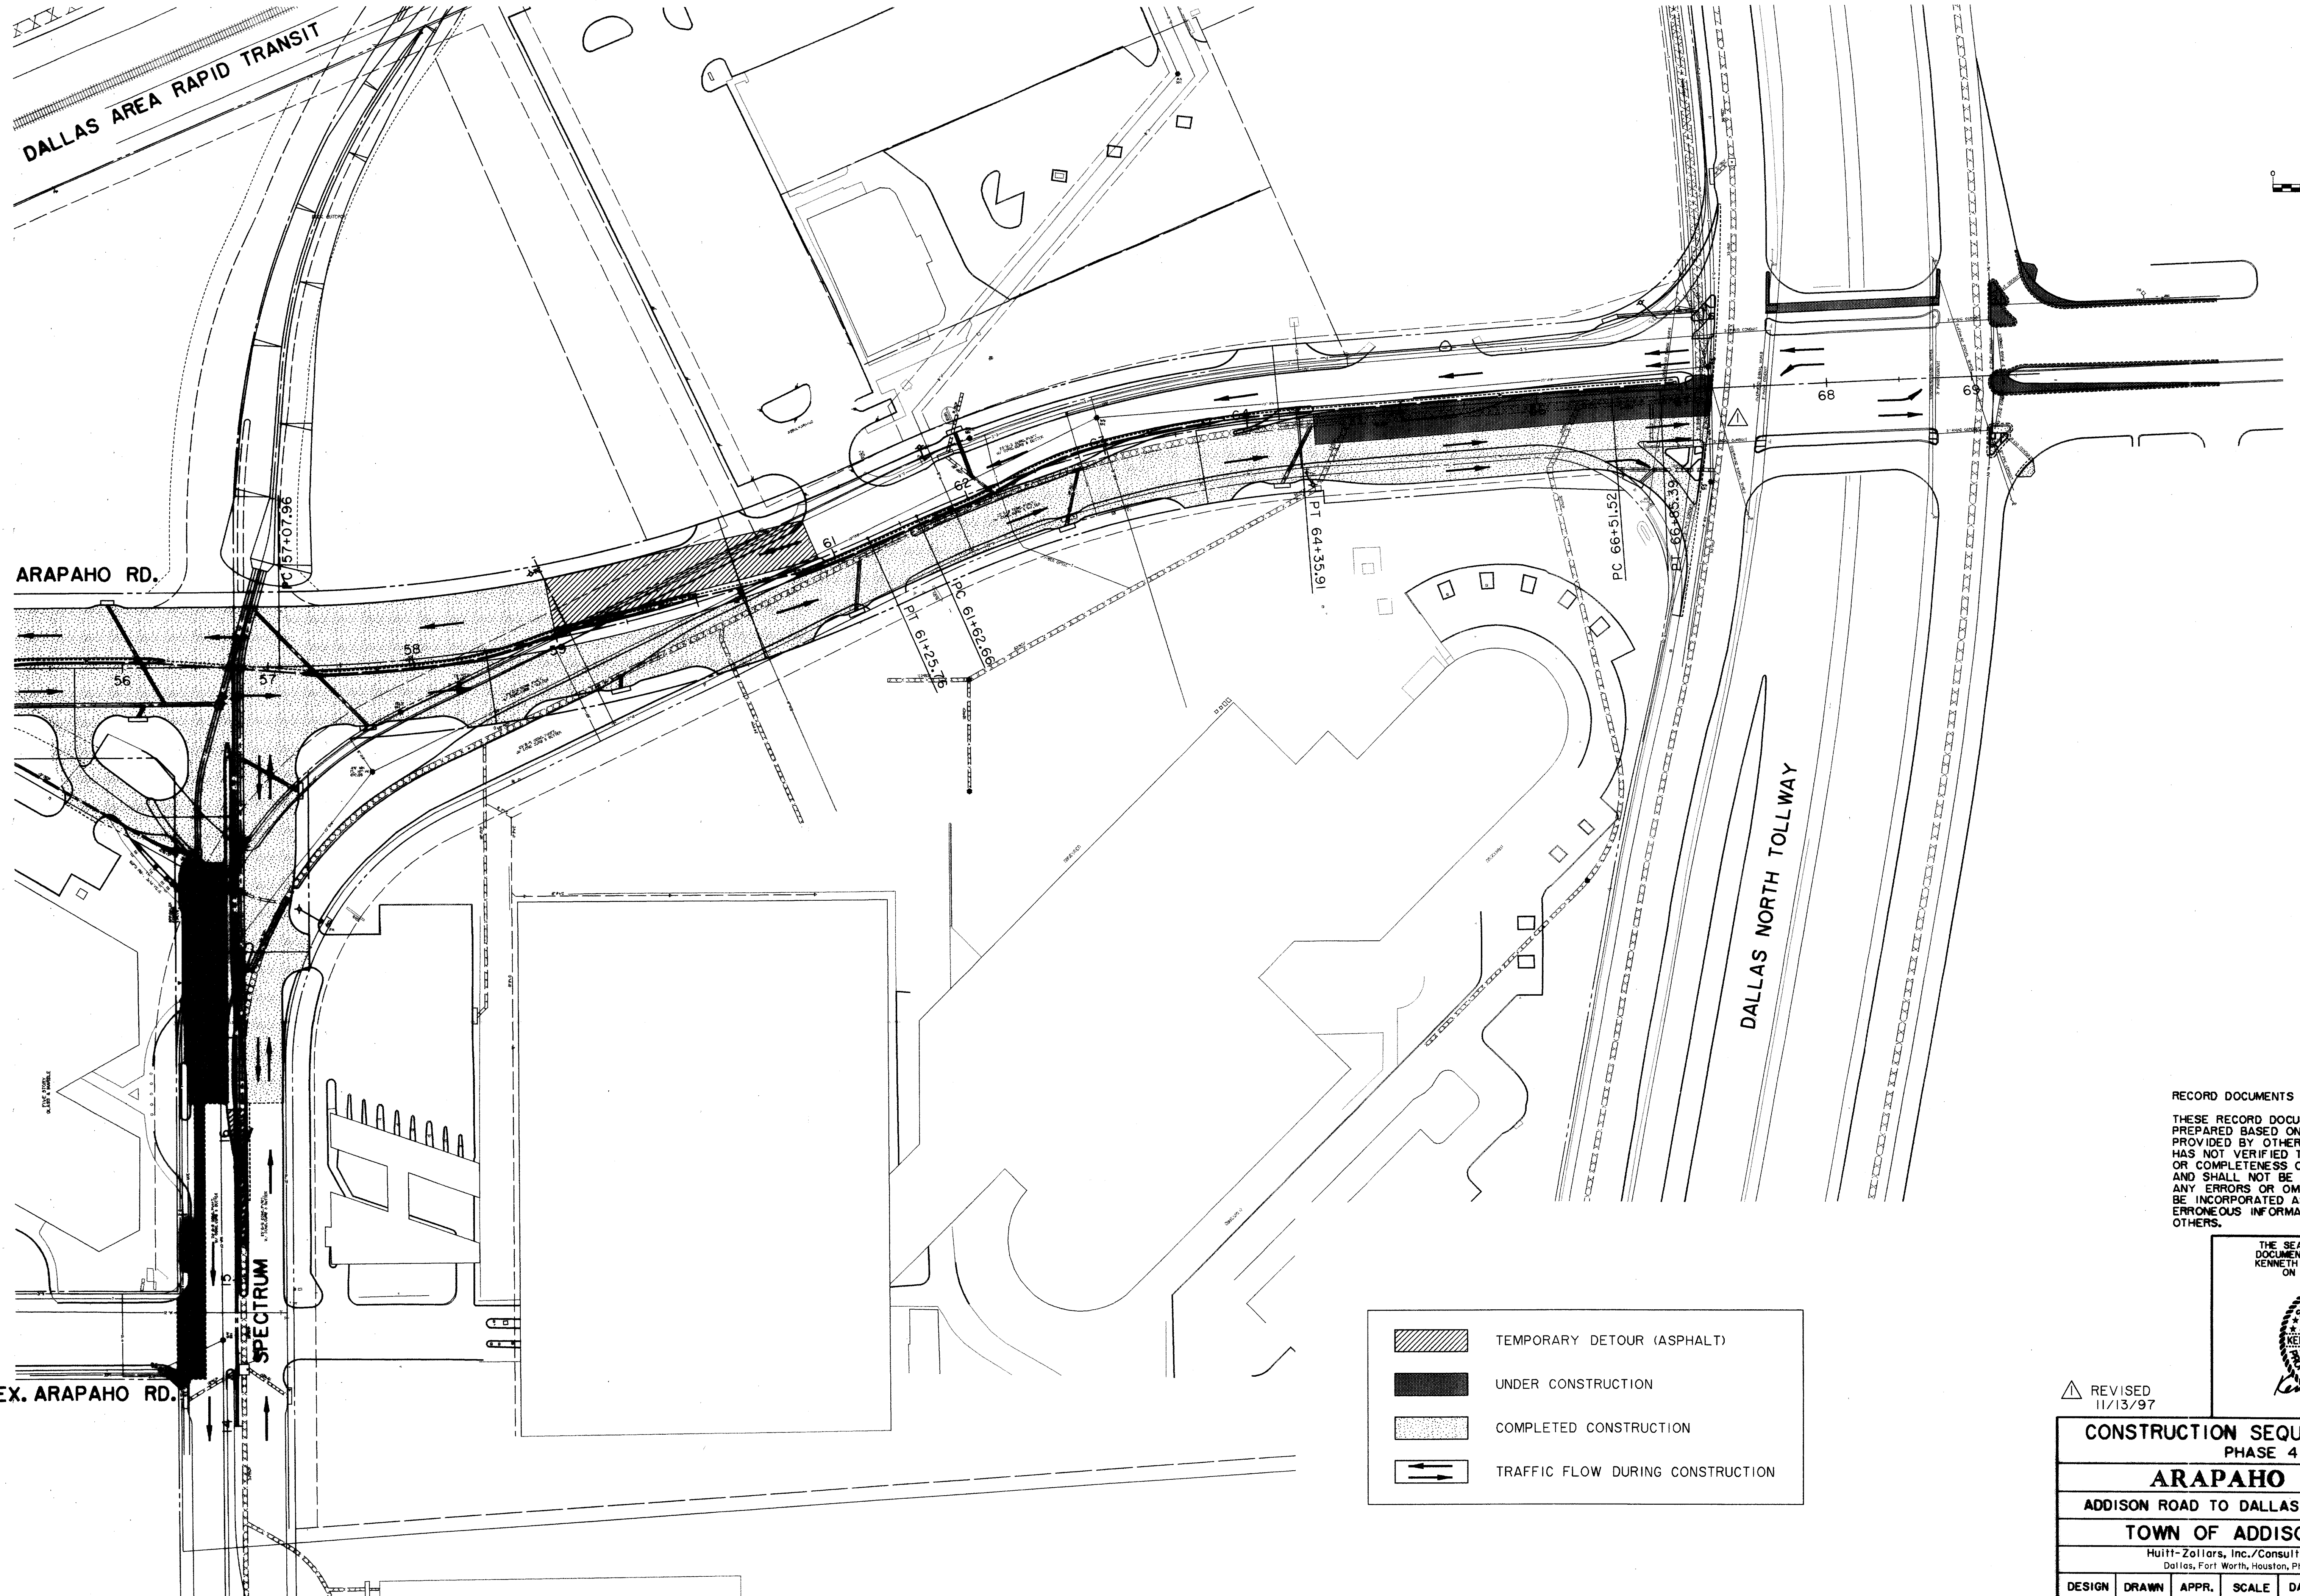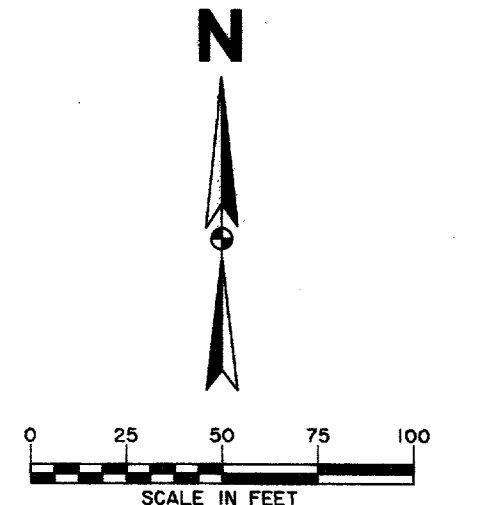

	TEMPORARY DETOUR (ASPHALT)
	UNDER CONSTRUCTION
	COMPLETED CONSTRUCTION
	TRAFFIC FLOW DURING CONSTRUCTION

RECORD DOCUMENTS 6/9/2000
 THESE RECORD DOCUMENTS HAVE BEEN PREPARED BASED ON INFORMATION PROVIDED BY OTHERS. THE CONSULTANT HAS NOT VERIFIED THE ACCURACY AND/OR COMPLETENESS OF THIS INFORMATION AND SHALL NOT BE RESPONSIBLE FOR ANY ERRORS OR OMISSIONS THAT MAY BE INCORPORATED AS A RESULT OF ERRONEOUS INFORMATION PROVIDED BY OTHERS.


THE SEAL APPEARING ON THIS DOCUMENT WAS AUTHORIZED BY KENNETH A. ROBERTS, P.E. 55446 ON OCTOBER 24, 1997

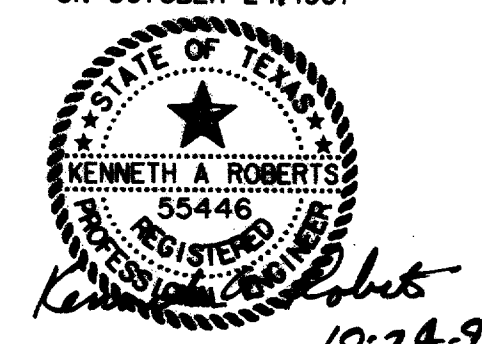

REVISOR 11/13/97

CONSTRUCTION SEQUENCING PLAN						
PHASE 4						
ARAPAHO ROAD						
ADDISON ROAD TO DALLAS NORTH TOLLWAY						
TOWN OF ADDISON, TEXAS						
Huitt-Zollars, Inc./Consulting Engineers Dallas, Fort Worth, Houston, Phoenix, Tustin						
DESIGN	DRAWN	APPR.	SCALE	DATE	PROJECT NO.	NO.
HZ1	HZ1	KAR	1"=50'	OCT 97	1772-01	CS-6

DALLAS AREA RAPID TRANSIT

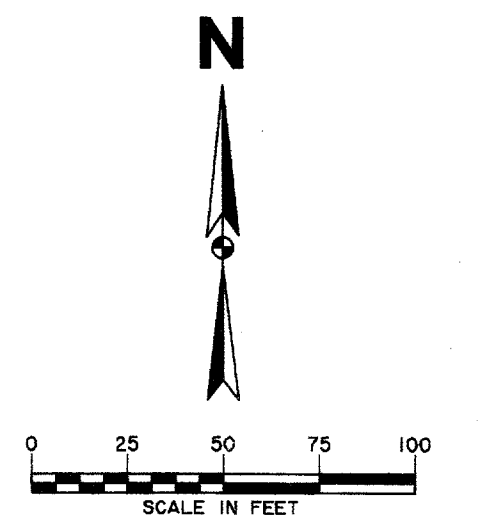

ARAPAHO RD.

DALLAS NORTH TOLLWAY

EX. ARAPAHO RD.

SPECTRUM

	TEMPORARY DETOUR (ASPHALT)
	UNDER CONSTRUCTION
	COMPLETED CONSTRUCTION
	TRAFFIC FLOW DURING CONSTRUCTION


RECORD DOCUMENTS 6/9/2000
 THESE RECORD DOCUMENTS HAVE BEEN PREPARED BASED ON INFORMATION PROVIDED BY OTHERS. THE CONSULTANT HAS NOT VERIFIED THE ACCURACY AND/OR COMPLETENESS OF THIS INFORMATION AND SHALL NOT BE RESPONSIBLE FOR ANY ERRORS OR OMISSIONS THAT MAY BE INCORPORATED AS A RESULT OF ERRONEOUS INFORMATION PROVIDED BY OTHERS.

THE SEAL APPEARING ON THIS DOCUMENT WAS AUTHORIZED BY KENNETH A. ROBERTS, P.E. 55446 ON OCTOBER 24, 1997




REVISOR 11/13/97

CONSTRUCTION SEQUENCING PLAN PHASE 5						
ARAPAHO ROAD						
ADDISON ROAD TO DALLAS NORTH TOLLWAY						
TOWN OF ADDISON, TEXAS						
Hult-Zollars, Inc./Consulting Engineers Dallas, Fort Worth, Houston, Phoenix, Tustin						
DESIGN	DRAWN	APPR.	SCALE	DATE	PROJECT NO.	NO.
HZI	HZI	KAR	1"=50'	OCT 97	1772-01	CS-7

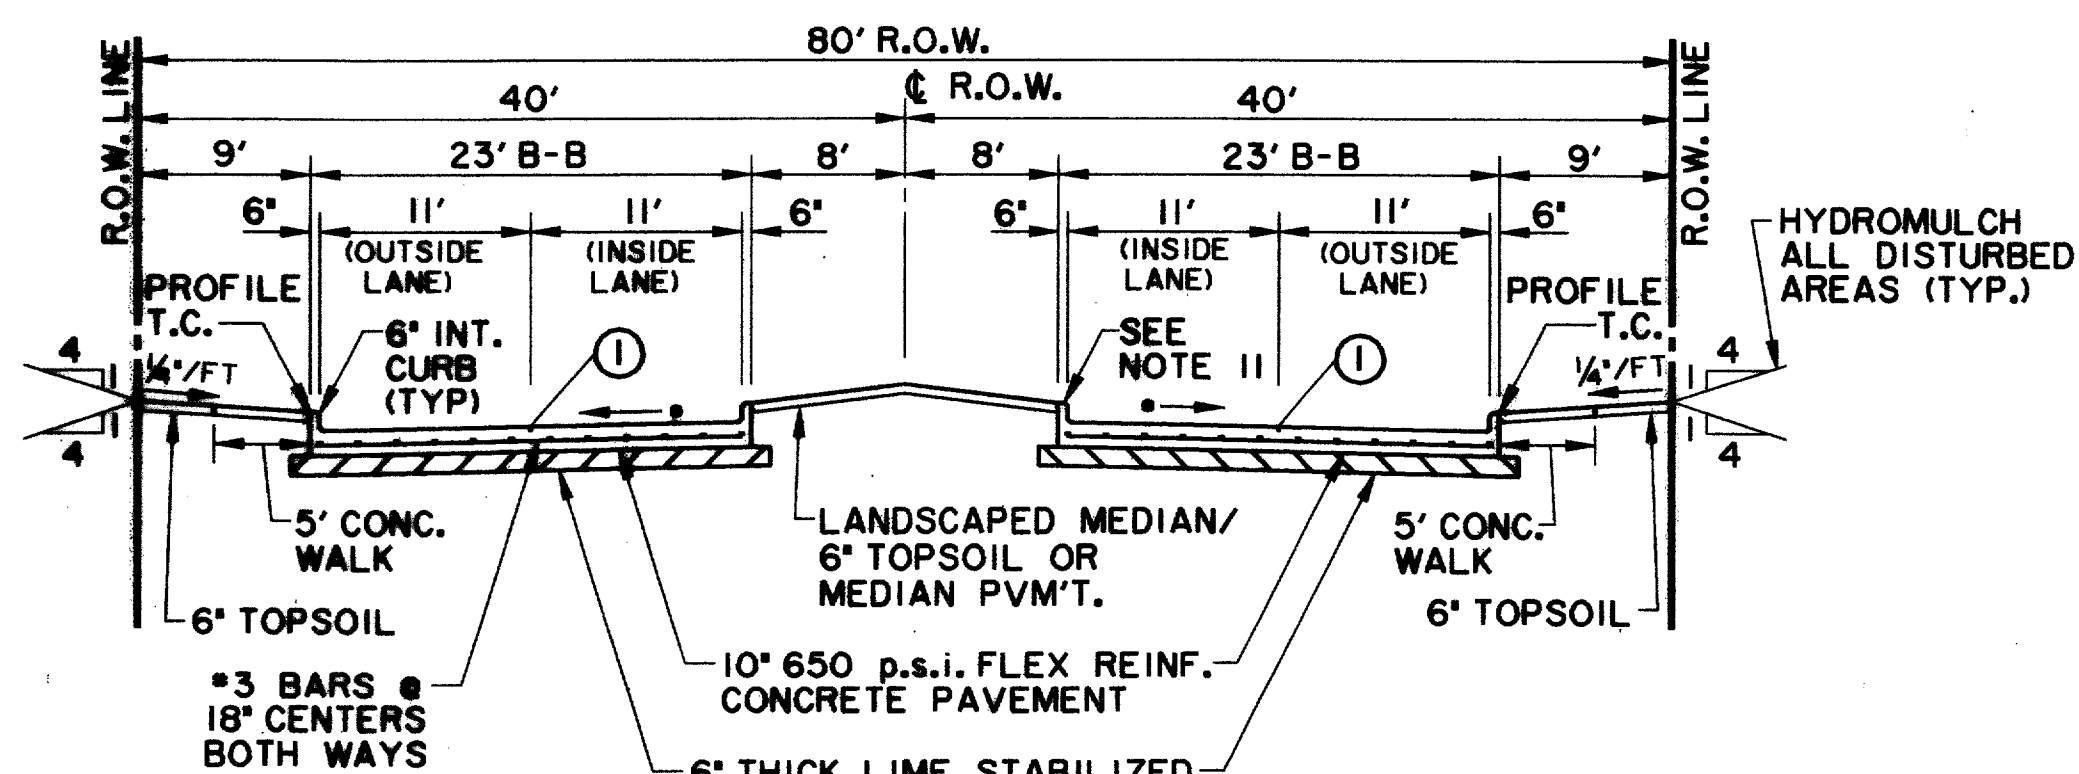


**TYPICAL SECTION 4 LANE DIVIDED
QUORUM DRIVE**

•PAVEMENT CROSS-SLOPES VARY FROM THE TYPICAL 1/4"/1' ALONG THE ENTIRE LENGTH OF THE PROJECT. SEE PAVING PLANS FOR PROPOSED MEDIAN GRADES.

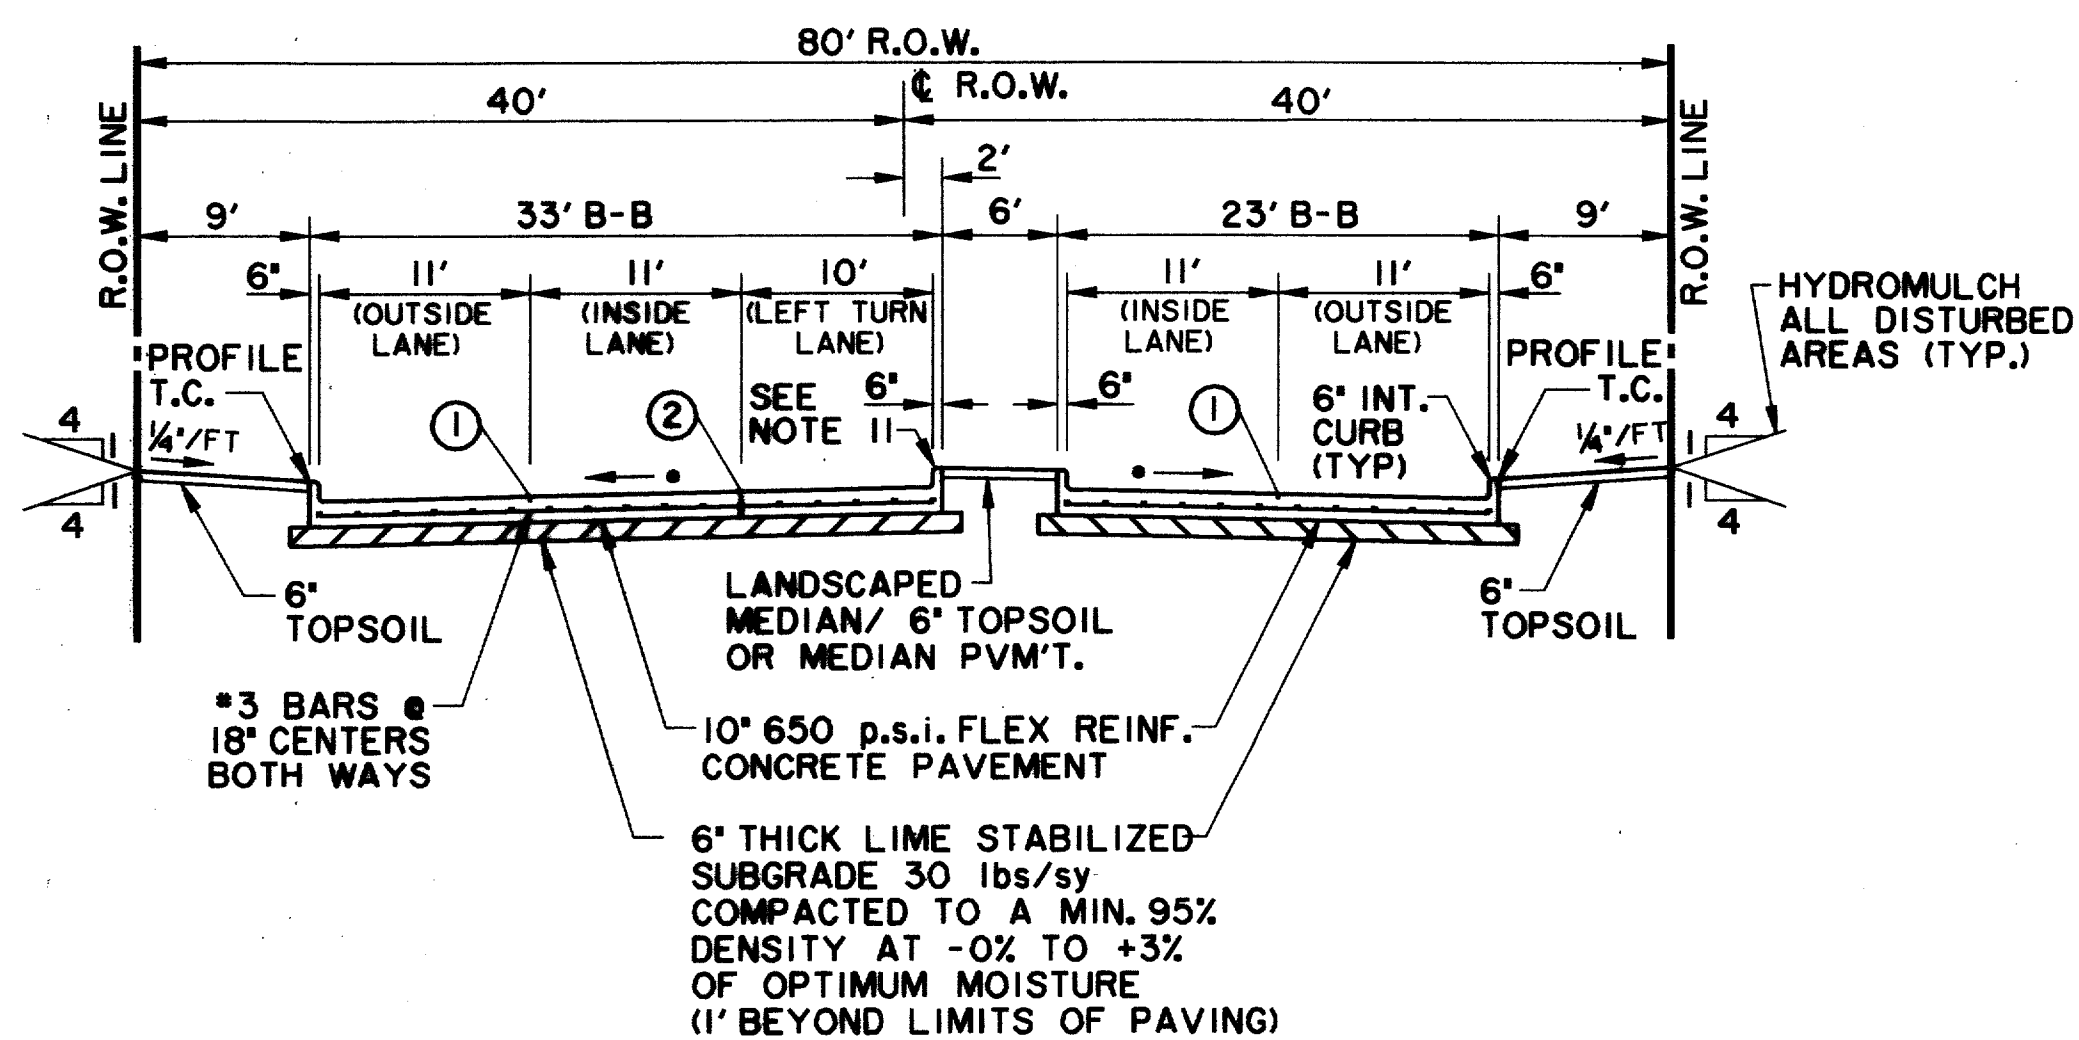


**TYPICAL SECTION 4 LANE DIVIDED
WITH LEFT TURN LANE
QUORUM DRIVE**

•PAVEMENT CROSS-SLOPES VARY FROM THE TYPICAL 1/4"/1' ALONG THE ENTIRE LENGTH OF THE PROJECT. SEE PAVING PLANS FOR PROPOSED MEDIAN GRADES.

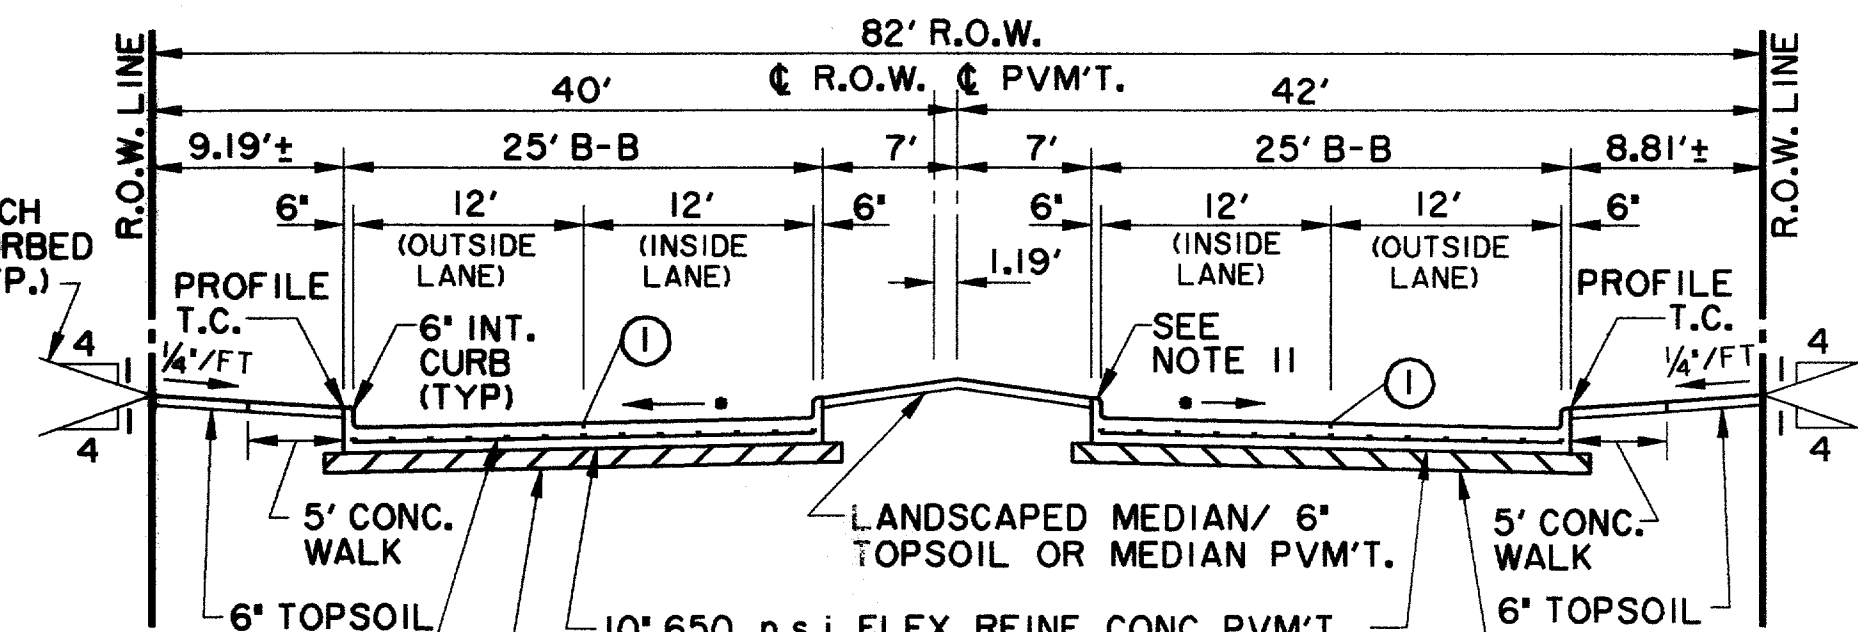


**TYPICAL SECTION 4 LANE DIVIDED
SPECTRUM DRIVE
LOOKING NORTH**

•PAVEMENT CROSS-SLOPES VARY FROM THE TYPICAL 1/4"/1' ALONG THE ENTIRE LENGTH OF THE PROJECT. SEE PAVING PLANS FOR PROPOSED MEDIAN GRADES.

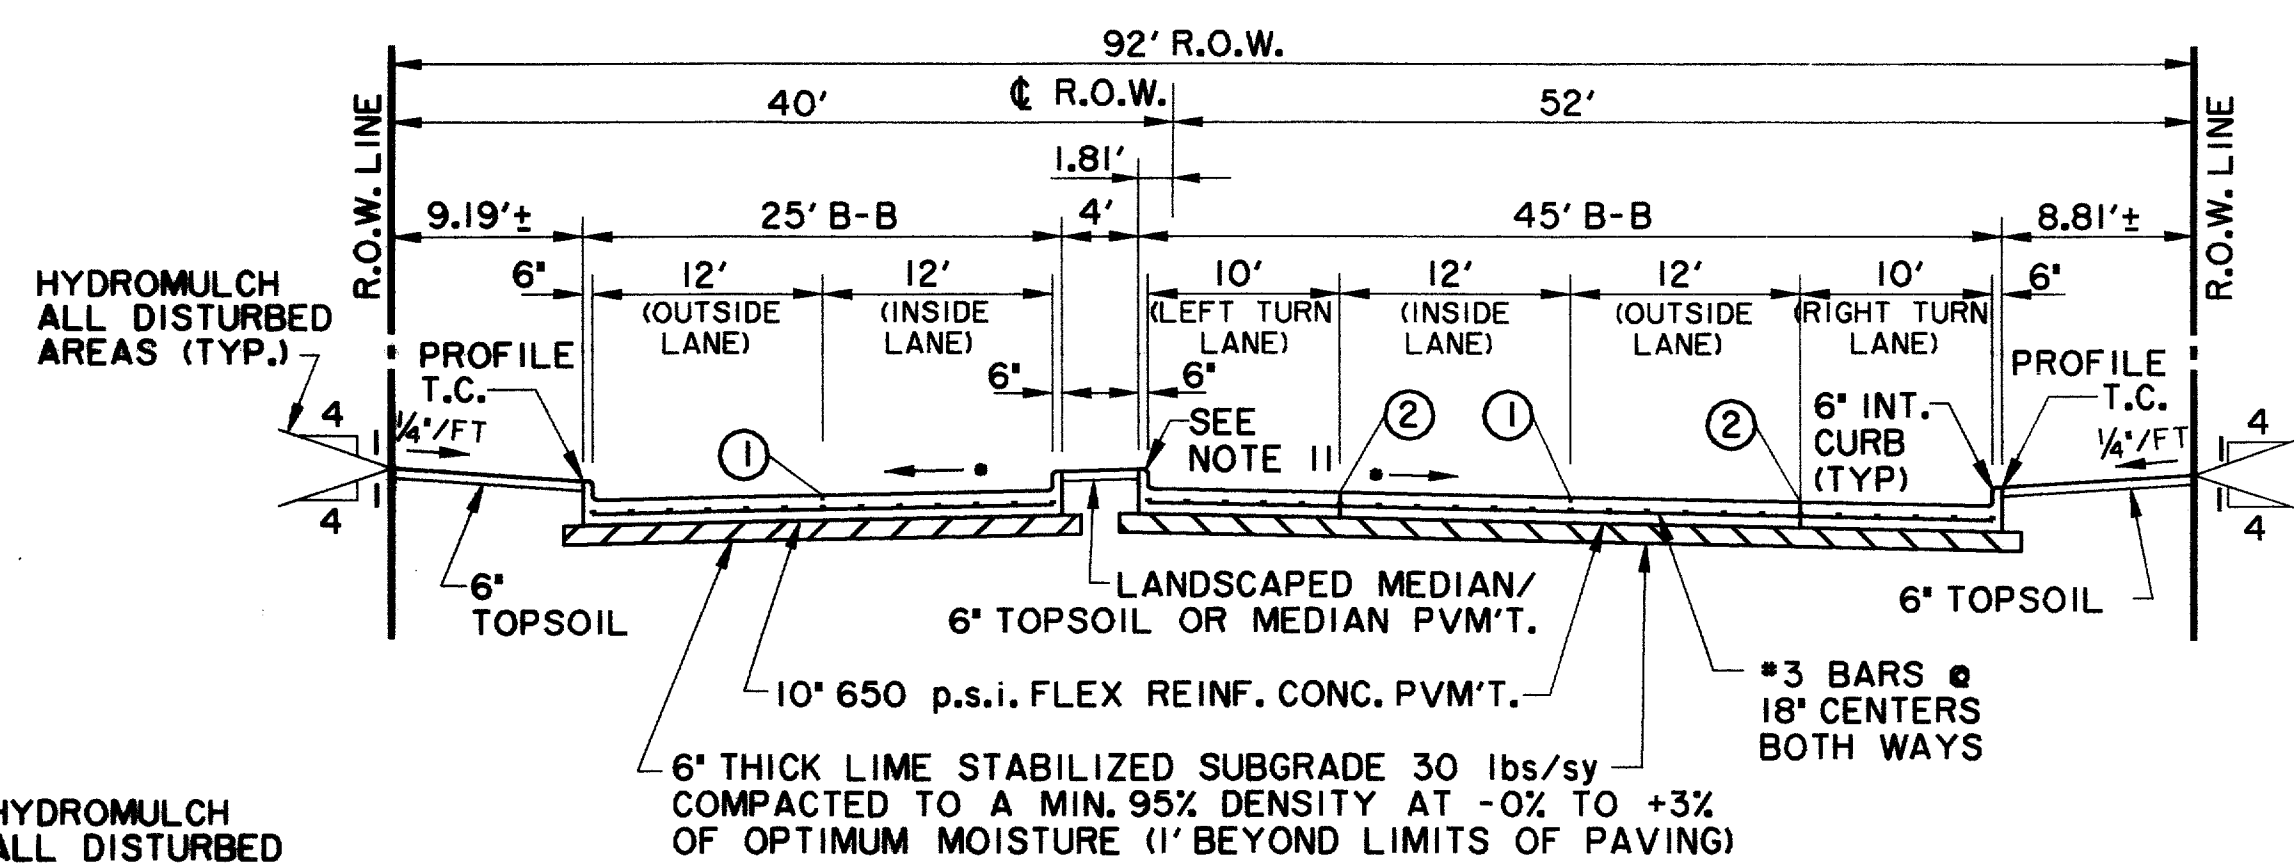

**TYPICAL SECTION 4 LANE DIVIDED WITH LEFT & RIGHT TURN LANE
SPECTRUM DRIVE
LOOKING NORTH**

•PAVEMENT CROSS-SLOPES VARY FROM THE TYPICAL 1/4"/1' ALONG THE ENTIRE LENGTH OF THE PROJECT. SEE PAVING PLANS FOR PROPOSED MEDIAN GRADES.

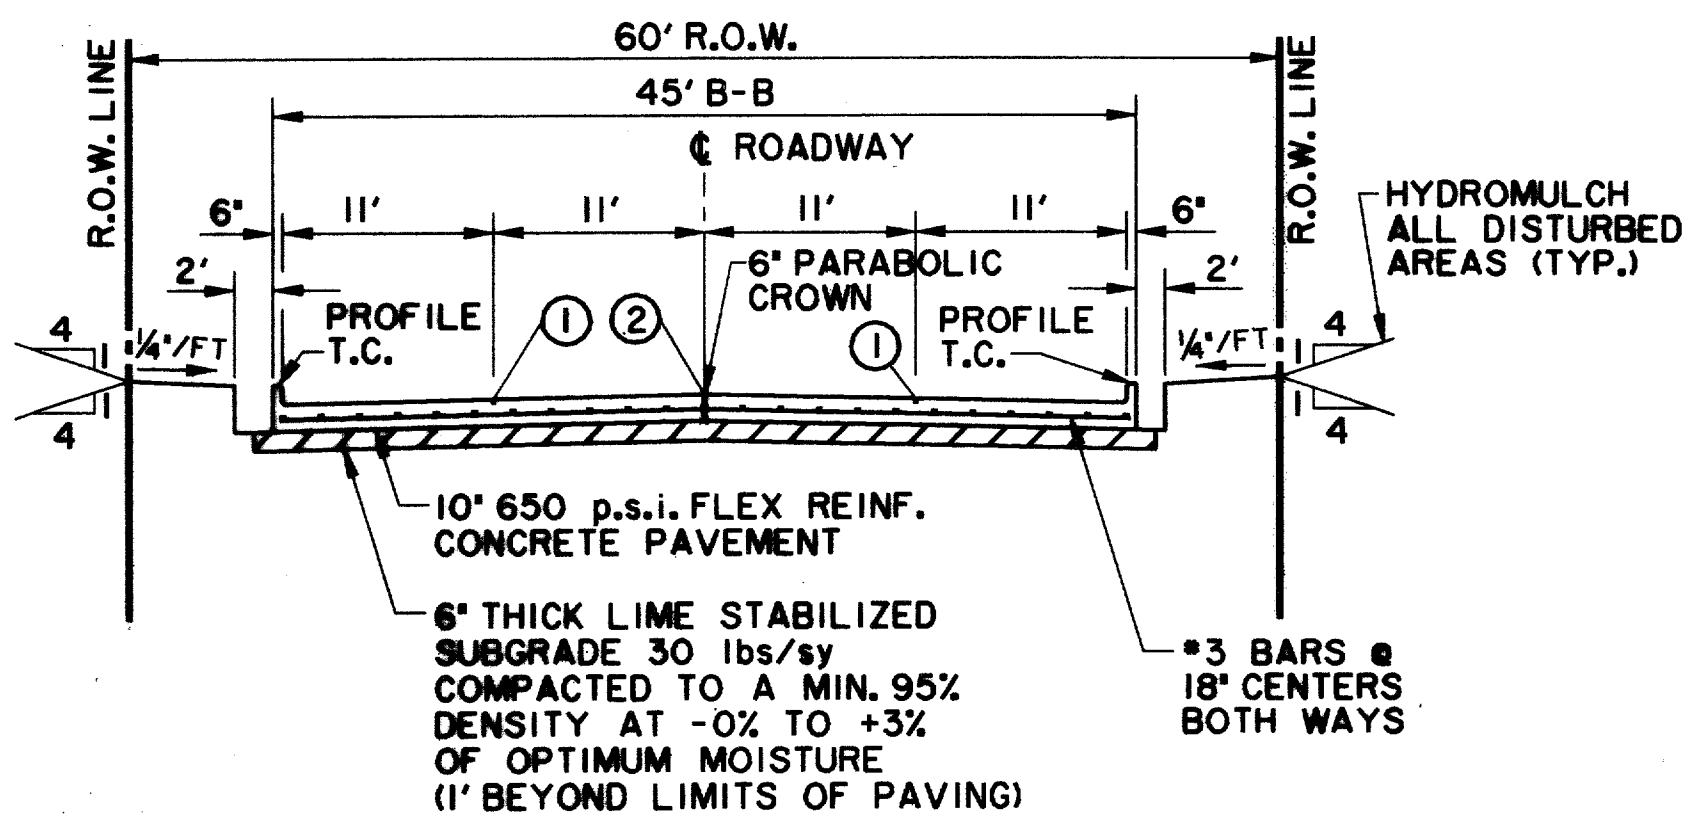


**4 LANES UNDIVIDED
EXISTING ARAPAHO ROAD**

NOTES:

1. BACKFILL MATERIAL NOT A SEPARATE PAY ITEM. MATERIAL ACQUIRED FROM EXCAVATION MAY BE USED IF APPROVED BY TOWN.
2. PAY LIMIT FOR UNCLASSIFIED EXCAVATION CALCULATED AT BACK OF CURB.
3. 3" PVC SCHEDULE 40 DOVE GREY ELECTRICAL TRAFFIC SIGNAL INTERCONNECT CONDUIT TO BE PLACED IN ALL MEDIANS, 6" BEHIND SOUTH OR EAST MEDIAN UNLESS OTHERWISE SHOWN ON THE PLANS. BURIAL DEPTH SHALL BE 3'-0" BELOW FINISH GRADE. 30" RADIUS SWEEP BENDS TO BE USED AT ALL STREET LIGHT BASES AND HANDHOLE BOXES.
4. A NO. 9 GALVANIZED WIRE SHALL BE PLACED IN ALL CONDUIT. THIS WIRE SHALL EXTEND A MINIMUM OF 1' BEYOND THE END OF THE CONDUIT. MARKER TAPE IS TO BE INSTALLED ON THE ENDS OF ALL CONDUIT WITH CAP.
5. CONTACT T.U. ELECTRIC COMPANY PRIOR TO INSTALLING PULL BOXES. PLACEMENT OF ELECTRIC HANDHOLE BOXES SHALL BE AS DIRECTED BY T.U. ELECTRIC COMPANY.
6. 2" PVC SCHEDULE 40 DOVE GREY ELECTRICAL STREET LIGHT CONDUIT SHALL BE PLACED IN ALL MEDIANS, 6" BEHIND NORTH OR WEST MEDIAN CURB UNLESS OTHERWISE SHOWN ON THE PLANS. BURIAL DEPTH SHALL BE 3'-0" BELOW FINISH GRADE. 30" RADIUS SWEEP BENDS TO BE USED AT ALL STREET LIGHT BASES AND HANDHOLE BOXES.
7. THE LETTER 'C' WILL BE STAMPED OR CHISELED ON CURB AT ALL LOCATIONS OF CONDUIT UNDER DRIVE AND INTERSECTIONS.
8. ALL TRANSVERSE JOINTS SHALL BE ON MAX. 12' CENTERS.
9. PROFILE GRADES SHOWN ON THE PAVING PLAN AND PROFILE SHEETS ARE TOP OF CURB AT BACK OF CURB UNLESS NOTED OTHERWISE ON THE PLANS.
10. SEE PAVING PLAN VIEWS FOR MEDIAN AND RIGHT TURN LANE TOP OF CURB GRADES.
11. THE FINAL FINISH ON THE CONCRETE STREET PAVEMENT SHALL CONSIST OF A COMBINATION OF A LONGITUDINAL CARPET DRAG AND TRANSVERSE METAL TINE FINISH AS DESCRIBED IN TxDOT STANDARD SPECIFICATIONS FOR ITEM 360 - CONCRETE PAVEMENT UNLESS SPECIFIED OTHERWISE IN THE PLANS.

JOINT LEGEND:


- ① - SAWED LONGITUDINAL DUMMY JOINT
- ② - CONSTRUCTION JOINT (FULL WIDTH PVM'T. IS ALLOWED WHERE APPROVED BY THE TOWN OF ADDISON.)

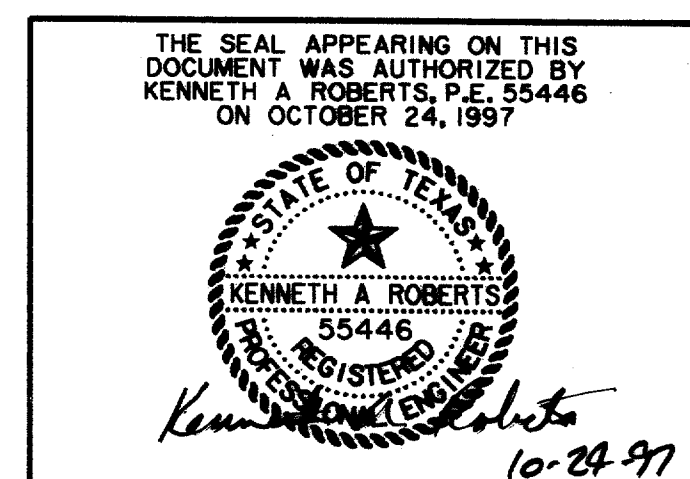

PAVING TYPICAL SECTIONS						
ARAPAHO ROAD						
ADDISON ROAD TO DALLAS NORTH TOLLWAY						
TOWN OF ADDISON, TEXAS						
Huitt-Zollars, Inc./Consulting Engineers Dallas, Fort Worth, Houston, Phoenix, Tustin						
DESIGN	DRAWN	APPR.	SCALE	DATE	PROJECT NO.	NO.
HZI	HZI	KAR	1" = 10'	OCT 97	1772-01	P-1

RECORD DOCUMENTS 6/9/2000


THESE RECORD DOCUMENTS HAVE BEEN PREPARED BASED ON INFORMATION PROVIDED BY OTHERS. THE CONSULTANT HAS NOT VERIFIED THE ACCURACY AND/OR COMPLETENESS OF THIS INFORMATION AND SHALL NOT BE RESPONSIBLE FOR ANY ERRORS OR OMISSIONS THAT MAY BE INCORPORATED AS A RESULT OF ERRONEOUS INFORMATION PROVIDED BY OTHERS.

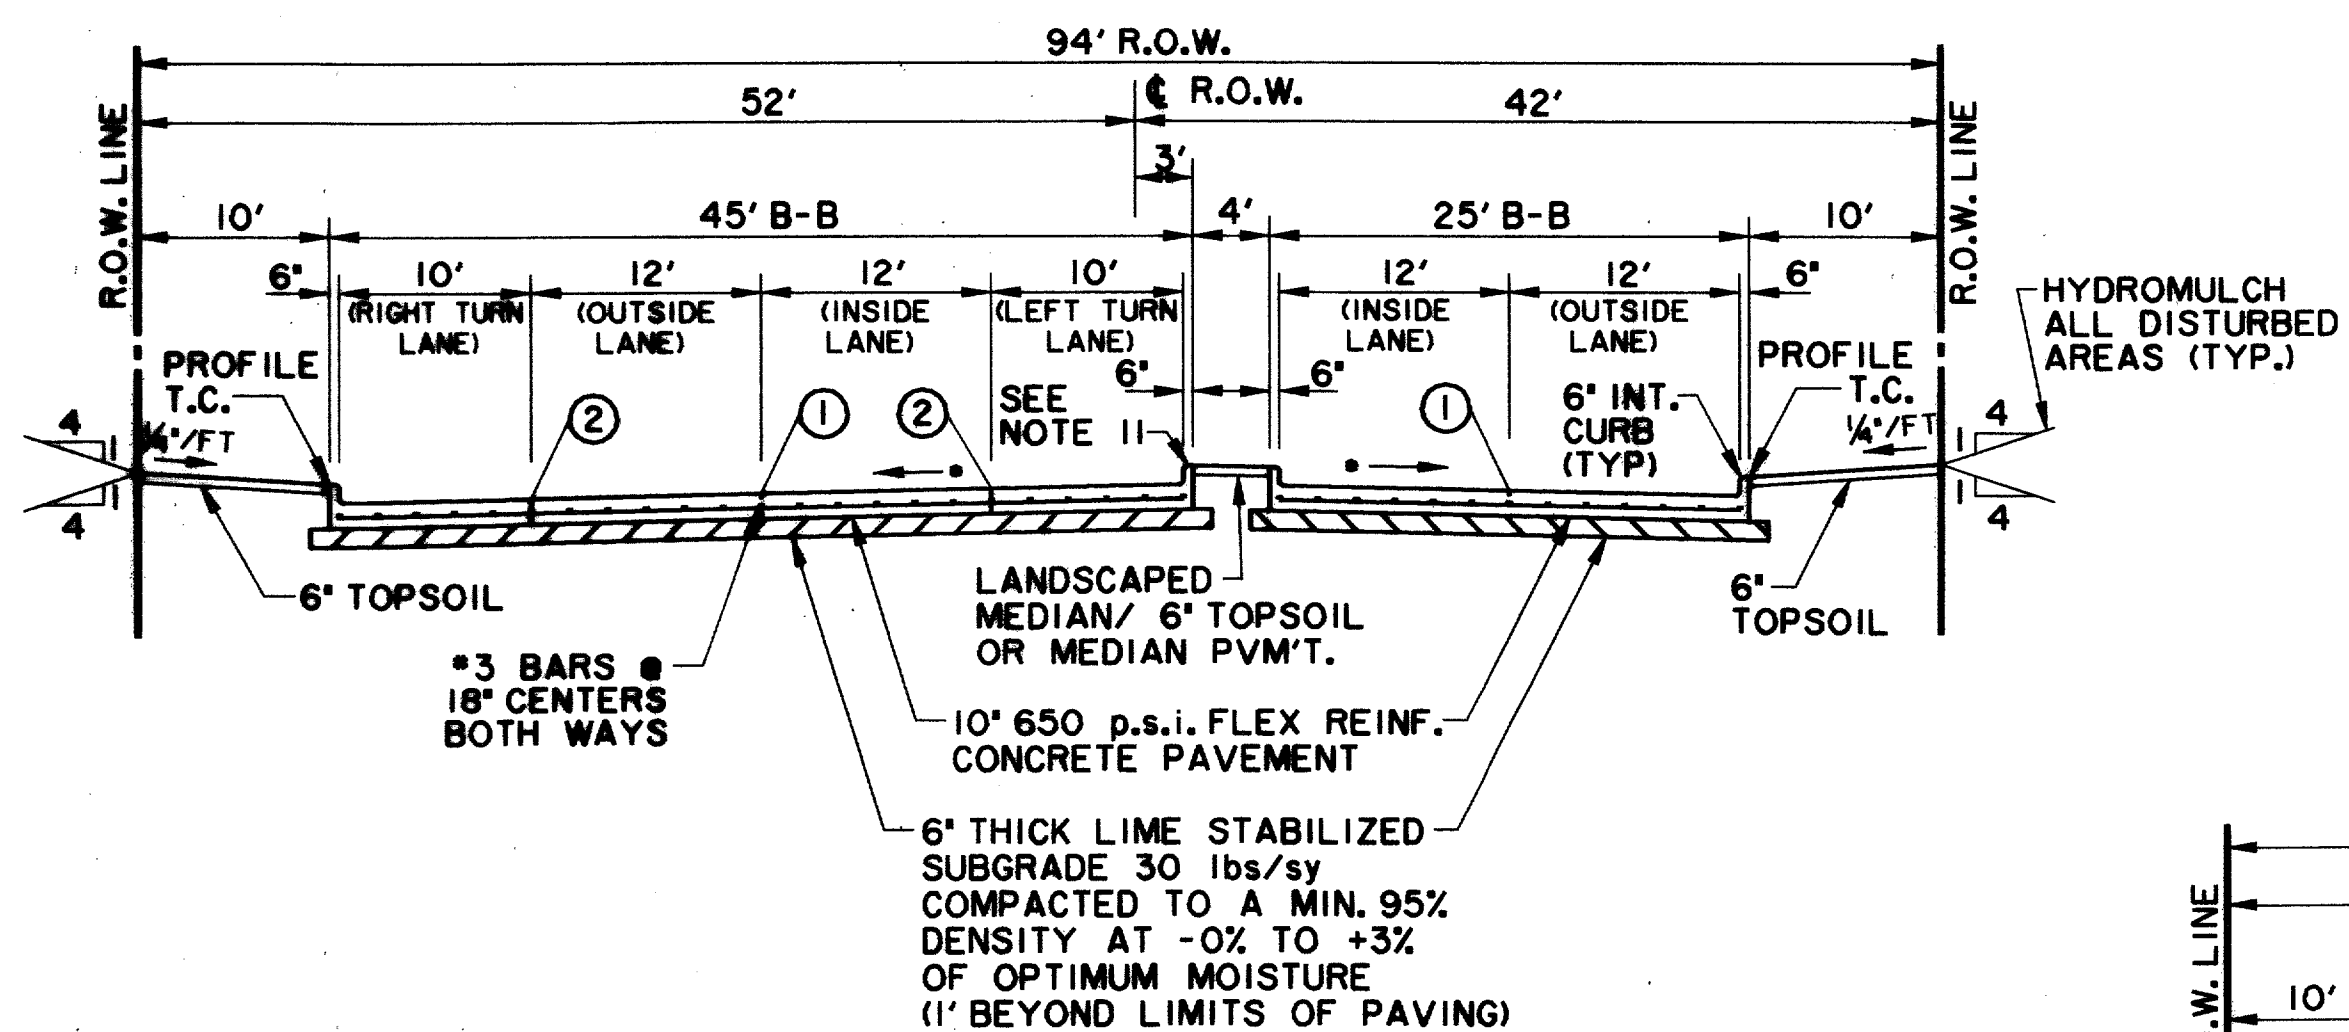

TYPICAL SECTION 4 LANE DIVIDED WITH LEFT & RIGHT TURN LANE

ARAPAHO ROAD


• PAVEMENT CROSS-SLOPES VARY FROM THE TYPICAL 1/4" / 1' ALONG THE ENTIRE LENGTH OF THE PROJECT. SEE PAVING PLANS FOR PROPOSED MEDIAN GRADES.

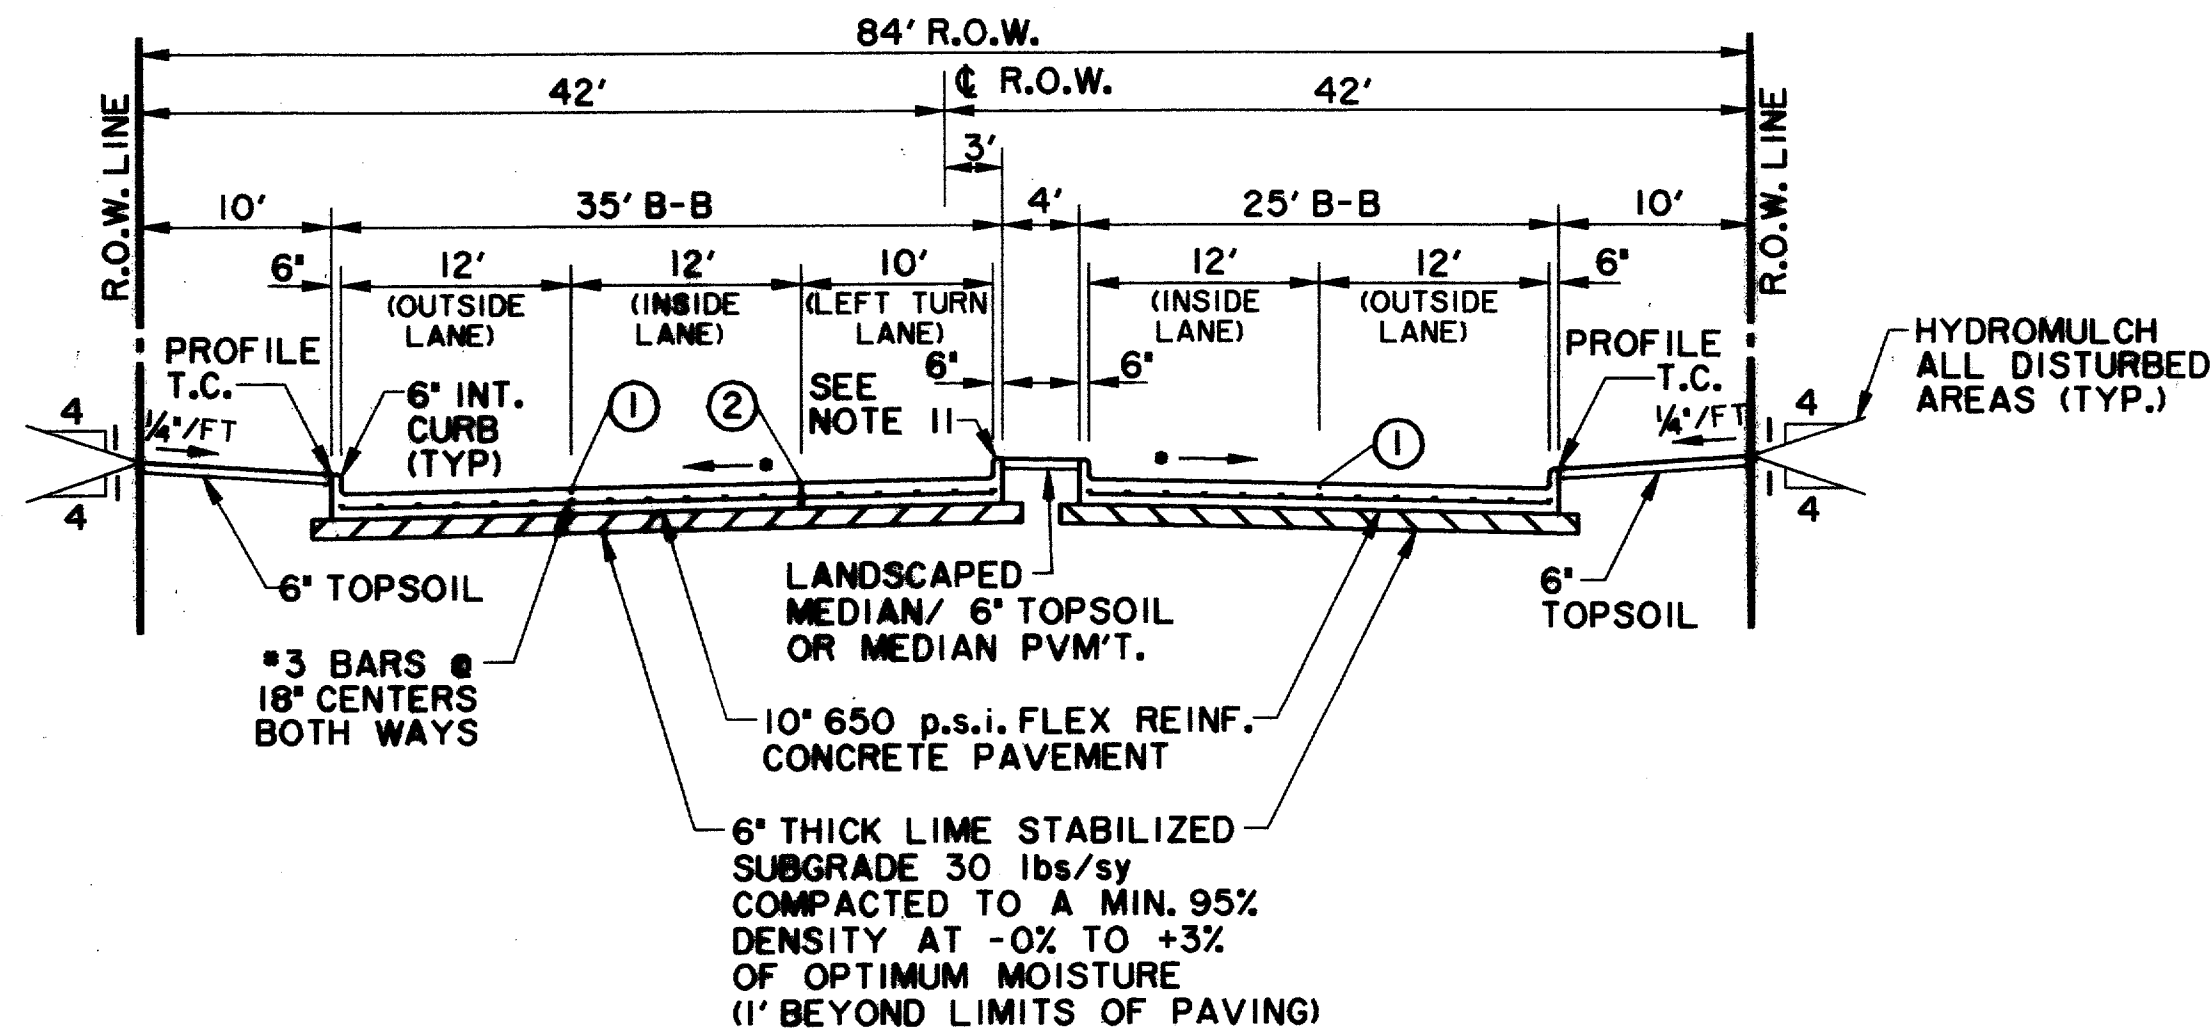

TYPICAL SECTION 4 LANE DIVIDED WITH LEFT TURN LANE

ARAPAHO ROAD


• PAVEMENT CROSS-SLOPES VARY FROM THE TYPICAL 1/4" / 1' ALONG THE ENTIRE LENGTH OF THE PROJECT. SEE PAVING PLANS FOR PROPOSED MEDIAN GRADES.

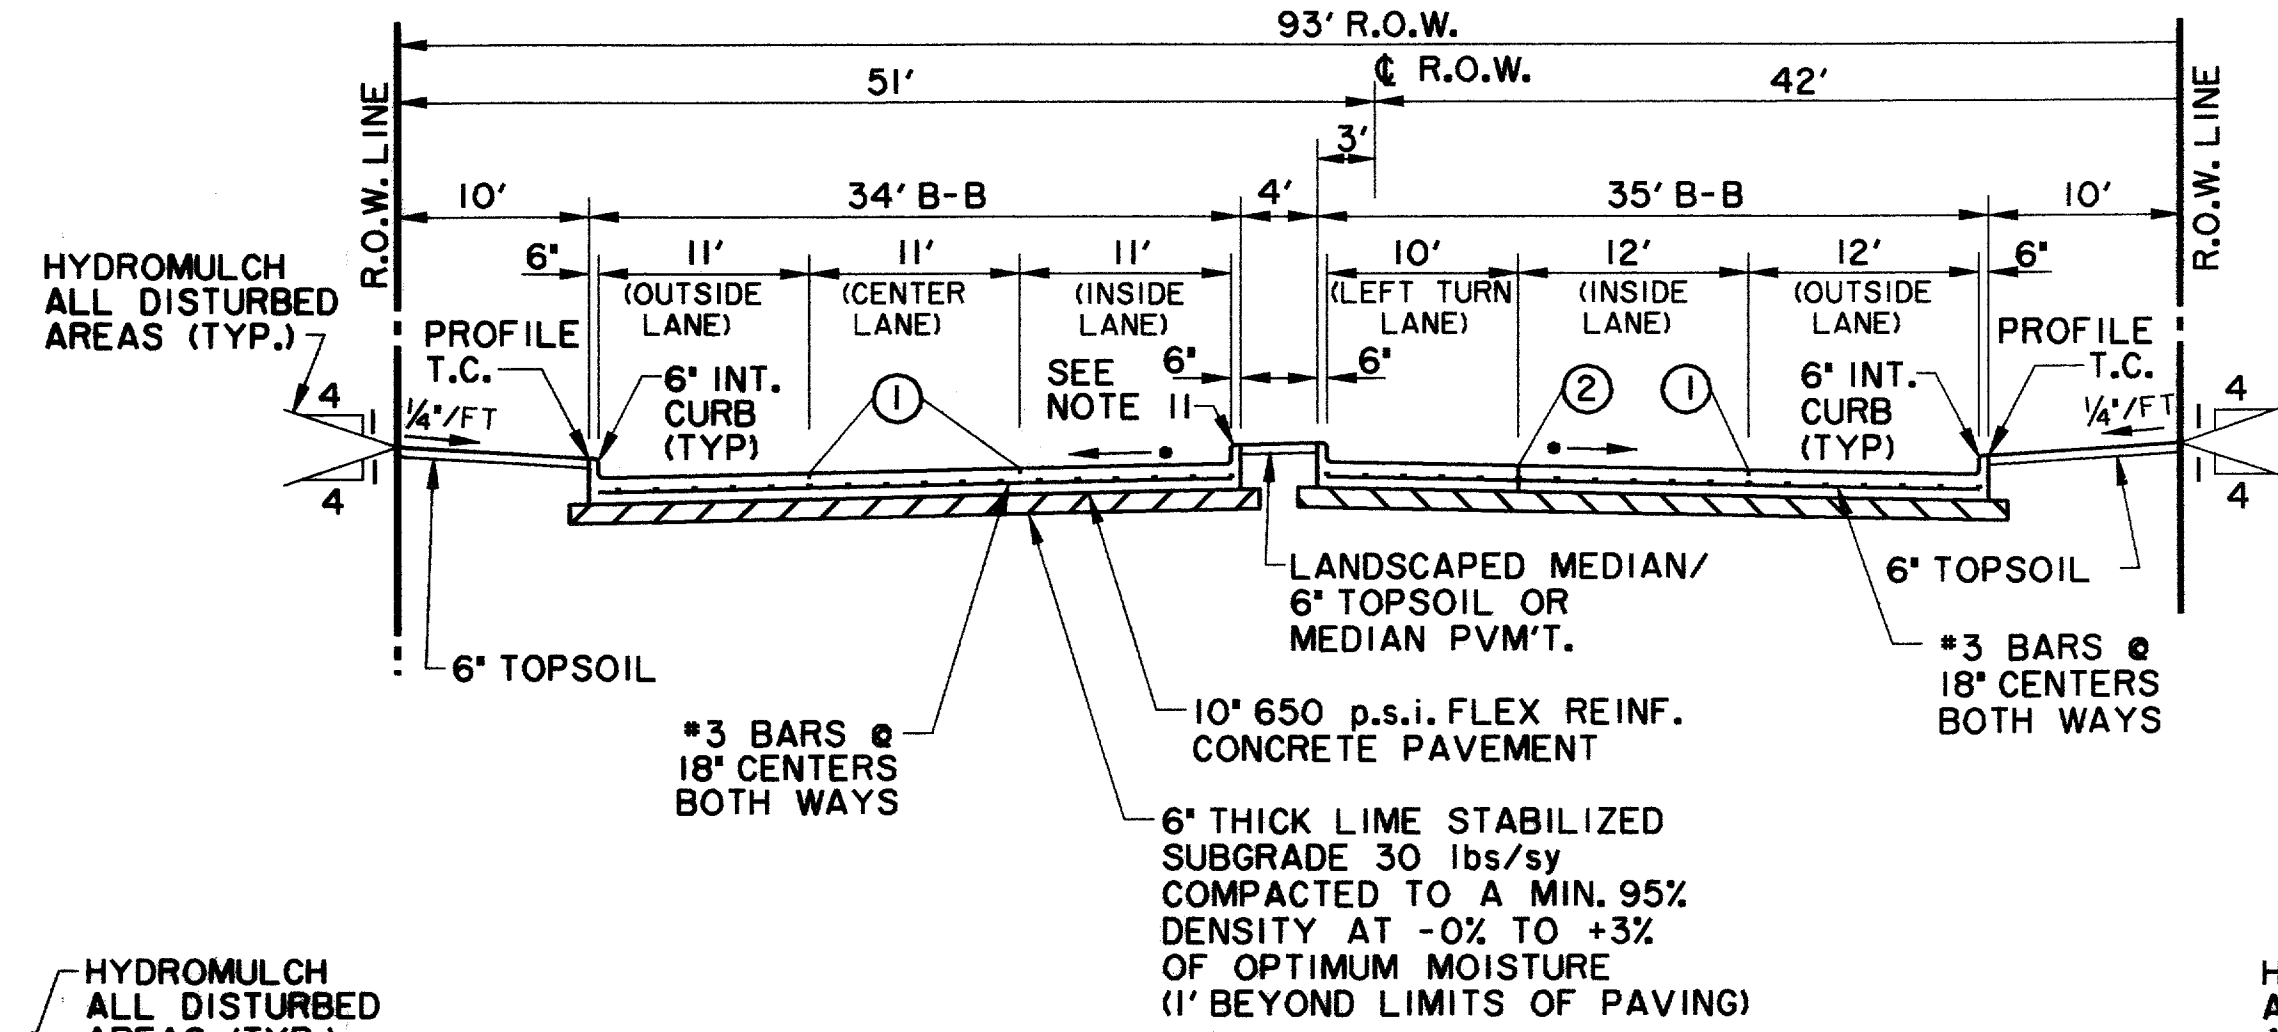

TYPICAL SECTION 5 LANE DIVIDED 2 EASTBOUND LANES WITH LEFT TURN LANE & 3 WESTBOUND LANES

ARAPAHO ROAD


• PAVEMENT CROSS-SLOPES VARY FROM THE TYPICAL 1/4" / 1' ALONG THE ENTIRE LENGTH OF THE PROJECT. SEE PAVING PLANS FOR PROPOSED MEDIAN GRADES.

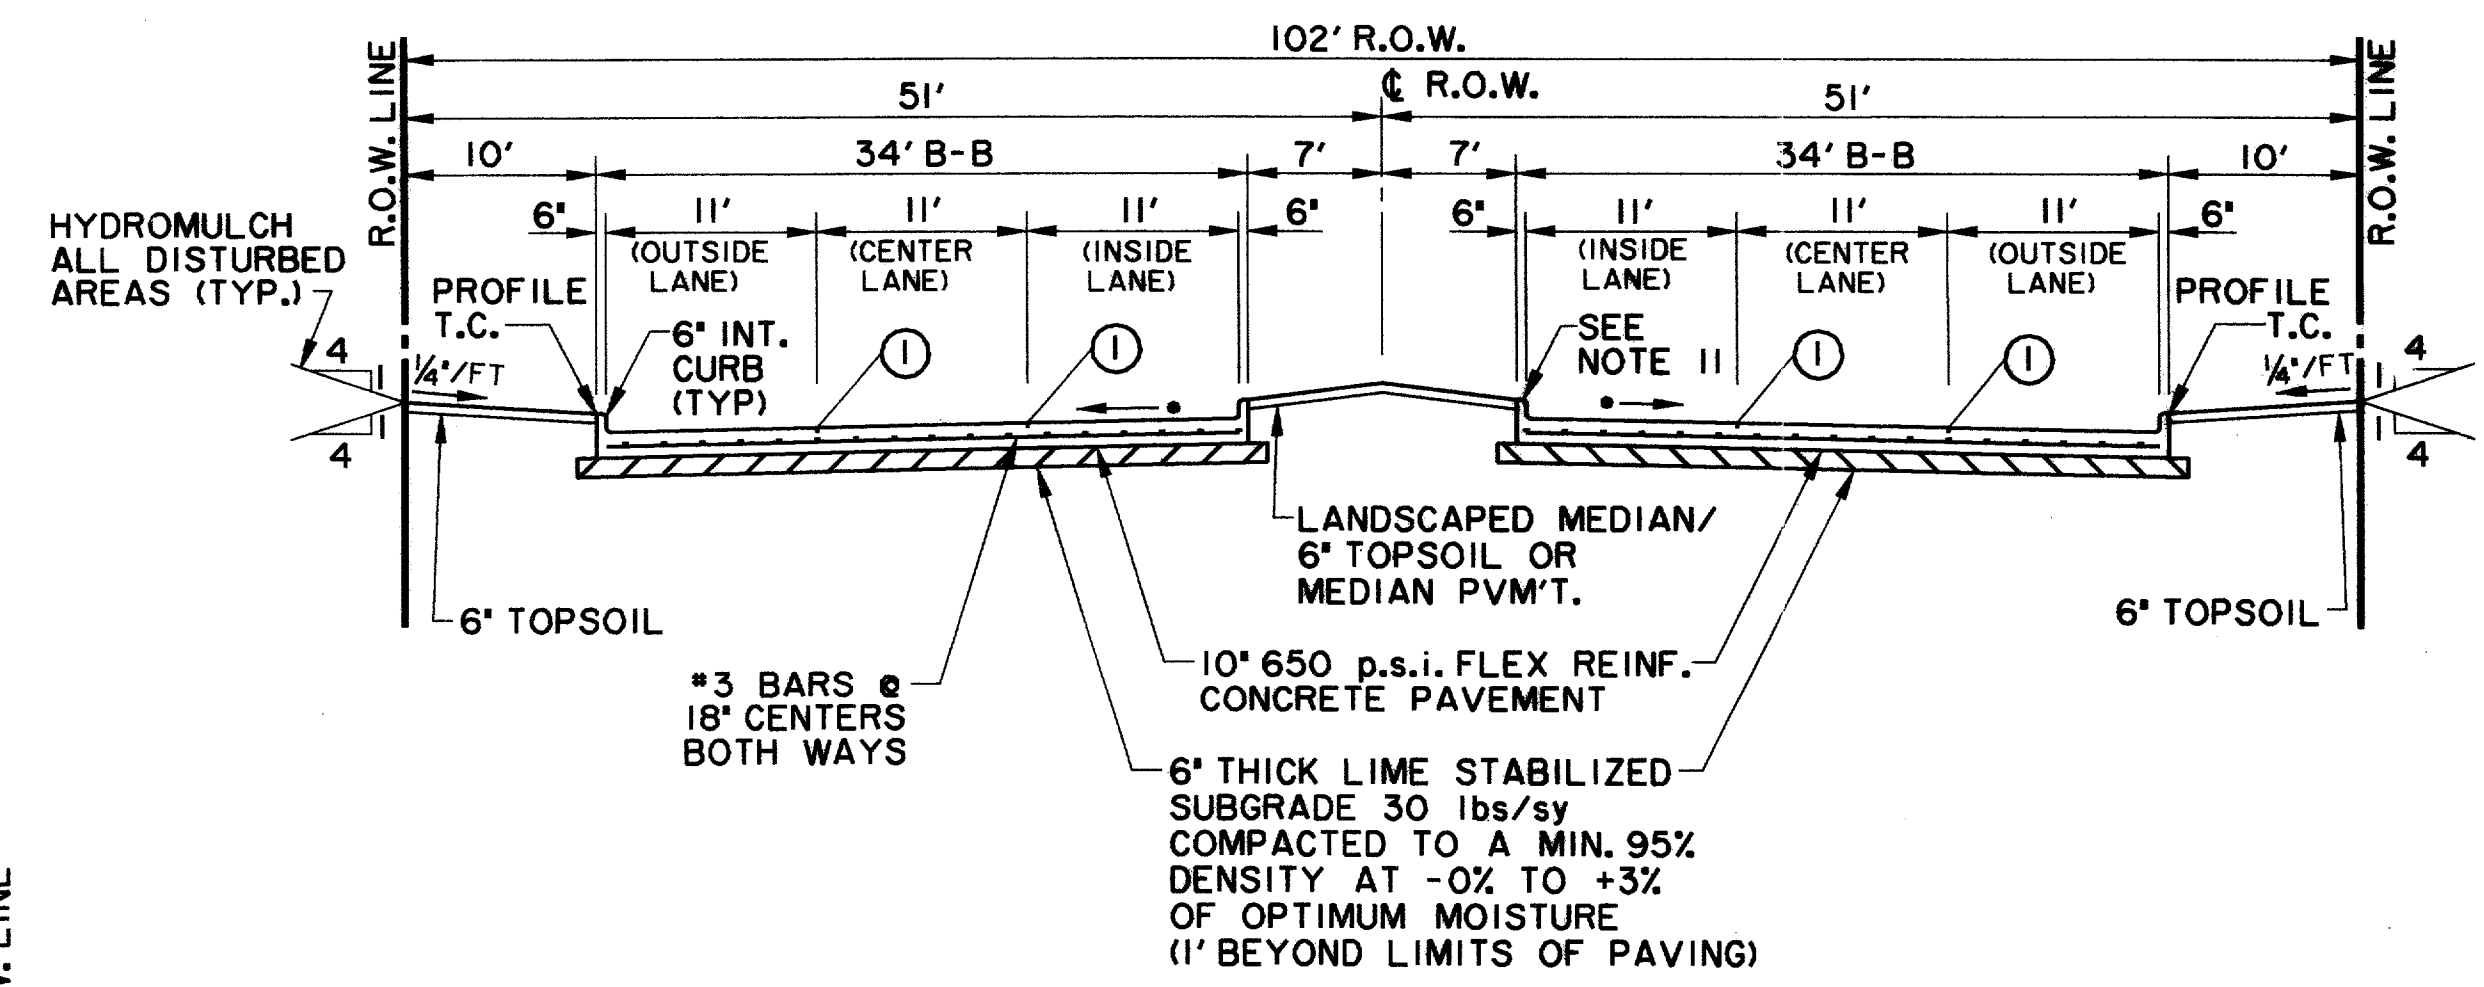

TYPICAL SECTION 6 LANE DIVIDED

ARAPAHO ROAD


• PAVEMENT CROSS-SLOPES VARY FROM THE TYPICAL 1/4" / 1' ALONG THE ENTIRE LENGTH OF THE PROJECT. SEE PAVING PLANS FOR PROPOSED MEDIAN GRADES.

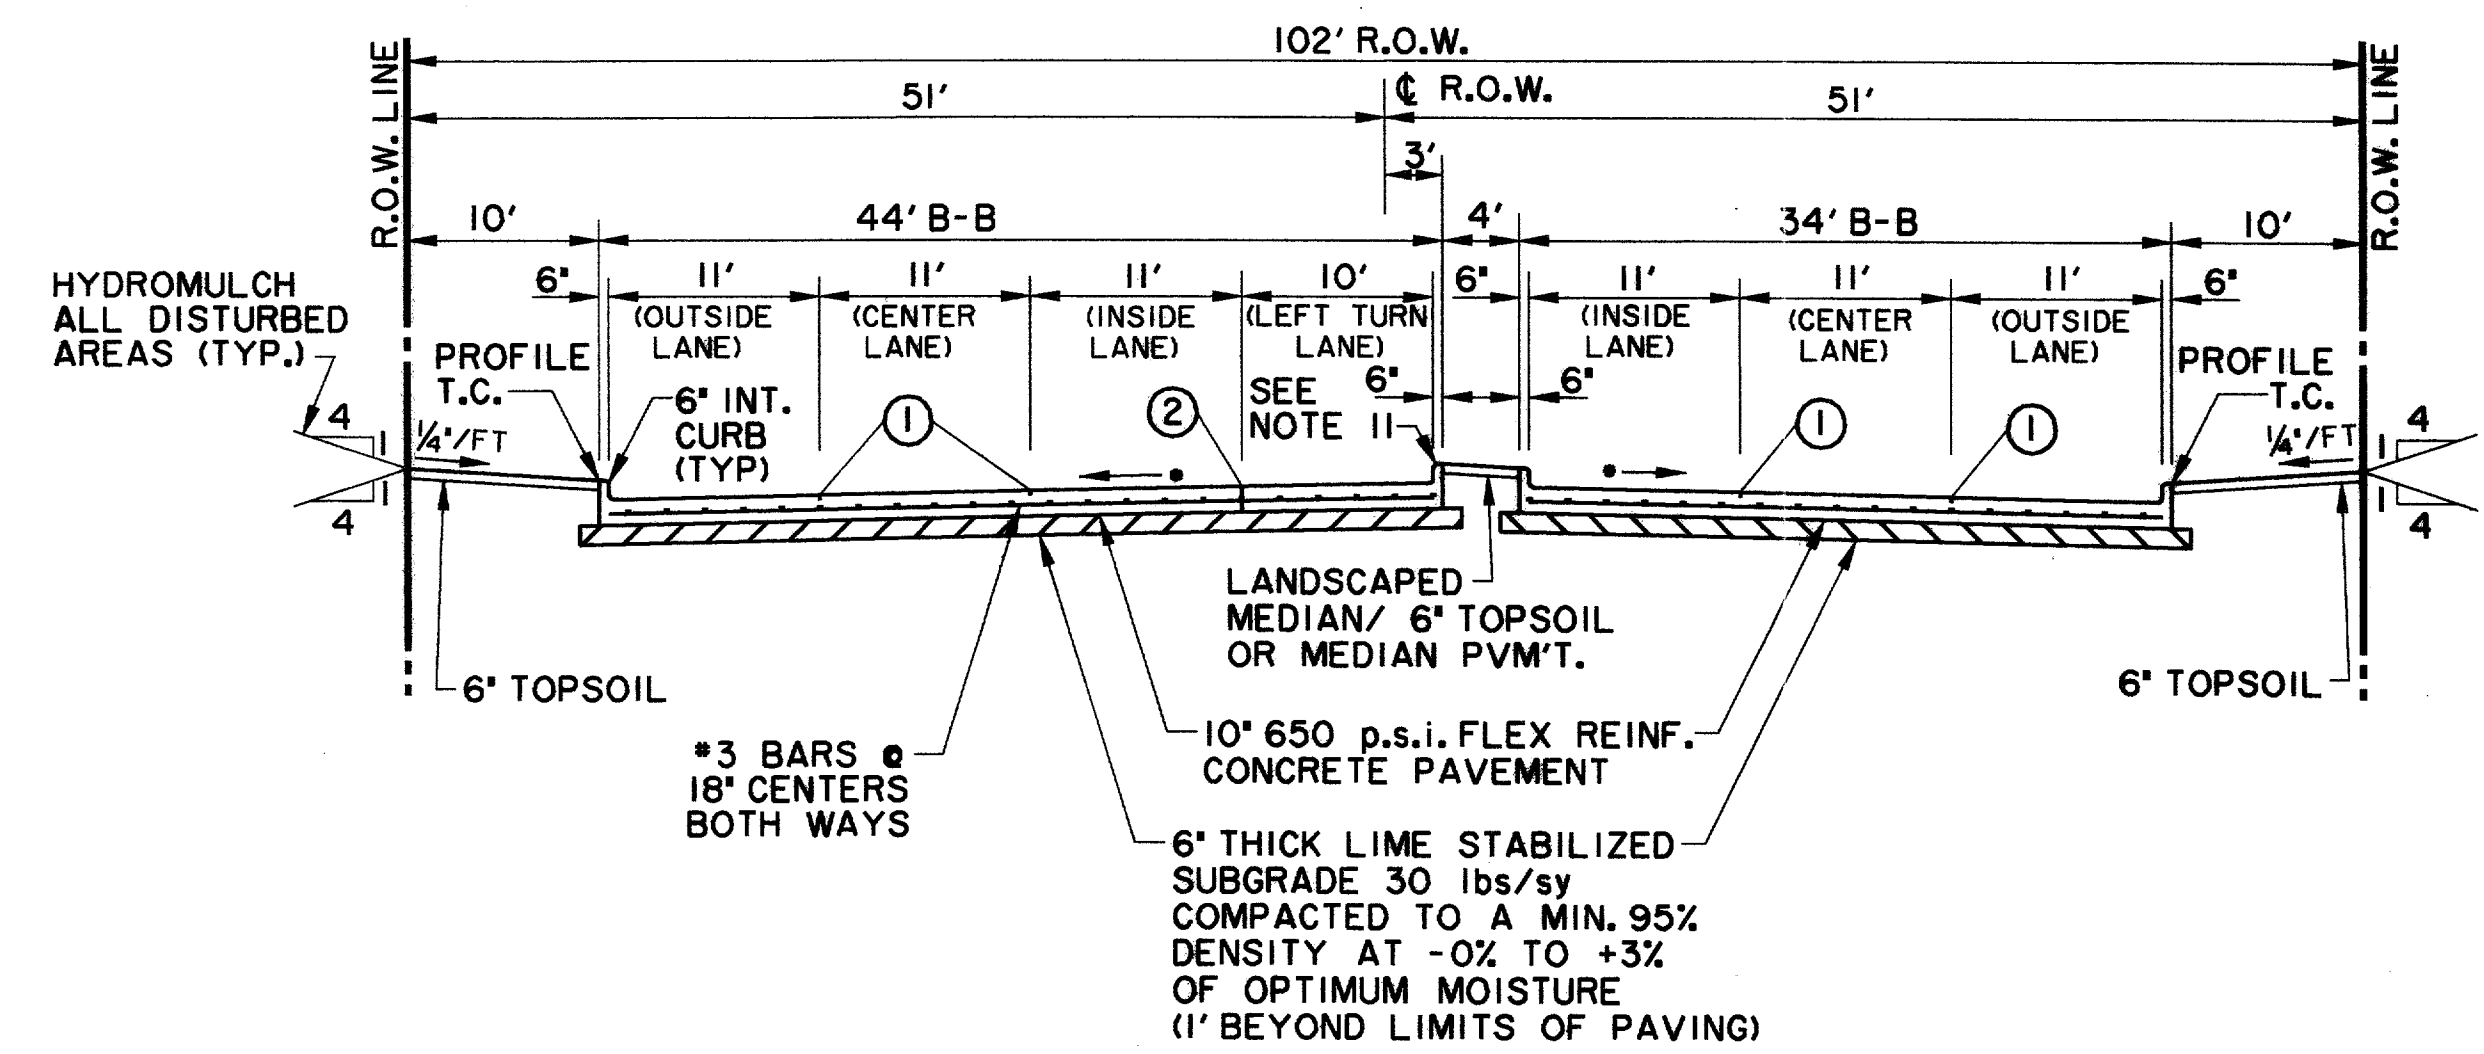

TYPICAL SECTION 6 LANE DIVIDED WITH LEFT TURN LANE

ARAPAHO ROAD


• PAVEMENT CROSS-SLOPES VARY FROM THE TYPICAL 1/4" / 1' ALONG THE ENTIRE LENGTH OF THE PROJECT. SEE PAVING PLANS FOR PROPOSED MEDIAN GRADES.

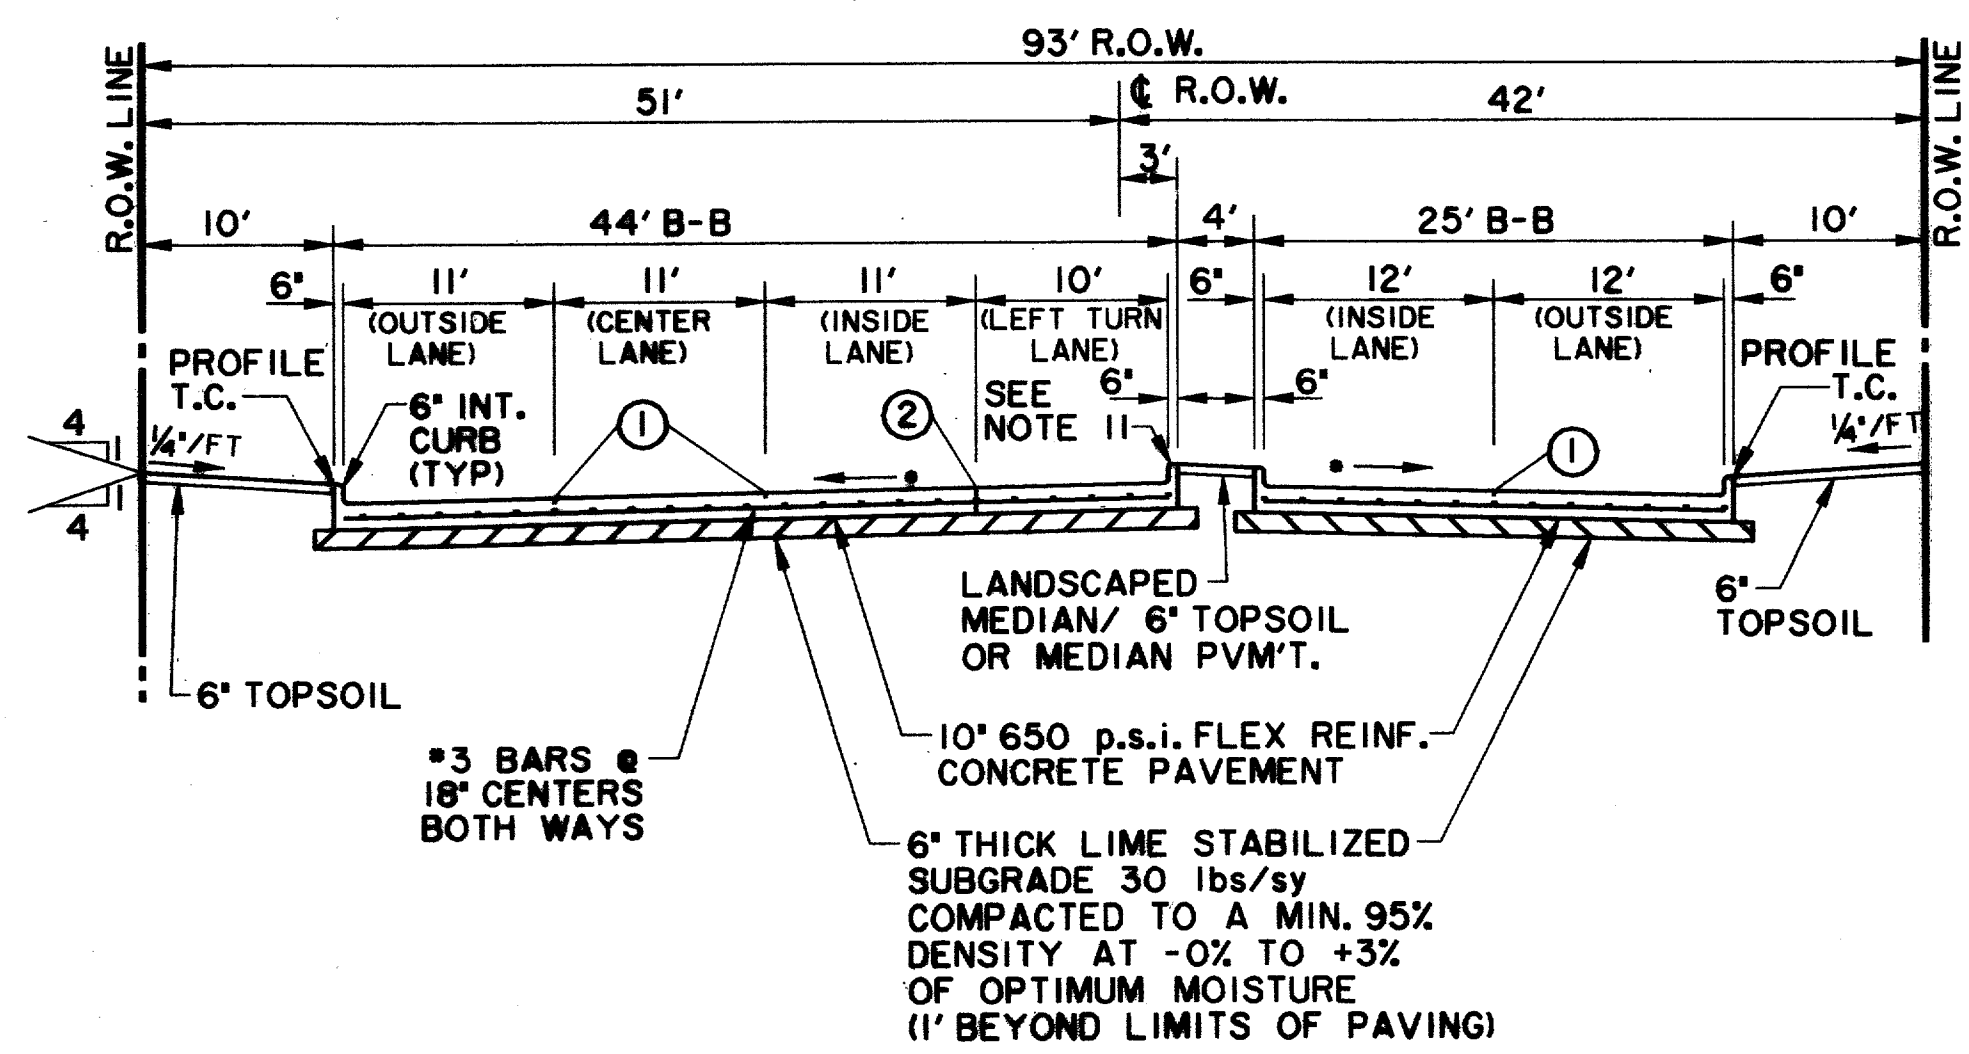

TYPICAL SECTION 5 LANE DIVIDED 2 EASTBOUND LANES & 3 WESTBOUND LANES WITH LEFT TURN LANE

ARAPAHO ROAD

• PAVEMENT CROSS-SLOPES VARY FROM THE TYPICAL 1/4" / 1' ALONG THE ENTIRE LENGTH OF THE PROJECT. SEE PAVING PLANS FOR PROPOSED MEDIAN GRADES.

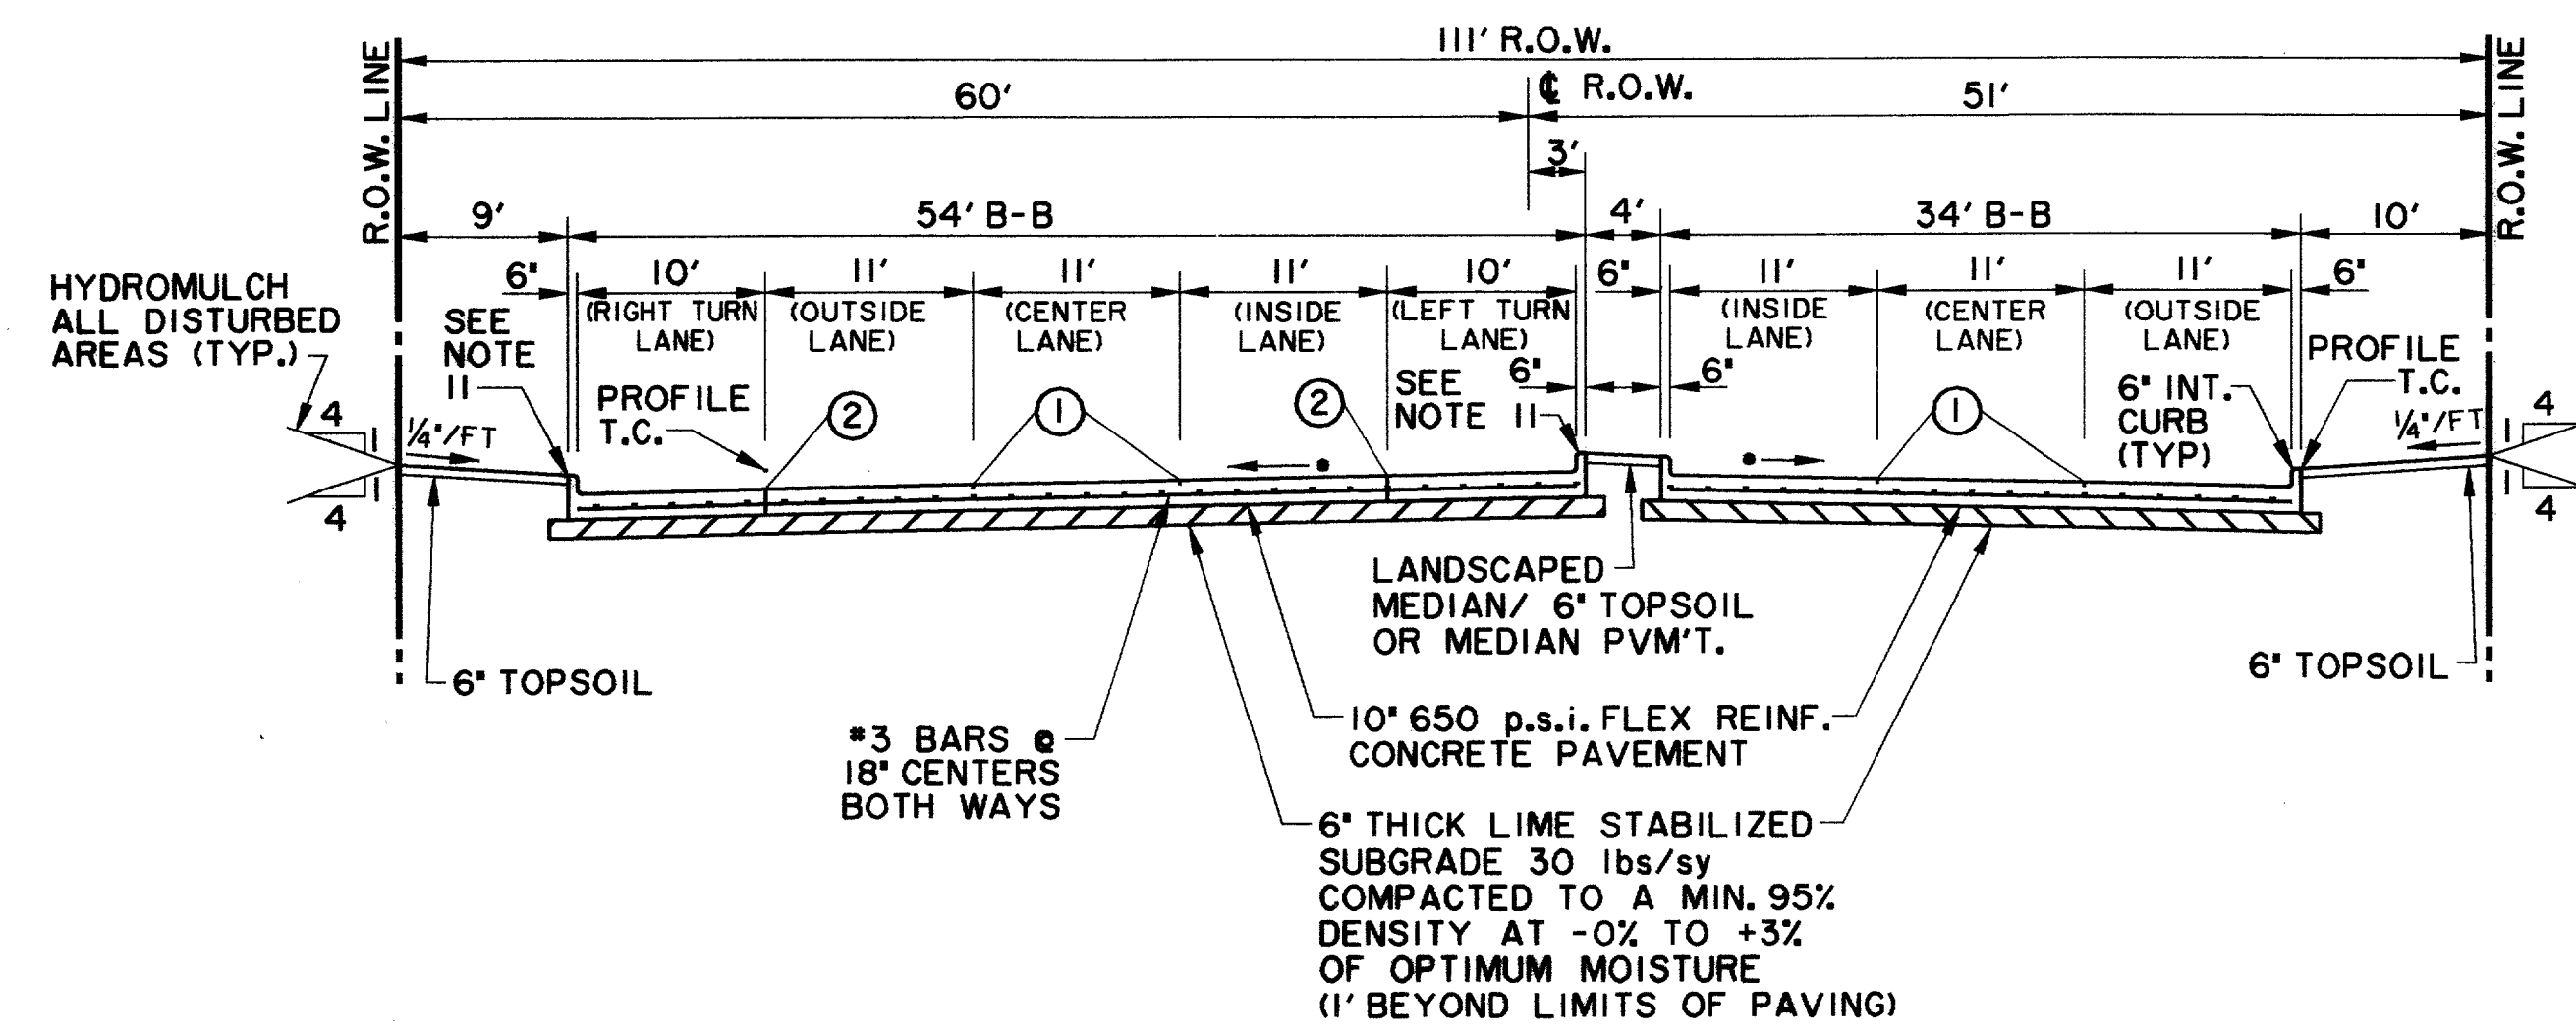

TYPICAL SECTION 6 LANE DIVIDED WITH LEFT & RIGHT TURN LANE


ARAPAHO ROAD

• PAVEMENT CROSS-SLOPES VARY FROM THE TYPICAL 1/4" / 1' ALONG THE ENTIRE LENGTH OF THE PROJECT. SEE PAVING PLANS FOR PROPOSED MEDIAN GRADES.

RECORD DOCUMENTS 6/9/2000

THESE RECORD DOCUMENTS HAVE BEEN PREPARED BASED ON INFORMATION PROVIDED BY OTHERS. THE CONSULTANT HAS NOT VERIFIED THE ACCURACY AND/OR COMPLETENESS OF THIS INFORMATION AND SHALL NOT BE RESPONSIBLE FOR ANY ERRORS OR OMISSIONS THAT MAY BE INCORPORATED AS A RESULT OF ERRONEOUS INFORMATION PROVIDED BY OTHERS.

THE SEAL APPEARING ON THIS DOCUMENT WAS AUTHORIZED BY KENNETH A. ROBERTS, P.E. 55446 ON OCTOBER 24, 1997

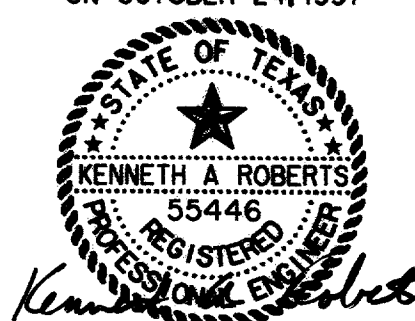

PAVING TYPICAL SECTIONS


ARAPAHO ROAD

ADDISON ROAD TO DALLAS NORTH TOLLWAY

TOWN OF ADDISON, TEXAS

Huilt-Zollars, Inc./Consulting Engineers
Dallas, Fort Worth, Houston, Phoenix, Tustin

DESIGN	DRAWN	APPR.	SCALE	DATE	PROJECT NO.	NO.
HZI	HZI	KAR	1" = 10'	OCT 97	1772-01	P-2

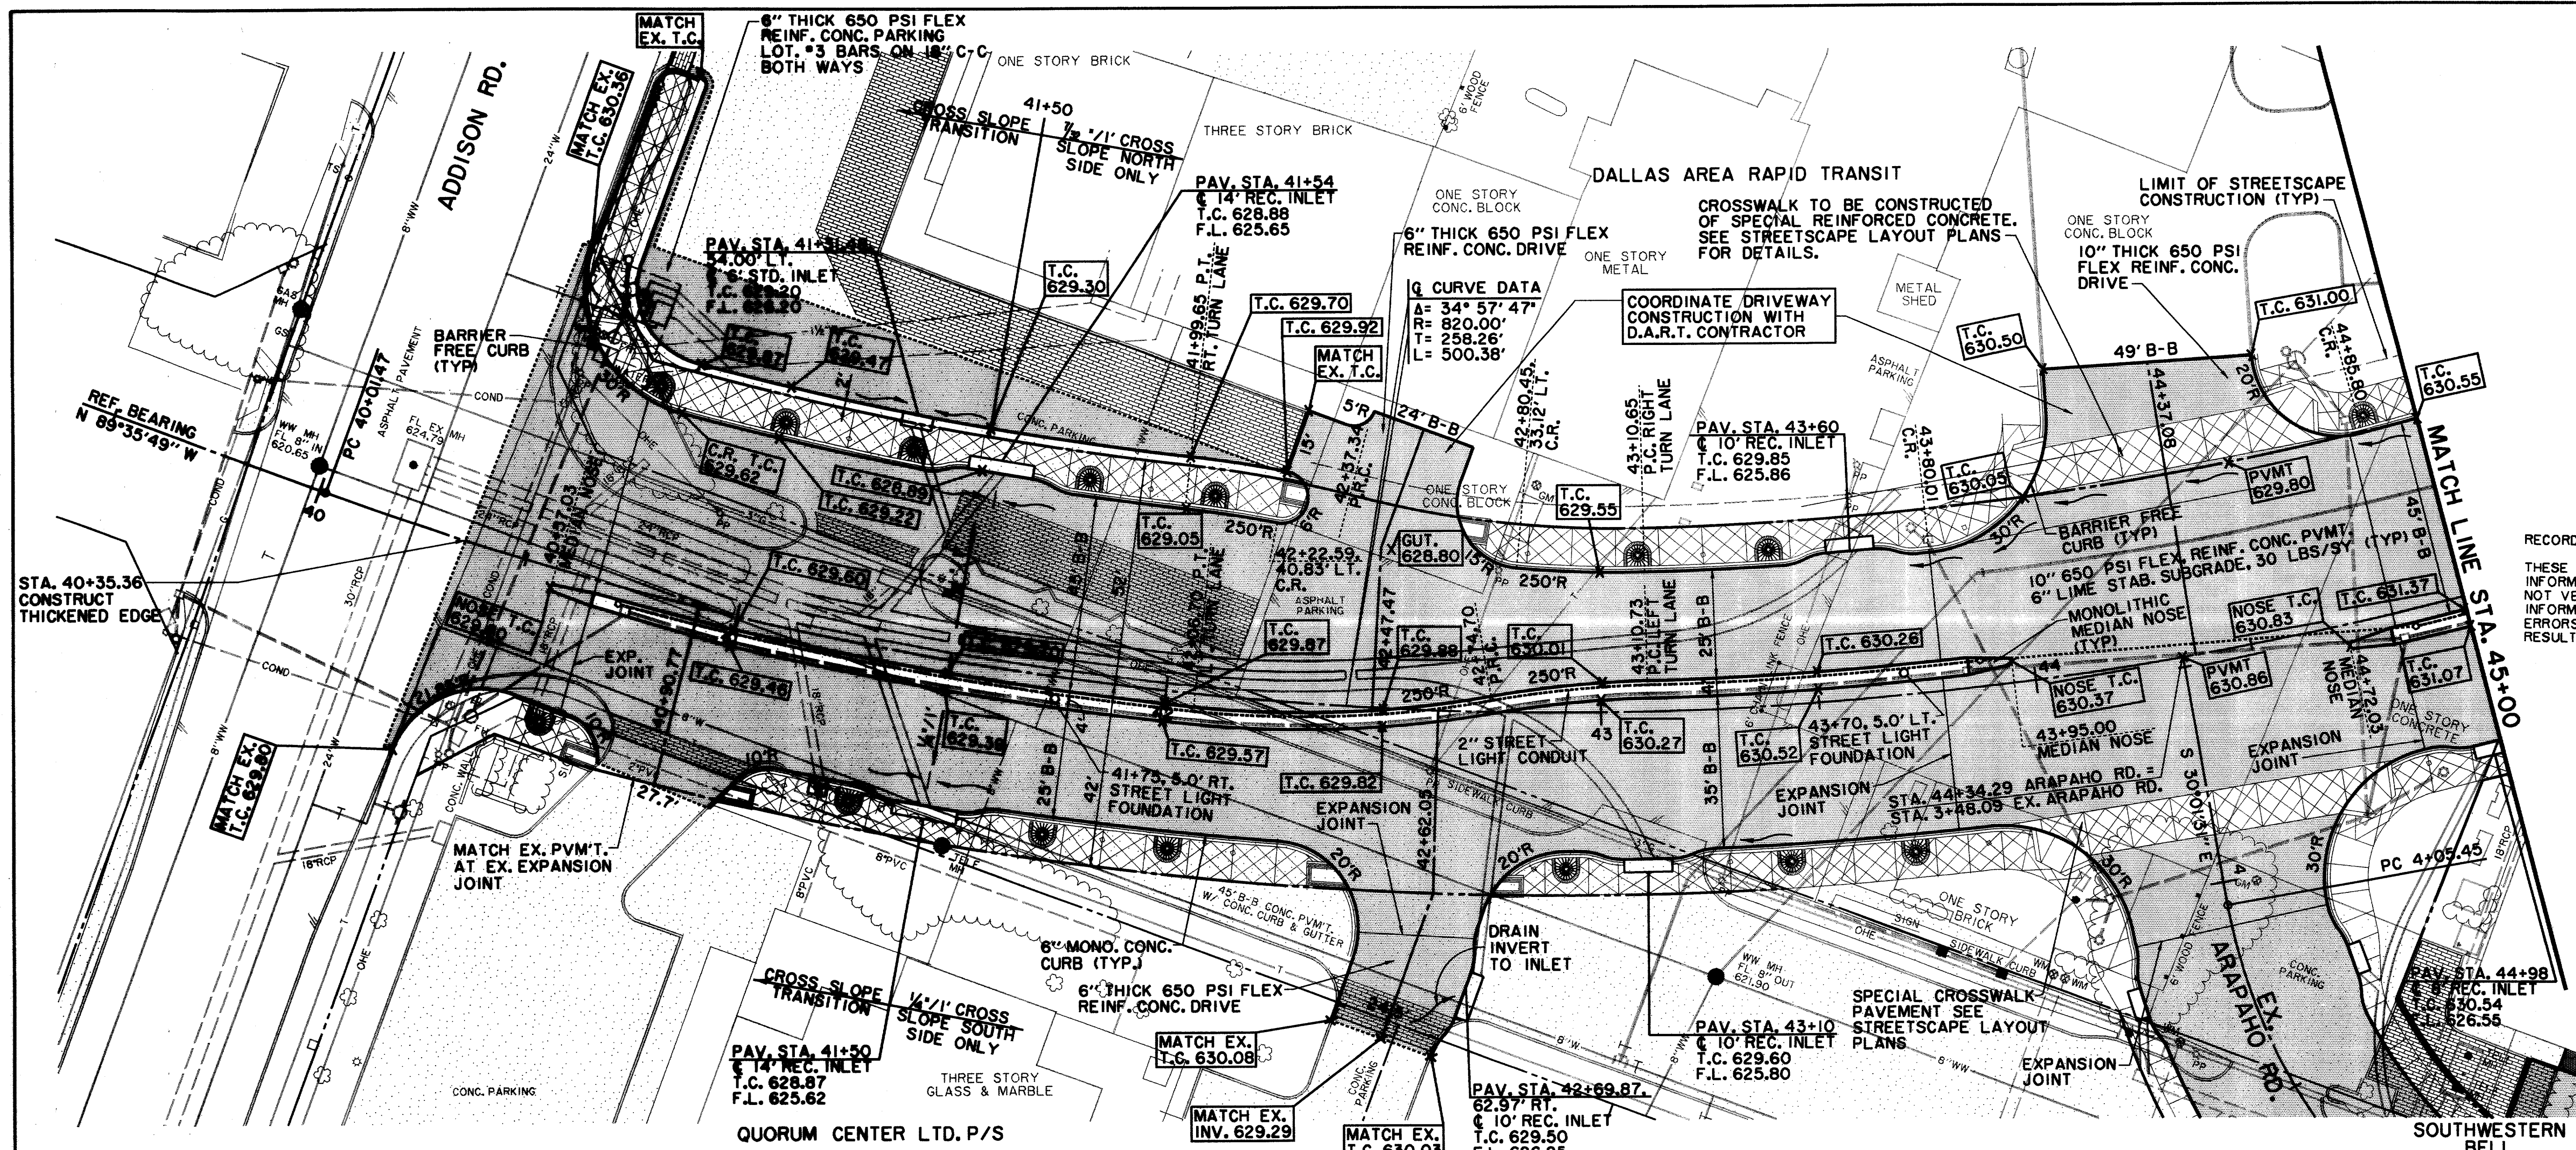


SEE STREETSCAPE PLANS FOR SIDEWALK, LANDSCAPING, IRRIGATION, LIGHTING AND PAVEMENT ENHANCEMENT DETAILS.

RECORD DOCUMENTS 6/9/2000
 THESE RECORD DOCUMENTS HAVE BEEN PREPARED BASED ON INFORMATION PROVIDED BY OTHERS. THE CONSULTANT HAS NOT VERIFIED THE ACCURACY AND/OR COMPLETENESS OF THIS INFORMATION AND SHALL NOT BE RESPONSIBLE FOR ANY ERRORS OR OMISSIONS THAT MAY BE INCORPORATED AS A RESULT OF ERRONEOUS INFORMATION PROVIDED BY OTHERS.

LEGEND

	ELECTRIC — OHE		WATER — W
	LIGHT POLE		FIRE HYDRANT
	POWER POLE		METER
	GUY WIRE		WATER VALVE
	TELEPHONE — T		MISC.
	TELEPHONE MANHOLE		R.C.P. REMOVAL
	TELEPHONE PEDESTAL		CHAIN LINK FENCE
	TELEPHONE SIGN		WOOD FENCE
	GAS — G		EXISTING ASPHALT
	GAS METER		EXISTING DIRT OR GRAVEL
	GAS SIGN		EX. CONCRETE
	LAND USE		TREE/TREE LINE
	RAILROAD SIGN		EXISTING CURB
	SIGN		PROP. CURB
	SURVEY		EX. PROPERTY LINE
	FOUND IRON ROD		PROP. CENTERLINE
	TEMP BENCHMARK		PROP. R.O.W.
	WASTEWATER — WW		PROP. INLET
	WASTEWATER MANHOLE		TOP OF PAVEMENT
	CLEANOUT		TOP OF CURB
			CURB RETURN

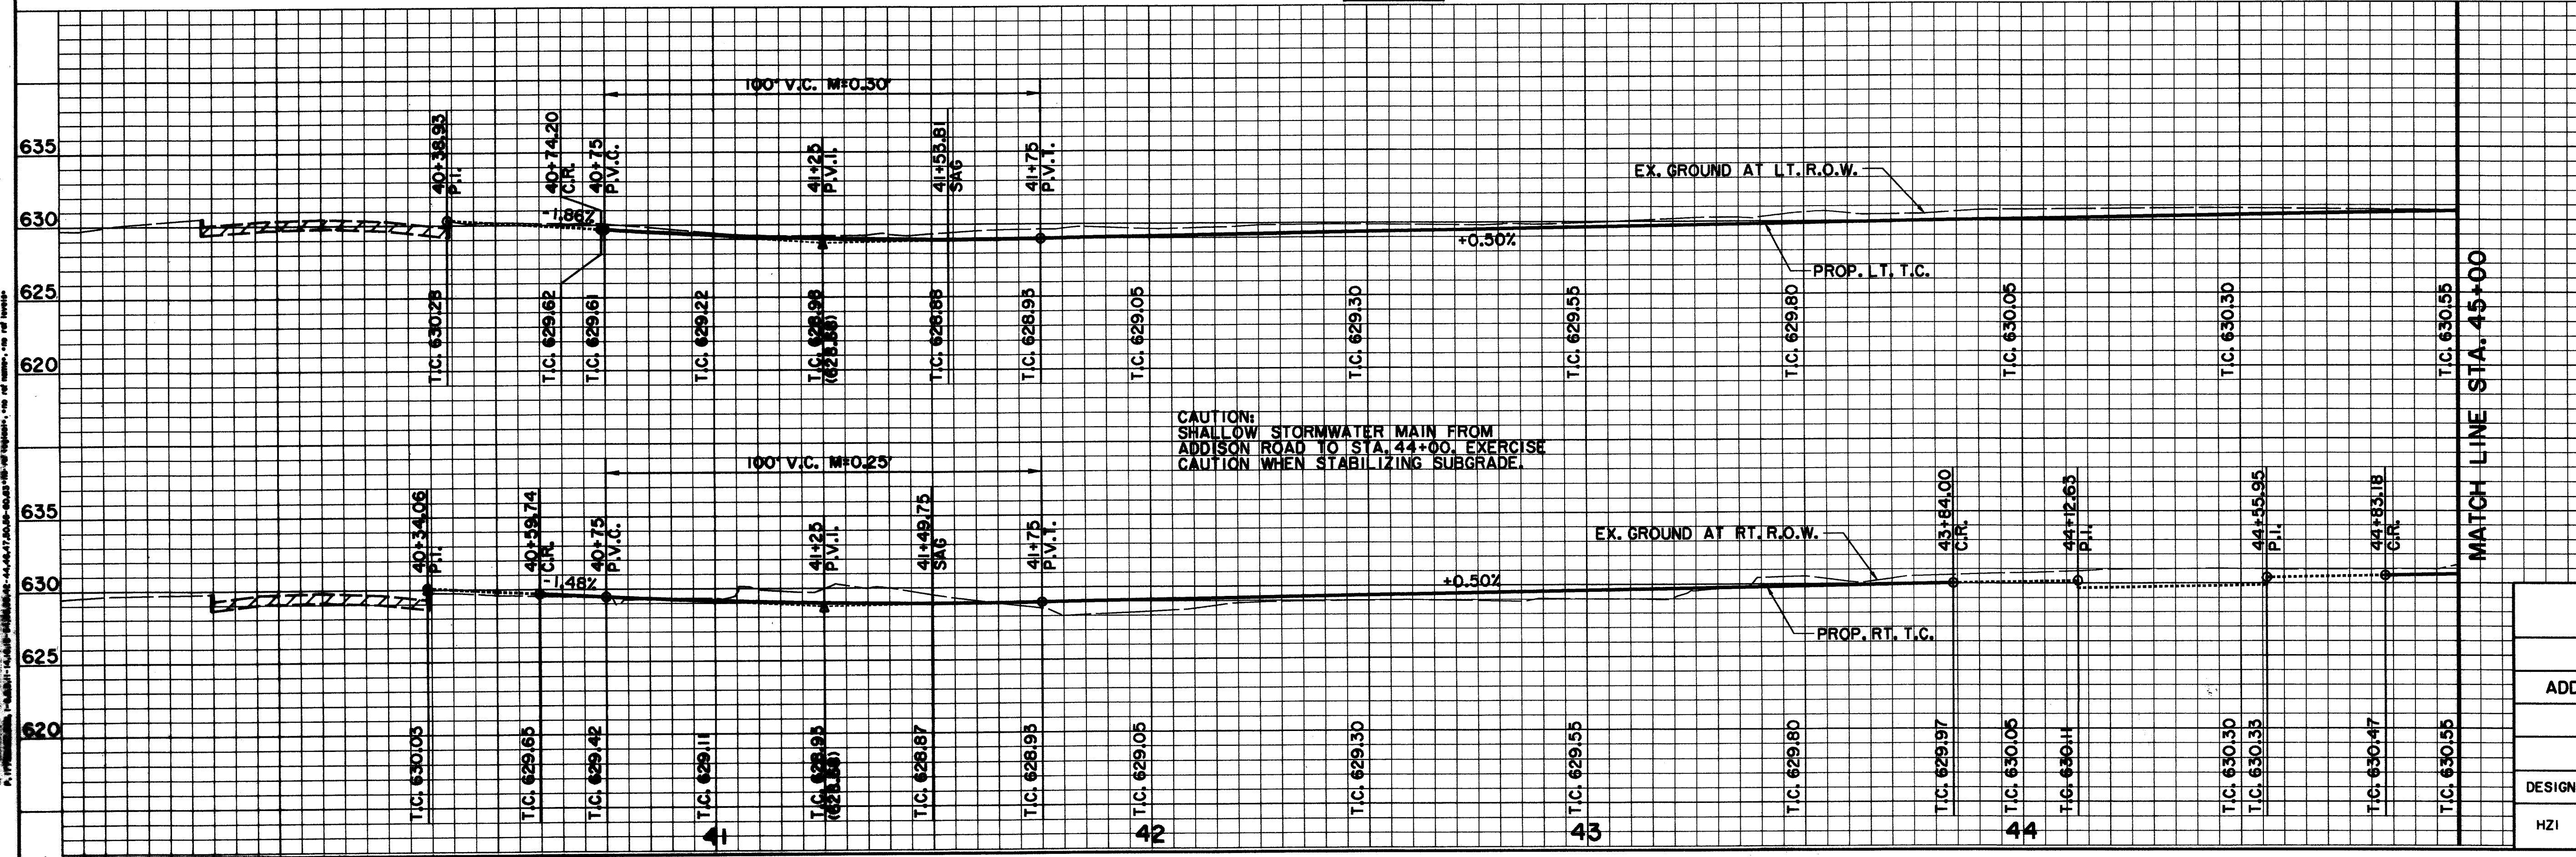

BENCHMARKS:
 USC & GS E-921 DISK IN BRICK WALL OF OLD ADDISON SCHOOL HOUSE (MAGIC TIME MACHINE RESTAURANT) ON SOUTH WALL, 4' EAST OF CENTER OF THE ENTRANCE, 4.7' ABOVE THE GROUND, ELEV. 650.61

"I" ON SOUTHEAST CORNER OF CONCRETE WALK AT FRONT ENTRANCE TO 4805 ARAPAHO ROAD, ELEV. 630.61



THE SEAL APPEARING ON THIS DOCUMENT WAS AUTHORIZED BY KENNETH A. ROBERTS, P.E. 55446 ON OCTOBER 24, 1997

Kenneth A. Roberts
10-24-97

PAVING PLAN & PROFILE
 ADDISON ROAD TO STA. 45+00
ARAPAHO ROAD
 ADDISON ROAD TO DALLAS NORTH TOLLWAY
TOWN OF ADDISON, TEXAS
 Huitt-Zollars, Inc./Consulting Engineers
 Dallas, Fort Worth, Houston, Phoenix, Tustin

DESIGN	DRAWN	APPR.	SCALE	DATE	PROJECT NO.	NO.
HZ1	HZ1	KAR	H _v 1"=20' V ₁ 1"=6'	OCT 97	1772-01	P-3

THE INFORMATION CONTAINED HEREIN IS THE PROPERTY OF HUIIT-ZOLLARS, INC. AND IS NOT TO BE REPRODUCED OR TRANSMITTED IN ANY FORM OR BY ANY MEANS, ELECTRONIC OR MECHANICAL, INCLUDING PHOTOCOPYING, RECORDING, OR BY ANY INFORMATION STORAGE AND RETRIEVAL SYSTEM, WITHOUT THE WRITTEN PERMISSION OF HUIIT-ZOLLARS, INC.

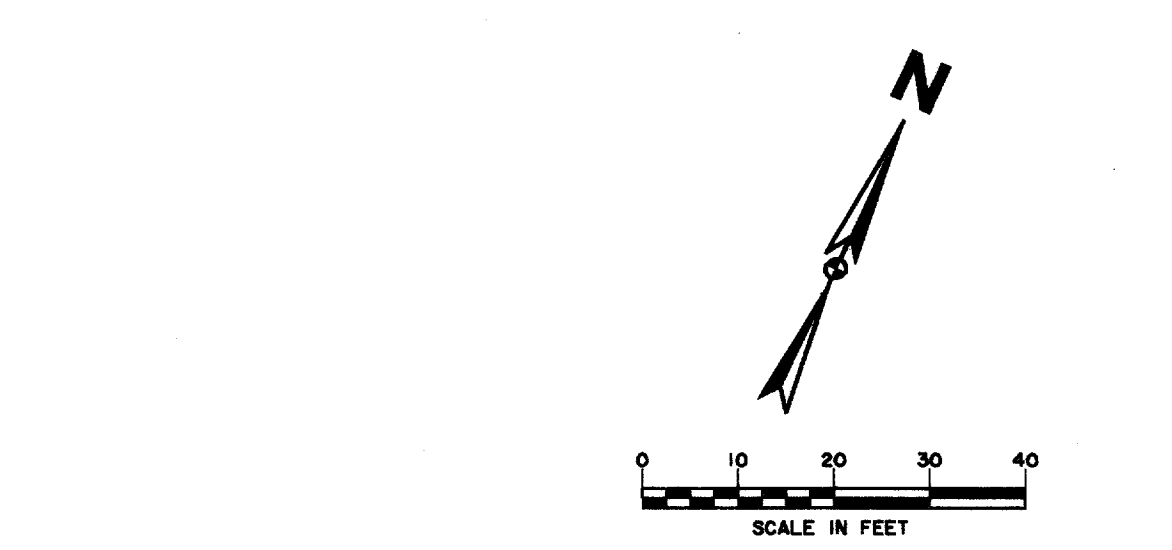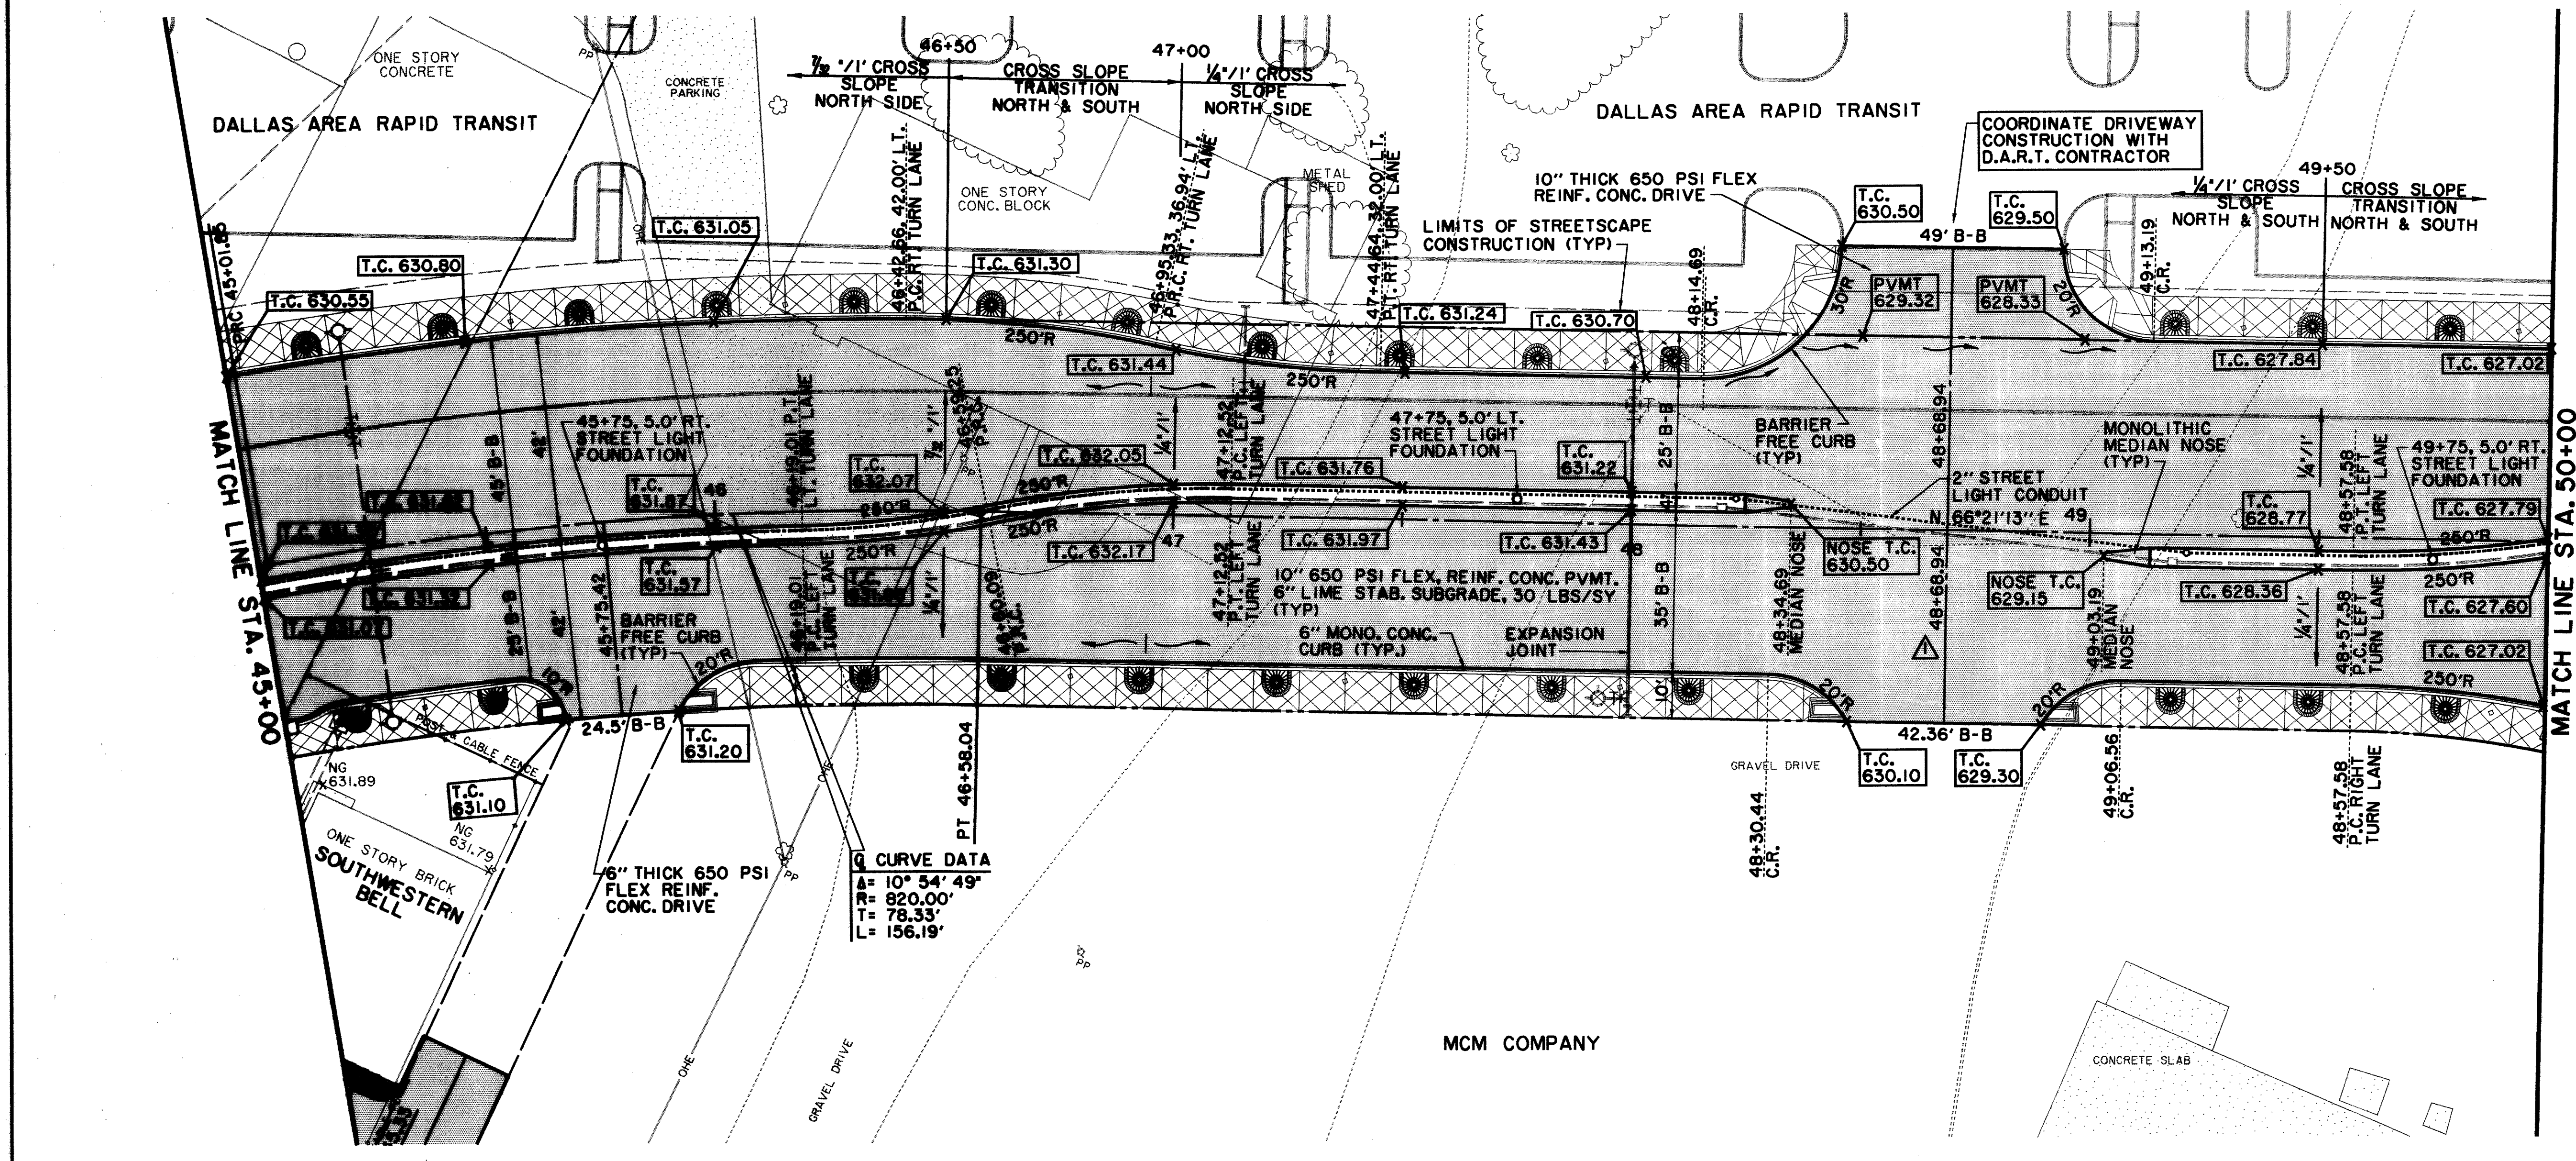


SEE STREETScape PLANS FOR SIDEWALK, LANDSCAPING, IRRIGATION, LIGHTING AND PAVEMENT ENHANCEMENT DETAILS.

RECORD DOCUMENTS 6/9/2000
 THESE RECORD DOCUMENTS HAVE BEEN PREPARED BASED ON INFORMATION PROVIDED BY OTHERS. THE CONSULTANT HAS NOT VERIFIED THE ACCURACY AND/OR COMPLETENESS OF THIS INFORMATION AND SHALL NOT BE RESPONSIBLE FOR ANY ERRORS OR OMISSIONS THAT MAY BE INCORPORATED AS A RESULT OF ERRONEOUS INFORMATION PROVIDED BY OTHERS.

LEGEND

ELECTRIC — OH —	WATER — W —
○ LIGHT POLE	FH FIRE HYDRANT
PP POWER POLE	WM METER
— GUY WIRE	T WATER VALVE
TELEPHONE — T —	MISC.
● TELEPHONE MANHOLE	48" RCP R.C.P. REMOVAL
□ TELEPHONE PEDESTAL	— CHAIN LINK FENCE
TS TELEPHONE SIGN	— WOOD FENCE
GAS — G —	— EXISTING ASPHALT
GM GAS METER	— EXISTING DIRT OR GRAVEL
GS GAS SIGN	— EX. CONCRETE
LAND USE	— TREE/TREE LINE
R/R RAILROAD SIGN	— EXISTING CURB
— SURVEY	— PROP. CURB
I.R. FOUND IRON ROD	— EX. PROPERTY LINE
□ TEMP BENCHMARK	— PROP. CENTERLINE
WASTEWATER — WW —	— PROP. R.O.W.
● WASTEWATER MANHOLE	— PROP. INLET
CO CLEANOUT	PVMT TOP OF PAVEMENT
	T.C. TOP OF CURB
	C.R. CURB RETURN

CURVE DATA
 $\Delta = 10^\circ 54' 49"$
 $R = 820.00'$
 $T = 78.33'$
 $L = 156.19'$

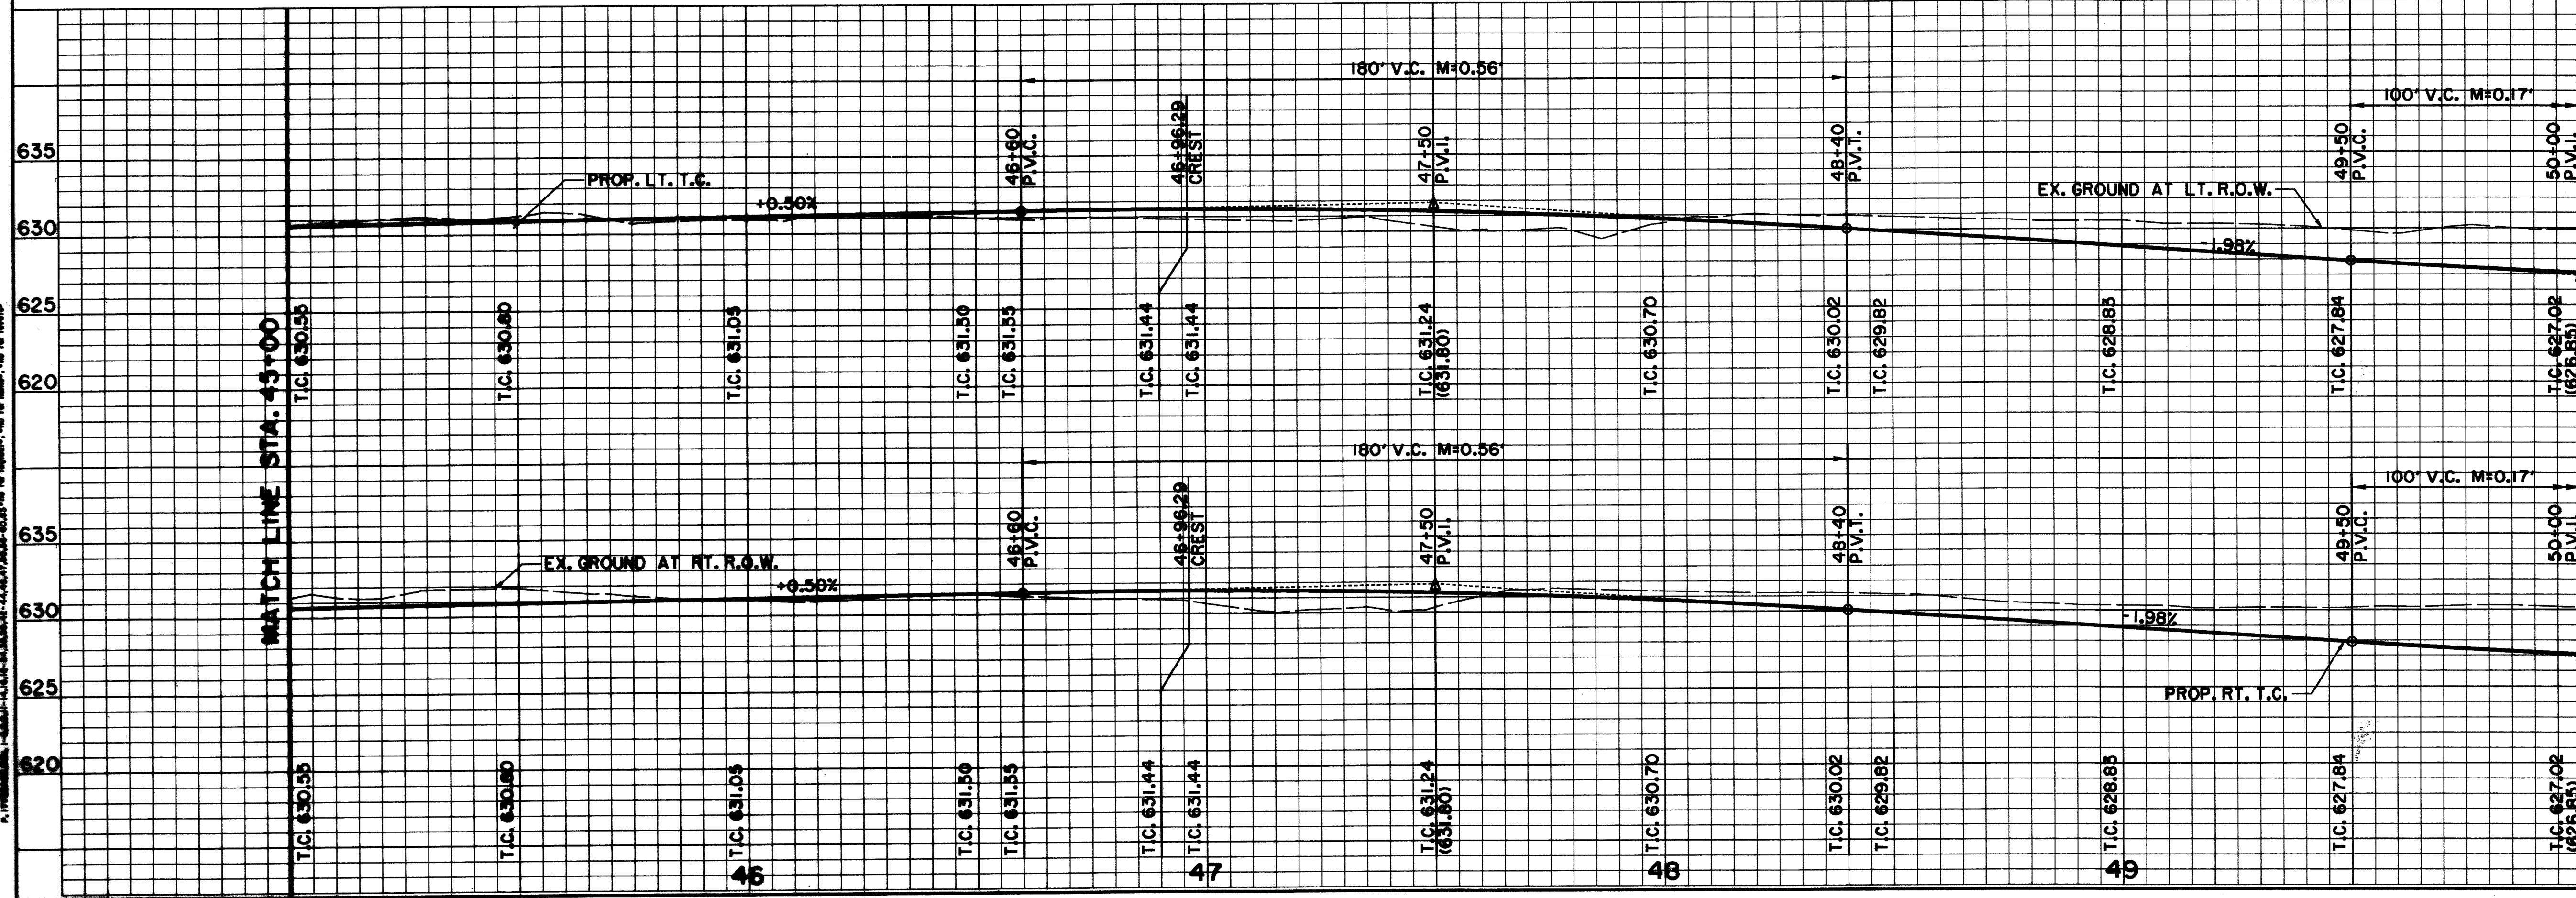

BENCHMARKS:
 USC & GS E-921 DISK IN BRICK WALL OF OLD ADDISON SCHOOL HOUSE (MAGIC TIME MACHINE RESTAURANT) ON SOUTH WALL, 4' EAST OF CENTER OF THE ENTRANCE, 4.7' ABOVE THE GROUND, ELEV. 650.61
 "I" ON SOUTHEAST CORNER OF CONCRETE WALK AT FRONT ENTRANCE TO 4805 ARAPAHO ROAD, ELEV. 630.61

THE SEAL APPEARING ON THIS DOCUMENT WAS AUTHORIZED BY KENNETH A. ROBERTS, P.E. 55446 ON OCTOBER 24, 1997

REVIS 1/16/98

PAVING PLAN & PROFILE
 STA. 45+00 TO STA. 50+00
ARAPAHO ROAD
 ADDISON ROAD TO DALLAS NORTH TOLLWAY
 TOWN OF ADDISON, TEXAS
 Huitt-Zollars, Inc./Consulting Engineers
 Dallas, Fort Worth, Houston, Phoenix, Tustin

DESIGN	DRAWN	APPR.	SCALE	DATE	PROJECT NO.	NO.
HZI	HZI	KAR	H: 1"=20' V: 1"=8'	OCT 97	1772-01	P-4

ALL INFORMATION CONTAINED HEREIN IS THE PROPERTY OF HUIIT-ZOLLARS, INC. AND IS TO BE USED ONLY FOR THE PROJECT AND SITE SPECIFICALLY IDENTIFIED HEREIN. ANY REUSE OR MODIFICATION OF THIS INFORMATION WITHOUT THE WRITTEN CONSENT OF HUIIT-ZOLLARS, INC. IS STRICTLY PROHIBITED.

COORDINATE CONSTRUCTION WITH D.A.R.T. CONTRACTOR


CROSS SLOPE 1/4" / 1' CROSS SLOPE TRANSITION NORTH & SOUTH

LIMITS OF STREETScape CONSTRUCTION (TYP)

BROOKS BURIED CABLE. CONTACT THERESA HARDIN 972/753-1900 48 HOURS PRIOR TO ANY CONSTRUCTION IN THIS AREA

TOWN OF ADDISON

THESE RECORD DOCUMENTS HAVE BEEN PREPARED BASED ON INFORMATION PROVIDED BY OTHERS. THE CONSULTANT HAS NOT VERIFIED THE ACCURACY AND/OR COMPLETENESS OF THIS INFORMATION AND SHALL NOT BE RESPONSIBLE FOR ANY ERRORS OR OMISSIONS THAT MAY BE INCORPORATED AS A RESULT OF ERRONEOUS INFORMATION PROVIDED BY OTHERS.

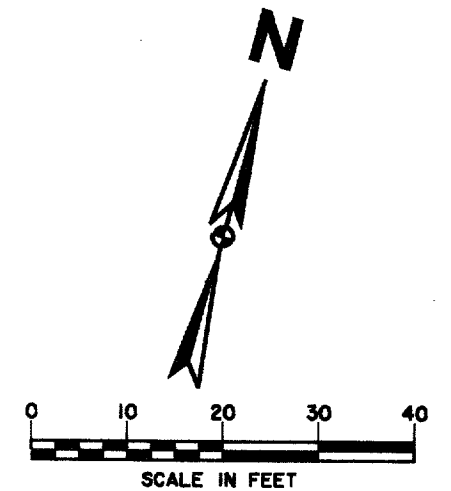


SEE STREETScape PLANS FOR SIDEWALK, LANDSCAPING, IRRIGATION, LIGHTING AND PAVEMENT ENHANCEMENT DETAILS.

NOTE: EXISTING FILL MATERIAL TO DEPTHS OF 4-6 FEET, FROM APPROXIMATELY PAVING STATION 53+00 TO 56+00, CONSISTING OF BROKEN LIMESTONE AND MISCELLANEOUS DEBRIS SHALL BE EXCAVATED, REMOVED AND DISPOSED OF AND REPLACED WITH ON-SITE SOILS COMPACTED IN LIFTS AS DESCRIBED IN THE SPECIFICATIONS.

LEGEND

ELECTRIC — OHE	WATER — W
○ LIGHT POLE	FH FIRE HYDRANT
PP POWER POLE	WM METER
— GUY WIRE	T WATER VALVE
TELEPHONE — T	MISC.
MH TELEPHONE MANHOLE	48" RCP R.C.P. REMOVAL
TELEPHONE PEDESTAL	CHAIN LINK FENCE
TS TELEPHONE SIGN	WOOD FENCE
GM GAS METER	EXISTING ASPHALT
GS GAS SIGN	EXISTING DIRT OR GRAVEL
LAND USE	EX. CONCRETE
R.R. RAILROAD SIGN	TREE/TREE LINE
— SIGN	EXISTING CURB
SURVEY	PROP. CURB
I.R. FOUND IRON ROD	EX. PROPERTY LINE
TEMP BENCHMARK	PROP. CENTERLINE
WASTEWATER — WW	PROP. R.O.W.
MH WASTEWATER MANHOLE	PROP. INLET
CO CLEANOUT	PVMT TOP OF PAVEMENT
	T.C. TOP OF CURB
	C.R. CURB RETURN

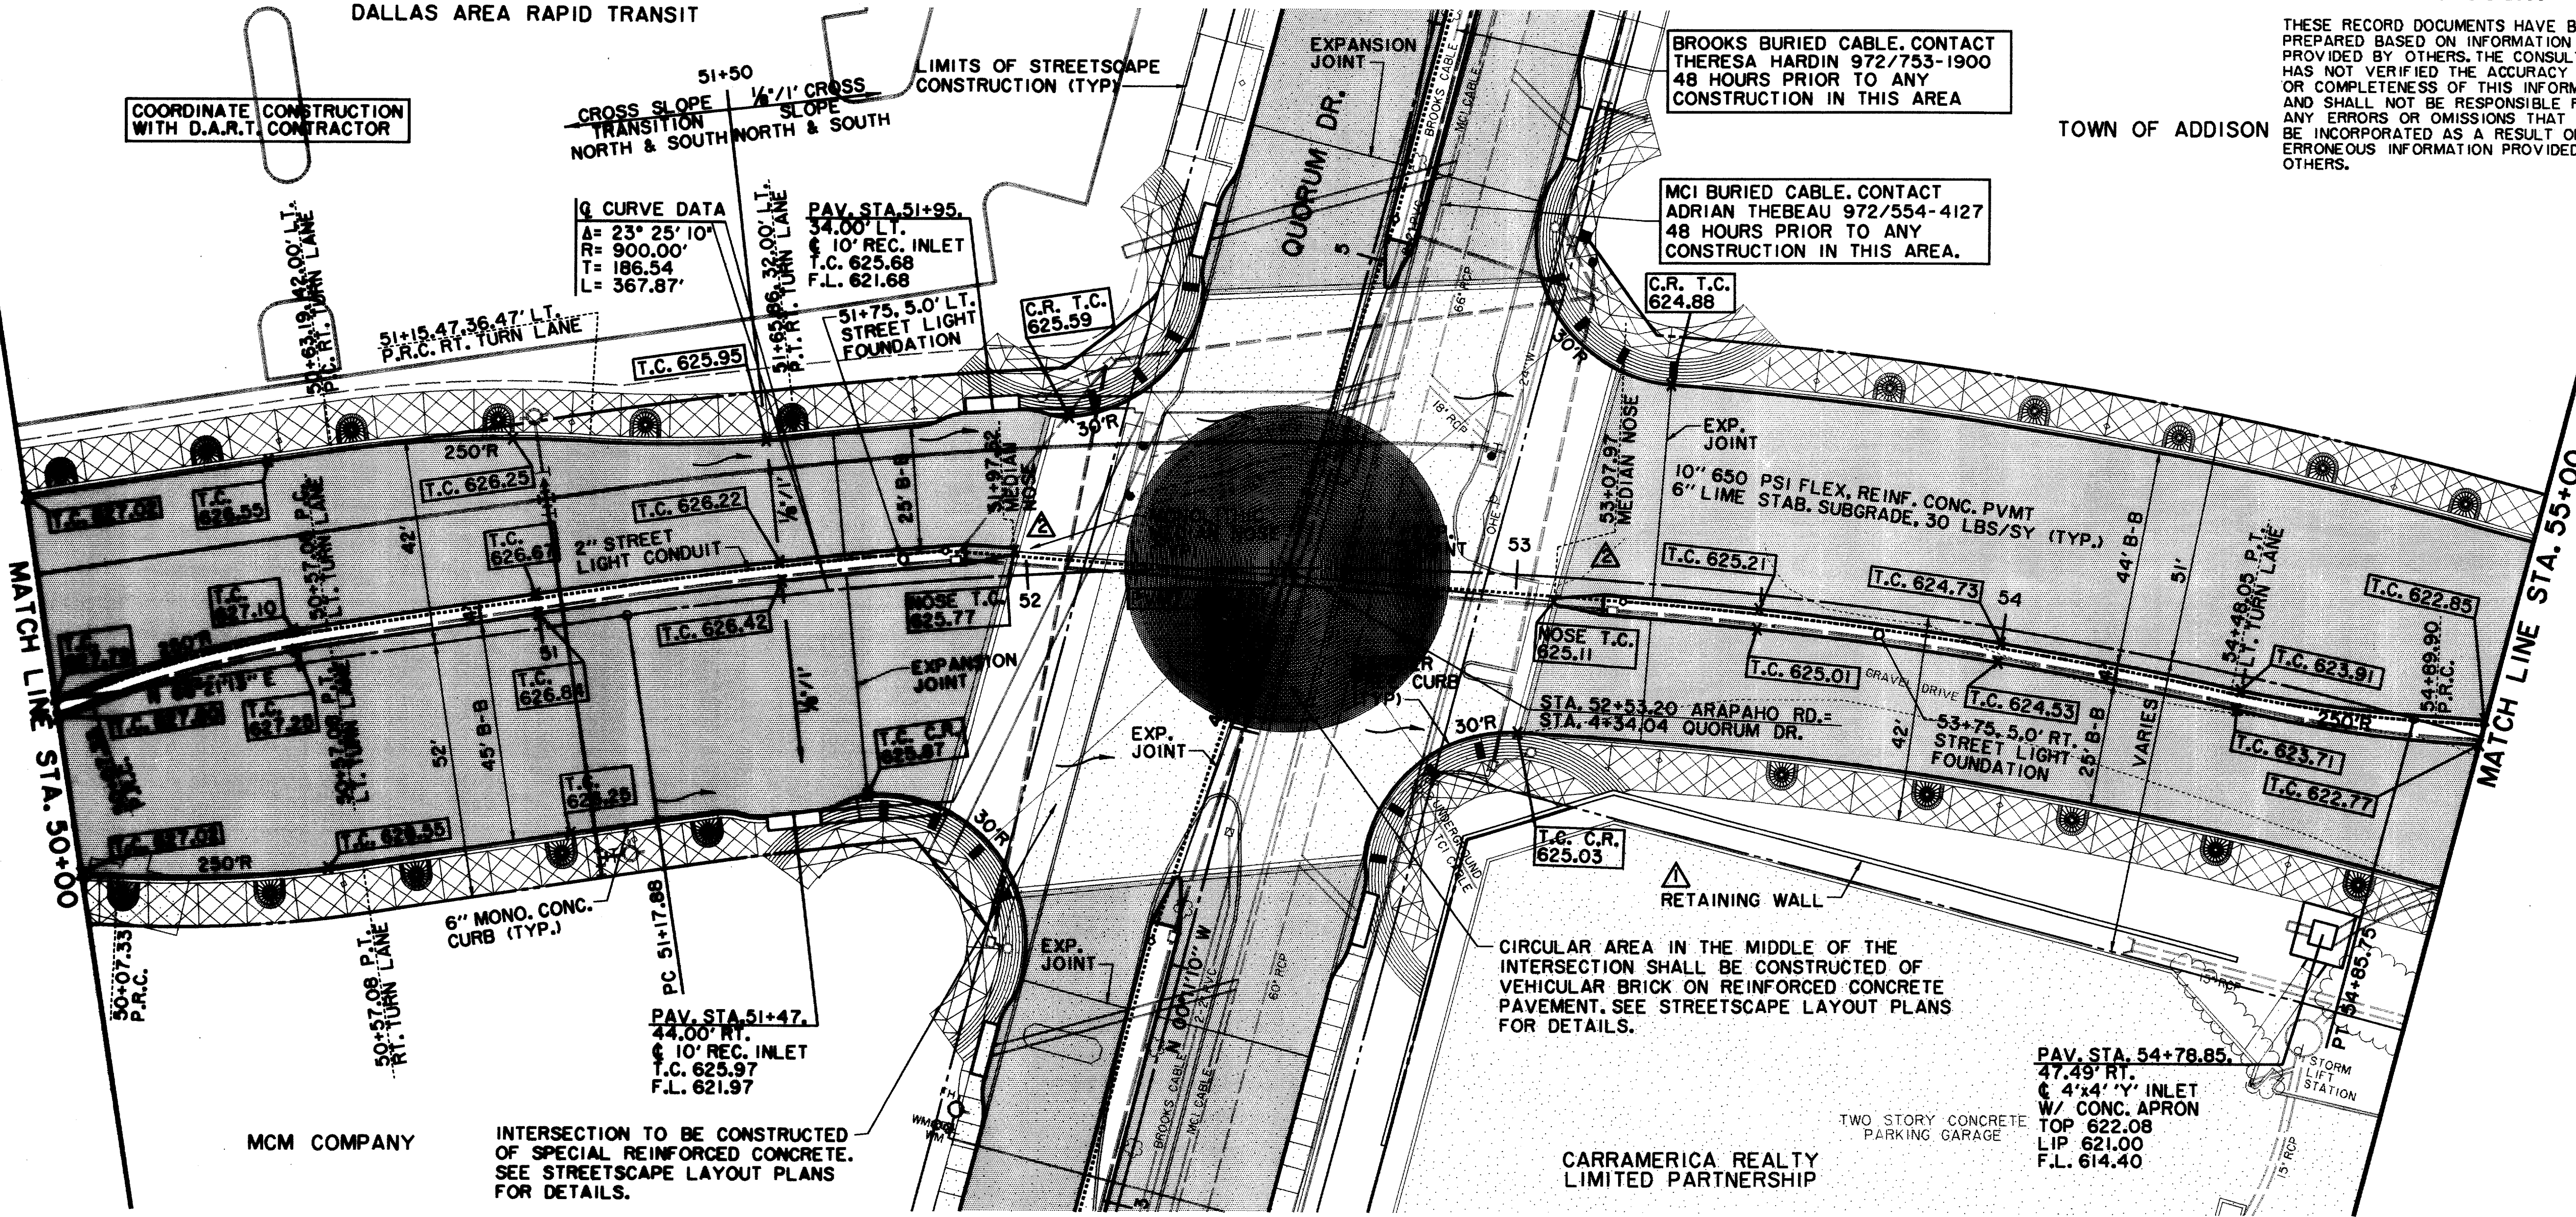


MCM COMPANY

INTERSECTION TO BE CONSTRUCTED OF SPECIAL REINFORCED CONCRETE. SEE STREETScape LAYOUT PLANS FOR DETAILS.

CARRAMERICA REALTY LIMITED PARTNERSHIP

TWO STORY CONCRETE PARKING GARAGE


PAV. STA. 54+78.85
47.49' RT.
4" x 4" INLET
W/ CONC. APRON
TOP 622.08
LIP 621.00
F.L. 614.40

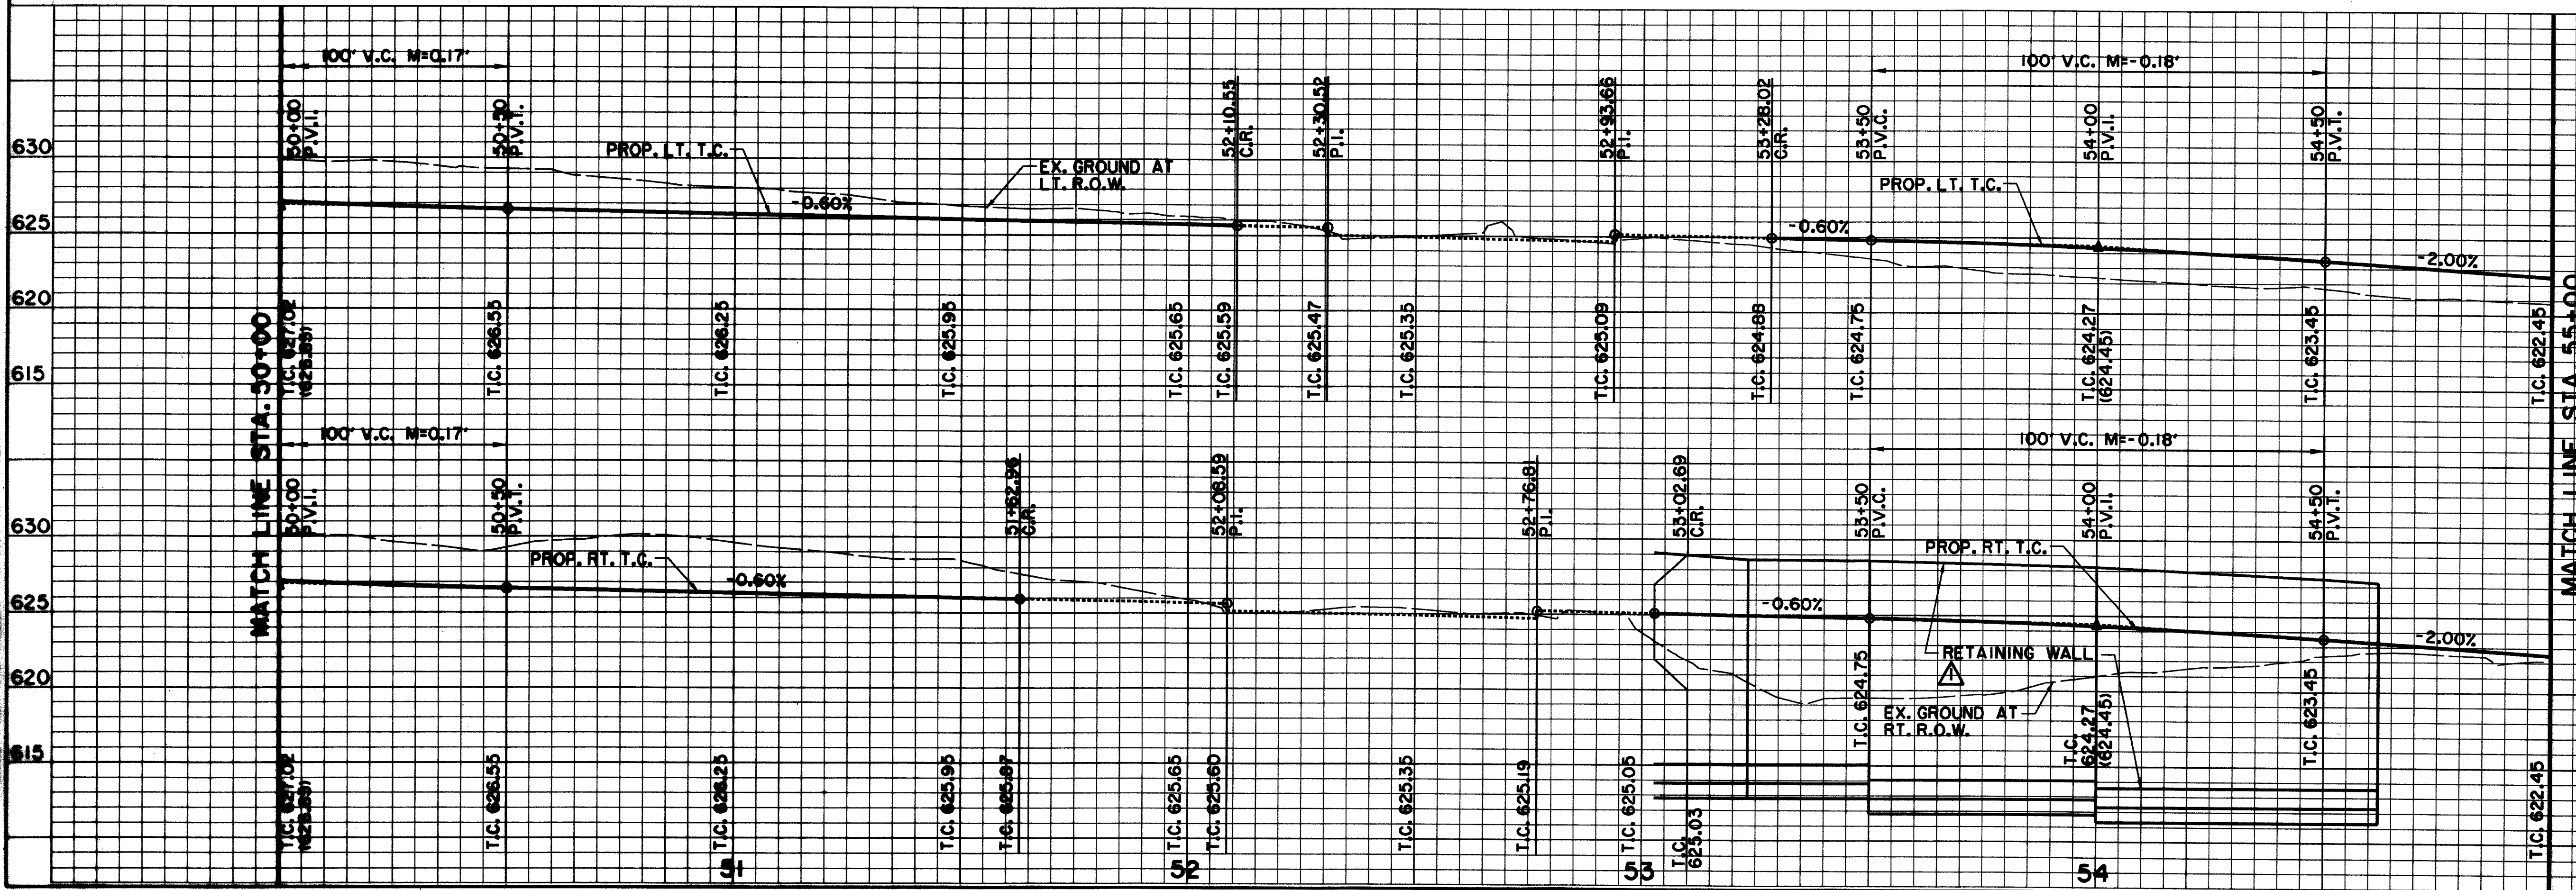

BENCHMARKS:
USC & GS E-921 DISK IN BRICK WALL OF OLD ADDISON SCHOOL HOUSE (MAGIC TIME MACHINE RESTAURANT) ON SOUTH WALL, 4' EAST OF CENTER OF THE ENTRANCE, 4.7' ABOVE THE GROUND. ELEV. 650.61

'I' ON SOUTHEAST CORNER OF CONCRETE WALK AT FRONT ENTRANCE TO 4805 ARAPAHO ROAD. ELEV. 630.61



THE SEAL APPEARING ON THIS DOCUMENT WAS AUTHORIZED BY KENNETH A. ROBERTS, P.E. 55446 ON OCTOBER 24, 1997

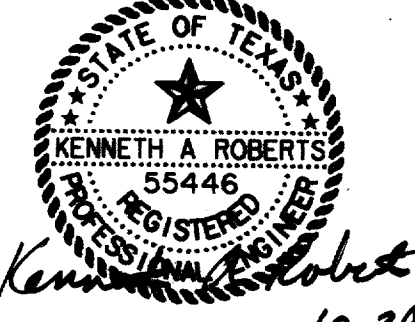

REVISED 1/16/98
ADDENDUM #4 12/12/97

<p>PAVING PLAN & PROFILE STA. 50+00 TO STA. 55+00 ARAPAHO ROAD ADDISON ROAD TO DALLAS NORTH TOLLWAY TOWN OF ADDISON, TEXAS Huitt-Zollars, Inc./Consulting Engineers Dallas, Fort Worth, Houston, Phoenix, Austin</p>					
DESIGN	DRAWN	APPR.	SCALE	DATE	PROJECT NO.
HZI	HZI	KAR	1/4" = 20' 1/8" = 6'	OCT 97	1772-01
					P-5

THESE RECORD DOCUMENTS HAVE BEEN PREPARED BASED ON INFORMATION PROVIDED BY OTHERS. THE CONSULTANT HAS NOT VERIFIED THE ACCURACY AND/OR COMPLETENESS OF THIS INFORMATION AND SHALL NOT BE RESPONSIBLE FOR ANY ERRORS OR OMISSIONS THAT MAY BE INCORPORATED AS A RESULT OF ERRONEOUS INFORMATION PROVIDED BY OTHERS.

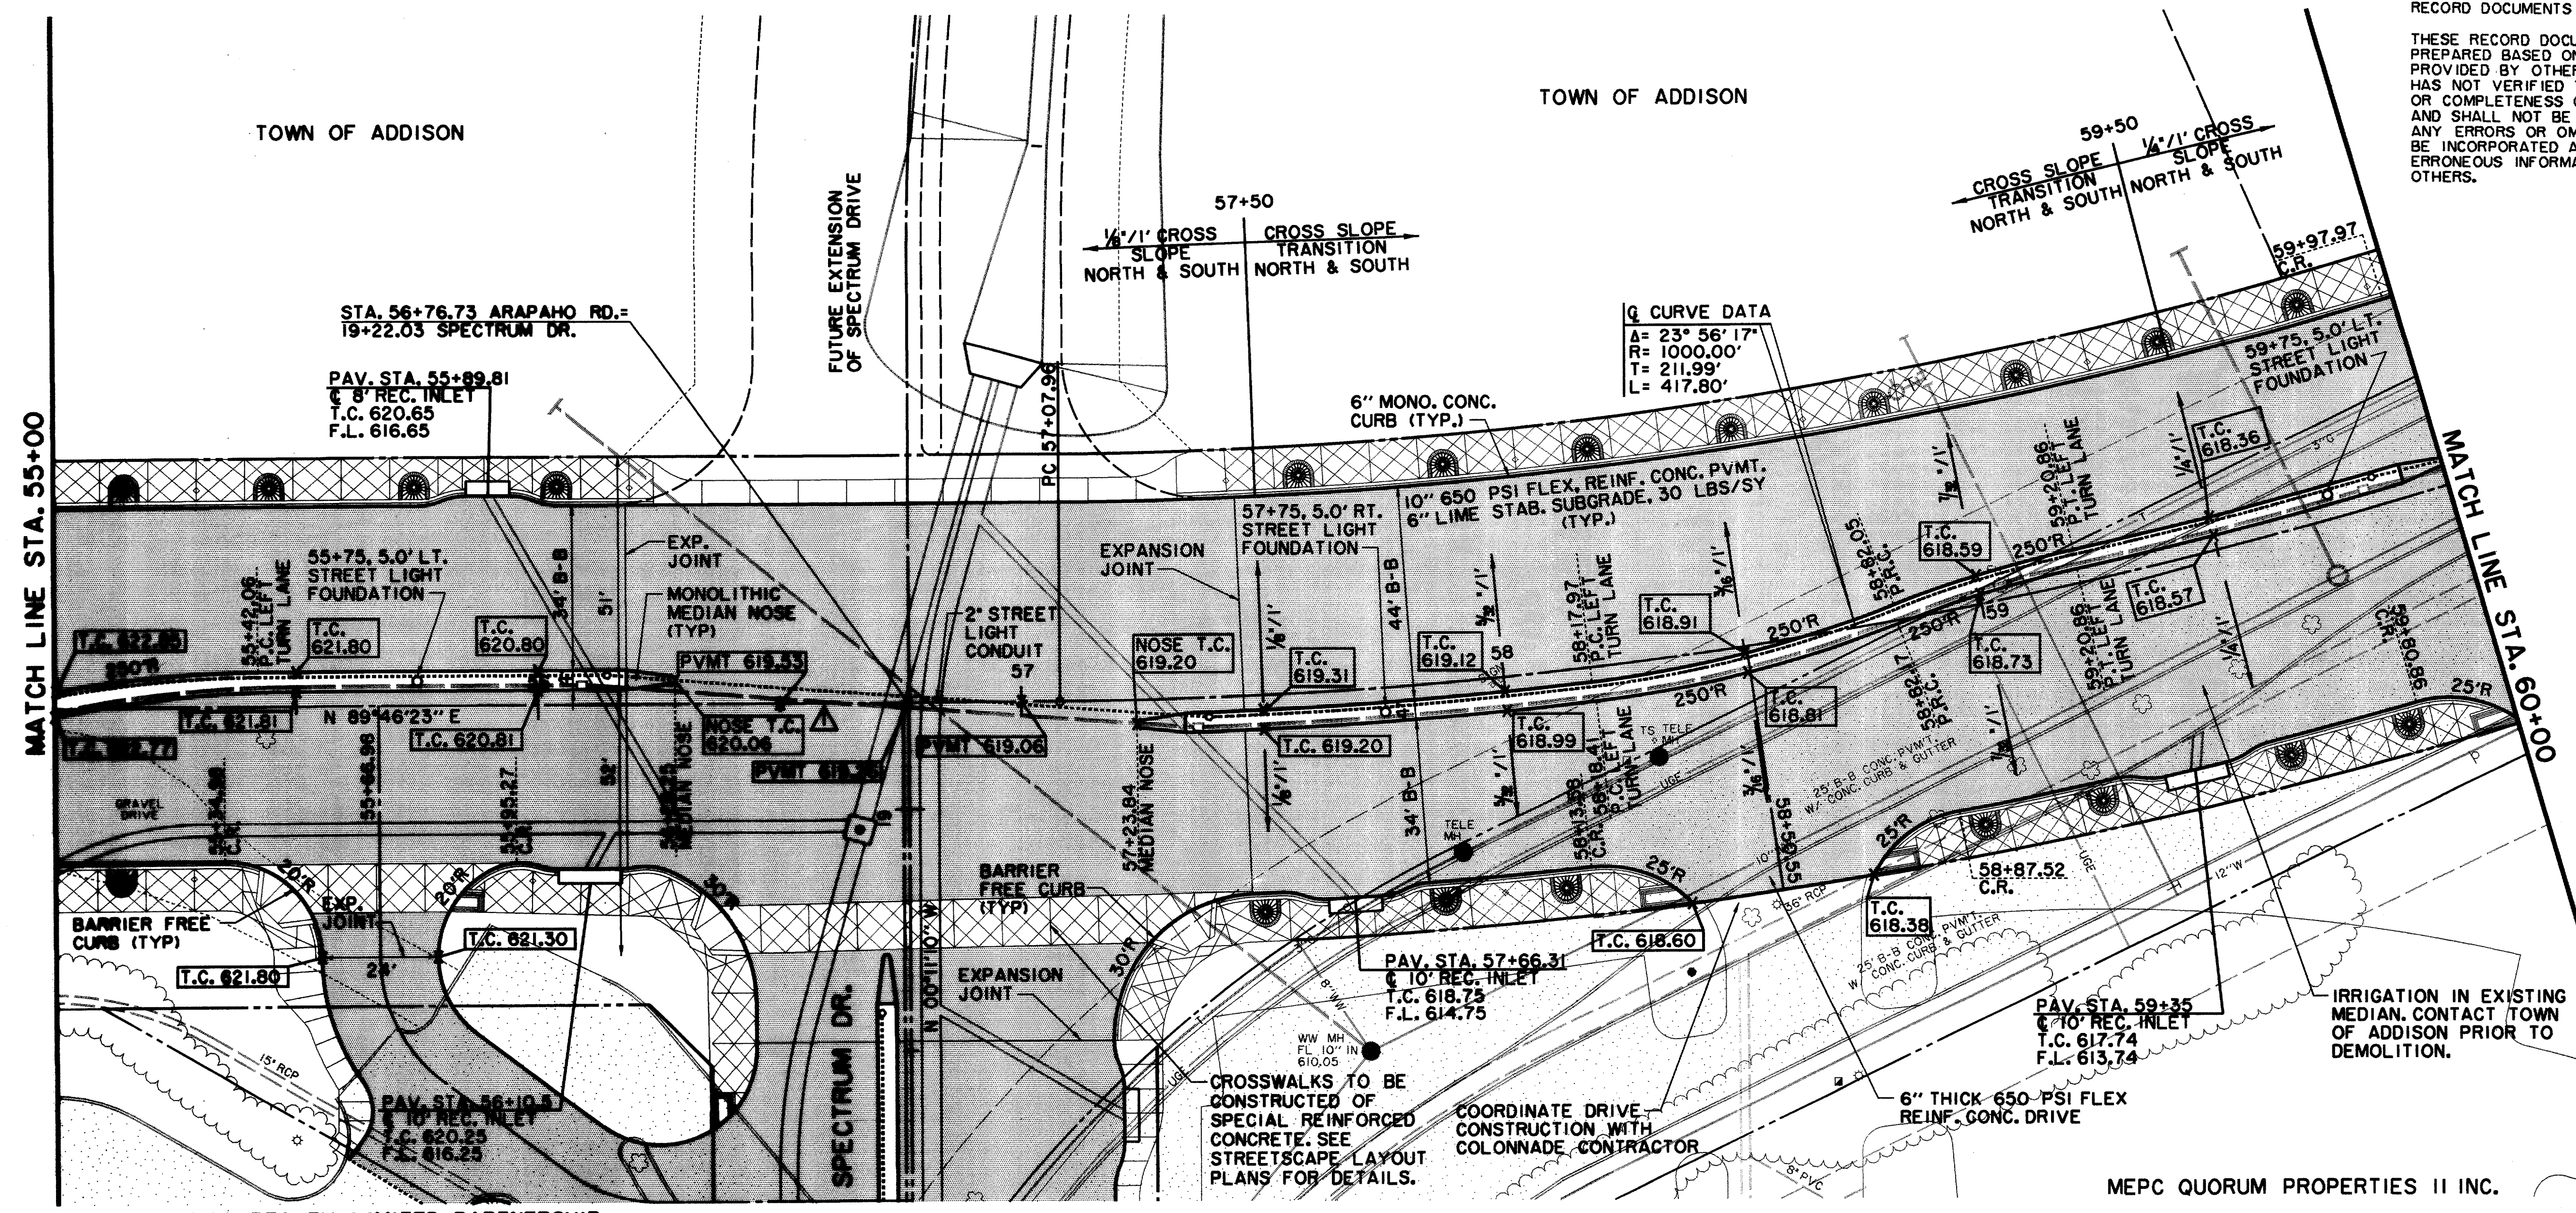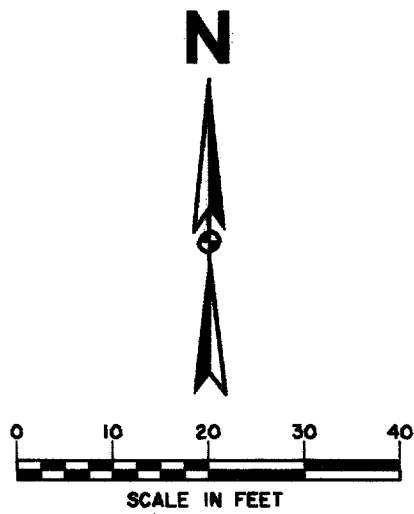

SEE STREETScape PLANS FOR SIDEWALK, LANDSCAPING, IRRIGATION, LIGHTING AND PAVEMENT ENHANCEMENT DETAILS.


NOTE:
EXISTING FILL MATERIAL TO DEPTHS OF 4-6 FEET, FROM APPROXIMATELY PAVING STATION 53+00 TO 56+00, CONSISTING OF BROKEN LIMESTONE AND MISCELLANEOUS DEBRIS SHALL BE EXCAVATED, REMOVED AND DISPOSED OF AND REPLACED WITH ON-SITE SOILS COMPACTED IN LIFTS AS DESCRIBED IN THE SPECIFICATIONS.

LEGEND

ELECTRIC — OHE —	WATER — W —
○ LIGHT POLE	FH ○ FIRE HYDRANT
pp ○ POWER POLE	WM ○ METER
— GUY WIRE	T WATER VALVE
TELEPHONE — T —	48" RCP
● TELEPHONE MANHOLE	X X X R.C.P. REMOVAL
□ TELEPHONE PEDESTAL	— CHAIN LINK FENCE
TS TELEPHONE SIGN	— WOOD FENCE
— GAS	— EXISTING ASPHALT
GM ○ GAS METER	— EXISTING DIRT OR GRAVEL
GS GAS SIGN	— EX. CONCRETE
LAND USE	○ TREE/TREE LINE
R,R RAILROAD SIGN	— EXISTING CURB
○ SIGN	— PROP. CURB
SURVEY	— EX. PROPERTY LINE
I,R FOUND IRON ROD	— PROP. CENTERLINE
□ TEMP BENCHMARK	— PROP. R.O.W.
— WASTEWATER	— PROP. INLET
WM ○ WASTEWATER MANHOLE	PVMT TOP OF PAVEMENT
CO CLEANOUT	T.C. TOP OF CURB
	C.R. CURB RETURN

CARRAMERICA REALTY LIMITED PARTNERSHIP


MEPC QUORUM PROPERTIES II INC.

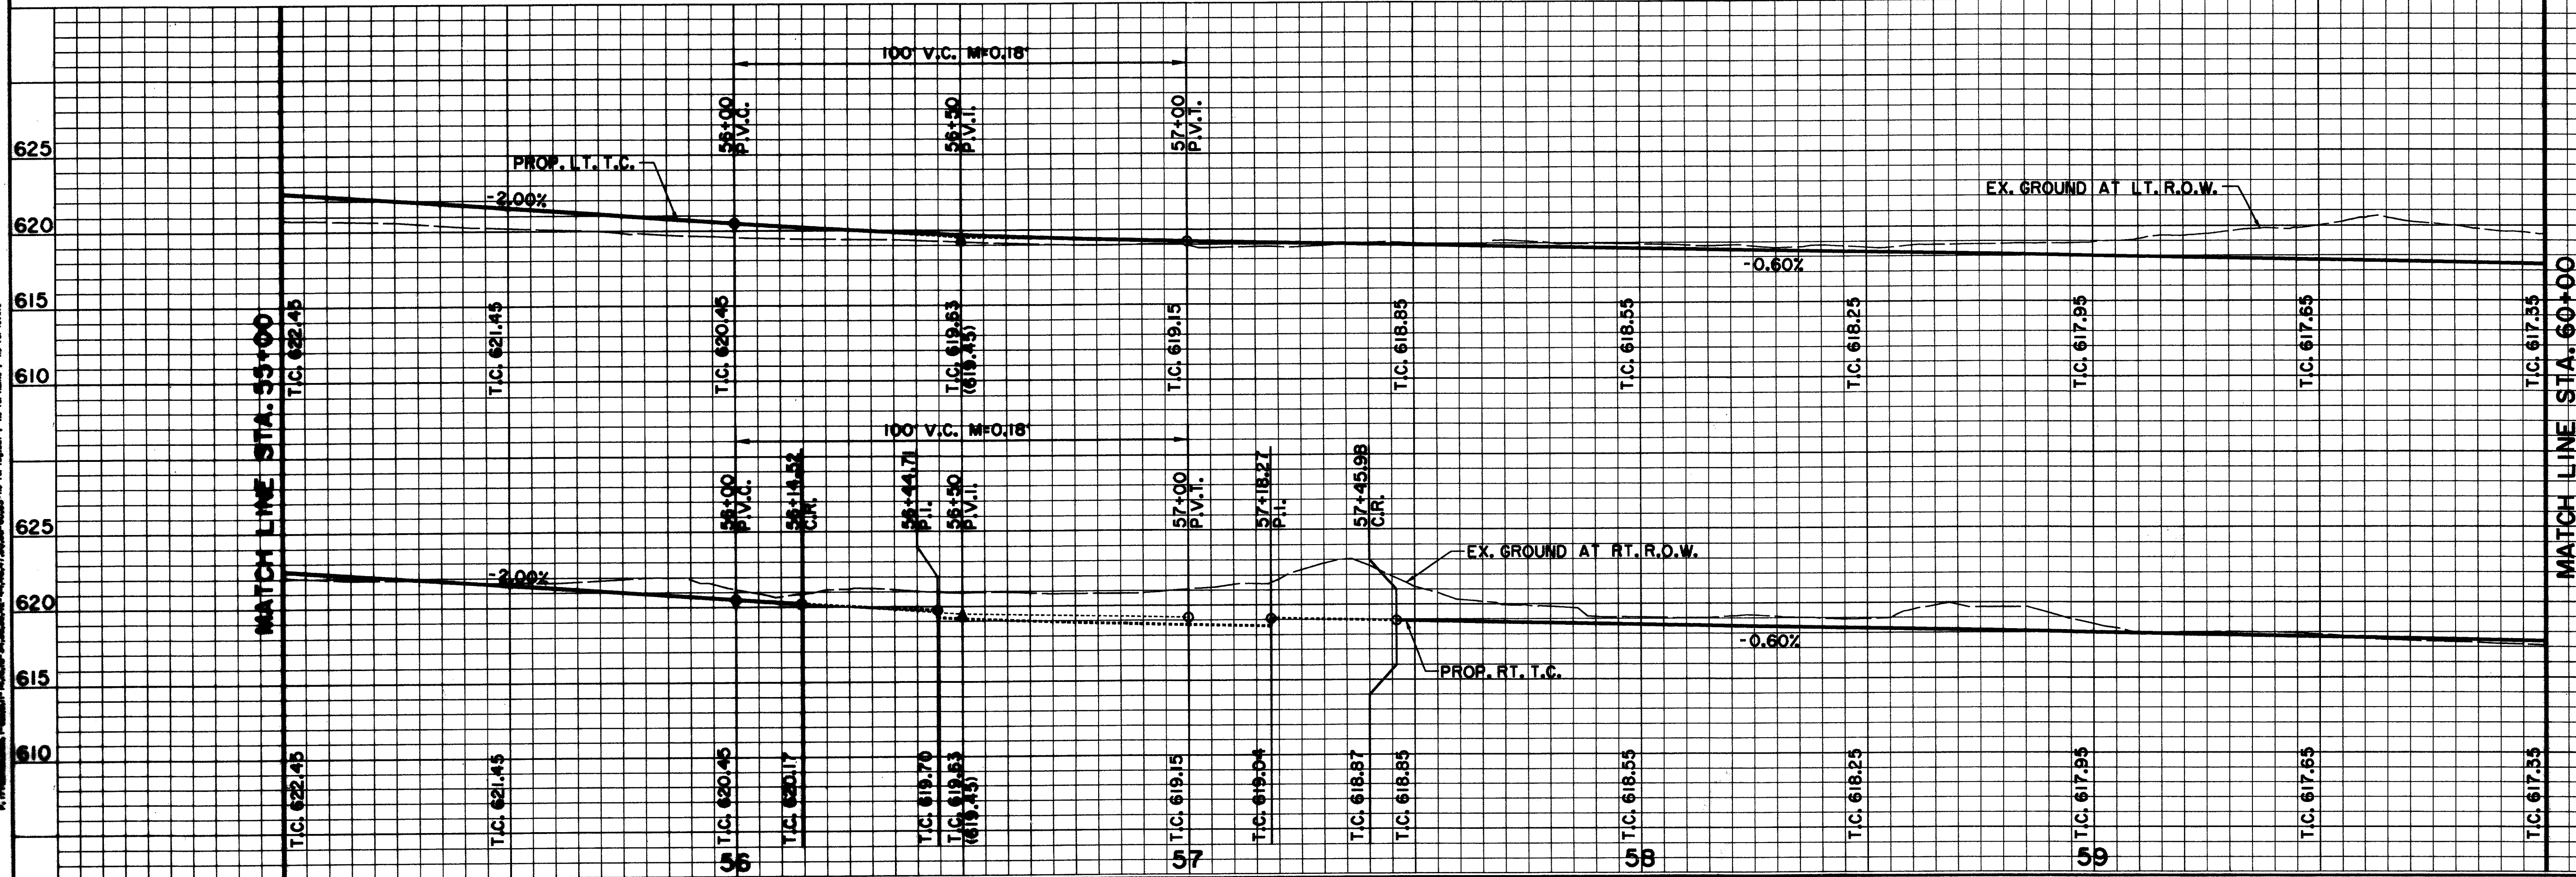

BENCHMARKS:
USC & GS E-921 DISK IN BRICK WALL OF OLD ADDISON SCHOOL HOUSE (MAGIC TIME MACHINE RESTAURANT) ON SOUTH WALL, 4' EAST OF CENTER OF THE ENTRANCE, 4.7' ABOVE THE GROUND. ELEV. 650.61

□ ON SOUTHEAST CORNER OF CONCRETE WALK AT FRONT ENTRANCE TO 4805 ARAPAHO ROAD. ELEV. 630.61



THE SEAL APPEARING ON THIS DOCUMENT WAS AUTHORIZED BY KENNETH A. ROBERTS, P.E. 55446 ON OCTOBER 24, 1997

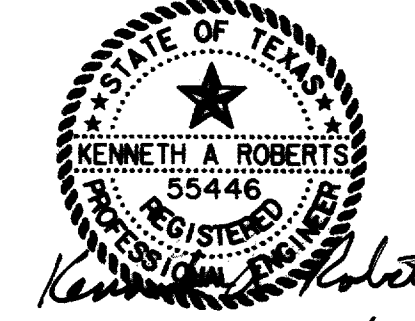

REVISOR 1/16/98

PAVING PLAN & PROFILE						
STA. 55+00 TO STA. 60+00						
ARAPAHO ROAD						
ADDISON ROAD TO DALLAS NORTH TOLLWAY						
TOWN OF ADDISON, TEXAS						
Huitt-Zollars, Inc./Consulting Engineers Dallas, Fort Worth, Houston, Phoenix, Austin						
DESIGN	DRAWN	APPR.	SCALE	DATE	PROJECT NO.	NO.
HZI	HZI	KAR	H ₁ 1"=20' V ₁ 1"=6'	OCT 97	1772-01	P-6

ALL DIMENSIONS UNLESS OTHERWISE NOTED ARE IN FEET AND DECIMALS THEREOF.
 ALL DIMENSIONS SHALL BE TO CENTERLINE UNLESS OTHERWISE NOTED.
 ALL DIMENSIONS SHALL BE TO FACE UNLESS OTHERWISE NOTED.
 ALL DIMENSIONS SHALL BE TO CENTERLINE UNLESS OTHERWISE NOTED.
 ALL DIMENSIONS SHALL BE TO FACE UNLESS OTHERWISE NOTED.
 ALL DIMENSIONS SHALL BE TO CENTERLINE UNLESS OTHERWISE NOTED.
 ALL DIMENSIONS SHALL BE TO FACE UNLESS OTHERWISE NOTED.

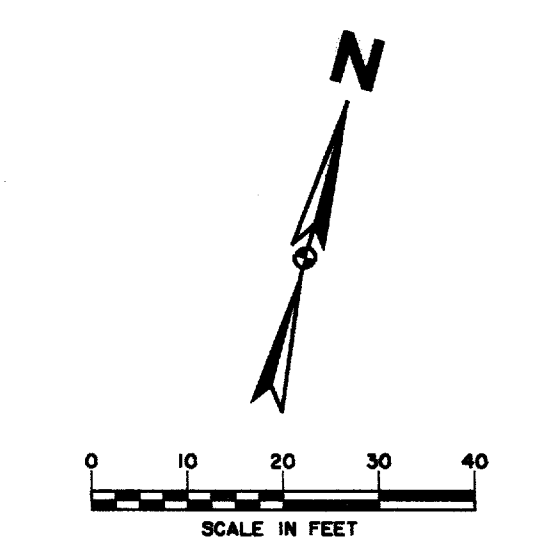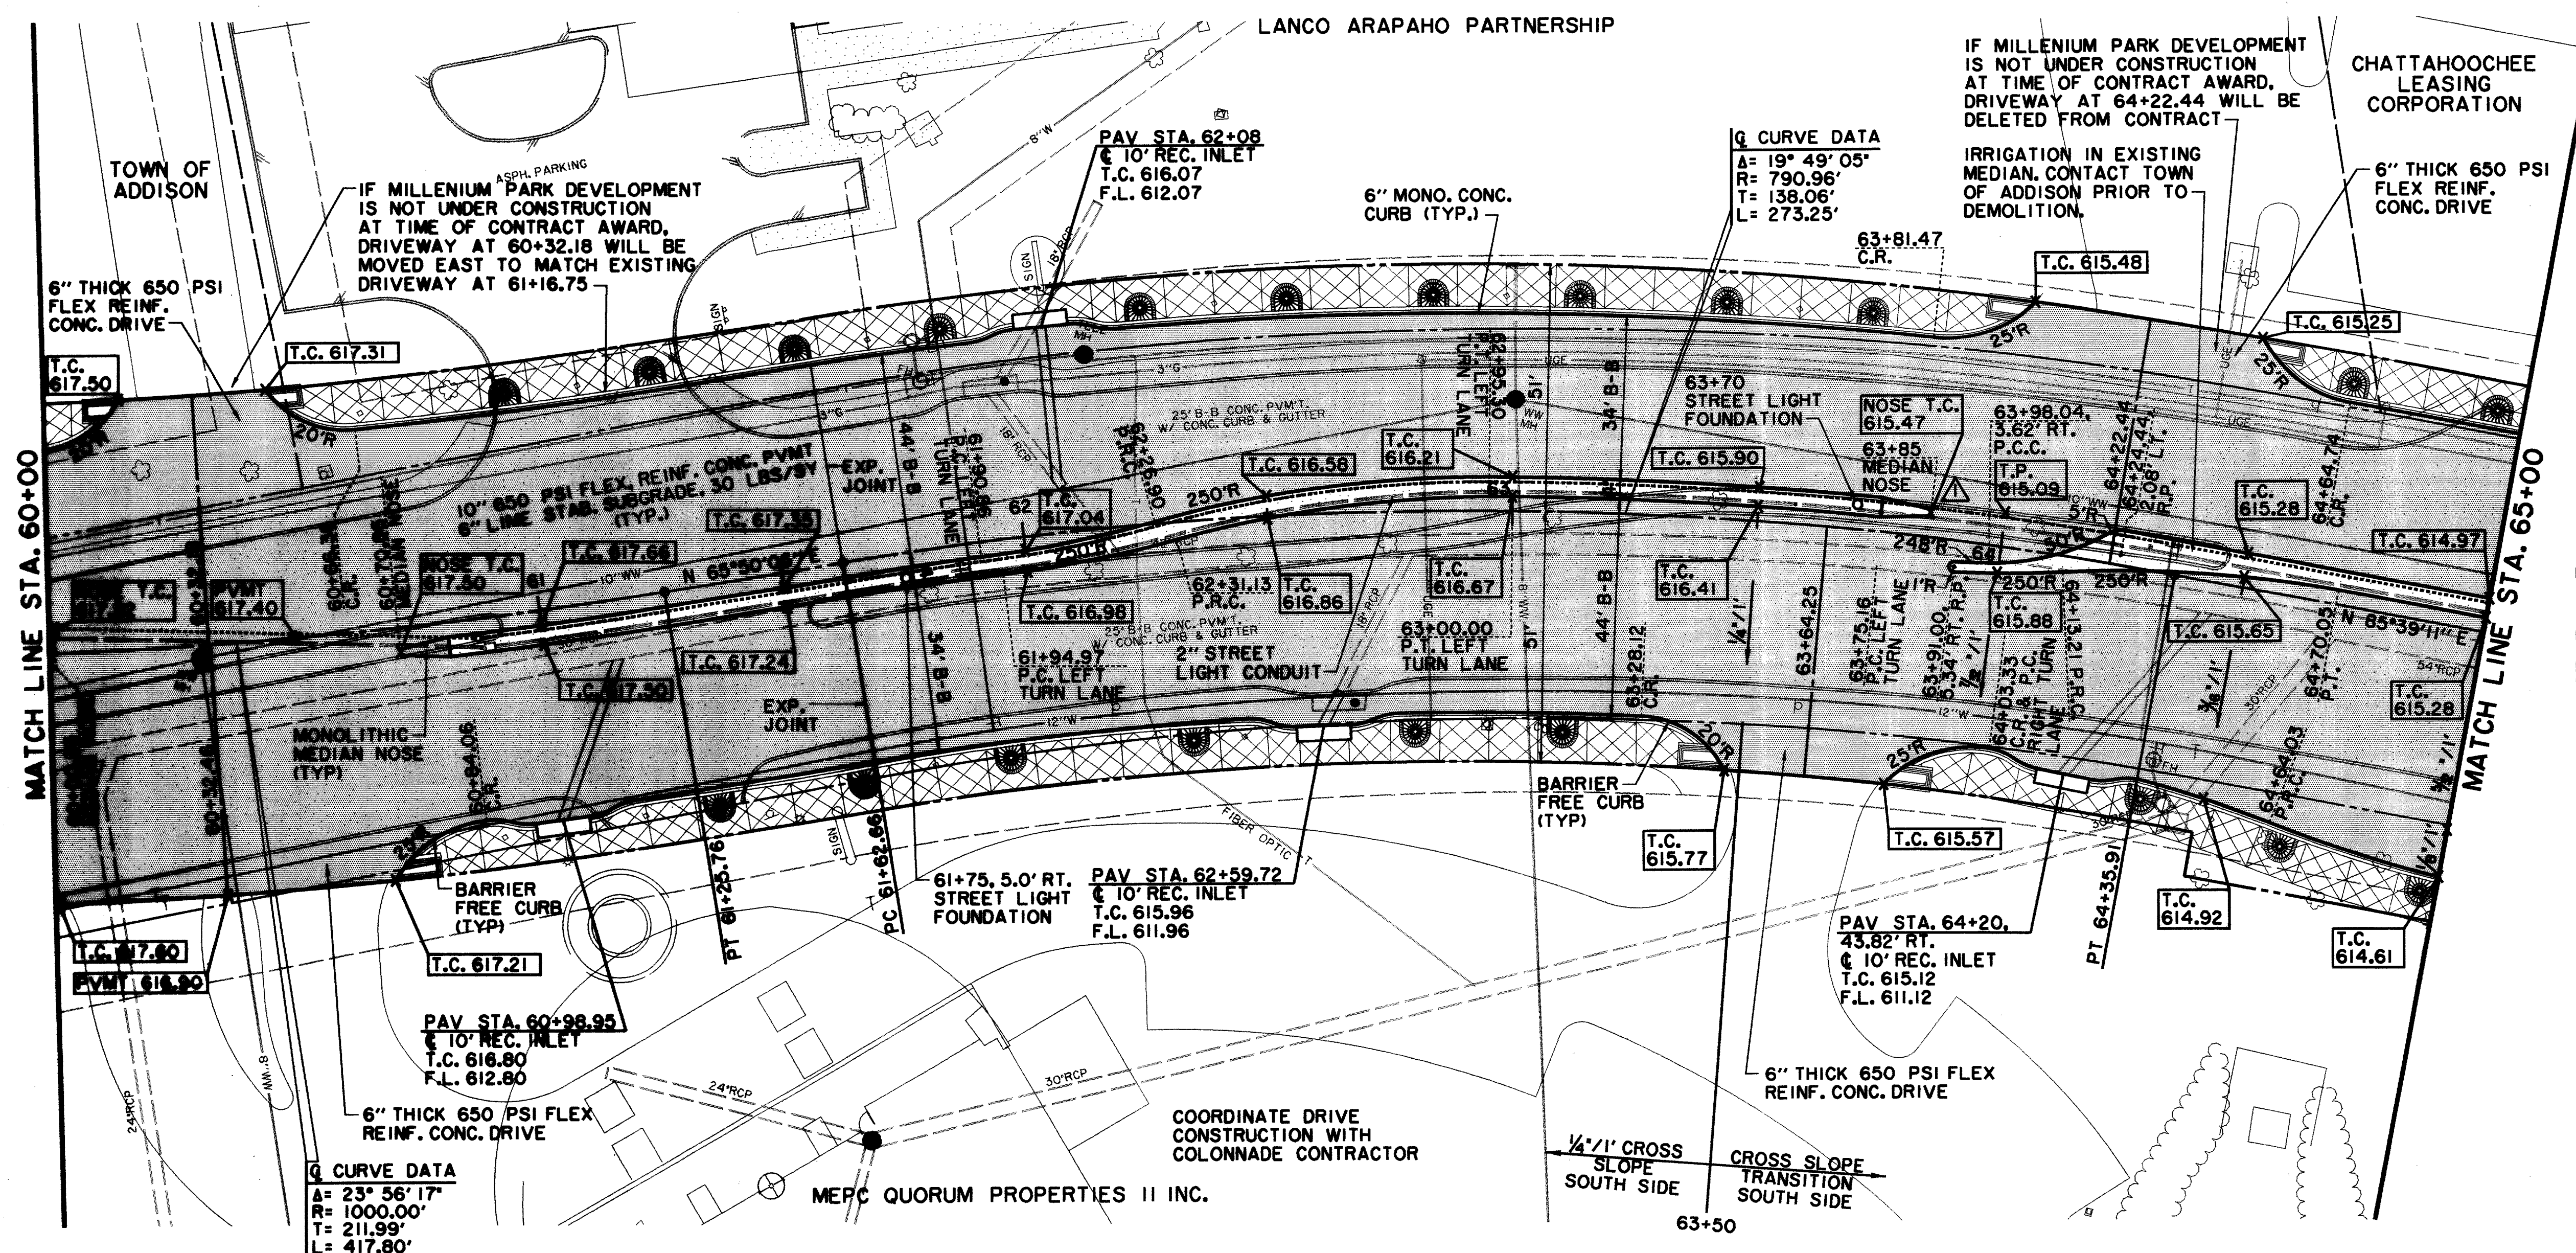


SEE STREETSCAPE PLANS FOR SIDEWALK, LANDSCAPING, IRRIGATION, LIGHTING AND PAVEMENT ENHANCEMENT DETAILS.

RECORD DOCUMENTS 6/9/2000
 THESE RECORD DOCUMENTS HAVE BEEN PREPARED BASED ON INFORMATION PROVIDED BY OTHERS. THE CONSULTANT HAS NOT VERIFIED THE ACCURACY AND/OR COMPLETENESS OF THIS INFORMATION AND SHALL NOT BE RESPONSIBLE FOR ANY ERRORS OR OMISSIONS THAT MAY BE INCORPORATED AS A RESULT OF ERRONEOUS INFORMATION PROVIDED BY OTHERS.

LEGEND


ELECTRIC — OHE	WATER — W
⊙ LIGHT POLE	FH FIRE HYDRANT
PP POWER POLE	WM METER
← GUY WIRE	T WATER VALVE
TELEPHONE — T	MISC.
TELEPHONE MANHOLE	48" RCP R.C.P. REMOVAL
TELEPHONE PEDESTAL	CHAIN LINK FENCE
TS TELEPHONE SIGN	WOOD FENCE
GAS — G	EXISTING ASPHALT
GAS METER	EXISTING DIRT OR GRAVEL
GAS SIGN	EX. CONCRETE
LAND USE	TREE/TREE LINE
R/R RAILROAD SIGN	EXISTING CURB
⊙ SIGN	PROP. CURB
SURVEY	EX. PROPERTY LINE
I.R. FOUND IRON ROD	PROP. CENTERLINE
⊙ SIGN BENCHMARK	PROP. R.O.W.
WASTEWATER — WW	PROP. INLET
WM WASTEWATER MANHOLE	PVMT TOP OF PAVEMENT
CO CLEANOUT	T.C. TOP OF CURB
	C.R. CURB RETURN

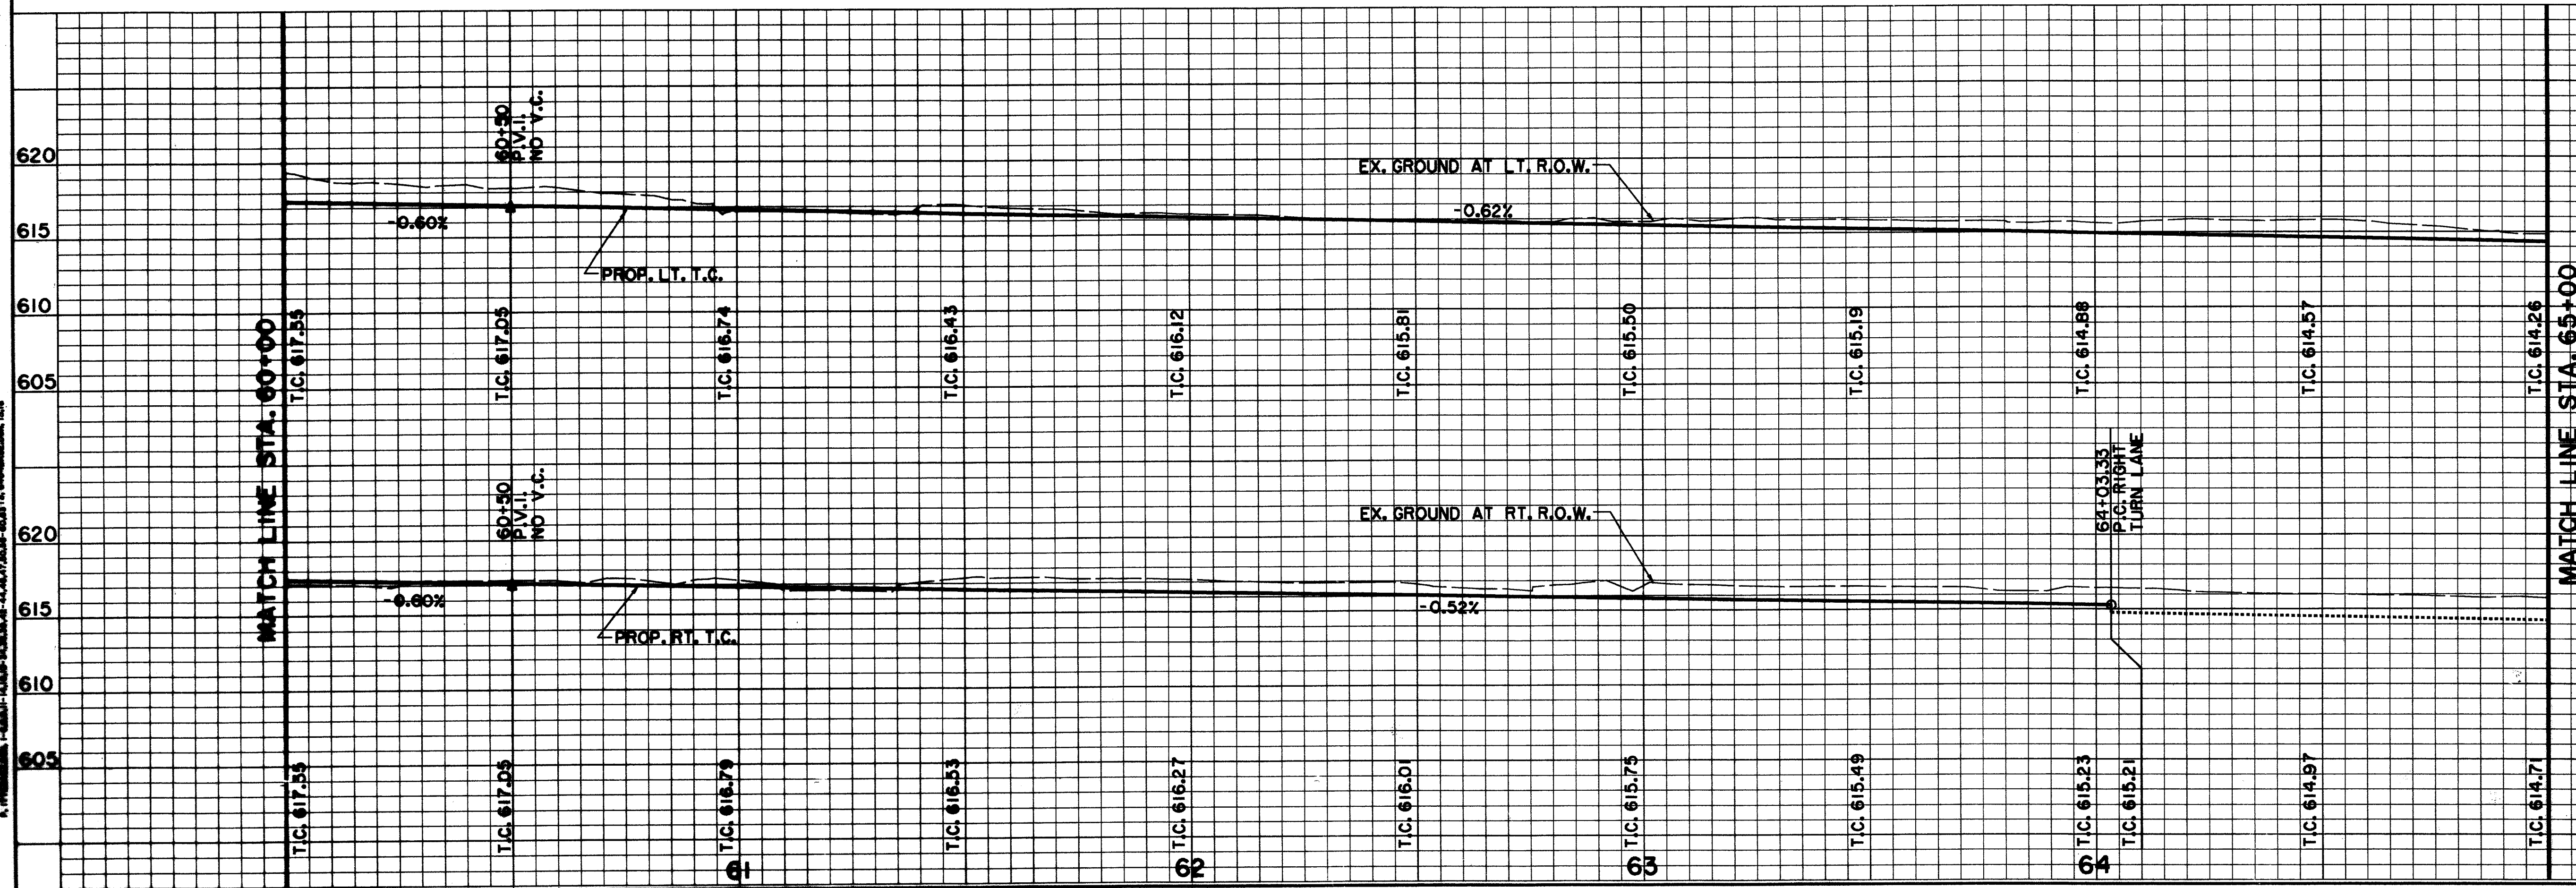

BENCHMARKS:
 USC & GS E-921 DISK IN BRICK WALL OF OLD ADDISON SCHOOL HOUSE (MAGIC TIME MACHINE RESTAURANT) ON SOUTH WALL, 4' EAST OF CENTER OF THE ENTRANCE, 4.7' ABOVE THE GROUND. ELEV. 650.61

"I" ON SOUTHEAST CORNER OF CONCRETE WALK AT FRONT ENTRANCE TO 4805 ARAPAHO ROAD. ELEV. 630.61




THE SEAL APPEARING ON THIS DOCUMENT WAS AUTHORIZED BY KENNETH A. ROBERTS, P.E. 55446 ON OCTOBER 24, 1997

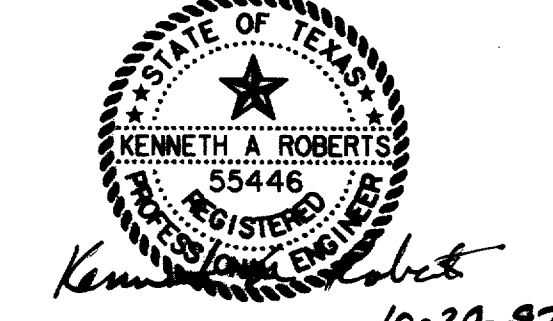

REVISED 3/15/98

PAVING PLAN & PROFILE						
STA. 60+00 TO STA. 65+00						
ARAPAHO ROAD						
ADDISON ROAD TO DALLAS NORTH TOLLWAY						
TOWN OF ADDISON, TEXAS						
Huitt-Zollars, Inc./Consulting Engineers Dallas, Fort Worth, Houston, Phoenix, Tustin						
DESIGN	DRAWN	APPR.	SCALE	DATE	PROJECT NO.	NO.
HZI	HZI	KAR	H _v 1"=20' V _h 1"=8'	OCT 97	1772-01	P-7

PROJECT NO. 1772-01
 SHEET NO. P-7
 DATE: 10/24/97
 DRAWN BY: HZI
 CHECKED BY: KAR
 APPROVED BY: KAR
 TITLE: PAVING PLAN & PROFILE

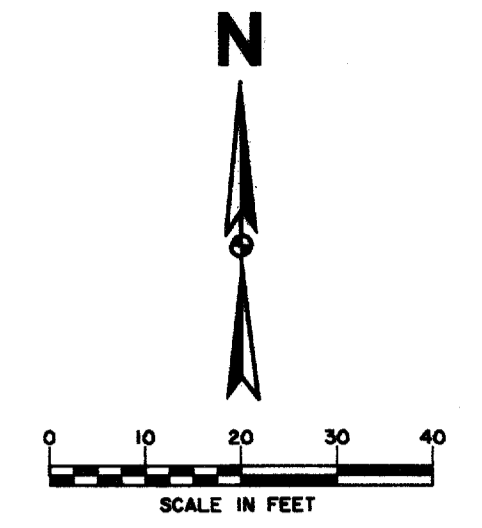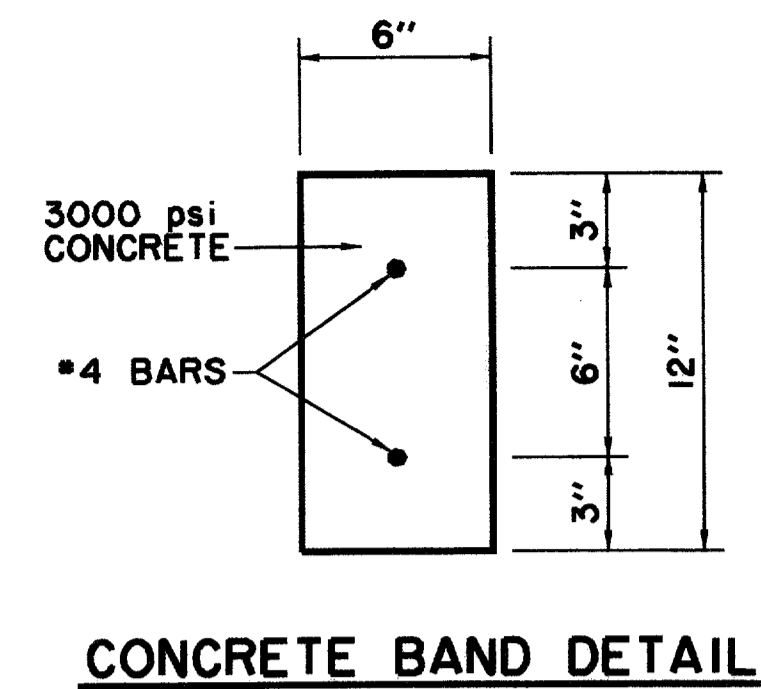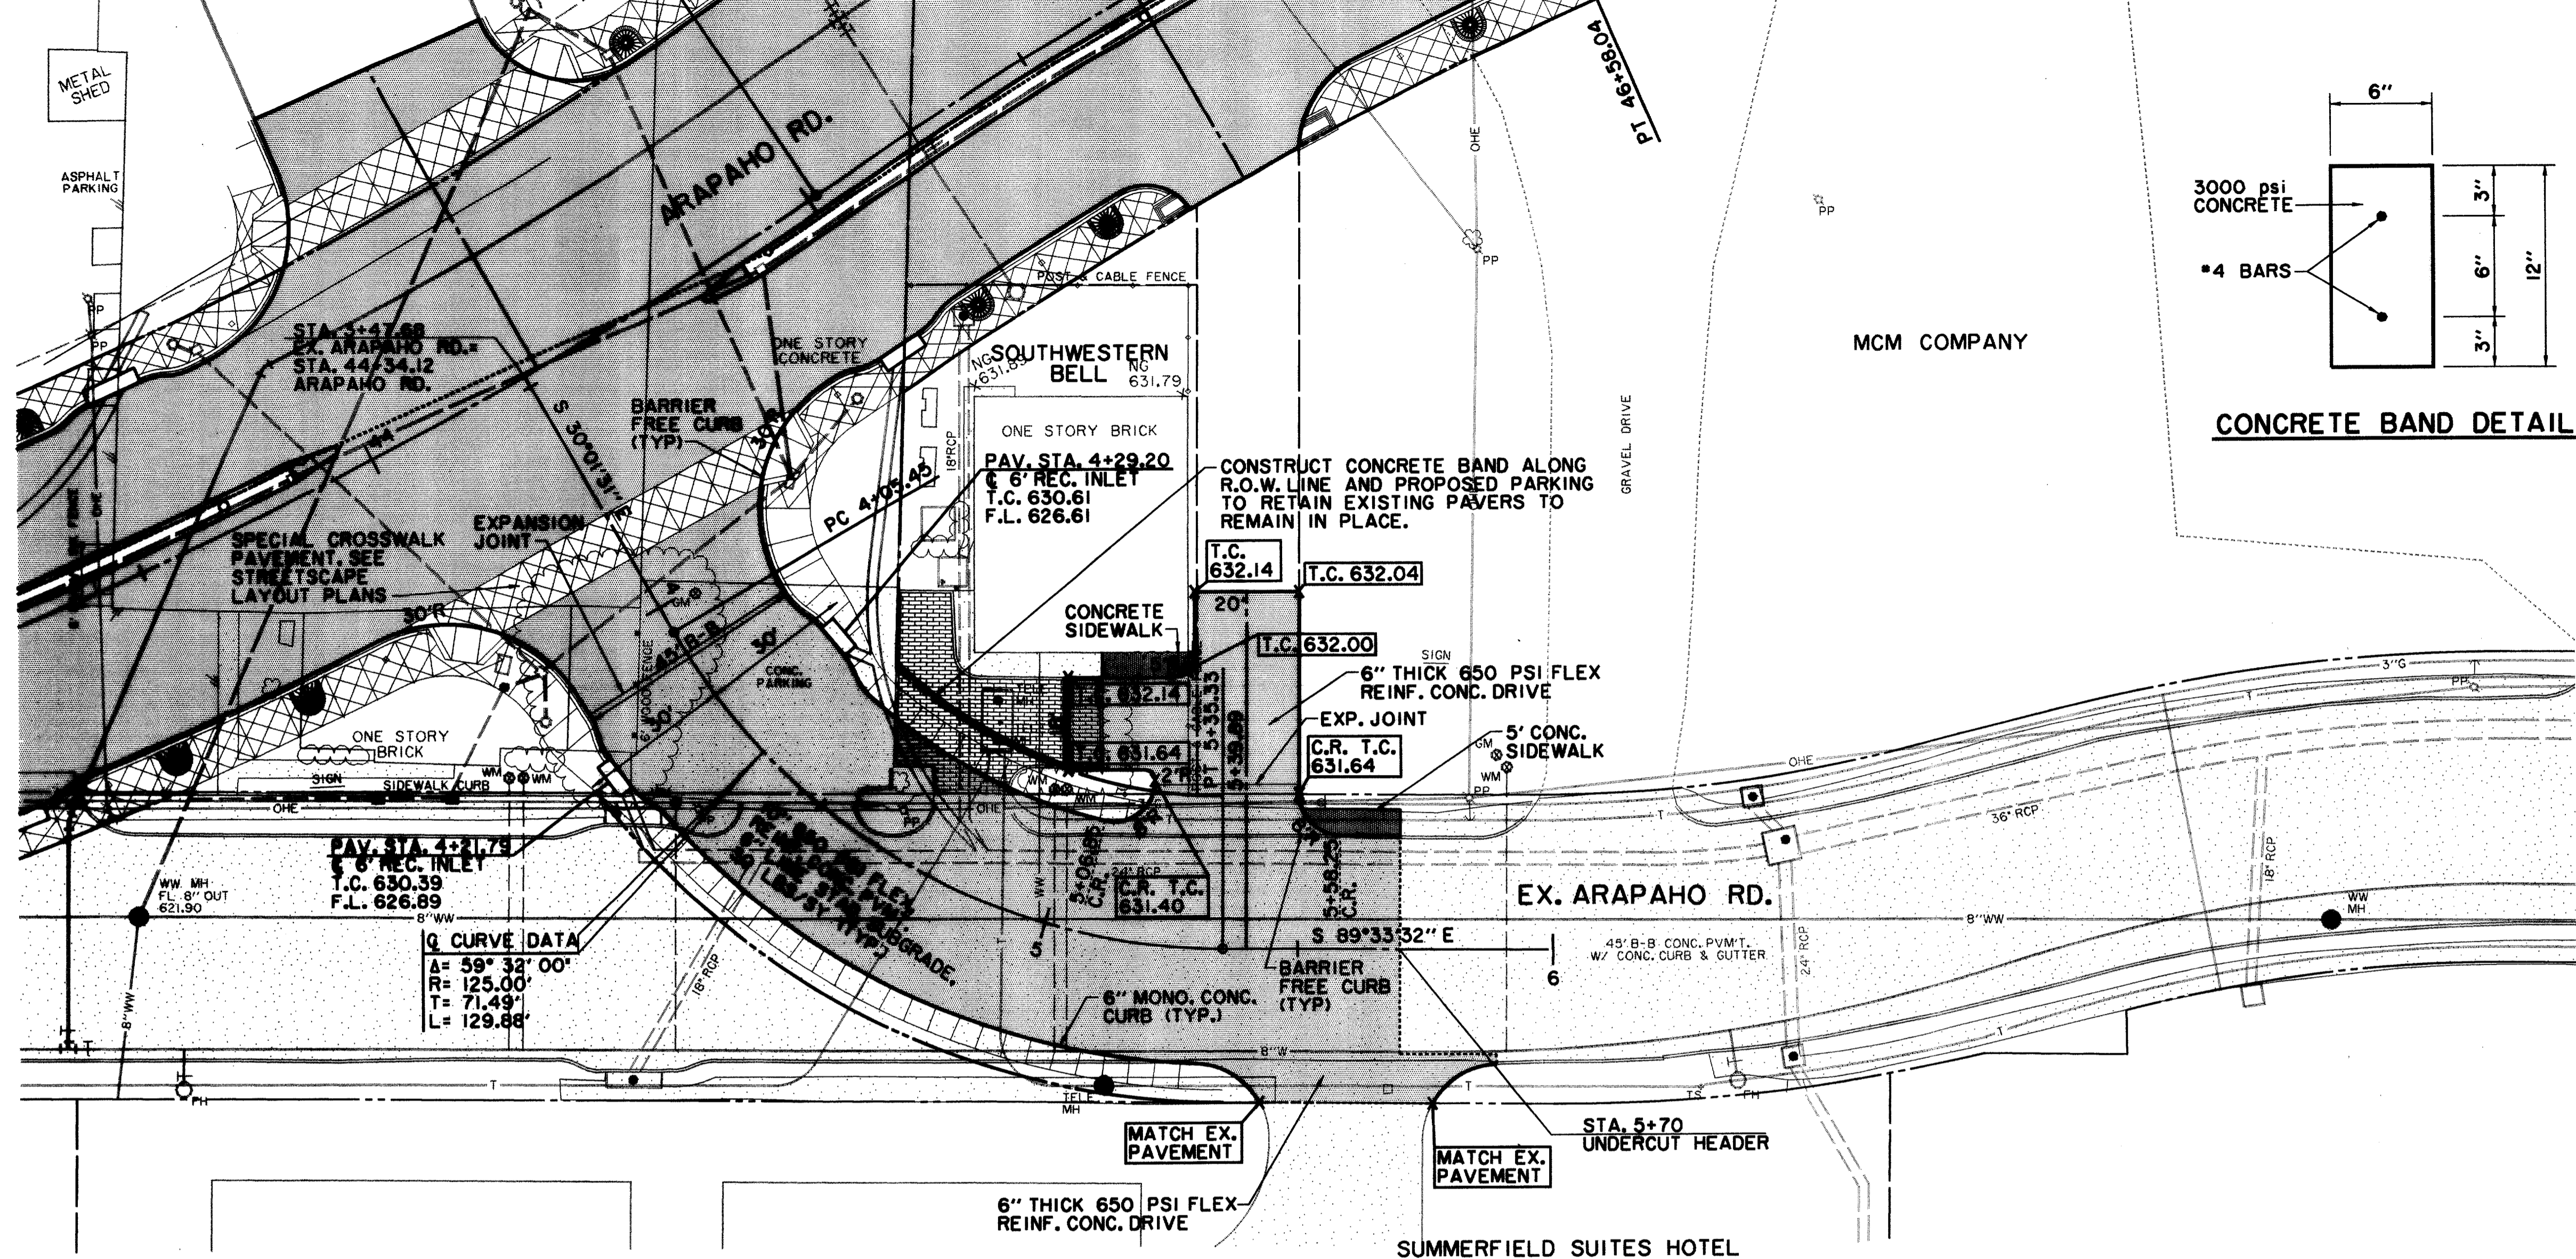


SEE STREETSCAPE PLANS FOR SIDEWALK, LANDSCAPING, IRRIGATION, LIGHTING AND PAVEMENT ENHANCEMENT DETAILS.

RECORD DOCUMENTS 6/9/2000

THESE RECORD DOCUMENTS HAVE BEEN PREPARED BASED ON INFORMATION PROVIDED BY OTHERS. THE CONSULTANT HAS NOT VERIFIED THE ACCURACY AND/OR COMPLETENESS OF THIS INFORMATION AND SHALL NOT BE RESPONSIBLE FOR ANY ERRORS OR OMISSIONS THAT MAY BE INCORPORATED AS A RESULT OF ERRONEOUS INFORMATION PROVIDED BY OTHERS.

LEGEND


ELECTRIC — OHE —	WATER — W —
○ LIGHT POLE	FH ○ FIRE HYDRANT
PP □ POWER POLE	WM ⊕ METER
← GUY WIRE	T WATER VALVE
TELEPHONE — T —	48" RCP
● TELEPHONE MANHOLE	X X X R.C.P. REMOVAL
□ TELEPHONE PEDESTAL	— CHAIN LINK FENCE
TS TELEPHONE SIGN	— WOOD FENCE
GAS — G —	— EXISTING ASPHALT
GM ⊕ GAS METER	— EXISTING DIRT OR GRAVEL
GS ⊕ GAS SIGN	— EX. CONCRETE
LAND USE	— TREE/TREE LINE
R.R. RAILROAD SIGN	— EXISTING CURB
□ SIGN	— PROP. CURB
SURVEY	— EX. PROPERTY LINE
I.R. FOUND IRON ROD	— PROP. CENTERLINE
□ TEMP BENCHMARK	— PROP. R.O.W.
WASTEWATER — WW —	— PROP. INLET
WM ⊕ WASTEWATER MANHOLE	PVMT TOP OF PAVEMENT
CO ⊕ CLEANOUT	T.C. TOP OF CURB
	C.R. CURB RETURN

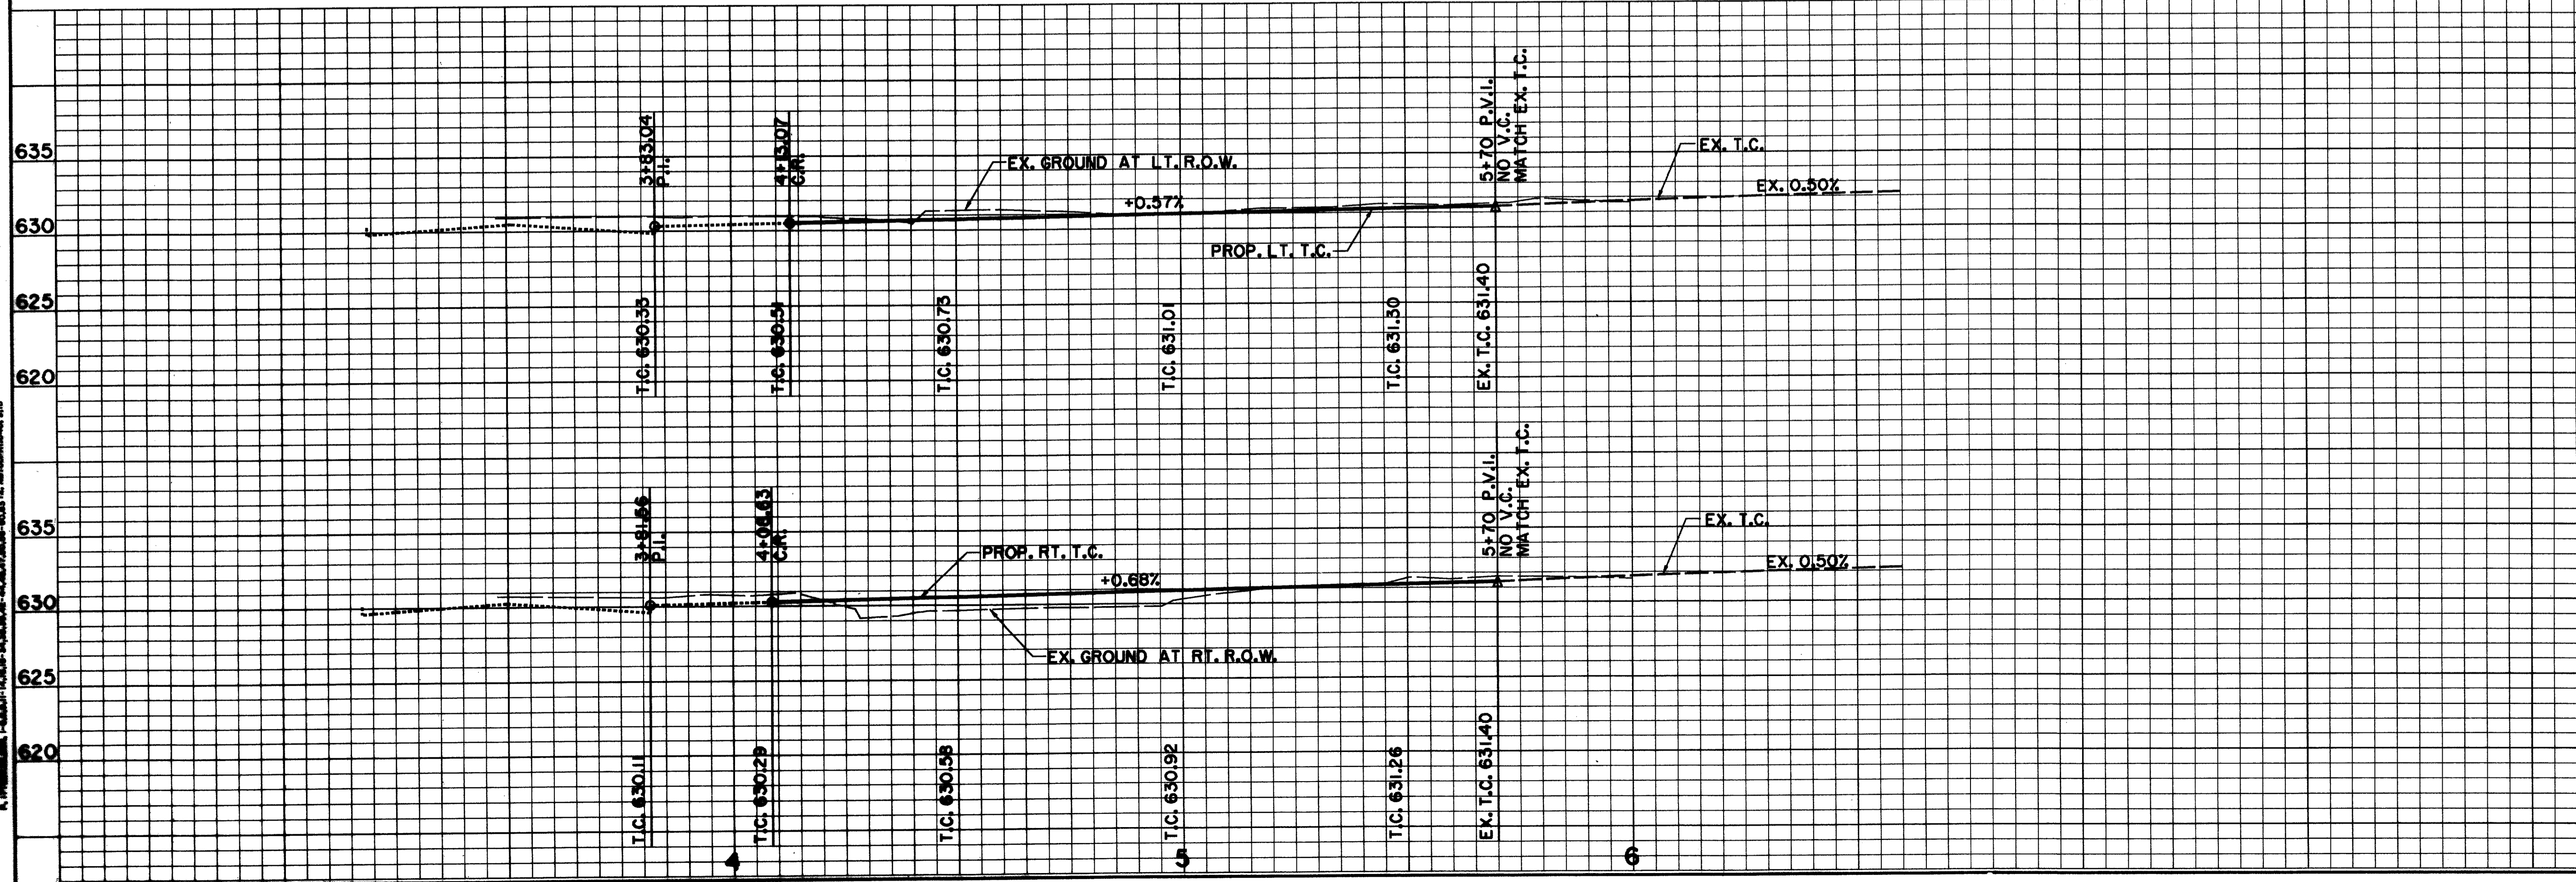



BENCHMARKS:
 USC & GS E-921 DISK IN BRICK WALL OF OLD ADDISON SCHOOL HOUSE (MAGIC TIME MACHINE RESTAURANT) ON SOUTH WALL, 4' EAST OF CENTER OF THE ENTRANCE, 4.7' ABOVE THE GROUND, ELEV. 650.61

□ ON SOUTHEAST CORNER OF CONCRETE WALK AT FRONT ENTRANCE TO 4805 ARAPAHO ROAD, ELEV. 630.61

THE SEAL APPEARING ON THIS DOCUMENT WAS AUTHORIZED BY KENNETH A. ROBERTS, P.E. 55446 ON OCTOBER 24, 1997

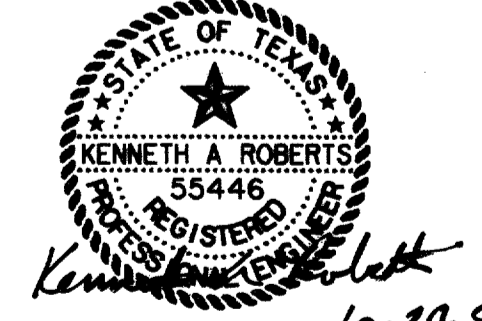

PAVING PLAN & PROFILE						
EX. ARAPAHO STA. 3+47.68 TO STA. 5+70						
ARAPAHO ROAD						
ADDISON ROAD TO DALLAS NORTH TOLLWAY						
TOWN OF ADDISON, TEXAS						
Huitt-Zollars, Inc./Consulting Engineers Dallas, Fort Worth, Houston, Phoenix, Austin						
DESIGN	DRAWN	APPR.	SCALE	DATE	PROJECT NO.	NO.
HZI	HZI	KAR	1/4"=20' 1/8"=8'	OCT 97	1772-01	P-9

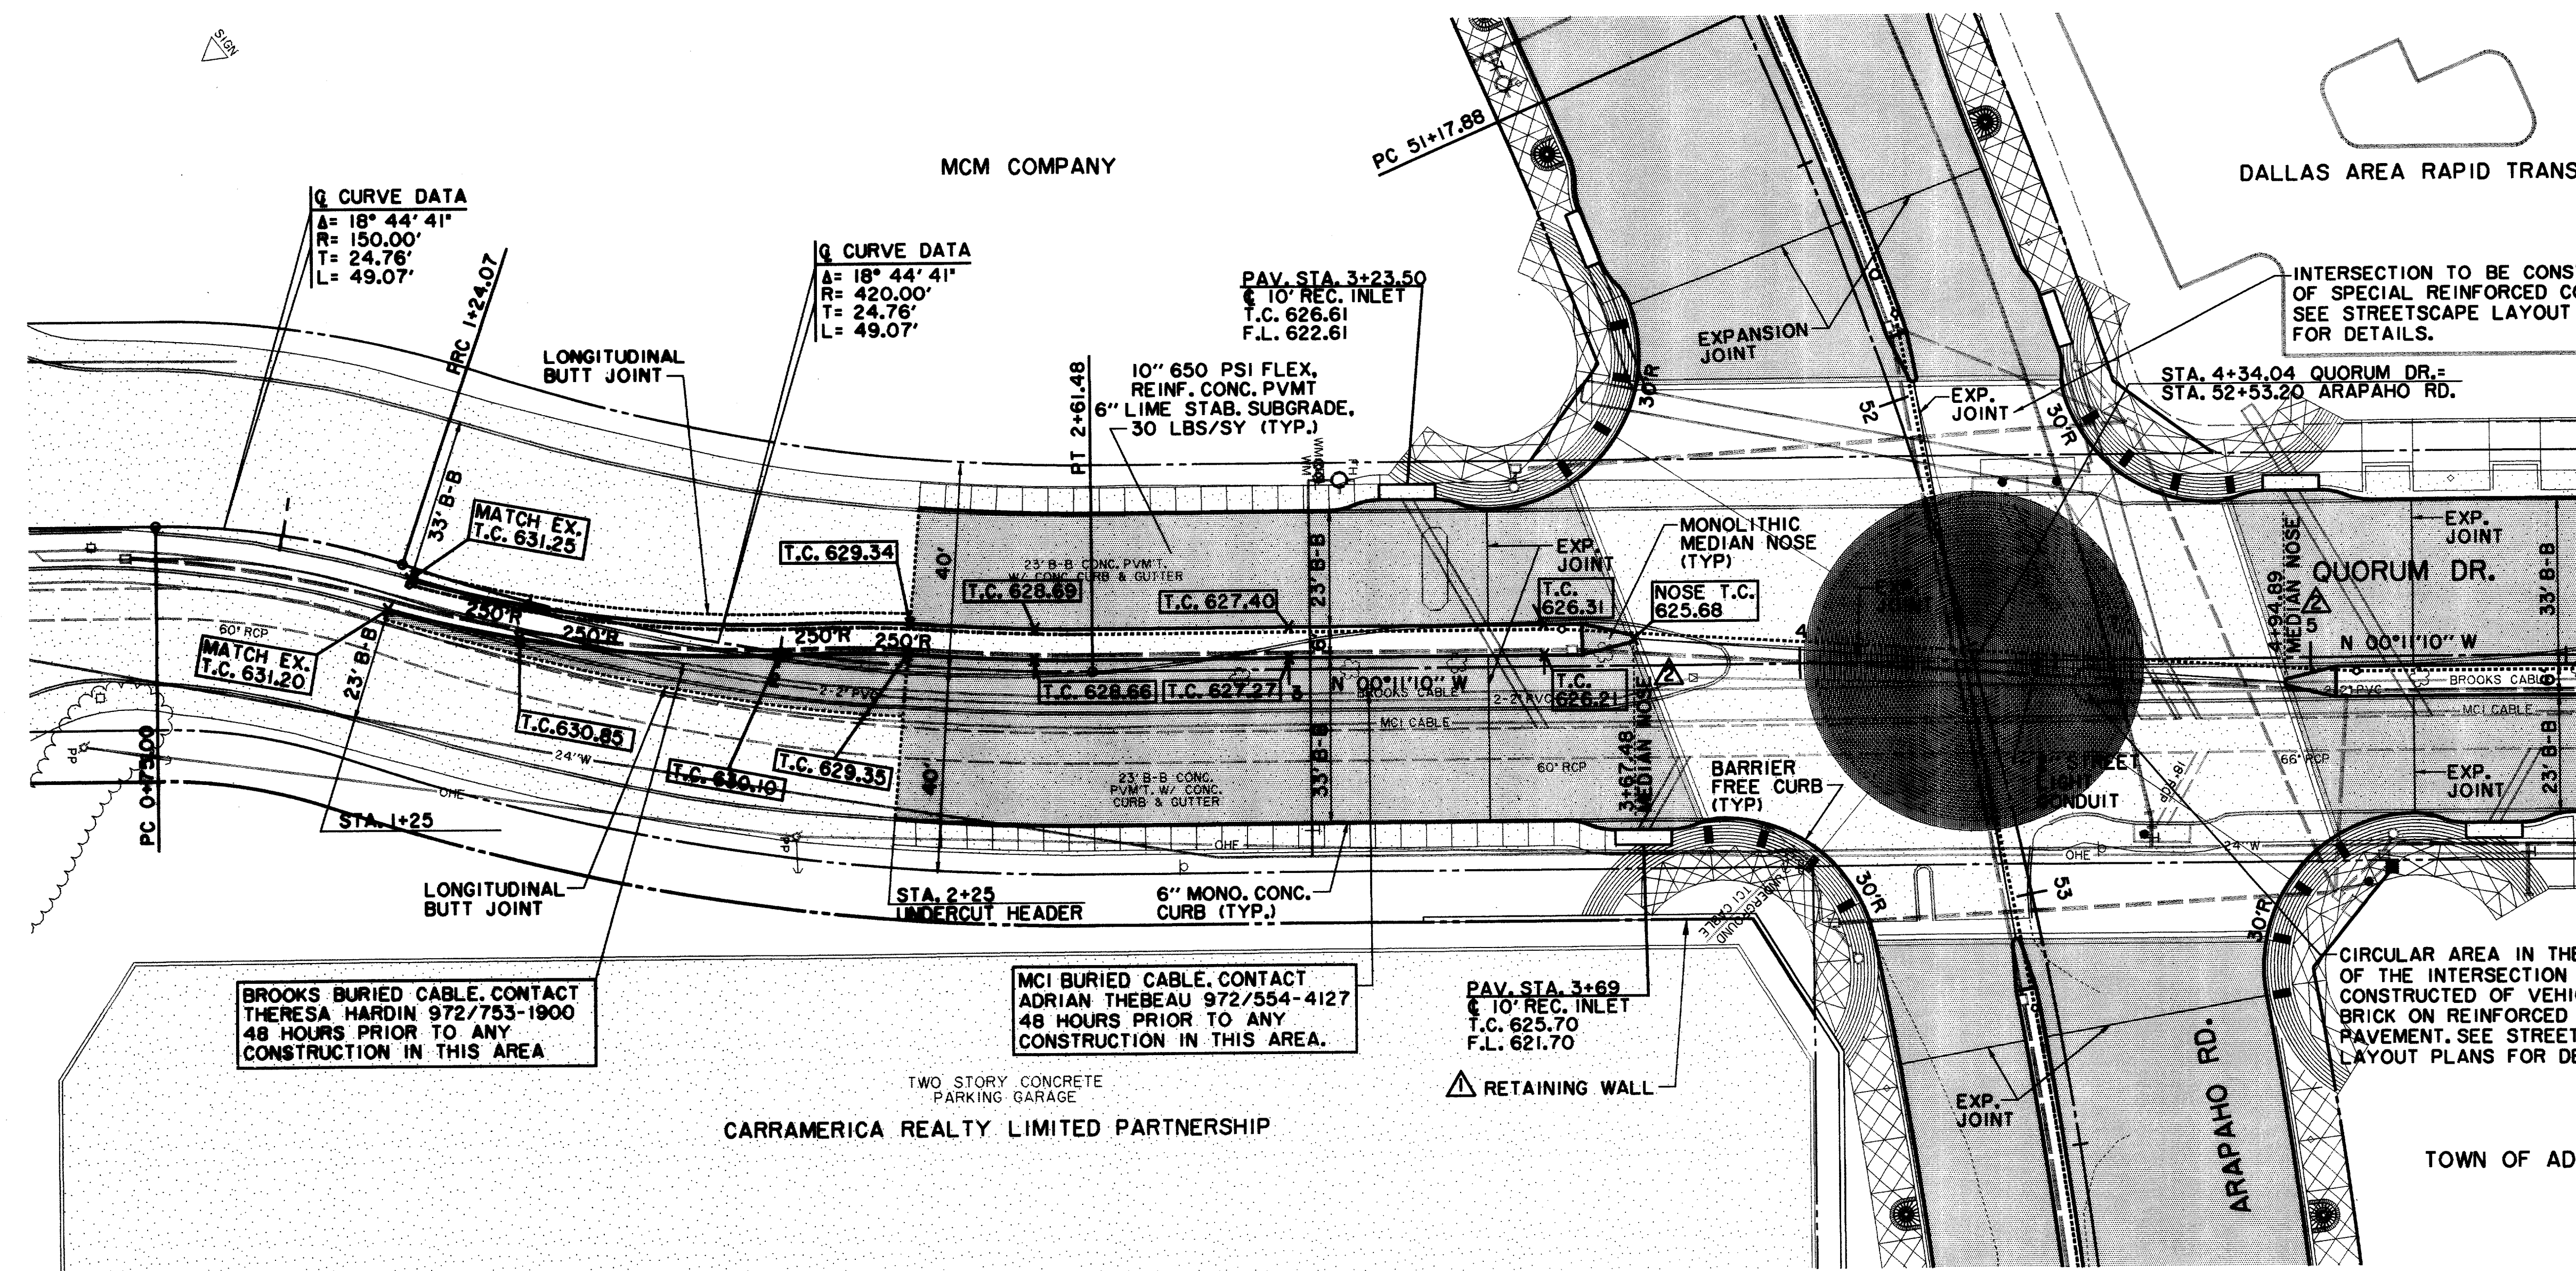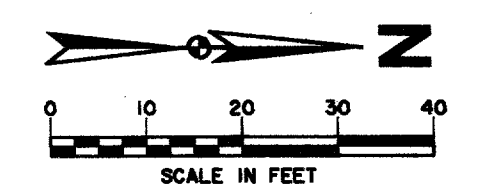

SEE STREETSCAPE PLANS FOR SIDEWALK, LANDSCAPING, IRRIGATION, LIGHTING AND PAVEMENT ENHANCEMENT DETAILS.

RECORD DOCUMENTS 6/9/2000
THESE RECORD DOCUMENTS HAVE BEEN PREPARED BASED ON INFORMATION PROVIDED BY OTHERS. THE CONSULTANT HAS NOT VERIFIED THE ACCURACY AND/OR COMPLETENESS OF THIS INFORMATION AND SHALL NOT BE RESPONSIBLE FOR ANY ERRORS OR OMISSIONS THAT MAY BE INCORPORATED AS A RESULT OF ERRONEOUS INFORMATION PROVIDED BY OTHERS.


LEGEND

BROOKS BURIED CABLE. CONTACT THERESA HARDIN 972/753-1900 48 HOURS PRIOR TO ANY CONSTRUCTION IN THIS AREA

MCI BURIED CABLE. CONTACT ADRIAN THEBEAU 972/554-4127 48 HOURS PRIOR TO ANY CONSTRUCTION IN THIS AREA.

CIRCULAR AREA IN THE MIDDLE OF THE INTERSECTION SHALL BE CONSTRUCTED OF VEHICULAR BRICK ON REINFORCED CONCRETE PAVEMENT. SEE STREETSCAPE LAYOUT PLANS FOR DETAILS.


TWO STORY CONCRETE PARKING GARAGE
CARRAMERICA REALTY LIMITED PARTNERSHIP

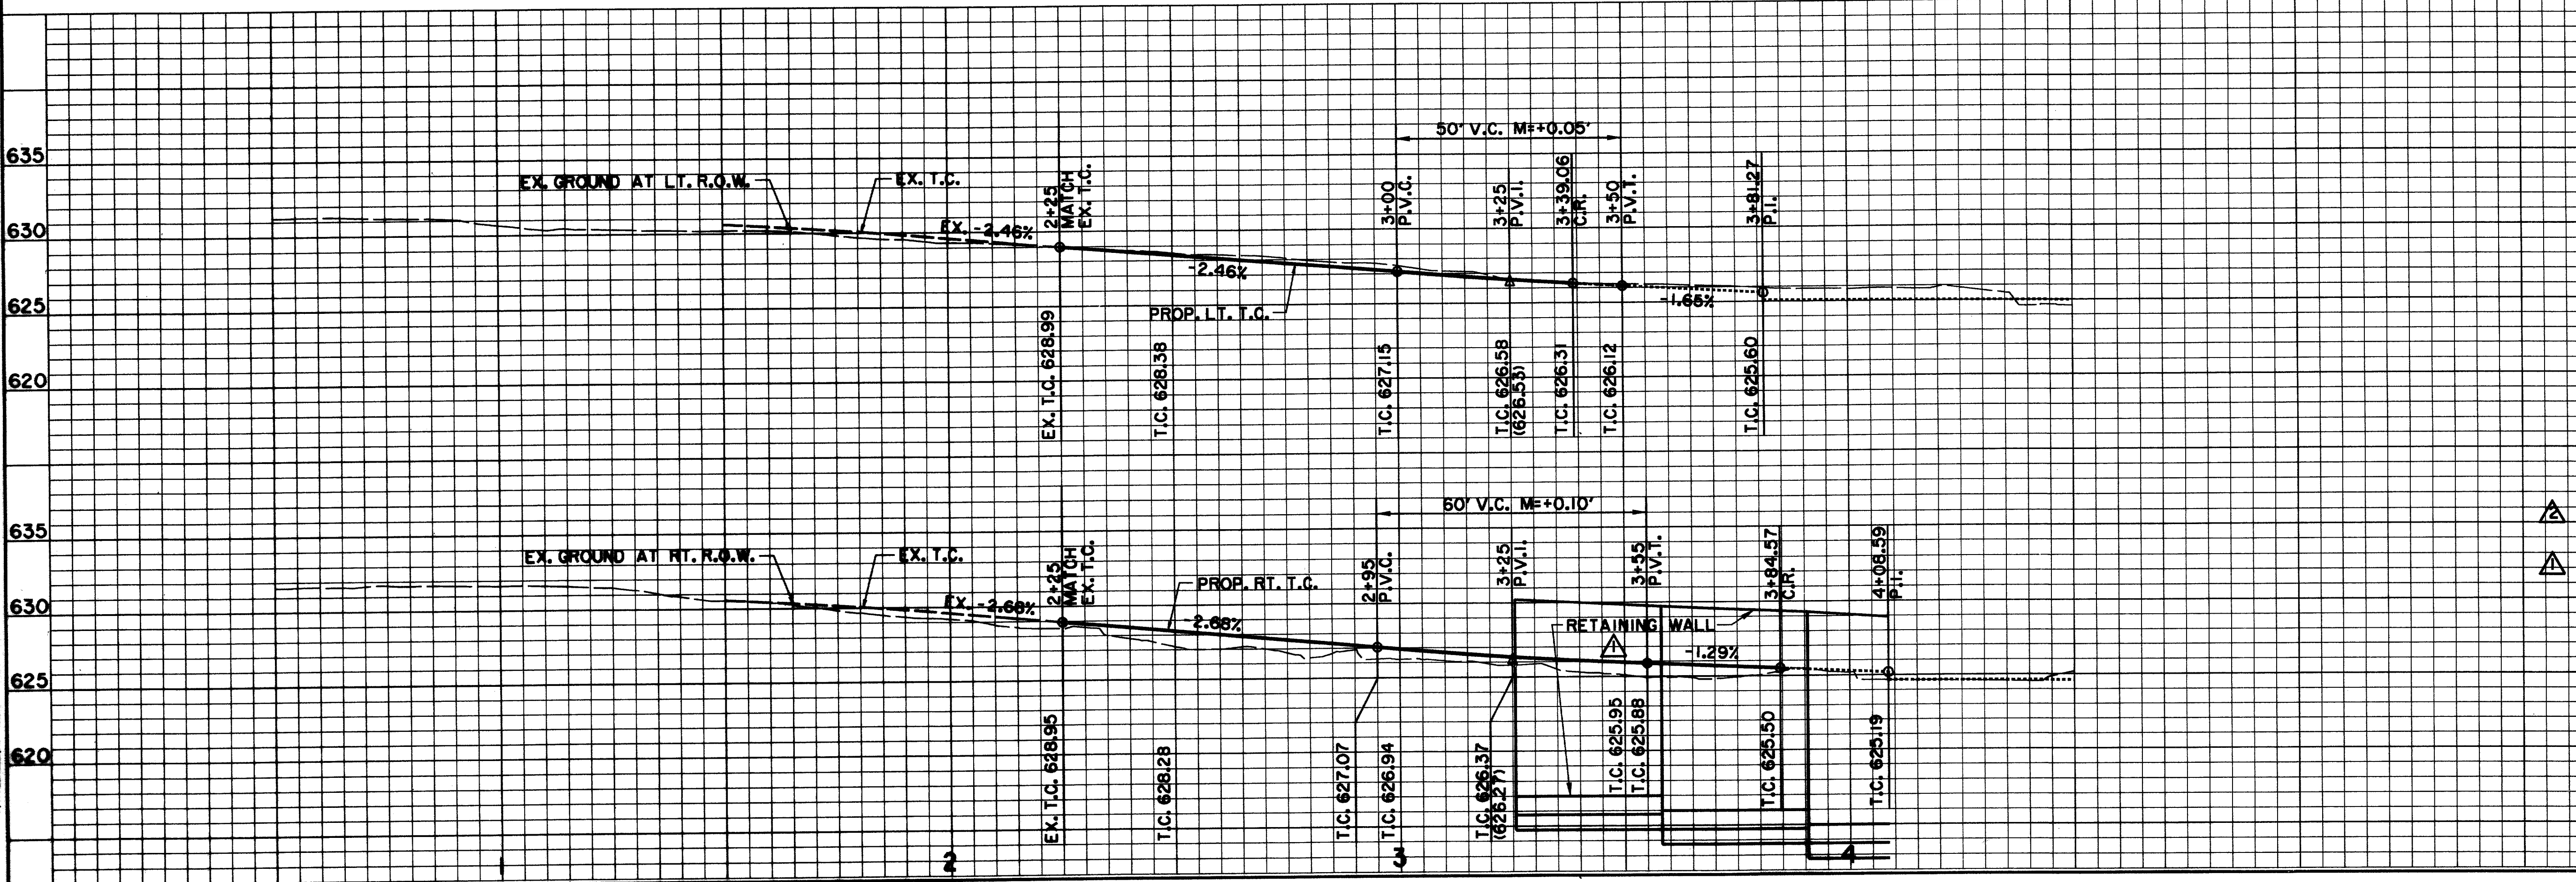

BENCHMARKS:
USC & GS E-921 DISK IN BRICK WALL OF OLD ADDISON SCHOOL HOUSE (MAGIC TIME MACHINE RESTAURANT) ON SOUTH WALL, 4' EAST OF CENTER OF THE ENTRANCE, 4.7' ABOVE THE GROUND. ELEV. 650.61

630 'I' ON SOUTHEAST CORNER OF CONCRETE WALK AT FRONT ENTRANCE TO 4805 ARAPAHO ROAD. ELEV. 630.61


THE SEAL APPEARING ON THIS DOCUMENT WAS AUTHORIZED BY KENNETH A. ROBERTS, P.E. 55446 ON OCTOBER 24, 1997

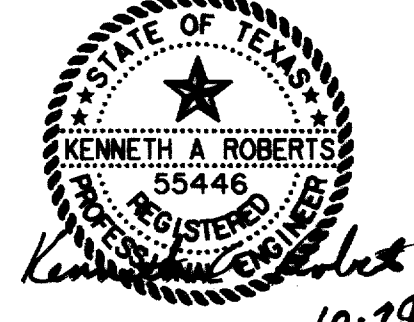

REVISED 1/16/98
ADDENDUM #4 12/12/97

PAVING PLAN & PROFILE						
QUORUM DR. STA. 2+25 TO STA. 4+50						
ARAPAHO ROAD						
ADDISON ROAD TO DALLAS NORTH TOLLWAY						
TOWN OF ADDISON, TEXAS						
Huitl-Zollars, Inc./Consulting Engineers Dallas, Fort. Worth, Houston, Phoenix, Tustin						
DESIGN	DRAWN	APPR.	SCALE	DATE	PROJECT NO.	NO.
HZI	HZI	KAR	H _v 1"=20' V _h 1"=6'	OCT 97	1772-01	P-10

Vertical text on the left margin containing project details and dates.

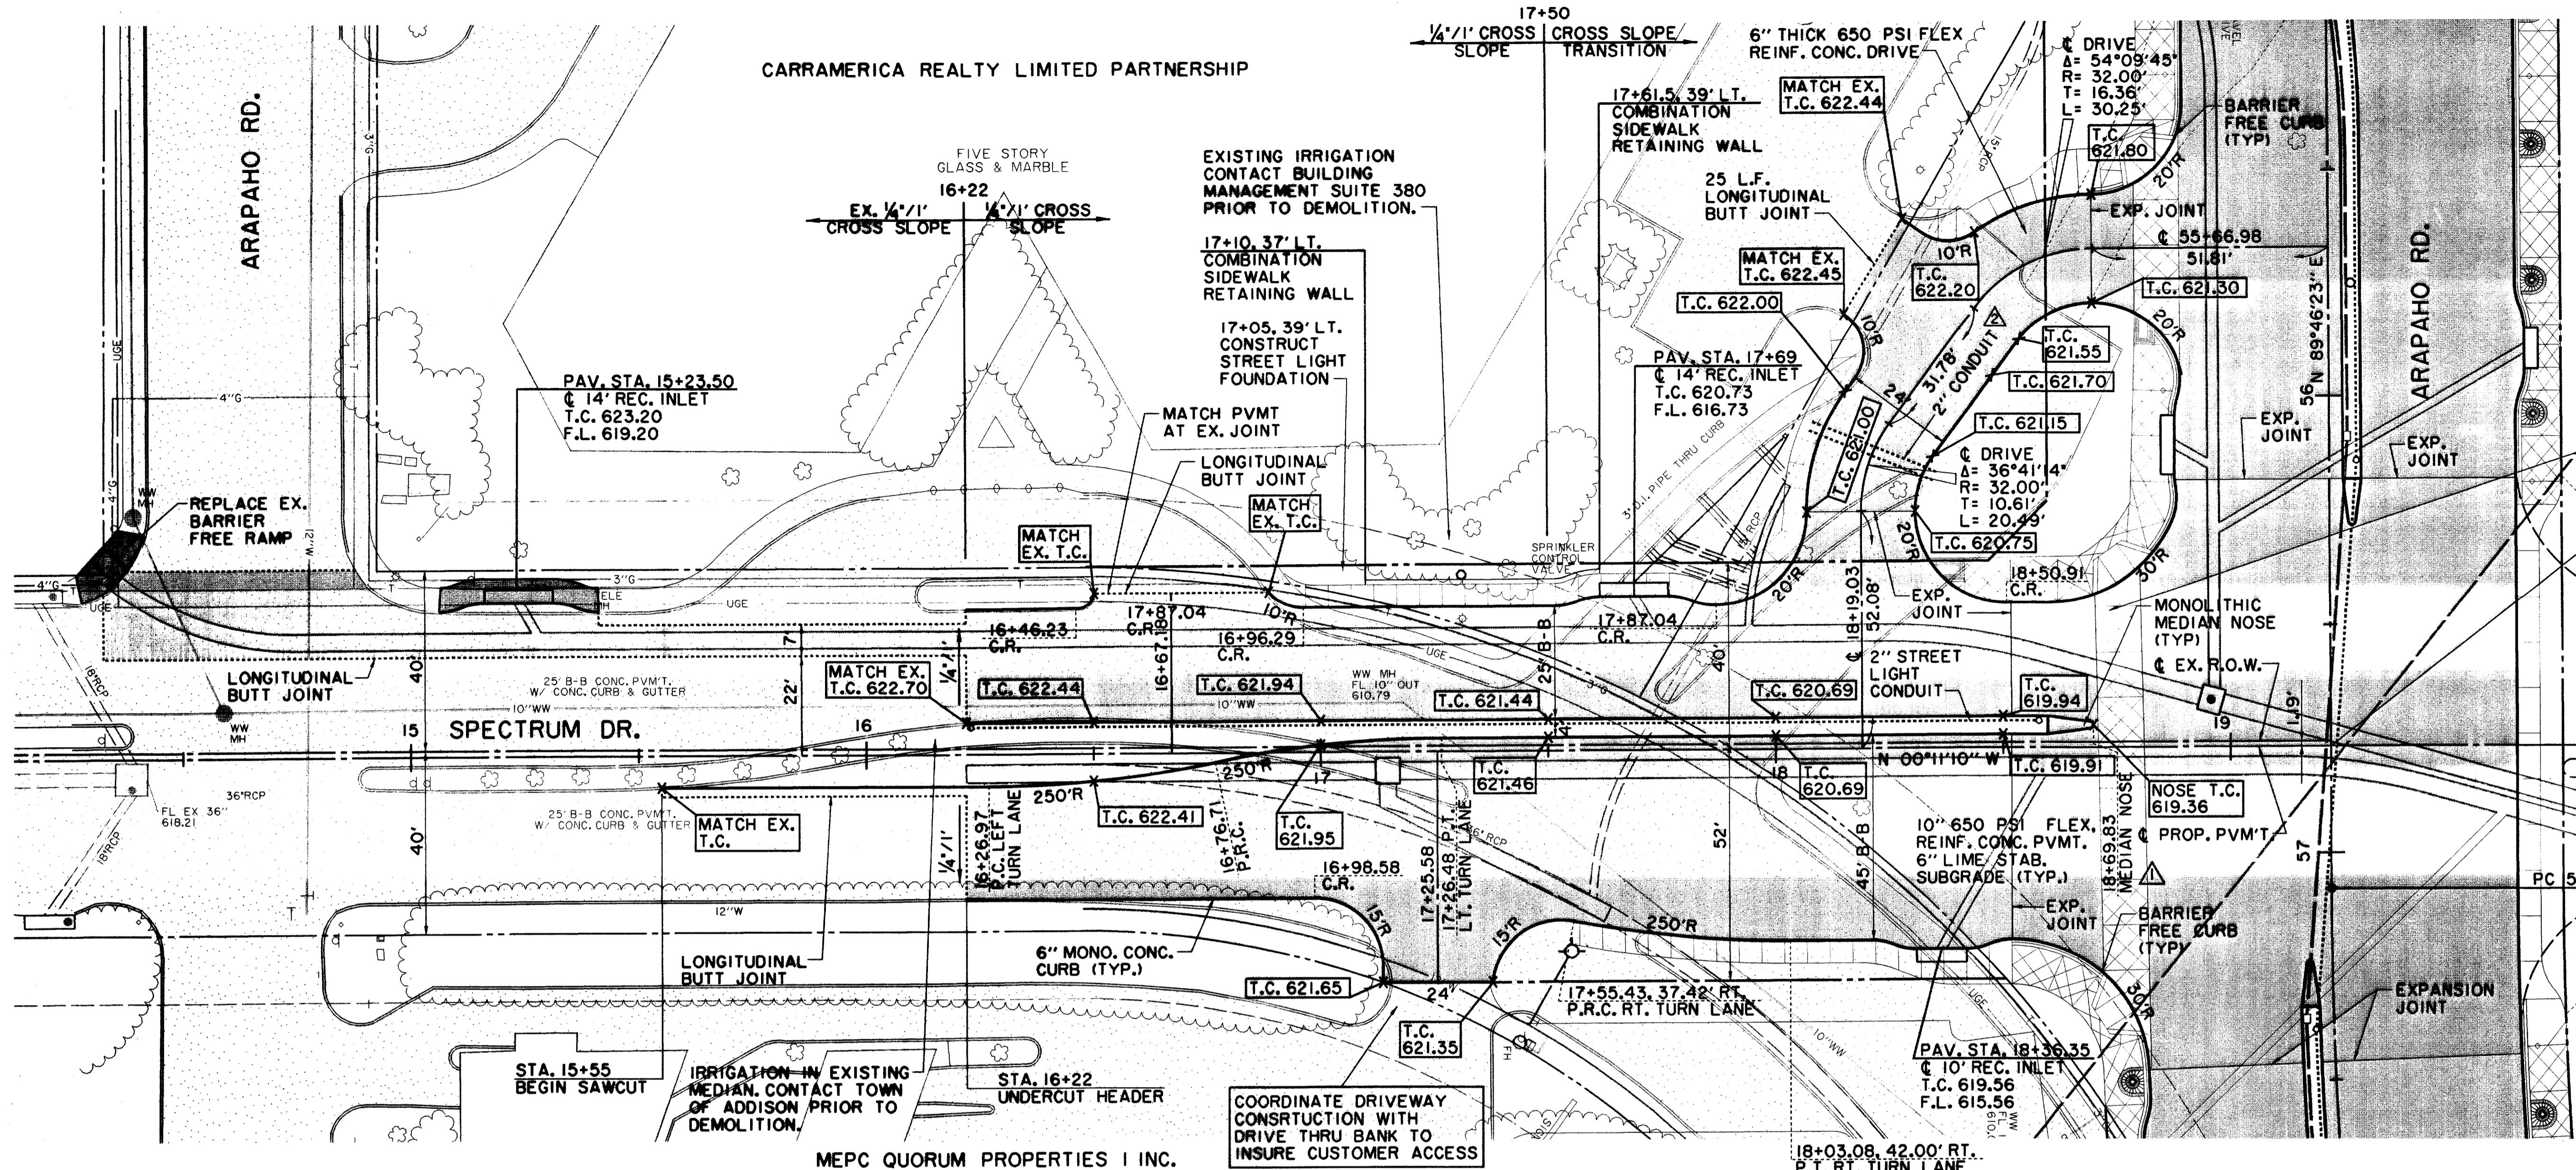

SEE STREETScape PLANS FOR SIDEWALK, LANDSCAPING, IRRIGATION, LIGHTING AND PAVEMENT ENHANCEMENT DETAILS.

THESE RECORD DOCUMENTS HAVE BEEN PREPARED BASED ON INFORMATION PROVIDED BY OTHERS. THE CONSULTANT HAS NOT VERIFIED THE ACCURACY AND/OR COMPLETENESS OF THIS INFORMATION AND SHALL NOT BE RESPONSIBLE FOR ANY ERRORS OR OMISSIONS THAT MAY BE INCORPORATED AS A RESULT OF ERRONEOUS INFORMATION PROVIDED BY OTHERS.

TOWN OF ADDISON

CROSSWALK TO BE CONSTRUCTED OF SPECIAL REINFORCED CONCRETE. SEE STREETScape LAYOUT PLANS FOR DETAILS.

STA. 19+22.03 SPECTRUM DR. = STA. 56+76.73 ARAPAH0 RD.

LEGEND

ELECTRIC — OHE	WATER — W
○ LIGHT POLE	○ FIRE HYDRANT
⊕ POWER POLE	WM METER
— GUY WIRE	T WATER VALVE
TELEPHONE — T	MISC.
TELEPHONE MANHOLE	X X X R.C.P. REMOVAL
TELEPHONE PEDESTAL	— CHAIN LINK FENCE
TELEPHONE SIGN	— WOOD FENCE
GAS — G	— EXISTING ASPHALT
GM GAS METER	— EXISTING DIRT OR GRAVEL
GS GAS SIGN	— EX. CONCRETE
LAND USE	— TREE/TREE LINE
R-R RAILROAD SIGN	— EXISTING CURB
⊕ SIGN	— PROP. CURB
I.R. FOUND IRON ROD	— EX. PROPERTY LINE
TEMP BENCHMARK	— PROP. CENTERLINE
WM WASTEWATER MANHOLE	— PROP. R.O.W.
CO CLEANOUT	— PROP. INLET
	P.V.M.T. TOP OF PAVEMENT
	T.C. TOP OF CURB
	C.R. CURB RETURN



BENCHMARKS:

USC & GS E-921 DISK IN BRICK WALL OF OLD ADDISON SCHOOL HOUSE (MAGIC TIME MACHINE RESTAURANT) ON SOUTH WALL, 4' EAST OF CENTER OF THE ENTRANCE, 4.7' ABOVE THE GROUND, ELEV. 650.61

□ ON SOUTHEAST CORNER OF CONCRETE WALK AT FRONT ENTRANCE TO 4805 ARAPAH0 ROAD, ELEV. 630.61

THE SEAL APPEARING ON THIS DOCUMENT WAS AUTHORIZED BY KENNETH A. ROBERTS, P.E. 55446 ON OCTOBER 24, 1997

Kenneth A. Roberts


10-24-97

PAVING PLAN & PROFILE					
SPECTRUM DR. STA. 15+55 TO STA. 19+22.03					
ARAPAH0 ROAD					
ADDISON ROAD TO DALLAS NORTH TOLLWAY					
TOWN OF ADDISON, TEXAS					
Huitt-Zollars, Inc., Consulting Engineers Dallas, Fort Worth, Houston, Phoenix, Tustin					
DESIGN	DRAWN	APPR.	SCALE	DATE	PROJECT NO.
HZI	HZI	KAR	H _v 1"=20' V _v 1"=8'	OCT 97	1772-01
					NO.
					P-12


ALL INFORMATION IS TO BE USED FOR THE PROJECT ONLY AND NOT TO BE REPRODUCED OR TRANSMITTED IN ANY FORM OR BY ANY MEANS, ELECTRONIC OR MECHANICAL, INCLUDING PHOTOCOPYING, RECORDING, OR BY ANY INFORMATION STORAGE AND RETRIEVAL SYSTEM. THE USER OF THIS DOCUMENT ASSUMES ALL LIABILITY FOR ANY ERRORS OR OMISSIONS. THE CONSULTANT'S LIABILITY IS LIMITED TO THE PROFESSIONAL SERVICES PROVIDED. THIS DOCUMENT IS THE PROPERTY OF HUITT-ZOLLARS, INC. AND IS TO BE RETURNED TO THE CONSULTANT UPON COMPLETION OF THE PROJECT.

NOTES-PAVING AND GRADING


- UNLESS SPECIFICALLY STATED OTHERWISE IN PLANS OR CONTRACT DOCUMENTS, THE CONTROLLING SPECIFICATIONS FOR ALL WORK WITHIN PUBLIC RIGHTS-OF-WAY AND EASEMENTS SHALL BE THE STANDARD SPECIFICATIONS FOR PUBLIC WORKS CONSTRUCTION, SECOND EDITION 1987, AS AMENDED BY THE NORTH CENTRAL TEXAS COUNCIL OF GOVERNMENTS (THE "STANDARD SPECIFICATIONS"). COPIES OF THE STANDARD SPECIFICATIONS MAY BE PURCHASED BY MAIL OR OVER THE COUNTER FROM THE NORTH CENTRAL TEXAS COUNCIL OF GOVERNMENTS, 616 SIX FLAGS DRIVE, P.O. BOX DRAWER COG, ARLINGTON, TEXAS 76005-5888, PHONE METRO 817/640-3300. BULK DISCOUNTS ARE AVAILABLE. THIS DOCUMENT IS COPYRIGHTED.
- ROUGH GRADING SHALL BE ACCOMPLISHED TO WITHIN +/- 0.10 FEET OF PLAN ELEVATION.
- ALL TRAFFIC CONTROL NECESSARY FOR THE WORK SHALL BE PROVIDED BY THE CONTRACTOR. ALL BARRICADES, WARNING SIGNS, LIGHTS, DEVICES, ETC. FOR THE GUIDANCE AND PROTECTION OF TRAFFIC AND PEDESTRIANS MUST CONFORM TO THE INSTALLATIONS SHOWN IN THE LATEST ISSUE OF THE "TEXAS MANUAL ON UNIFORM TRAFFIC CONTROL DEVICES", AS CURRENTLY AMENDED, TEXAS DEPARTMENT OF TRANSPORTATION.
- ALL FILL SHALL BE PLACED IN MAXIMUM 8-INCH LIFTS COMPACTED TO 95% OF STANDARD PROCTOR DENSITY BETWEEN 0% AND +3% OF OPTIMUM MOISTURE CONTENT.
- ALL TREES, STUMPS, BRUSH, GRASSES AND SURFACE ORGANICS WITHIN PROPOSED RIGHT-OF-WAY ARE TO BE REMOVED AND PROPERLY DISPOSED OF OFF-SITE. TREE REMOVAL PERMITS, IF REQUIRED, WILL BE OBTAINED BY THE OWNER.
- EXISTING UTILITY POLES, IF ANY, WILL BE REMOVED OR RELOCATED BY THE UTILITY COMPANIES THROUGH COORDINATION BY THE OWNER. CONTRACTOR SHALL BRING TO THE OWNER'S ATTENTION ANY FACILITIES THAT APPEAR TO BE IN CONFLICT SO THAT THE OWNER HAS SUFFICIENT TIME TO ACCOMPLISH THE NECESSARY RELOCATIONS.
- WHERE DEEP VERTICAL EXCAVATIONS (IN EXCESS OF 3 FEET) ARE INDICATED, CUTS SHALL BE LAID BACK AT A STABLE SLOPE (ON OWNER'S PROPERTY) UNTIL WALLS ARE CONSTRUCTED. BACKFILL MATERIAL SHALL BE STOCKPILED ON-SITE AT THE DIRECTION OF THE OWNER.
- ALL REINFORCING STEEL AND DOWEL BARS IN PAVEMENT SHALL BE SUPPORTED AND MAINTAINED AT THE CORRECT CLEARANCES BY THE USE OF BAR CHAIRS OR OTHER APPROVED SUPPORT.
- THE USE OF WOOD FORMS FOR PAVEMENT CONSTRUCTION WILL BE PERMITTED.
- DUMMY JOINTS SHALL BE SAWS IN THE PAVEMENT IN THIS PROJECT. DUMMY JOINTS WILL BE SPACED APPROXIMATELY 12 FEET ON CENTERS UNLESS DIRECTED OTHERWISE BY THE TOWN. SPACING VARIATIONS SHALL BE MADE AT BLOCKOUTS, CONSTRUCTION JOINTS, AND STREET INTERSECTIONS TO LINE UP WITH EXISTING PAVING JOINTS AS DIRECTED BY THE TOWN. THE SPACING BETWEEN ANY JOINT SHALL NOT BE LESS THAN 10 FEET NOR MORE THAN 15 FEET. ALL DUMMY JOINTS SHALL BE SAWS NOT LATER THAN 12 HOURS AFTER THE PLACEMENT OF THE PAVEMENT.
- BARRIER-FREE RAMPS SHALL BE BUILT WITH THIS PROJECT. LOCATIONS MAY BE ADJUSTED AS DIRECTED BY THE TOWN TO CLEAR OBSTRUCTIONS.
- VARIABLE HEIGHT CURB AT INTERSECTIONS AND SLOPING CURBS AT DRIVES SHALL BE BUILT TO MATCH FUTURE BARRIER-FREE RAMPS PER PLANS. NO SEPARATE PAY ITEMS ARE PROVIDED.
- TWO-WAY TRAFFIC MUST BE MAINTAINED AT ALL TIMES ON PUBLIC STREETS ADJACENT TO THIS PROJECT UNLESS SPECIFIED OTHERWISE IN THE PLANS AND SPECIFICATIONS. THE TRAVELWAY WIDTH SHALL NOT BE LESS THAN 10 FEET.
- SEE TYPICAL SECTIONS SHEET FOR ADDITIONAL DETAILS AND NOTES.
- ALL CURBS SHALL BE PLACED INTEGRAL WITH PAVEMENT.
- CURBS SHALL MEET THE SAME COMPRESSIVE STRENGTH AS SPECIFIED FOR THE CONCRETE PAVEMENT.
- BAR LAPS SHALL BE 30 DIAMETERS.

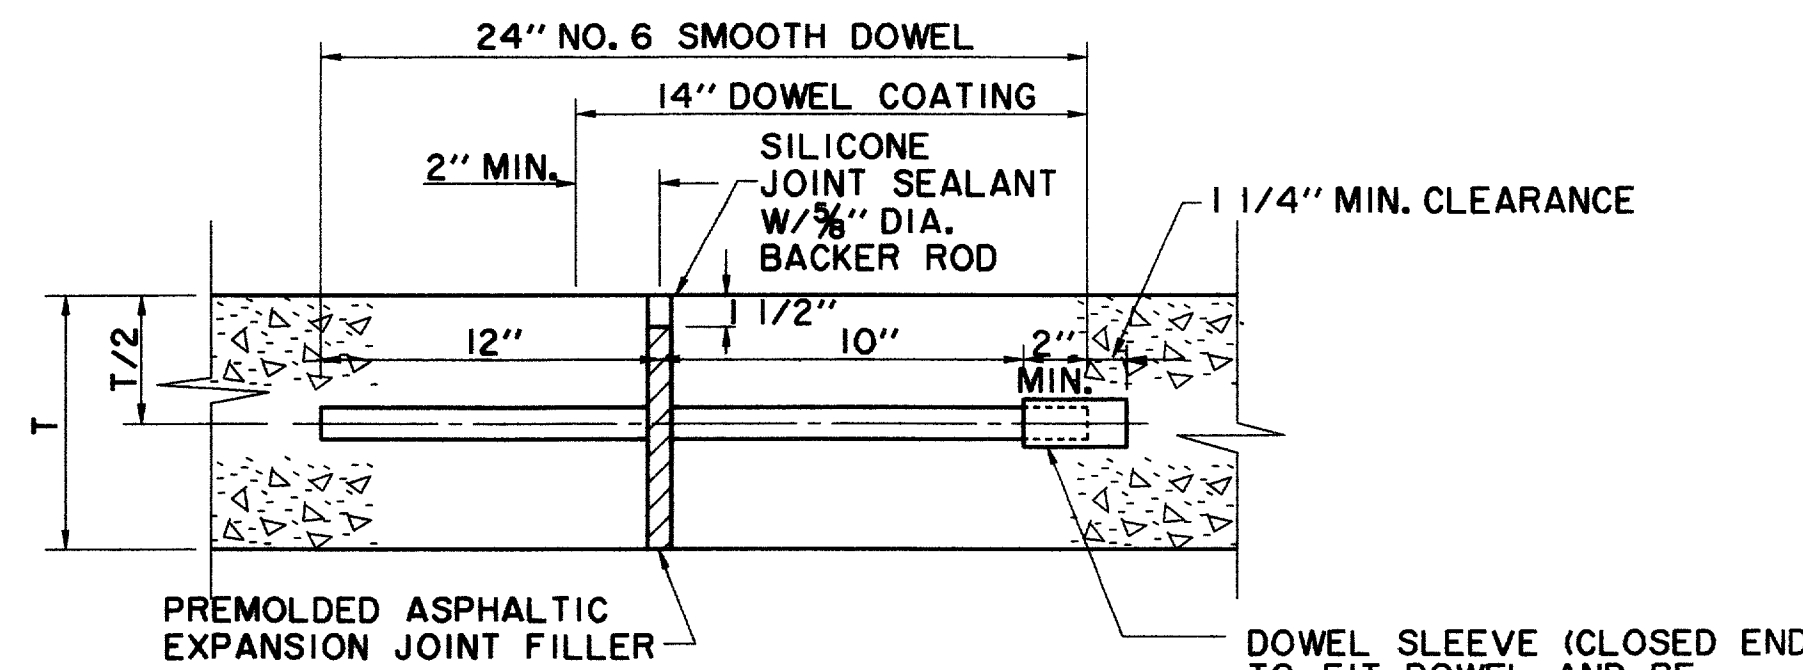


TRANSVERSE EXPANSION JOINT
N.T.S.
(SPACED 600 FT. MAXIMUM, LOCATE AT INTERSECTIONS)
NOTE:
DOWELS AND REINFORCING BARS SHALL BE SUPPORTED BY AN APPROVED DEVICE.

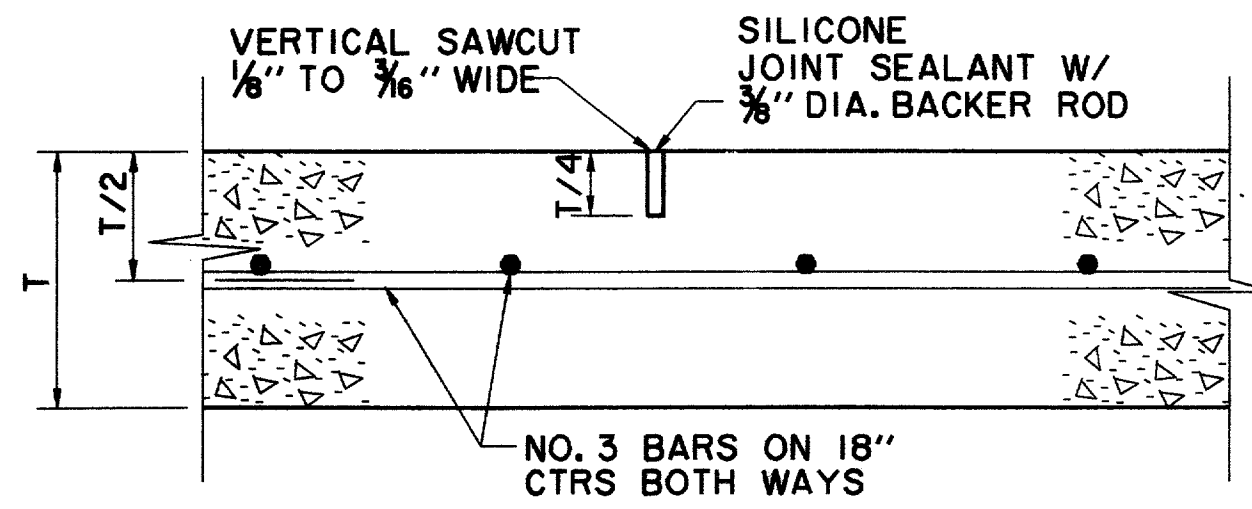


SAWED DUMMY JOINT
N.T.S.

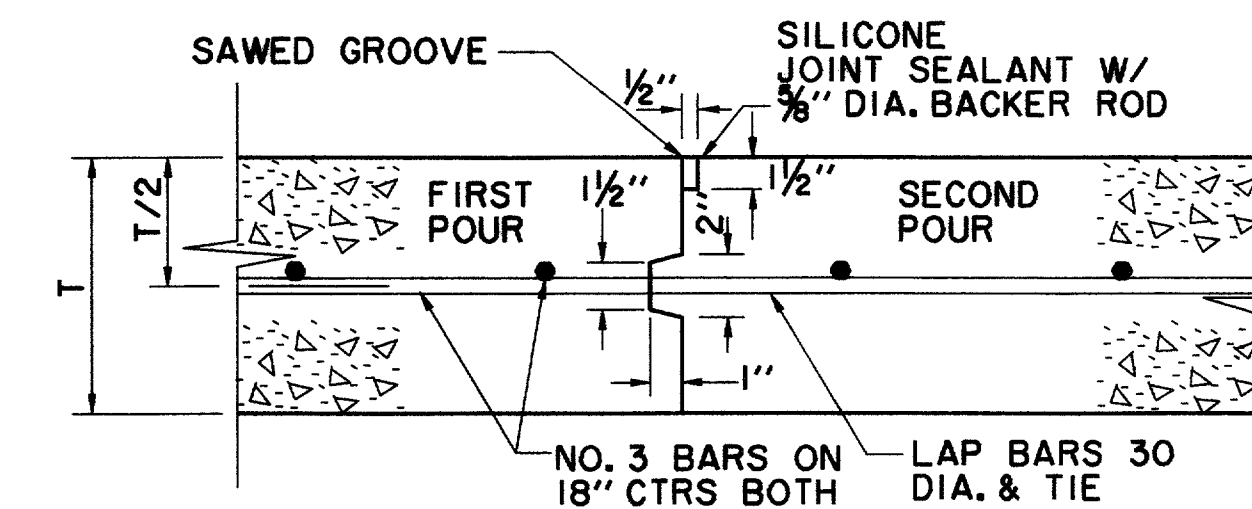


CONSTRUCTION JOINT
N.T.S.

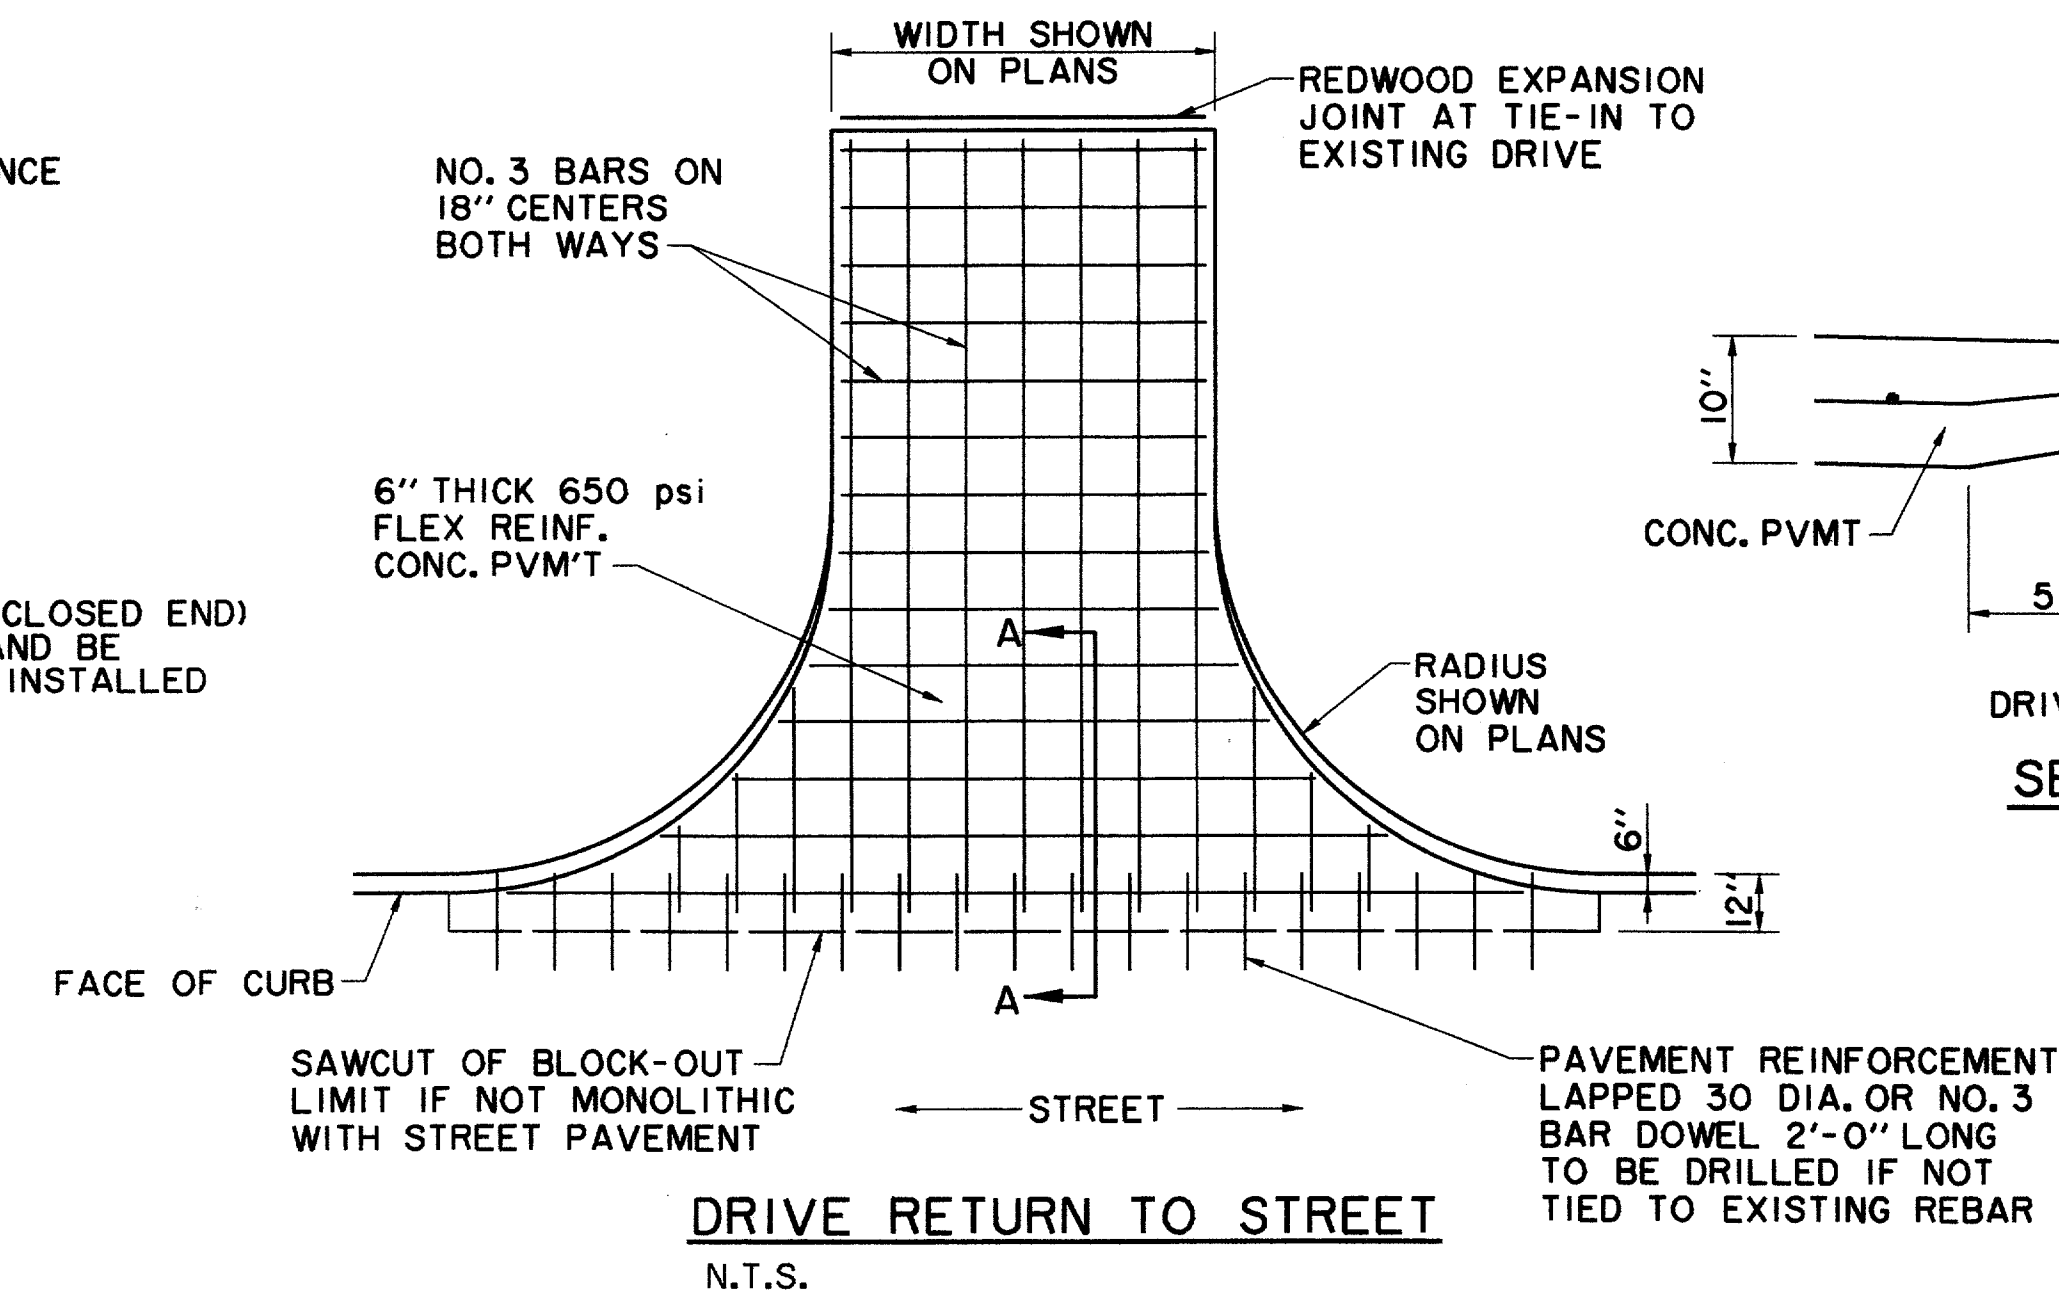


DRIVE RETURN TO STREET
N.T.S.

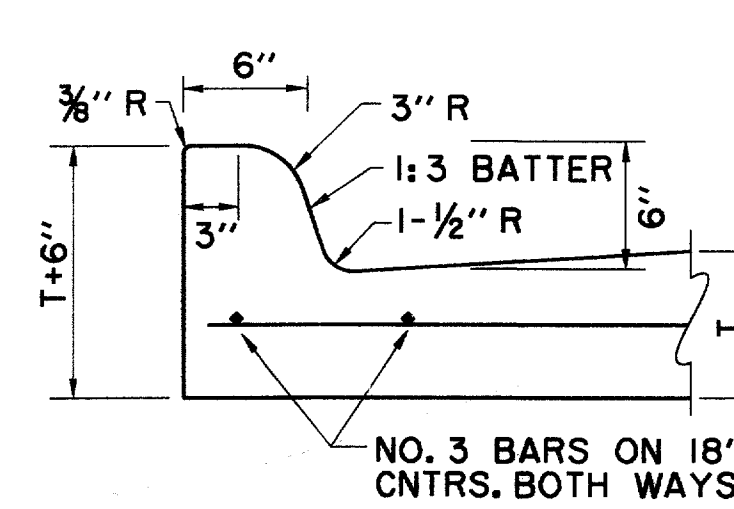


INTEGRAL CURB AND GUTTER
N.T.S.

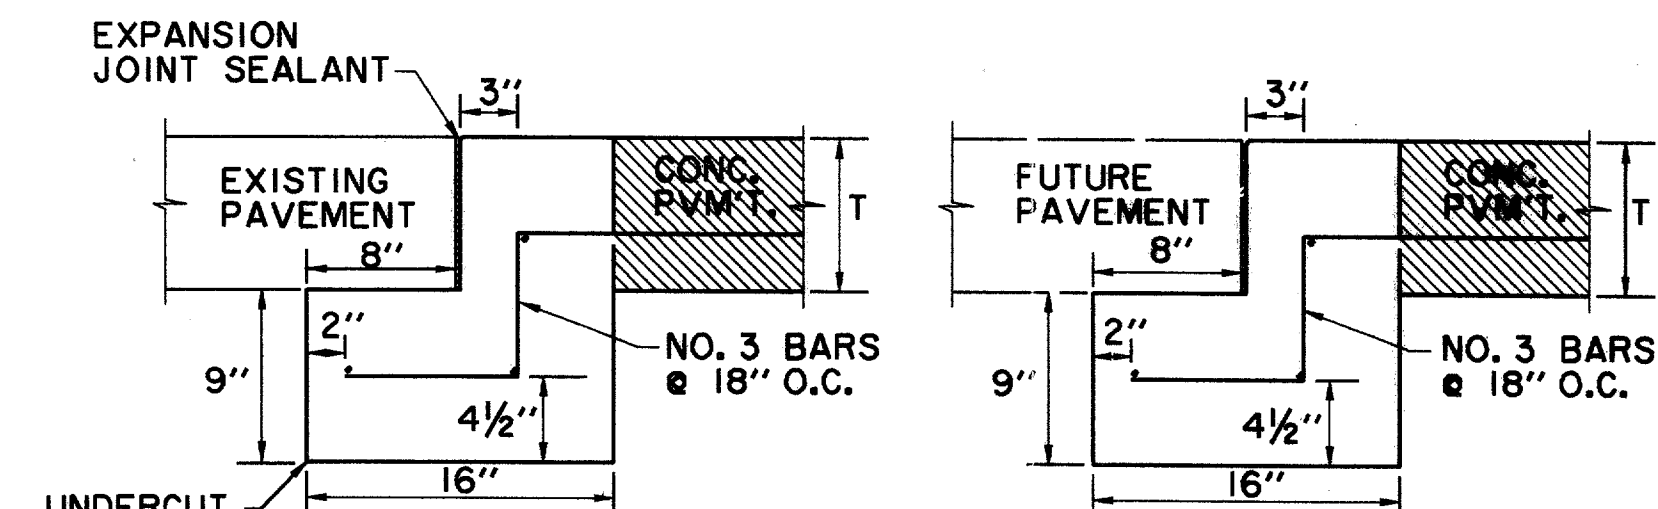


STREET HEADER
N.T.S.
PAVEMENT BARS TO BE BENT DOWN INTO HEADER. HEADER AND PAVEMENT TO BE MONOLITHIC.

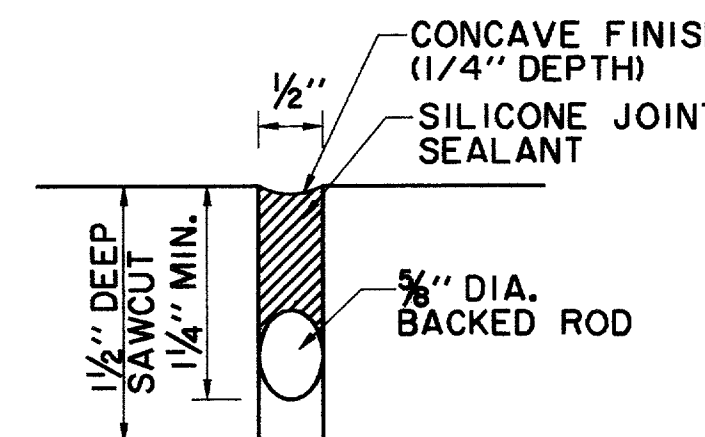


TYPICAL JOINT DETAIL
N.T.S.

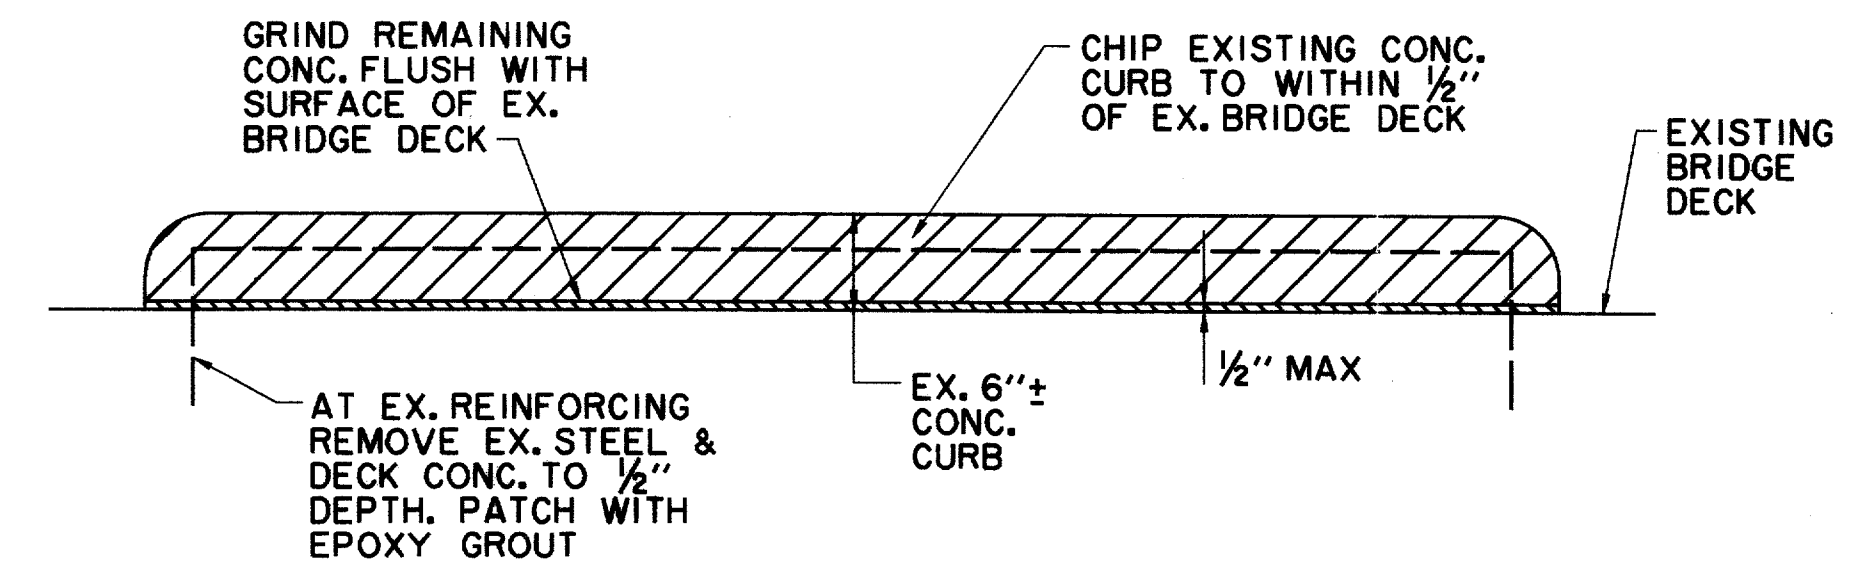


CONCRETE ISLAND REMOVAL DETAIL
N.T.S.

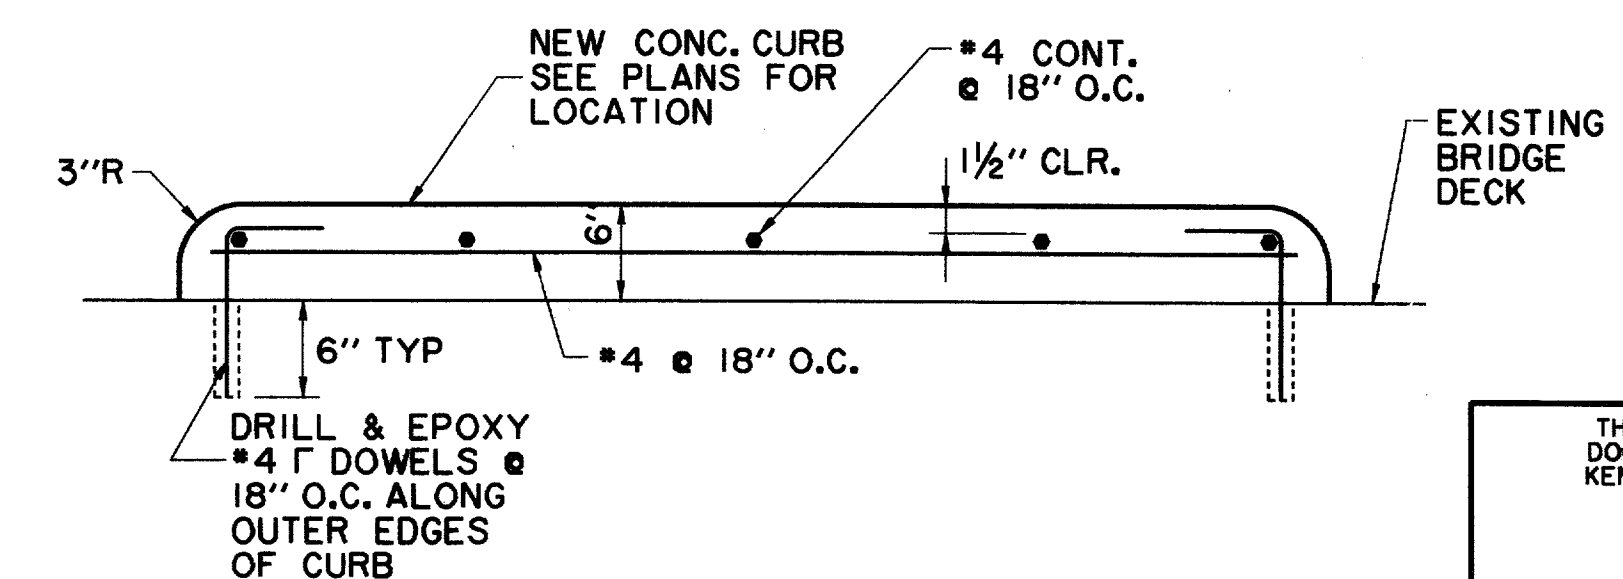


NEW CONCRETE ISLAND DETAIL
N.T.S.

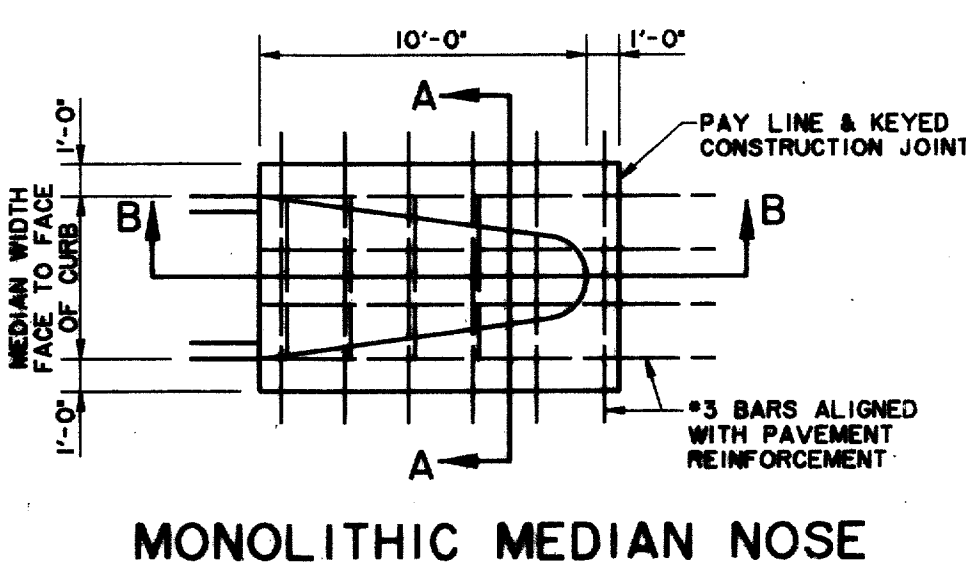


MONOLITHIC MEDIAN NOSE

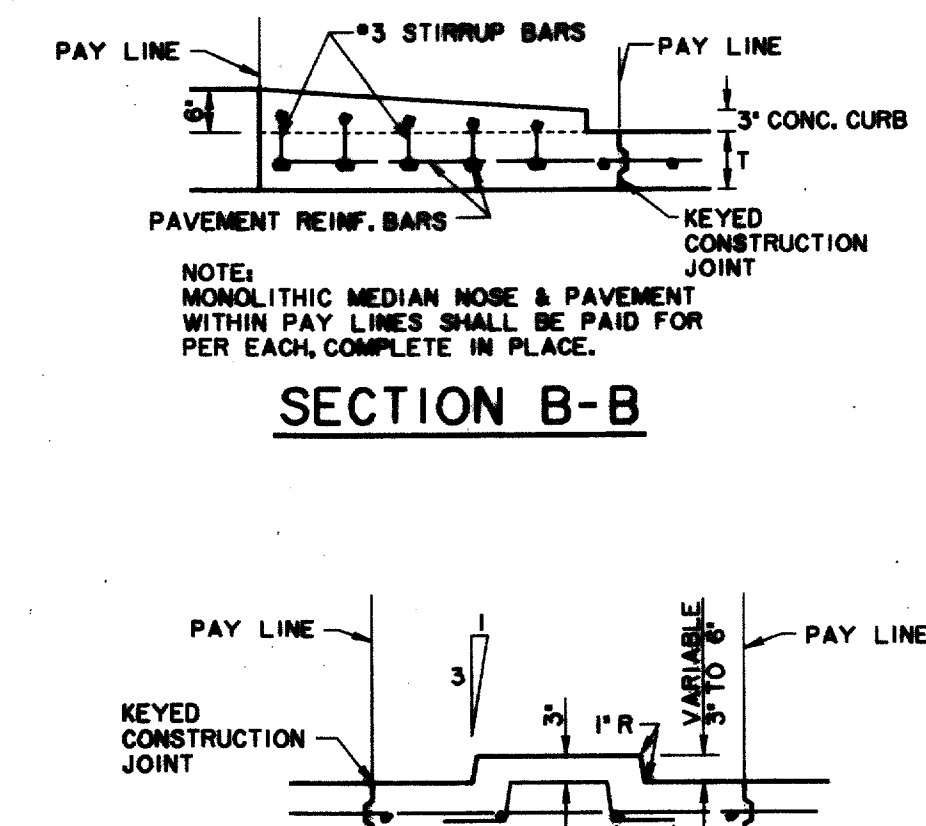


SECTION A-A

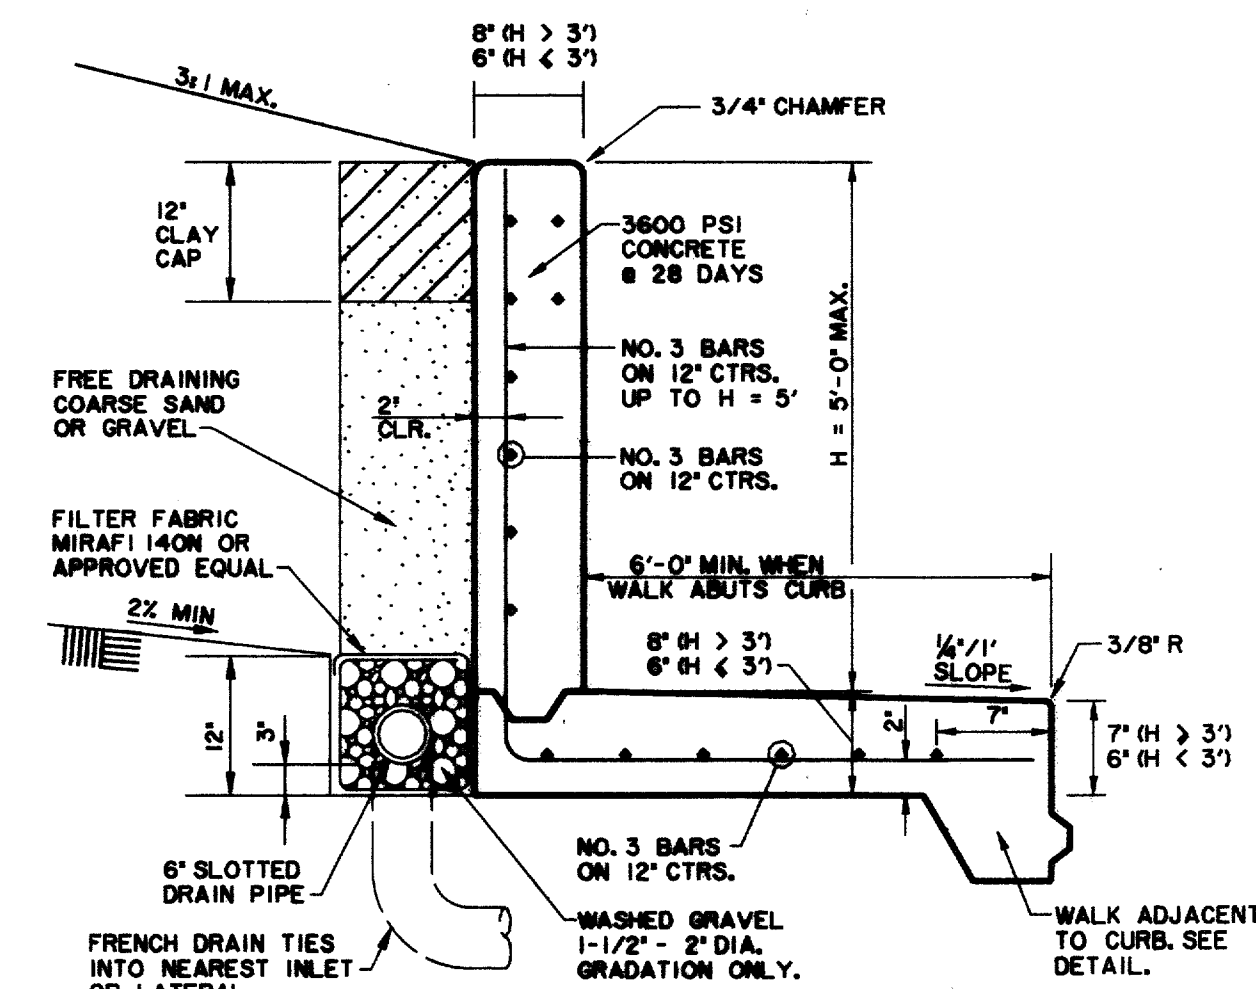

COMBINATION CANTILEVER RETAINING WALL & SIDEWALK DETAIL

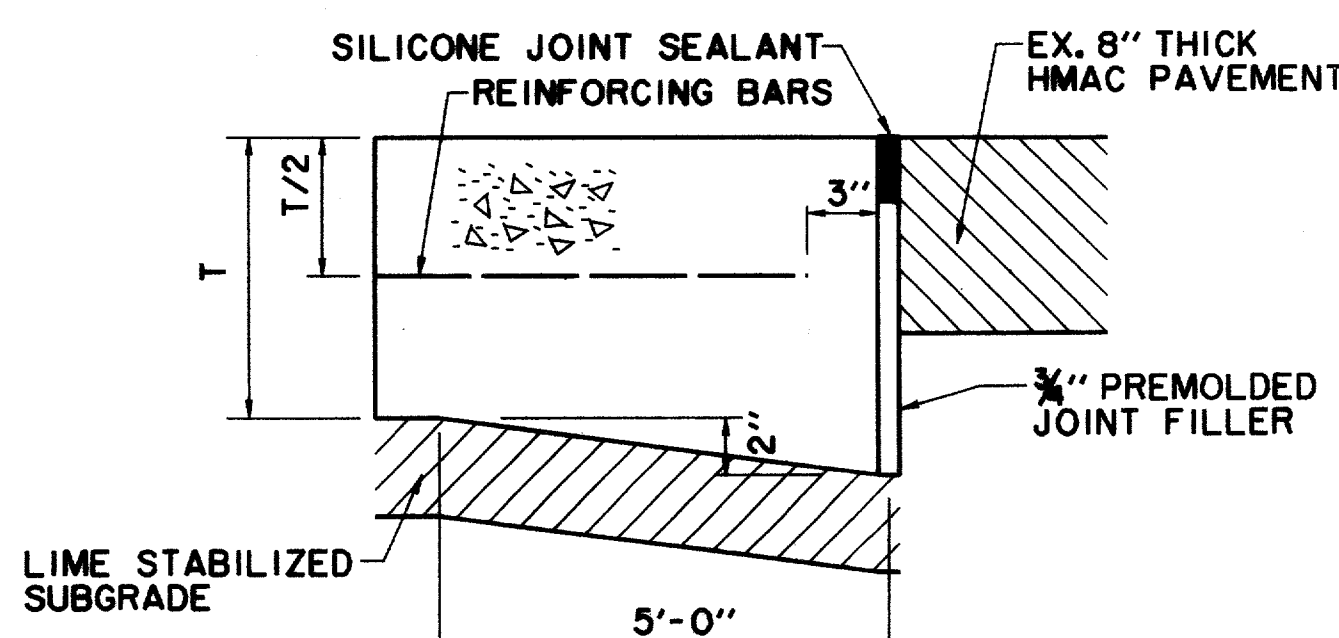



THICKENED EDGE JOINT AT ADDISON ROAD
N.T.S.

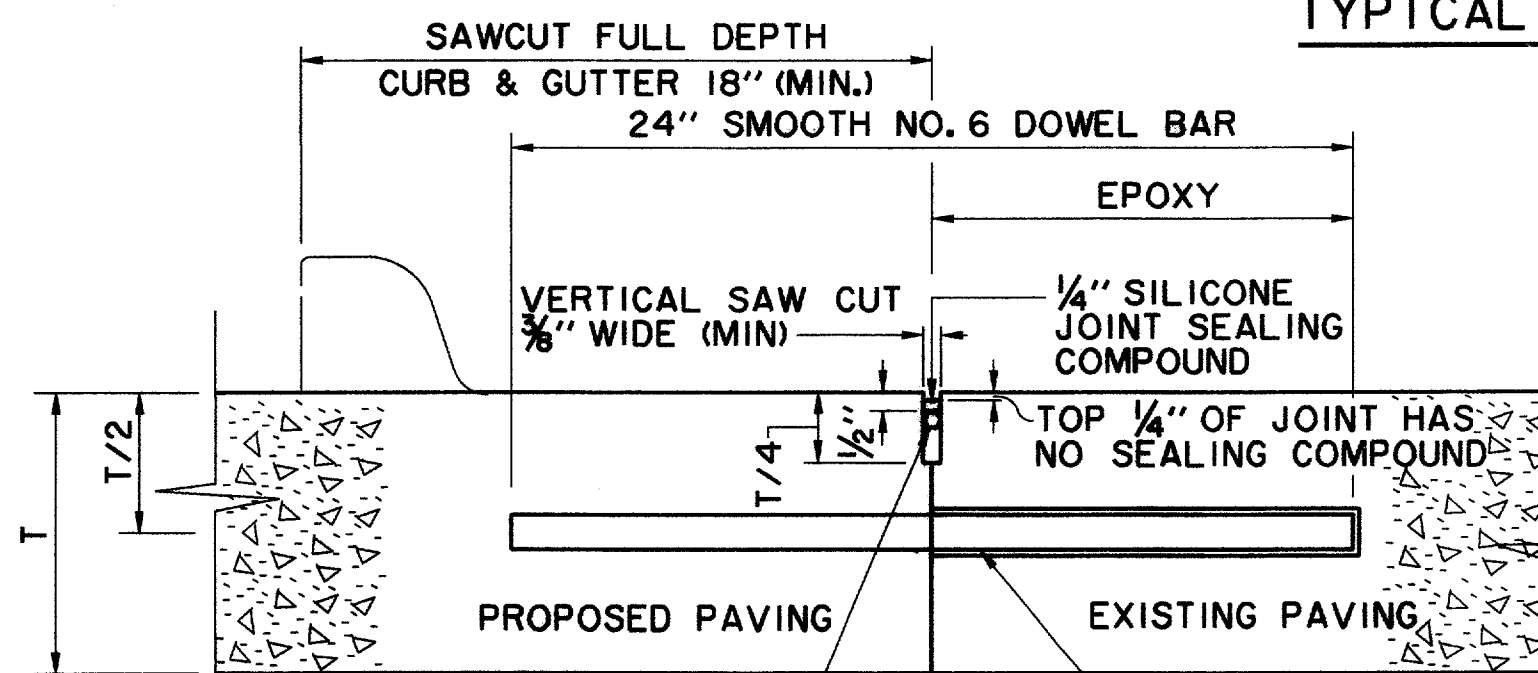

LONGITUDINAL BUTT JOINT
N.T.S.

DOWEL BARS SHALL BE DRILLED INTO EX. PAVEMENT HORIZONTALLY BY USE OF A MECHANICAL RIG. DRILLING BY HAND IS NOT ACCEPTABLE. PUSHING DOWEL BARS INTO GREEN CONCRETE NOT ACCEPTABLE.

MONOLITHIC MEDIAN NOSES AT QUORUM DR.

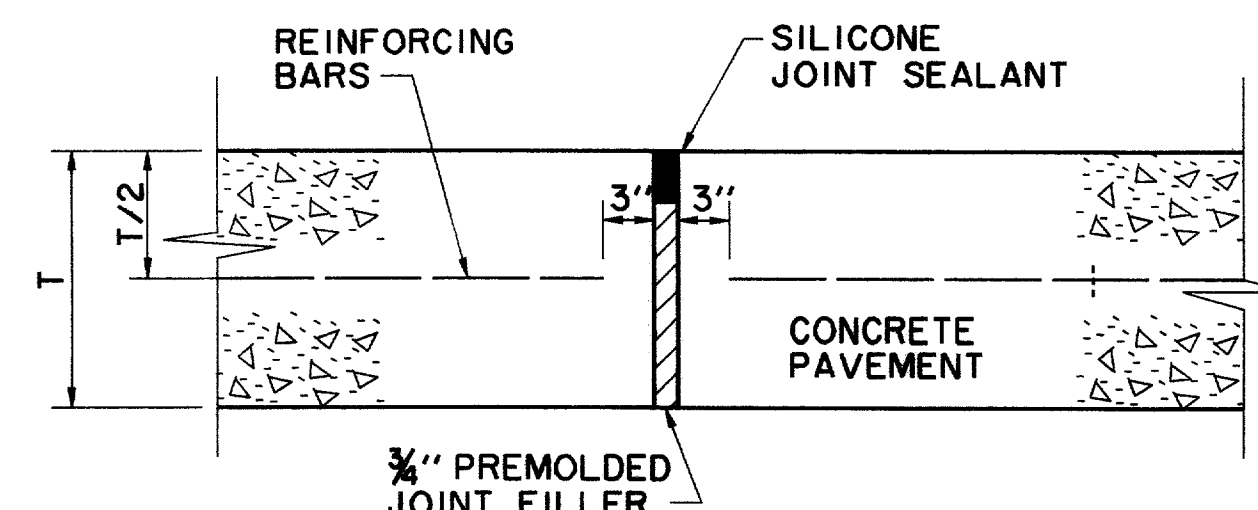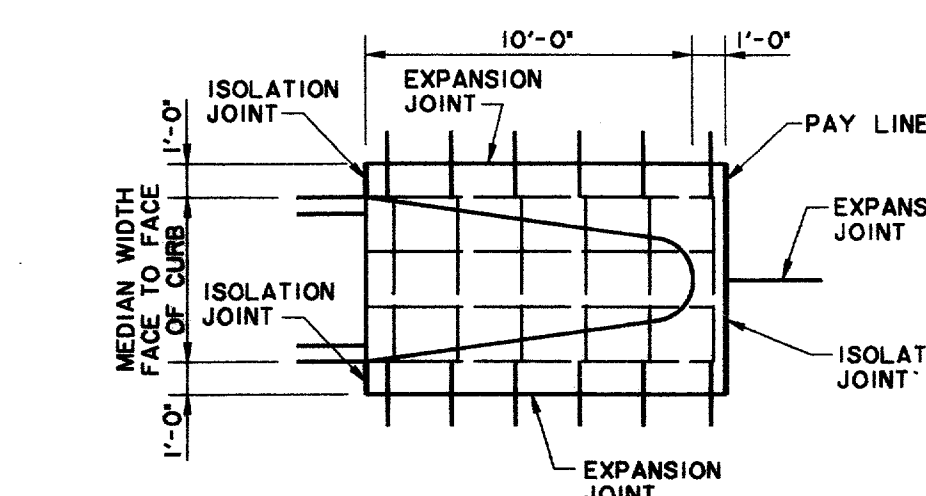

ISOLATION JOINT
N.T.S.

RECORD DOCUMENTS 6/9/2000

THESE RECORD DOCUMENTS HAVE BEEN PREPARED BASED ON INFORMATION PROVIDED BY OTHERS. THE CONSULTANT HAS NOT VERIFIED THE ACCURACY AND/OR COMPLETENESS OF THIS INFORMATION AND SHALL NOT BE RESPONSIBLE FOR ANY ERRORS OR OMISSIONS THAT MAY BE INCORPORATED AS A RESULT OF ERRONEOUS INFORMATION PROVIDED BY OTHERS.


ADDENDUM #4, 12/19/97
ADDENDUM #2, 11/18/97

THE SEAL APPEARING ON THIS DOCUMENT WAS AUTHORIZED BY KENNETH A. ROBERTS, P.E. 55446 ON OCTOBER 24, 1997




PAVING DETAILS


ARAPAHO ROAD						
ADDISON ROAD TO DALLAS NORTH TOLLWAY						
TOWN OF ADDISON, TEXAS						
Huitt-Zollars, Inc./Consulting Engineers Dallas, Fort Worth, Houston, Phoenix, Tucson						
DESIGN	DRAWN	APPR.	SCALE	DATE	PROJECT NO.	NO.
HZI	HZI	KAR	N.T.S.	OCT 97	1772-01	P-13

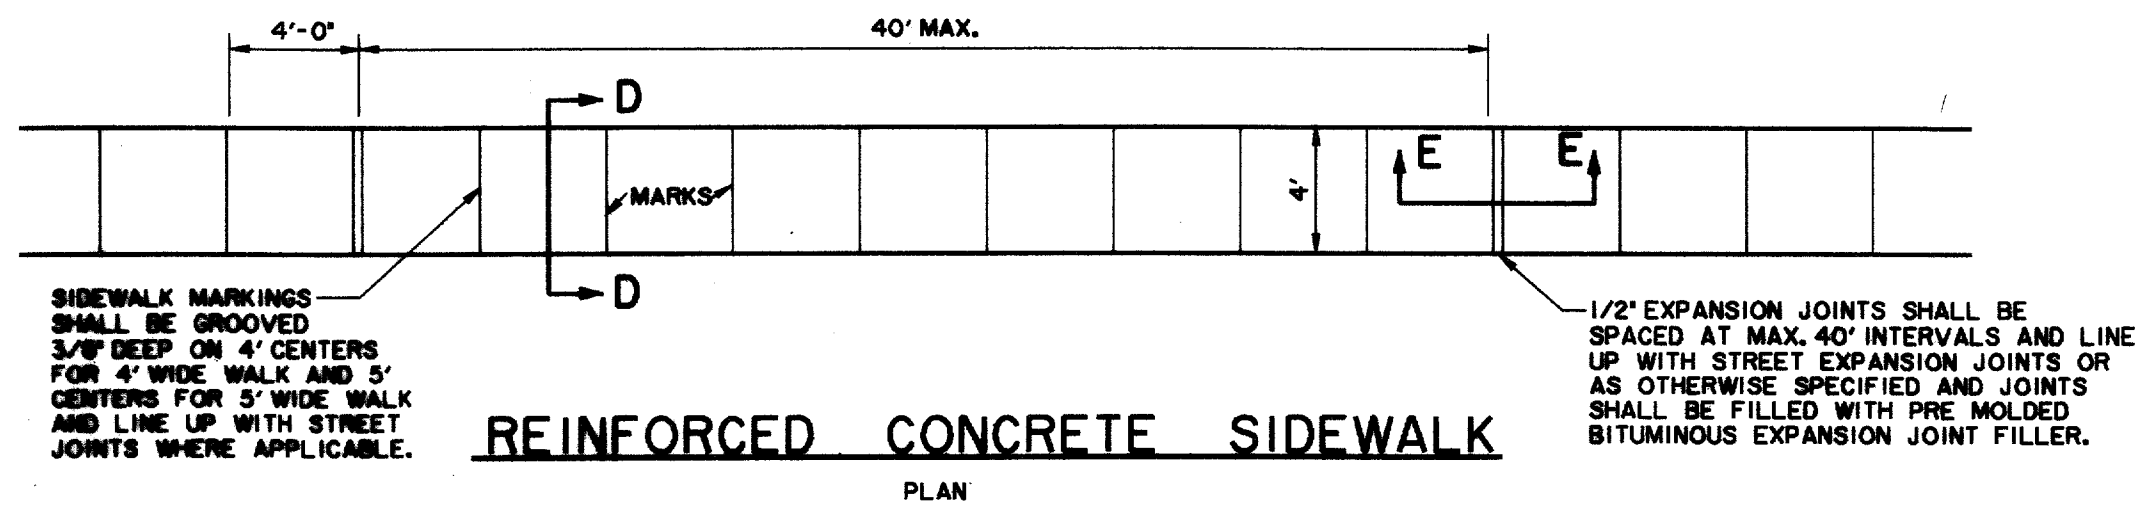


NOTE: CONCRETE TO HAVE MINIMUM 3000 P.S.I. COMPRESSIVE STRENGTH AT 28 DAYS AND MINIMUM CEMENT CONTENT OF 5 BAGS PER CUBIC YARD OF CONCRETE.

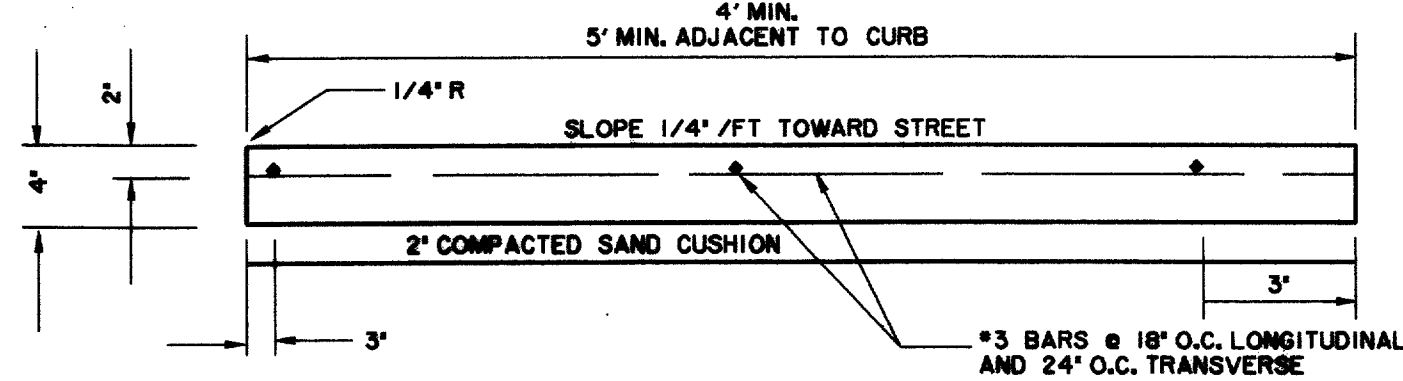


SECTION D-D
TYPICAL SECTION

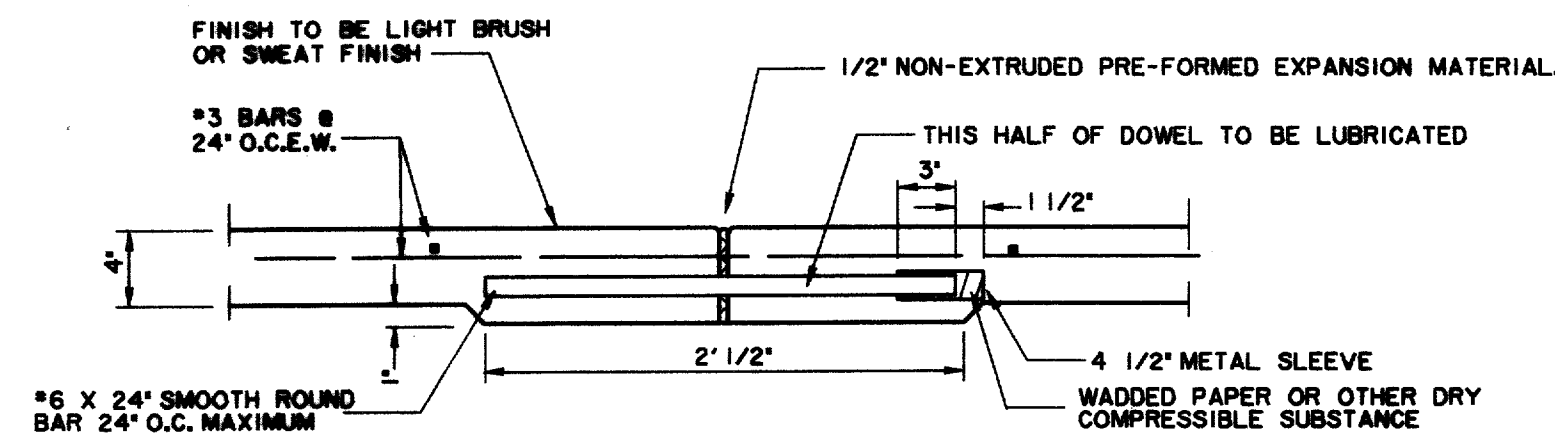


SECTION E-E
EXPANSION JOINT DETAIL

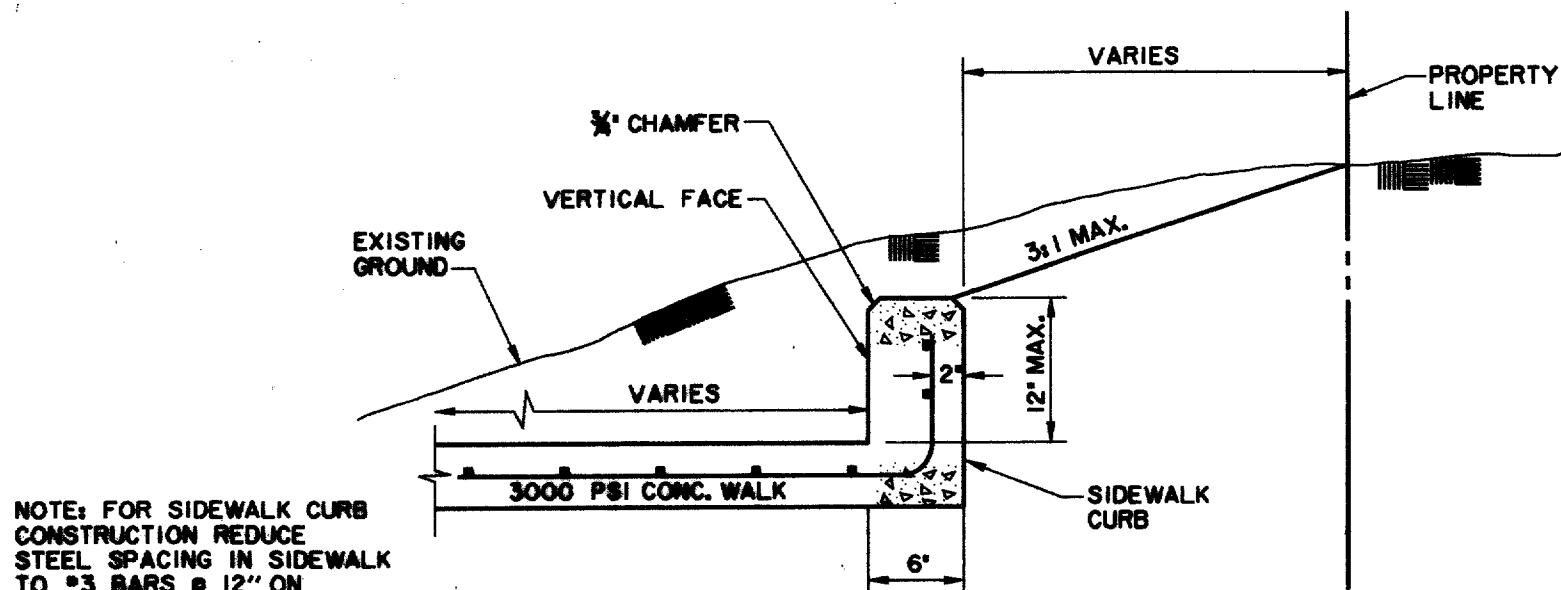

SIDEWALK CURB DETAIL

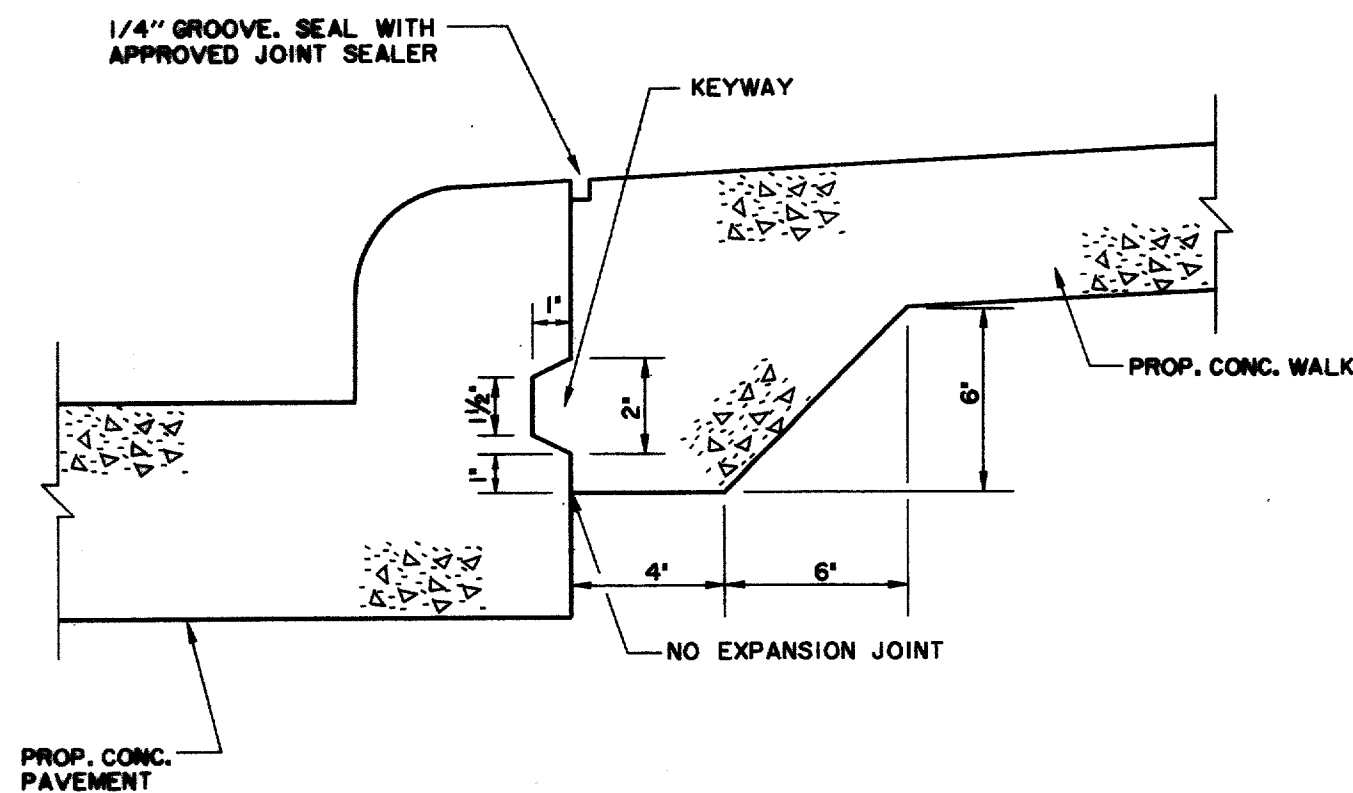


JOINT DETAIL FOR SIDEWALK
ADJACENT TO PROPOSED PAVEMENT

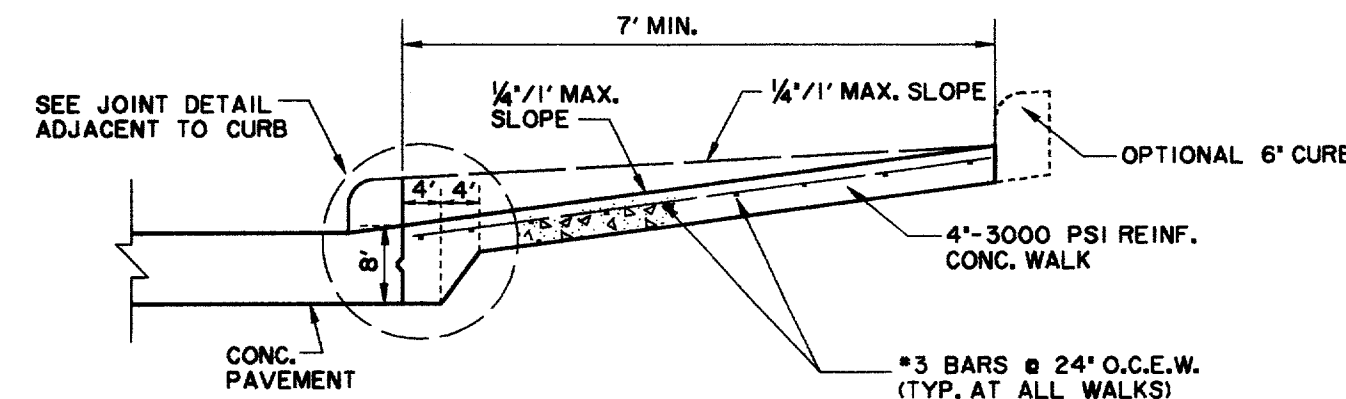


SECTION A-A


NOTES:
1. ALL HONEYCOMB IN BACK OF CURB TO BE TROWEL-PLASTERED BEFORE POURING SIDEWALK
2. LUG MAY BE FORMED BY SHAPING SUBGRADE TO APPROXIMATE DIMENSIONS SHOWN.

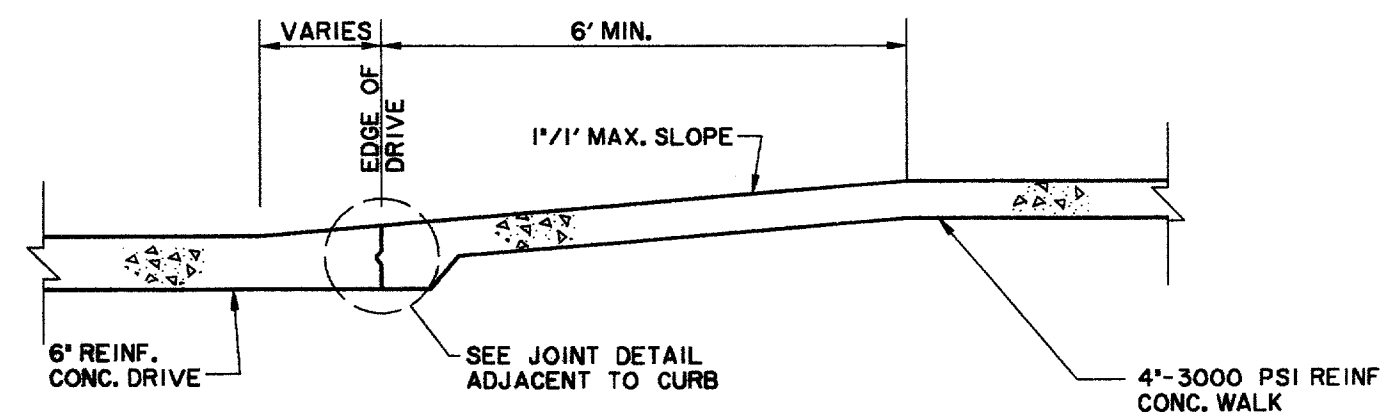


SECTION B-B

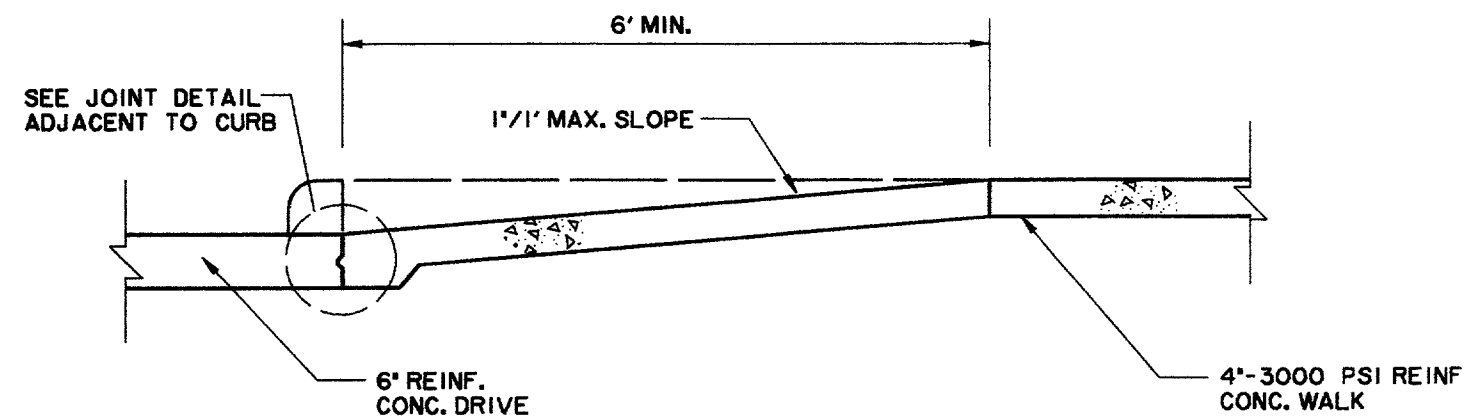


SECTION C-C

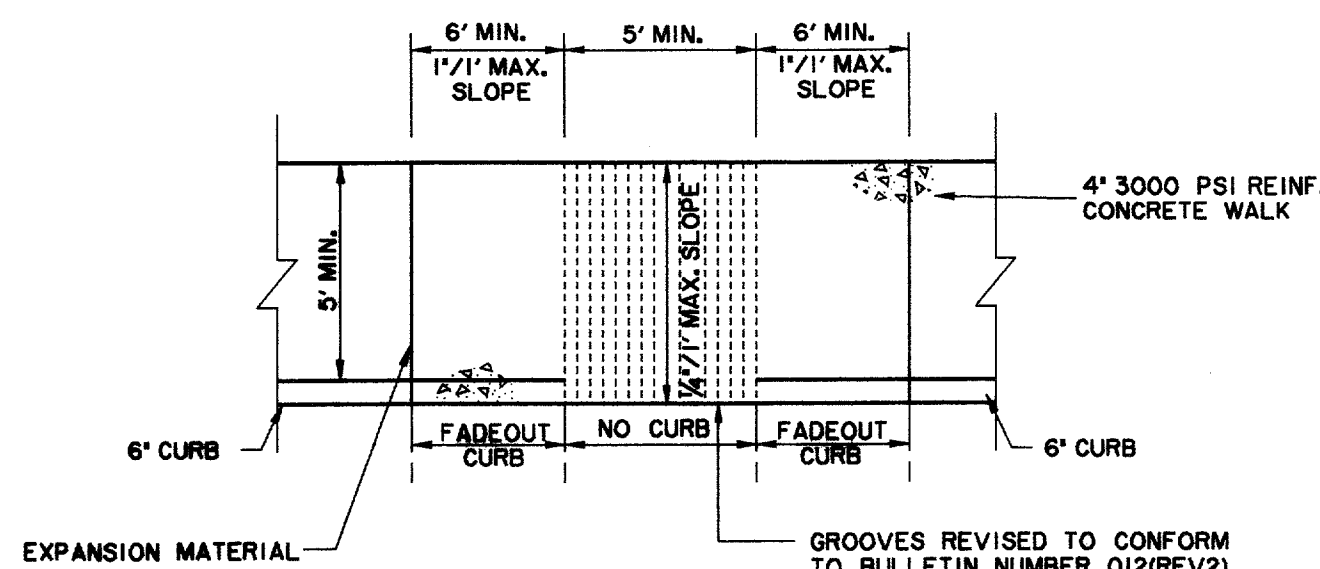

BARRIER FREE RAMP IN STRAIGHT CURB
SIDEWALK ADJACENT TO CURB

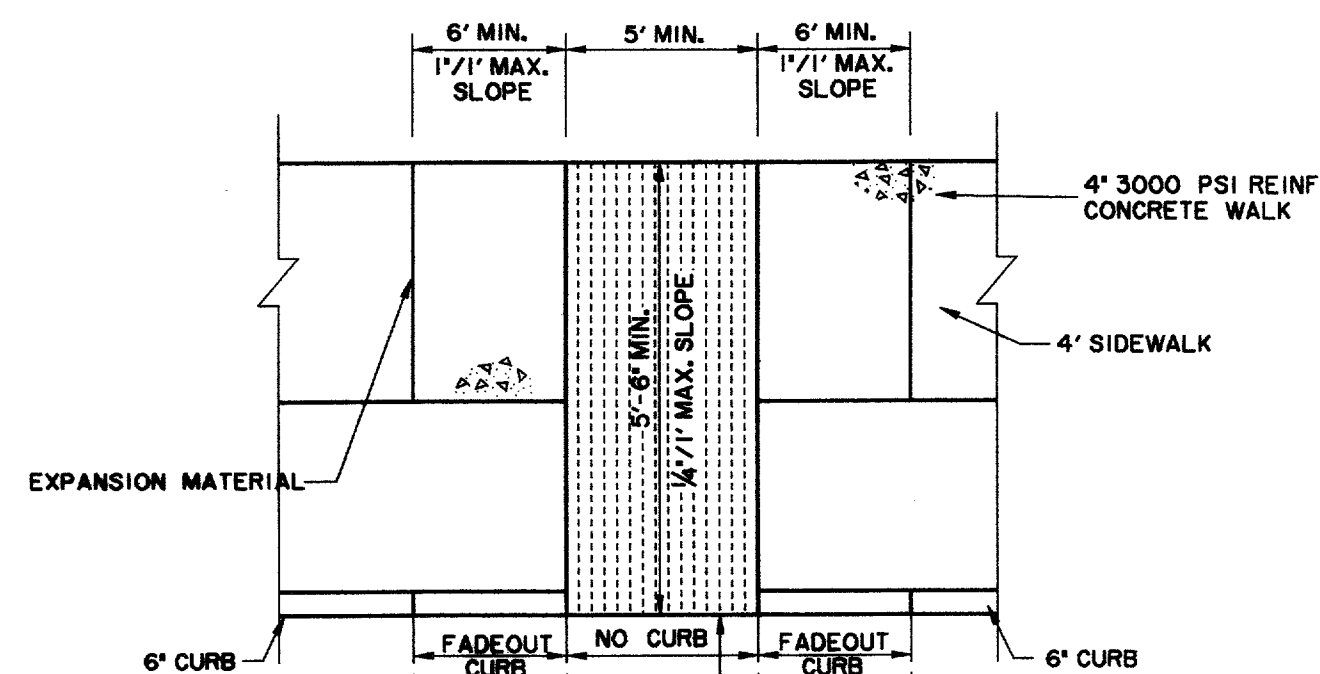


BARRIER FREE RAMP IN STRAIGHT CURB
SIDEWALK AWAY FROM CURB

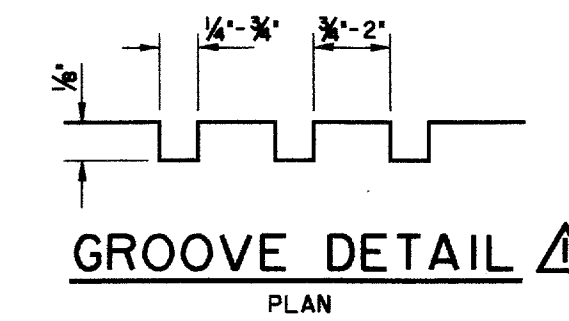


GROOVE DETAIL
PLAN


NOTE: ENTIRE BARRIER FREE RAMP AREA TO HAVE GROOVED TEXTURE.

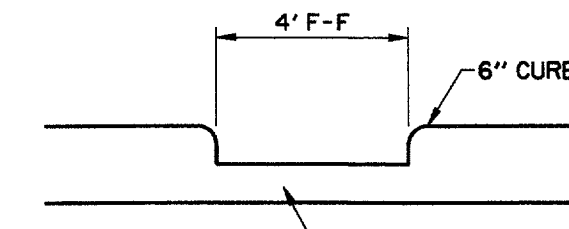


BARRIER FREE
WALK DETAIL

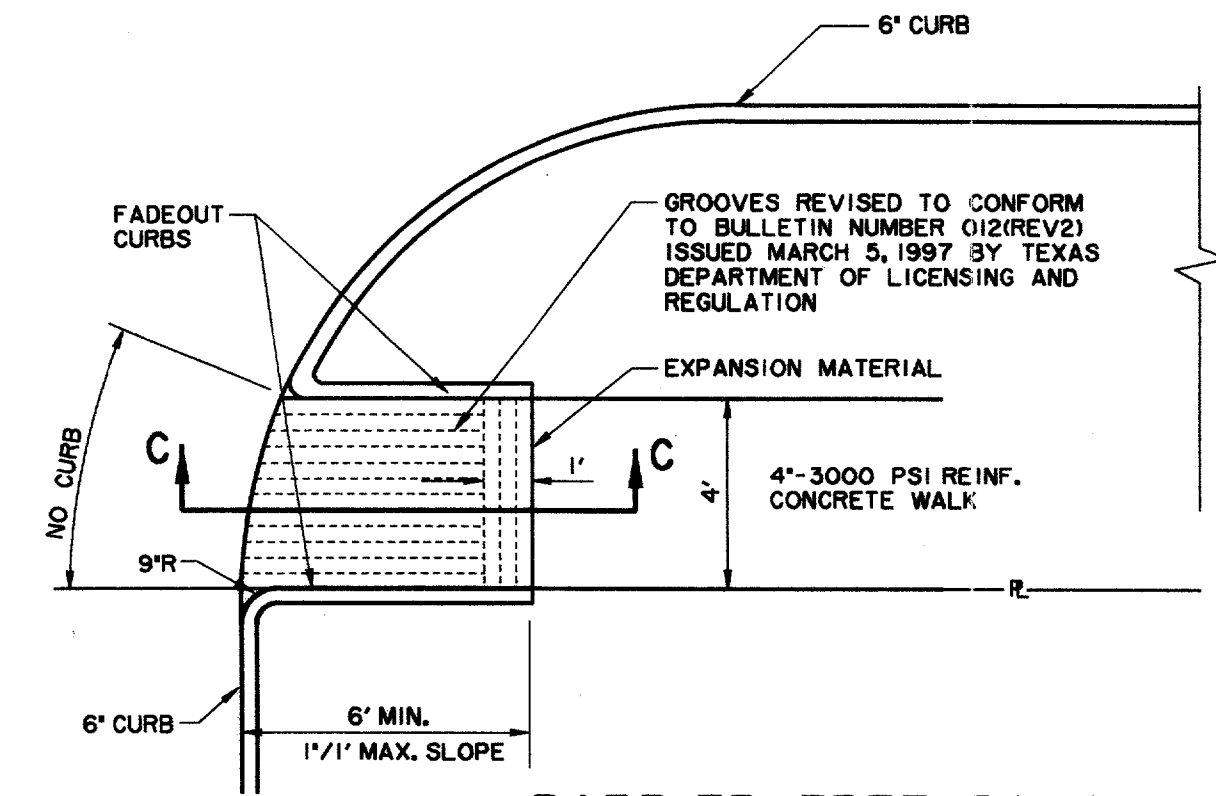

BARRIER FREE RAMP
AT CURBED DRIVE

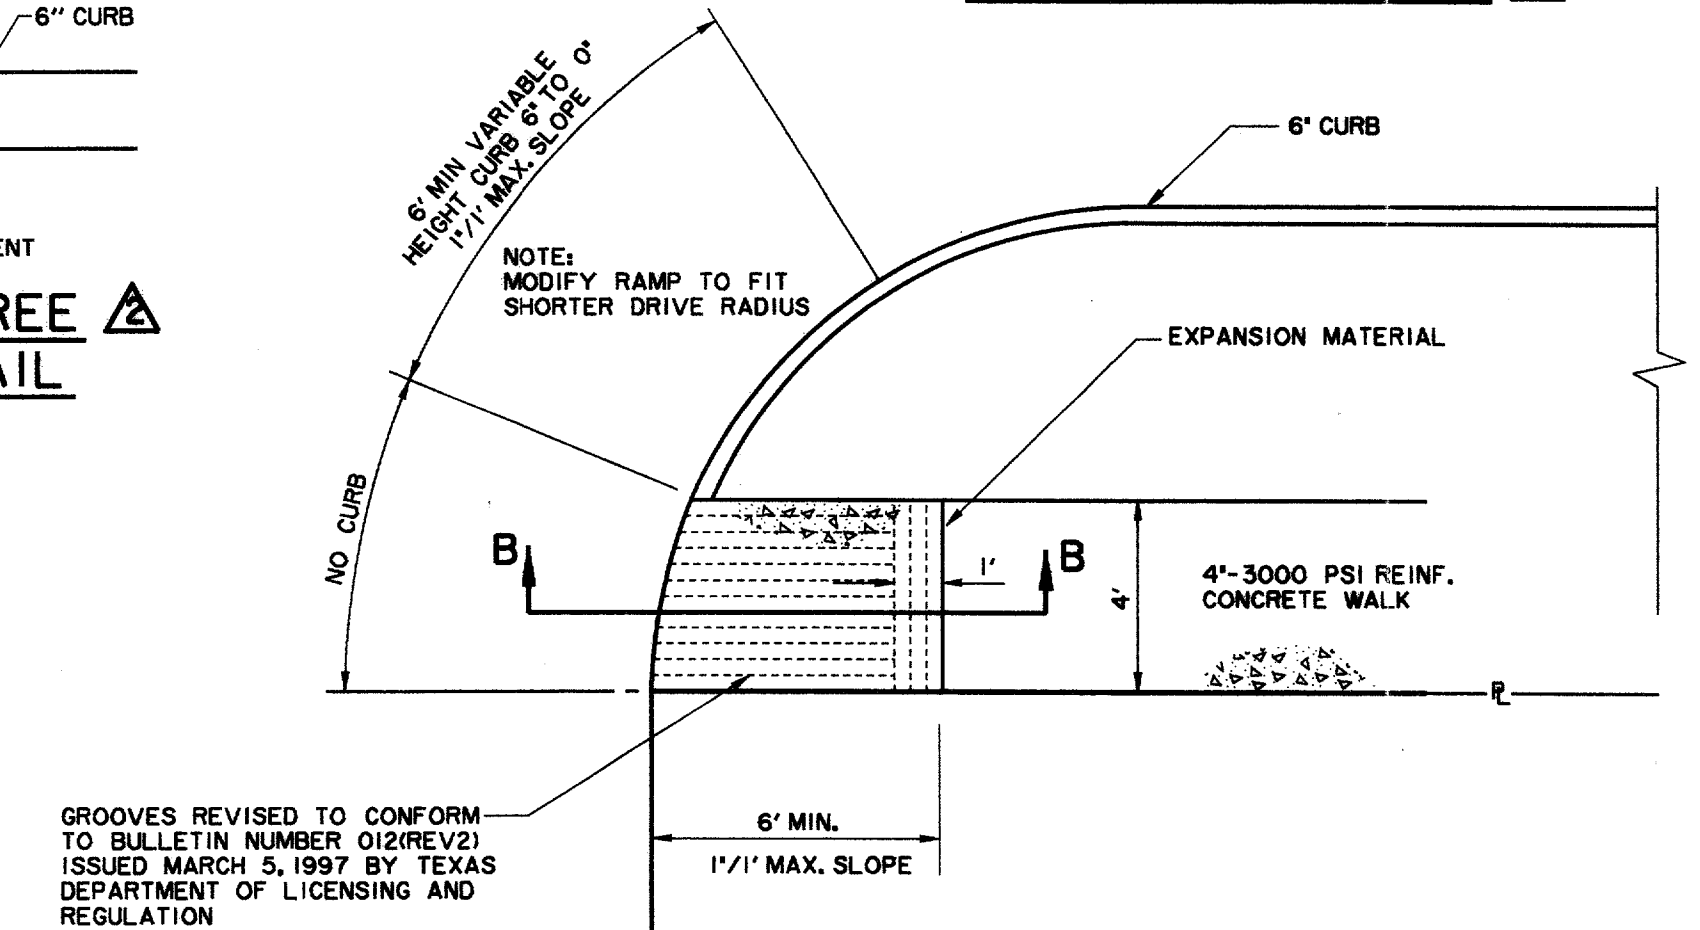

BARRIER FREE RAMP
AT DRIVE

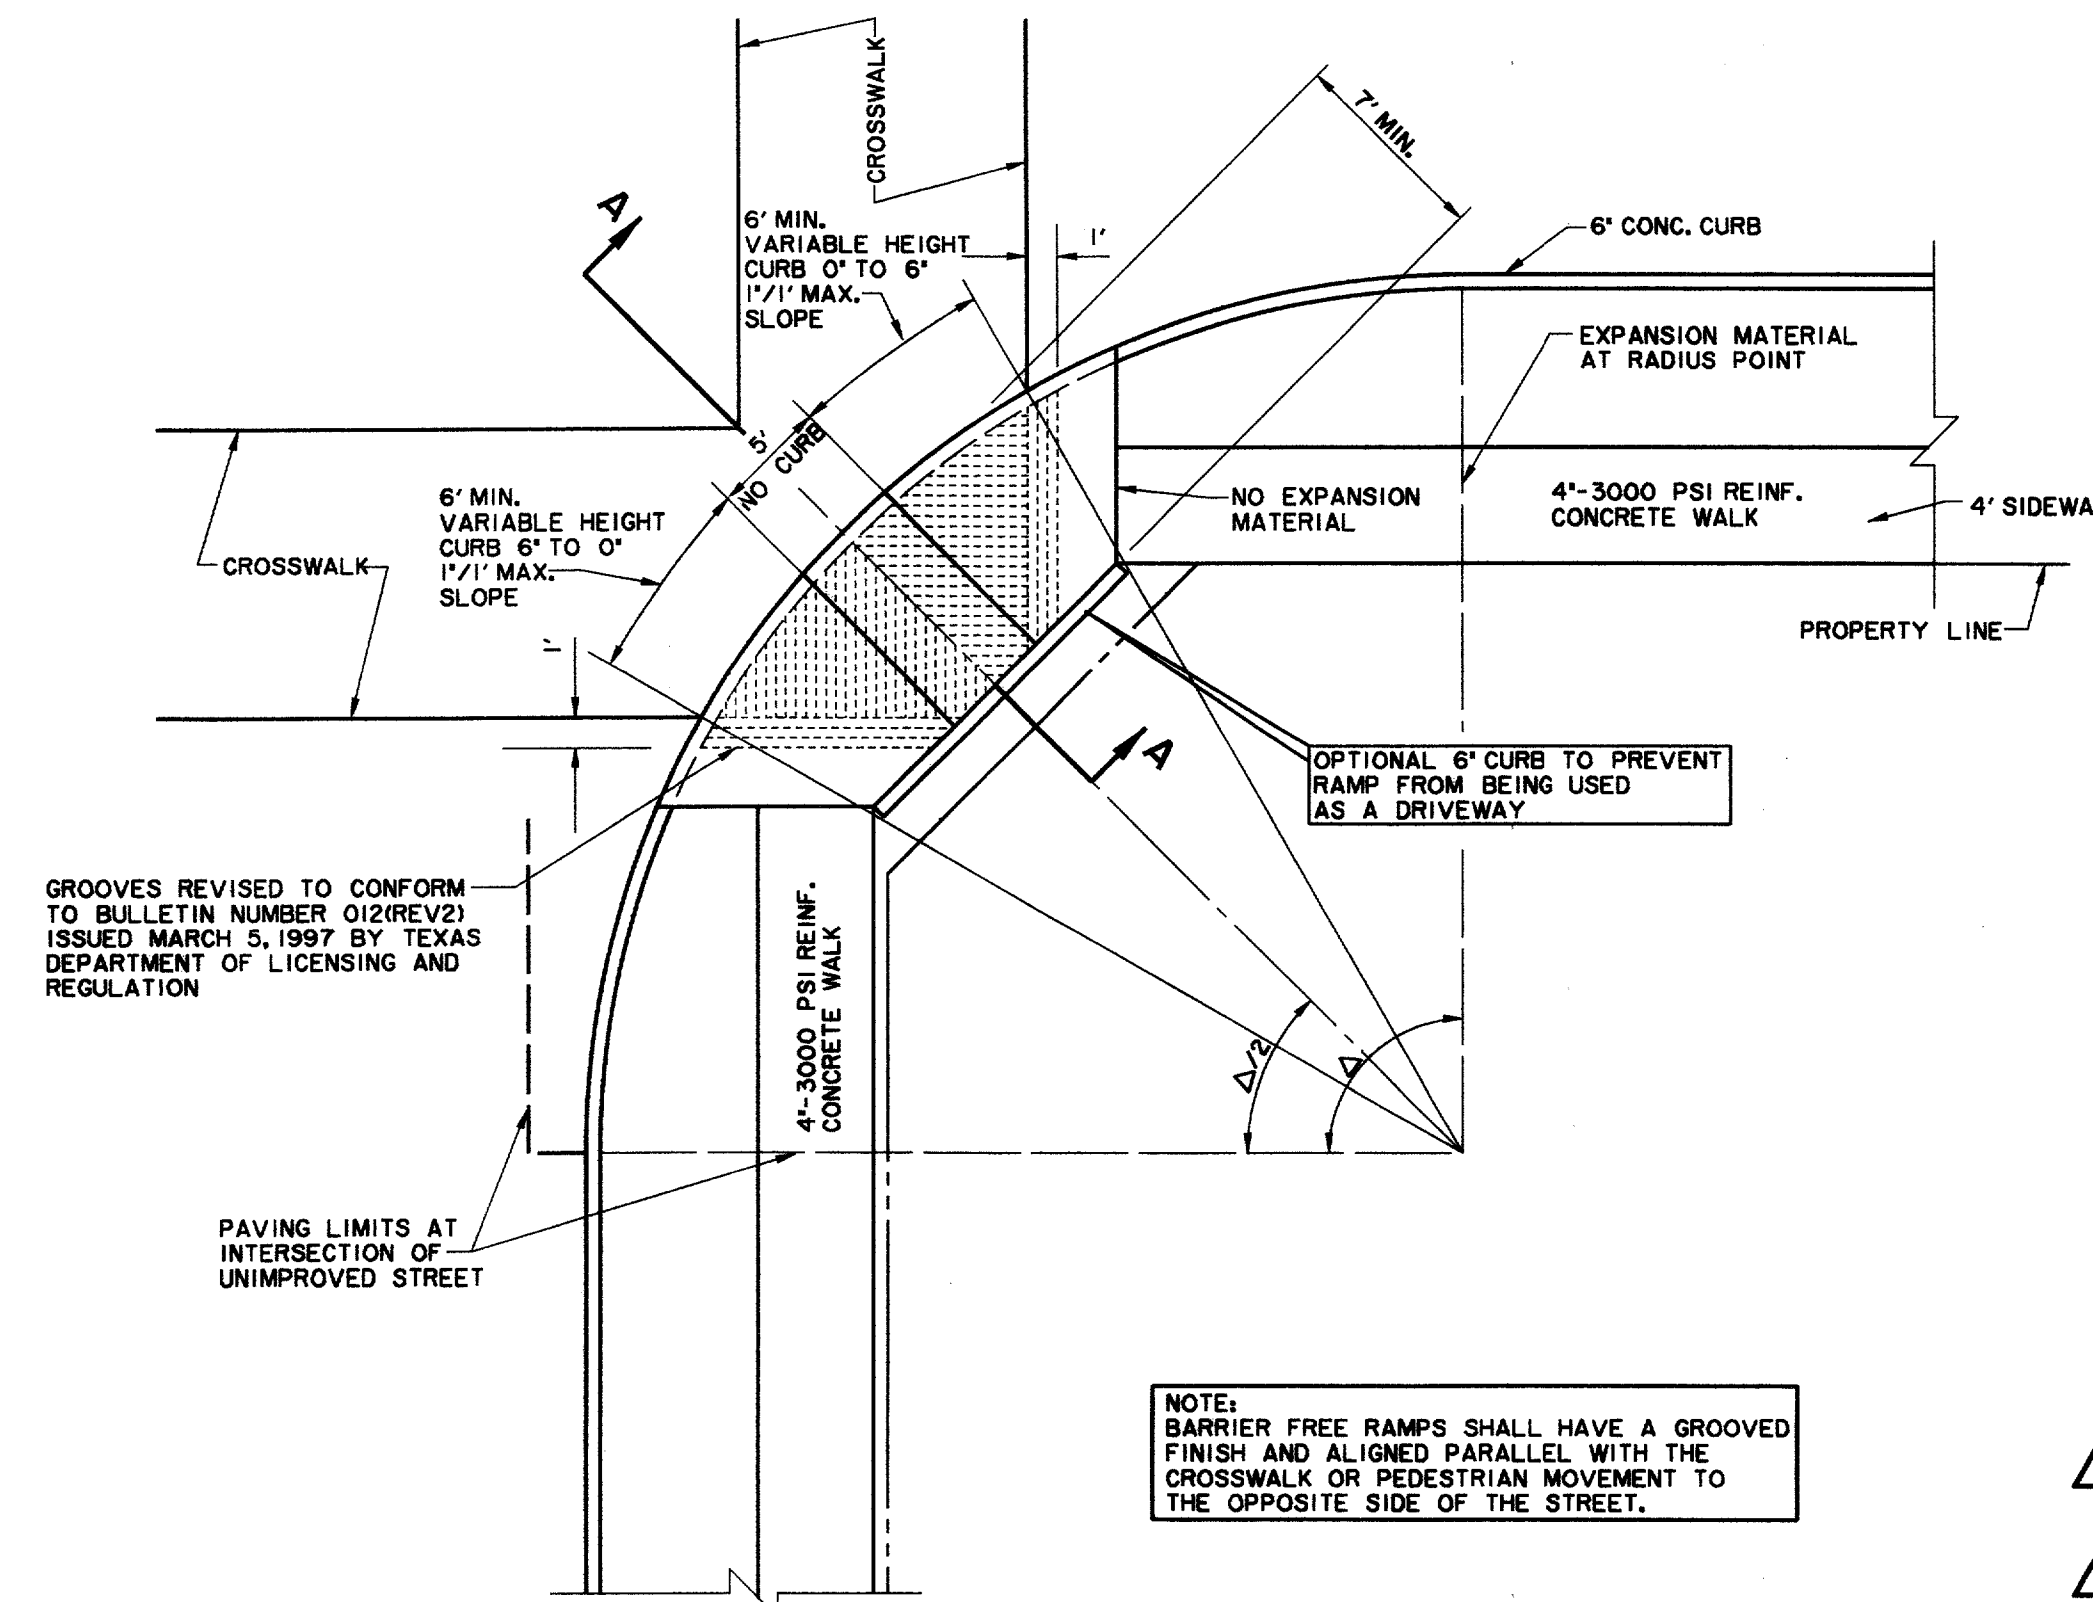

BARRIER FREE RAMP DETAIL
AT INTERSECTING STREET


**BARRIER FREE RAMP
GENERAL NOTES**

1. MAXIMUM SLOPE ON BARRIER FREE RAMPS MUST NOT EXCEED ONE INCH PER FOOT AT ANY LOCATION.
2. DESIGNS SHOWN ARE FOR 6\"/>

NOTE: BARRIER FREE RAMPS SHALL HAVE A GROOVED FINISH AND ALIGNED PARALLEL WITH THE CROSSWALK OR PEDESTRIAN MOVEMENT TO THE OPPOSITE SIDE OF THE STREET.

REVISÉ
1/16/98
ADDENDUM #2,
11/18/97


THE SEAL APPEARING ON THIS DOCUMENT WAS AUTHORIZED BY KENNETH A. ROBERTS, P.E. 55446 ON OCTOBER 24, 1997

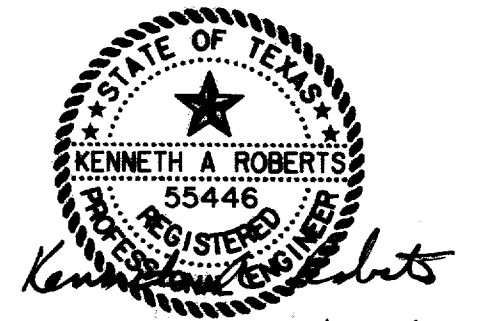


SIDEWALK & B.F. RAMP DETAILS						
ARAPAHO ROAD						
ADDISON ROAD TO DALLAS NORTH TOLLWAY						
TOWN OF ADDISON, TEXAS						
Huitt-Zollars, Inc./Consulting Engineers Dallas, Fort Worth, Houston, Phoenix, Tustin						
DESIGN	DRAWN	APPR.	SCALE	DATE	PROJECT NO.	NO.
HZI	HZI	KAR	N.T.S.	OCT 97	1772-01	P-14

RECORD DOCUMENTS 6/9/2000



THESE RECORD DOCUMENTS HAVE BEEN PREPARED BASED ON INFORMATION PROVIDED BY OTHERS. THE CONSULTANT HAS NOT VERIFIED THE ACCURACY AND/OR COMPLETENESS OF THIS INFORMATION AND SHALL NOT BE RESPONSIBLE FOR ANY ERRORS OR OMISSIONS THAT MAY BE INCORPORATED AS A RESULT OF ERRONEOUS INFORMATION PROVIDED BY OTHERS.

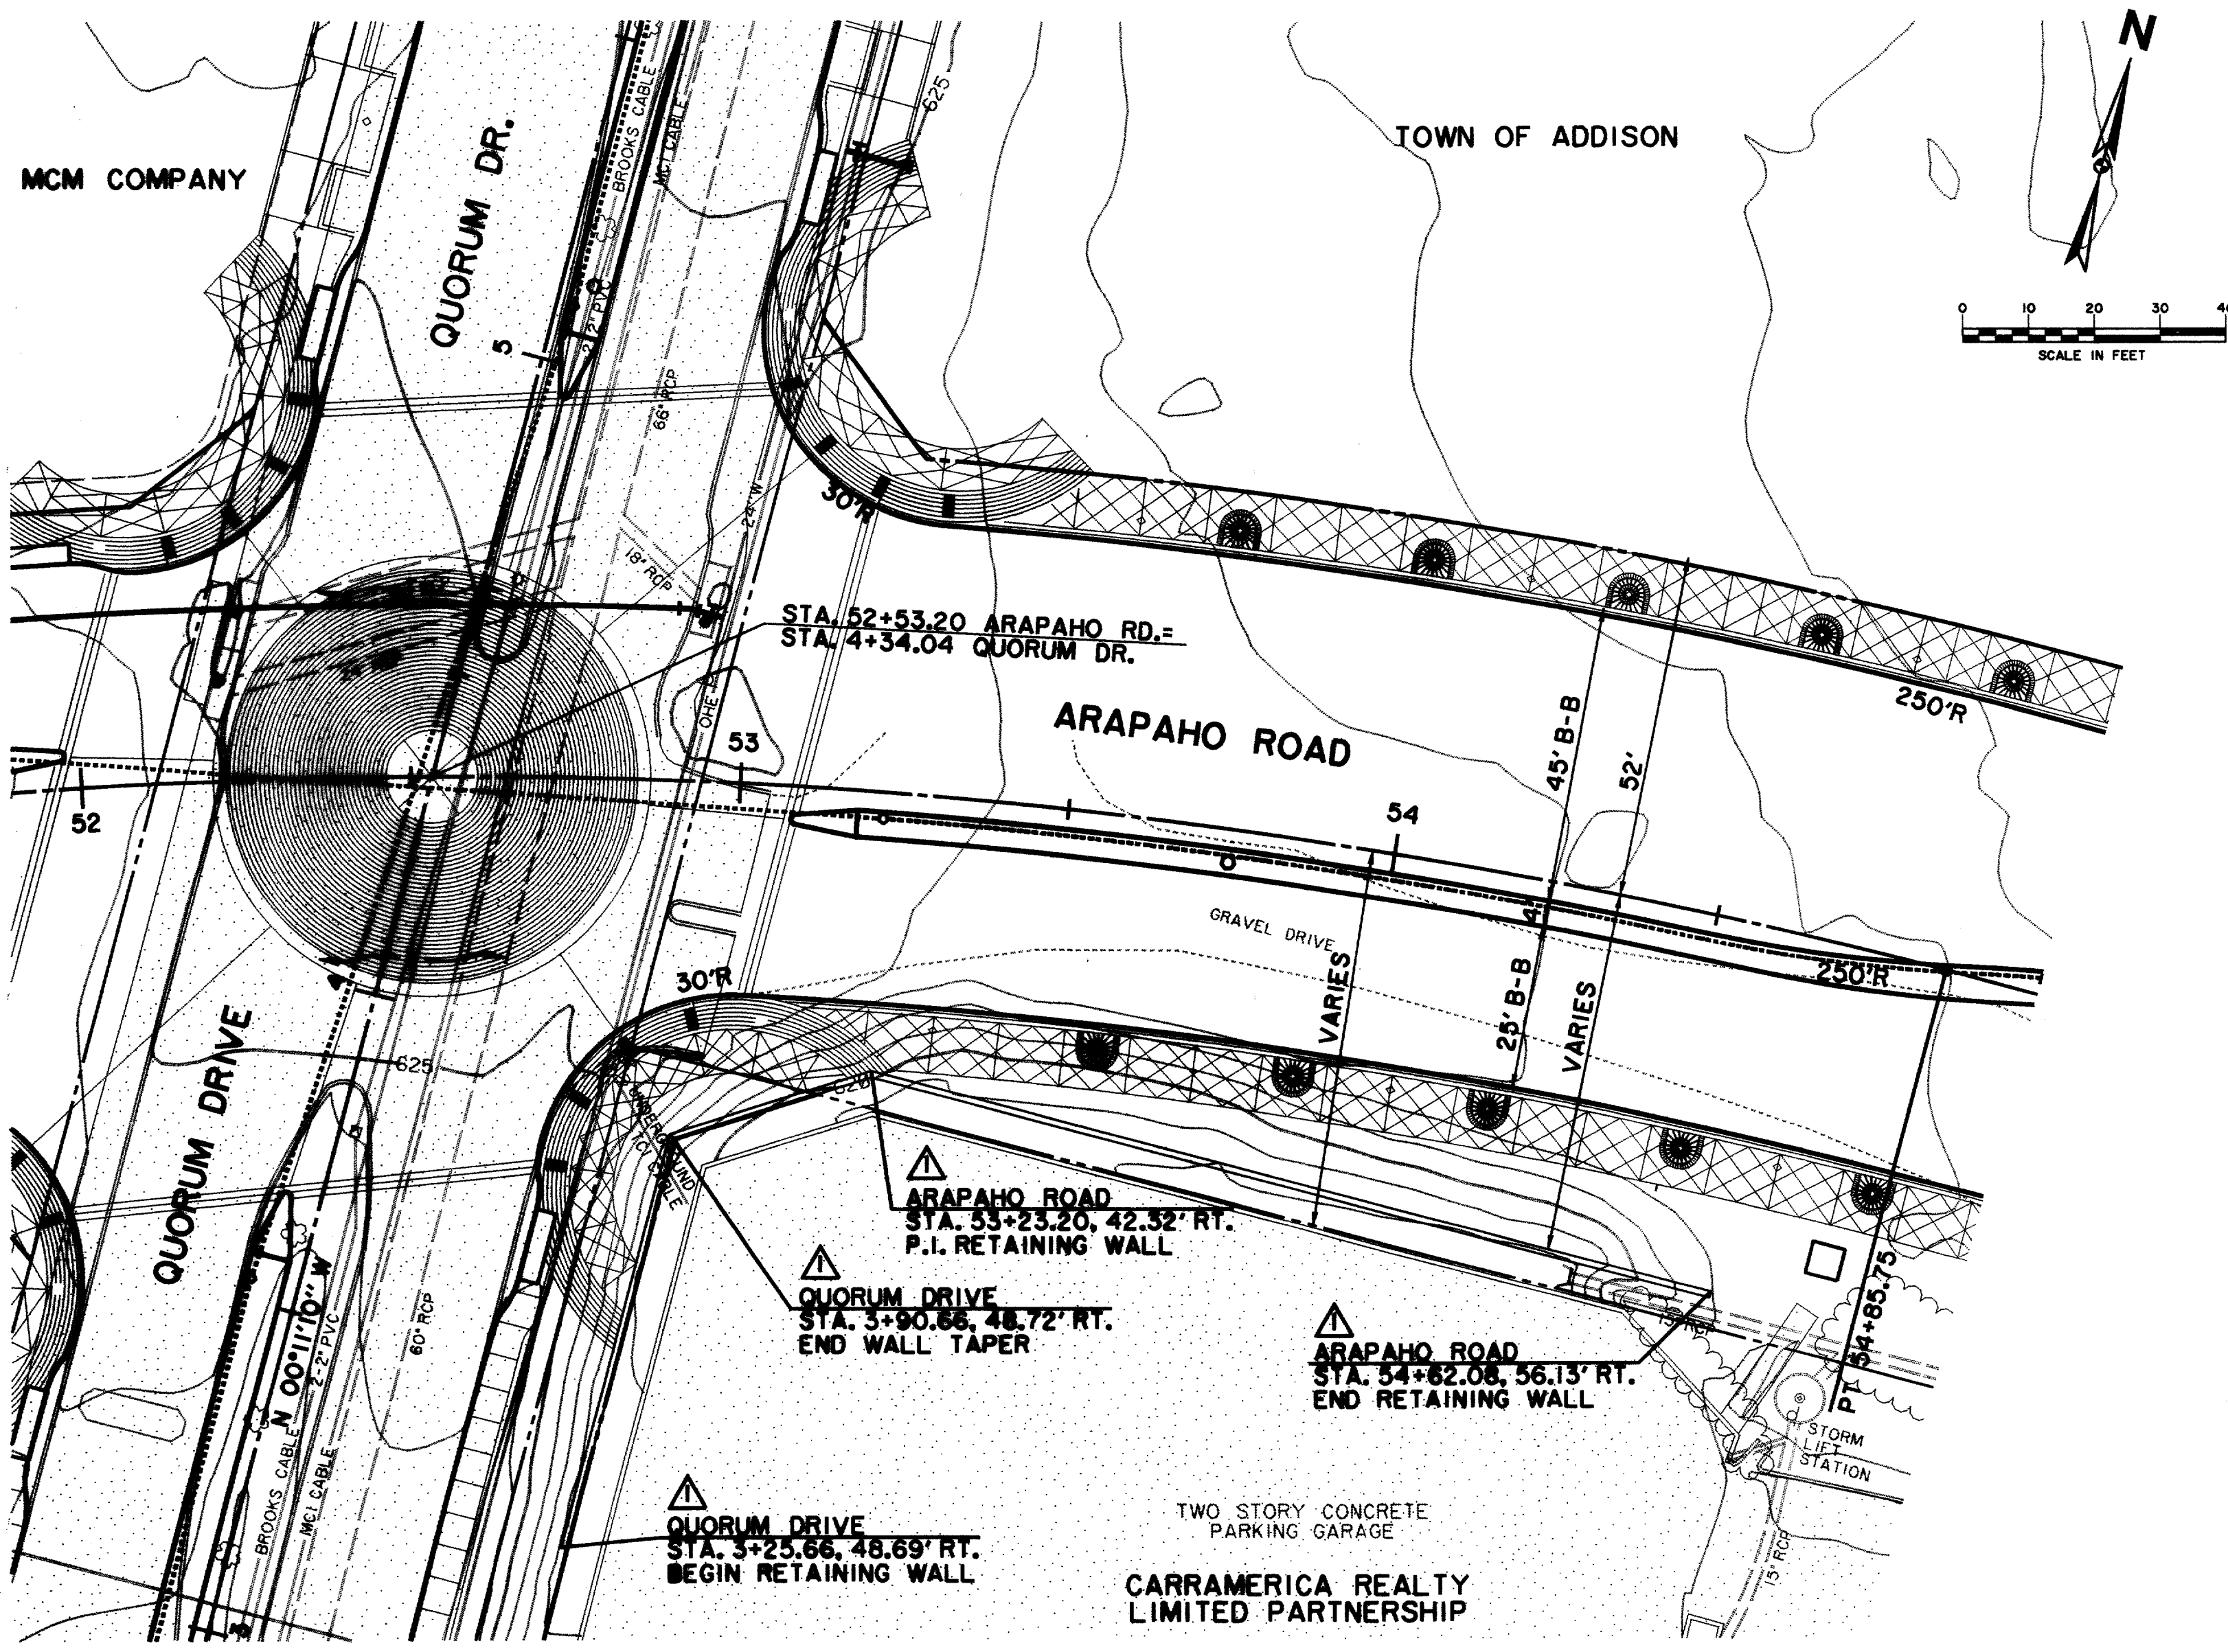

- GENERAL NOTES:**
1. SELECT FILL MATERIAL SHALL CONSIST OF INORGANIC NONEXPANSIVE SOIL OR ROCK WITH A PLASTICITY INDEX BETWEEN 4 AND 12. THE MATERIAL SHALL BE FREE OF CLAY LUMPS, ROCKS IN EXCESS OF 4 INCHES IN DIAMETER, AND OTHER DELETERIOUS MATERIAL.
 2. SELECT MATERIAL SHALL BE PLACED IN LOOSE LIFTS NOT TO EXCEED 8 INCHES IN THICKNESS AND COMPACTED TO BETWEEN 95% AND 100% OF STANDARD PROCTOR DENSITY AT OPTIMUM MOISTURE CONTENT (-0% + 3%).
 3. THE COMPACTION OF BACKFILL WITHIN 5'-0" OF WALL SHALL BE ACHIEVED USING HAND COMPACTION EQUIPMENT.
 4. REINFORCING STEEL SHALL BE NEW DOMESTIC DEFORMED BILLET STEEL CONFORMING TO ASTM A-615, GRADE 60.
 5. DETAIL REINFORCING BARS AND PROVIDE BAR SUPPORTS AND SPACES IN ACCORDANCE WITH THE LATEST EDITION OF THE ACI DETAILING MANUAL.
 6. REINFORCING BARS SHALL BE SUPPORTED, SPACED AND ACCURATELY SECURED IN PLACE BY BOLSTERS, SPACERS OR CHAIRS IN ACCORDANCE WITH SPECIFICATIONS FOR PLACING REINFORCEMENTS OF THE ACI "MANUAL OF STANDARD PRACTICE FOR DETAILING REINFORCED CONCRETE STRUCTURES".
 7. ALL REINFORCING STEEL SHALL BE LAPPED A MINIMUM OF 36 BAR DIAMETERS AT ALL CORNERS AND AT ALL SPLICE POINTS UNLESS OTHERWISE NOTED.
 8. FIVE TO SEVEN PERCENT AIR ENTRAINMENT SHALL BE ADDED TO CONCRETE USED FOR STRUCTURAL ELEMENTS EXPOSED TO WEATHER, UNLESS SPECIFIED OTHERWISE ON THE PLANS.
 9. CHAMFER ALL EXPOSED CORNERS 3/4" INCHES
 10. CONCRETE FOR ALL RETAINING WALLS AND JUNCTION STRUCTURES SHALL BE CLASS "C" WITH A MINIMUM COMPRESSIVE STRENGTH OF 3600 PSI AT 28 DAYS.
 11. WHERE INDICATED ON THE DRAWINGS, ROUGHENED SURFACES SHALL BE PROVIDED BY MEANS OF HEAVY RAKING OR GROOVING TO A FULL AMPLITUDE OF 1/4" INCH. ALL INTERFACING SURFACES MUST BE CLEAN AND FREE OF LAITANCE.
 12. ALL ITEMS TO BE CAST IN CONCRETE SUCH AS REINFORCING, DOWELS, BOLTS, ANCHORS, PIPE SLEEVES, ETC., SHALL BE SURELY POSITIONED IN THE FORMS BEFORE PLACING CONCRETE.
 13. THE KEYWAY AND FOOTING SHALL BE POURED DIRECTLY AGAINST UNDISTURBED SOIL WITHIN 48 HOURS AFTER EXCAVATION.
 14. ALL EXPOSED SURFACES ON THE RETAINING WALL SHALL BE STAINED WITH A WATER REPELLANT (PIGMENTED) STAIN MANUFACTURED BY UNITED COATINGS, EAST 19011 CATALDO, GREENACRES, WA 99016 OR APPROVED EQUAL. COLOR SELECTION SHALL BE APPROVED BY THE OWNER PRIOR TO APPLICATION.

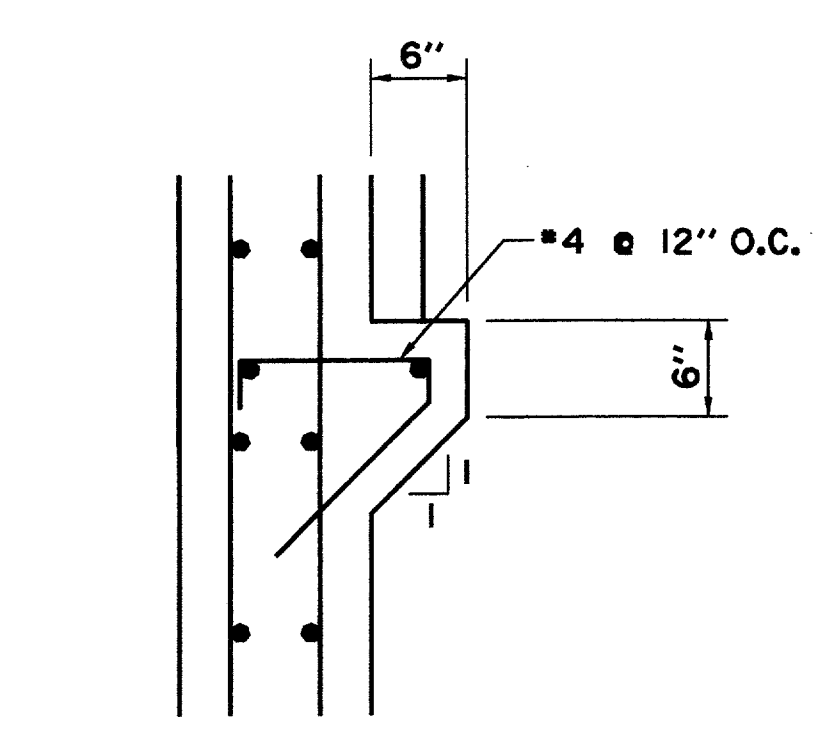

BRICK LEDGE DETAIL
SCALE: 1" = 1'-0"

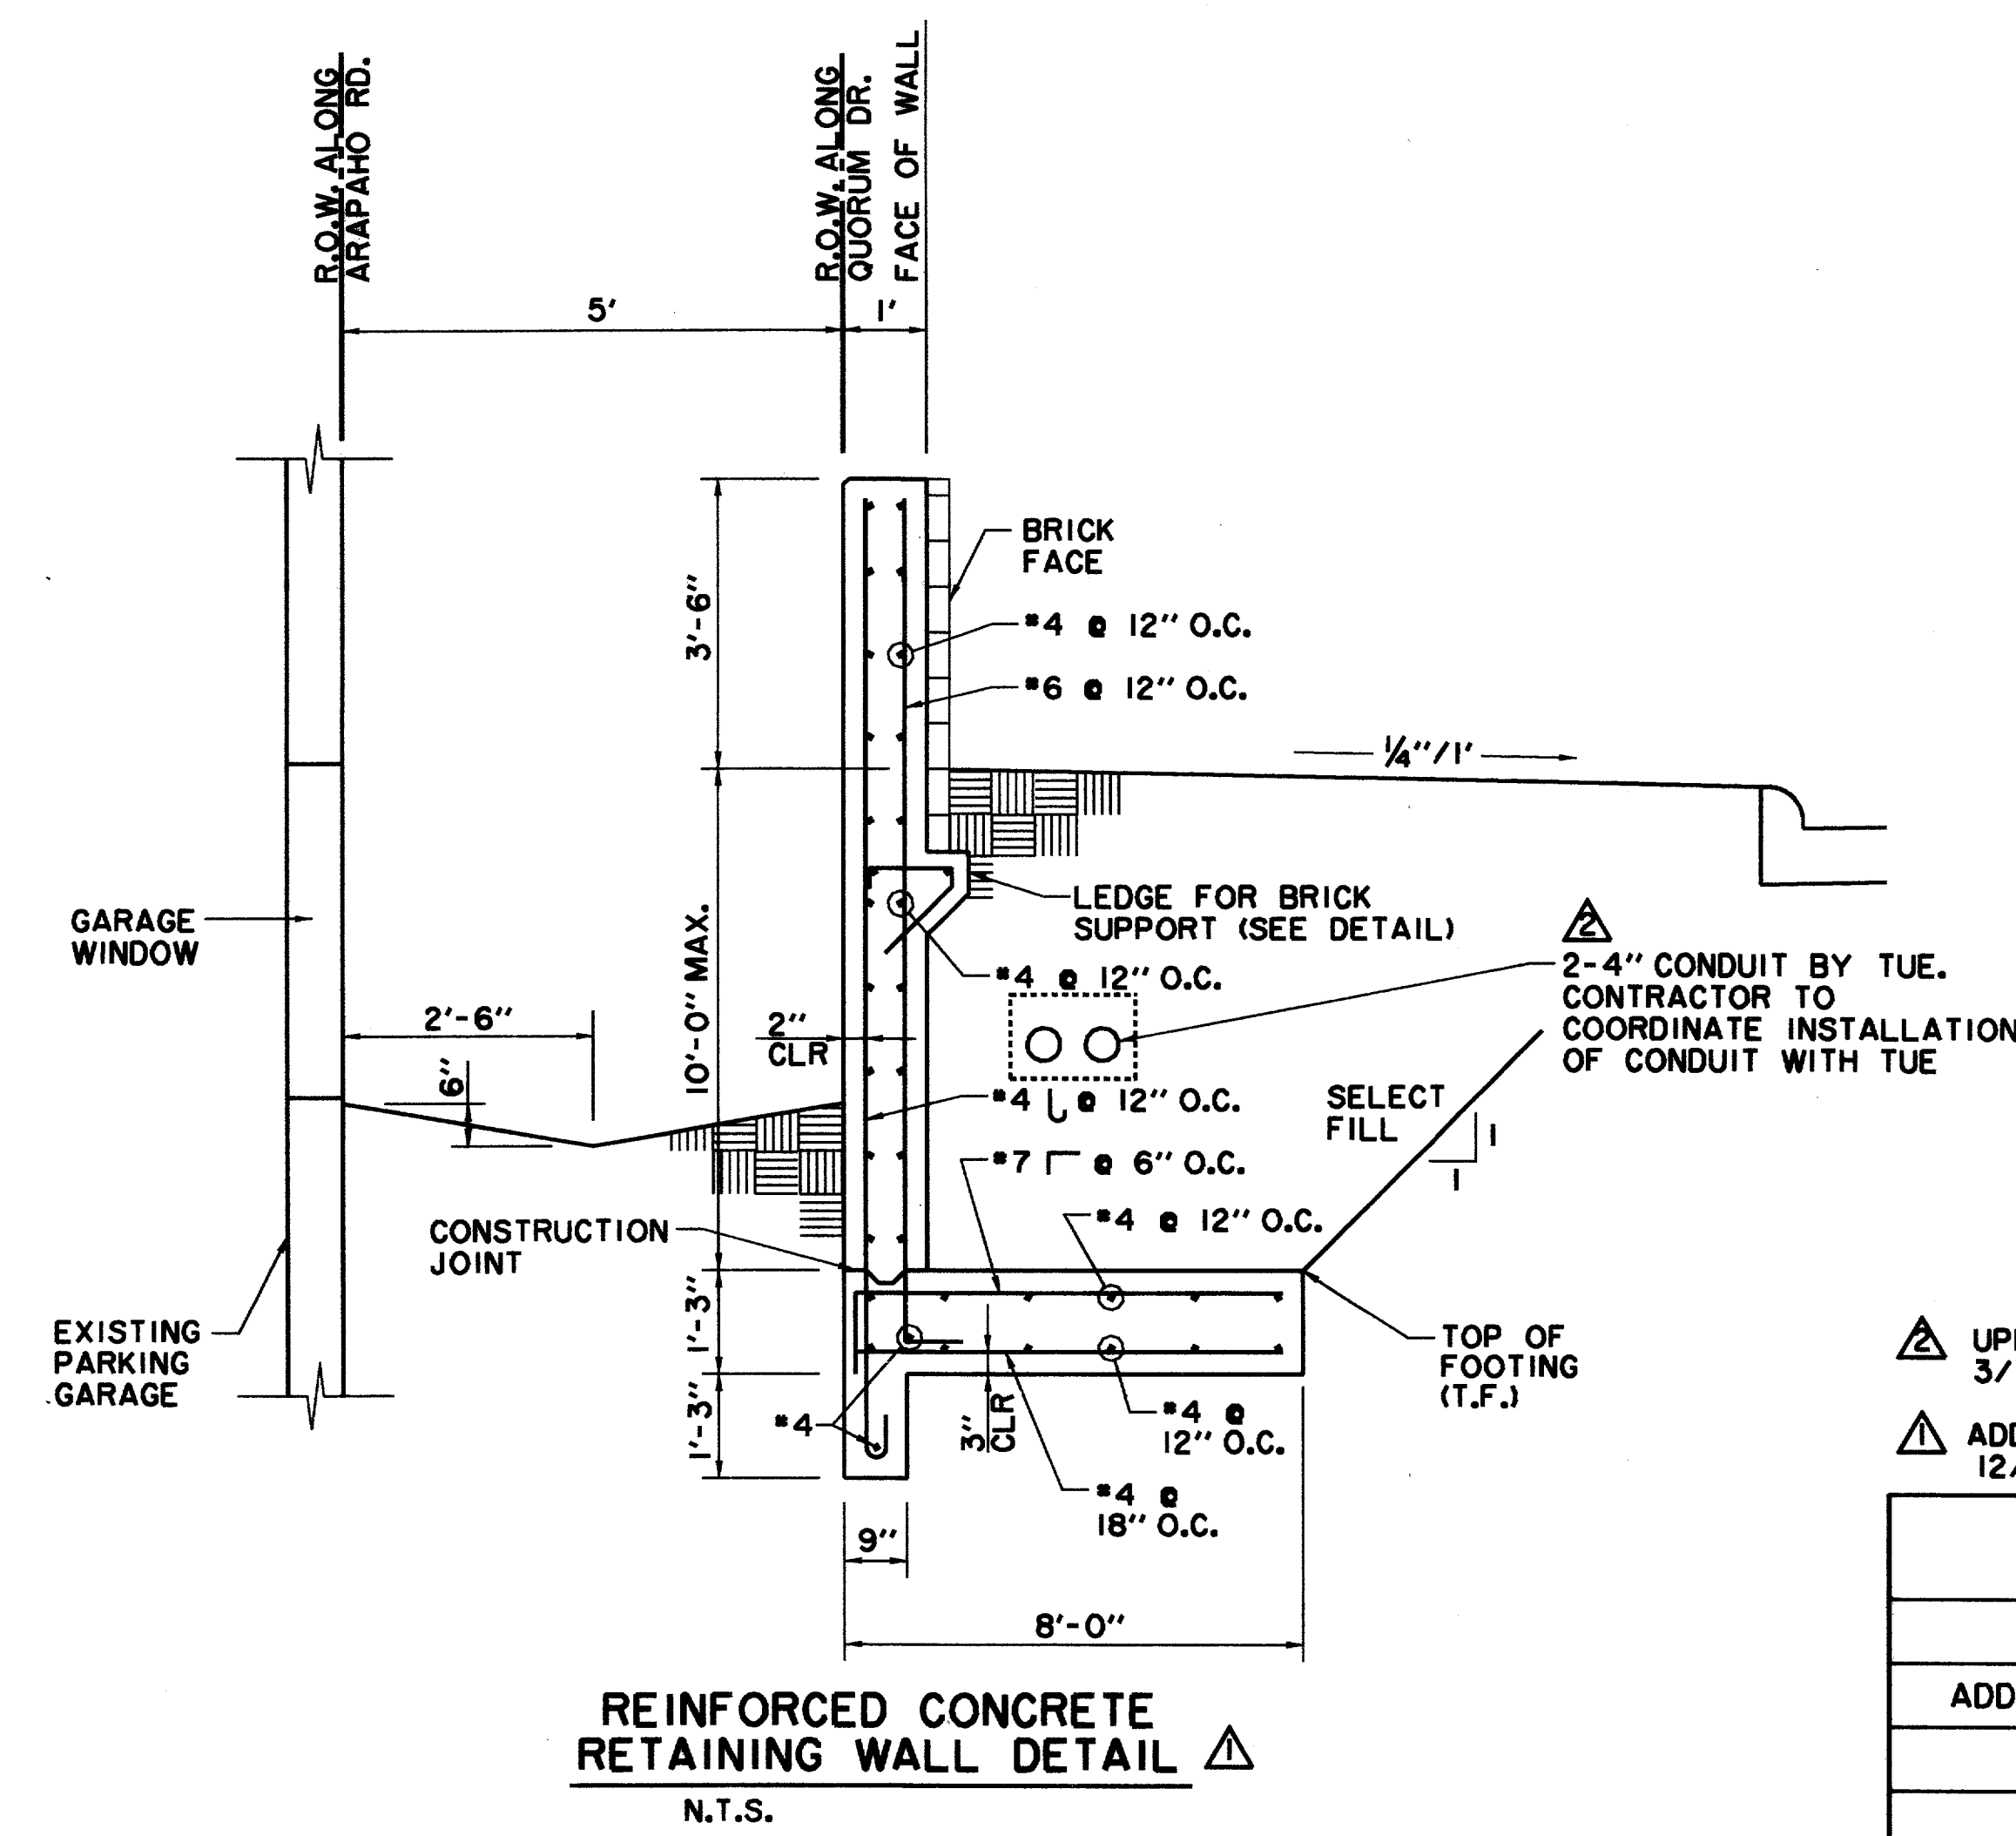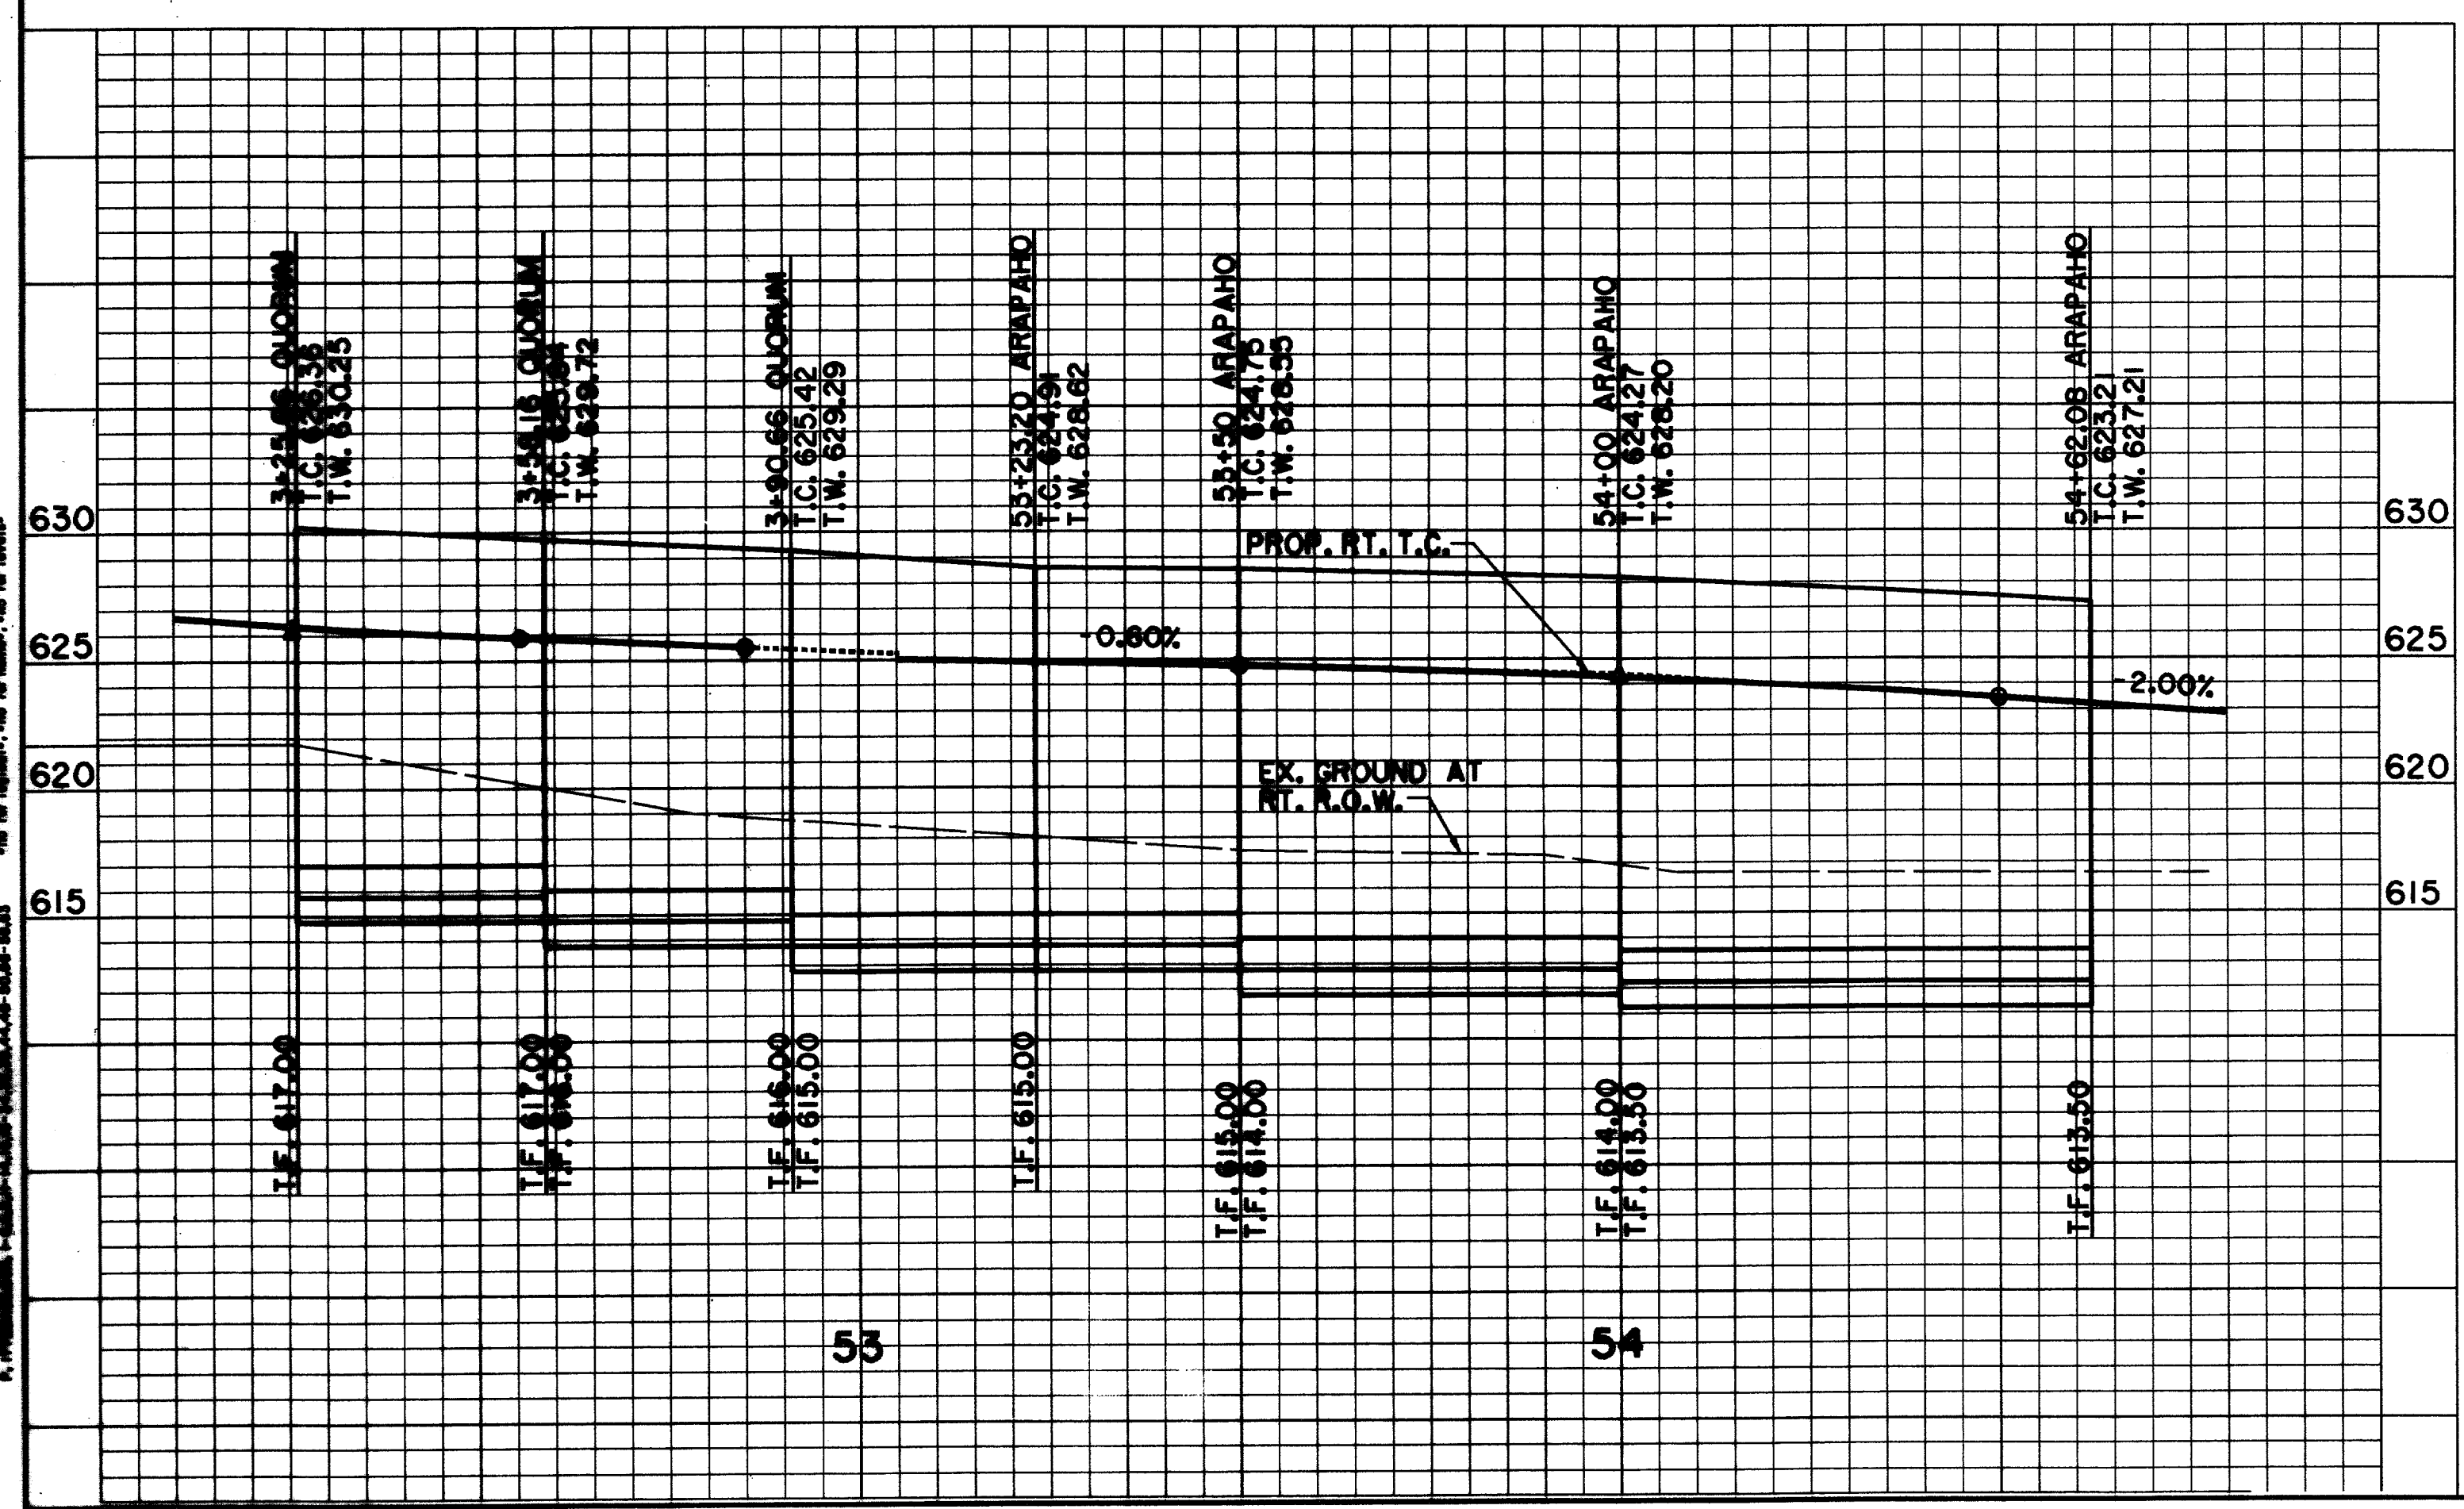

REINFORCED CONCRETE RETAINING WALL DETAIL
N.T.S.

RECORD DOCUMENTS 6/9/2000


THESE RECORD DOCUMENTS HAVE BEEN PREPARED BASED ON INFORMATION PROVIDED BY OTHERS. THE CONSULTANT HAS NOT VERIFIED THE ACCURACY AND/OR COMPLETENESS OF THIS INFORMATION AND SHALL NOT BE RESPONSIBLE FOR ANY ERRORS OR OMISSIONS THAT MAY BE INCORPORATED AS A RESULT OF ERRONEOUS INFORMATION PROVIDED BY OTHERS.

BENCHMARKS:





USC & GS E-921 DISK IN BRICK WALL OF OLD ADDISON SCHOOL HOUSE (MAGIC TIME MACHINE RESTAURANT) ON SOUTH WALL, 4' EAST OF CENTER OF THE ENTRANCE, 4.7' ABOVE THE GROUND, ELEV. 650.61

'I' ON SOUTHEAST CORNER OF CONCRETE WALK AT FRONT ENTRANCE TO 4805 ARAPAHO ROAD, ELEV. 630.61

△ UPDATED 3/16/98
△ ADDENDUM #4, 12/19/97

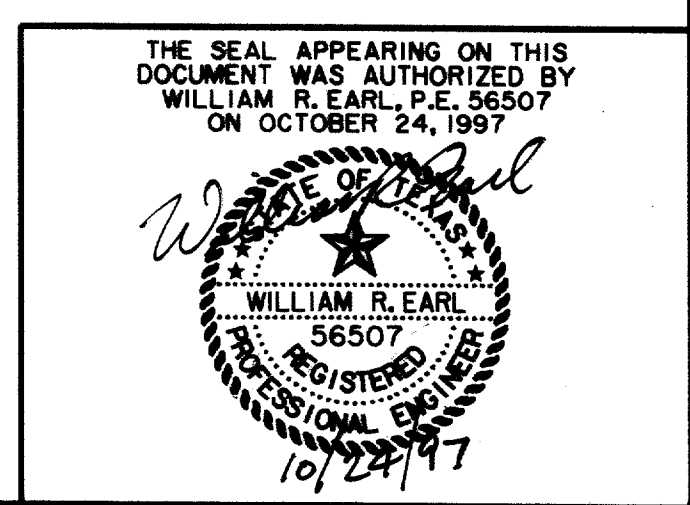


RETAINING WALL PLAN, PROFILE & DETAILS						
ARAPAHO ROAD						
ADDISON ROAD TO DALLAS NORTH TOLLWAY						
TOWN OF ADDISON, TEXAS						
Huff-Zollars, Inc./Consulting Engineers Dallas, Fort Worth, Houston, Phoenix, Tucson						
DESIGN	DRAWN	APPR.	SCALE	DATE	PROJECT NO.	NO.
HZI	HZI	WRE	H _v 1"=20' V _h 1"=6'	OCT 97	1772-01	P-15

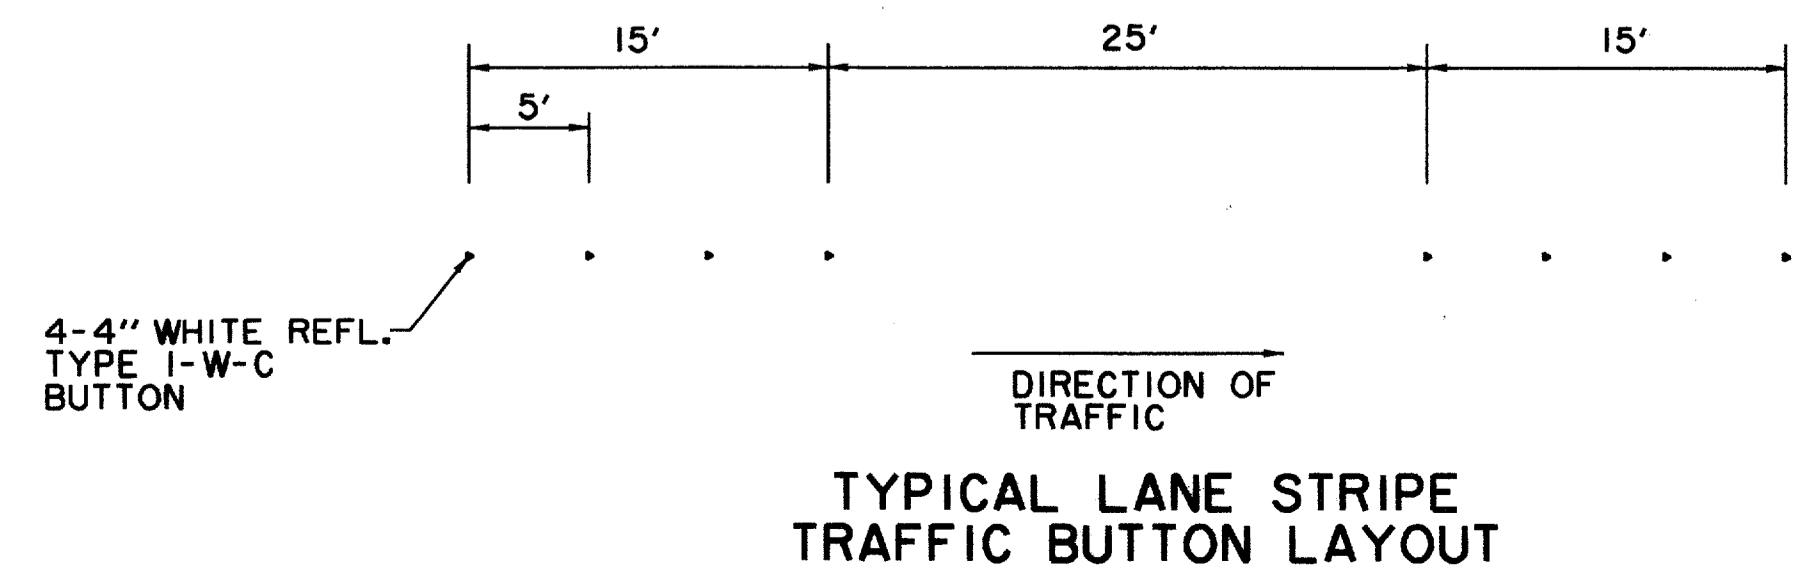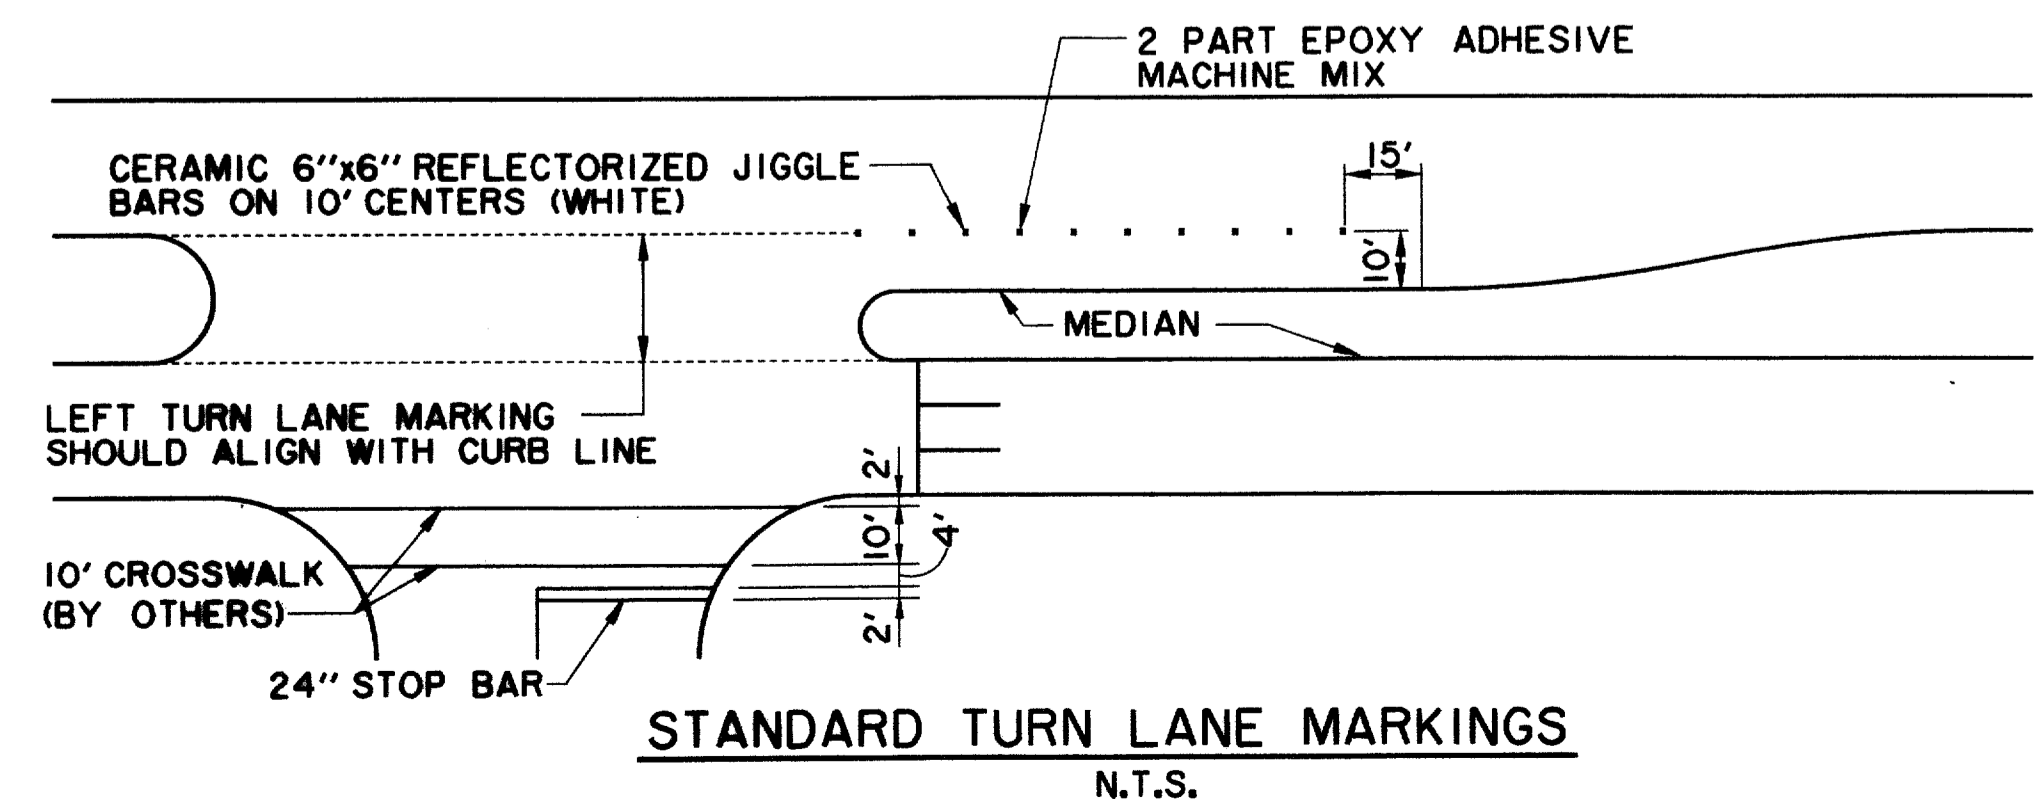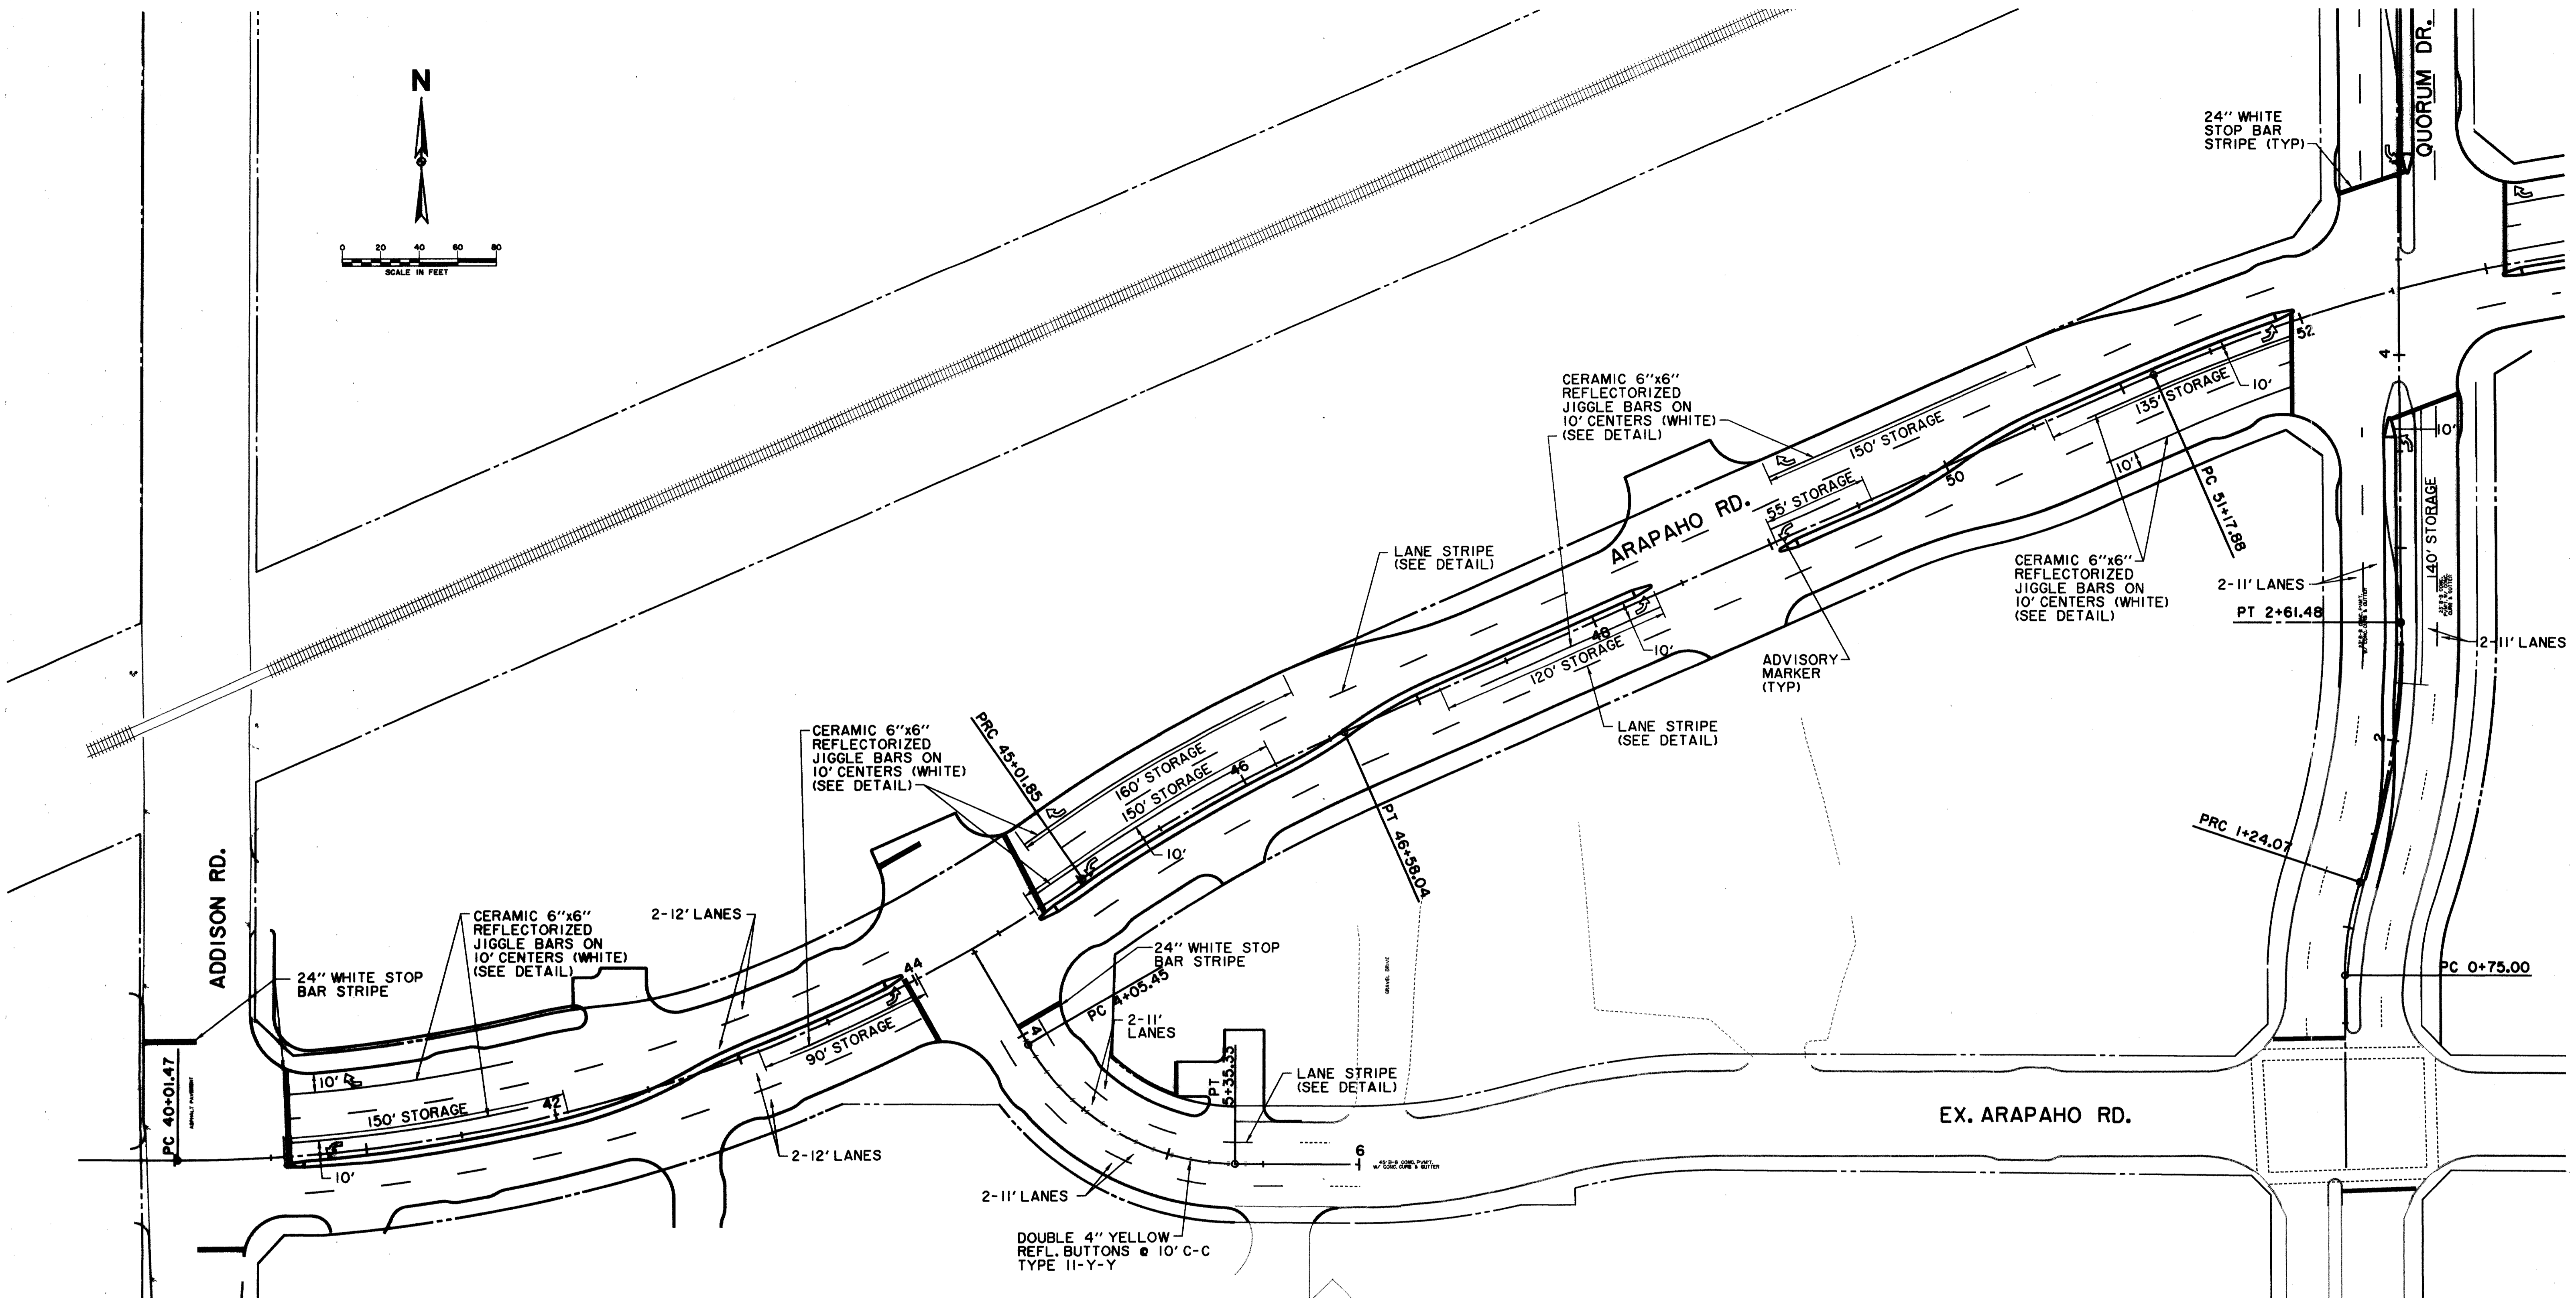
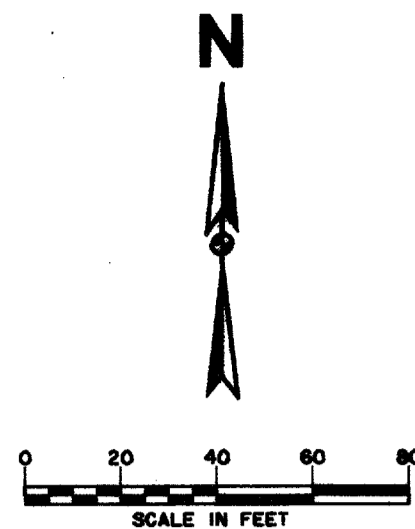


RECORD DOCUMENTS 6/9/2000

THESE RECORD DOCUMENTS HAVE BEEN PREPARED BASED ON INFORMATION PROVIDED BY OTHERS. THE CONSULTANT HAS NOT VERIFIED THE ACCURACY AND/OR COMPLETENESS OF THIS INFORMATION AND SHALL NOT BE RESPONSIBLE FOR ANY ERRORS OR OMISSIONS THAT MAY BE INCORPORATED AS A RESULT OF ERRONEOUS INFORMATION PROVIDED BY OTHERS.

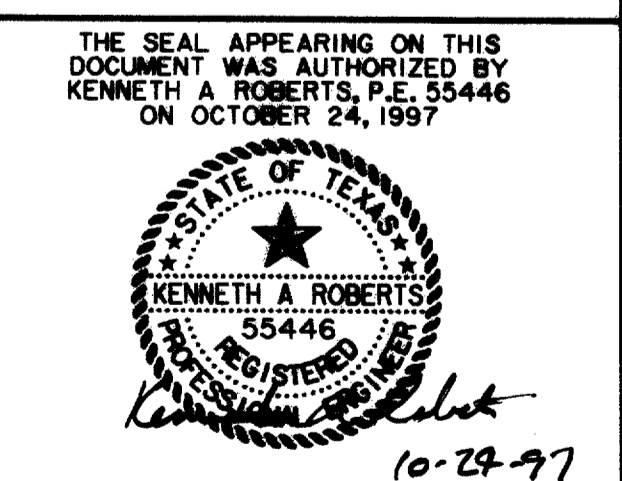

STRIPING PLAN						
ADDISON ROAD TO QUORUM DRIVE						
ARAPAHO ROAD						
ADDISON ROAD TO DALLAS NORTH TOLLWAY						
TOWN OF ADDISON, TEXAS						
Huitt-Zollars, Inc./Consulting Engineers Dallas, Fort Worth, Houston, Phoenix, Tustin						
DESIGN	DRAWN	APPR.	SCALE	DATE	PROJECT NO.	NO.
HZI	HZI	KAR	1"=40'	OCT 97	1772-01	P-16

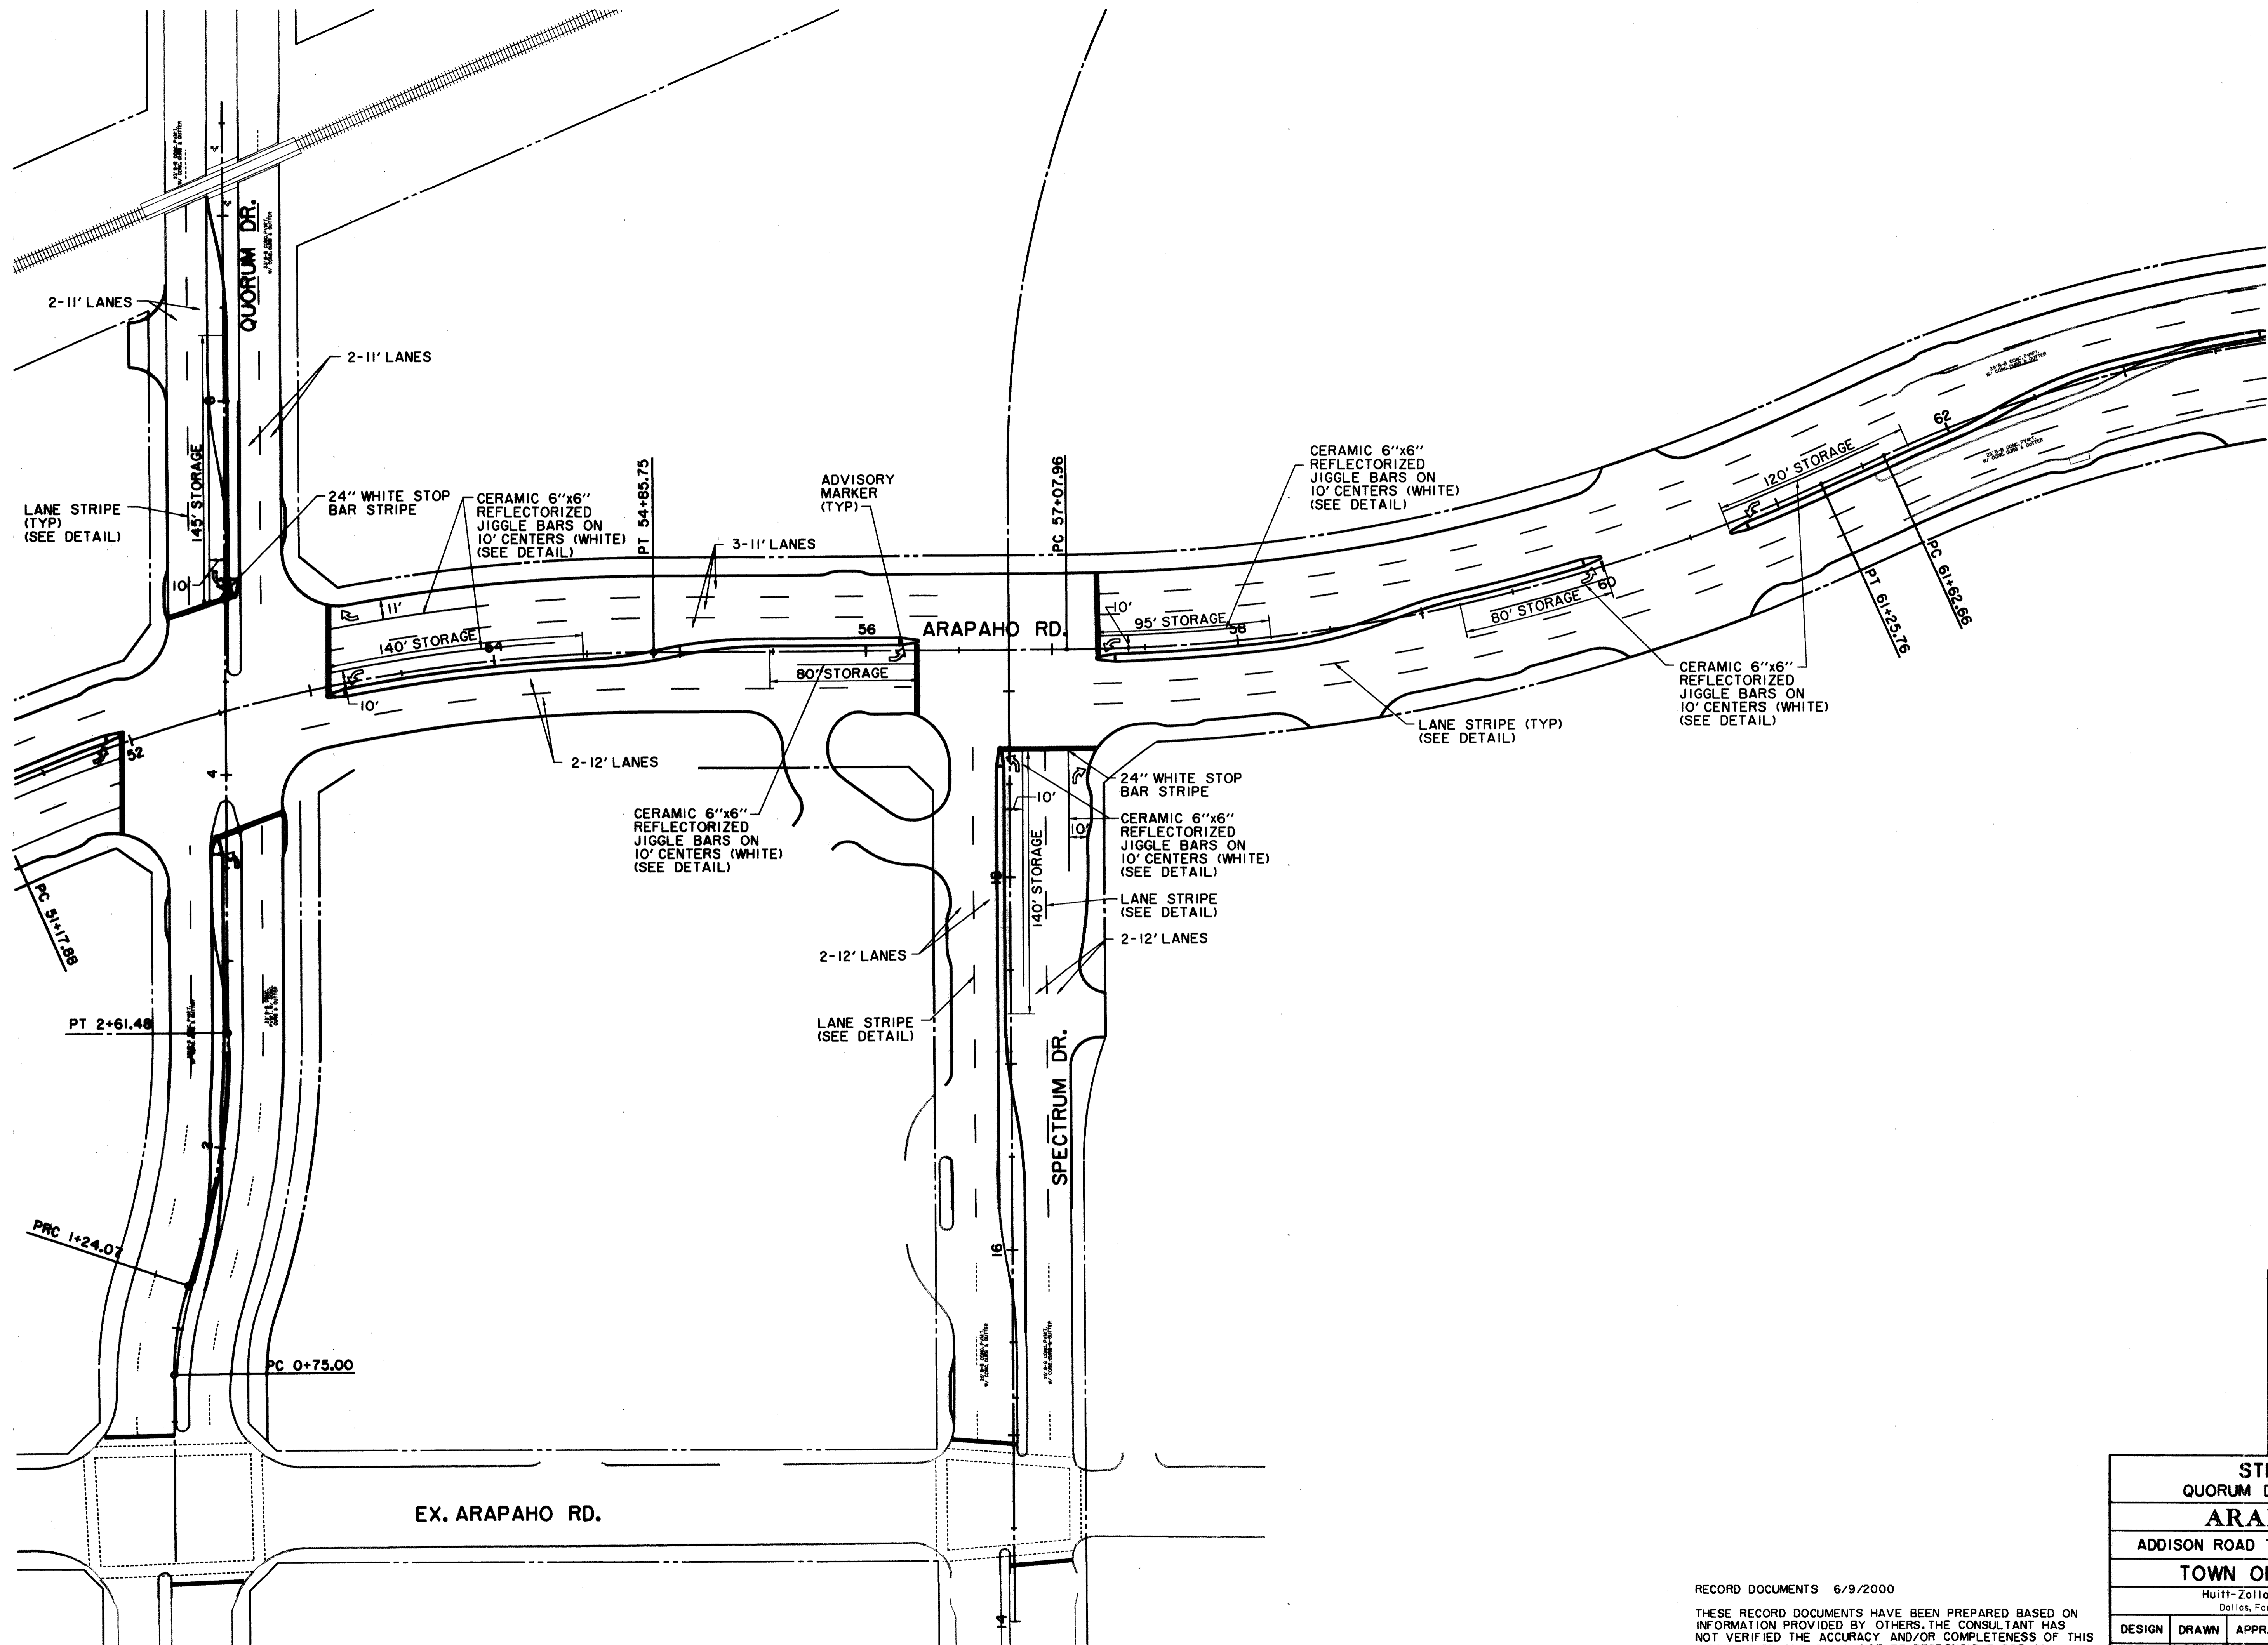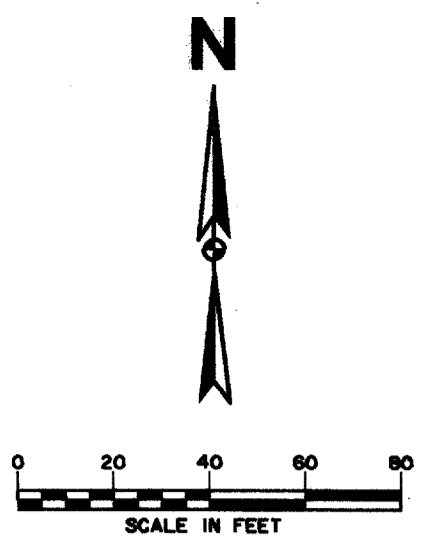



ALL DIMENSIONS ARE IN FEET UNLESS OTHERWISE NOTED.
 ALL DISTANCES ARE MEASURED ALONG THE CENTERLINE OF THE ROAD.
 ALL CORNER POINTS ARE TO BE SET AND MARKED.
 ALL STRIPING IS TO BE PAINTED AND REFLECTORIZED.
 ALL MATERIALS ARE TO BE OF THE BEST QUALITY AVAILABLE.
 ALL WORK IS TO BE COMPLETED WITHIN THE SPECIFIED TIME FRAME.
 ALL CHANGES MUST BE APPROVED BY THE ENGINEER.
 ALL RECORDS ARE TO BE MAINTAINED AND SUBMITTED WITH THE FINAL REPORT.
 ALL RIGHTS-OF-WAY ARE TO BE MAINTAINED AND PROTECTED.
 ALL UTILITIES ARE TO BE LOCATED AND DEPTH MARKED.
 ALL EROSION CONTROL MEASURES ARE TO BE INSTALLED AND MAINTAINED.
 ALL SAFETY MEASURES ARE TO BE IN PLACE DURING CONSTRUCTION.
 ALL TRAFFIC CONTROLS ARE TO BE MAINTAINED AT ALL TIMES.
 ALL MATERIALS ARE TO BE TESTED AND APPROVED.
 ALL WORK IS TO BE DONE IN ACCORDANCE WITH THE LATEST EDITIONS OF THE STANDARD SPECIFICATIONS FOR CONSTRUCTION OF PUBLIC WORKS.
 ALL CONTRACTORS ARE TO BE LICENSED AND BONDED.
 ALL SUBCONTRACTORS ARE TO BE APPROVED BY THE ENGINEER.
 ALL MATERIALS ARE TO BE STORED PROPERLY AND PROTECTED FROM WEATHER.
 ALL EQUIPMENT IS TO BE MAINTAINED AND OPERATED SAFELY.
 ALL WORK IS TO BE COMPLETED WITHIN THE SPECIFIED TIME FRAME.
 ALL CHANGES MUST BE APPROVED BY THE ENGINEER.
 ALL RECORDS ARE TO BE MAINTAINED AND SUBMITTED WITH THE FINAL REPORT.
 ALL RIGHTS-OF-WAY ARE TO BE MAINTAINED AND PROTECTED.
 ALL UTILITIES ARE TO BE LOCATED AND DEPTH MARKED.
 ALL EROSION CONTROL MEASURES ARE TO BE INSTALLED AND MAINTAINED.
 ALL SAFETY MEASURES ARE TO BE IN PLACE DURING CONSTRUCTION.
 ALL TRAFFIC CONTROLS ARE TO BE MAINTAINED AT ALL TIMES.
 ALL MATERIALS ARE TO BE TESTED AND APPROVED.
 ALL CONTRACTORS ARE TO BE LICENSED AND BONDED.
 ALL SUBCONTRACTORS ARE TO BE APPROVED BY THE ENGINEER.
 ALL MATERIALS ARE TO BE STORED PROPERLY AND PROTECTED FROM WEATHER.
 ALL EQUIPMENT IS TO BE MAINTAINED AND OPERATED SAFELY.

THE SEAL APPEARING ON THIS DOCUMENT WAS AUTHORIZED BY KENNETH A. ROBERTS, P.E. 55446 ON OCTOBER 24, 1997.

Kenneth A. Roberts
 10-24-97

STRIPING PLAN						
QUORUM DRIVE TO STA. 62+00						
ARAPAHO ROAD						
ADDISON ROAD TO DALLAS NORTH TOLLWAY						
TOWN OF ADDISON, TEXAS						
Huitt-Zollars, Inc./Consulting Engineers Dallas, Fort Worth, Houston, Phoenix, Tucson						
DESIGN	DRAWN	APPR.	SCALE	DATE	PROJECT NO.	NO.
HZI	HZI	KAR	1"=40'	OCT 97	1772-01	P-17

RECORD DOCUMENTS 6/9/2000
 THESE RECORD DOCUMENTS HAVE BEEN PREPARED BASED ON INFORMATION PROVIDED BY OTHERS. THE CONSULTANT HAS NOT VERIFIED THE ACCURACY AND/OR COMPLETENESS OF THIS INFORMATION AND SHALL NOT BE RESPONSIBLE FOR ANY ERRORS OR OMISSIONS THAT MAY BE INCORPORATED AS A RESULT OF ERRONEOUS INFORMATION PROVIDED BY OTHERS.

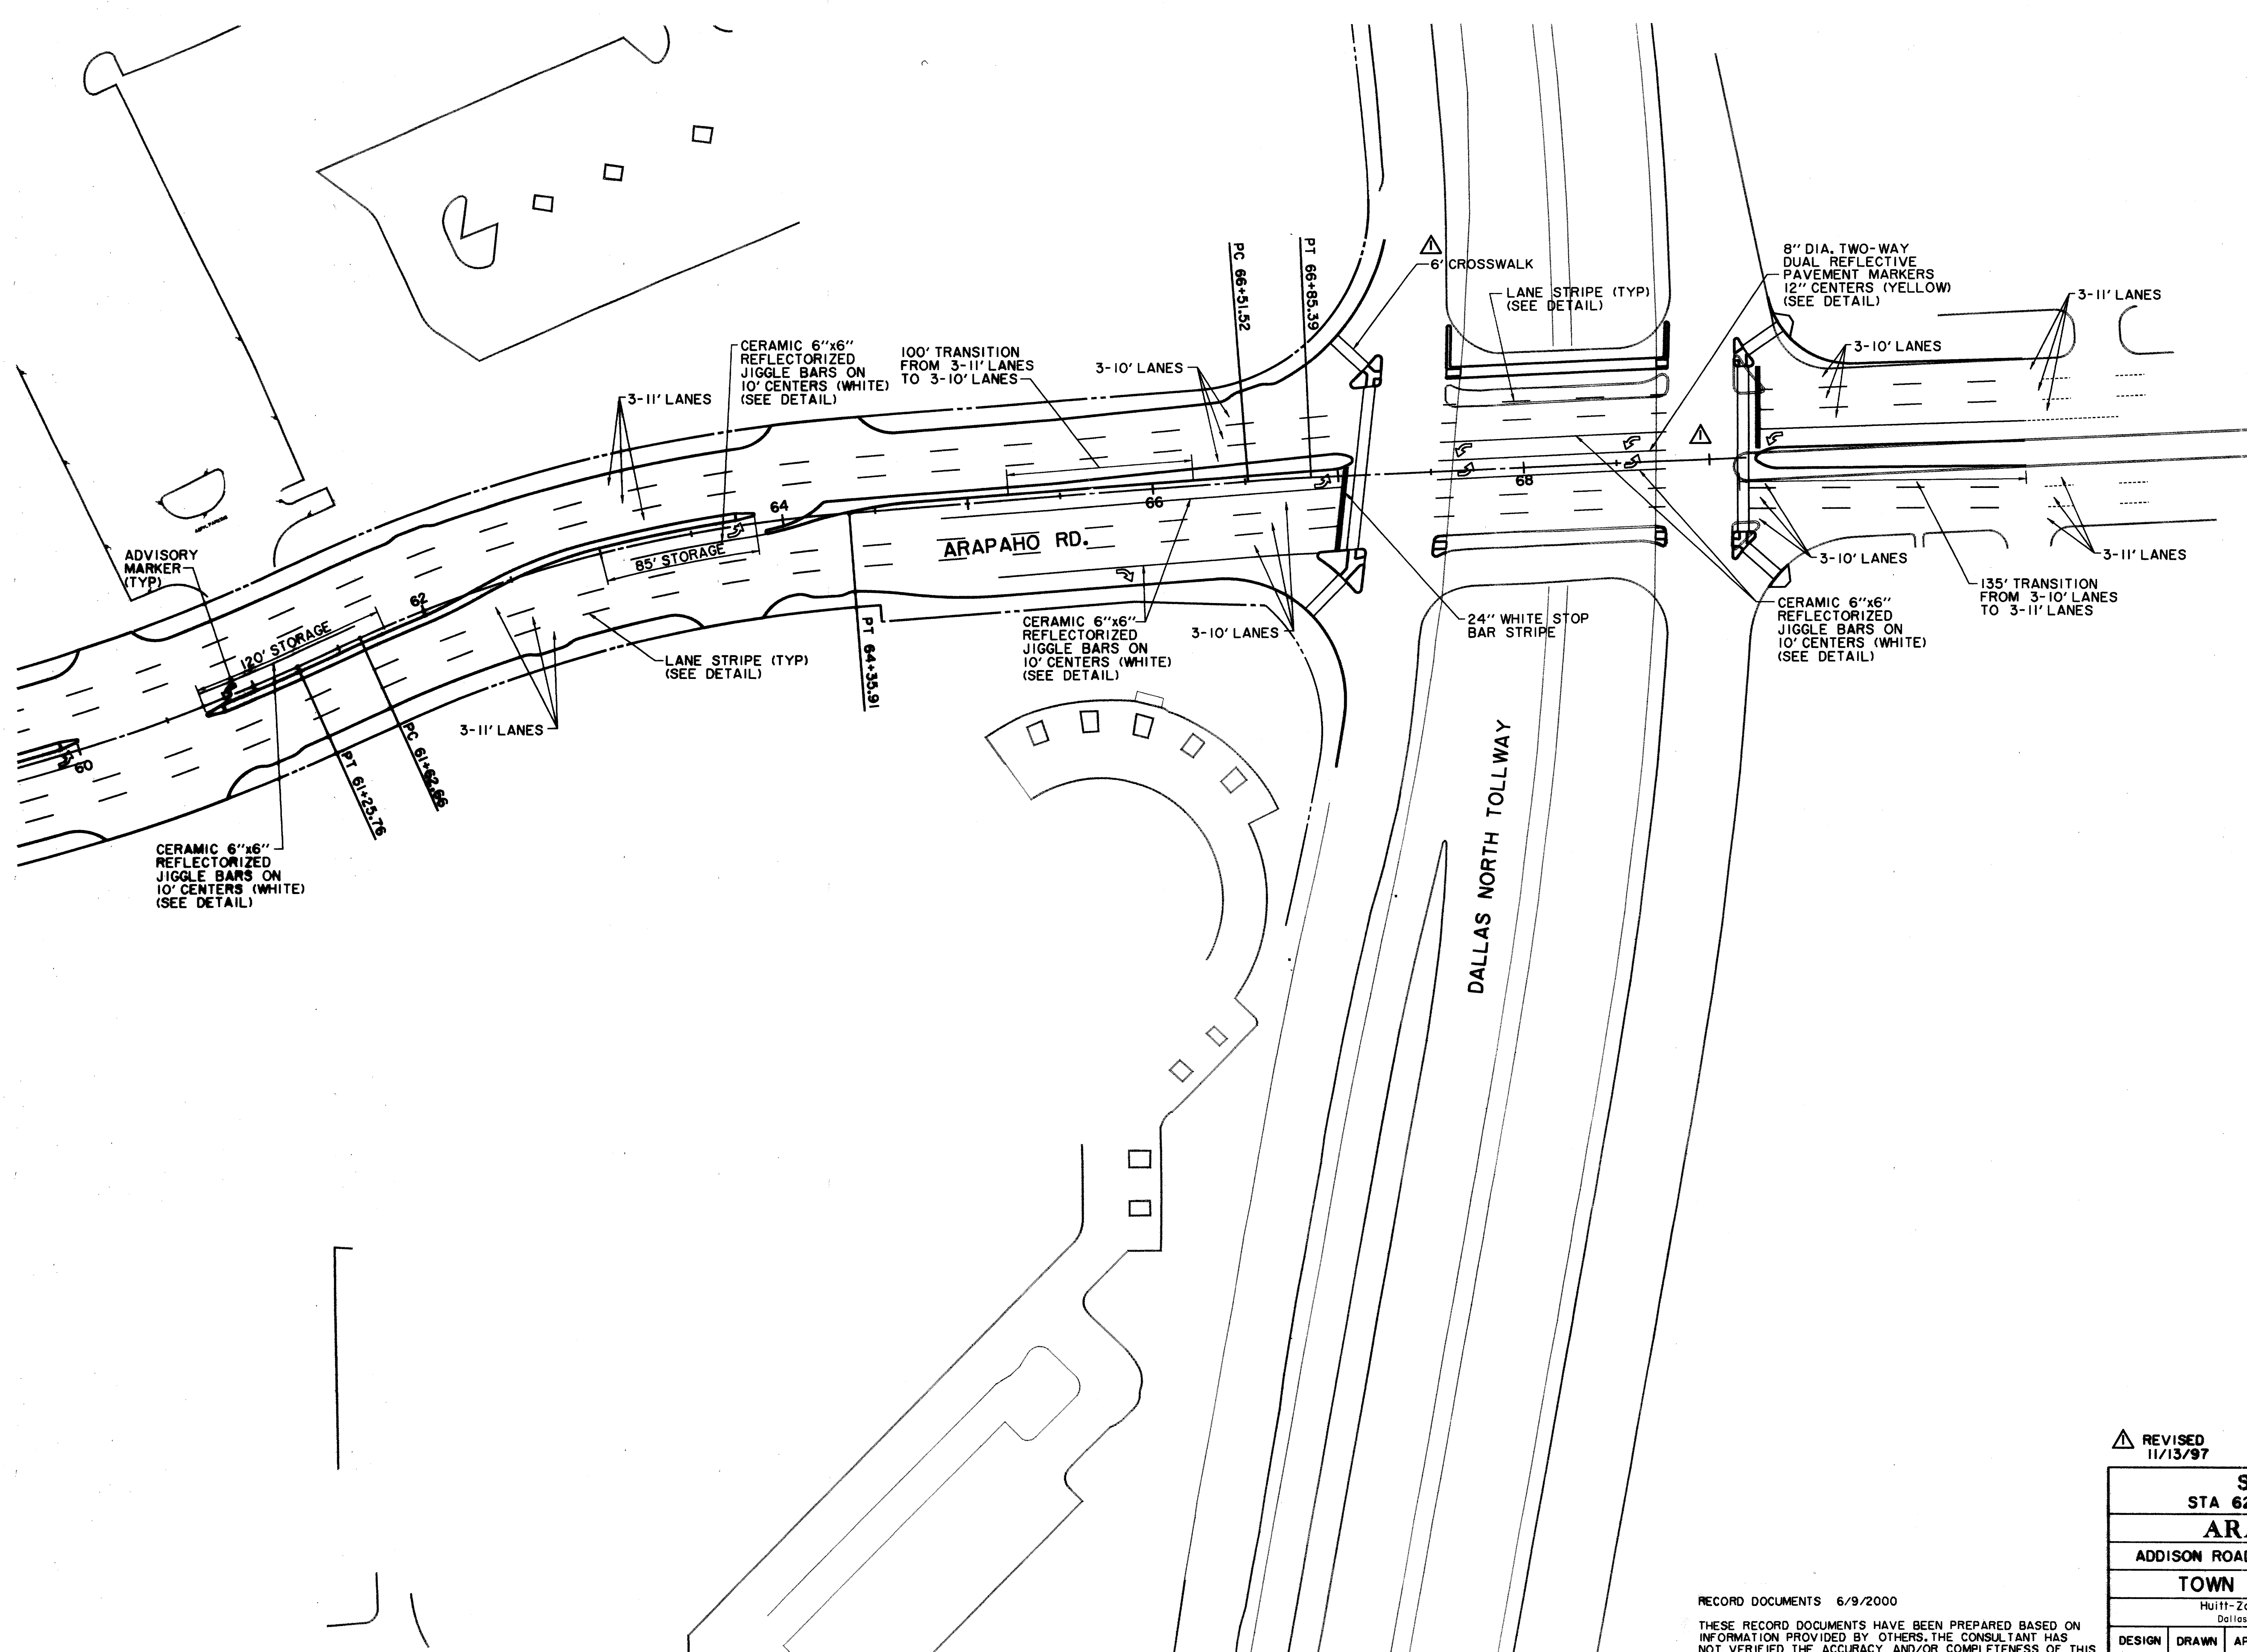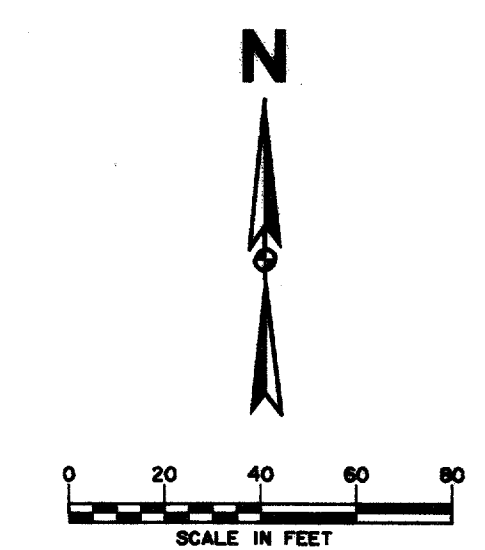

THE SEAL APPEARING ON THIS DOCUMENT WAS AUTHORIZED BY KENNETH A. ROBERTS, P.E. 55446 ON OCTOBER 24, 1997


Kenneth A. Roberts
10-24-97

REVISD
11/13/97


STRIPING PLAN						
STA 62+00 TO PROJECT END						
ARAPAHO ROAD						
ADDISON ROAD TO DALLAS NORTH TOLLWAY						
TOWN OF ADDISON, TEXAS						
Hullitt-Zollars, Inc./Consulting Engineers Dallas, Fort Worth, Houston, Phoenix, Tustin						
DESIGN	DRAWN	APPR.	SCALE	DATE	PROJECT NO.	NO.
HZI	HZI	KAR	1"=40'	OCT 97	1772-01	P-18

RECORD DOCUMENTS 6/9/2000
 THESE RECORD DOCUMENTS HAVE BEEN PREPARED BASED ON INFORMATION PROVIDED BY OTHERS. THE CONSULTANT HAS NOT VERIFIED THE ACCURACY AND/OR COMPLETENESS OF THIS INFORMATION AND SHALL NOT BE RESPONSIBLE FOR ANY ERRORS OR OMISSIONS THAT MAY BE INCORPORATED AS A RESULT OF ERRONEOUS INFORMATION PROVIDED BY OTHERS.

CHATAHOOCHEE LEASING CORPORATION

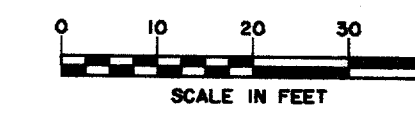

G CURVE DATA
 Δ = 01° 56' 26"
 R = 1000.00'
 T = 16.94'
 L = 33.87'

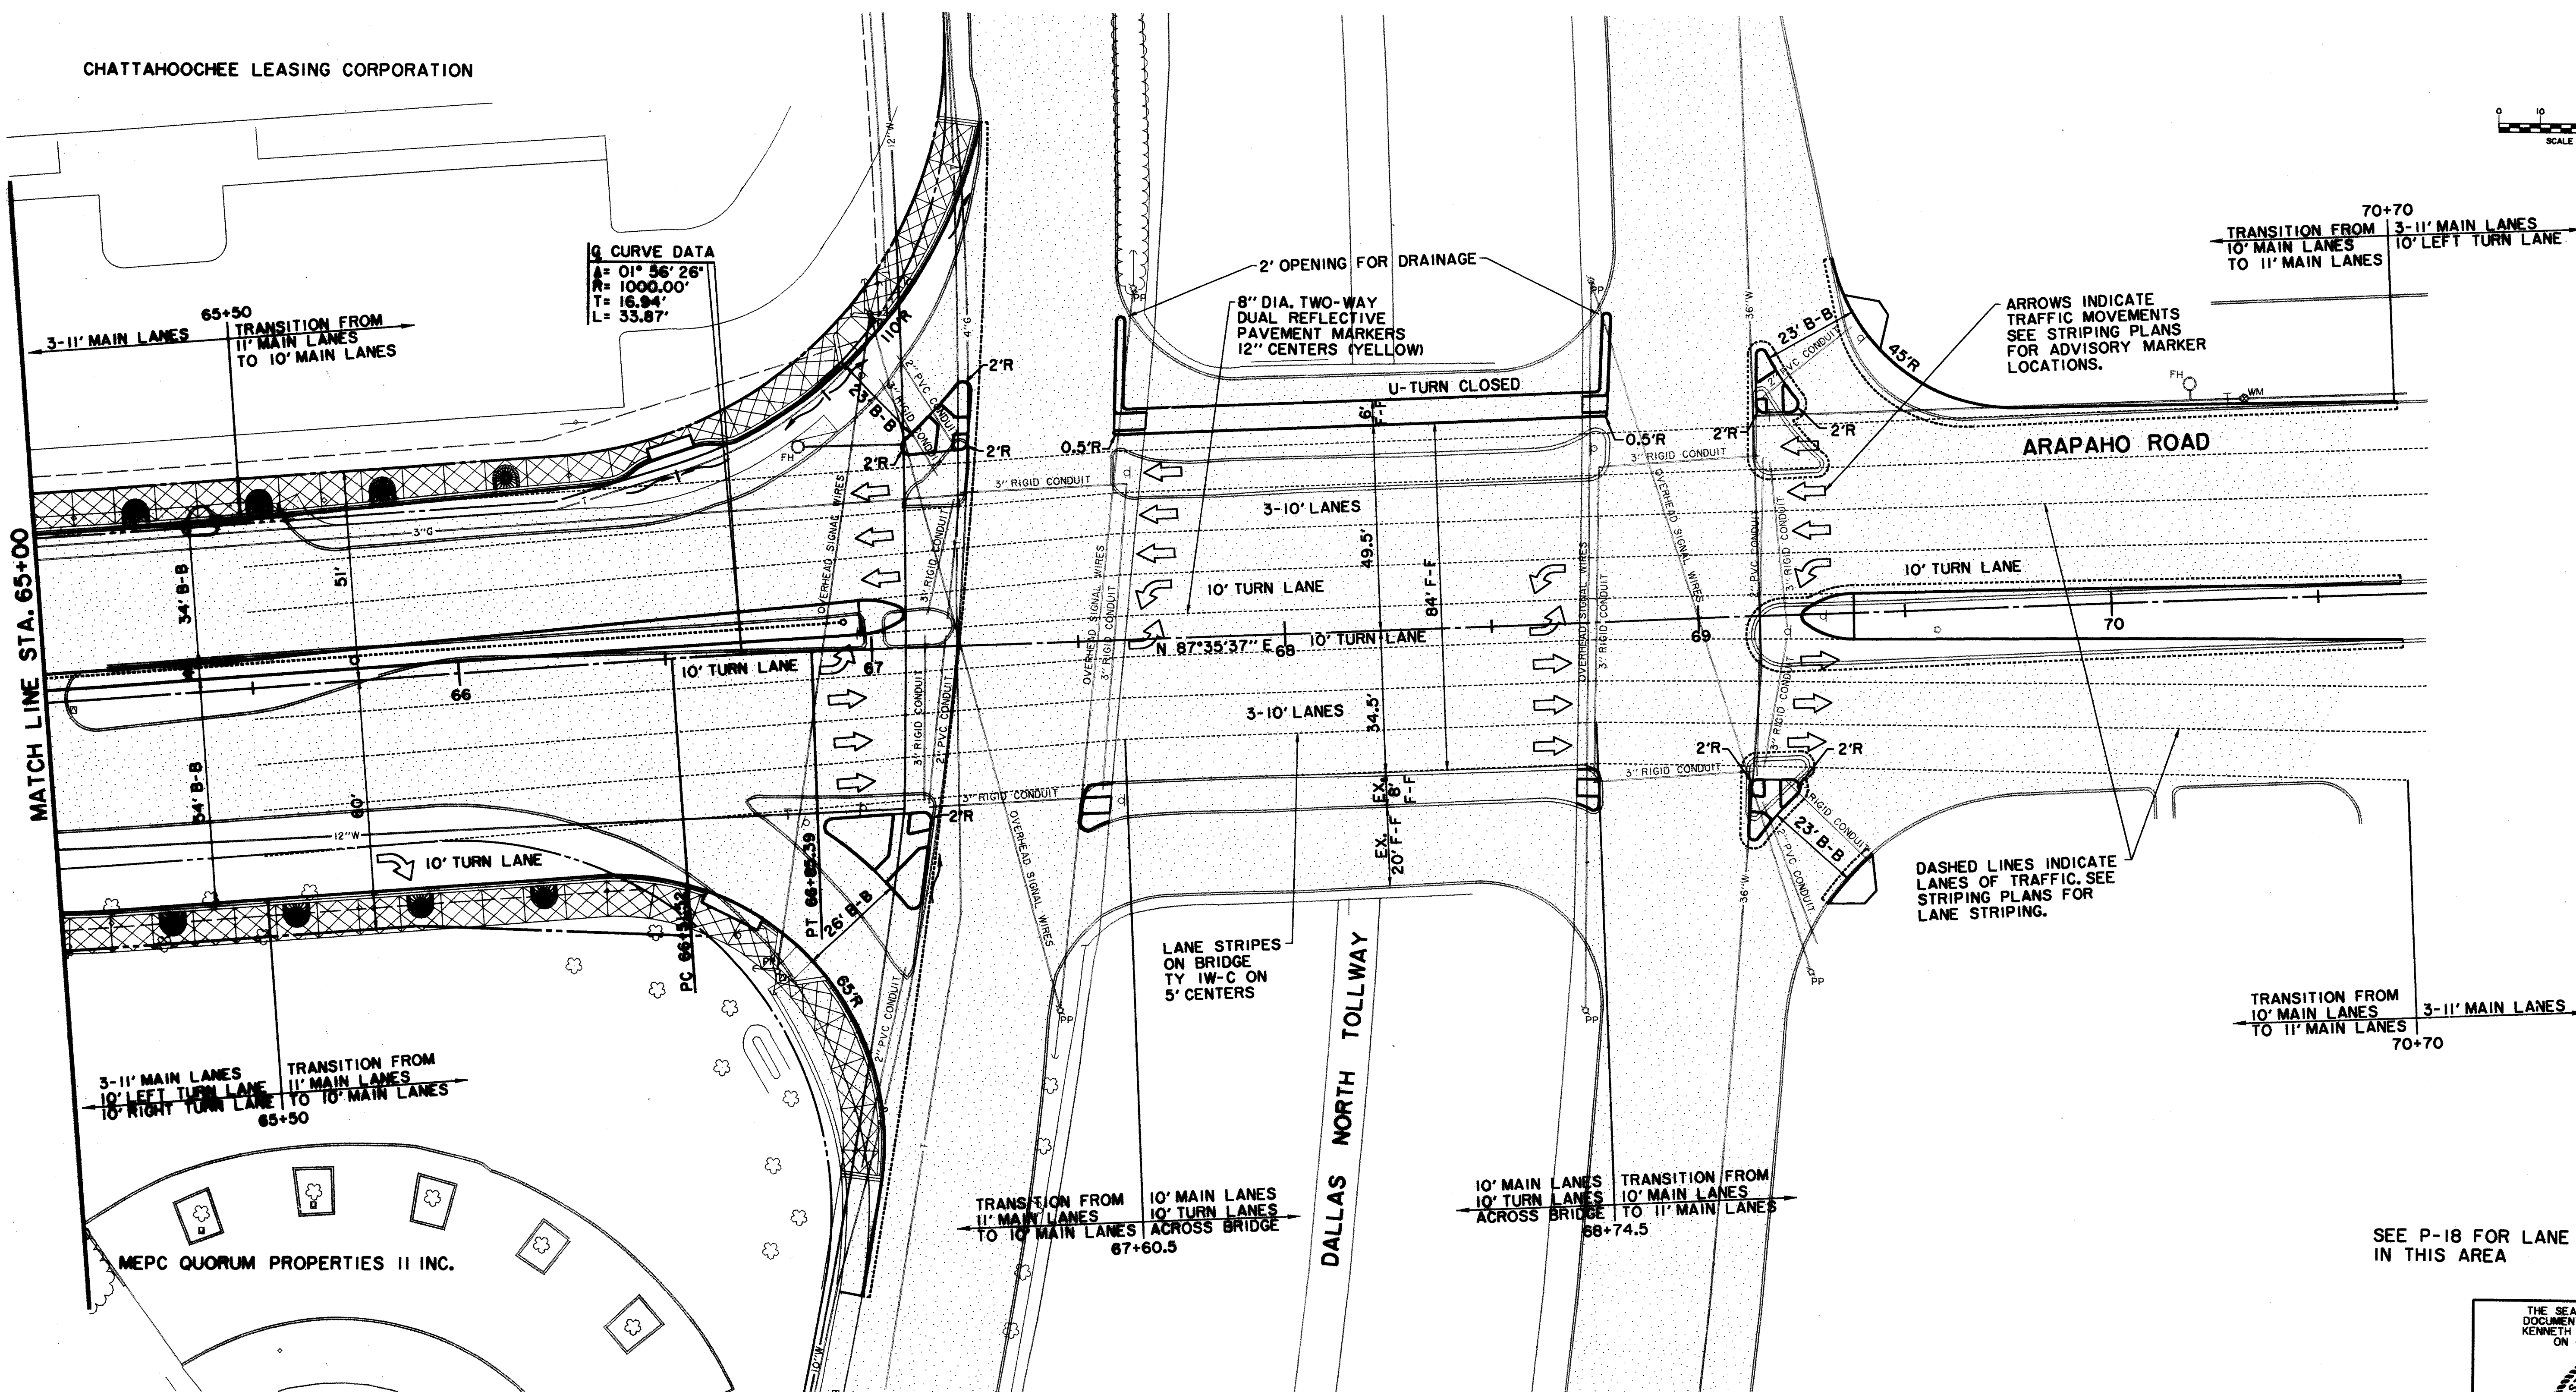


MATCH LINE STA. 65+00

ARROWS INDICATE TRAFFIC MOVEMENTS SEE STRIPING PLANS FOR ADVISORY MARKER LOCATIONS.

DASHED LINES INDICATE LANES OF TRAFFIC. SEE STRIPING PLANS FOR LANE STRIPING.

LANE STRIPES ON BRIDGE TY 1W-C ON 5' CENTERS

SEE P-18 FOR LANE STRIPING IN THIS AREA

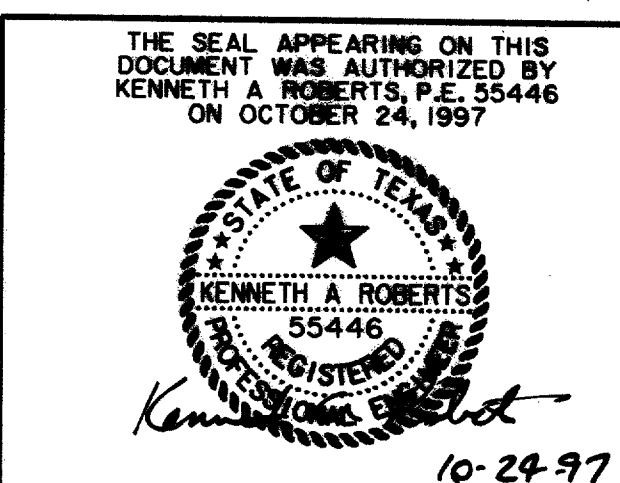


REVIS 11/13/97

BRIDGE LANE MODIFICATION						
ARAPAHO ROAD						
ADDISON ROAD TO DALLAS NORTH TOLLWAY						
TOWN OF ADDISON, TEXAS						
Hull-Zollars, Inc./Consulting Engineers Dallas, Fort Worth, Houston, Phoenix, Tustin						
DESIGN	DRAWN	APPR.	SCALE	DATE	PROJECT NO.	NO.
HZI	HZI	KAR	1"=20'	OCT 97	1772-01	P-19

RECORD DOCUMENTS 6/9/2000


THESE RECORD DOCUMENTS HAVE BEEN PREPARED BASED ON INFORMATION PROVIDED BY OTHERS. THE CONSULTANT HAS NOT VERIFIED THE ACCURACY AND/OR COMPLETENESS OF THIS INFORMATION AND SHALL NOT BE RESPONSIBLE FOR ANY ERRORS OR OMISSIONS THAT MAY BE INCORPORATED AS A RESULT OF ERRONEOUS INFORMATION PROVIDED BY OTHERS.

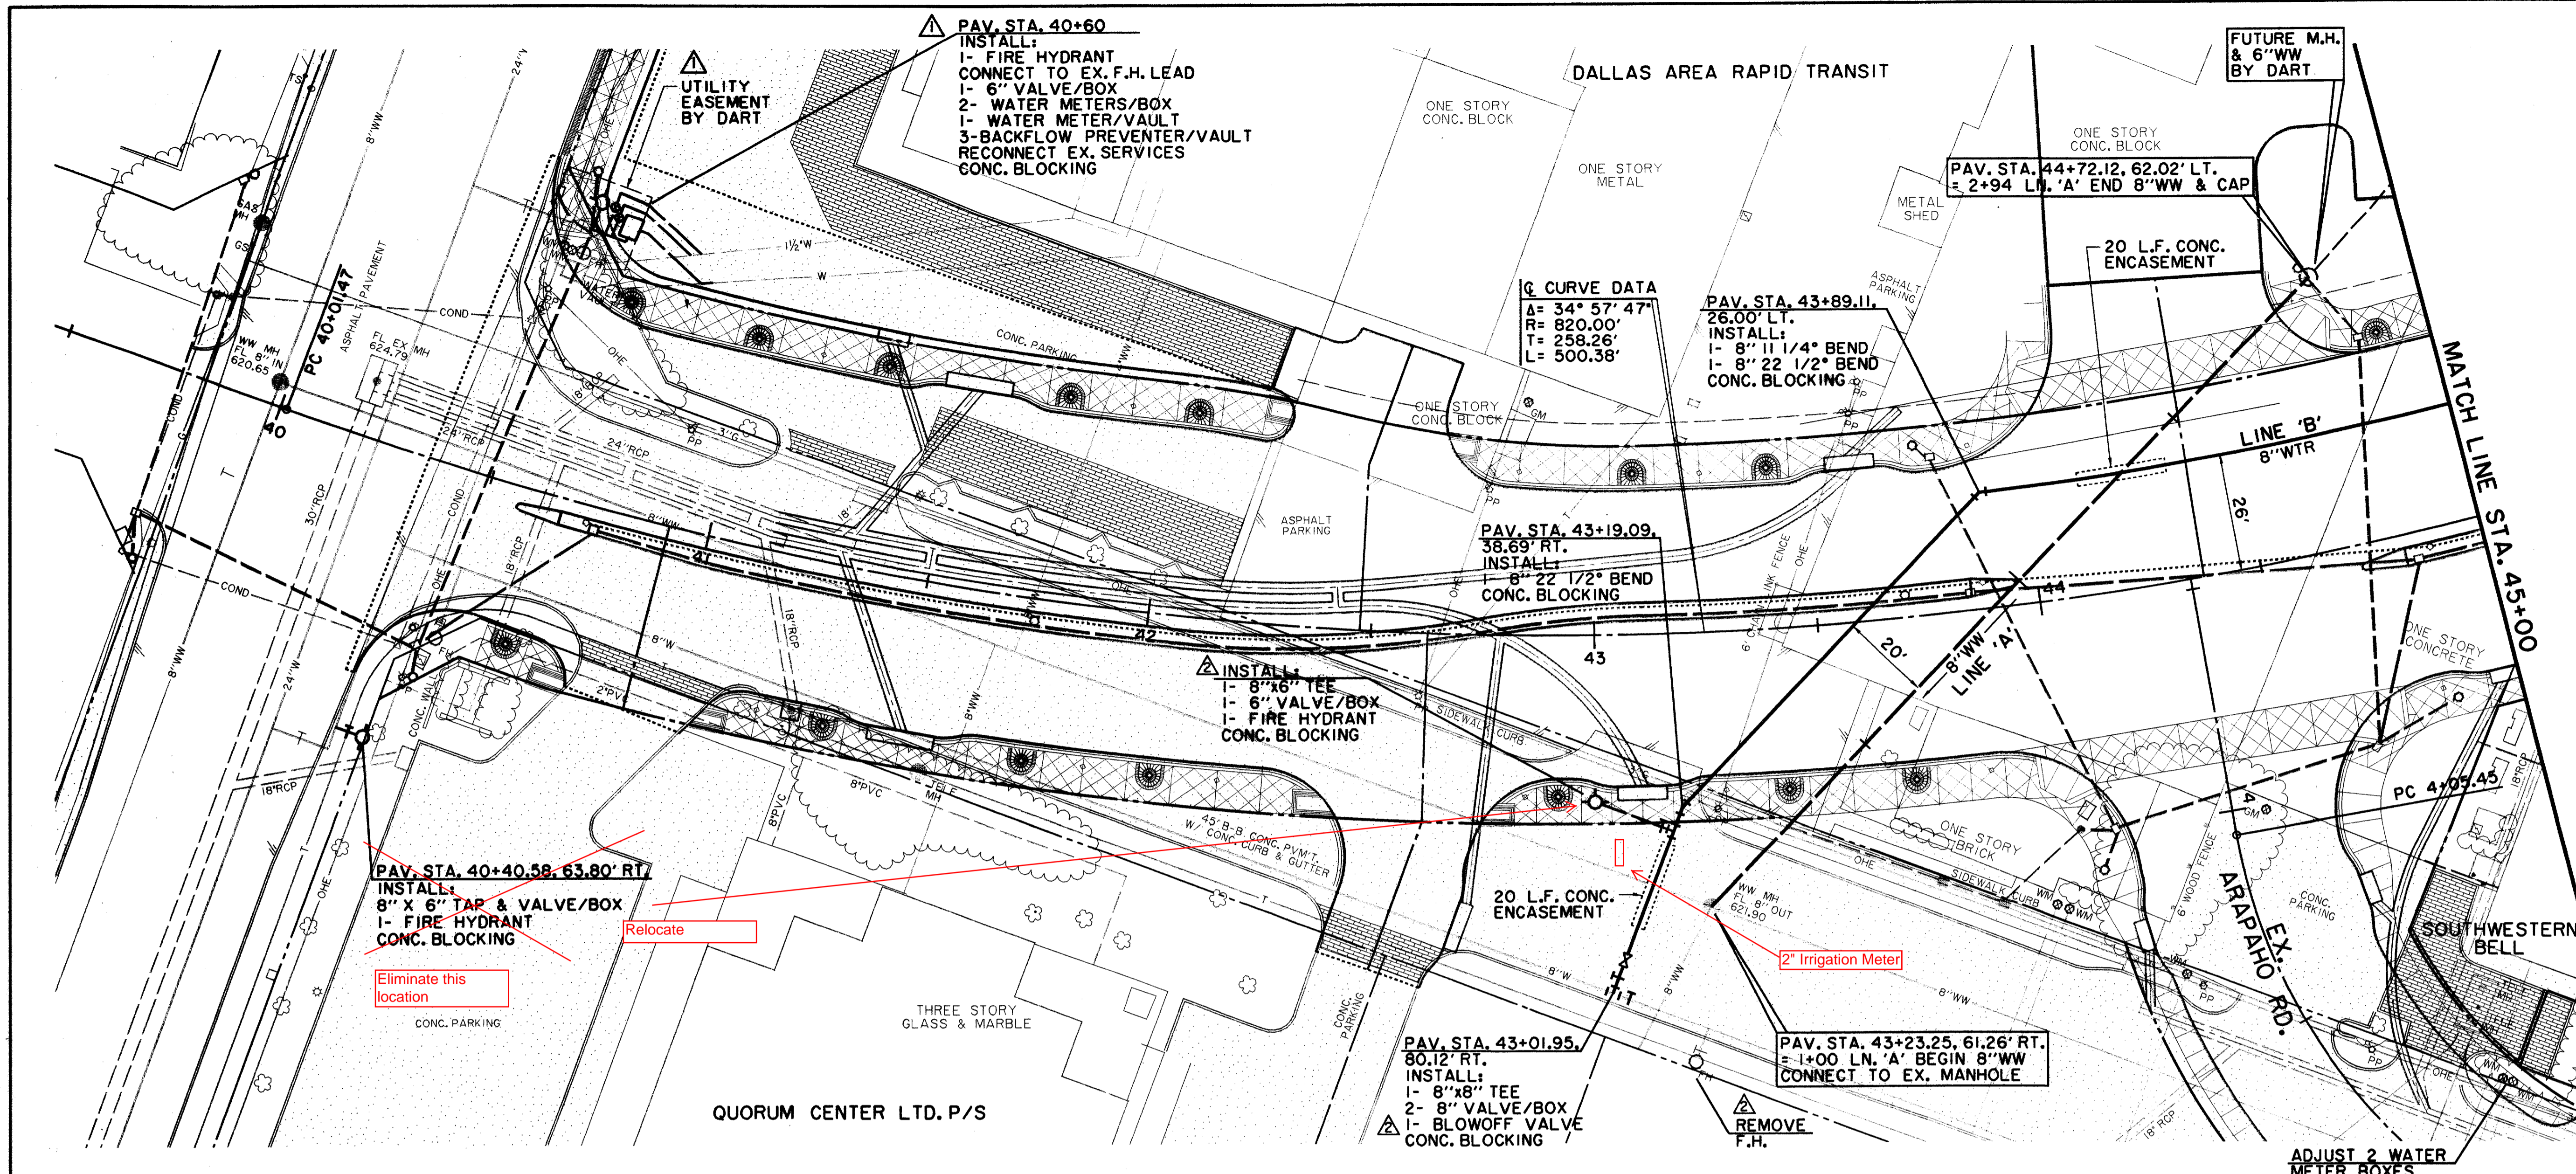

THESE RECORD DOCUMENTS HAVE BEEN PREPARED BASED ON INFORMATION PROVIDED BY OTHERS. THE CONSULTANT HAS NOT VERIFIED THE ACCURACY AND/OR COMPLETENESS OF THIS INFORMATION AND SHALL NOT BE RESPONSIBLE FOR ANY ERRORS OR OMISSIONS THAT MAY BE INCORPORATED AS A RESULT OF ERRONEOUS INFORMATION PROVIDED BY OTHERS.

LEGEND

	ELECTRIC — OHE		WATER — W
	○ LIGHT POLE		○ FIRE HYDRANT
	□ POWER POLE		○ METER
	— GUY WIRE		○ WATER VALVE
	TELEPHONE — T		MISC. R.C.P. REMOVAL
	○ TELEPHONE MANHOLE		— CHAIN LINK FENCE
	□ TELEPHONE PEDESTAL		— WOOD FENCE
	GAS — G		— EXISTING ASPHALT
	○ GAS METER		— EXISTING DIRT OR GRAVEL
	○ GAS SIGN		— EX. CONCRETE
	LAND USE		— TREE/TREE LINE
	○ RAILROAD SIGN		— EXISTING CURB
	○ SIGN		— PROP. CURB
	○ SURVEY FOUND IRON ROD		— EX. PROPERTY LINE
	○ TEMP BENCHMARK		— PROP. CENTERLINE
	WASTEWATER — W		— PROP. R.O.W.
	○ WASTEWATER MANHOLE		— PROP. INLET
	○ CLEANOUT		— TOP OF PAVEMENT
			— TOP OF CURB
			— CURB RETURN

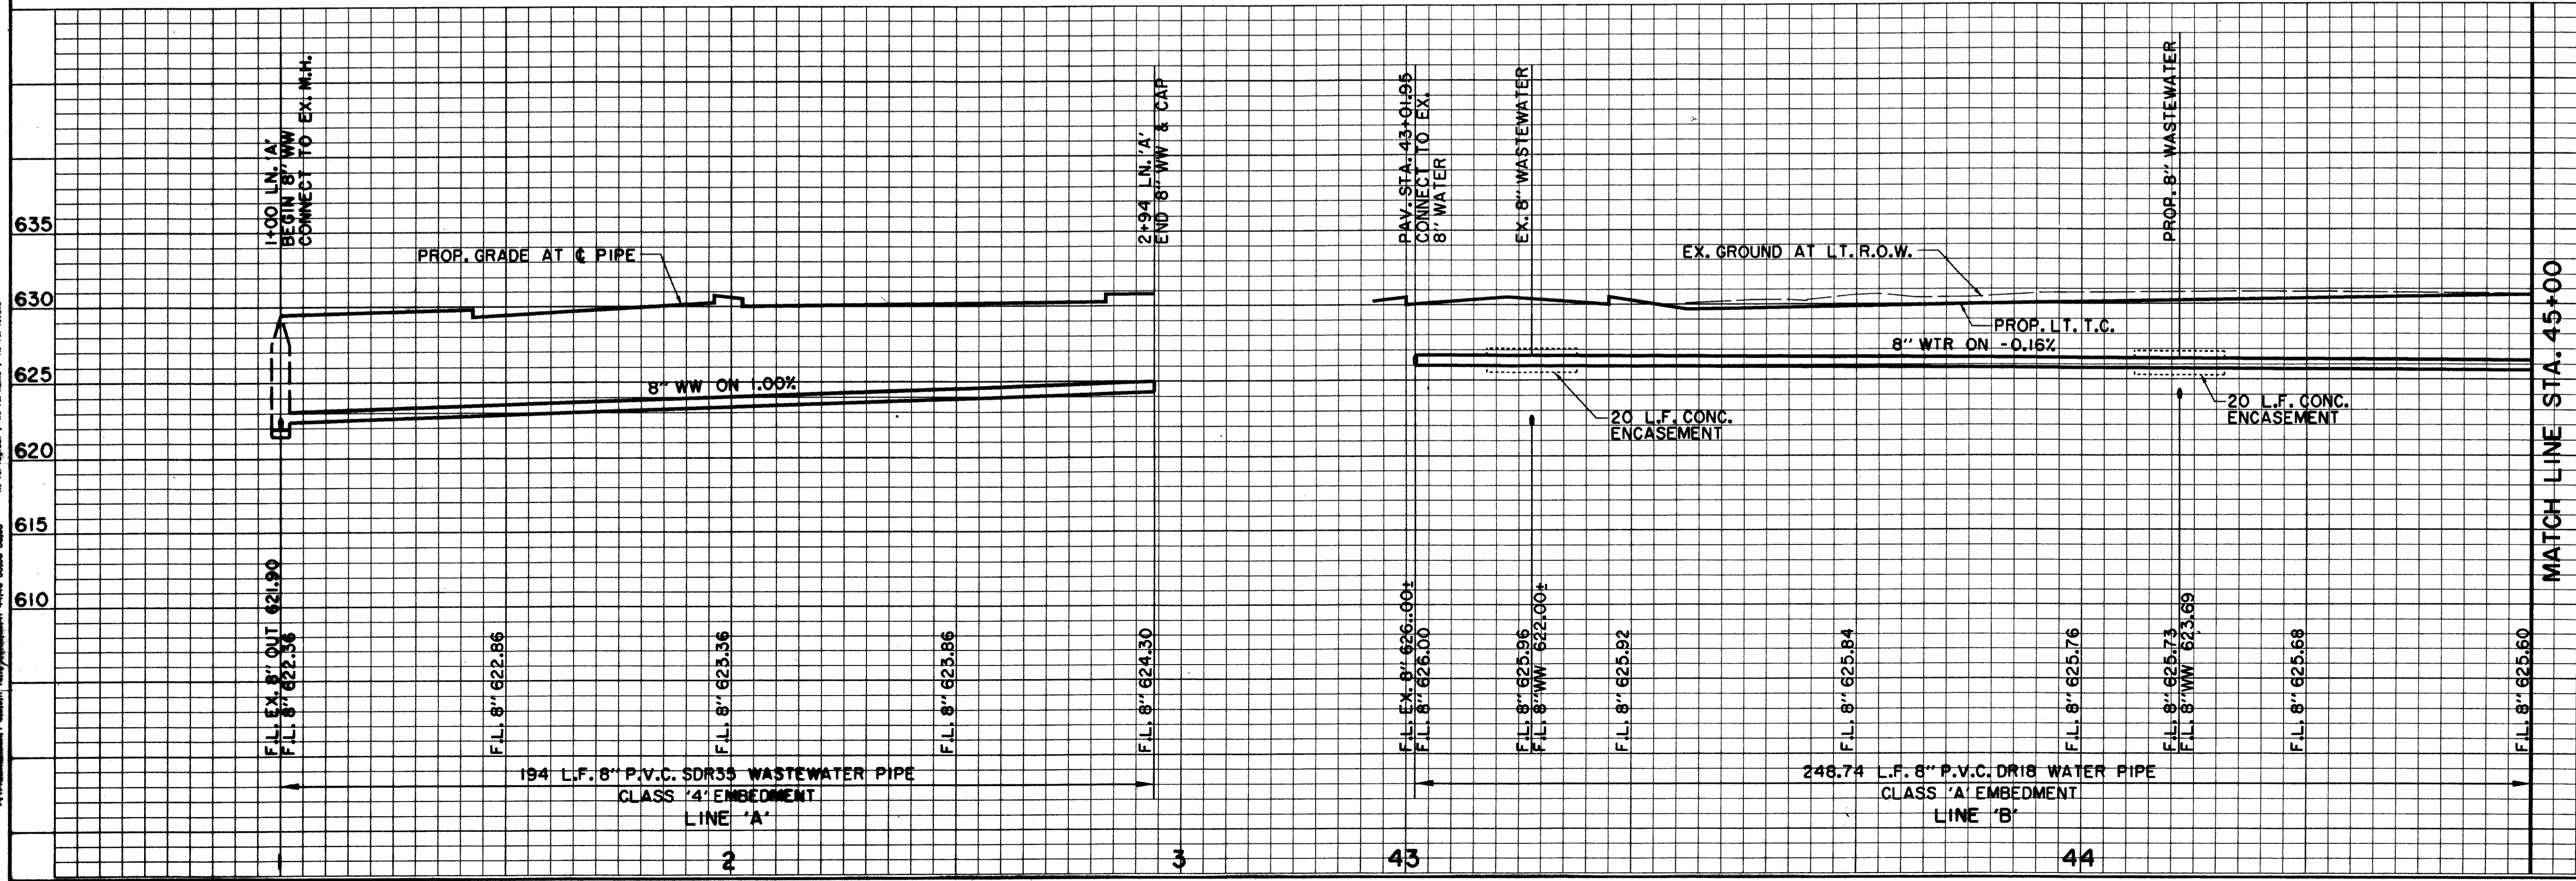

BENCHMARKS:
 USC & GS E-921 DISK IN BRICK WALL OF OLD ADDISON SCHOOL HOUSE (MAGIC TIME MACHINE RESTAURANT) ON SOUTH WALL, 4' EAST OF CENTER OF THE ENTRANCE, 4.7' ABOVE THE GROUND. ELEV. 650.61



635 "I" ON SOUTHEAST CORNER OF CONCRETE WALK AT FRONT ENTRANCE TO 4805 ARAPAHO ROAD. ELEV. 630.61

THE SEAL APPEARING ON THIS DOCUMENT WAS AUTHORIZED BY KENNETH A. ROBERTS, P.E. 55446 ON OCTOBER 24, 1997




WATER & WASTEWATER PLAN & PROFILE						
ADDISON ROAD TO STA. 45+00						
ARAPAHO ROAD						
ADDISON ROAD TO DALLAS NORTH TOLLWAY						
TOWN OF ADDISON, TEXAS						
Huitt-Zollars, Inc./Consulting Engineers Dallas, Fort Worth, Houston, Phoenix, Tustin						
DESIGN	DRAWN	APPR.	SCALE	DATE	PROJECT NO.	NO.
HZI	HZI	KAR	H ₁ 1"=20' V ₁ 1"=6'	OCT 97	1772-01	W-1

ALL INFORMATION CONTAINED HEREIN IS THE PROPERTY OF HUIIT-ZOLLARS, INC. AND IS TO BE USED ONLY FOR THE PROJECT AND SITE SPECIFICALLY IDENTIFIED HEREIN. ANY REUSE OR MODIFICATION OF THIS INFORMATION WITHOUT THE WRITTEN CONSENT OF HUIIT-ZOLLARS, INC. IS STRICTLY PROHIBITED.

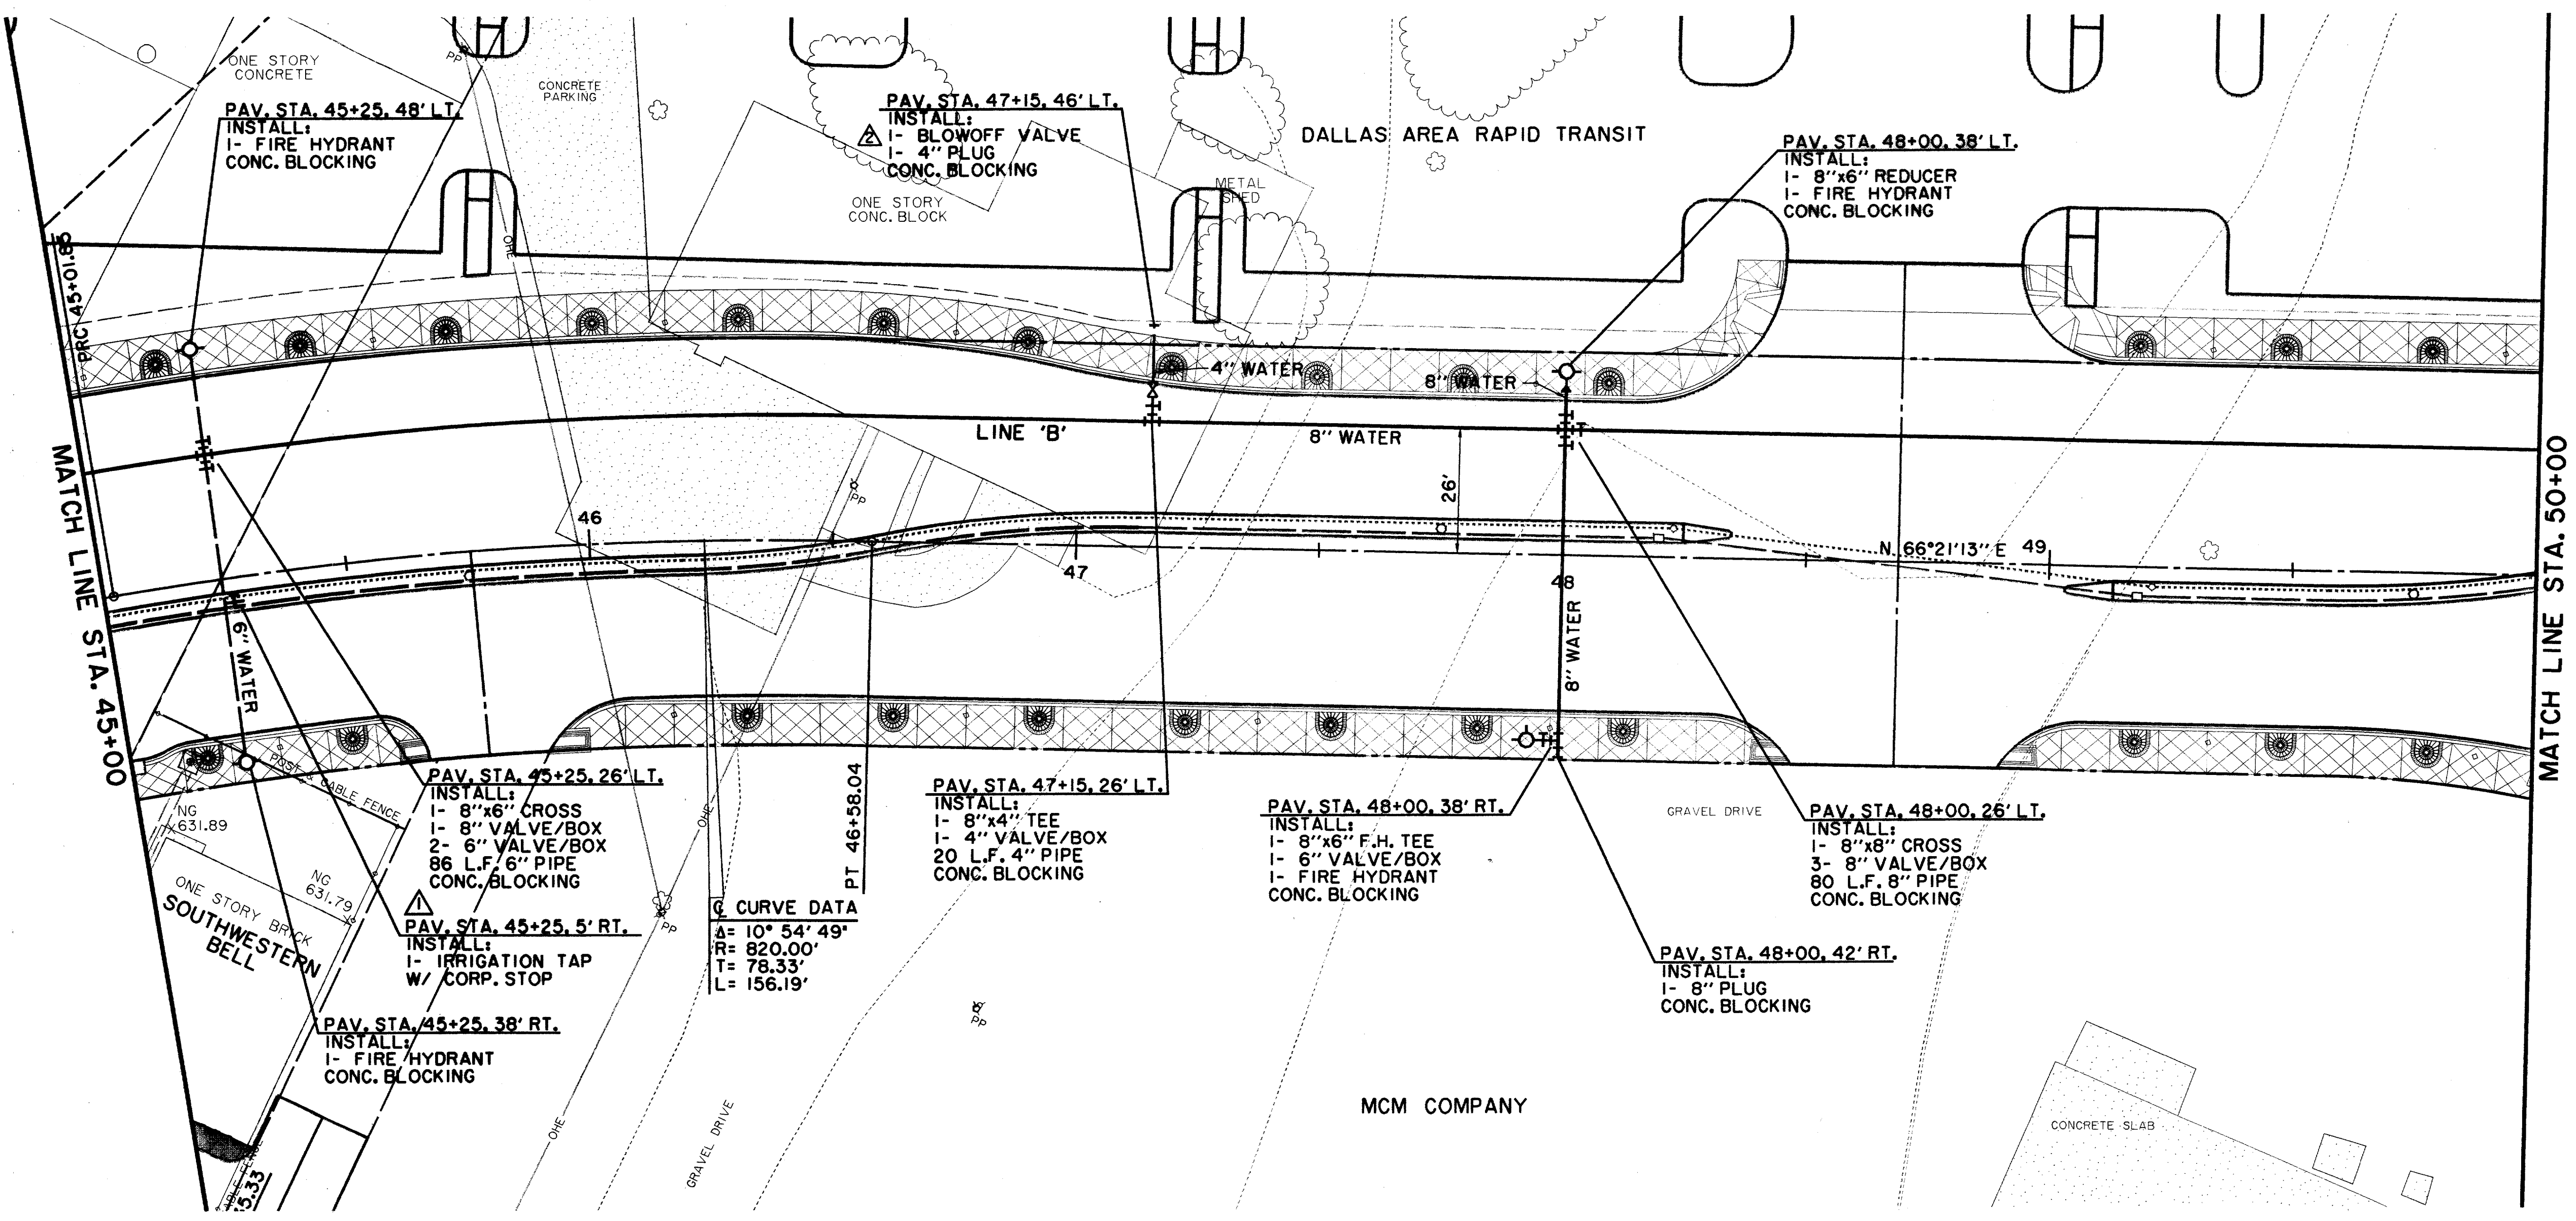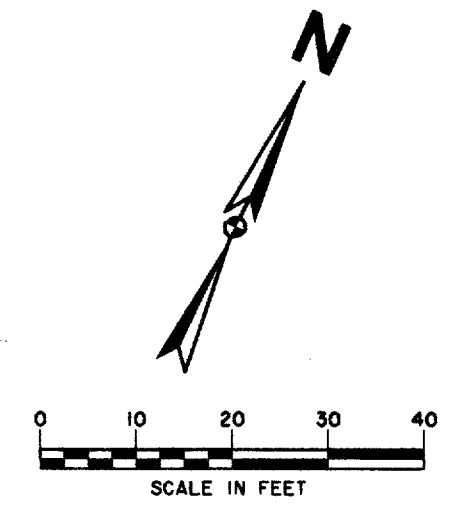

THESE RECORD DOCUMENTS HAVE BEEN PREPARED BASED ON INFORMATION PROVIDED BY OTHERS. THE CONSULTANT HAS NOT VERIFIED THE ACCURACY AND/OR COMPLETENESS OF THIS INFORMATION AND SHALL NOT BE RESPONSIBLE FOR ANY ERRORS OR OMISSIONS THAT MAY BE INCORPORATED AS A RESULT OF ERRONEOUS INFORMATION PROVIDED BY OTHERS.

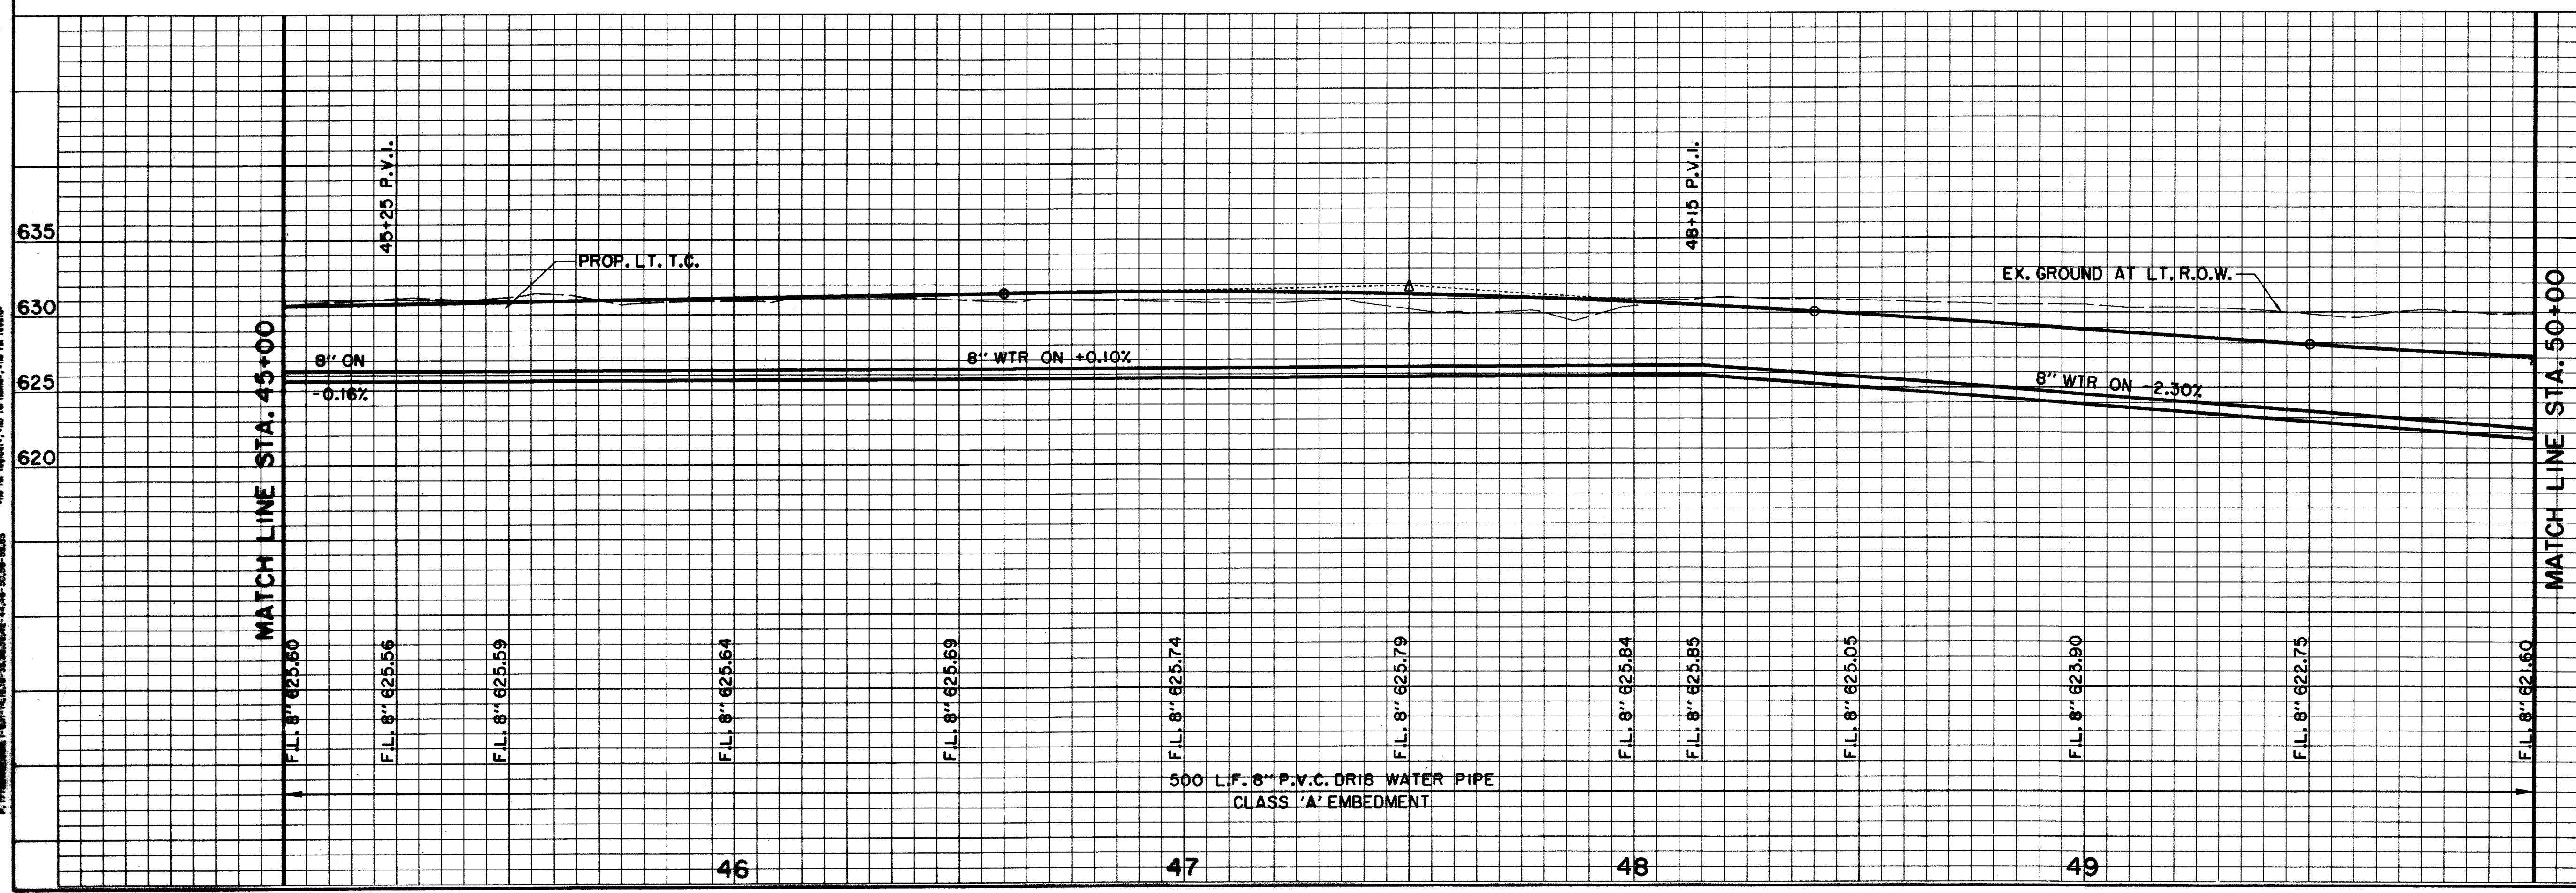

BENCHMARKS:
 USC & GS E-921 DISK IN BRICK WALL OF OLD ADDISON SCHOOL HOUSE (MAGIC TIME MACHINE RESTAURANT) ON SOUTH WALL, 4' EAST OF CENTER OF THE ENTRANCE, 4.7' ABOVE THE GROUND, ELEV. 650.61

'I' ON SOUTHEAST CORNER OF CONCRETE WALK AT FRONT ENTRANCE TO 4805 ARAPAHO ROAD, ELEV. 630.61

THE SEAL APPEARING ON THIS DOCUMENT WAS AUTHORIZED BY KENNETH A. ROBERTS, P.E. 55446 ON OCTOBER 24, 1997

RECORD DOCUMENTS
6/9/2000


REVISED
1/16/98

WATER PLAN & PROFILE
 STA. 45+00 TO STA. 50+00
ARAPAHO ROAD
 ADDISON ROAD TO DALLAS NORTH TOLLWAY
 TOWN OF ADDISON, TEXAS

Huitt-Zollars, Inc./Consulting Engineers
 Dallas, Fort Worth, Houston, Phoenix, Tustin

DESIGN	DRAWN	APPR.	SCALE	DATE	PROJECT NO.	NO.
HZI	HZI	KAR	H ₁ 1"=20' V ₁ 1"=6'	OCT 97	1772-01	W-2


ALL INFORMATION CONTAINED HEREIN IS THE PROPERTY OF HUITT-ZOLLARS, INC. IT IS TO BE USED ONLY FOR THE PROJECT AND SITE SPECIFICALLY IDENTIFIED HEREIN. NO PART OF THIS DOCUMENT IS TO BE REPRODUCED OR TRANSMITTED IN ANY FORM OR BY ANY MEANS, ELECTRONIC OR MECHANICAL, INCLUDING PHOTOCOPYING, RECORDING, OR BY ANY INFORMATION STORAGE AND RETRIEVAL SYSTEM, WITHOUT THE WRITTEN PERMISSION OF HUITT-ZOLLARS, INC.

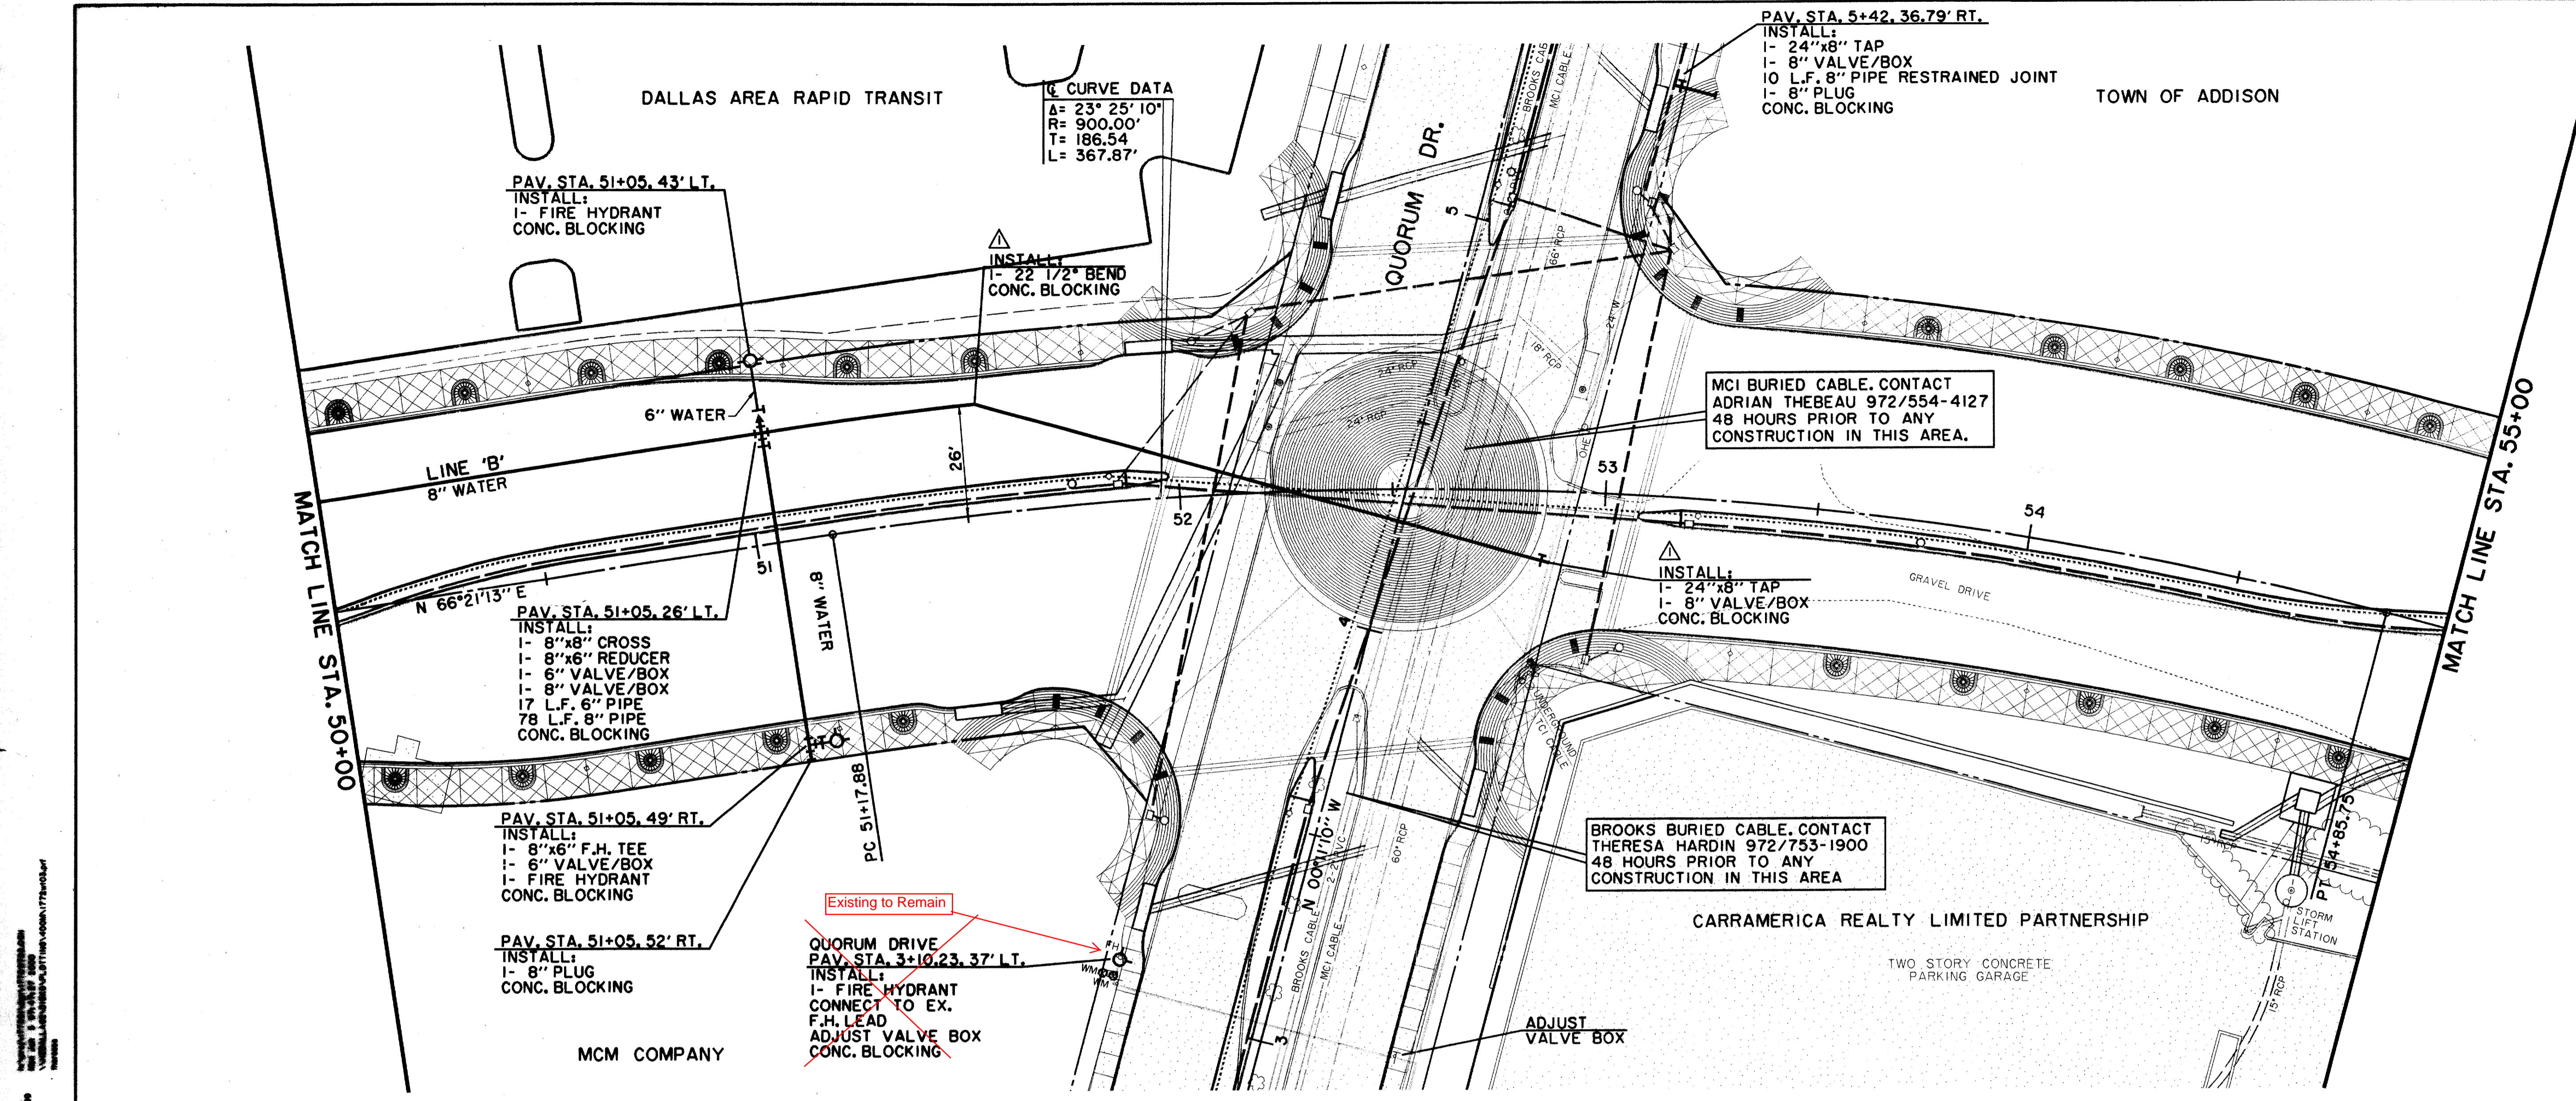

THESE RECORD DOCUMENTS HAVE BEEN PREPARED BASED ON INFORMATION PROVIDED BY OTHERS. THE CONSULTANT HAS NOT VERIFIED THE ACCURACY AND/OR COMPLETENESS OF THIS INFORMATION AND SHALL NOT BE RESPONSIBLE FOR ANY ERRORS OR OMISSIONS THAT MAY BE INCORPORATED AS A RESULT OF ERRONEOUS INFORMATION PROVIDED BY OTHERS.

LEGEND

	ELECTRIC — OHE —		WATER — W —
	○ LIGHT POLE		○ FIRE HYDRANT
	PP □ POWER POLE		○ METER
	— GUY WIRE		T WATER VALVE
	— TELEPHONE — T —		X R.C.P. REMOVAL
	MH □ TELEPHONE MANHOLE		— CHAIN LINK FENCE
	□ TELEPHONE PEDESTAL		— WOOD FENCE
	TS □ TELEPHONE SIGN		— EXISTING ASPHALT
	— GAS — G —		— EXISTING DIRT OR GRAVEL
	GM ○ GAS METER		— EX. CONCRETE
	GS ○ GAS SIGN		— TREE/TREE LINE
	— LAND USE		— EXISTING CURB
	R.R. □ RAILROAD SIGN		— PROP. CURB
	□ SIGN		— EX. PROPERTY LINE
	I.R. □ FOUND IRON ROD		— PROP. CENTERLINE
	□ TEMP BENCHMARK		— PROP. R.O.W.
	— WASTEWATER — WW —		— PROP. INLET
	MH ○ WASTEWATER MANHOLE		— P.V.M. TOP OF PAVEMENT
	CO ○ CLEANOUT		— T.C. TOP OF CURB
			— C.R. CURB RETURN

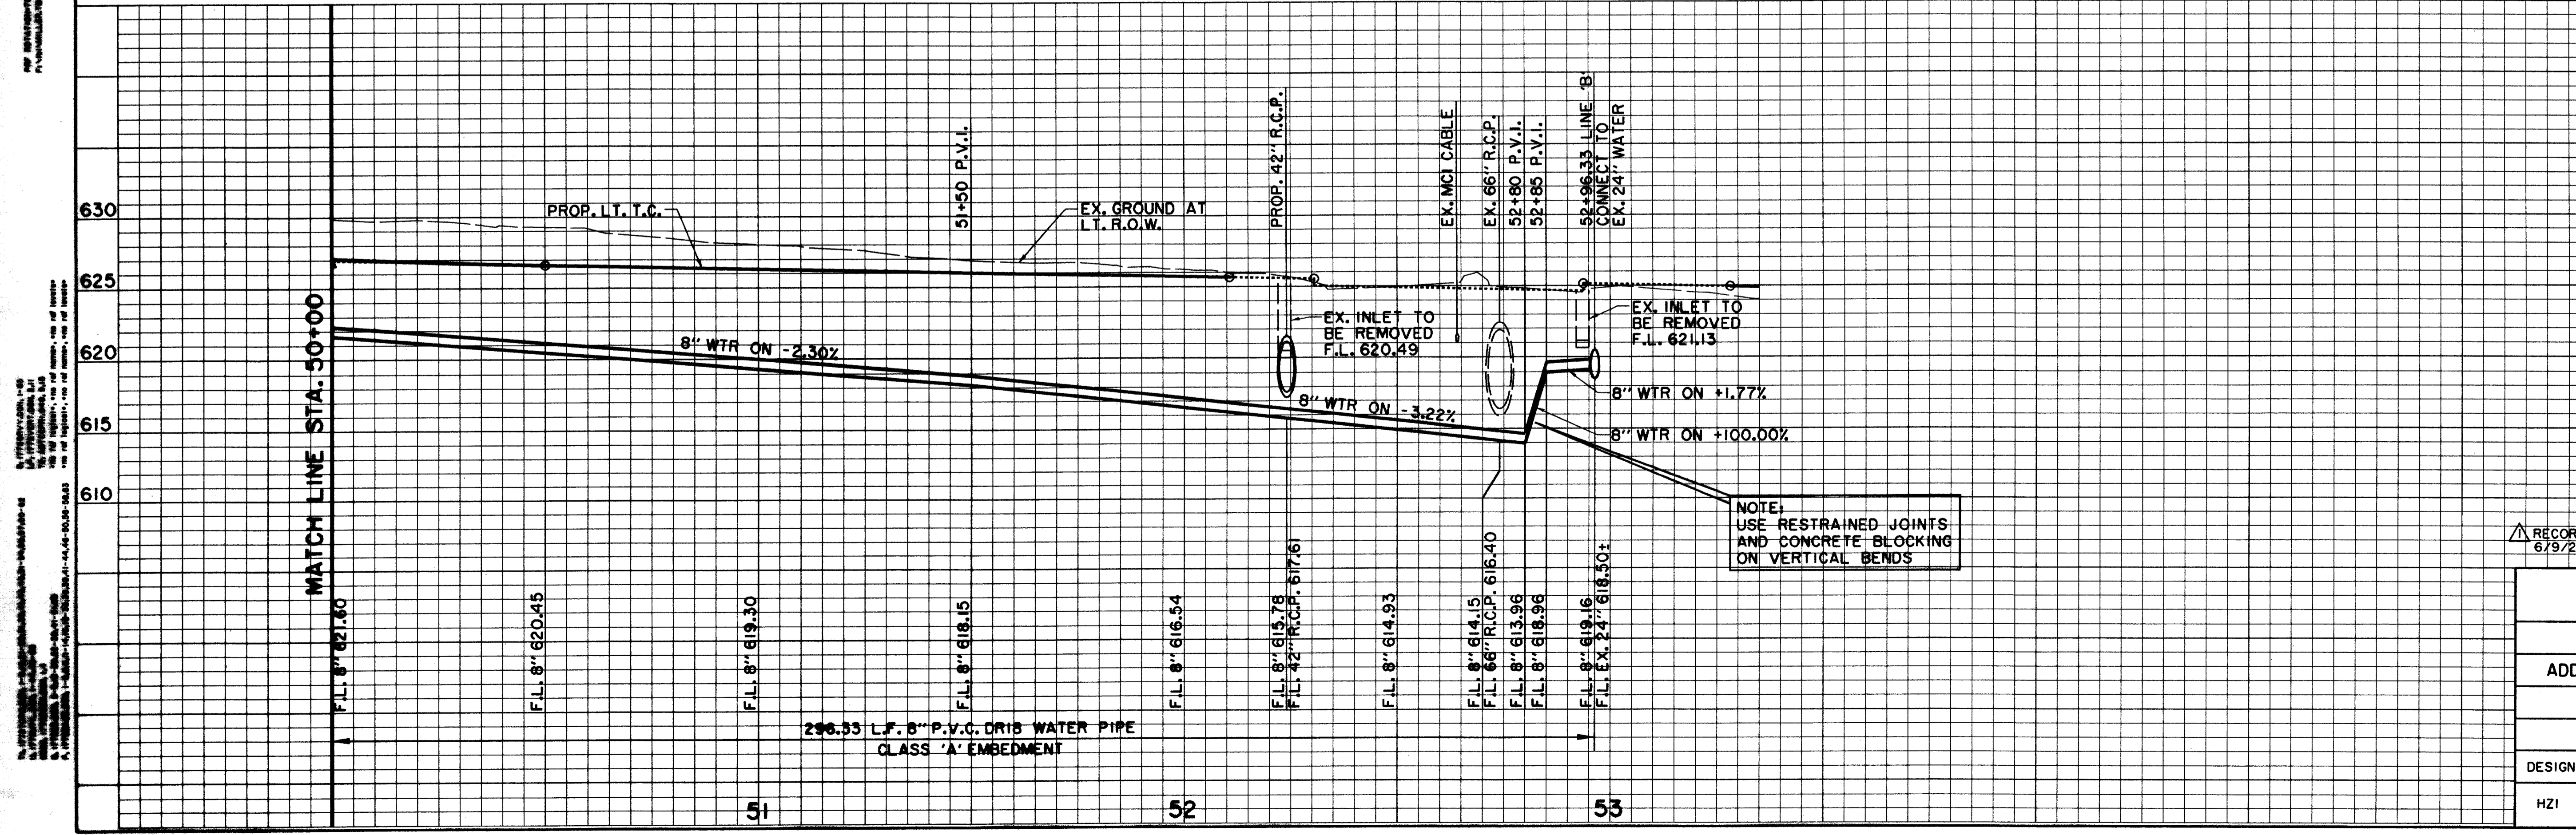

BENCHMARKS:


630	USC & GS E-921 DISK IN BRICK WALL OF OLD ADDISON SCHOOL HOUSE (MAGIC TIME MACHINE RESTAURANT) ON SOUTH WALL, 4' EAST OF CENTER OF THE ENTRANCE, 4.7' ABOVE THE GROUND. ELEV. 650.61
625	'□' ON SOUTHEAST CORNER OF CONCRETE WALK AT FRONT ENTRANCE TO 4805 ARAPAHO ROAD. ELEV. 630.61
620	
615	THE SEAL APPEARING ON THIS DOCUMENT WAS AUTHORIZED BY KENNETH A. ROBERTS, P.E. 55446 ON OCTOBER 24, 1997
610	

WATER PLAN & PROFILE
STA. 50+00 TO STA. 55+00
ARAPAHO ROAD
 ADDISON ROAD TO DALLAS NORTH TOLLWAY
 TOWN OF ADDISON, TEXAS

Hui!!-Zollars, Inc./Consulting Engineers
 Dallas, Fort Worth, Houston, Phoenix, Tustin

DESIGN	DRAWN	APPR.	SCALE	DATE	PROJECT NO.	NO.
HZ1	HZ1	KAR	H ₁ "=20' V ₁ "=6'	OCT 97	1772-01	W-3


ALL INFORMATION CONTAINED HEREIN IS THE PROPERTY OF HUI!!-ZOLLARS, INC. AND IS TO BE USED ONLY FOR THE PROJECT AND SITE SPECIFICALLY IDENTIFIED HEREIN. ANY REUSE OR MODIFICATION OF THIS INFORMATION WITHOUT THE WRITTEN CONSENT OF HUI!!-ZOLLARS, INC. IS STRICTLY PROHIBITED.

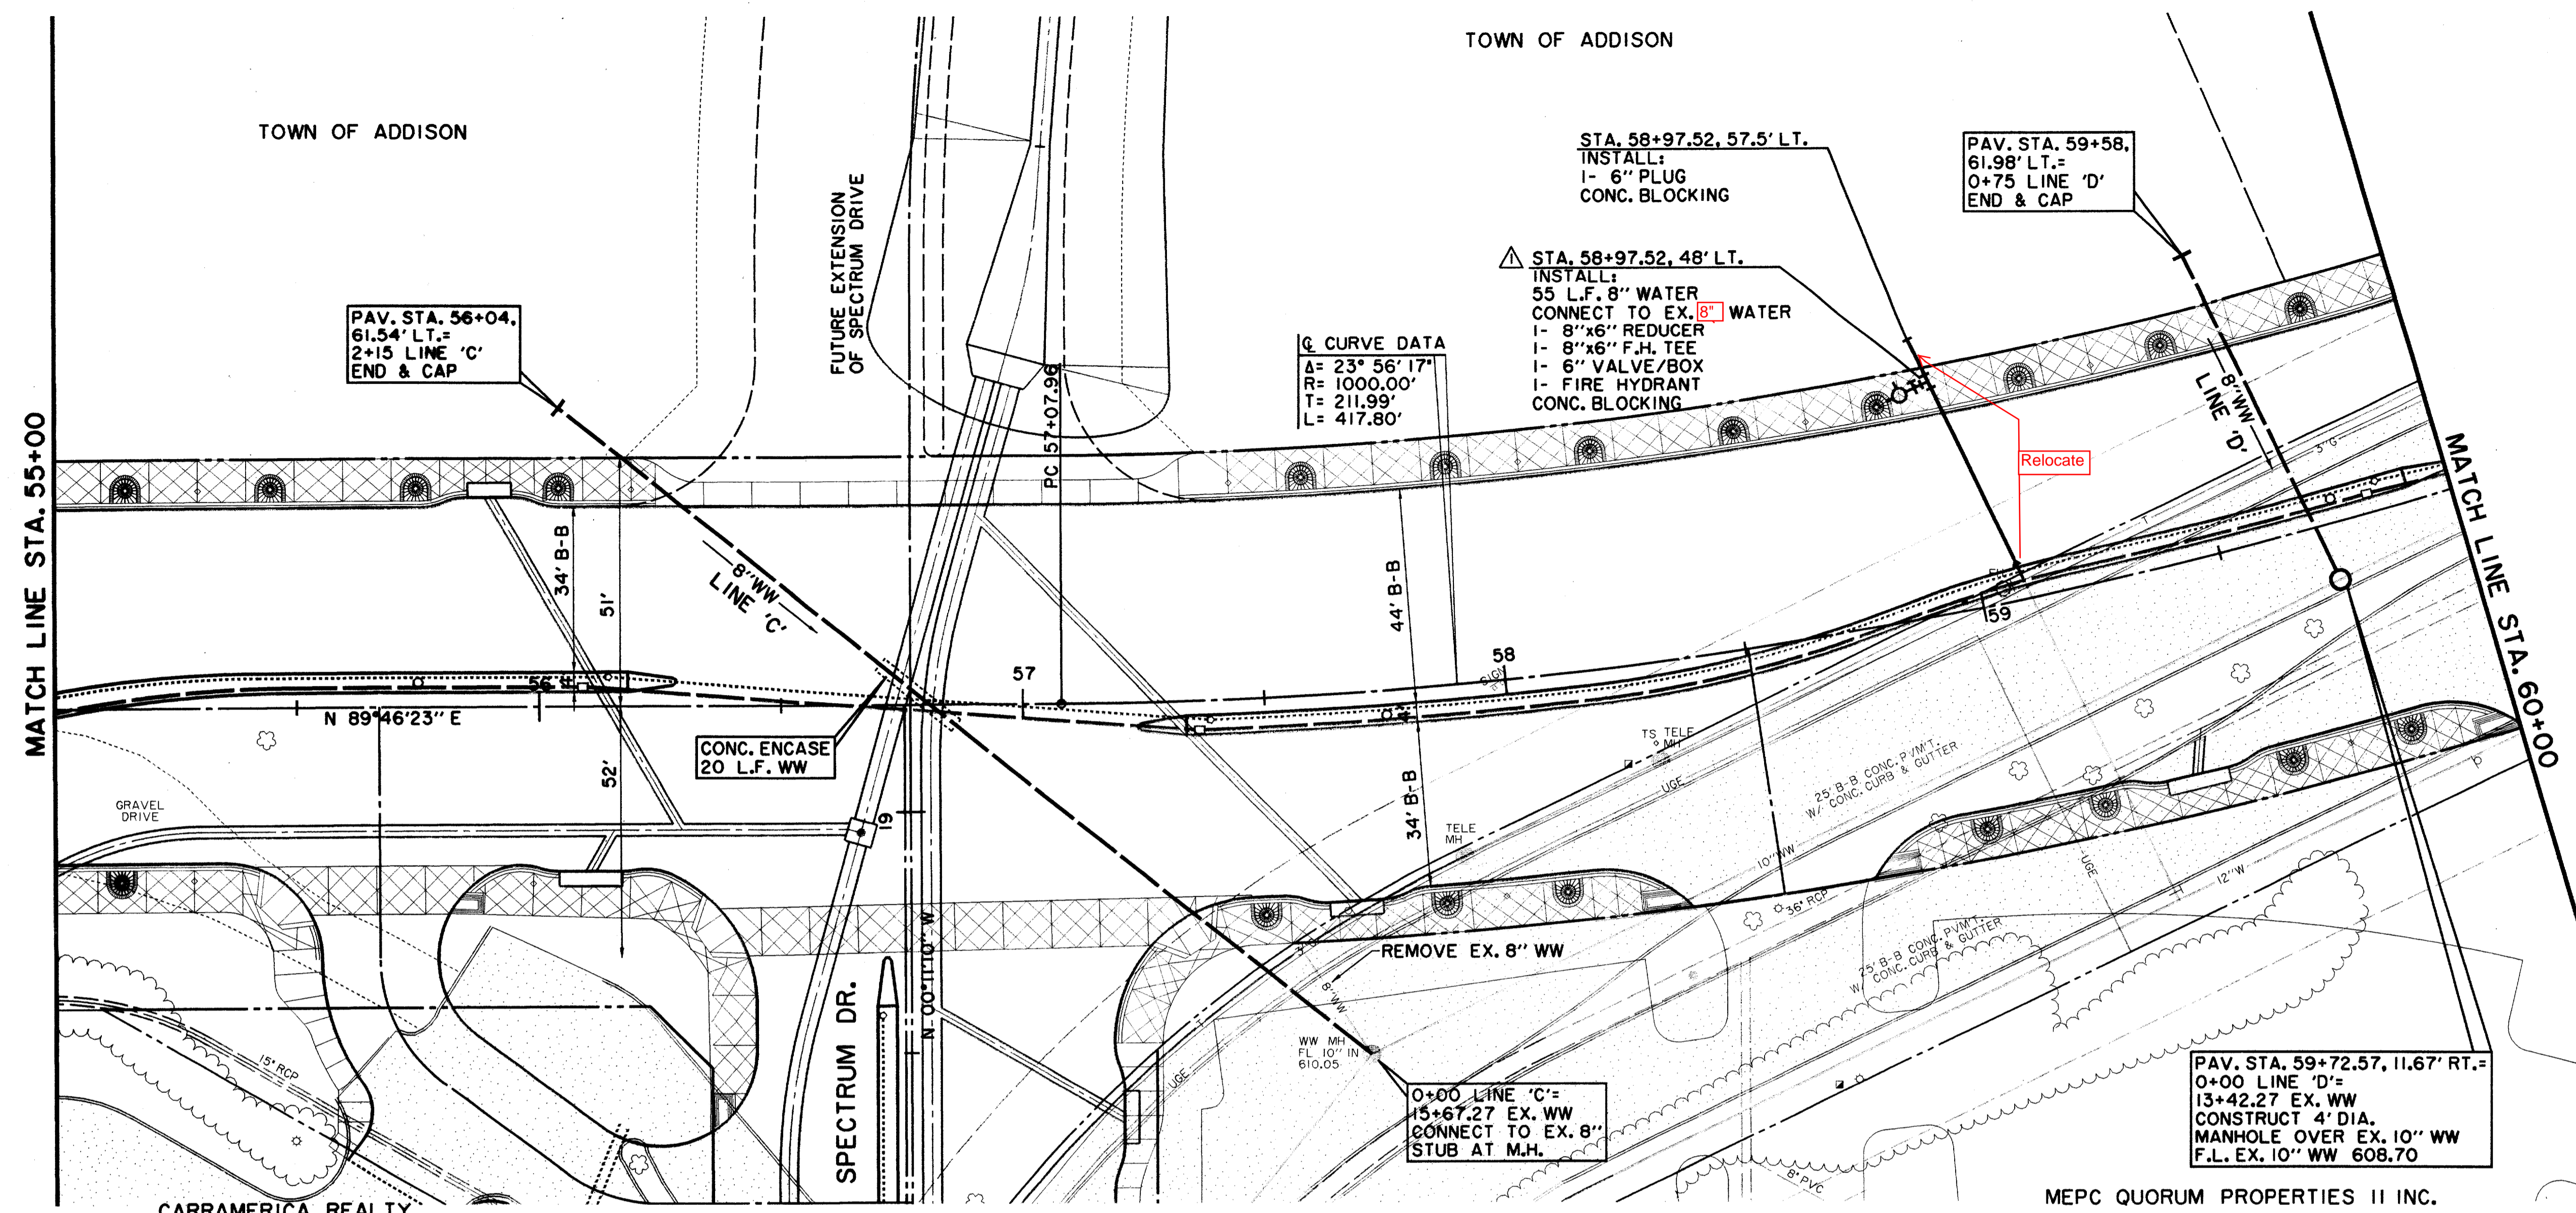

THESE RECORD DOCUMENTS HAVE BEEN PREPARED BASED ON INFORMATION PROVIDED BY OTHERS. THE CONSULTANT HAS NOT VERIFIED THE ACCURACY AND/OR COMPLETENESS OF THIS INFORMATION AND SHALL NOT BE RESPONSIBLE FOR ANY ERRORS OR OMISSIONS THAT MAY BE INCORPORATED AS A RESULT OF ERRONEOUS INFORMATION PROVIDED BY OTHERS.


LEGEND

	ELECTRIC		WATER
	LIGHT POLE		FIRE HYDRANT
	POWER POLE		METER
	GUY WIRE		WATER VALVE
	TELEPHONE		MISC.
	TELEPHONE MANHOLE		CHAIN LINK FENCE
	TELEPHONE PEDESTAL		WOOD FENCE
	GAS		EXISTING ASPHALT
	GAS METER		EXISTING DIRT OR GRAVEL
	GAS SIGN		EX. CONCRETE
	LAND USE		TREE/TREE LINE
	RAILROAD SIGN		EXISTING CURB
	FOUND IRON ROD		PROP. CURB
	TEMP BENCHMARK		EX. PROPERTY LINE
	WASTEWATER		PROP. CENTERLINE
	WASTEWATER MANHOLE		PROP. R.O.W.
	CLEANOUT		PROP. INLET
			P.V.M.T. TOP OF PAVEMENT
			T.C. TOP OF CURB
			C.R. CURB RETURN

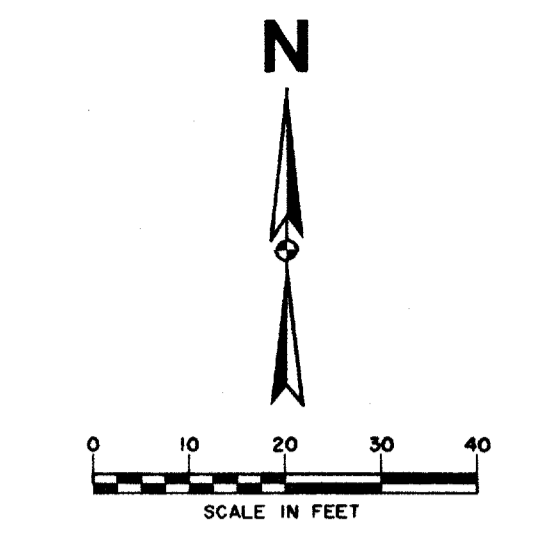


THE INFORMATION CONTAINED HEREIN IS THE PROPERTY OF HUNT-ZOLLERS, INC. AND IS NOT TO BE REPRODUCED OR TRANSMITTED IN ANY FORM OR BY ANY MEANS, ELECTRONIC OR MECHANICAL, INCLUDING PHOTOCOPYING, RECORDING, OR BY ANY INFORMATION STORAGE AND RETRIEVAL SYSTEM, WITHOUT THE WRITTEN PERMISSION OF HUNT-ZOLLERS, INC.

HUNT-ZOLLERS, INC. CONSULTING ENGINEERS
 11111 W. HUNTSVILLE BLVD., SUITE 100
 FORT WORTH, TEXAS 76116
 TEL: 817-335-1111 FAX: 817-335-1112
 WWW.HUNT-ZOLLERS.COM

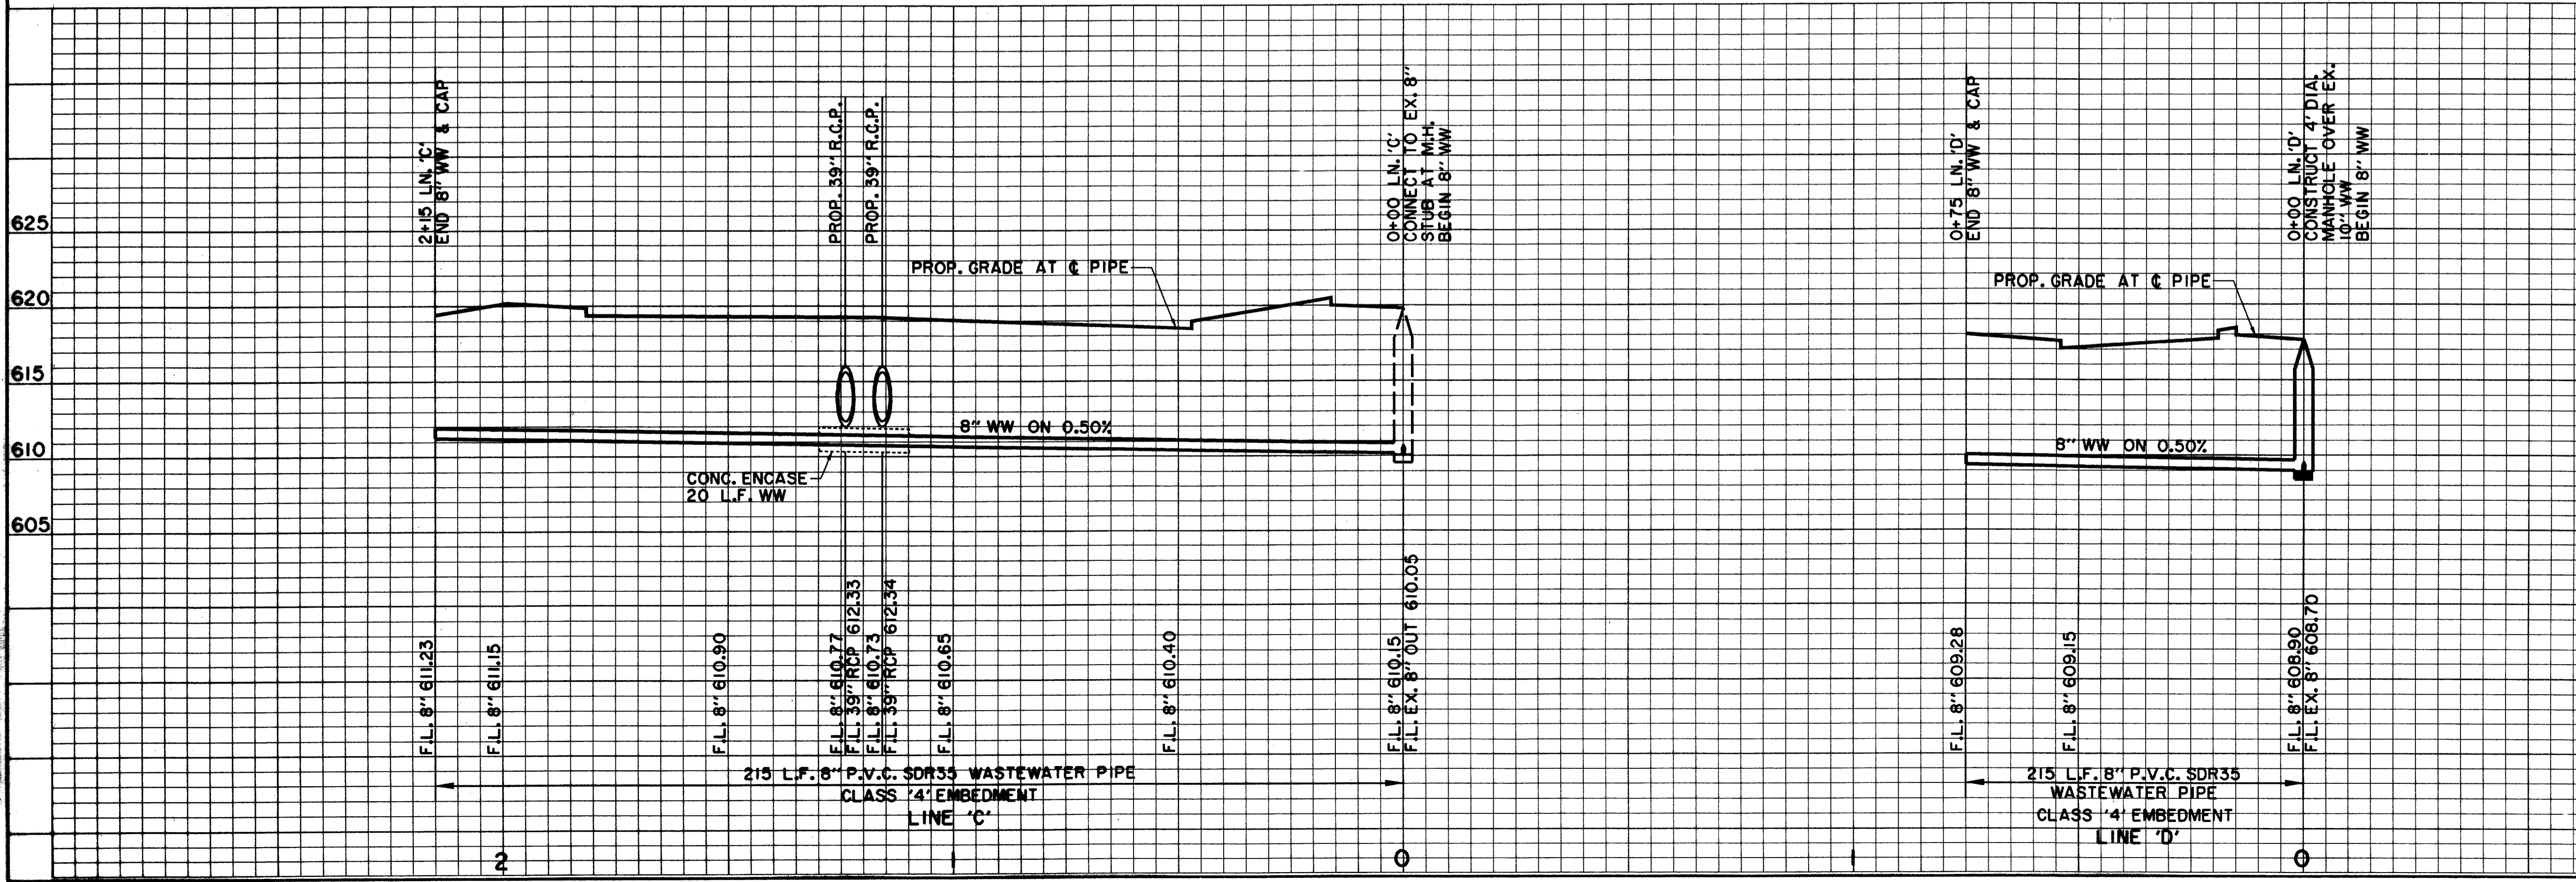



BENCHMARKS:
 USC & GS E-921 DISK IN BRICK WALL OF OLD ADDISON SCHOOL HOUSE (MAGIC TIME MACHINE RESTAURANT) ON SOUTH WALL, 4' EAST OF CENTER OF THE ENTRANCE, 4.7' ABOVE THE GROUND. ELEV. 650.61
 "I" ON SOUTHEAST CORNER OF CONCRETE WALK AT FRONT ENTRANCE TO 4805 ARAPAHO ROAD. ELEV. 630.61

THE SEAL APPEARING ON THIS DOCUMENT WAS AUTHORIZED BY KENNETH A. ROBERTS, P.E. 55446 ON OCTOBER 24, 1997

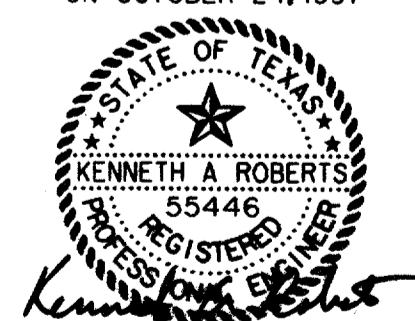

RECORD DOCUMENTS
6/9/2000


WATER & WASTEWATER PLAN & PROFILE						
STA. 55+00 TO STA. 60+00						
ARAPAHO ROAD						
ADDISON ROAD TO DALLAS NORTH TOLLWAY						
TOWN OF ADDISON, TEXAS						
Hunt-Zollers, Inc./Consulting Engineers Dallas, Fort Worth, Houston, Phoenix, Tustin						
DESIGN	DRAWN	APPR.	SCALE	DATE	PROJECT NO.	NO.
HZI	HZI	KAR	H ₁ 1"=20' V ₁ 1"=6'	OCT 97	1772-01	W-4

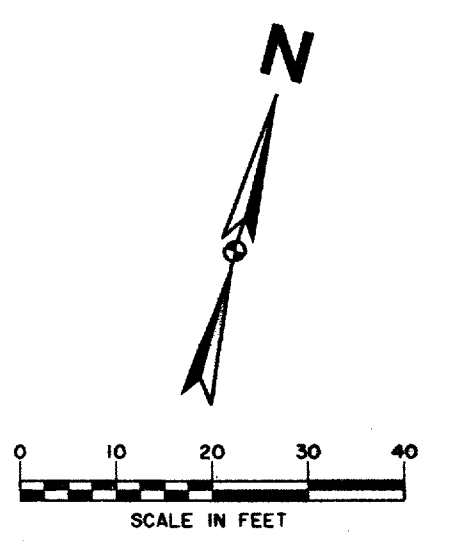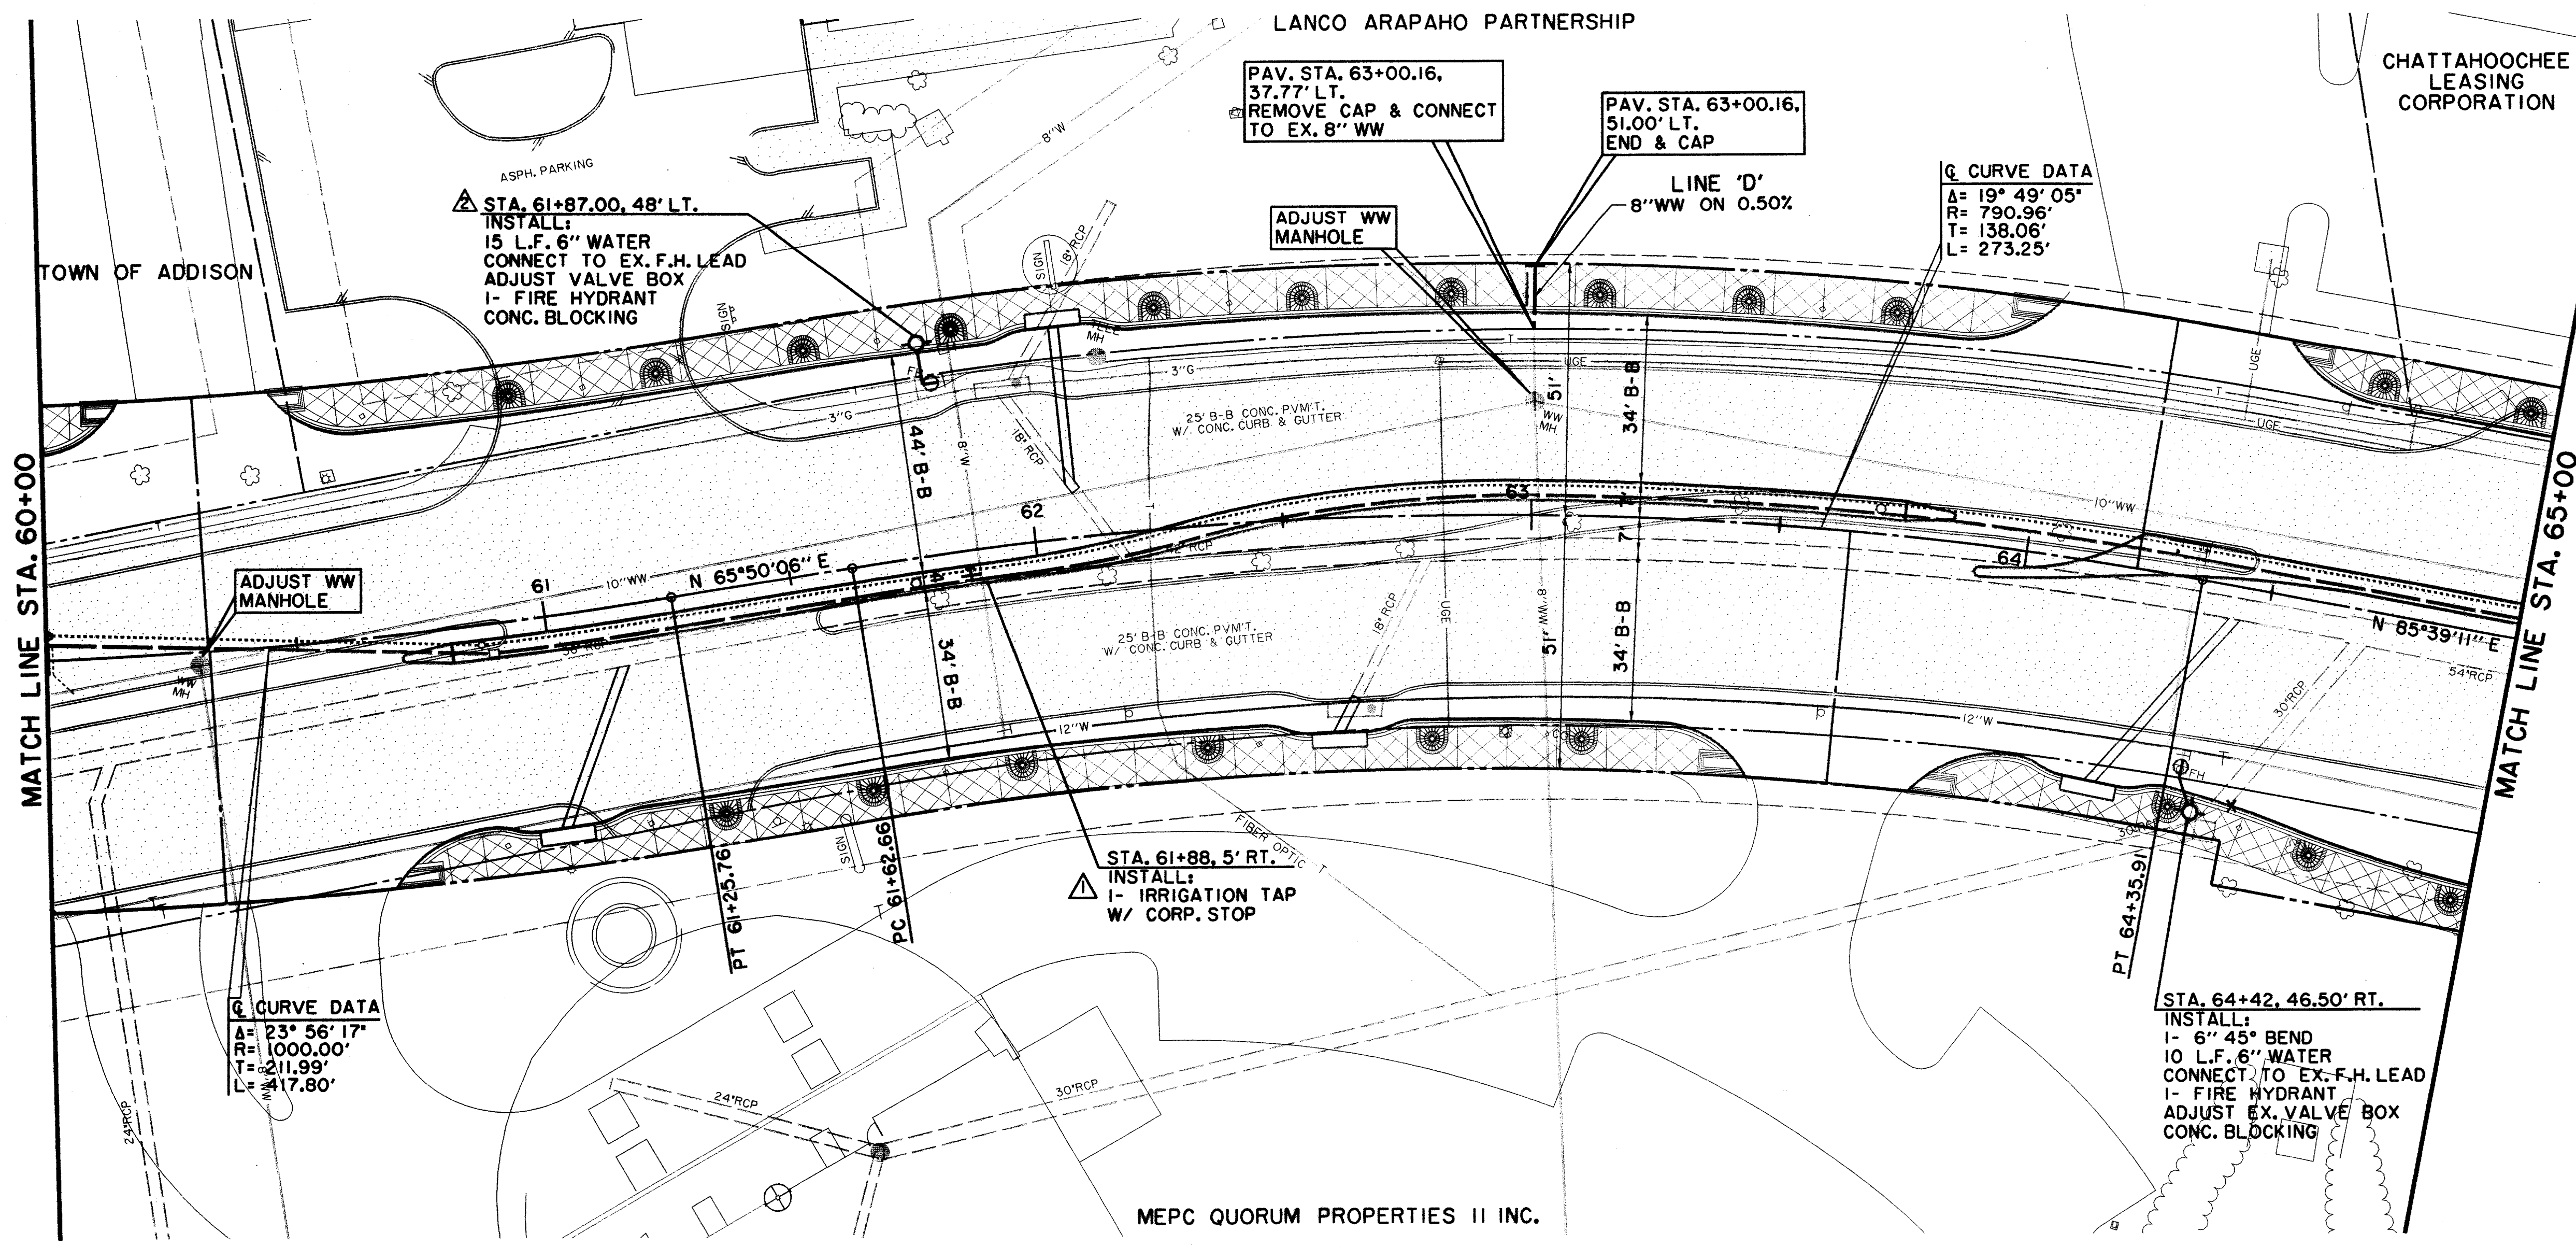

THESE RECORD DOCUMENTS HAVE BEEN PREPARED BASED ON INFORMATION PROVIDED BY OTHERS. THE CONSULTANT HAS NOT VERIFIED THE ACCURACY AND/OR COMPLETENESS OF THIS INFORMATION AND SHALL NOT BE RESPONSIBLE FOR ANY ERRORS OR OMISSIONS THAT MAY BE INCORPORATED AS A RESULT OF ERRONEOUS INFORMATION PROVIDED BY OTHERS.

LEGEND

ELECTRIC — OHE —	WATER — W —
⊙ LIGHT POLE	⊙ FIRE HYDRANT
⊙ POWER POLE	⊙ METER
← GUY WIRE	⊙ WATER VALVE
TELEPHONE — T —	MISC.
⊙ TELEPHONE MANHOLE	X X X R.C.P. REMOVAL
⊙ TELEPHONE PEDESTAL	— CHAIN LINK FENCE
⊙ TELEPHONE SIGN	— WOOD FENCE
— GAS —	— EXISTING ASPHALT
⊙ GAS METER	— EXISTING DIRT OR GRAVEL
⊙ GAS SIGN	— EX. CONCRETE
LAND USE	— TREE/TREE LINE
R.R. RAILROAD SIGN	— EXISTING CURB
⊙ SIGN	— PROP. CURB
SURVEY	— EX. PROPERTY LINE
⊙ FOUND IRON ROD	— PROP. CENTERLINE
⊙ TEMP BENCHMARK	— PROP. R.O.W.
WASTEWATER — WW —	— PROP. INLET
⊙ WASTEWATER MANHOLE	— TOP OF PAVEMENT
⊙ CLEANOUT	— TOP OF CURB
	— C.R. CURB RETURN

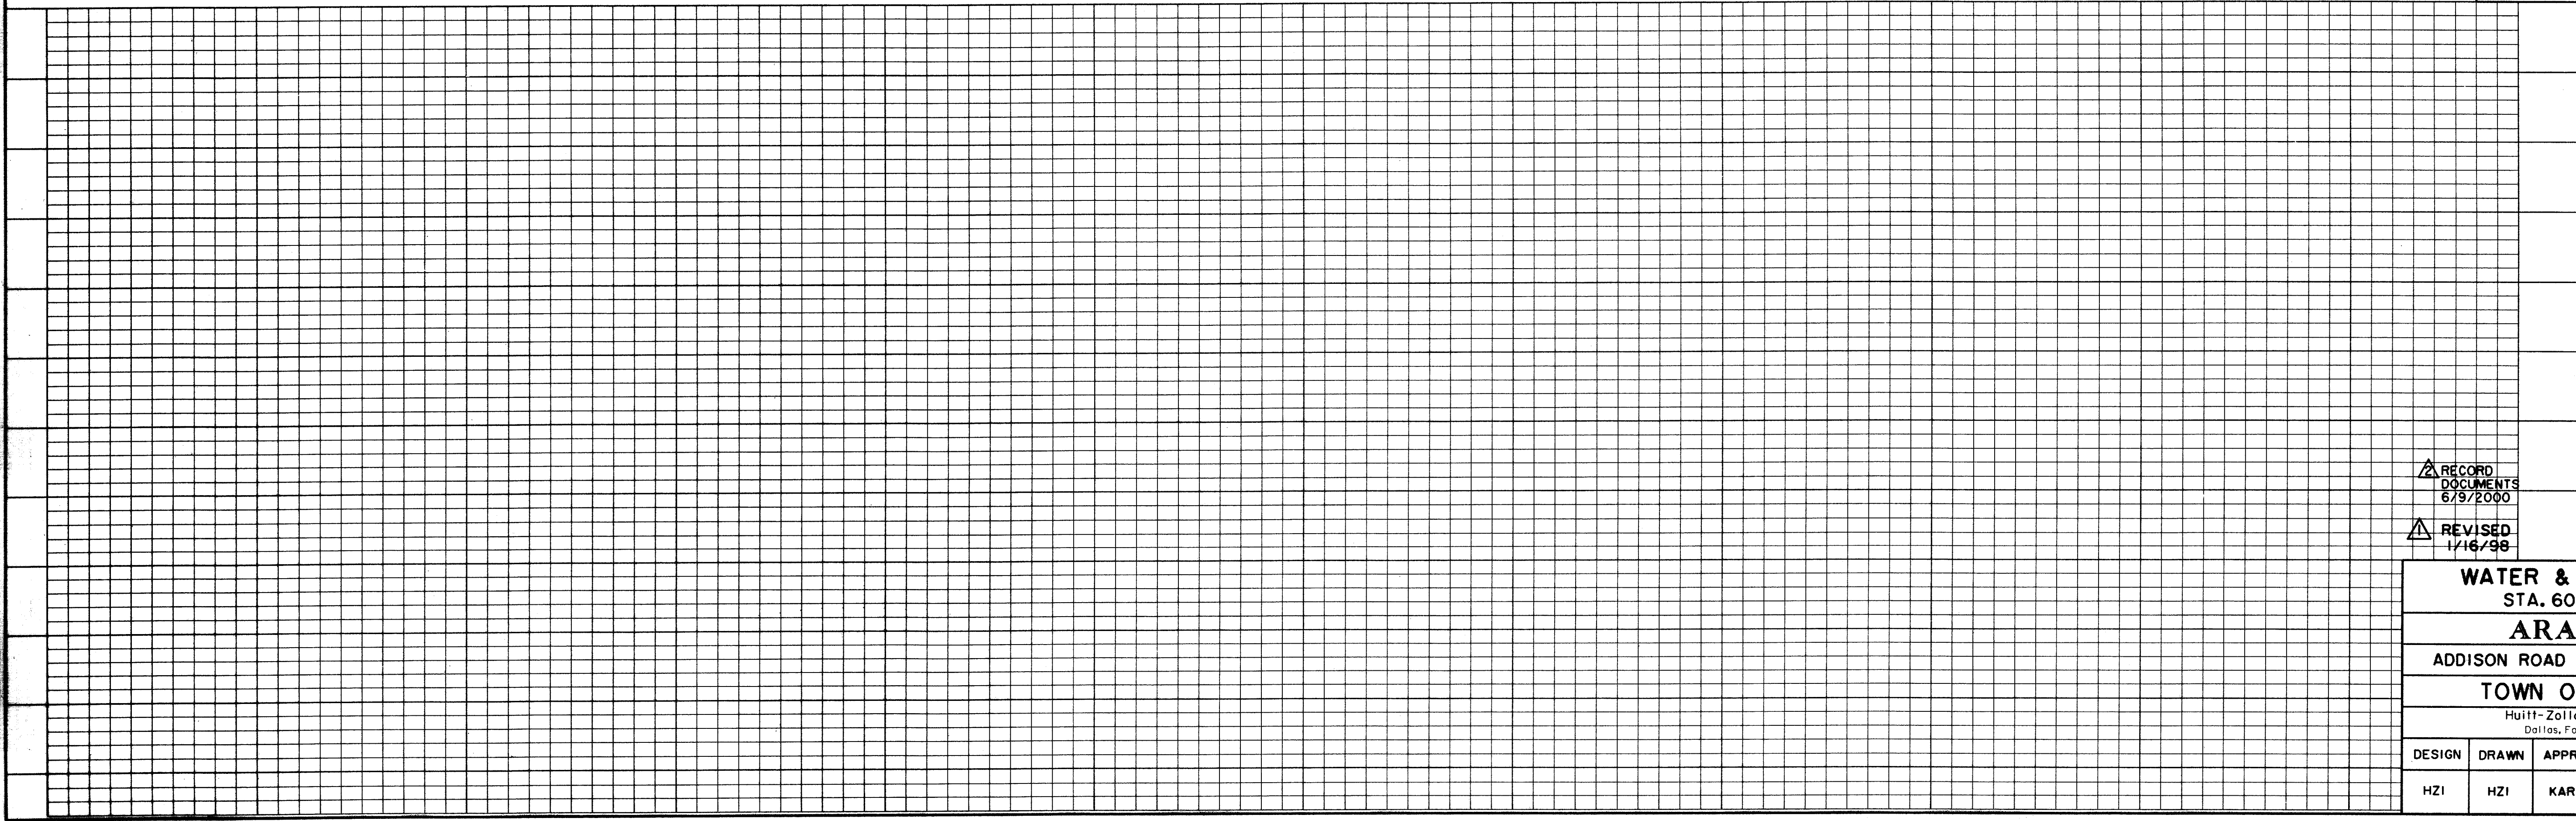

BENCHMARKS:

USC & GS E-921 DISK IN BRICK WALL OF OLD ADDISON SCHOOL HOUSE (MAGIC TIME MACHINE RESTAURANT) ON SOUTH WALL, 4' EAST OF CENTER OF THE ENTRANCE, 4.7' ABOVE THE GROUND. ELEV. 650.61

"I" ON SOUTHEAST CORNER OF CONCRETE WALK AT FRONT ENTRANCE TO 4805 ARAPAH0 ROAD. ELEV. 630.61


THE SEAL APPEARING ON THIS DOCUMENT WAS AUTHORIZED BY KENNETH A. ROBERTS, P.E. 55446 ON OCTOBER 24, 1997

10-28-97

RECORD DOCUMENTS
6/9/2000


REVISED
1/16/98

WATER & WASTEWATER PLAN						
STA. 60+00 TO STA. 65+00						
ARAPAH0 ROAD						
ADDISON ROAD TO DALLAS NORTH TOLLWAY						
TOWN OF ADDISON, TEXAS						
Hult-Zollers, Inc./Consulting Engineers Dallas, Fort Worth, Houston, Phoenix, Tusin						
DESIGN	DRAWN	APPR.	SCALE	DATE	PROJECT NO.	NO.
HZI	HZI	KAR	H ₁ 1"=20' V ₁ 1"=6'	OCT 97	1772-01	W-5

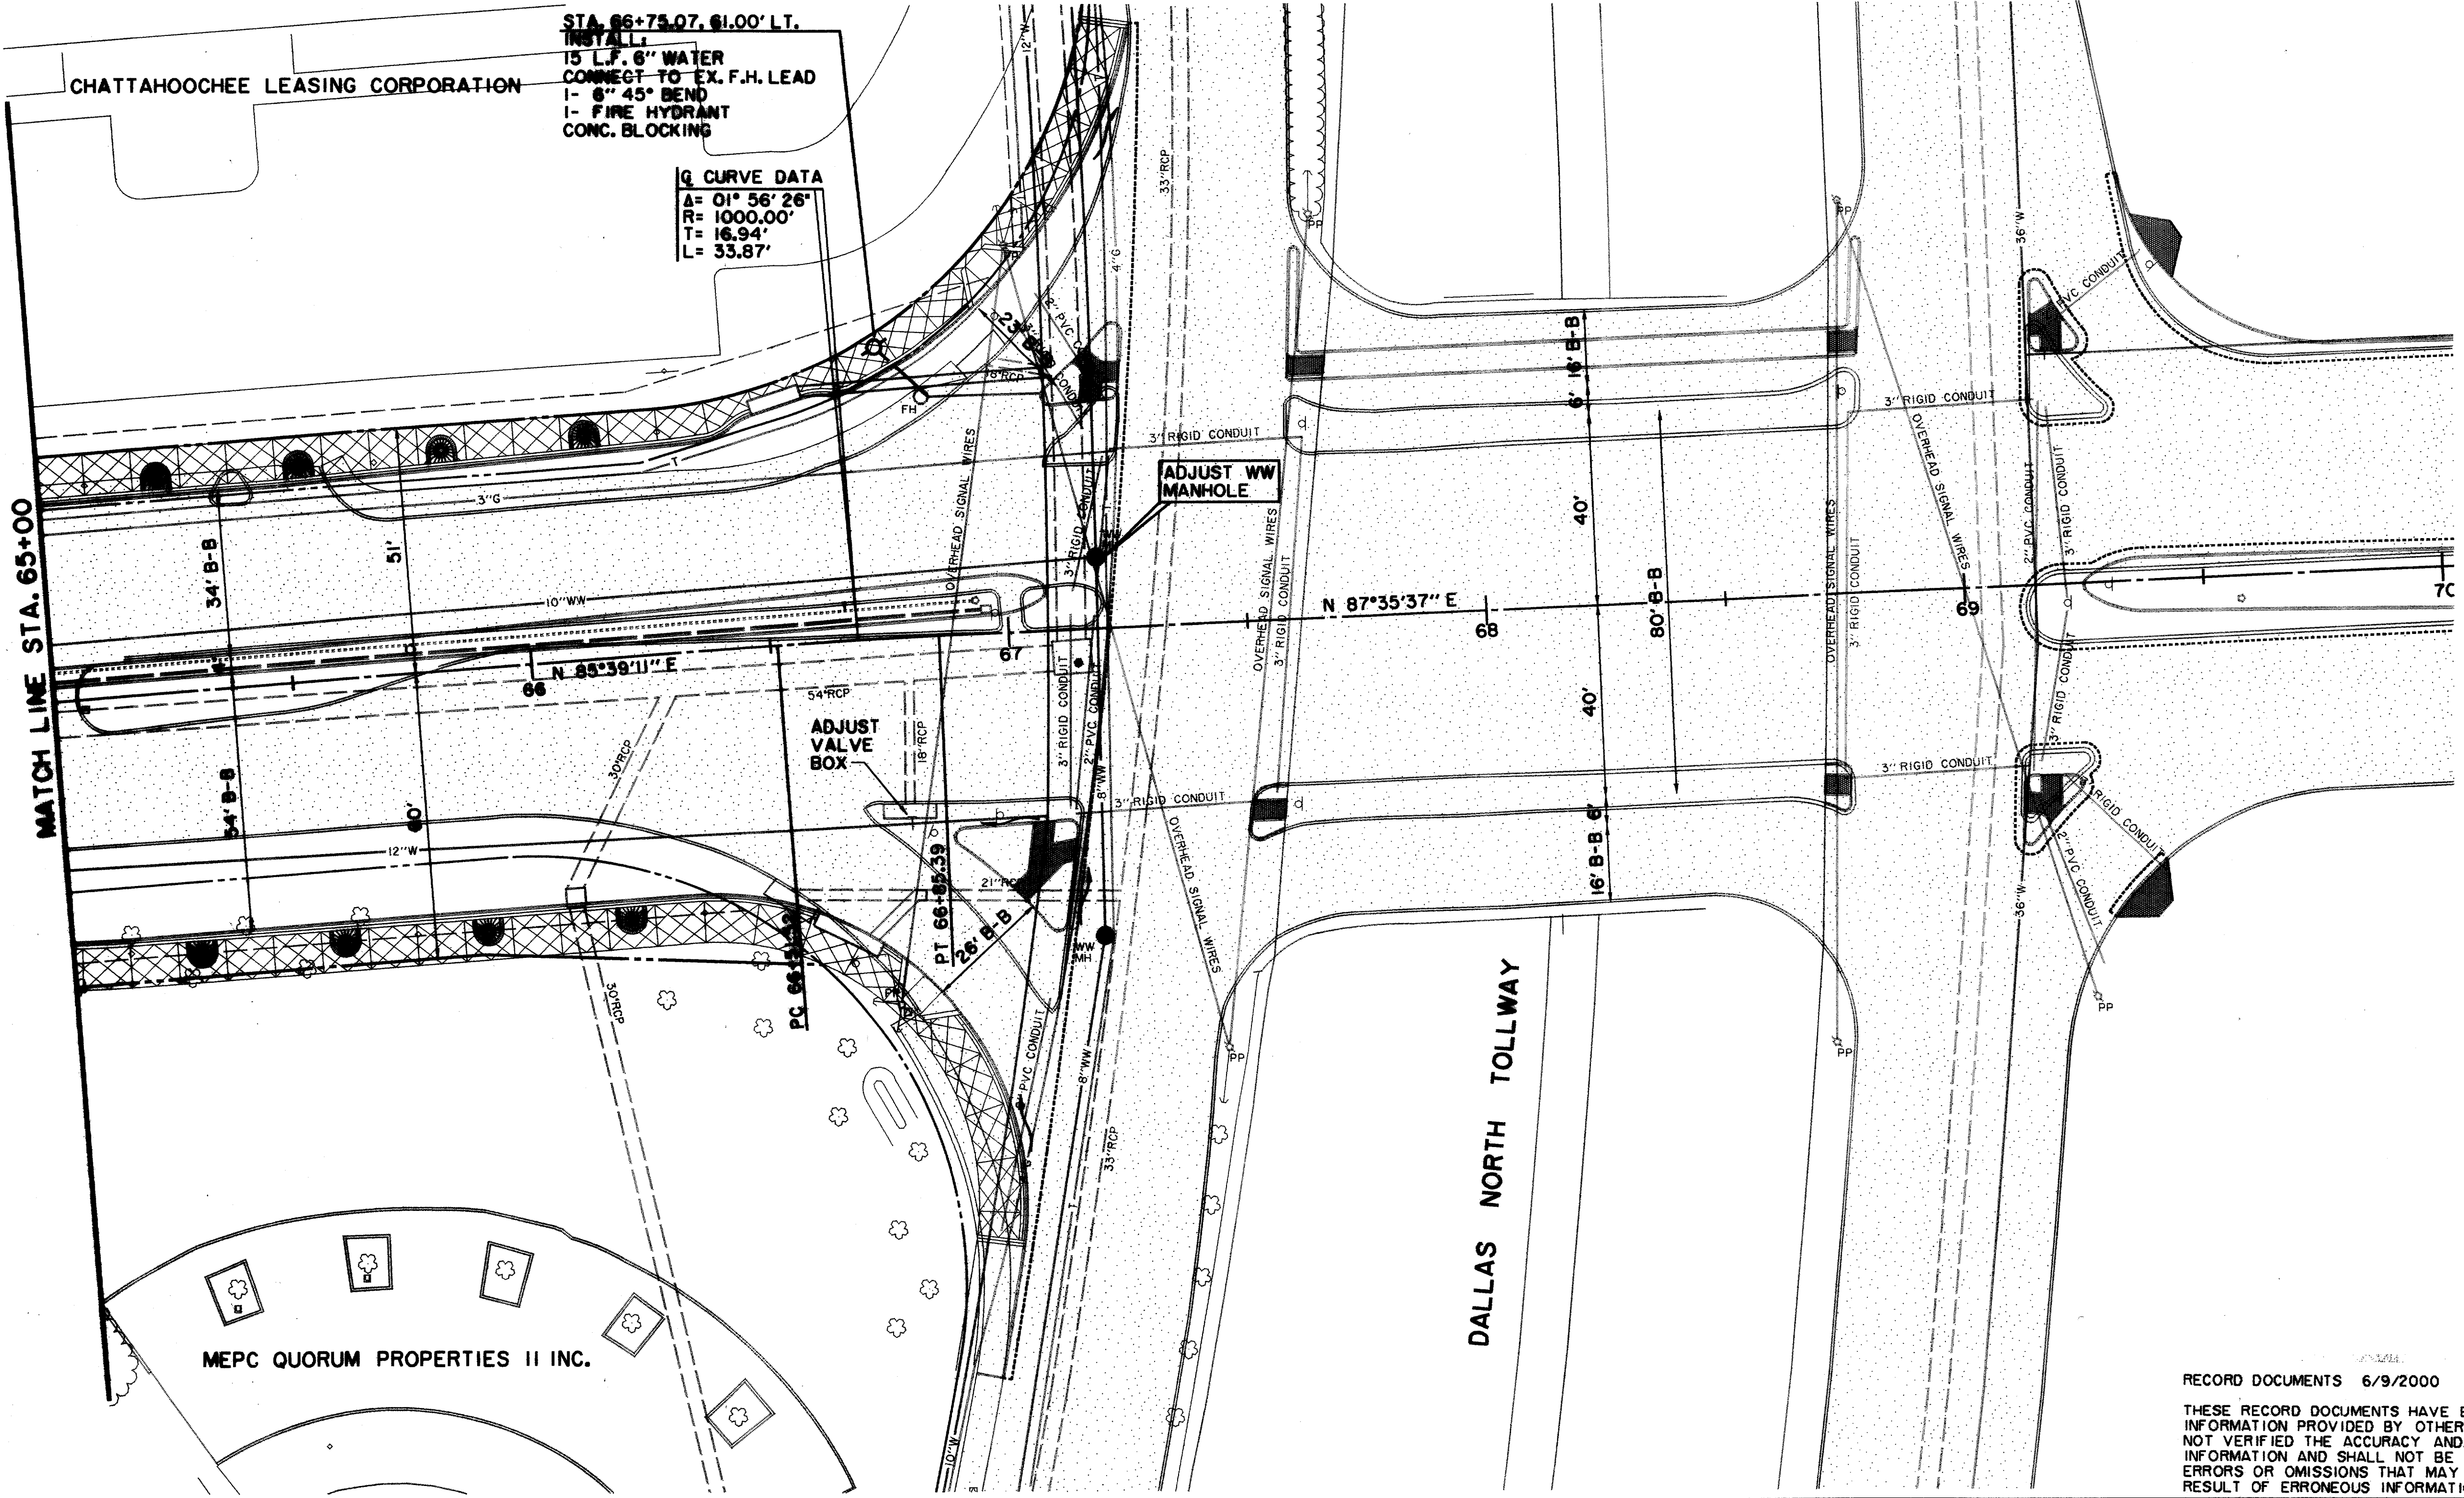

STA. 66+75.07, 61.00' LT.
 INSTALL
 15 L.F. 8" WATER
 CONNECT TO EX. F.H. LEAD
 1- 6" 45° BEND
 1- FIRE HYDRANT
 CONC. BLOCKING

Q CURVE DATA
 Δ = 01° 56' 26"
 R = 1000.00'
 T = 18.94'
 L = 33.87'

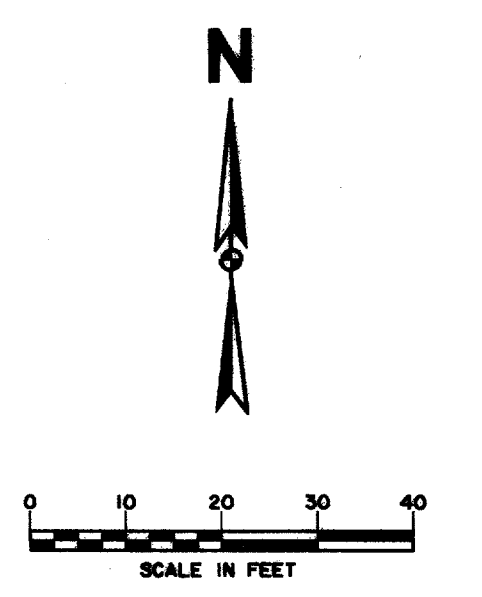

LEGEND

	ELECTRIC — OHE		WATER — W
	○ LIGHT POLE		FH FIRE HYDRANT
	pp POWER POLE		WM METER
	— GUY WIRE		T WATER VALVE
	TELEPHONE — T		MISC. R.C.P. REMOVAL
	TELEPHONE MANHOLE		CHAIN LINK FENCE
	TELEPHONE PEDESTAL		WOOD FENCE
	TELEPHONE SIGN		EXISTING ASPHALT
	GAS — G		EXISTING DIRT OR GRAVEL
	GM GAS METER		EX. CONCRETE
	GS GAS SIGN		TREE/TREE LINE
	LAND USE		EXISTING CURB
	RR RAILROAD SIGN		PROP. CURB
	SIGN		EX. PROPERTY LINE
	SURVEY		PROP. CENTERLINE
	I.R. FOUND IRON ROD		PROP. R.O.W.
	TEMP BENCHMARK		PROP. INLET
	WASTEWATER — WW		PROP. R.O.W.
	WM WASTEWATER MANHOLE		P.V.M.T. TOP OF PAVEMENT
	CO CLEANOUT		T.C. TOP OF CURB
			C.R. CURB RETURN

BENCHMARKS:
 USC & GS E-921 DISK IN BRICK WALL OF OLD ADDISON SCHOOL HOUSE (MAGIC TIME MACHINE RESTAURANT) ON SOUTH WALL, 4' EAST OF CENTER OF THE ENTRANCE, 4.7' ABOVE THE GROUND. ELEV. 650.61

"I" ON SOUTHEAST CORNER OF CONCRETE WALK AT FRONT ENTRANCE TO 4805 ARAPAHO ROAD. ELEV. 630.61

RECORD DOCUMENTS 6/9/2000

THESE RECORD DOCUMENTS HAVE BEEN PREPARED BASED ON INFORMATION PROVIDED BY OTHERS. THE CONSULTANT HAS NOT VERIFIED THE ACCURACY AND/OR COMPLETENESS OF THIS INFORMATION AND SHALL NOT BE RESPONSIBLE FOR ANY ERRORS OR OMISSIONS THAT MAY BE INCORPORATED AS A RESULT OF ERRONEOUS INFORMATION PROVIDED BY OTHERS.

ALL INFORMATION CONTAINED HEREIN IS THE PROPERTY OF HUIFF-ZOLLARS, INC. AND IS NOT TO BE REPRODUCED OR TRANSMITTED IN ANY FORM OR BY ANY MEANS, ELECTRONIC OR MECHANICAL, INCLUDING PHOTOCOPYING, RECORDING, OR BY ANY INFORMATION STORAGE AND RETRIEVAL SYSTEM, WITHOUT THE WRITTEN PERMISSION OF HUIFF-ZOLLARS, INC.



WATER & WASTEWATER PLAN
 STA. 65+00 TO DALLAS NORTH TOLLWAY
ARAPAHO ROAD
 ADDISON ROAD TO DALLAS NORTH TOLLWAY
 TOWN OF ADDISON, TEXAS

Huiff-Zollars, Inc./Consulting Engineers
 Dallas, Fort Worth, Houston, Phoenix, Tustin

DESIGN	DRAWN	APPR.	SCALE	DATE	PROJECT NO.	NO.
HZI	HZI	KAR	H ₁ 1"=20' V ₁ 1"=6'	OCT 97	1772-01	W-6

THE SEAL APPEARING ON THIS DOCUMENT WAS AUTHORIZED BY KENNETH A. ROBERTS, P.E. 55446 ON OCTOBER 24, 1997

10-24-97

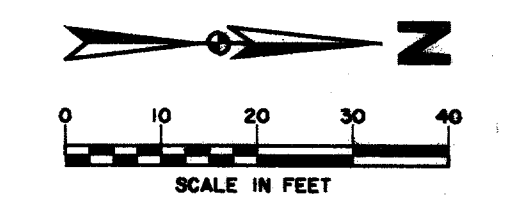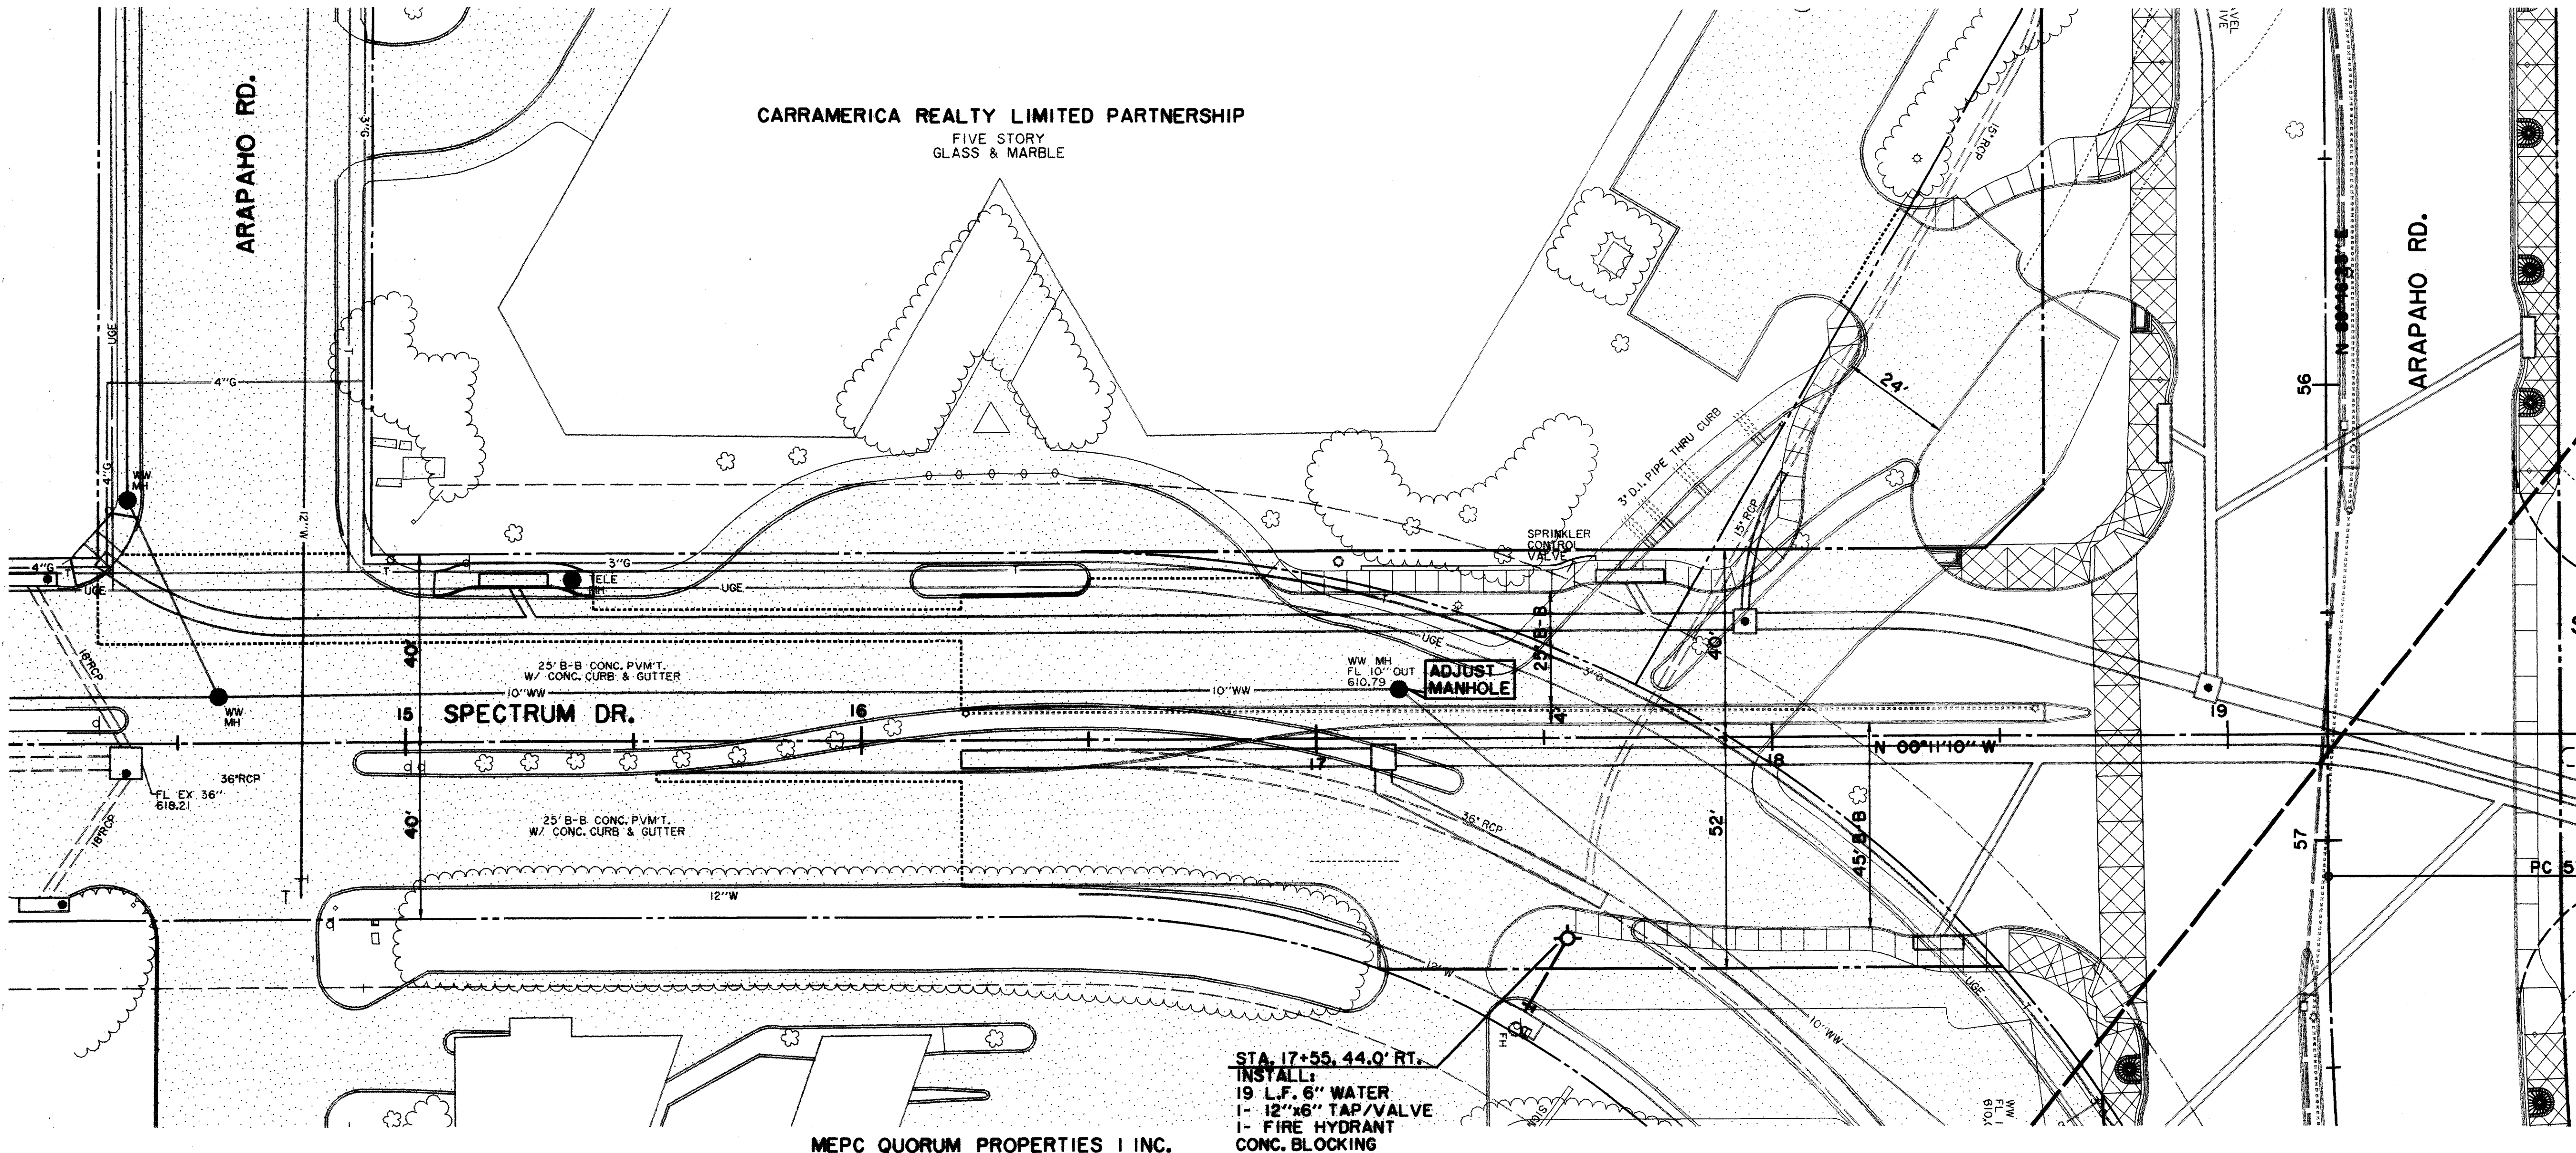

TOWN OF ADDISON

RECORD DOCUMENTS 6/9/2000
 THESE RECORD DOCUMENTS HAVE BEEN PREPARED BASED ON INFORMATION PROVIDED BY OTHERS. THE CONSULTANT HAS NOT VERIFIED THE ACCURACY AND/OR COMPLETENESS OF THIS INFORMATION AND SHALL NOT BE RESPONSIBLE FOR ANY ERRORS OR OMISSIONS THAT MAY BE INCORPORATED AS A RESULT OF ERRONEOUS INFORMATION PROVIDED BY OTHERS.


FUTURE SPECTRUM DR. EXTENSION

LEGEND

ELECTRIC — OHE —	WATER — W —
○ LIGHT POLE	○ FH FIRE HYDRANT
pp POWER POLE	WM METER
— GUY WIRE	T WATER VALVE
TELEPHONE — T —	MISC.
● TELEPHONE MANHOLE	48" RCP R.C.P. REMOVAL
□ TELEPHONE PEDESTAL	— CHAIN LINK FENCE
TS TELEPHONE SIGN	— WOOD FENCE
GAS — G —	— EXISTING ASPHALT
GM GAS METER	— EXISTING DIRT OR GRAVEL
GS GAS SIGN	— EX. CONCRETE
LAND USE	— TREE/TREE LINE
R/R RAILROAD SIGN	— EXISTING CURB
○ SIGN	— PROP. CURB
SURVEY	— EX. PROPERTY LINE
I.R. FOUND IRON ROD	— PROP. CENTERLINE
□ TEMP BENCHMARK	— PROP. R.O.W.
WASTEWATER — WW —	— PROP. INLET
WM WASTEWATER MANHOLE	PVMT TOP OF PAVEMENT
CO CLEANOUT	T.C. TOP OF CURB
	C.R. CURB RETURN

STA. 17+55.44.0' RT.
 INSTALL:
 19 L.F. 8" WATER
 1- 12"x6" TAP/VALVE
 1- FIRE HYDRANT
 CONC. BLOCKING

MEPC QUORUM PROPERTIES I INC.

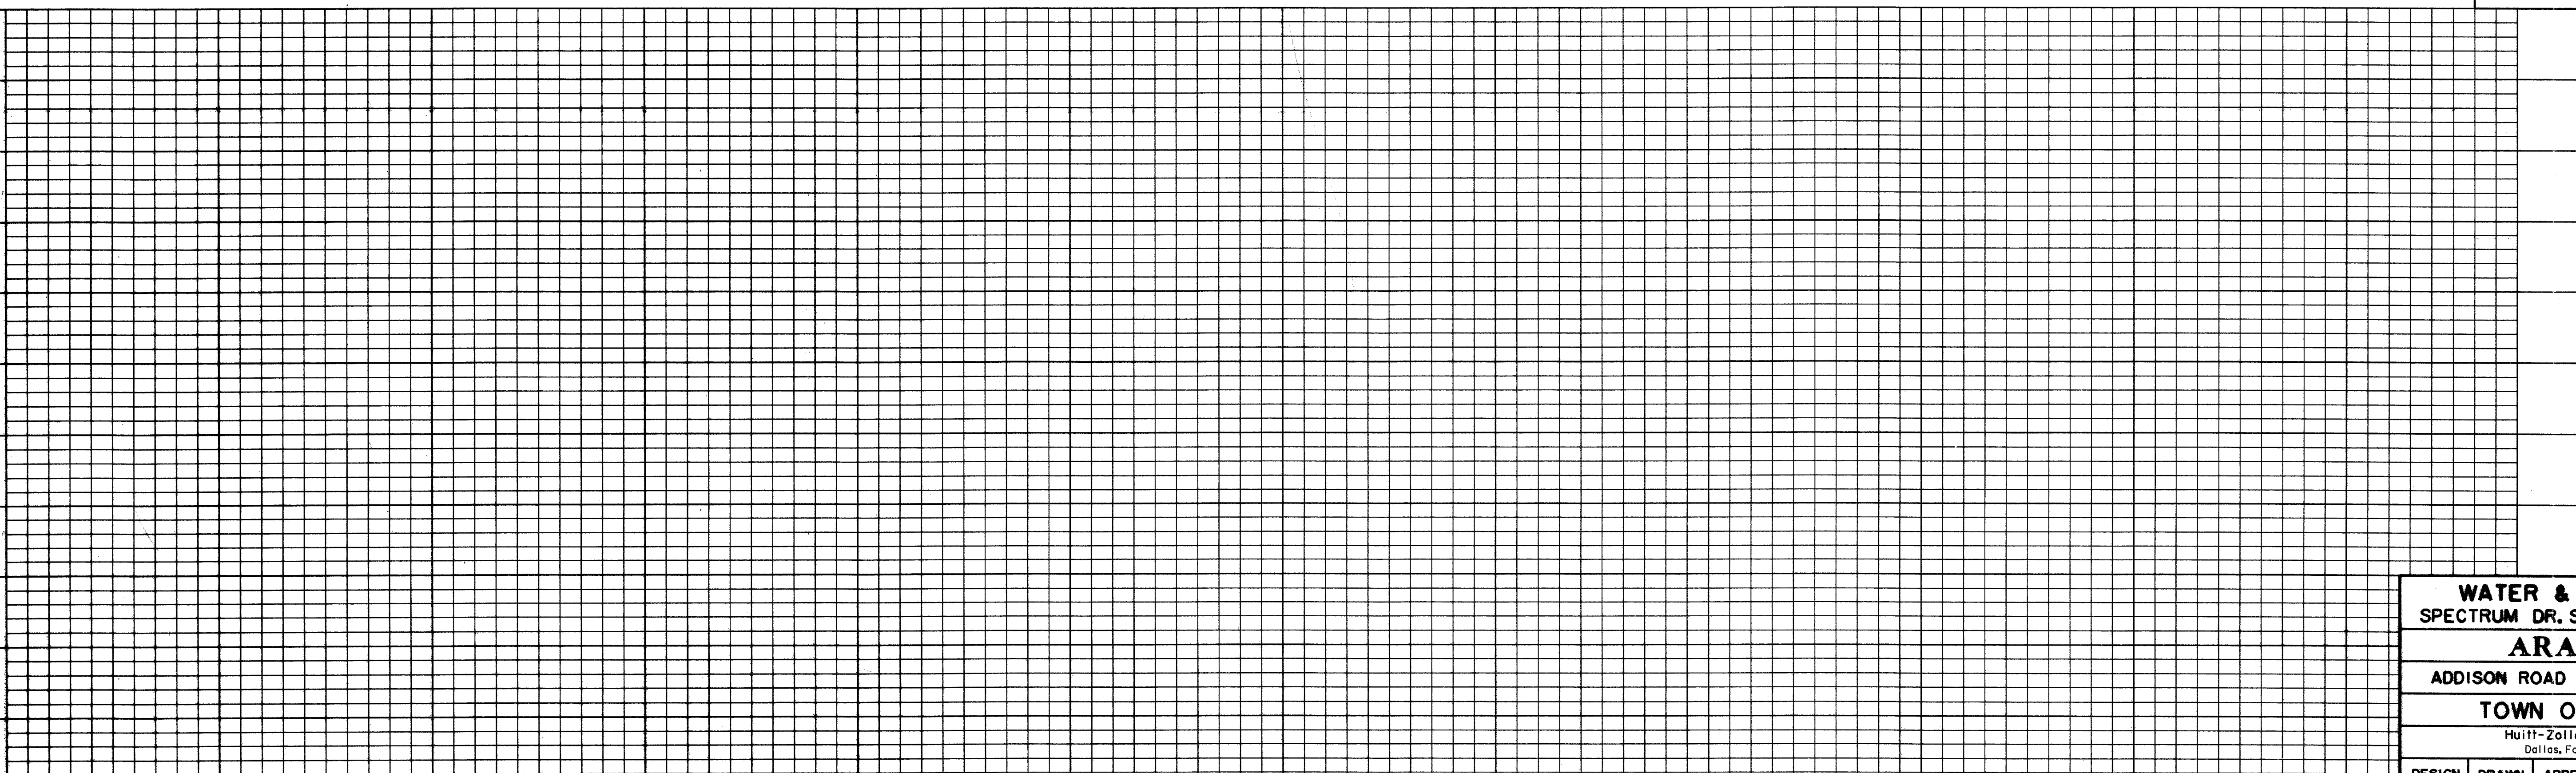


BENCHMARKS:
 USC & GS E-921 DISK IN BRICK WALL OF OLD ADDISON SCHOOL HOUSE (MAGIC TIME MACHINE RESTAURANT) ON SOUTH WALL, 4' EAST OF CENTER OF THE ENTRANCE, 4.7' ABOVE THE GROUND. ELEV. 650.61
 "I" ON SOUTHEAST CORNER OF CONCRETE WALK AT FRONT ENTRANCE TO 4805 ARAPAHO ROAD. ELEV. 630.61

THE SEAL APPEARING ON THIS DOCUMENT WAS AUTHORIZED BY KENNETH A. ROBERTS, P.E. 55446 ON OCTOBER 24, 1997


10-24-97

WATER & WASTEWATER PLAN
 SPECTRUM DR. STA. 15+55 TO STA. 19+22.03
ARAPAHO ROAD
 ADDISON ROAD TO DALLAS NORTH TOLLWAY
 TOWN OF ADDISON, TEXAS
 Huitt-Zollars, Inc./Consulting Engineers
 Dallas, Fort Worth, Houston, Phoenix, Tustin


DESIGN	DRAWN	APPR.	SCALE	DATE	PROJECT NO.	NO.
HZI	HZI	KAR	1/2"=20' 1/4"=8'	OCT 97	1772-01	W-7

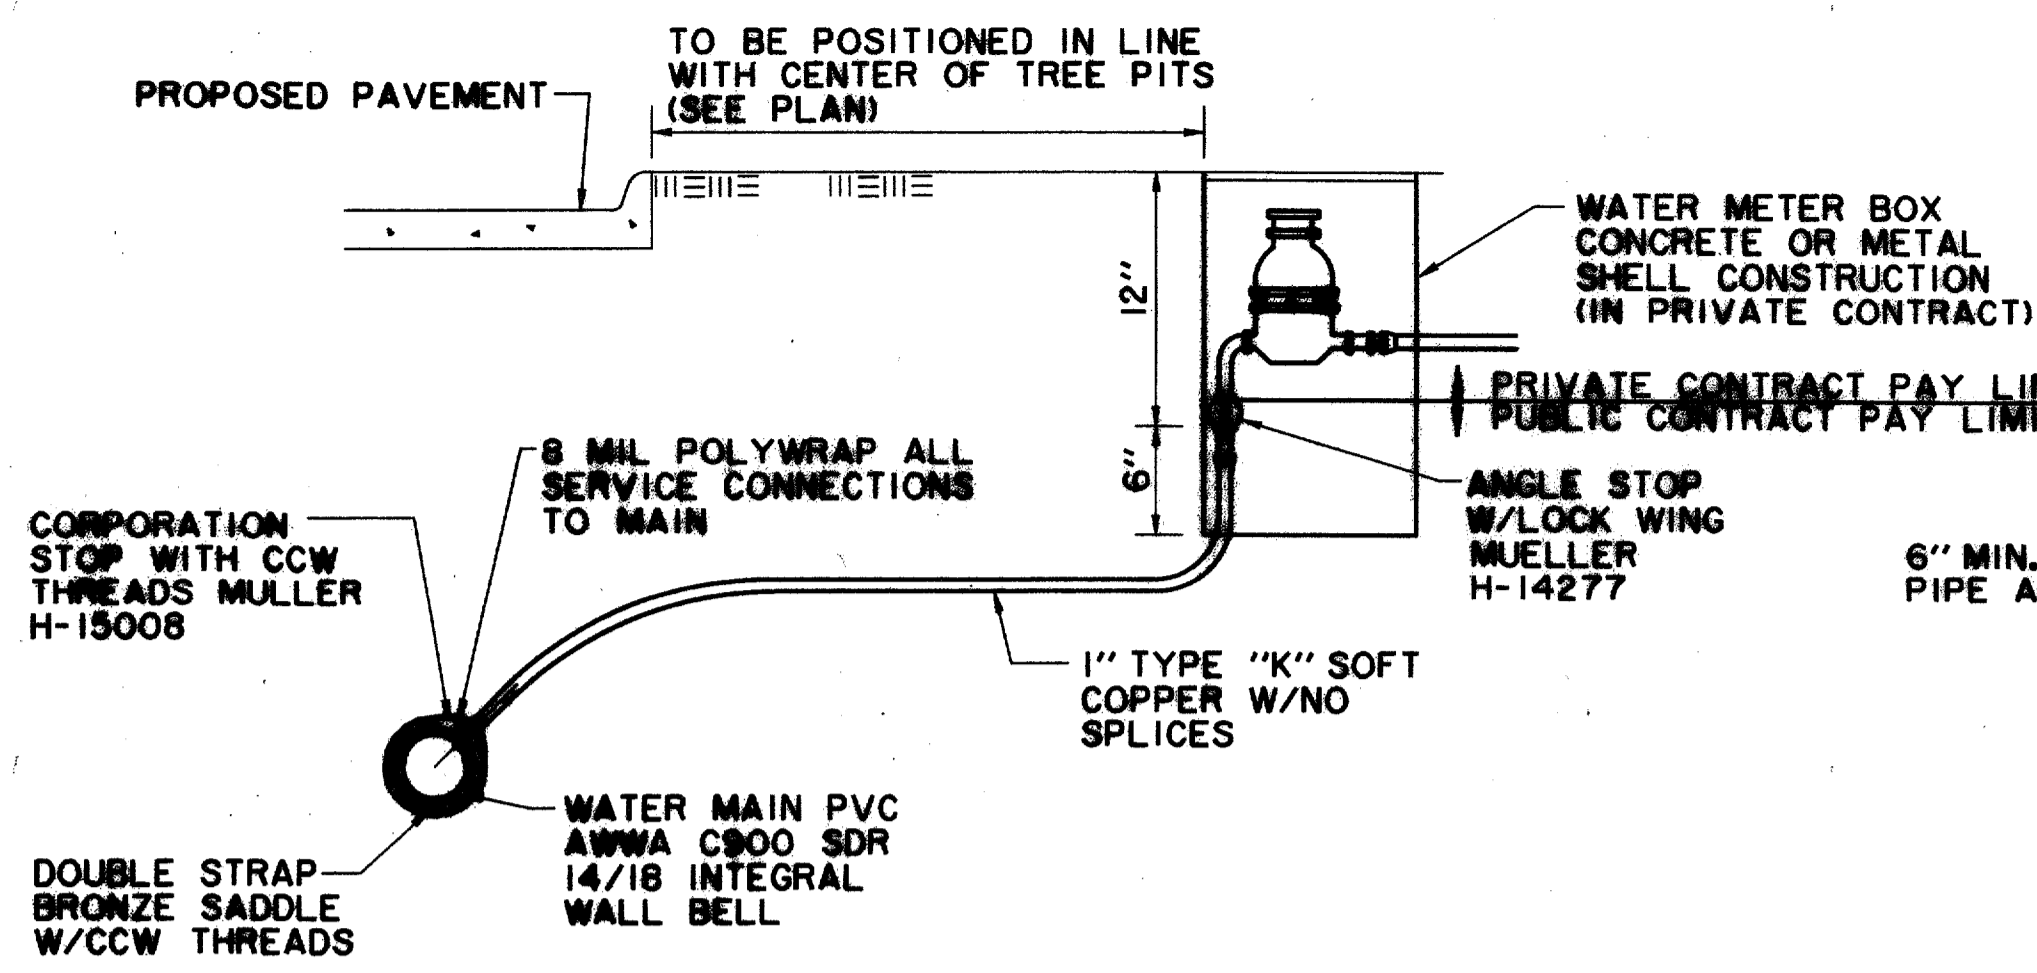


TYPICAL WATER SERVICE DETAIL
N.T.S.

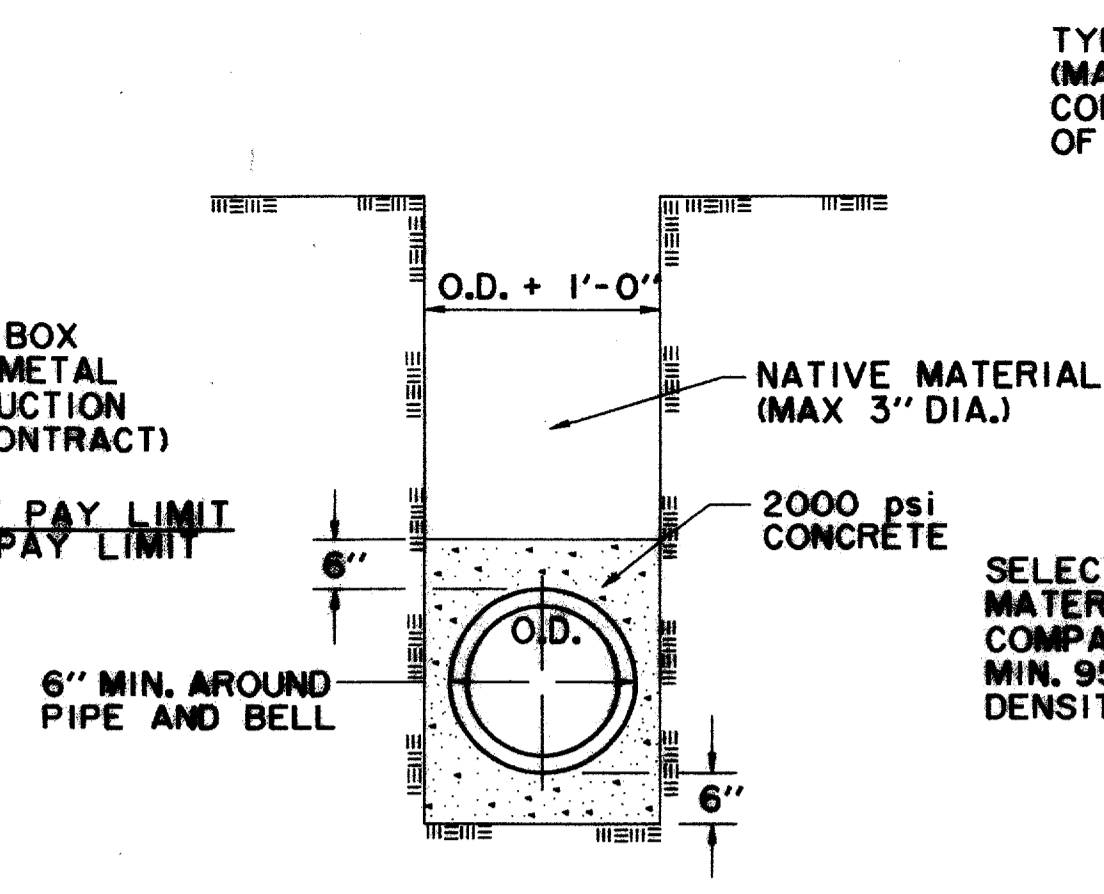


CONCRETE ENCASEMENT WATER MAIN
N.T.S.

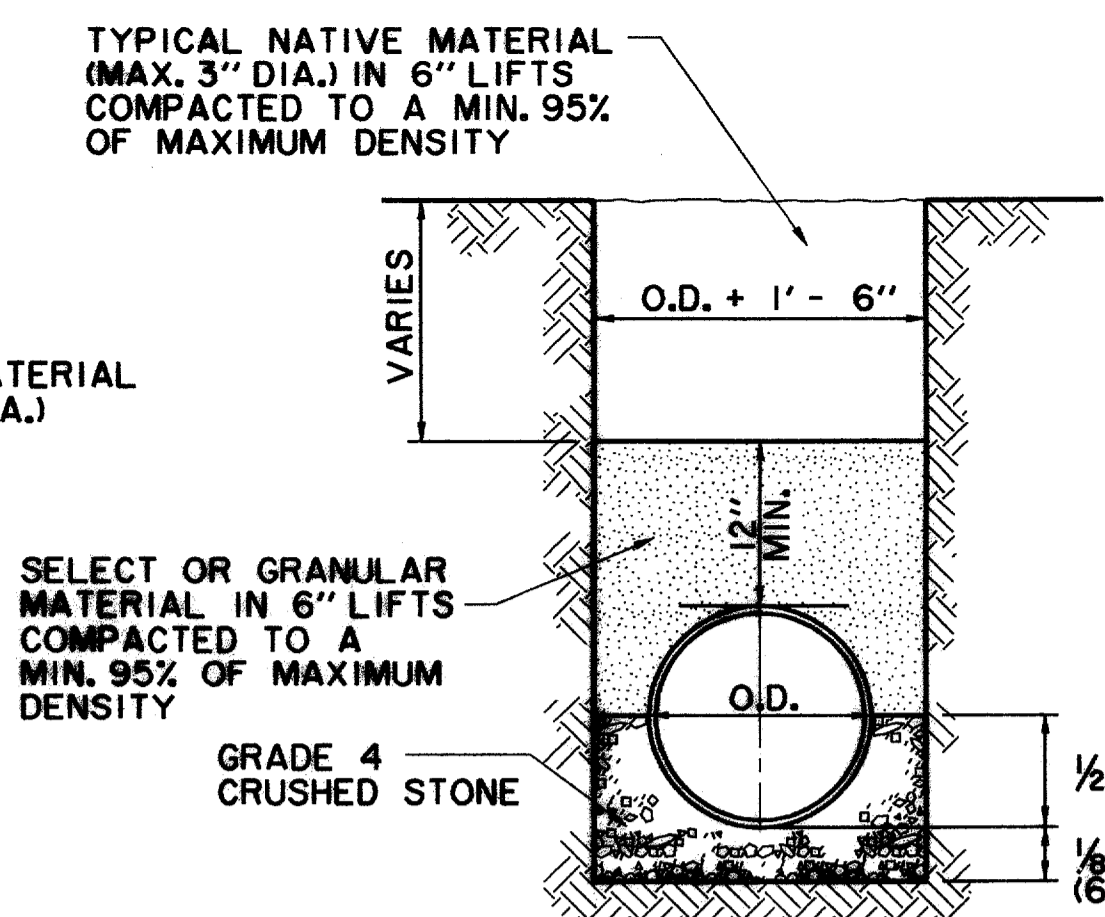

RCCP WATERLINE EMBEDMENT
N.T.S.

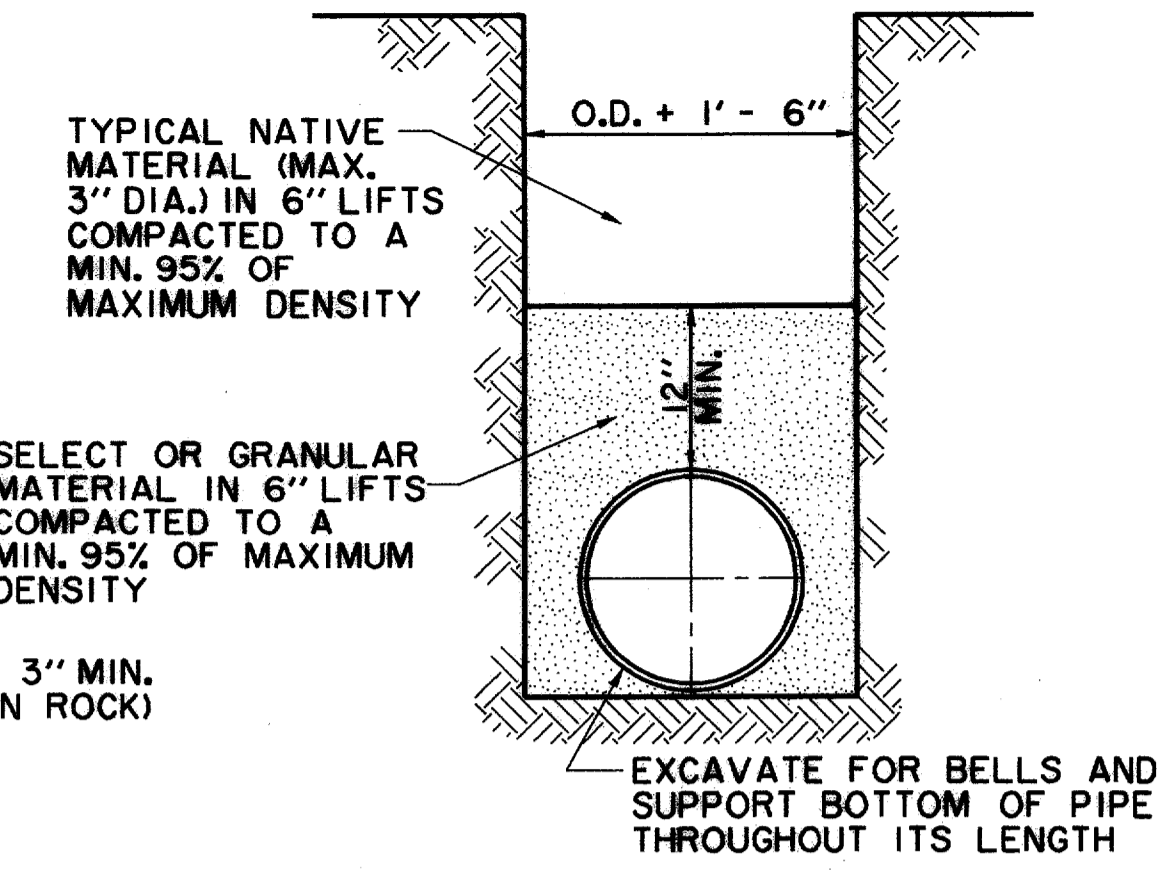


C.I. OR D.I. PIPE
N.T.S.

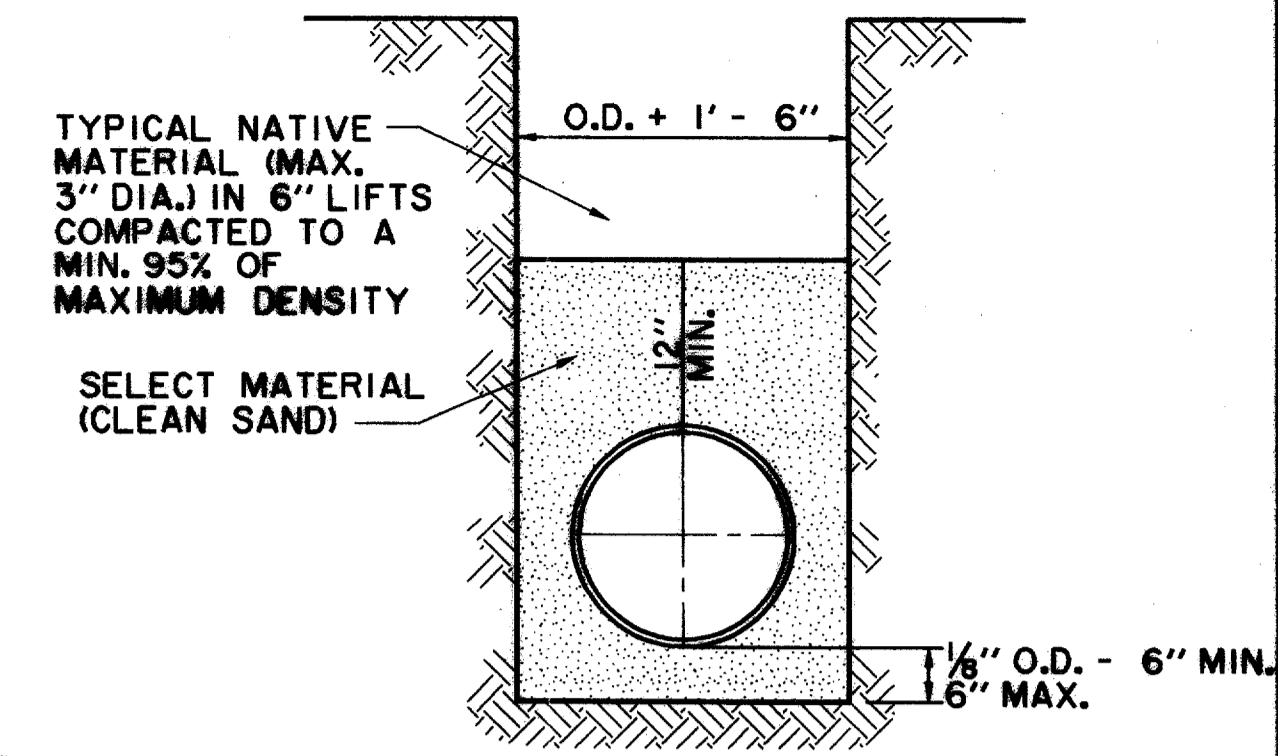

CLASS "A" EMBEDMENT P.V.C.
N.T.S.

FIRE HYDRANT TO BE "MUELLER" TRAFFIC MODEL W/6" MECHANICAL JOINT CONNECTION OR APPROVED EQUAL W/3/4" VALVE OPENING W/BARREL APPROX. 7" INSIDE DIAMETER. HYDRANT BODY SHALL BE COATED W/2 COATS OF ALUMINUM PAINT OVER ONE SHOP COAT OF RED. BONNET TO FLANGE & NOZZLE CAPS SHALL BE PAINTED BY COLOR CODE FOR MAIN SIZE ACCORDING TO CITY STANDARDS. ALL HYDRANTS SHALL BE EQUIPPED WITH A BREAKAWAY FLANGE & SHALL BE NO CLOSER THAN 3' TO ANY SURFACE OBSTRUCTION. (150 PSI WORKING PRESSURE - AWWA STD. C-302-85 OR LATEST REVISION) USE "MUELLER CENTURION"

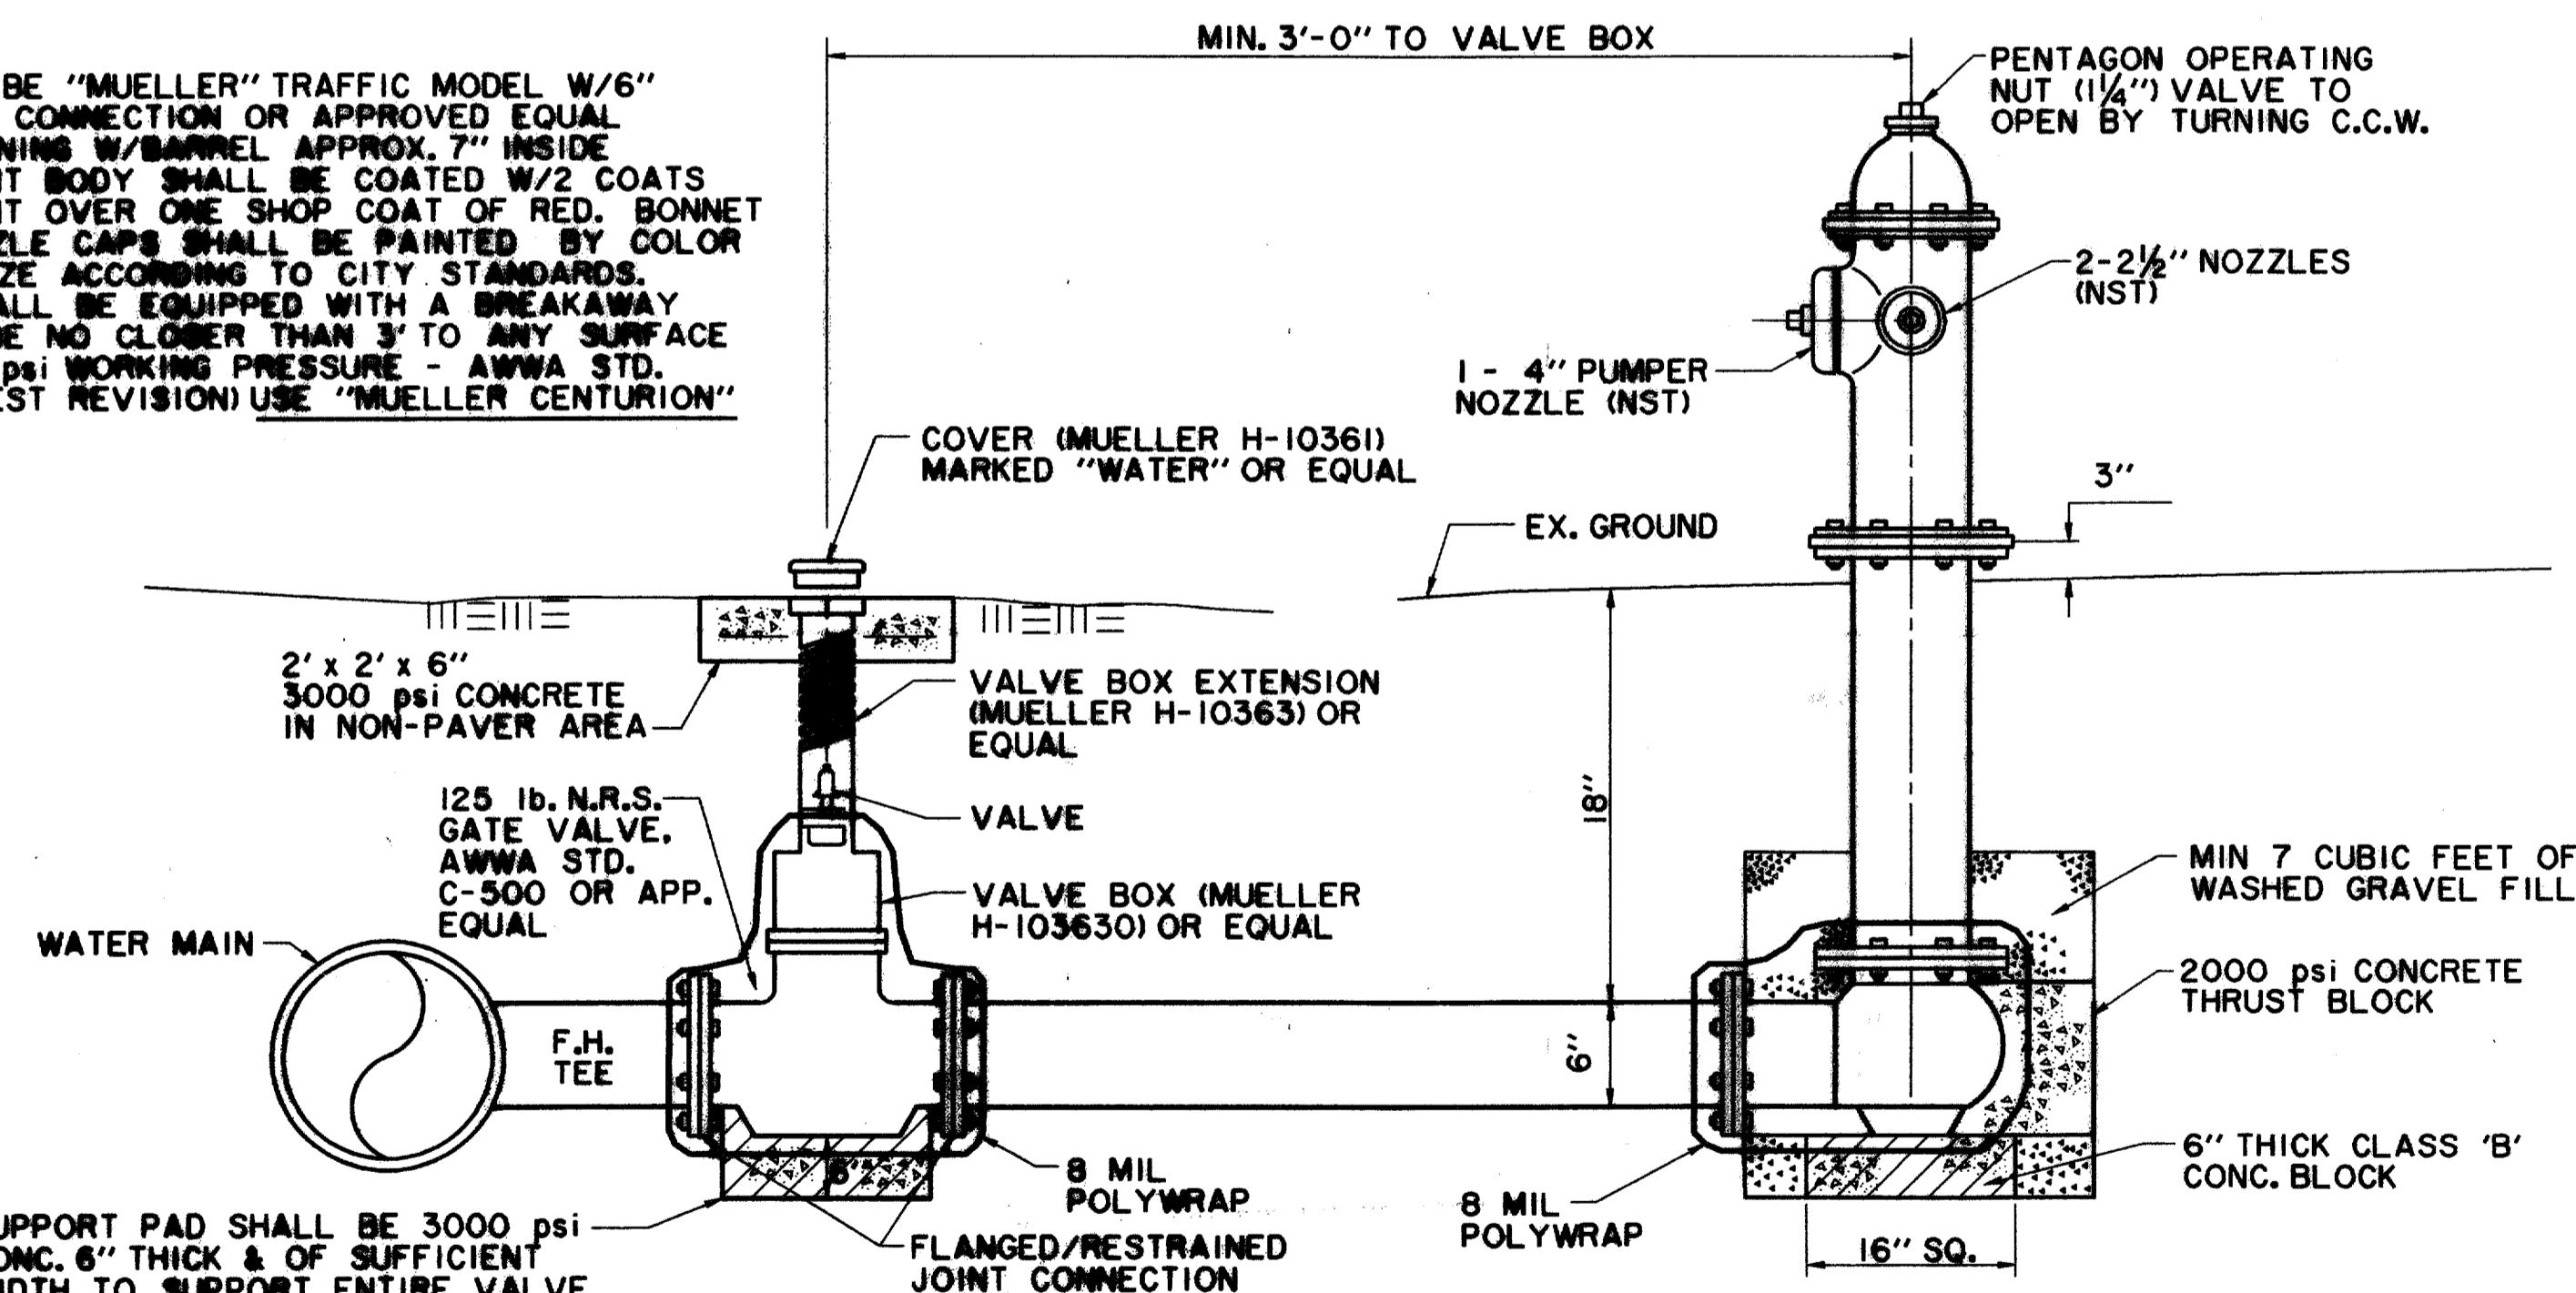


VALVE BOX DETAIL
N.T.S.


TYPICAL FIRE HYDRANT INSTALLATION
N.T.S.

- GATE VALVES AND VALVE BOXES:**
- GATE VALVES SHALL BE IRON BODY, BRONZE OR BRASS MOUNTED, NON-RISING STEM, PARALLEL SEAT TYPE. VALVES SHALL BE OF EQUAL OR GREATER PRESSURE CLASS THAN THE PIPING IN WHICH THEY ARE TO BE INSTALLED.
 - VALVE BOXES SHALL BE CAST IRON AND SHALL BE OF SUFFICIENT LENGTH AND DIAMETER TO OPERATE ALL VALVES BURIED IN THE GROUND. COVERS SHALL BE MARKED "WATER". THE BOXES SHALL REST ON THE VALVE AND BE ADJUSTED SO THAT THE COVER MAY SET FLUSH WITH THE FINISHED GRADE.

- GENERAL NOTES:**
- 1/2" OF F.H. BARREL SHALL BE NOT LESS THAN 6.0' OR MORE THAN 9.0' FROM BACK OF CURB OR EDGE OF DRIVING LANE.
 - DO NOT SET F.H. IN AN EXISTING OR PROPOSED SIDEWALK, UNLESS OTHERWISE NOTED.
 - ALL F.H. TEES SHALL BE M.J. WITH FLANGED/RESTRAINED JOINT ON THE BRANCH WITH FLANGED/RESTRAINED JOINT VALVE.

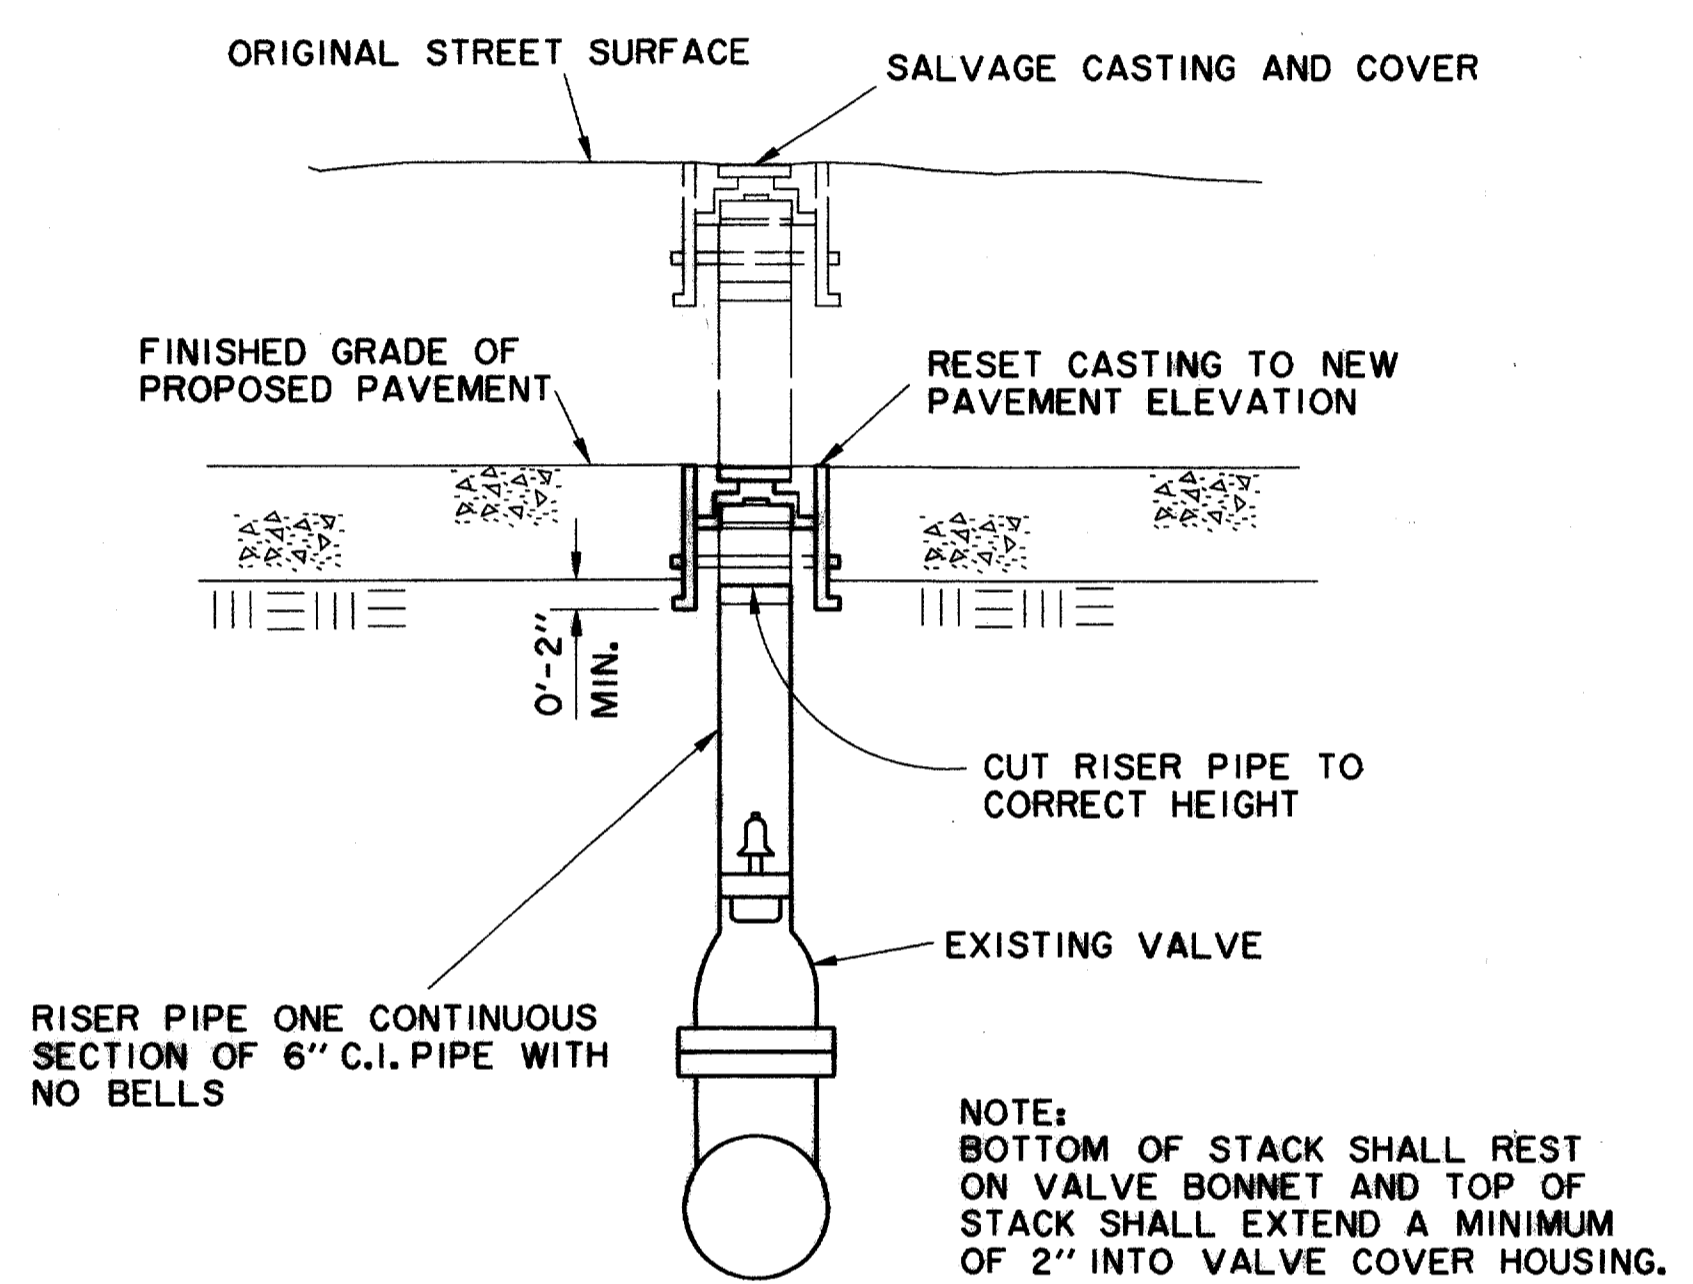

VALVE COVER AND RISER PIPE ADJUSTMENT
N.T.S.

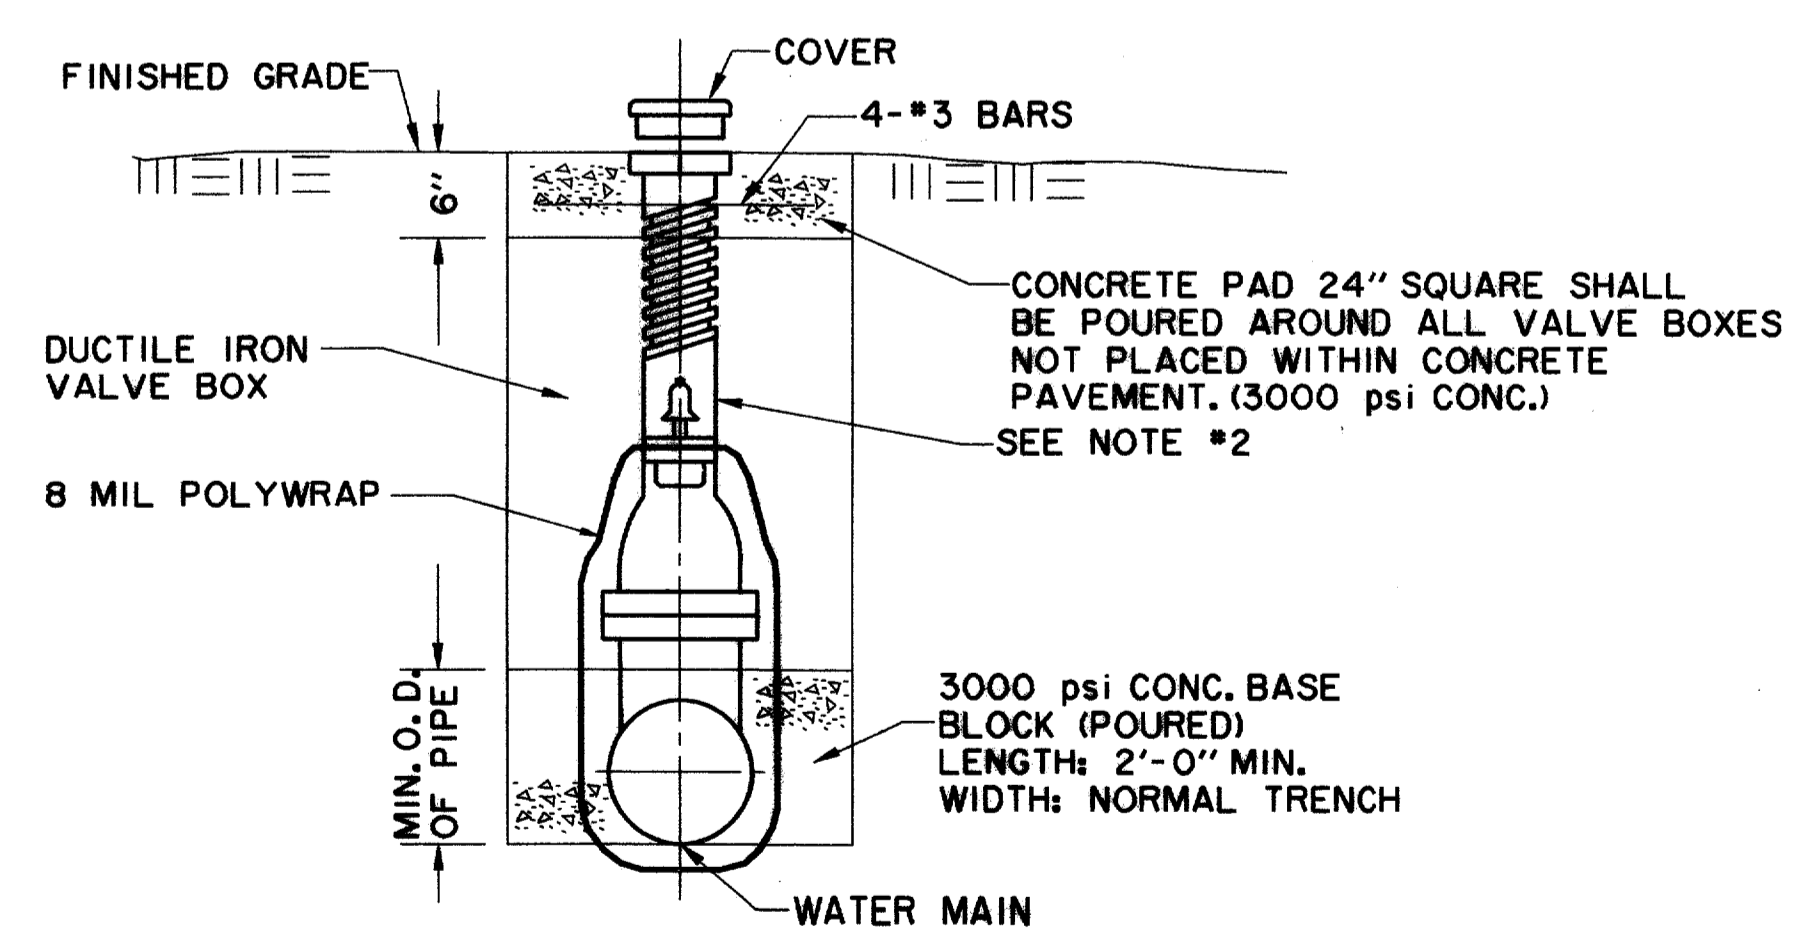


TYPICAL VALVE SETTING AND BOX
N.T.S.



- NOTES:**
- GATE VALVES SHALL BE IN ACCORDANCE WITH AWWA STANDARD C-509-80 OR LATEST THEREOF ALL VALVES SHALL BE "MUELLER" OR APPROVED EQUAL.
 - A PERMANENTLY ATTACHED VALVE EXTENSION STEM SHALL BE REQUIRED FOR ANY VALVE THAT ITS OPERATING NUT IS LOCATED IN EXCESS OF 4 FEET BELOW THE TOP OF VALVE BOX. THIS EXTENSION SHALL BE OF SUFFICIENT LENGTH TO INSURE THAT ITS TOP IS WITHIN 4" OF VALVE BOX LID. MANUFACTURED VALVE STACK DUCTILE IRON PIPE TO BE USED FOR EXTENSION GREATER THAN 4'-0" BELL END OF STACK TO BE FITTED OVER VALVE. VALVE AND VALVE STACK IS TO BE POLY WRAPPED.
 - VALVES SHALL BE OF DUCTILE IRON W/RUBBER ENCAPSULATED DISK. BOLTS SHALL BE STAINLESS STEEL OF SAME SIZE ON EACH VALVE.

RECORD DOCUMENTS 6/9/2000


THESE RECORD DOCUMENTS HAVE BEEN PREPARED BASED ON INFORMATION PROVIDED BY OTHERS. THE CONSULTANT HAS NOT VERIFIED THE ACCURACY AND/OR COMPLETENESS OF THIS INFORMATION AND SHALL NOT BE RESPONSIBLE FOR ANY ERRORS OR OMISSIONS THAT MAY BE INCORPORATED AS A RESULT OF ERRONEOUS INFORMATION PROVIDED BY OTHERS.

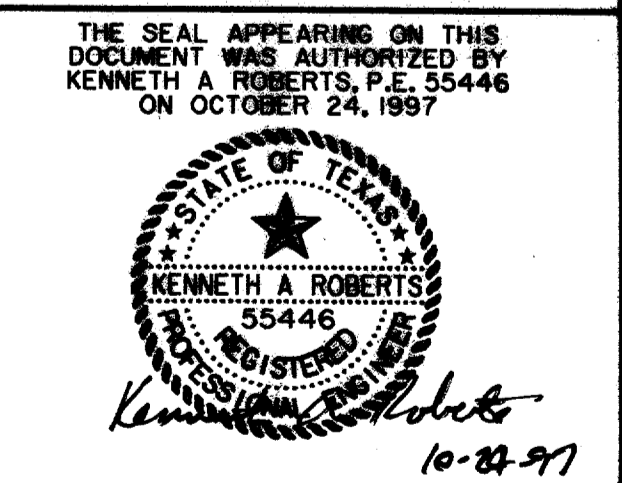


WATER DETAILS						
ARAPAHO ROAD						
ADDISON ROAD TO DALLAS NORTH TOLLWAY						
TOWN OF ADDISON, TEXAS						
Huitt-Zollars, Inc./Consulting Engineers Dallas, Fort Worth, Houston, Phoenix, Tustin						
DESIGN	DRAWN	APPR.	SCALE	DATE	PROJECT NO.	NO.
HZI	HZI	KAR	N.T.S.	OCT 97	1772-01	W-8

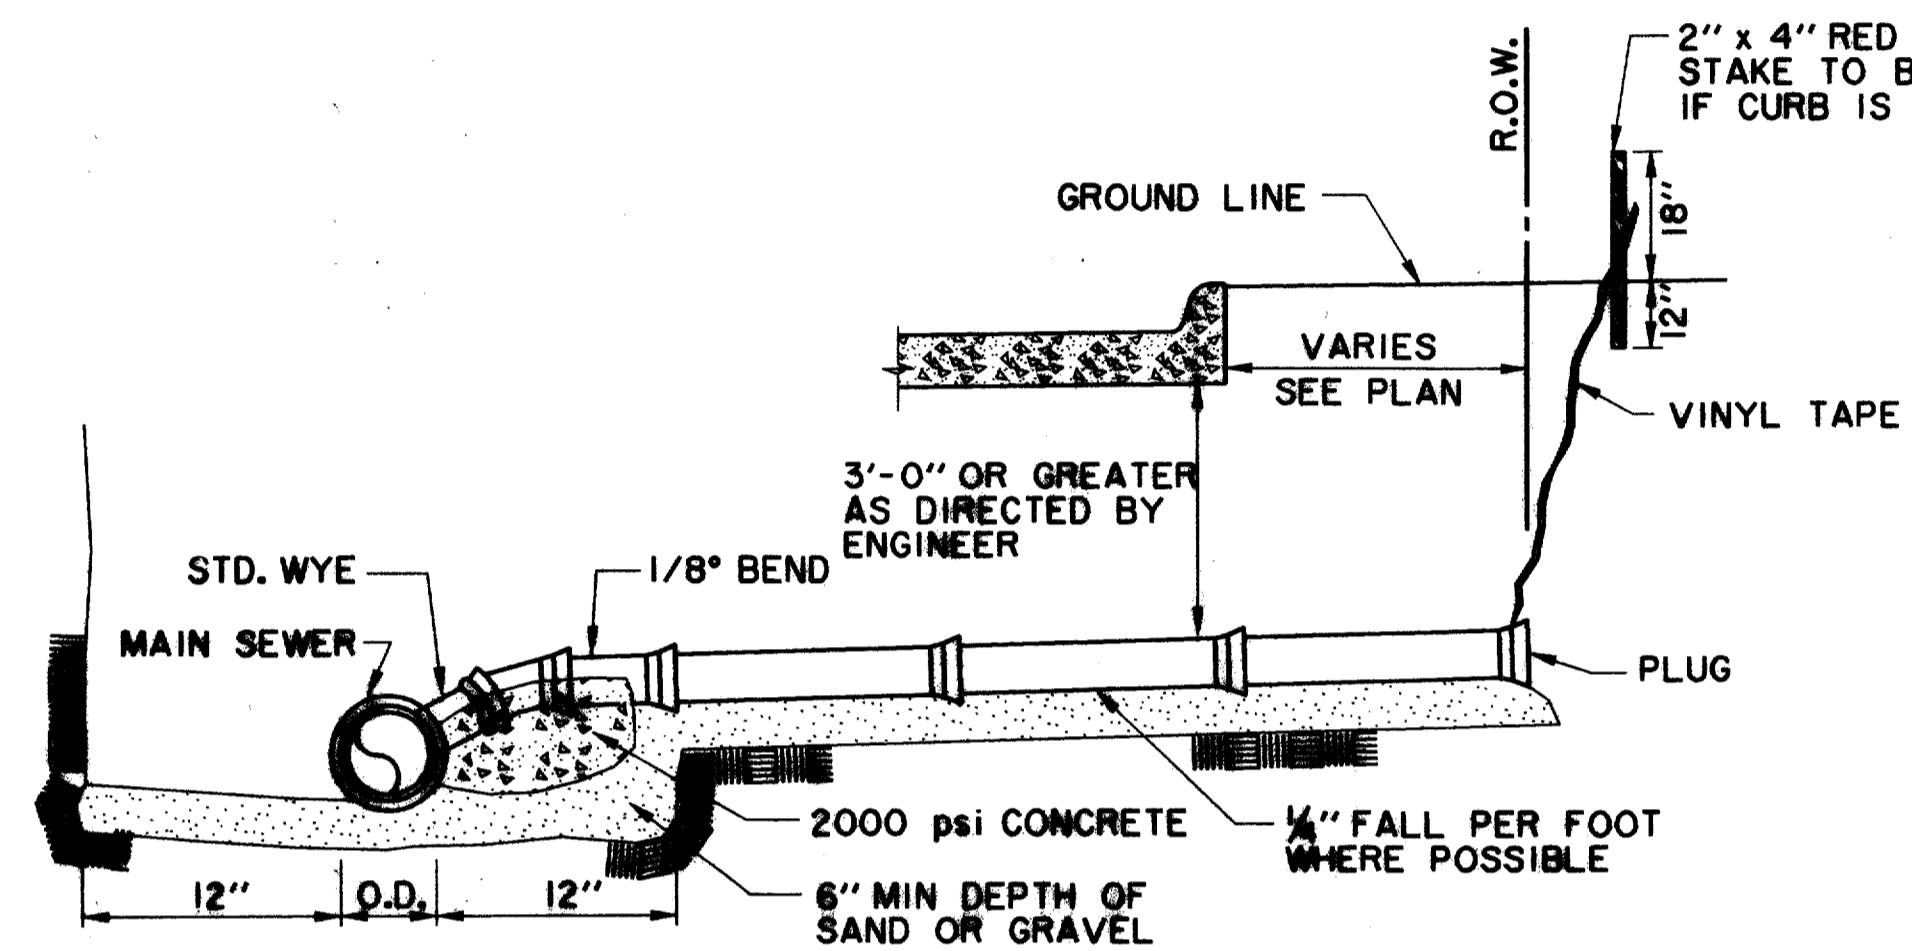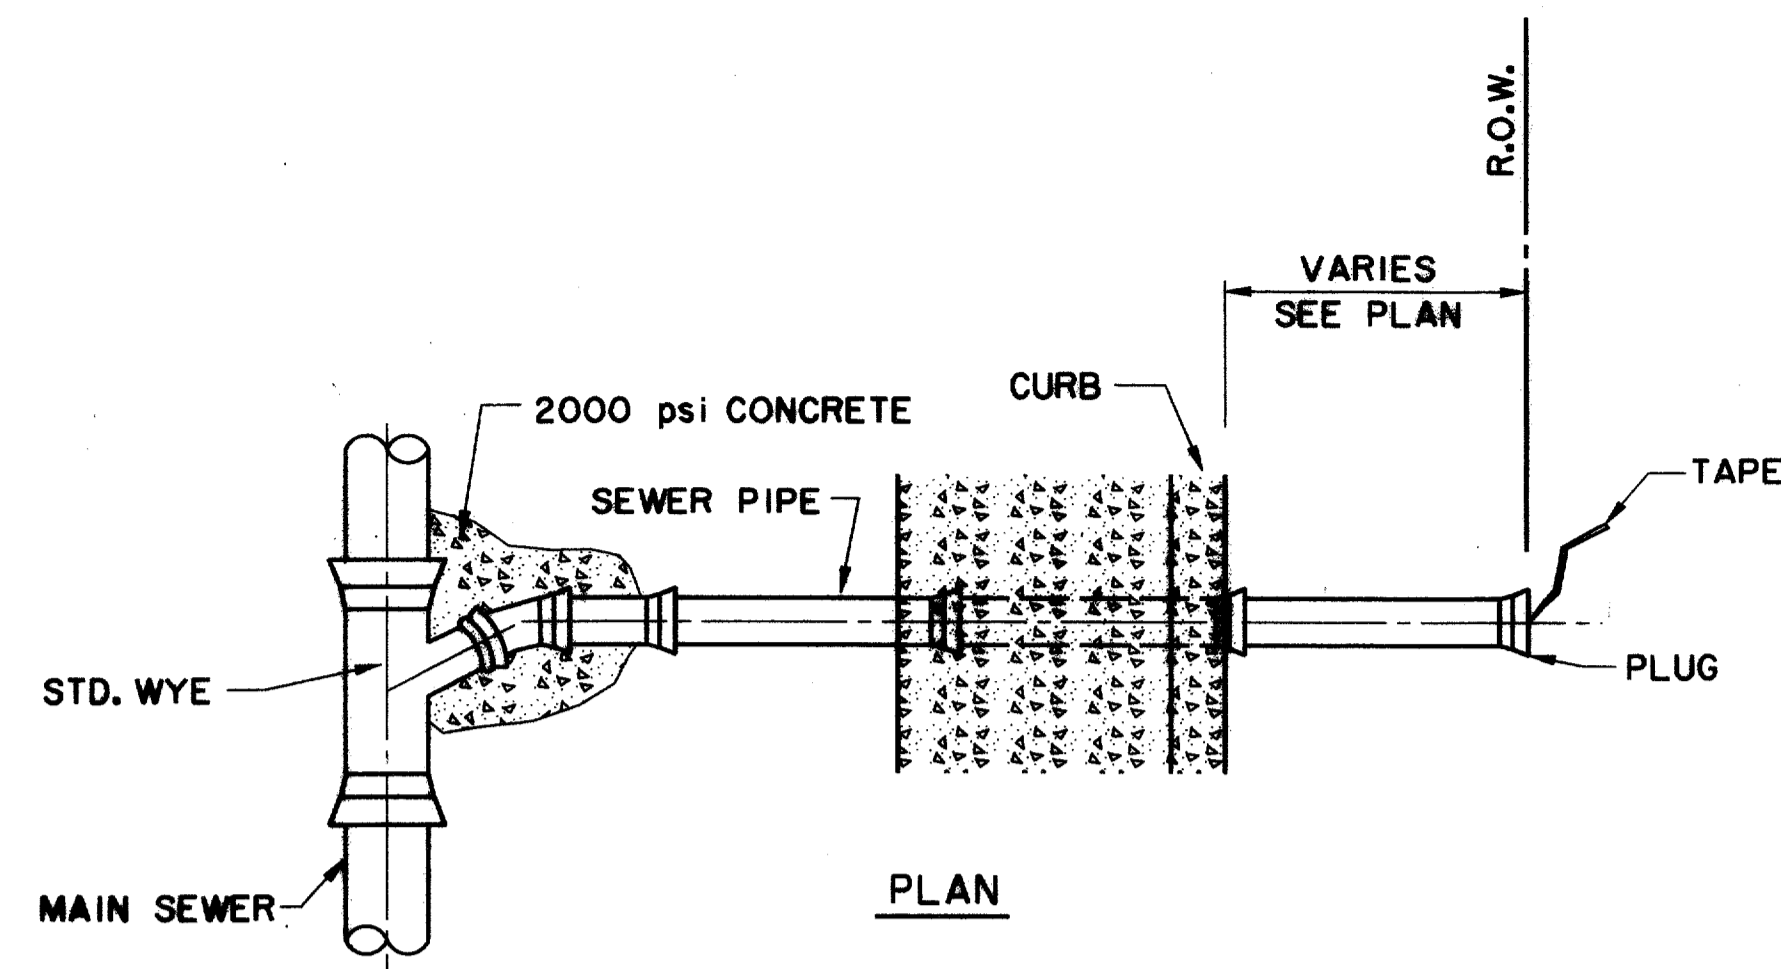


SANITARY SEWER SERVICE CONNECTION
NTS

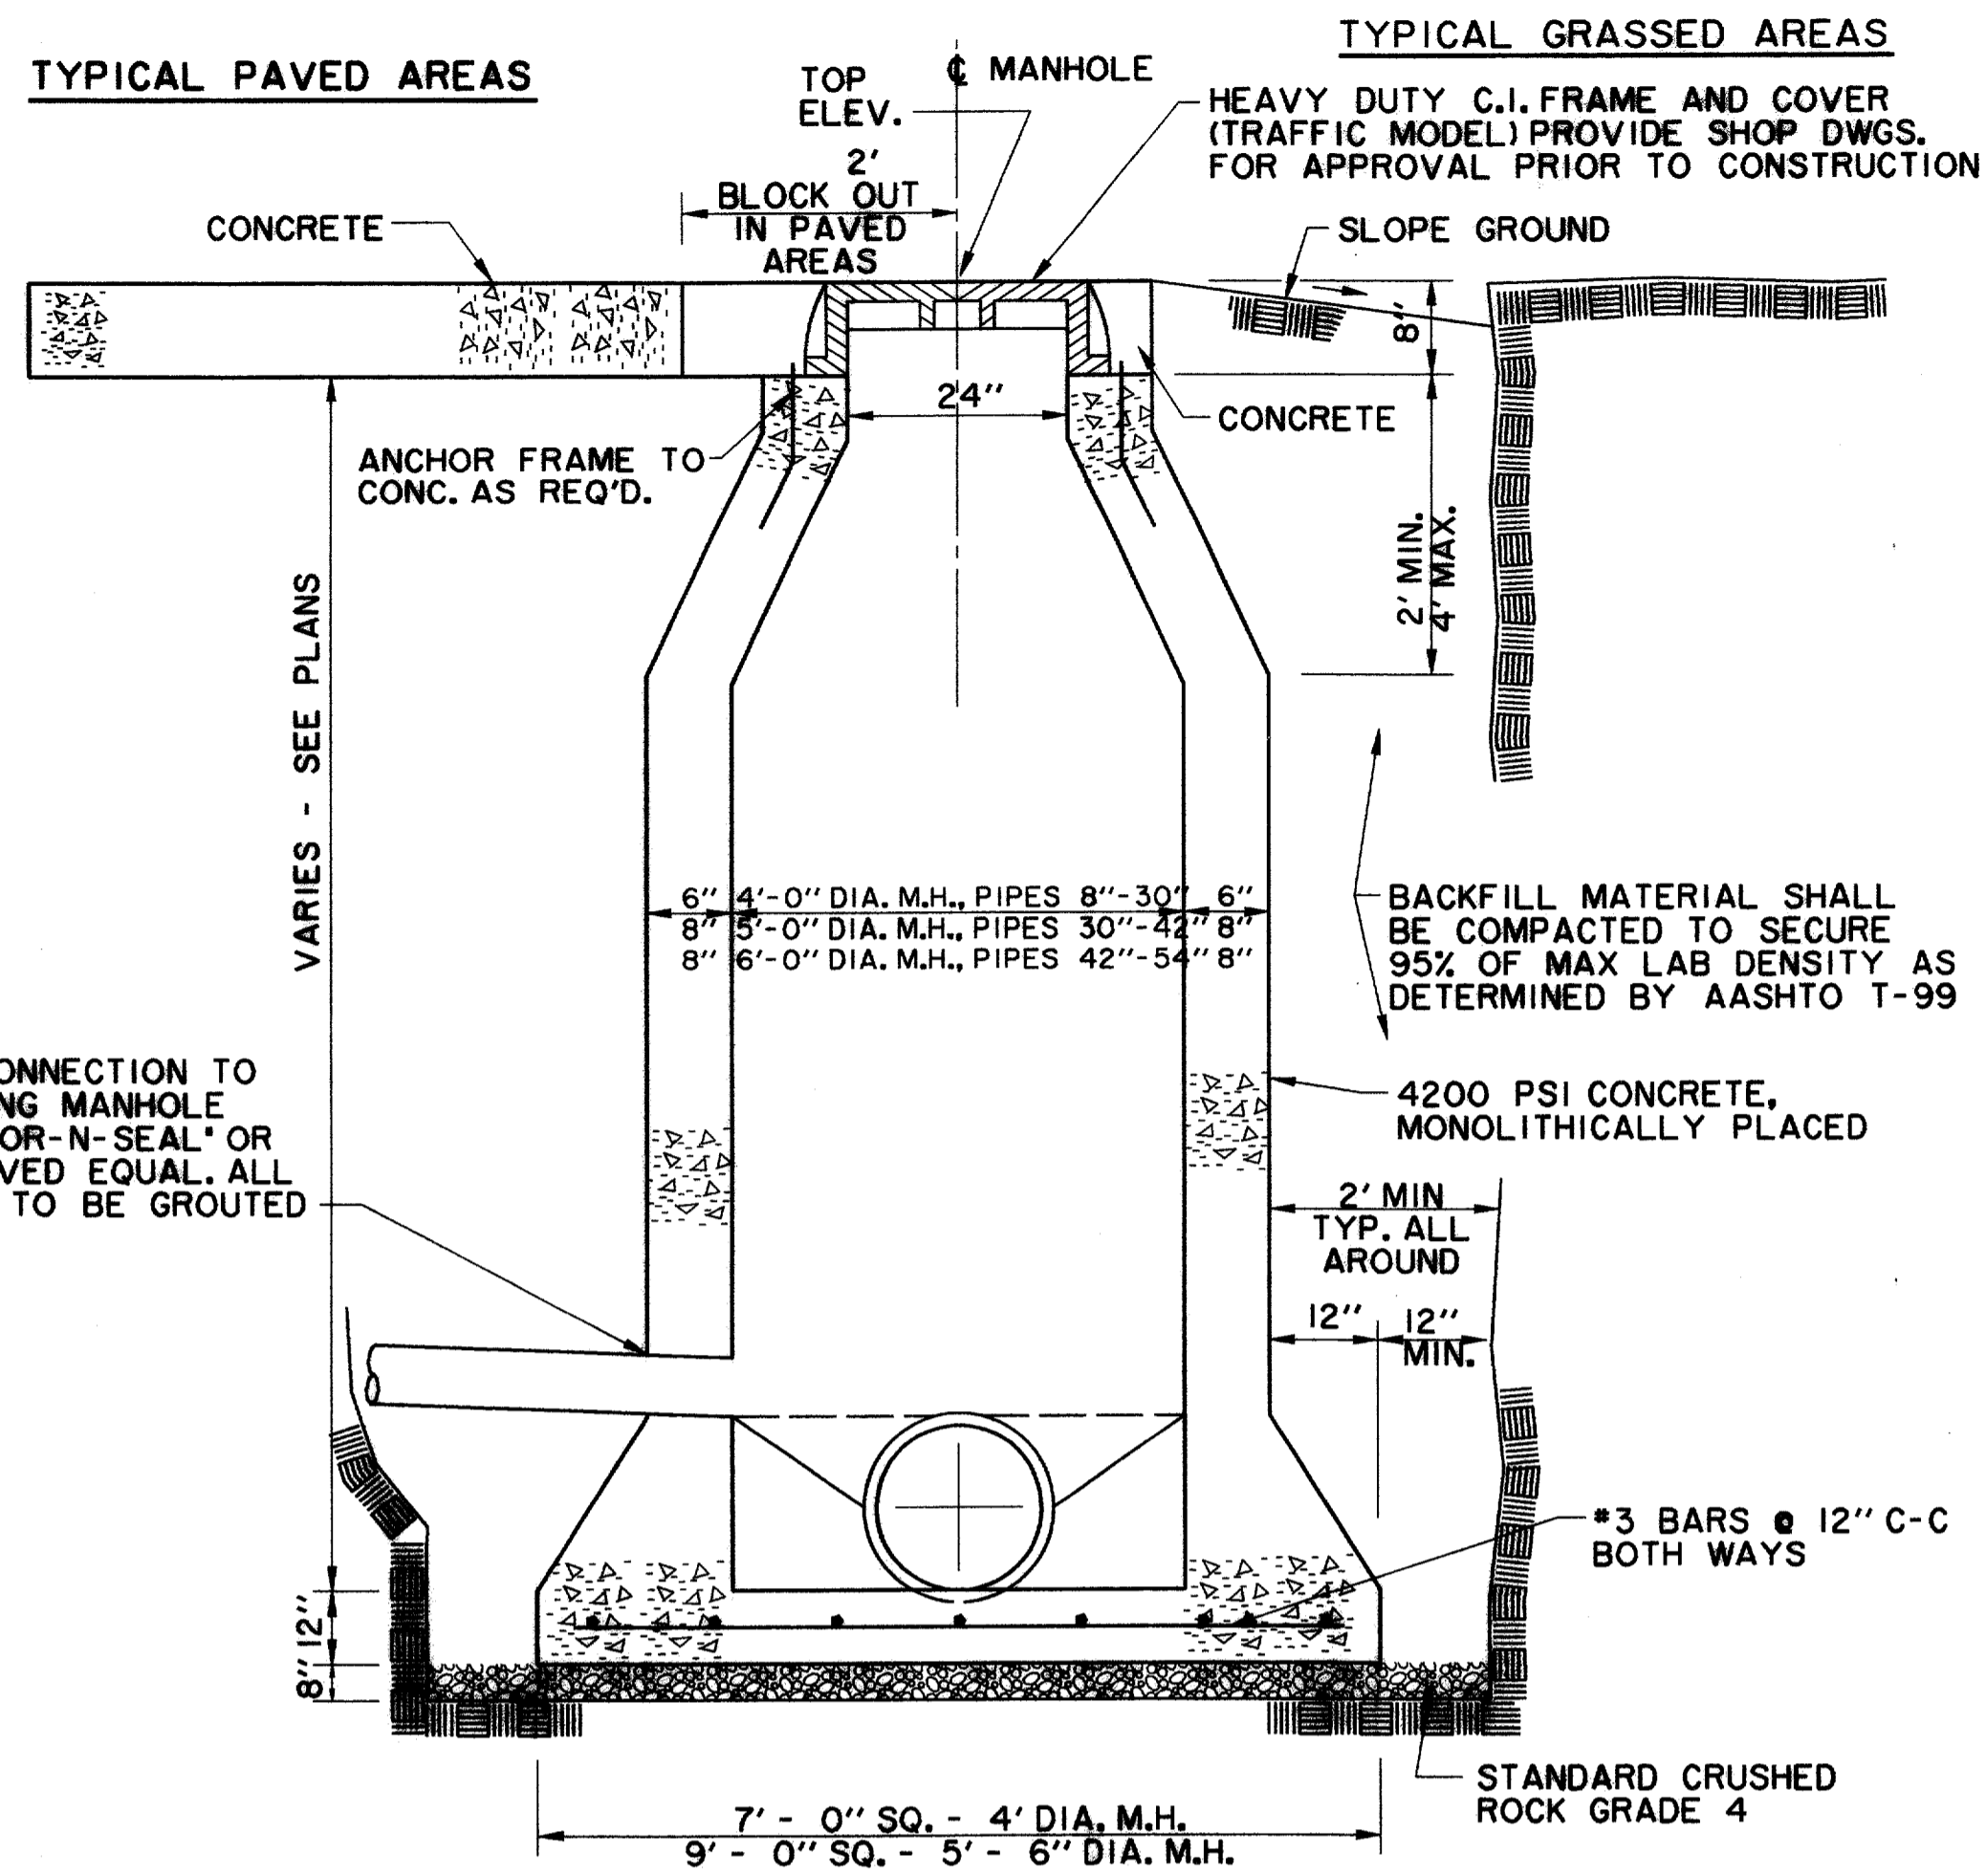


CAST IN PLACE MANHOLE
NOTE:
KEYWAY WITH P.V.C. WATERSTOP
REQUIRED AT ALL CONSTRUCTION
JOINTS

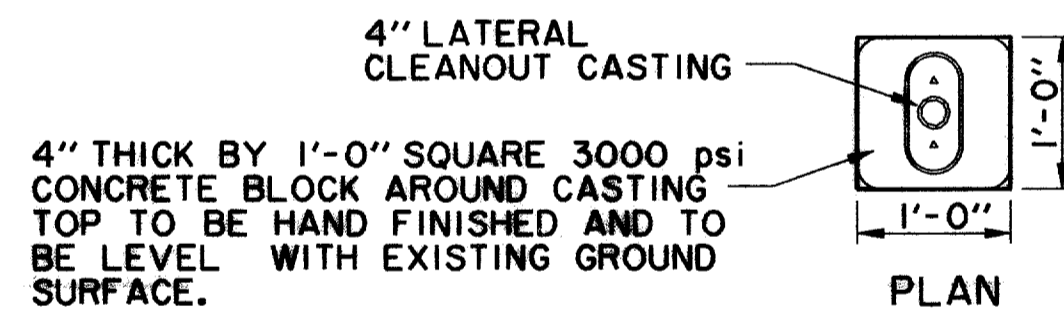

4" THICK BY 1'-0" SQUARE 3000 psi
CONCRETE BLOCK AROUND CASTING
TOP TO BE HAND FINISHED AND TO
BE LEVEL WITH EXISTING GROUND
SURFACE.

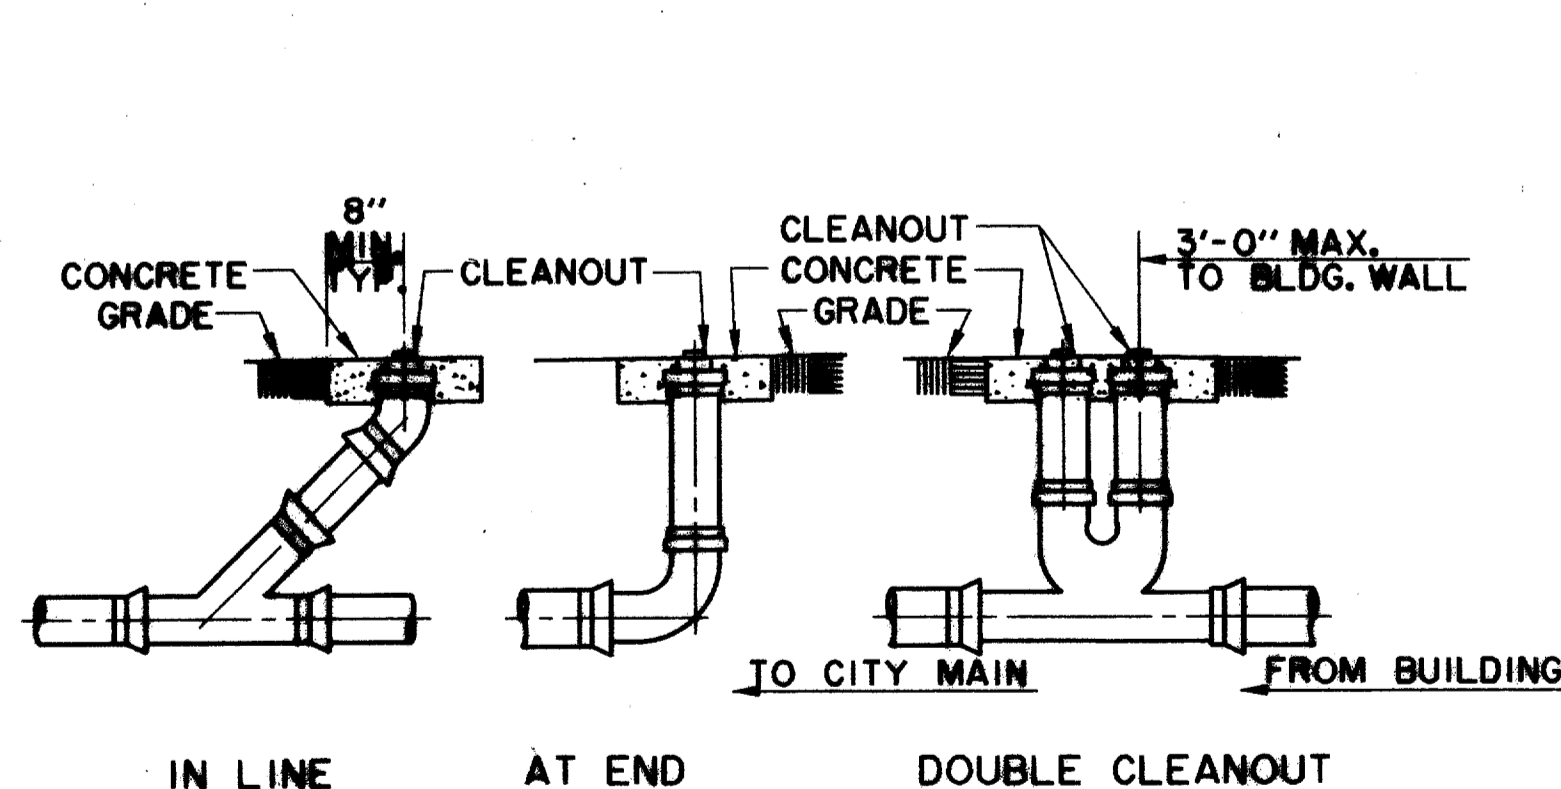

TYPICAL CLEANOUTS IN NON-PAVED AREAS

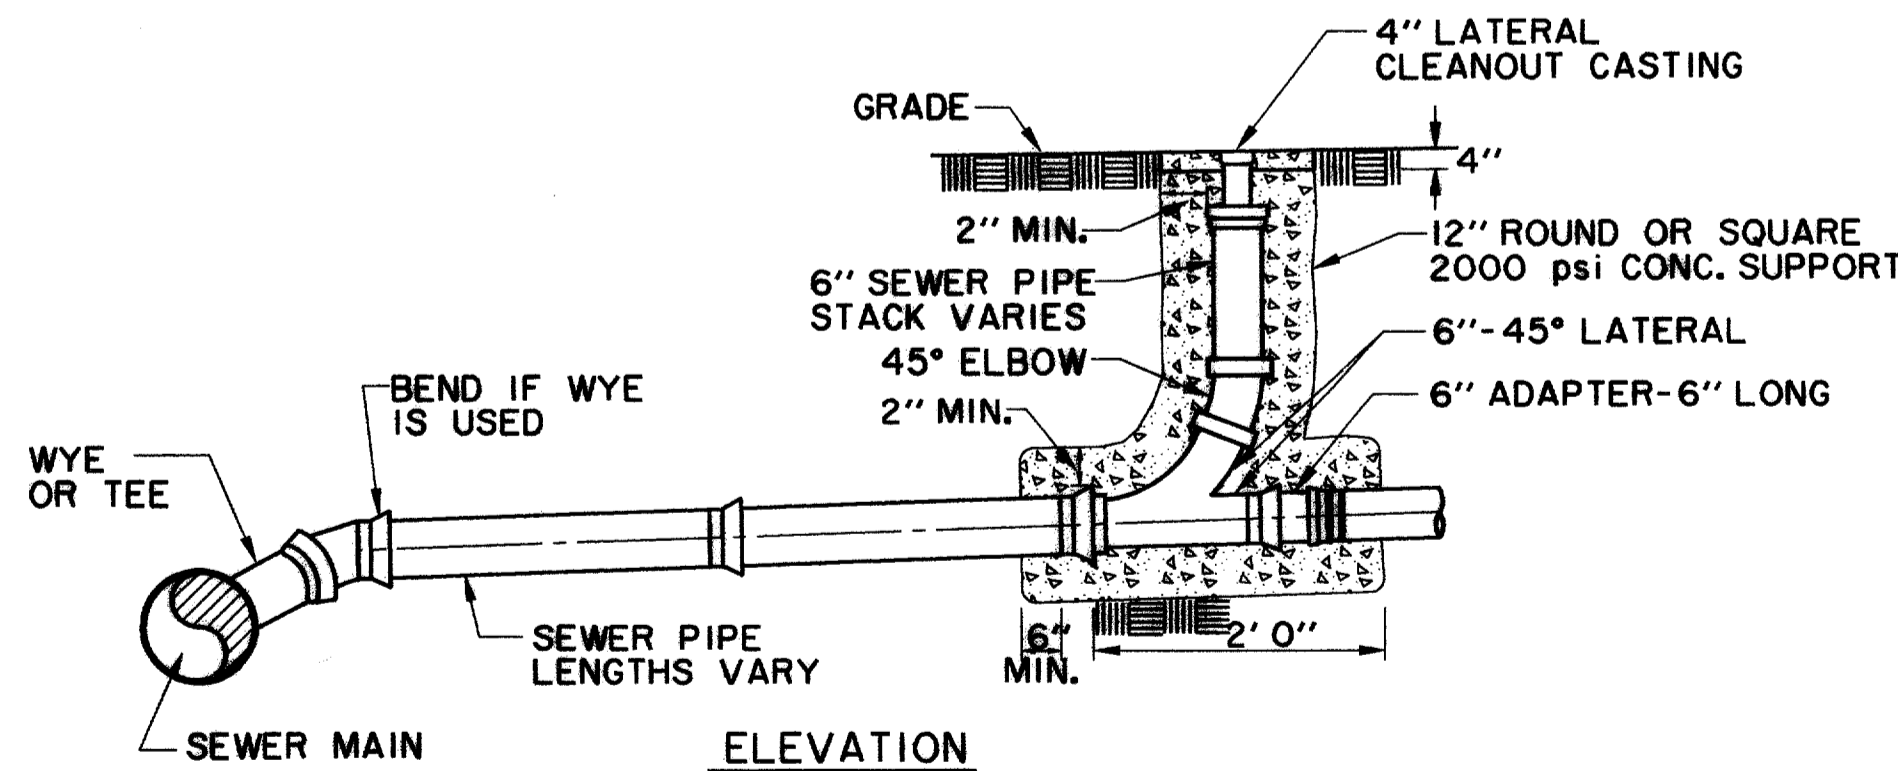

SANITARY SEWER CLEANOUT DETAIL
NTS


PVC SANITARY SEWER PIPE TO BE SDR 35 OR SDR 26 (AS NOTED ON
PLANS) WITH INTEGRAL BELL. IT SHALL BE THE RESPONSIBILITY OF THE
CONTRACTOR TO FIELD LOCATE HORIZONTALLY EACH SERVICE IN RELATION
TO THE SANITARY SEWER STATIONING.

FIELD TIES ARE TO BE INCLUDED AND RECORDED ON ALUMINIZED
SANITARY SEWER TAPE. THIS TAPE, GREEN OR RED IN COLOR IS TO BE
ATTACHED TO THE 6" SERVICE AT THE R.O.W. LINE AND BROUGHT TO
THE SURFACE TO BE USED AS A PERMANENT MARKER.

RECORD DOCUMENTS 6/9/2000

THESE RECORD DOCUMENTS HAVE BEEN PREPARED BASED ON
INFORMATION PROVIDED BY OTHERS. THE CONSULTANT HAS
NOT VERIFIED THE ACCURACY AND/OR COMPLETENESS OF THIS
INFORMATION AND SHALL NOT BE RESPONSIBLE FOR ANY
ERRORS OR OMISSIONS THAT MAY BE INCORPORATED AS A
RESULT OF ERRONEOUS INFORMATION PROVIDED BY OTHERS.

THE SEAL APPEARING ON THIS
DOCUMENT WAS AUTHORIZED BY
KENNETH A. ROBERTS, P.E. 55446
ON OCTOBER 24, 1997

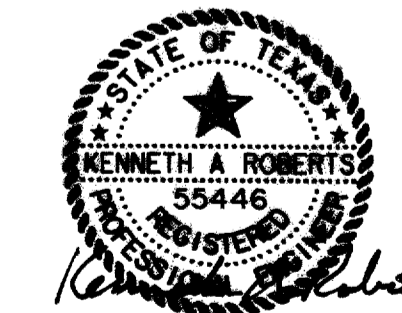

10-24-97

WASTEWATER DETAILS







ARAPAHO ROAD

ADDISON ROAD TO DALLAS NORTH TOLLWAY

TOWN OF ADDISON, TEXAS

Huitt-Zollars, Inc./Consulting Engineers
Dallas, Fort Worth, Houston, Phoenix, Tustin

DESIGN	DRAWN	APPR.	SCALE	DATE	PROJECT NO.	NO.
HZI	HZI	KAR	N.T.S.	OCT 97	1772-01	W-10

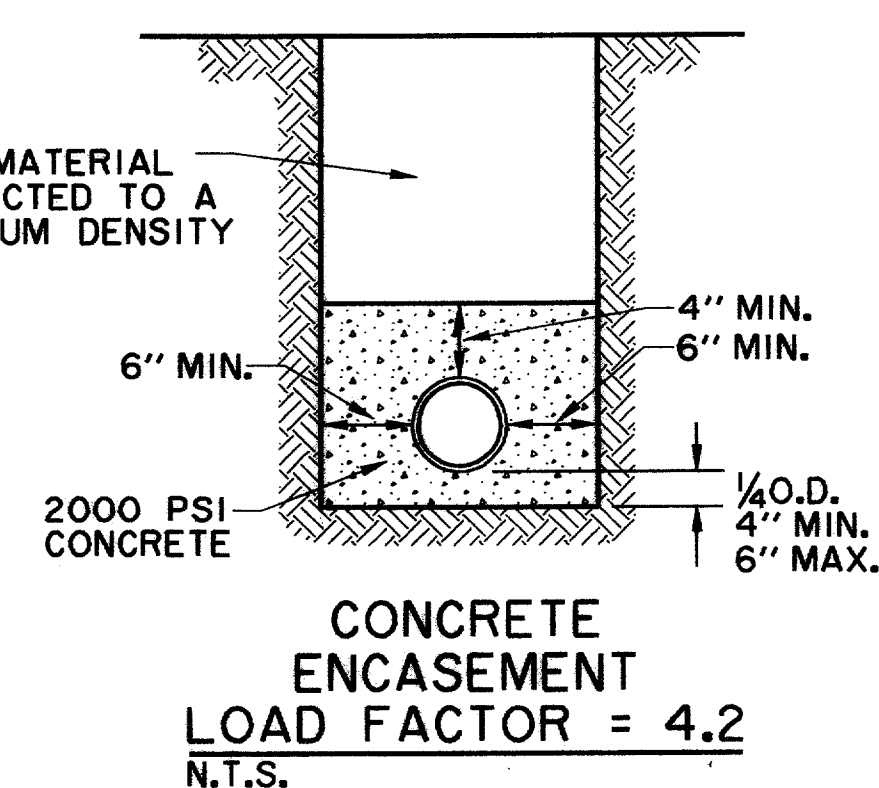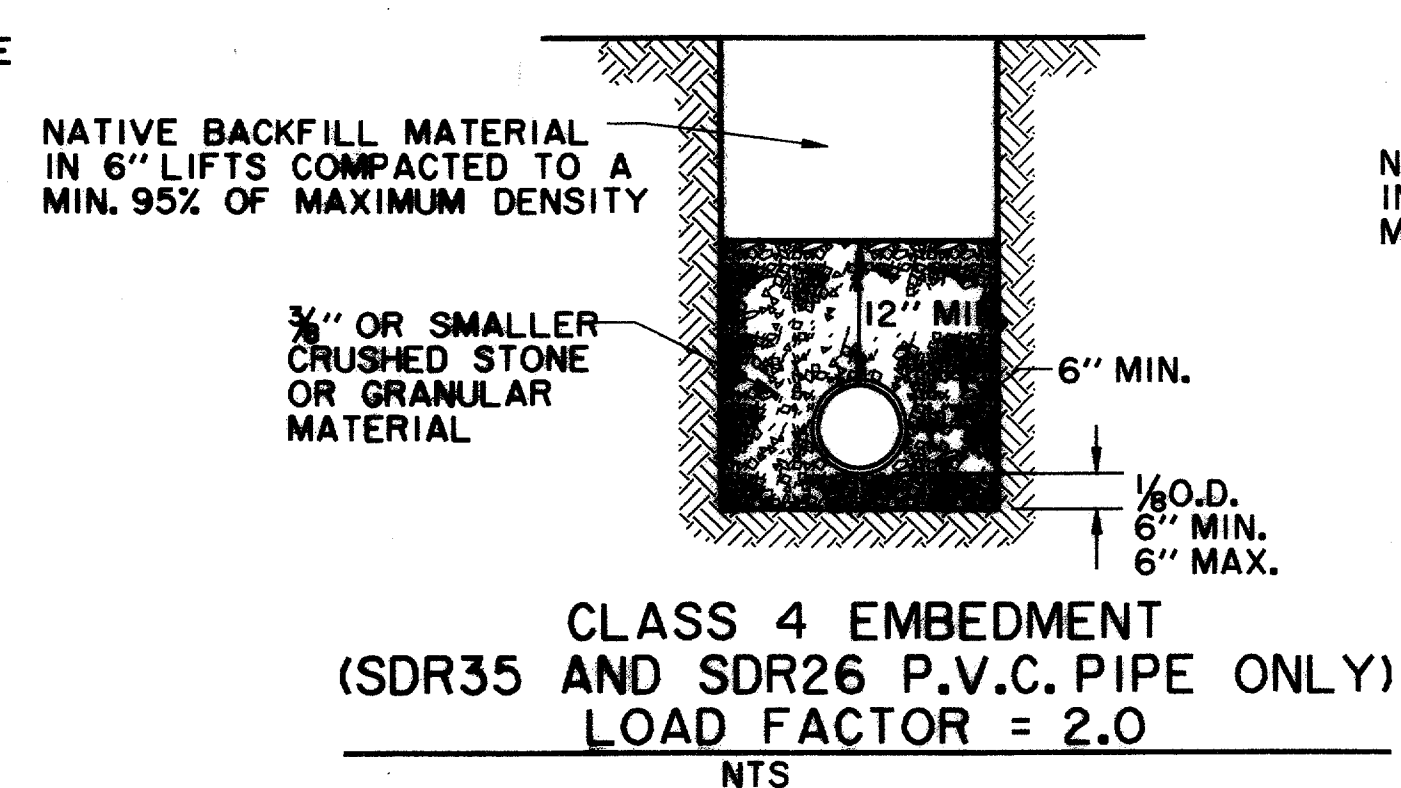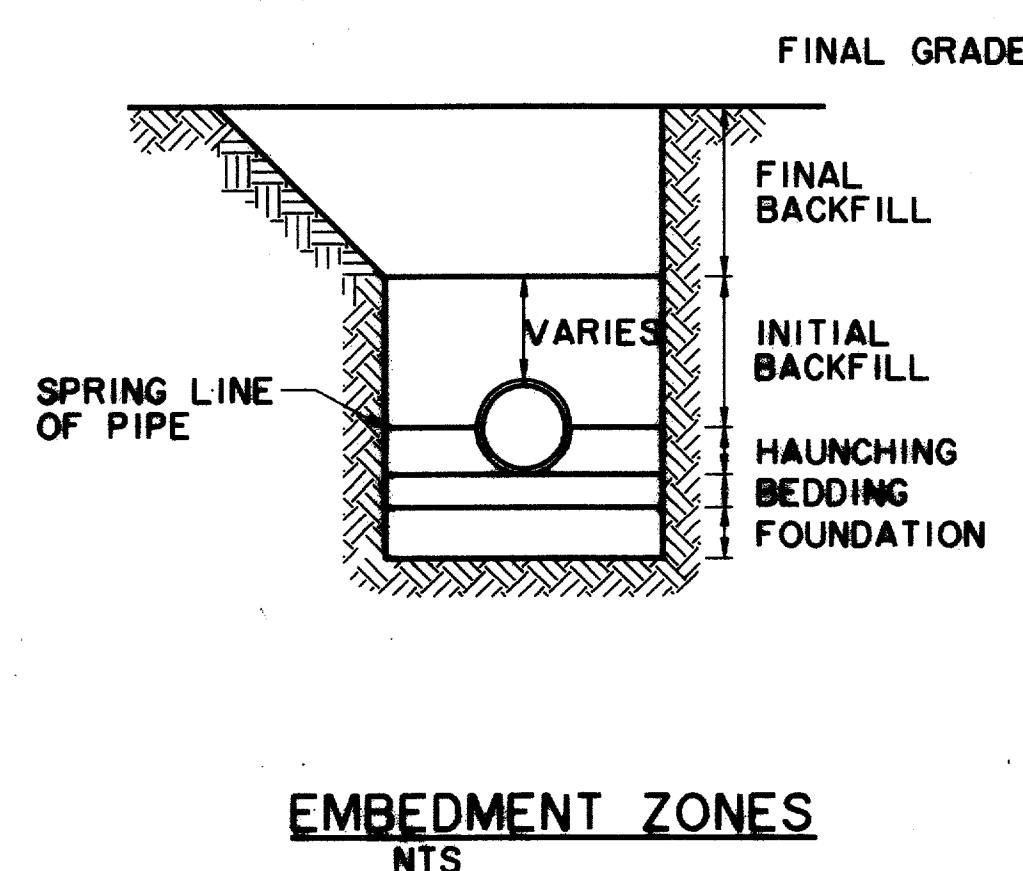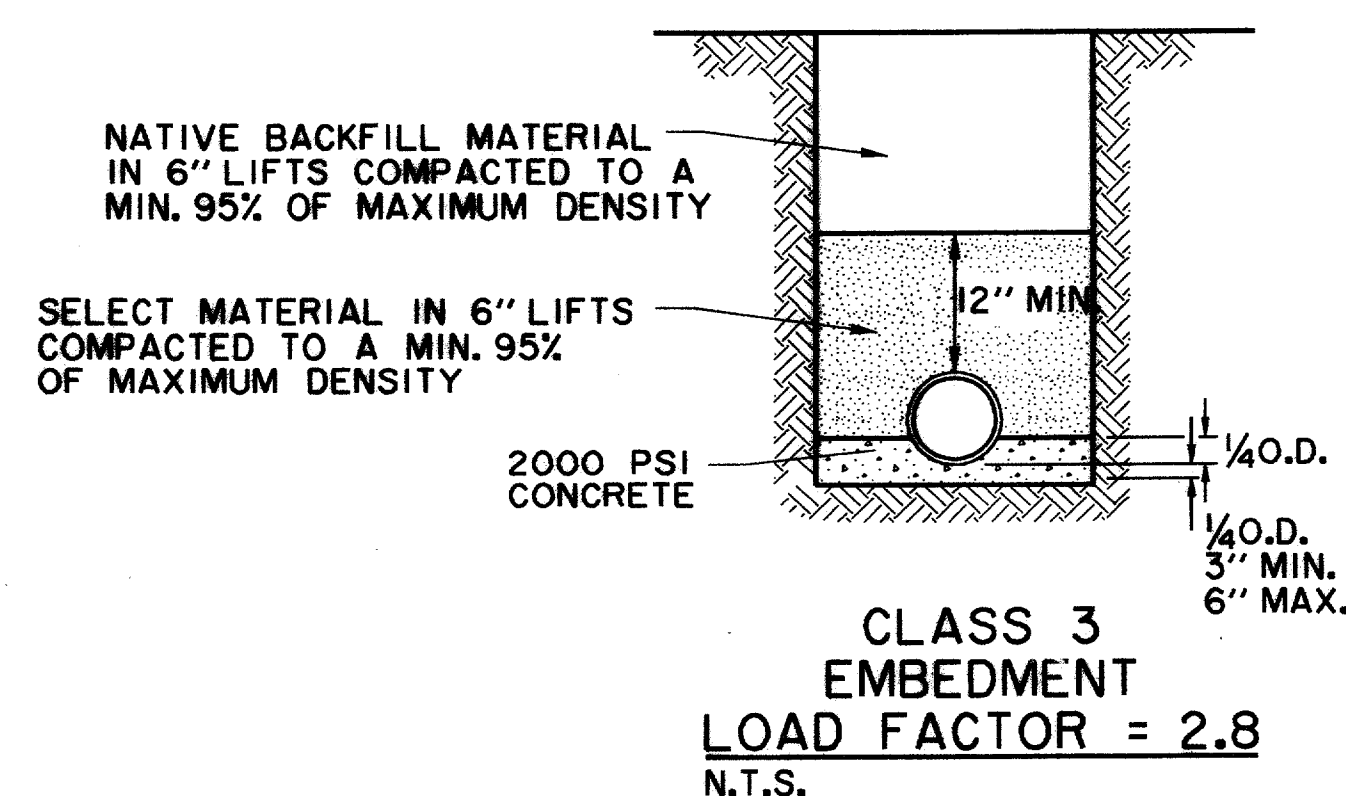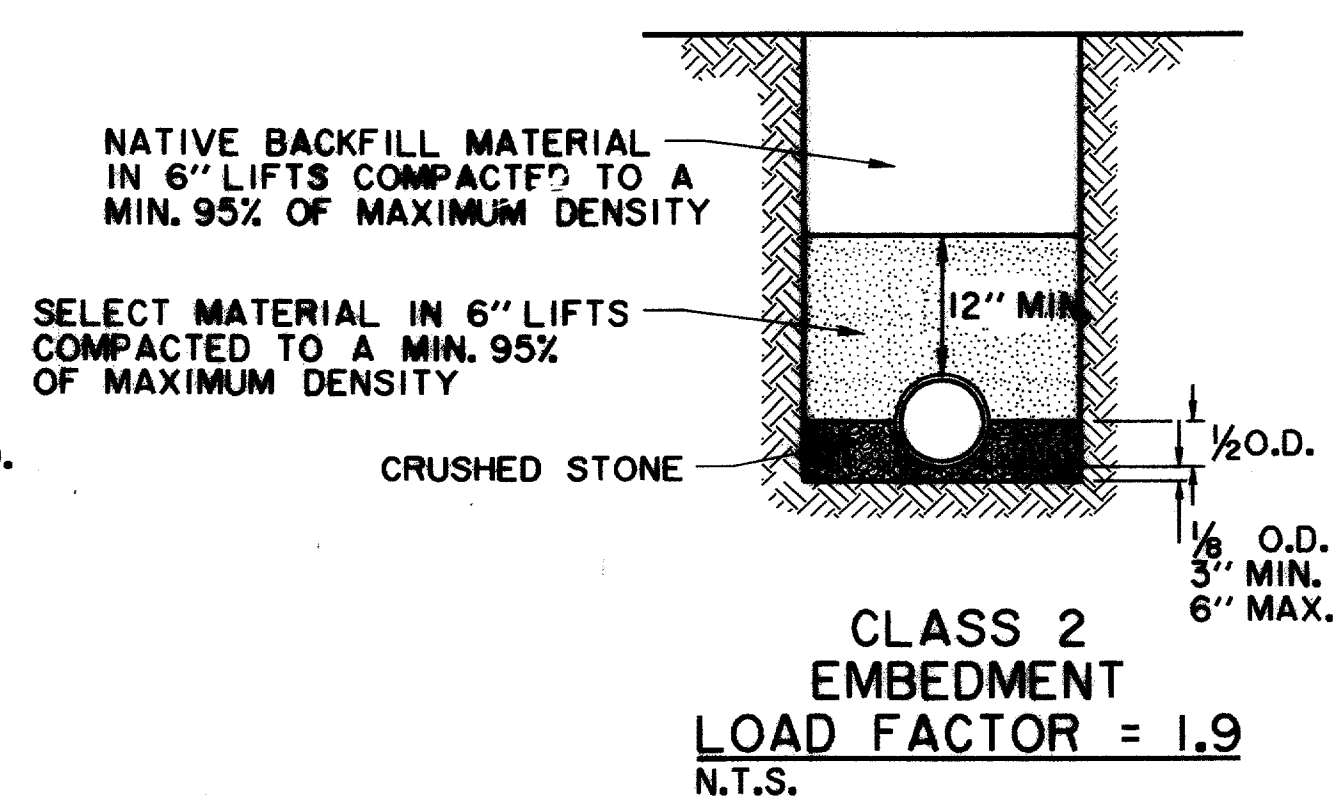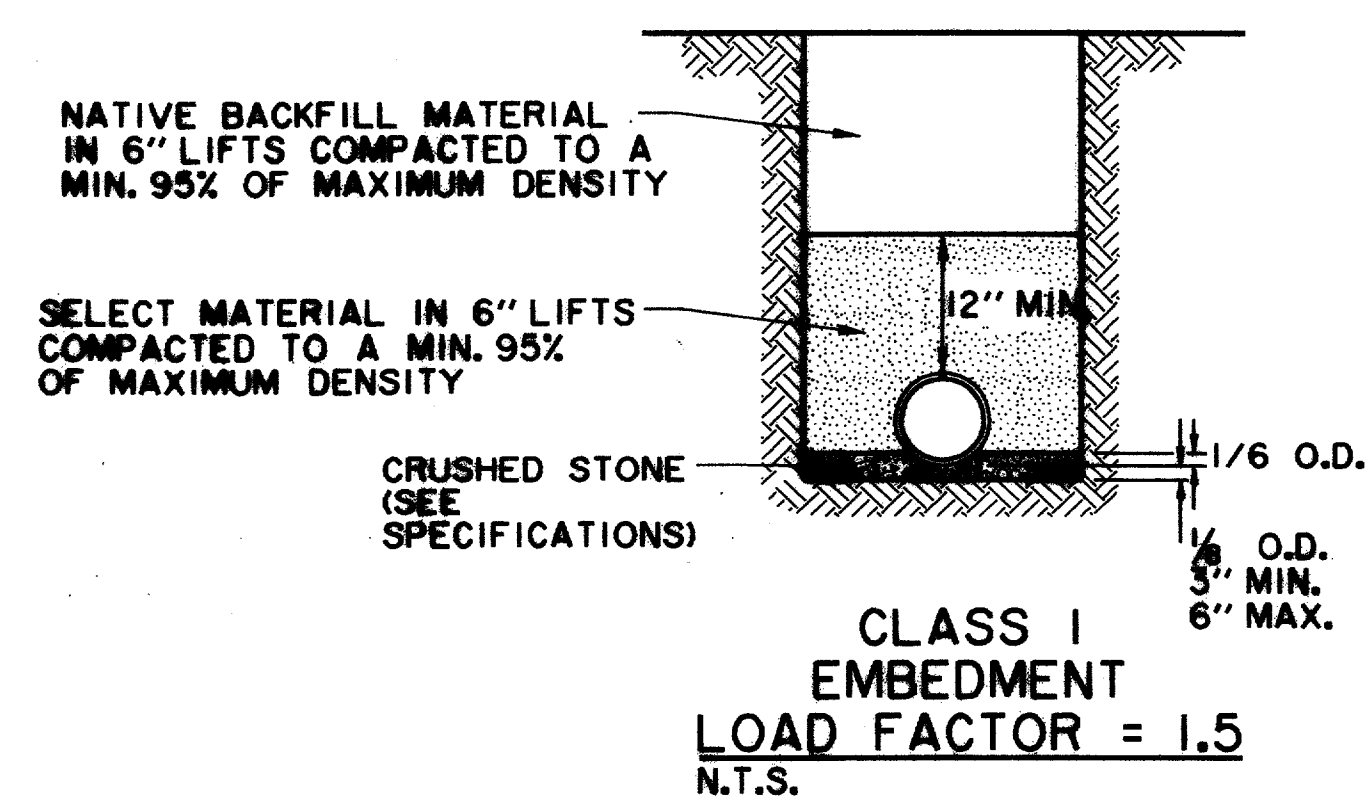

TYPICAL NATIVE MATERIAL COMPACTED TO:
95% OF STANDARD PROCTOR DENSITY AT
OPTIMUM MOISTURE 0 TO +3% UNDER PAVEMENT
95% OF STANDARD PROCTOR DENSITY AT
OPTIMUM MOISTURE 0 TO +3% OUTSIDE CURB LINES
JETTING IS NOT ALLOWED
BACKFILL TO BE COMPACTED IN 6" +/- LIFTS
TYPICAL NATIVE MATERIAL (MAX. 3" DIA.)

EMBEDMENT DETAILS FOR SANITARY SEWER

TABLE OF QUANTITIES OF 2000 psi CONCRETE, GRAVEL OR CRUSHED STONE IN CUBIC YARDS PER 100 LINEAR FEET FOR EACH CLASS EMBEDMENT

SIZE OF PIPE IN INCHES I.D.	O.D. OF PIPE IN INCHES	TRENCH WIDTH IN INCHES	TRENCH WIDTH IN FEET	CLASS 1 EMBEDMENT CRUSHED STONE	CLASS 2 EMBEDMENT CONCRETE	CLASS 3 EMBEDMENT CONCRETE	CONCRETE ENCASEMENT
12	16.00	32	2.67	4.1	6.5	4.8	15.8
15	19.50	36	3.00	4.8	7.8	6.4	19.2
18	23.00	39	3.25	5.7	9.2	8.2	21.2
21	26.50	43	3.58	6.9	11.0	10.2	24.9
24	30.00	46	3.83	8.3	13.1	12.4	28.7
27	33.50	51	4.25	10.3	16.1	14.4	32.8
30	37.00	57	4.75	12.7	20.1	17.0	34.8
33	40.50	62	5.17	15.1	23.8	19.3	39.2
36	44.00	67	5.58	18.0	28.6	22.1	43.8

SIZE OF PIPE IN INCHES I.D.	O.D. OF PIPE IN INCHES	TRENCH WIDTH IN INCHES	TRENCH WIDTH IN FEET	CLASS 4 EMBEDMENT CRUSHED STONE	CONCRETE ENCASEMENT
6	6.28	24	2.00	8.0	11.7
8	8.16	24	2.00	8.7	12.4
10	10.20	26	2.18	10.2	14.2
12	12.24	28	2.35	11.7	15.9
16	15.30	31	2.61	14.0	18.8
24		36	3.0		
30		42	3.5		

THE SEAL APPEARING ON THIS DOCUMENT WAS AUTHORIZED BY KENNETH A. ROBERTS, P.E. 55446 ON OCTOBER 24, 1997



10-24-97

WASTEWATER DETAILS

ARAPAHO ROAD

ADDISON ROAD TO DALLAS NORTH TOLLWAY



TOWN OF ADDISON, TEXAS

Huitt-Zollars, Inc./Consulting Engineers
Dallas, Fort Worth, Houston, Phoenix, Austin

DESIGN	DRAWN	APPR.	SCALE	DATE	PROJECT NO.	NO.
HZI	HZI	KAR	N.T.S.	OCT 97	1772-01	W-11

RECORD DOCUMENTS 6/9/2000

THESE RECORD DOCUMENTS HAVE BEEN PREPARED BASED ON INFORMATION PROVIDED BY OTHERS. THE CONSULTANT HAS NOT VERIFIED THE ACCURACY AND/OR COMPLETENESS OF THIS INFORMATION AND SHALL NOT BE RESPONSIBLE FOR ANY ERRORS OR OMISSIONS THAT MAY BE INCORPORATED AS A RESULT OF ERRONEOUS INFORMATION PROVIDED BY OTHERS.

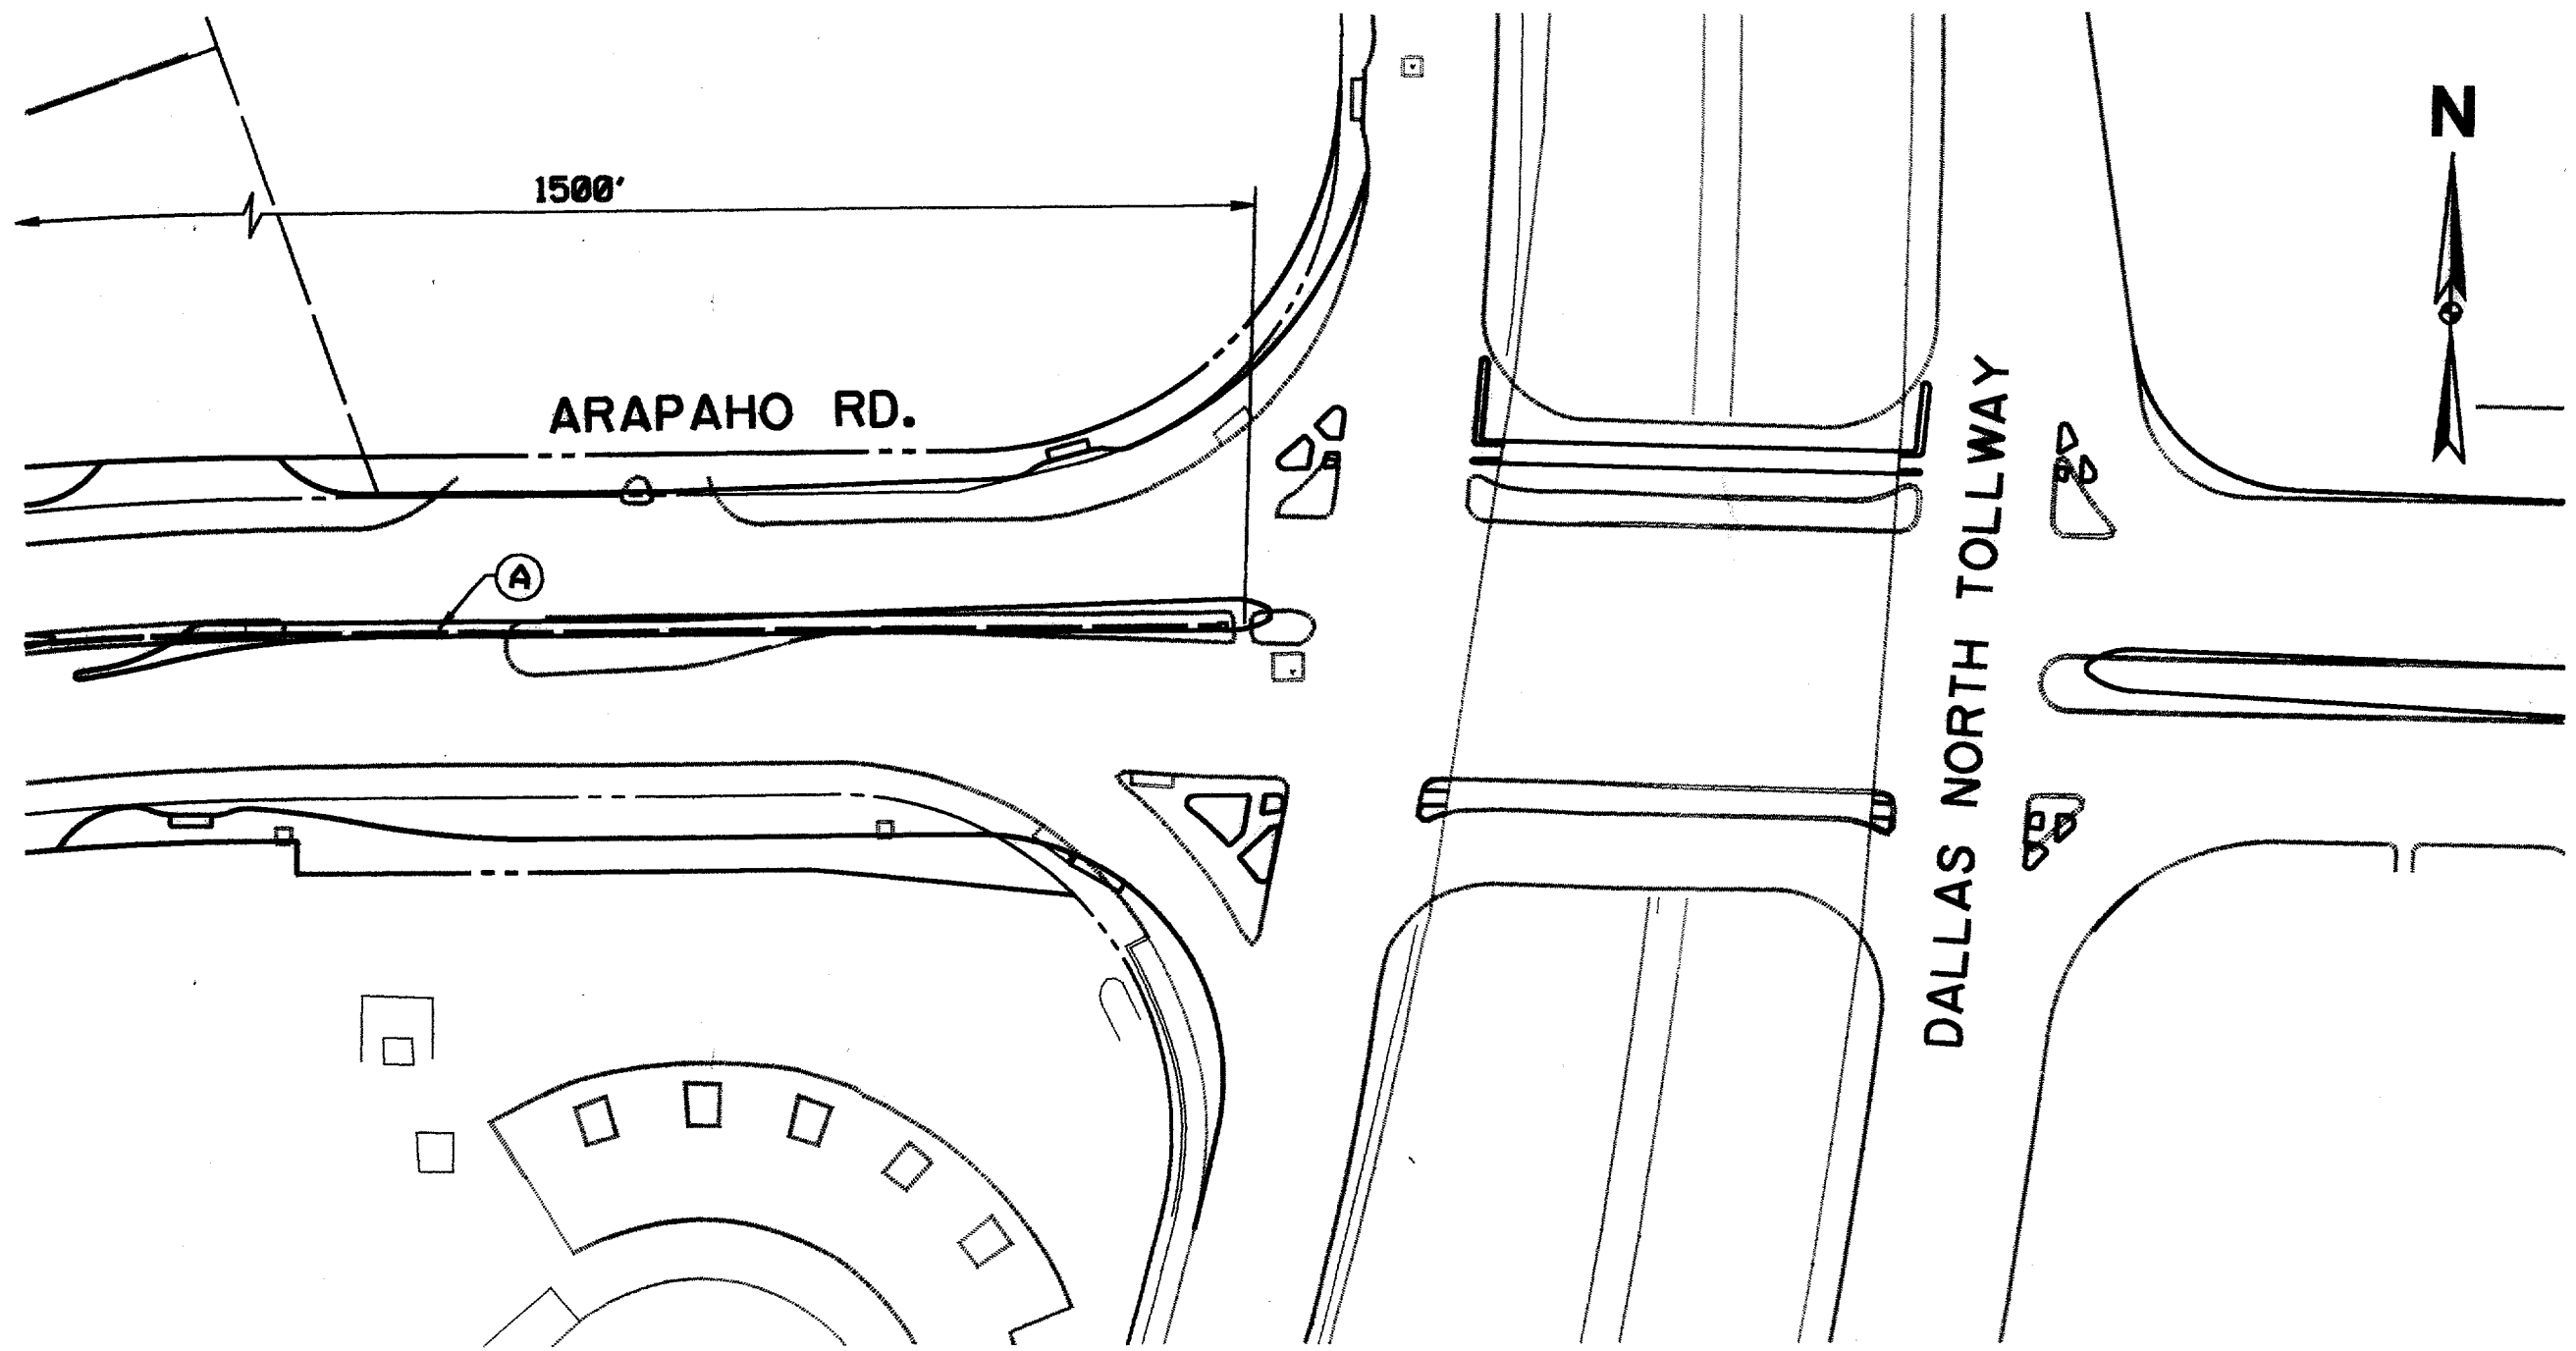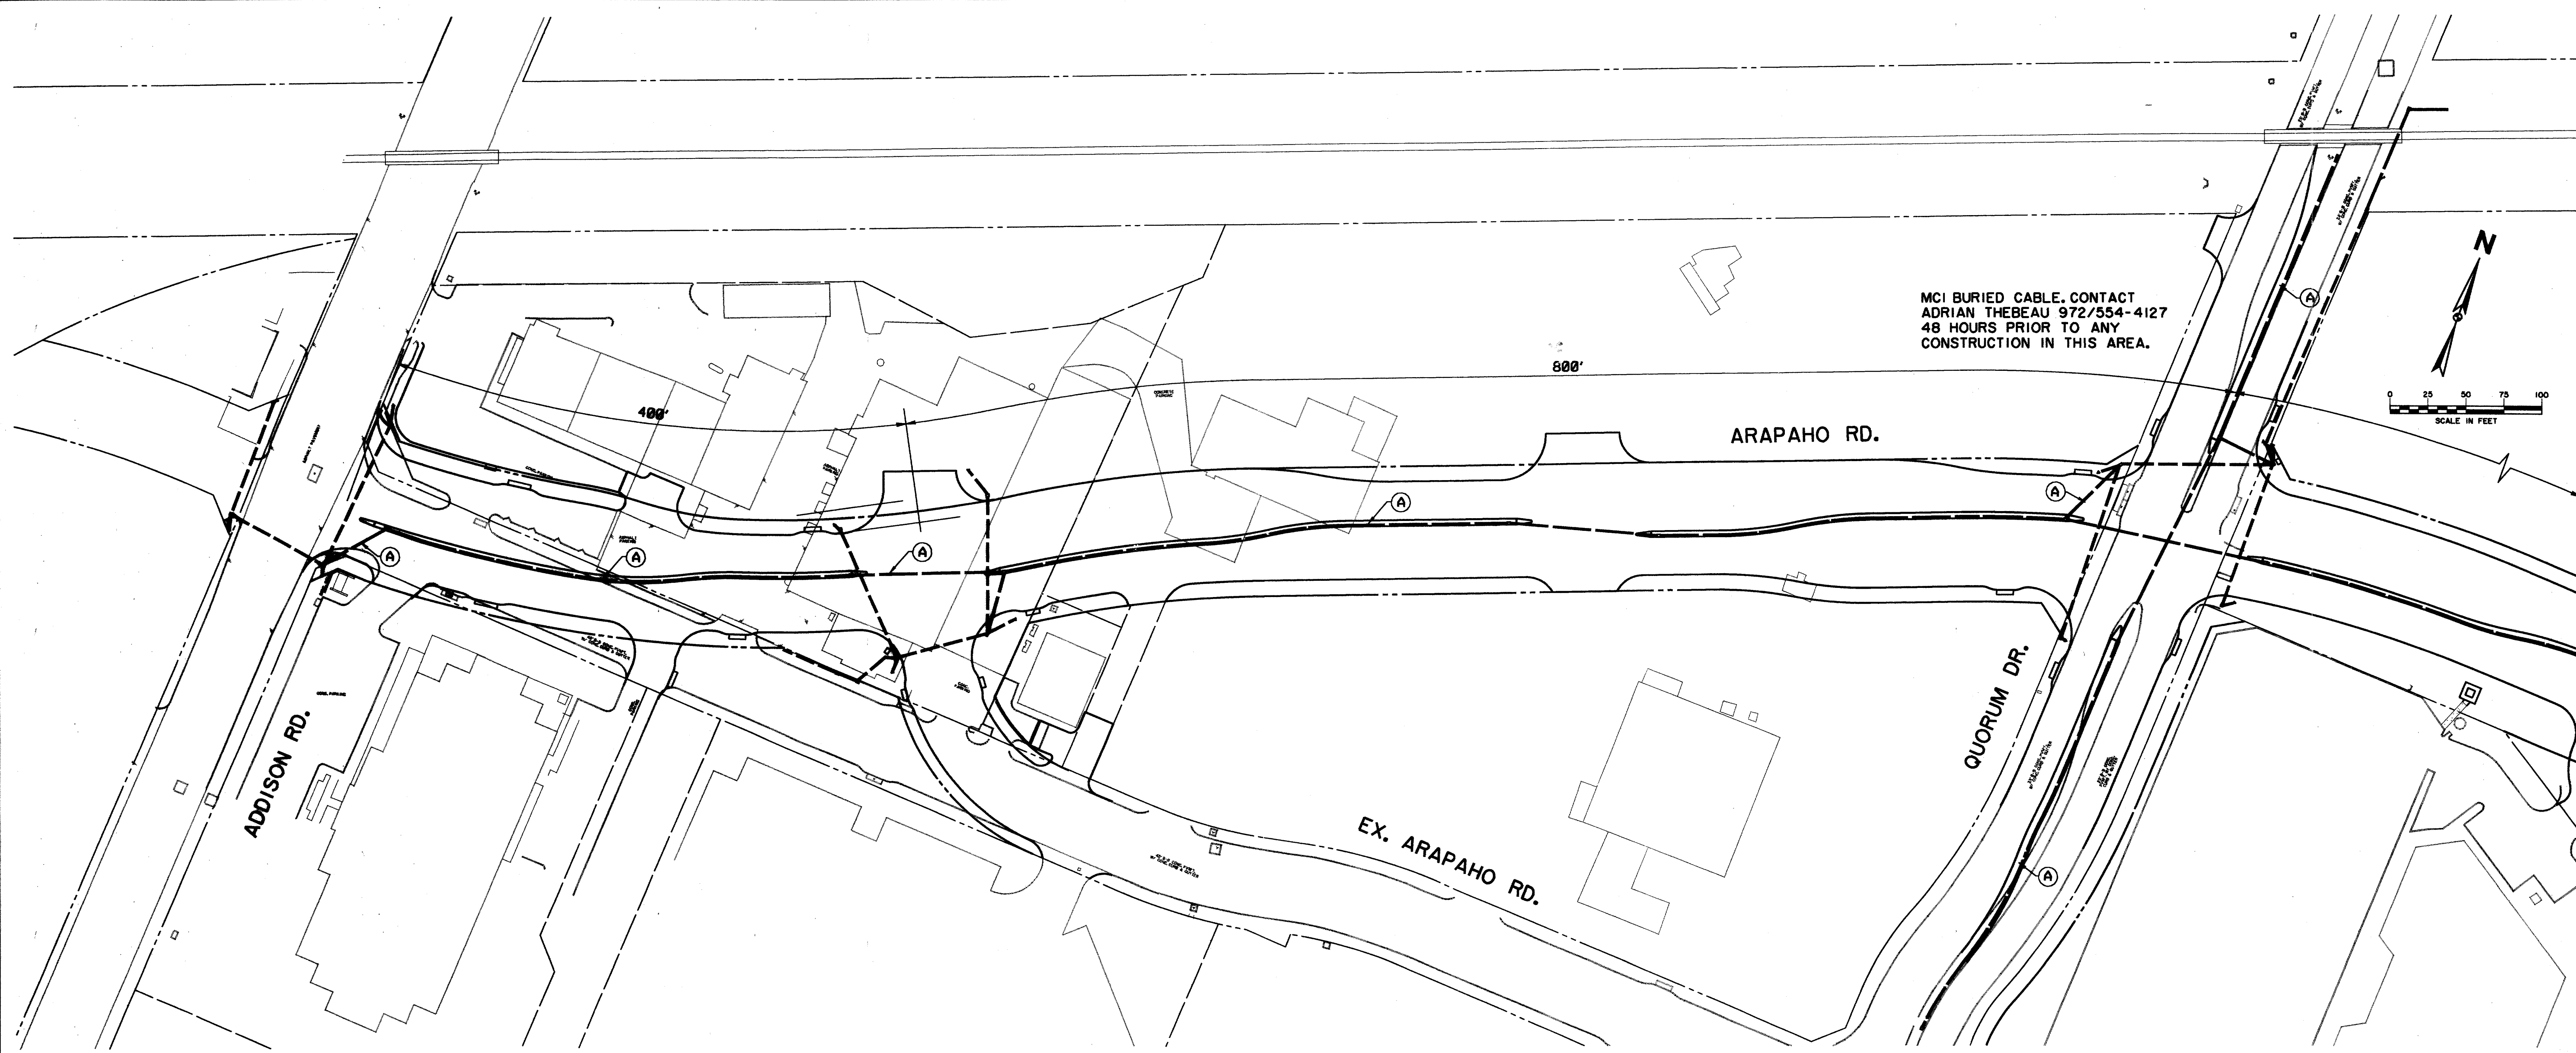

LEGEND

- PROPOSED CONTROLLER
- PROPOSED SIGNAL CONDUIT
- FUTURE SIGNAL CONDUIT
- PROPOSED PULL BOX
- 2" SCH40 PVC INTERCONNECT

INTERCONNECT CONDUIT

RUN	SCH 40 PVC (INCH)	LENGTH (FEET)	PULL BOX (EACH)
A	2"	2720	16

SEE SIGNAL LAYOUT SHEETS FOR SIGNAL CONDUIT RUNS TO CONTROLLER


THE SEAL APPEARING ON THIS DOCUMENT WAS AUTHORIZED BY DONNA L. MANHART, P.E. 65548 ON OCTOBER 24, 1997



INTERCONNECT LAYOUT						
ARAPAHO ROAD						
ADDISON ROAD TO DALLAS NORTH TOLLWAY						
TOWN OF ADDISON, TEXAS						
Huitt-Zollars, Inc./Consulting Engineers Dallas, Fort Worth, Houston, Phoenix, Tustin						
DESIGN	DRAWN	APPR.	SCALE	DATE	PROJECT NO.	NO.
HZI	HZI	DLM	1"=50'	OCT 97	1772-01	S-1

RECORD DOCUMENTS 6/9/2000


THESE RECORD DOCUMENTS HAVE BEEN PREPARED BASED ON INFORMATION PROVIDED BY OTHERS. THE CONSULTANT HAS NOT VERIFIED THE ACCURACY AND/OR COMPLETENESS OF THIS INFORMATION AND SHALL NOT BE RESPONSIBLE FOR ANY ERRORS OR OMISSIONS THAT MAY BE INCORPORATED AS A RESULT OF ERRONEOUS INFORMATION PROVIDED BY OTHERS.

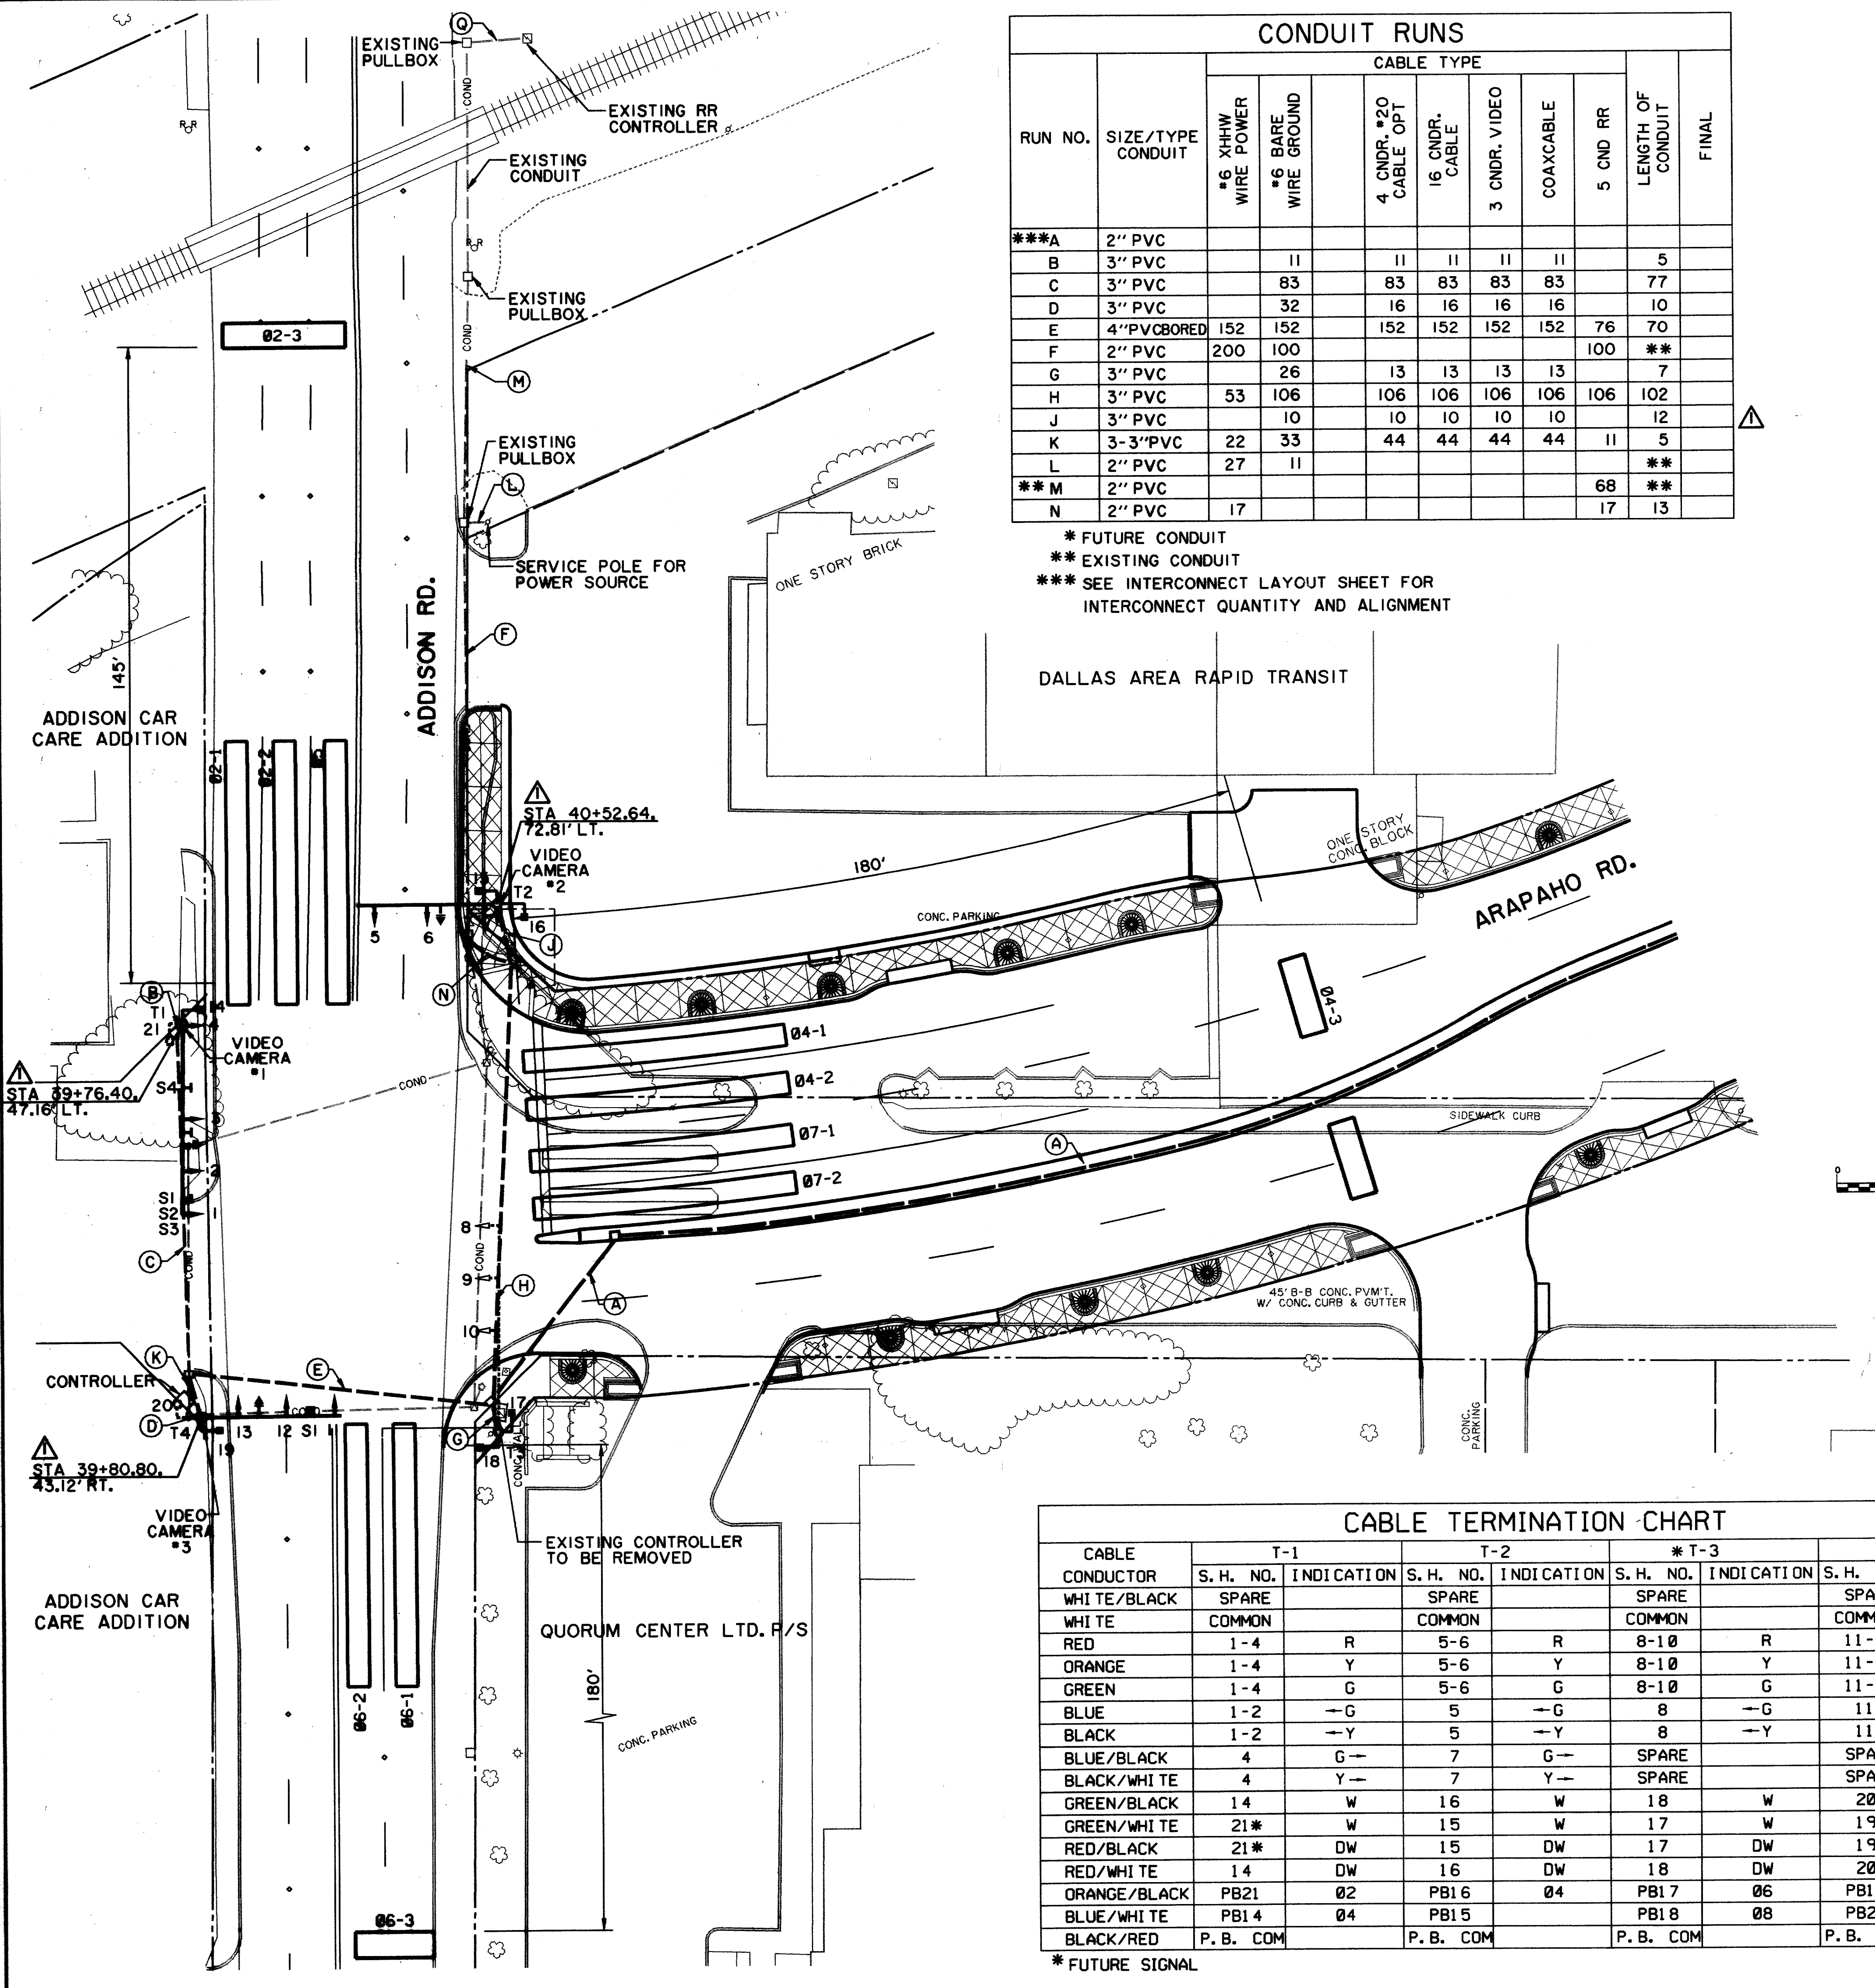

CONDUIT RUNS


RUN NO.	SIZE/TYPE CONDUIT	CABLE TYPE							LENGTH OF CONDUIT	FINAL
		#6 XHHW WIRE POWER	#6 BARE WIRE GROUND	4 CNDR. #20 CABLE OPT	16 CNDR. CABLE	3 CNDR. VIDEO	COAXCABLE	5 CND RR		
***A	2" PVC									
B	3" PVC		11		11	11	11		5	
C	3" PVC		83		83	83	83		77	
D	3" PVC		32		16	16	16		10	
E	4" PVC BORED	152	152		152	152	152	76	70	
F	2" PVC	200	100					100	**	
G	3" PVC		26		13	13	13		7	
H	3" PVC	53	106		106	106	106	106	102	
J	3" PVC		10		10	10	10		12	
K	3-3" PVC	22	33		44	44	44	11	5	
L	2" PVC		27						**	
**M	2" PVC		11					68	**	
N	2" PVC		17					17	13	

* FUTURE CONDUIT
 ** EXISTING CONDUIT
 *** SEE INTERCONNECT LAYOUT SHEET FOR INTERCONNECT QUANTITY AND ALIGNMENT

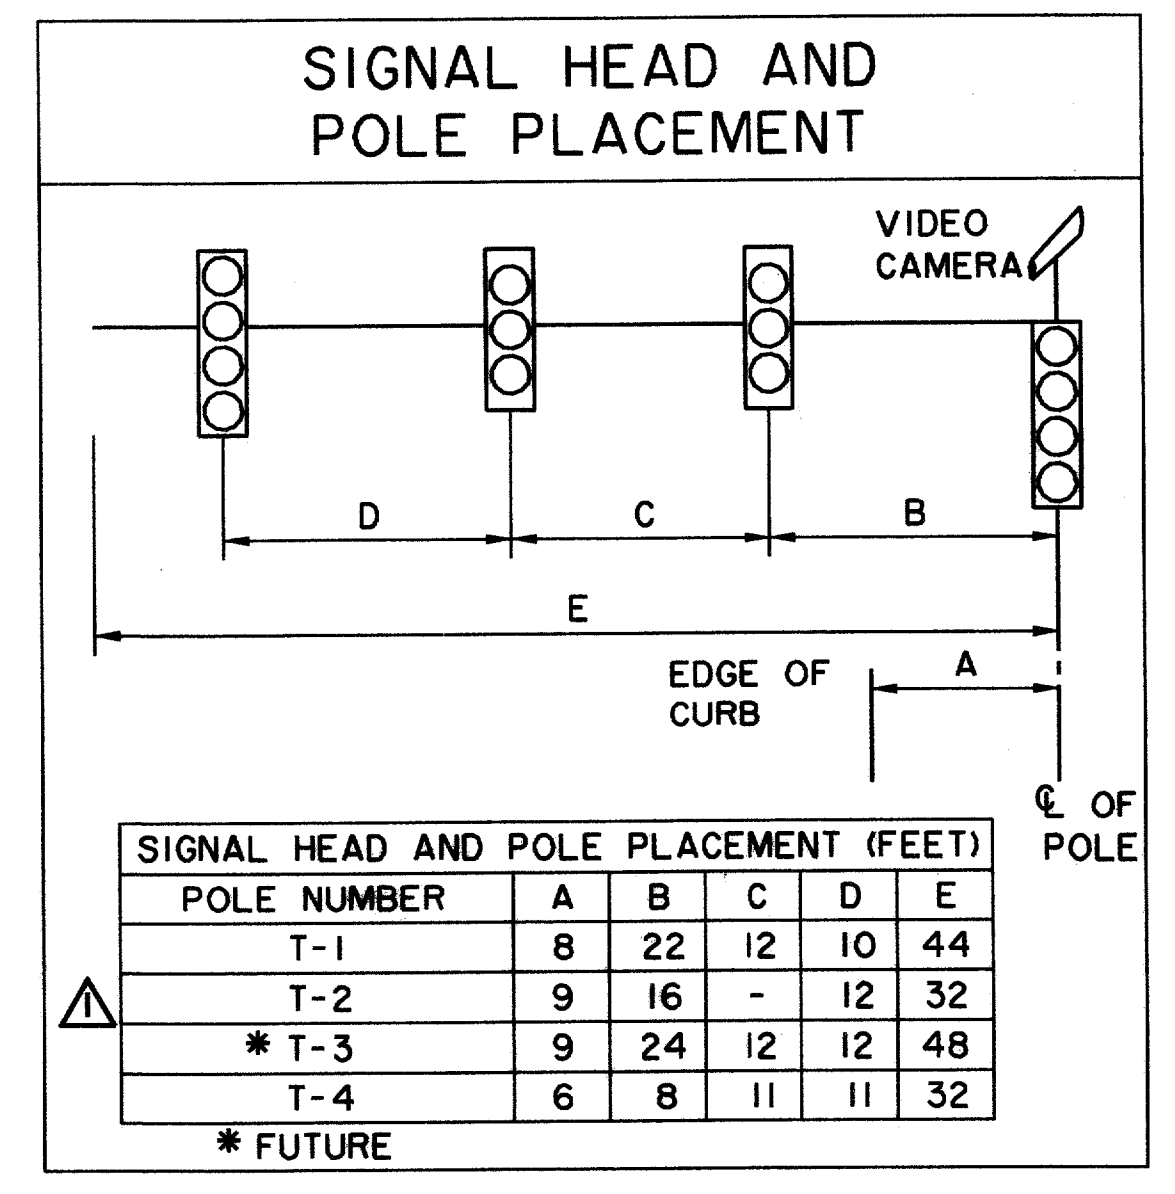

SIGNAL POLE CONDUCTORS

POLE NUMBER	4CND	5CND	7CND
T-1	65	70	140
T-2	35	60	55
T-4	40	95	60

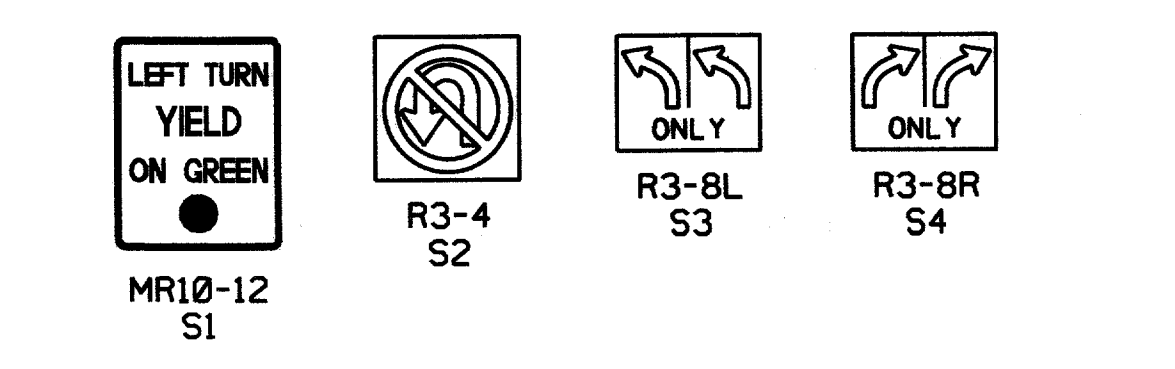

RECORD DOCUMENTS 6/9/2000
 THESE RECORD DOCUMENTS HAVE BEEN PREPARED BASED ON INFORMATION PROVIDED BY OTHERS. THE CONSULTANT HAS NOT VERIFIED THE ACCURACY AND/OR COMPLETENESS OF THIS INFORMATION AND SHALL NOT BE RESPONSIBLE FOR ANY ERRORS OR OMISSIONS THAT MAY BE INCORPORATED AS A RESULT OF ERRONEOUS INFORMATION PROVIDED BY OTHERS.



QUANTITIES

ITEM	UNIT	QTY.
CONDUIT		
1-3' TRENCH	L.F.	215
1-2' TRENCH	L.F.	13
1-4' BORED	L.F.	70
PULL BOX	EA.	4
VIDEO CAMERA	EA.	4
3M OPTICOM DETECTOR	EA.	3
PEDESTRIAN PUSH BUTTON	EA.	6
CABLE WIRE		
5 CONDUCTOR RR	L.F.	378
7 CONDUCTOR #12	L.F.	270
5 CONDUCTOR #12	L.F.	225
16 CONDUCTOR #12	L.F.	435
COAXCABLE	L.F.	525
1 CONDUCTOR #6 GROUND	L.F.	564
2 CONDUCTOR #6 POWER	L.F.	472
3 CONDUCTOR (VIDEO)	L.F.	525
4 CONDUCTOR OPTICOM	L.F.	575
SIGNS		
MR10-12	EA.	2
R3-4	EA.	1
R3-8	EA.	2
FOUNDATIONS		
CONTROLLER	EA.	1
TYPE 30-A	EA.	2
TYPE 30-B	EA.	2
TYPE C	EA.	-
POLES:		
MAST ARM POLE W/ 32' ARM	EA.	2
W/ 44' ARM	EA.	1
* W/ 48' ARM	EA.	1
SIGNAL HEADS:		
4 SECTION 12' LENS	EA.	6
3 SECTION 12' LENS	EA.	4
2 SECTION PEDESTRIAN	EA.	6
MISCELLANEOUS:		
CONNECT TO RAILROAD GATE CONTROLLER	LS	1

* FUTURE

LEGEND

- PROPOSED PEDESTRIAN SIGNAL
- CONDUIT RUN NUMBER
- SIGNAL HEAD NUMBER
- PROPOSED SIGNAL HEAD
- PROPOSED SIGNAL CONDUIT
- EXISTING SIGNAL CONDUIT
- FUTURE SIGNAL CONDUIT
- FUTURE SIGNAL IMPROVEMENTS
- PROPOSED PULL BOX
- EXISTING PULL BOX
- PROPOSED SIGNAL POLE
- LEFT TURN ON ARROW SIGN
- OPTICOM
- DETECTION ZONE FOR VIDEO

SIGNAL HEADS

NO	TYPE	PHASE	BACKPLATE		12' VEH SEC	PED SIG SEC
			3 SEC	4 SEC		
1	V4LT	07			4	
2	V4LT	07			4	
3	V3	04			3	
4	V4RT	04			4	
5	V4LT	06			4	
6	V3	06			3	
7	V4RT	06			4	
8	V4LT*	03				
9	V3*	08				
10	V3*	08				
11	V4LT	05			4	
12	V3	02			3	
13	V3	02			3	
14,15	PED	04P				2
16,17	PED	06P				2
18,19	PED	08P				2
20,21	PED	02P				
TOTALS			4	6	36	6

* FUTURE

- NOTES:
- ALLOW FOR EXTRA 4.5 & 7CNDR CABLE FOR THE FUTURE T3 SIGNALS.
 - ALL CABLE SHALL BE RUN CONTINUOUSLY WITHOUT SPLICES.
 - SEE INTERCONNECT LAYOUT SHEET FOR 2" PVC RUN A ALIGNMENT AND SUMMARY.
 - CONTRACTOR SHALL CONTACT TU ELECTRIC TO COORDINATE DISCONNECT AND RECONNECT OF EXISTING STREET LIGHT CIRCUIT. CONTRACTOR SHALL INSTALL NEW FOUNDATION, CONDUIT AND CONDUCTOR IF NECESSARY TO RELOCATE SERVICE POLE.
 - VIDEO CAMERAS SHALL BE MOUNTED ON TOP OF SIGNAL POLE AND AIMED IN THE SAME DIRECTION AS SIGNAL HEADS AND ALIGNED TO DETECT ZONES SHOWN ON THIS SHEET.
 - STREET NAME SIGNS WILL BE INSTALLED BY THE TOWN OF ADDISON.

CABLE TERMINATION CHART

CABLE CONDUCTOR	T-1		T-2		* T-3		T-4	
	S. H. NO.	INDICATION	S. H. NO.	INDICATION	S. H. NO.	INDICATION	S. H. NO.	INDICATION
WHI TE/BLACK	SPARE		SPARE		SPARE		SPARE	
WHI TE	COMMON		COMMON		COMMON		COMMON	
RED	1-4	R	5-6	R	8-10	R	11-13	R
ORANGE	1-4	Y	5-6	Y	8-10	Y	11-13	Y
GREEN	1-4	G	5-6	G	8-10	G	11-13	G
BLUE	1-2	-G	5	-G	8	-G	11	-G
BLACK	1-2	-Y	5	-Y	8	-Y	11	-Y
BLUE/BLACK	4	G-	7	G-	SPARE		SPARE	
BLACK/WHI TE	4	Y-	7	Y-	SPARE		SPARE	
GREEN/BLACK	14	W	16	W	18	W	20*	W
GREEN/WHI TE	21*	W	15	W	17	W	19	W
RED/BLACK	21*	DW	15	DW	17	DW	19	DW
RED/WHI TE	14	DW	16	DW	18	DW	20*	DW
ORANGE/BLACK	PB21	02	PB16	04	PB17	06	PB19	08
BLUE/WHI TE	PB14	04	PB15		PB18	08	PB20	02
BLACK/RED	P. B. COM		P. B. COM		P. B. COM		P. B. COM	


* FUTURE SIGNAL

THE SEAL APPEARING ON THIS DOCUMENT WAS AUTHORIZED BY DONNA L. MANHART, P.E. 65548 ON OCTOBER 24, 1997

SIGNALIZATION PLAN
ARAPAHO ROAD & ADDISON ROAD
ARAPAHO ROAD
ADDISON ROAD TO DALLAS NORTH TOLLWAY
TOWN OF ADDISON, TEXAS


Huff-Zollars, Inc./Consulting Engineers
 Dallas, Fort Worth, Houston, Phoenix, Austin

DESIGN	DRAWN	APPR.	SCALE	DATE	PROJECT NO.	NO.
HZ1	HZ1	DLM	1"=20'	OCT 97	1772-01	S-2

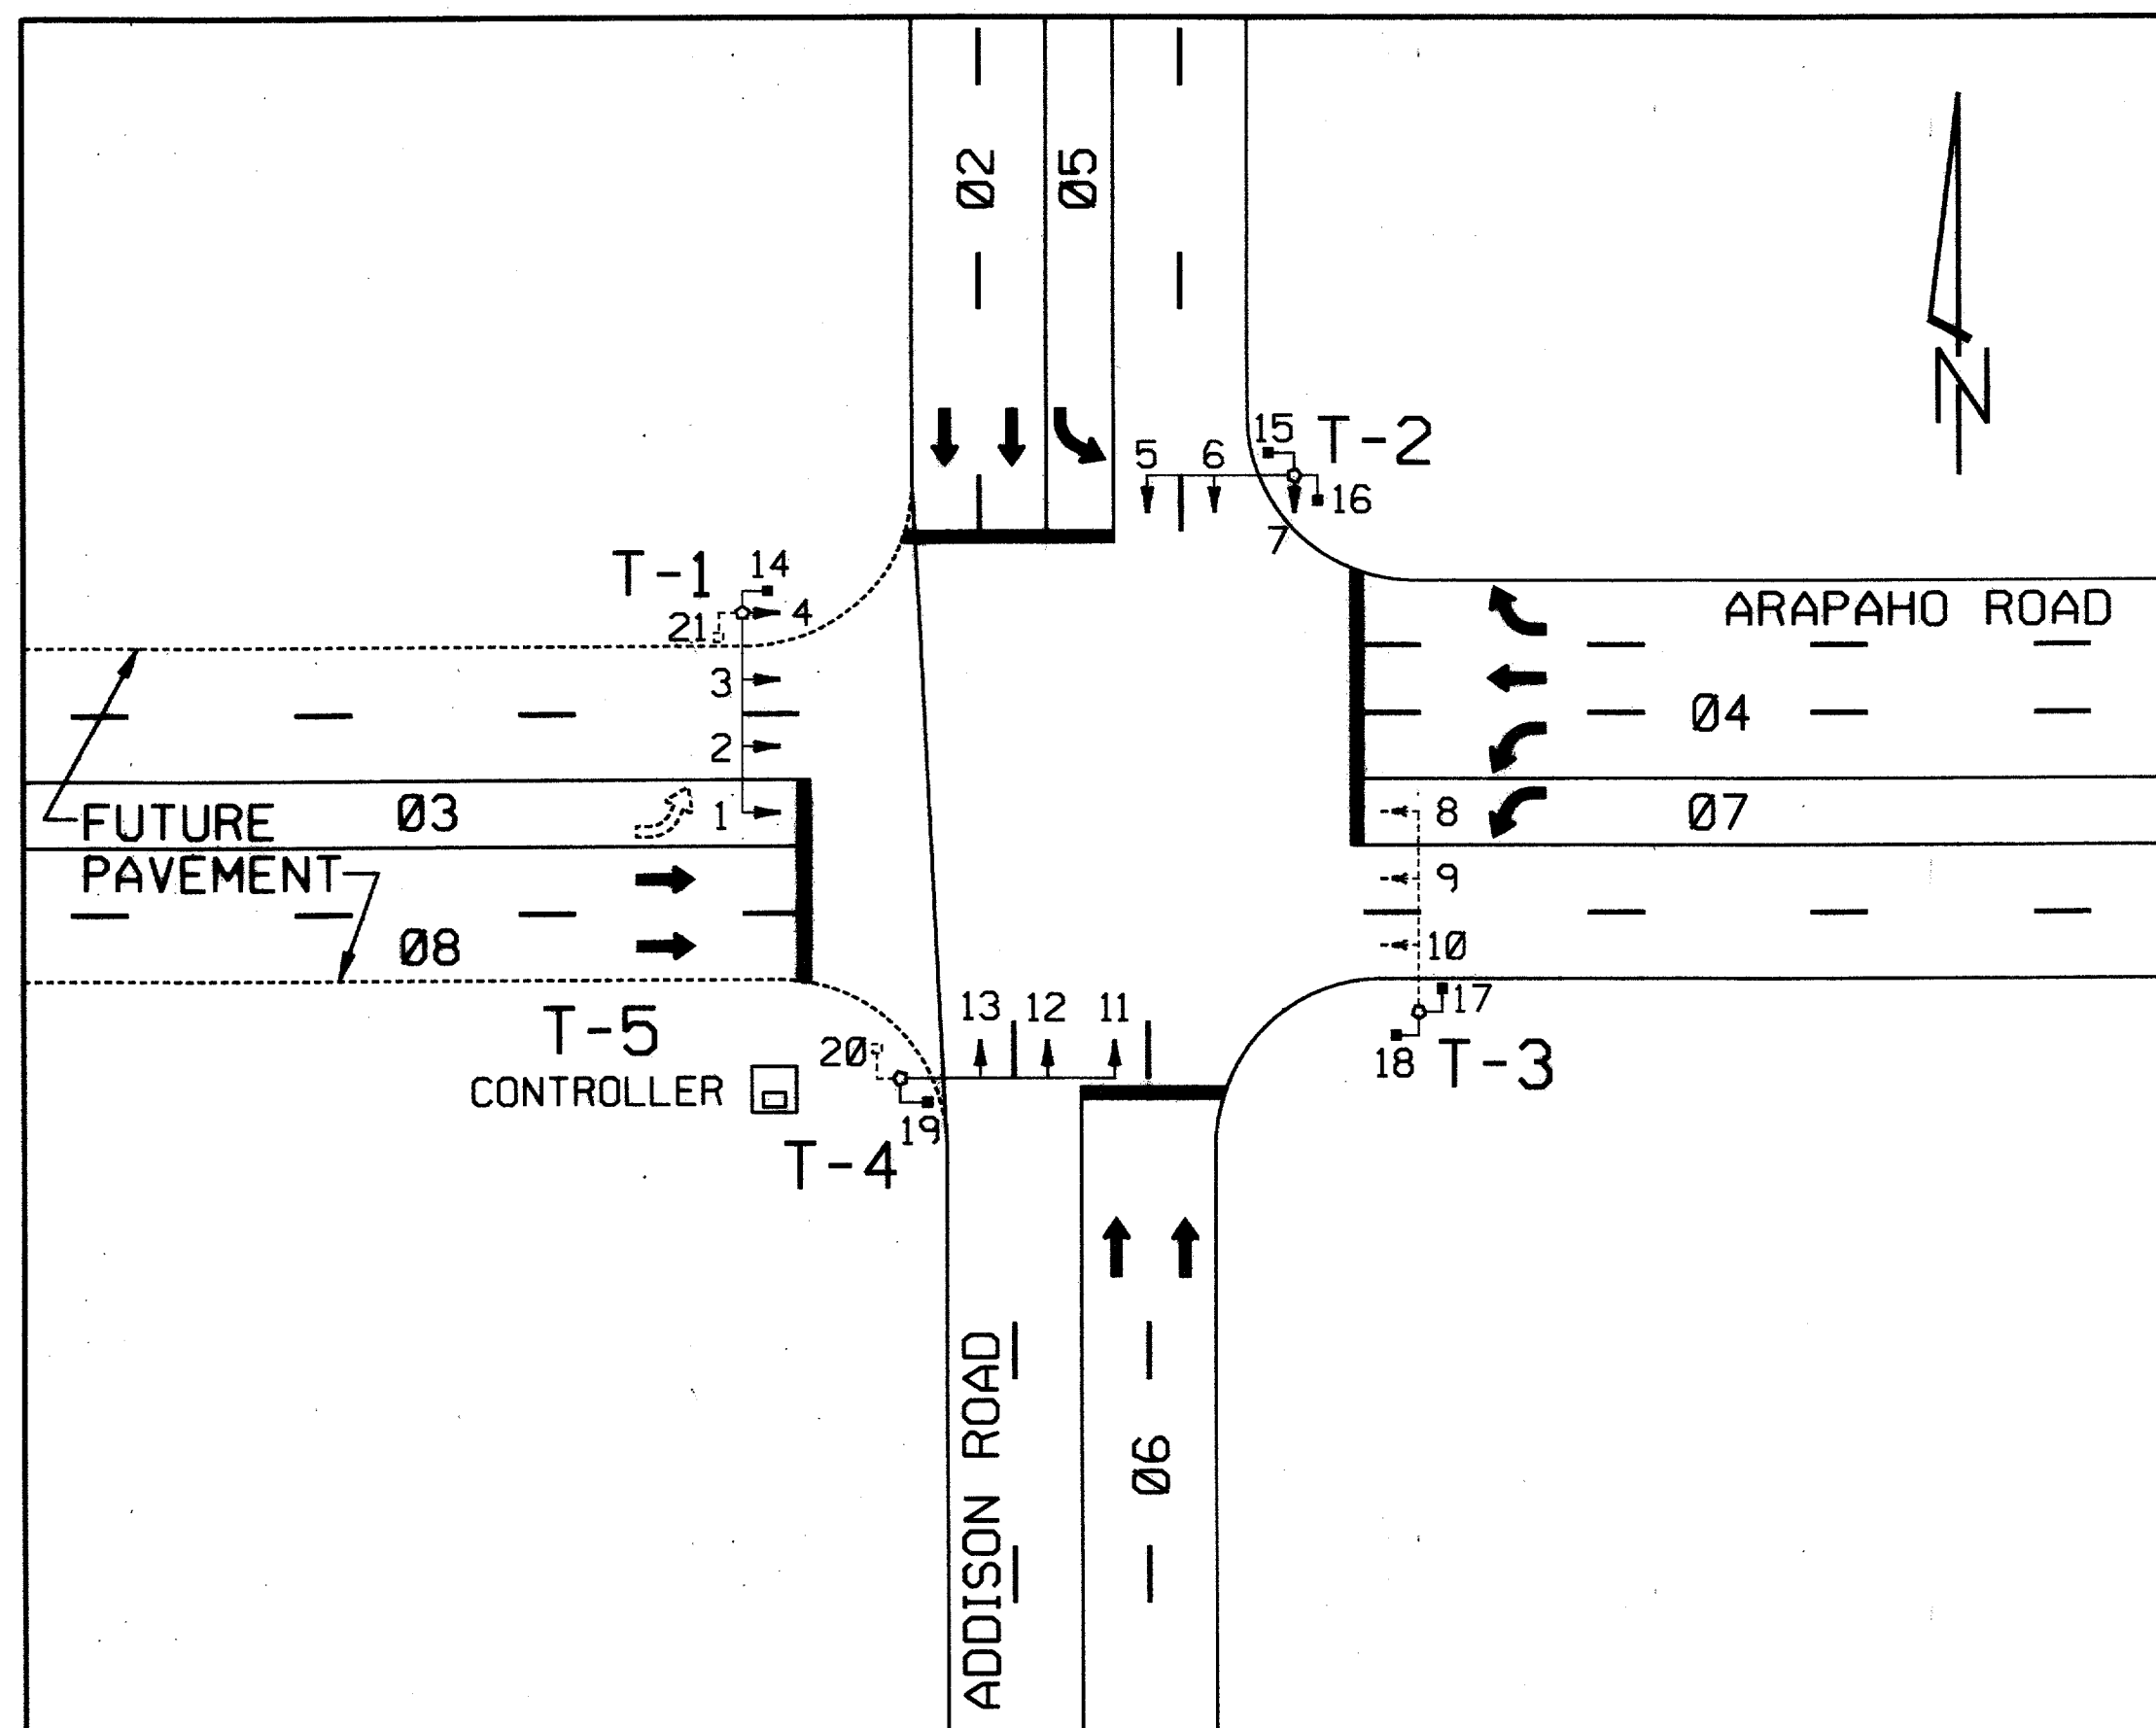


SIGNAL FACES																				
1	2	3	4	5	6	7	8*	9*	10*	11	12	13	14	15	16	17	18	19	20	21
R	R	R	R	R	R	R	R	R	R	R	R	R	DW	DW	DW	DW	DW	DW	DW	DW
Y	Y	Y	Y	Y	Y	Y	Y	Y	Y	Y	Y	Y	W	W	W	W	W	W	W	W
G	G	G	G	G	G	G	G	G	G	G	G	G								
-8	-8			-8	-8			-8												


* FUTURE SIGNAL HEADS

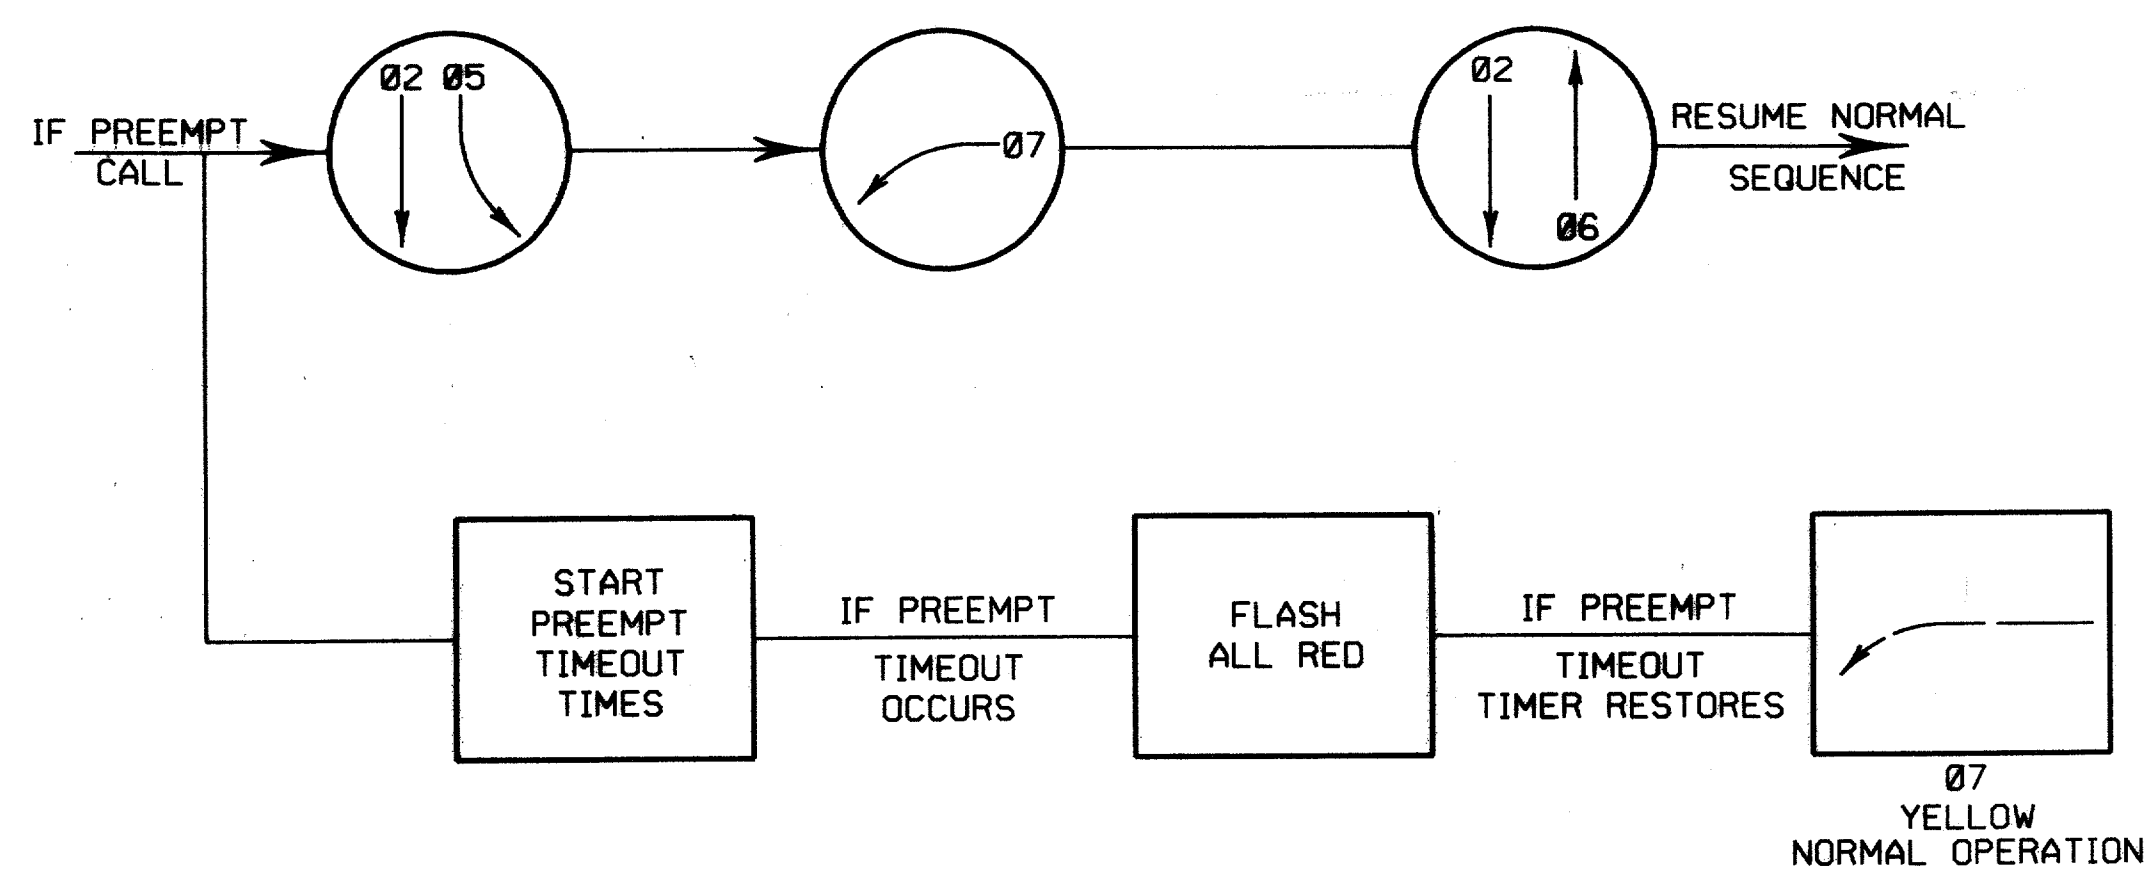

RAILROAD PRE-EMPTION PHASING DIAGRAM

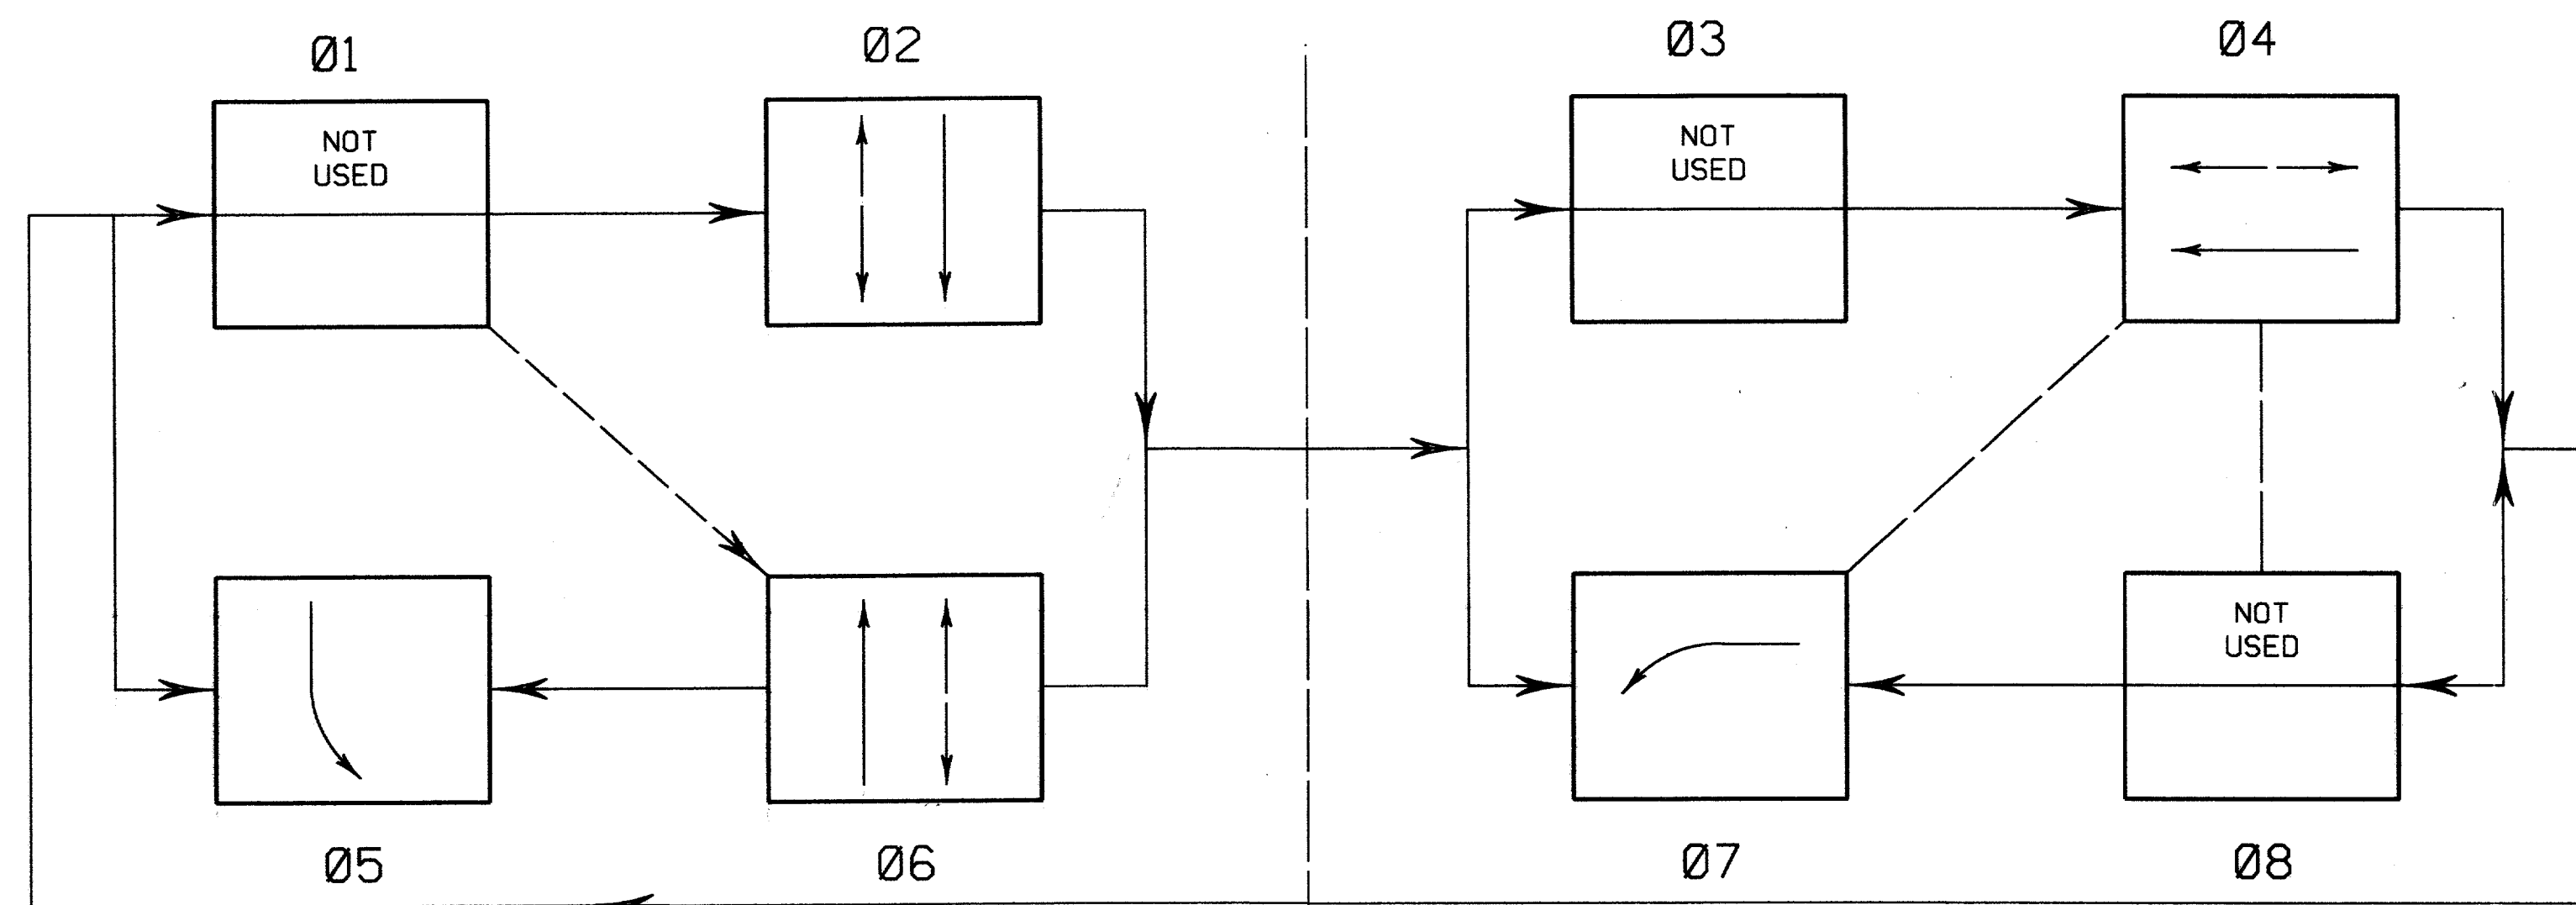

PHASE 4 RIGHT TURN WILL OVERLAP WITH PHASE 5
 PHASE 5 IS PROTECTED
 PHASE 6 RIGHT TURN WILL OVERLAP WITH PHASE 7

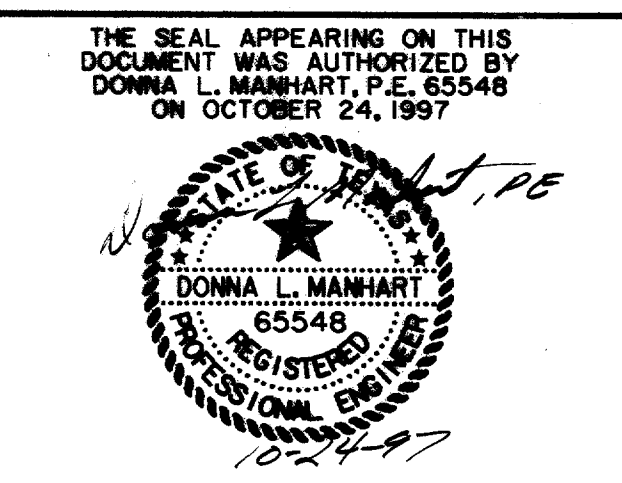



PHASE DIAGRAM						
ARAPAHO ROAD & ADDISON ROAD						
ARAPAHO ROAD						
ADDISON ROAD TO DALLAS NORTH TOLLWAY						
TOWN OF ADDISON, TEXAS						
Hult-Zollars, Inc./Consulting Engineers Dallas, Fort Worth, Houston, Phoenix, Tustin						
DESIGN	DRAWN	APPR.	SCALE	DATE	PROJECT NO.	NO.
HZI	HZI	DLM	NTS	OCT 97	1772-01	S-3

RECORD DOCUMENTS 6/9/2000
 THESE RECORD DOCUMENTS HAVE BEEN PREPARED BASED ON INFORMATION PROVIDED BY OTHERS. THE CONSULTANT HAS NOT VERIFIED THE ACCURACY AND/OR COMPLETENESS OF THIS INFORMATION AND SHALL NOT BE RESPONSIBLE FOR ANY ERRORS OR OMISSIONS THAT MAY BE INCORPORATED AS A RESULT OF ERRONEOUS INFORMATION PROVIDED BY OTHERS.

CABLE CONDUCTOR	T-1		T-2		T-3		T-4	
	S.H. NO.	INDICATION	S.H. NO.	INDICATION	S.H. NO.	INDICATION	S.H. NO.	INDICATION
WHITE/BLACK	SPARE		SPARE		SPARE		SPARE	
WHITE	COMMON		COMMON		COMMON		COMMON	
RED	1-4	R	5-7	R	8-11	R	12-14	R
ORANGE	1-4	Y	5-7	Y	8-11	Y	12-14	Y
GREEN	1-4	G	5-7	G	8-11	G	12-14	G
BLUE	1	-G	5	-G	8	-G	12	-G
BLACK	1	-Y	5	-Y	8	-Y	12	-Y
BLUE/BLACK	4	G-	7	G-	11	G-	14	G-
BLACK/WHITE	4	Y-	7	Y-	11	Y-	14	Y-
GREEN/BLACK	22	W	16	W	18	W	20	W
GREEN/WHITE	15	W	17	W	19	W	21	W
RED/BLACK	22	DW	16	DW	18	DW	20	DW
RED/WHITE	15	DW	17	DW	19	DW	21	DW
ORANGE/BLACK	PB22	02	PB16	4	PB18	06	PB20	08
BLUE/WHITE	PB15	04	PB17	06	PB19	08	PB21	02
BLACK/RED	P.B. COM		P.B. COM		P.B. COM		P.B. COM	


RUN NO.	SIZE/TYPE CONDUIT	CABLE TYPE						LENGTH OF CONDUIT	FINAL
		2 CNDR. #6 XHHW WIRE POWER	#6 BARE WIRE GROUND	COAX CABLE	4 CNDR. #20 CABLE OPT	16 CNDR. CABLE	3C VIDEO		
*A	2" PVC								
B	4" PVC		68	136	136	136	136	62	
C	3" PVC		30	15	15	15	15	9	
D	3" PVC		98	98	98	98	98	92	
E	3" PVC		10	10	10	10	10	4	
F	3" PVC		52	26	26	26	26	20	
G	3" PVC		96	96	96	96	96	90	
H	3" PVC		30	30	30	30	30	24	
I	2" PVC	20	20					14	
J	2-3" PVC	14	42	56	56	56	56	8	

* SEE INTERCONNECT LAYOUT FOR 2" PVC QUANTITIES AND ALIGNMENT

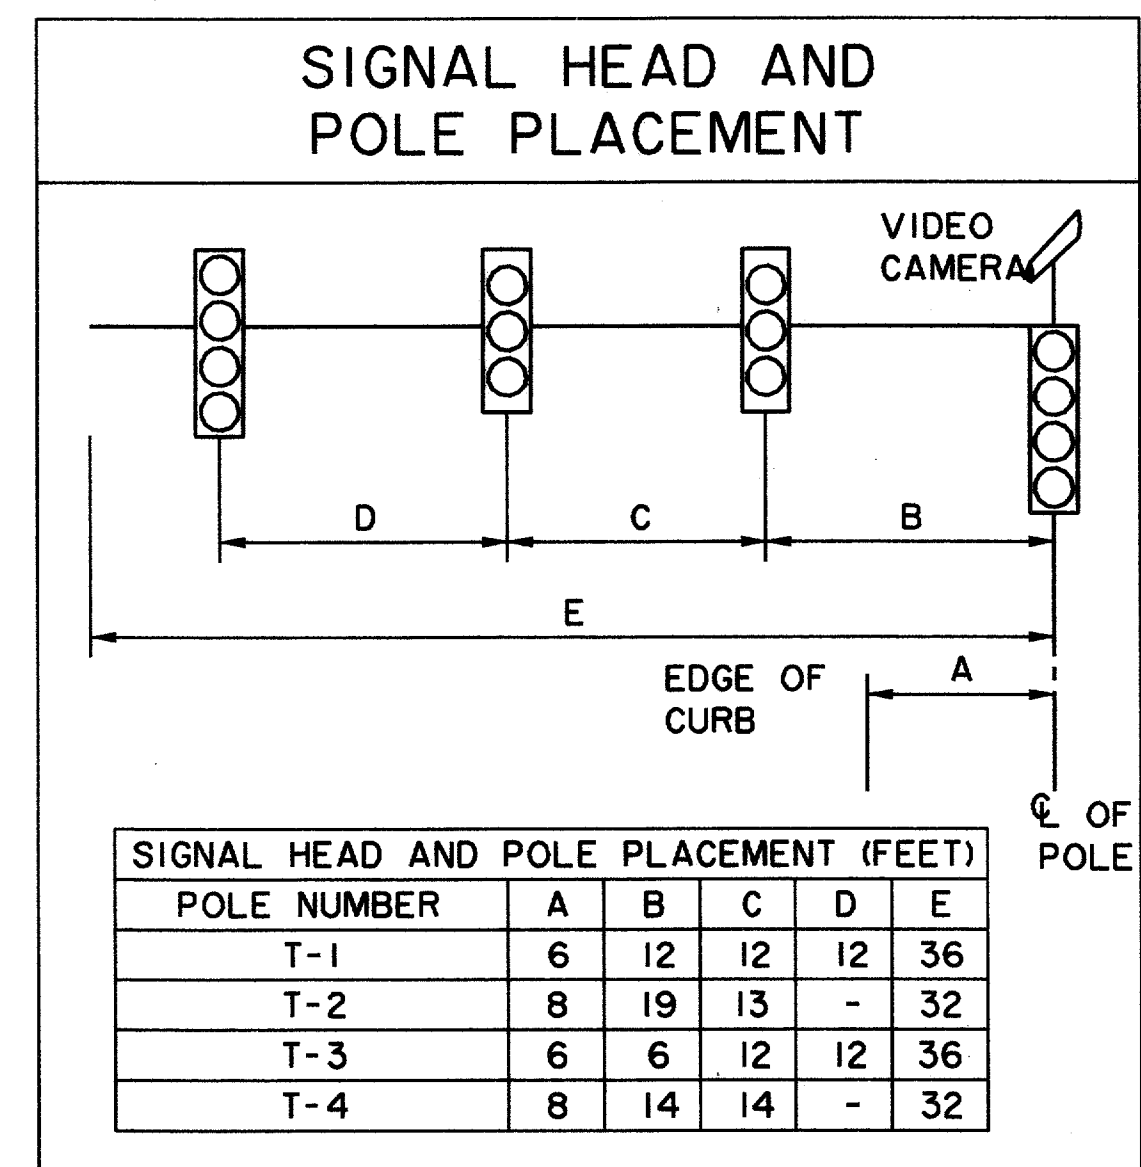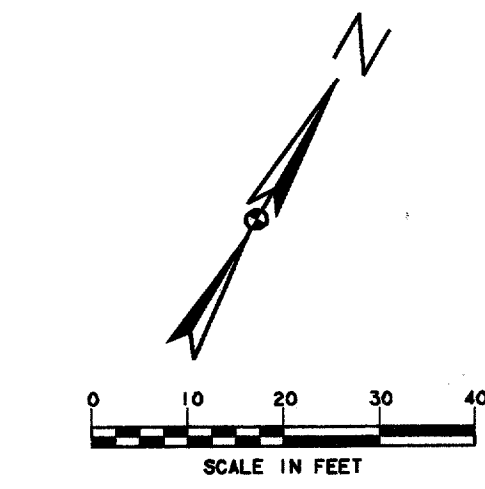

POLE NUMBER	A	B	C	D	E
T-1	6	12	12	12	36
T-2	8	19	13	-	32
T-3	6	6	12	12	36
T-4	8	14	14	-	32

ITEM	UNIT	QTY.
CONDUIT		
1-3" TRENCH	L.F.	255
1-2" TRENCH	L.F.	14
1-4" TRENCH	L.F.	62
PULL BOX	EA.	4
VIDEO CAMERA	EA.	4
3M OPTICOM DETECTOR	EA.	4
PEDESTRIAN PUSH BUTTON	EA.	8
CABLE WIRE		
7 CONDUCTOR #12	L.F.	285
5 CONDUCTOR #12	L.F.	393
16 CONDUCTOR #12	L.F.	467
3 CONDUCTOR (VIDEO)	L.F.	587
1 CONDUCTOR #6 GROUND	L.F.	446
2 CONDUCTOR #6 POWER	L.F.	34
4 CONDUCTOR OPTICOM	L.F.	638
COAX CABLE	L.F.	587
SIGNS		
MR10-12	EA.	4
R3-4	EA.	2
FOUNDATIONS		
CONTROLLER	EA.	1
TYPE 30-A	EA.	4
POLES:		
SIGNAL PEDESTAL	EA.	-
MAST ARM POLE		
W/ 32' ARM	EA.	2
W/ 36' ARM	EA.	2
SIGNAL HEADS:		
4 SECTION 12" LENS	EA.	8
3 SECTION 12" LENS	EA.	6
2 SECTION PEDESTRIAN	EA.	8
INSTALL TUE SUPPLIED		
PEDESTAL POLE & METER	L.S.	1

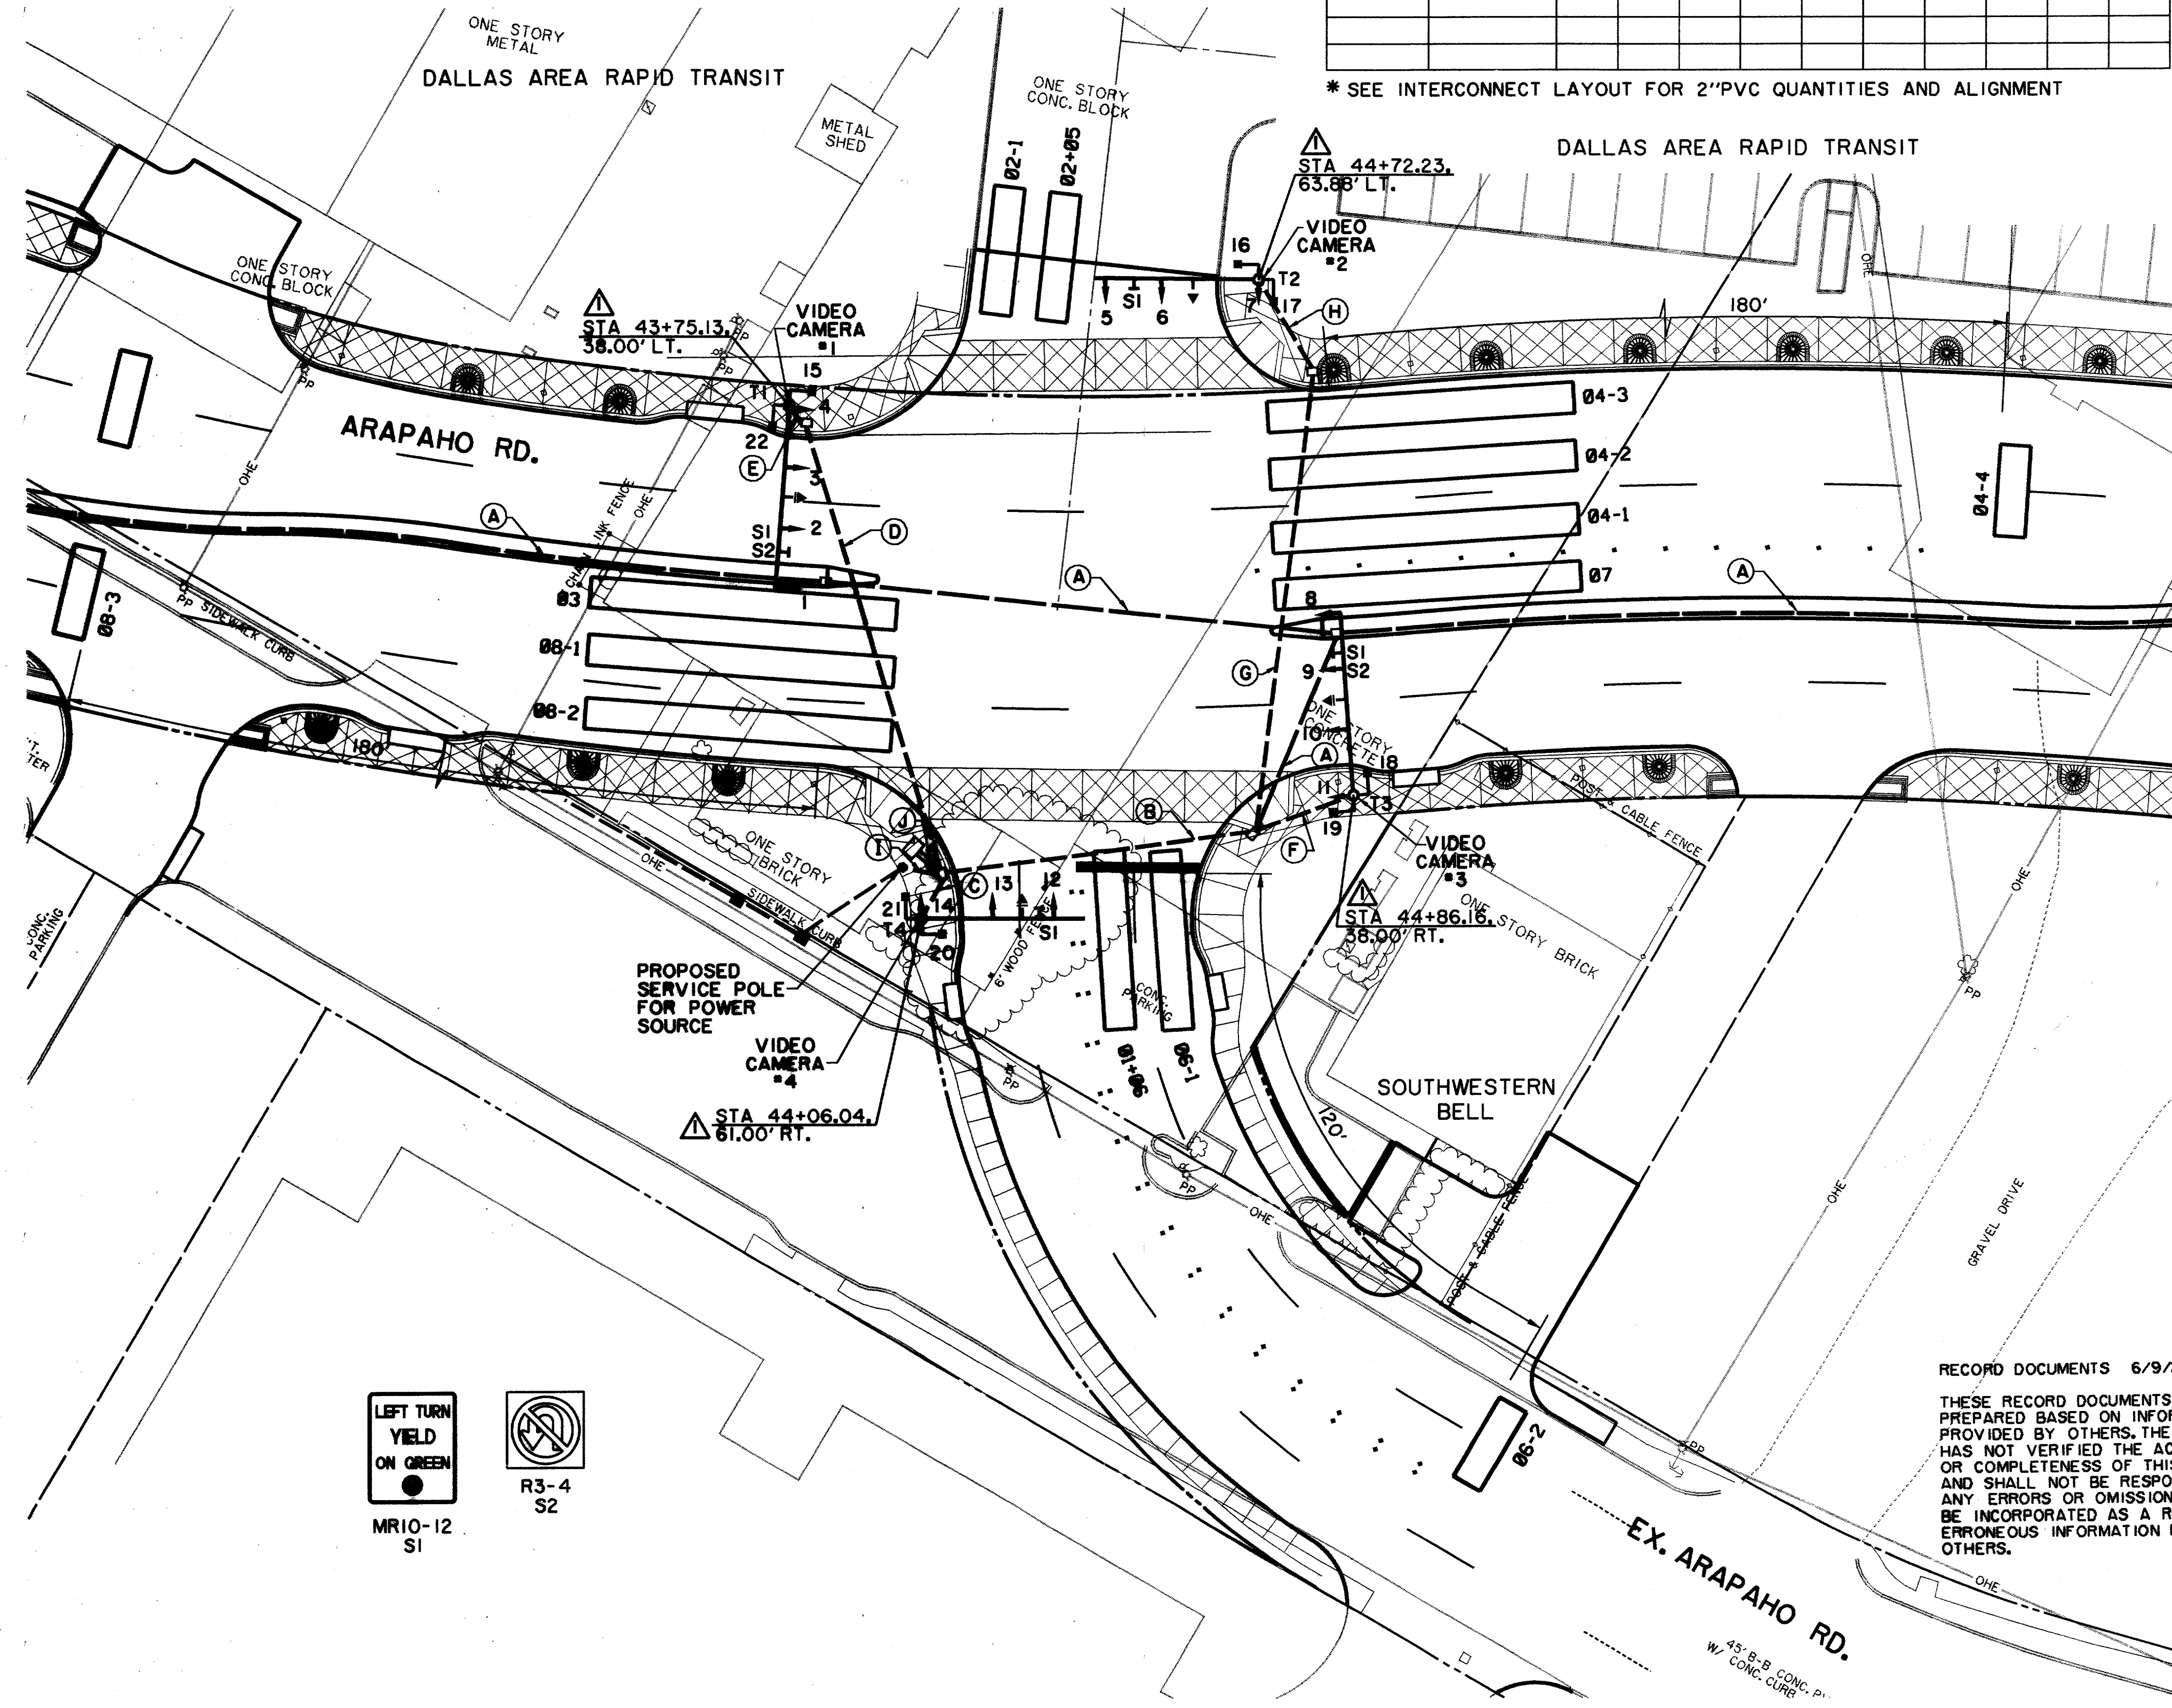

NO	TYPE	PHASE	BACKPLATE		12' VEH SEC	PED SIG SEC
			3 SEC	4 SEC		
1	V4LT	07		1	4	
2	V3	04	1		3	
3	V3	04	1		3	
*4	V4RT	04		1	4	
5	V4LT	01+06		1	4	
6	V3	06	1		3	
*7	V4RT	06		1	4	
8	V4LT	03		1	4	
9	V3	08	1		3	
10	V3	08	1		3	
*11	V4RT	08		1	4	
12	V4LT	02+05		1	4	
13	V3	02	1		3	
*14	V4RT	02		1	4	
15,16	PED	04P				2
17,18	PED	06P				2
19,20	PED	08P				2
21,22	PED	02P				2
TOTALS			6	8	50	8

*FIBER OPTIC SIGNAL

- LEGEND**
- PROPOSED PEDESTRIAN SIGNAL
 - H CONDUIT RUN NUMBER
 - 8 SIGNAL HEAD NUMBER
 - ↓ PROPOSED SIGNAL HEAD
 - PROPOSED SIGNAL CONDUIT
 - PROPOSED PULL BOX
 - EXISTING PULL BOX
 - T3 PROPOSED SIGNAL POLE
 - T LEFT TURN ON ARROW SIGN
 - ↑ OPTICOM
 - DETECTION ZONE FOR VIDEO
 - TUE SWITCHGEAR
 - TUE PEDESTAL POLE & METER



- NOTES:**
- ALL CABLE SHALL BE RUN CONTINUOUSLY WITHOUT SPLICES.
 - SEE INTERCONNECT LAYOUT SHEET FOR 2" PVC RUN A ALIGNMENT AND SUMMARY.
 - CONTRACTOR SHALL CONTACT TU ELECTRIC TO COORDINATE DISCONNECT AND RECONNECT OF EXISTING STREET LIGHT CIRCUIT. CONTRACTOR SHALL INSTALL NEW FOUNDATION, CONDUIT AND CONDUCTOR IF NECESSARY TO RELOCATE SERVICE POLE.
 - VIDEO CAMERAS SHALL BE MOUNTED ON TOP OF SIGNAL POLE AND AIMED IN THE SAME DIRECTION AS SIGNAL HEADS AND ALIGNED TO DETECT ZONES SHOWN ON THIS SHEET.
 - STREET NAME SIGNS WILL BE INSTALLED BY THE TOWN OF ADDISON.
 - TUE WILL PROVIDE PEDESTAL & METER FOR CONTRACTOR TO INSTALL.



RECORD DOCUMENTS 6/9/2000
 THESE RECORD DOCUMENTS HAVE BEEN PREPARED BASED ON INFORMATION PROVIDED BY OTHERS. THE CONSULTANT HAS NOT VERIFIED THE ACCURACY AND/OR COMPLETENESS OF THIS INFORMATION AND SHALL NOT BE RESPONSIBLE FOR ANY ERRORS OR OMISSIONS THAT MAY BE INCORPORATED AS A RESULT OF ERRONEOUS INFORMATION PROVIDED BY OTHERS.

REVISED 3/16/98

SIGNALIZATION PLAN
 ARAPAHO ROAD & EXISTING ARAPAHO ROAD
ARAPAHO ROAD
 ADDISON ROAD TO DALLAS NORTH TOLLWAY
 TOWN OF ADDISON, TEXAS
 Huitt-Zollars, Inc./Consulting Engineers
 Dallas, Fort Worth, Houston, Phoenix, Tustin

DESIGN	DRAWN	APPR.	SCALE	DATE	PROJECT NO.	NO.
HZI	HZI	DLM	1"=20'	OCT 97	1772-01	S-4

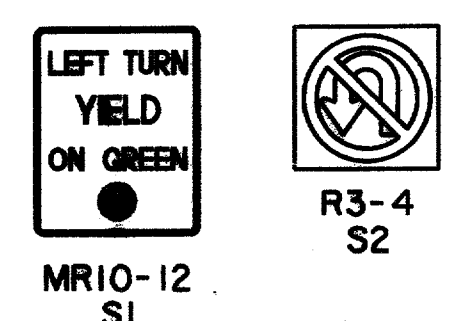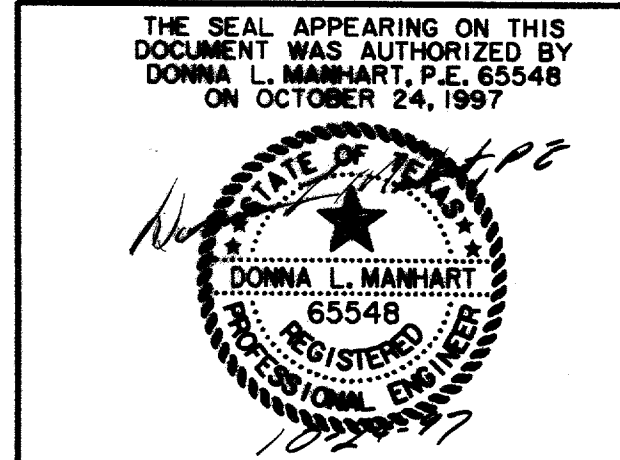

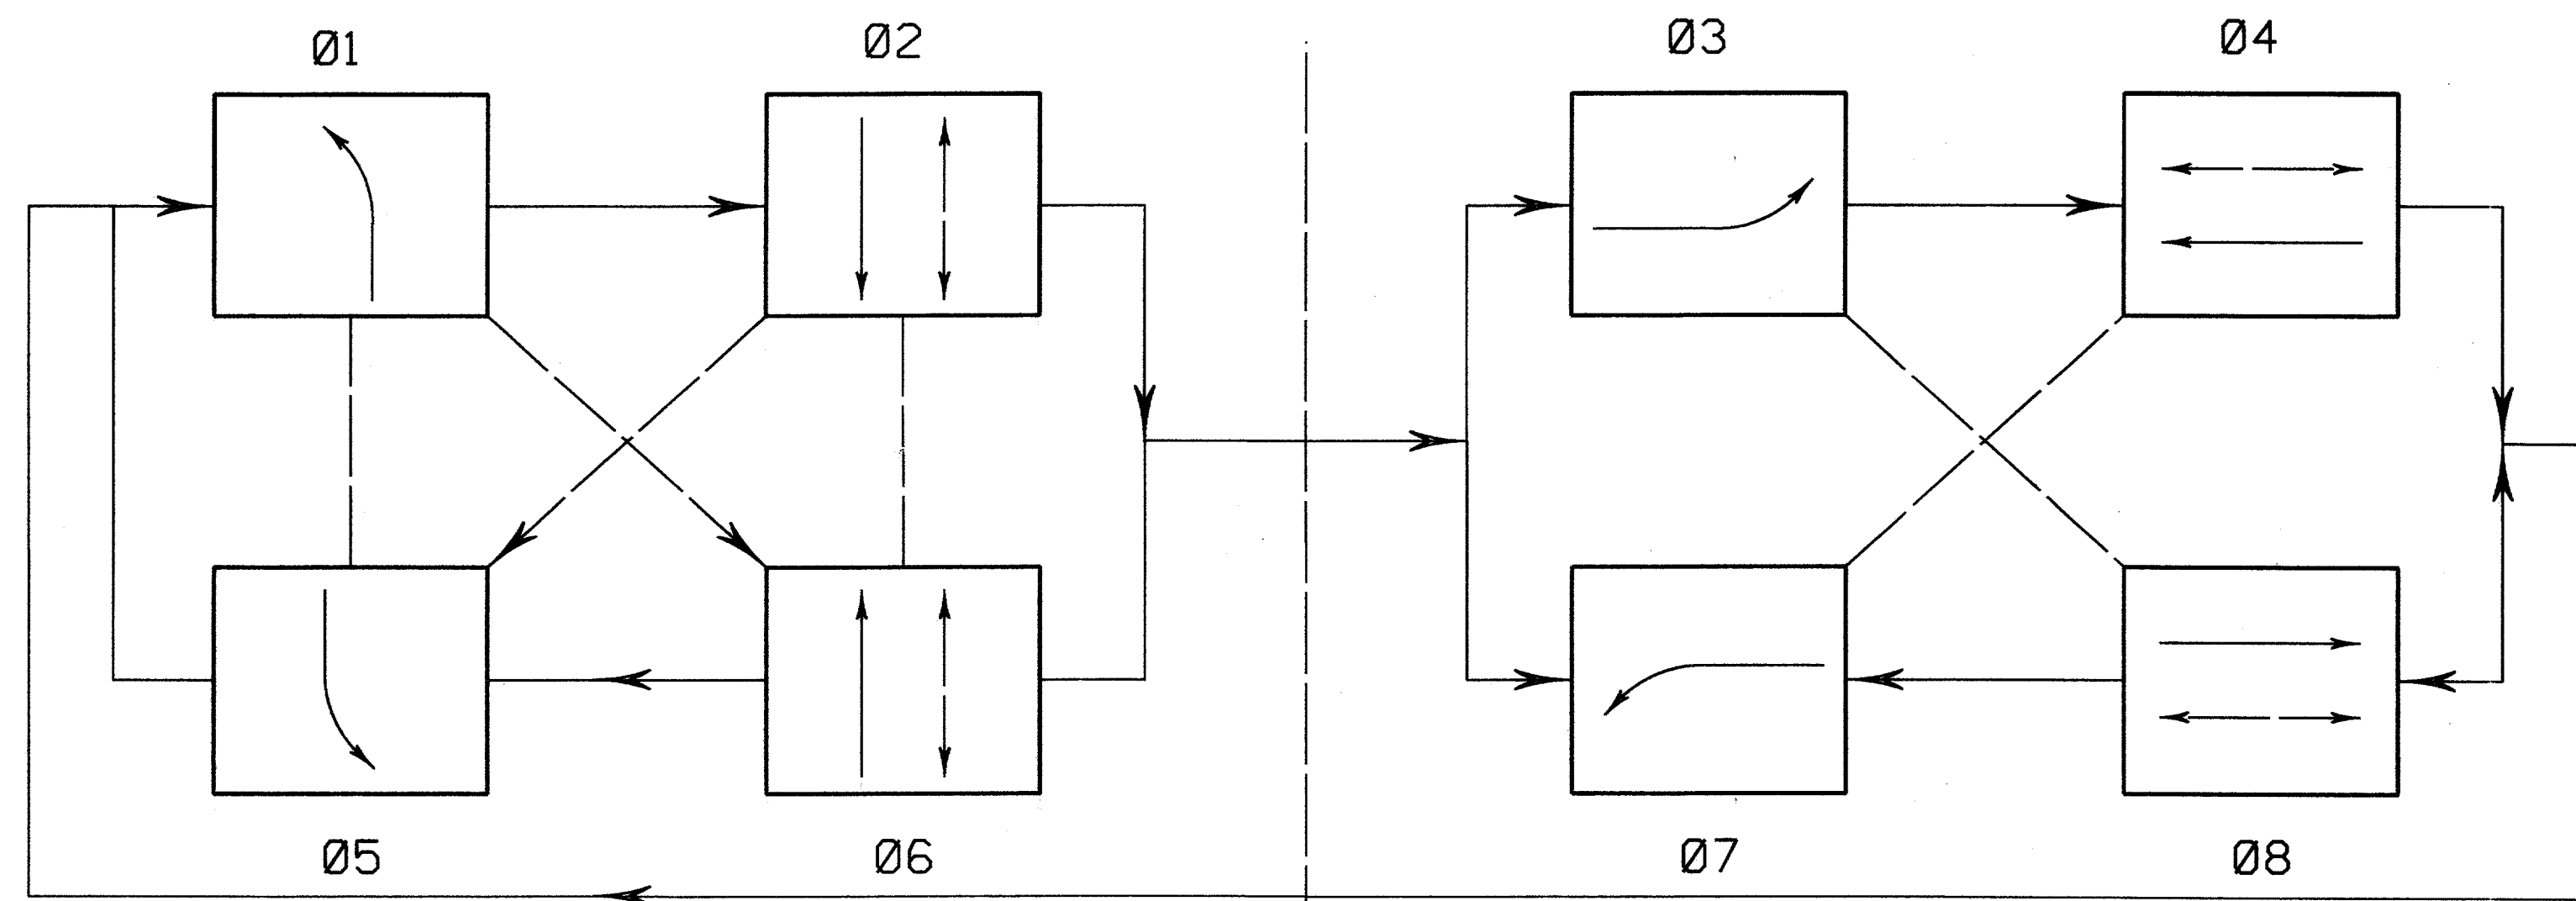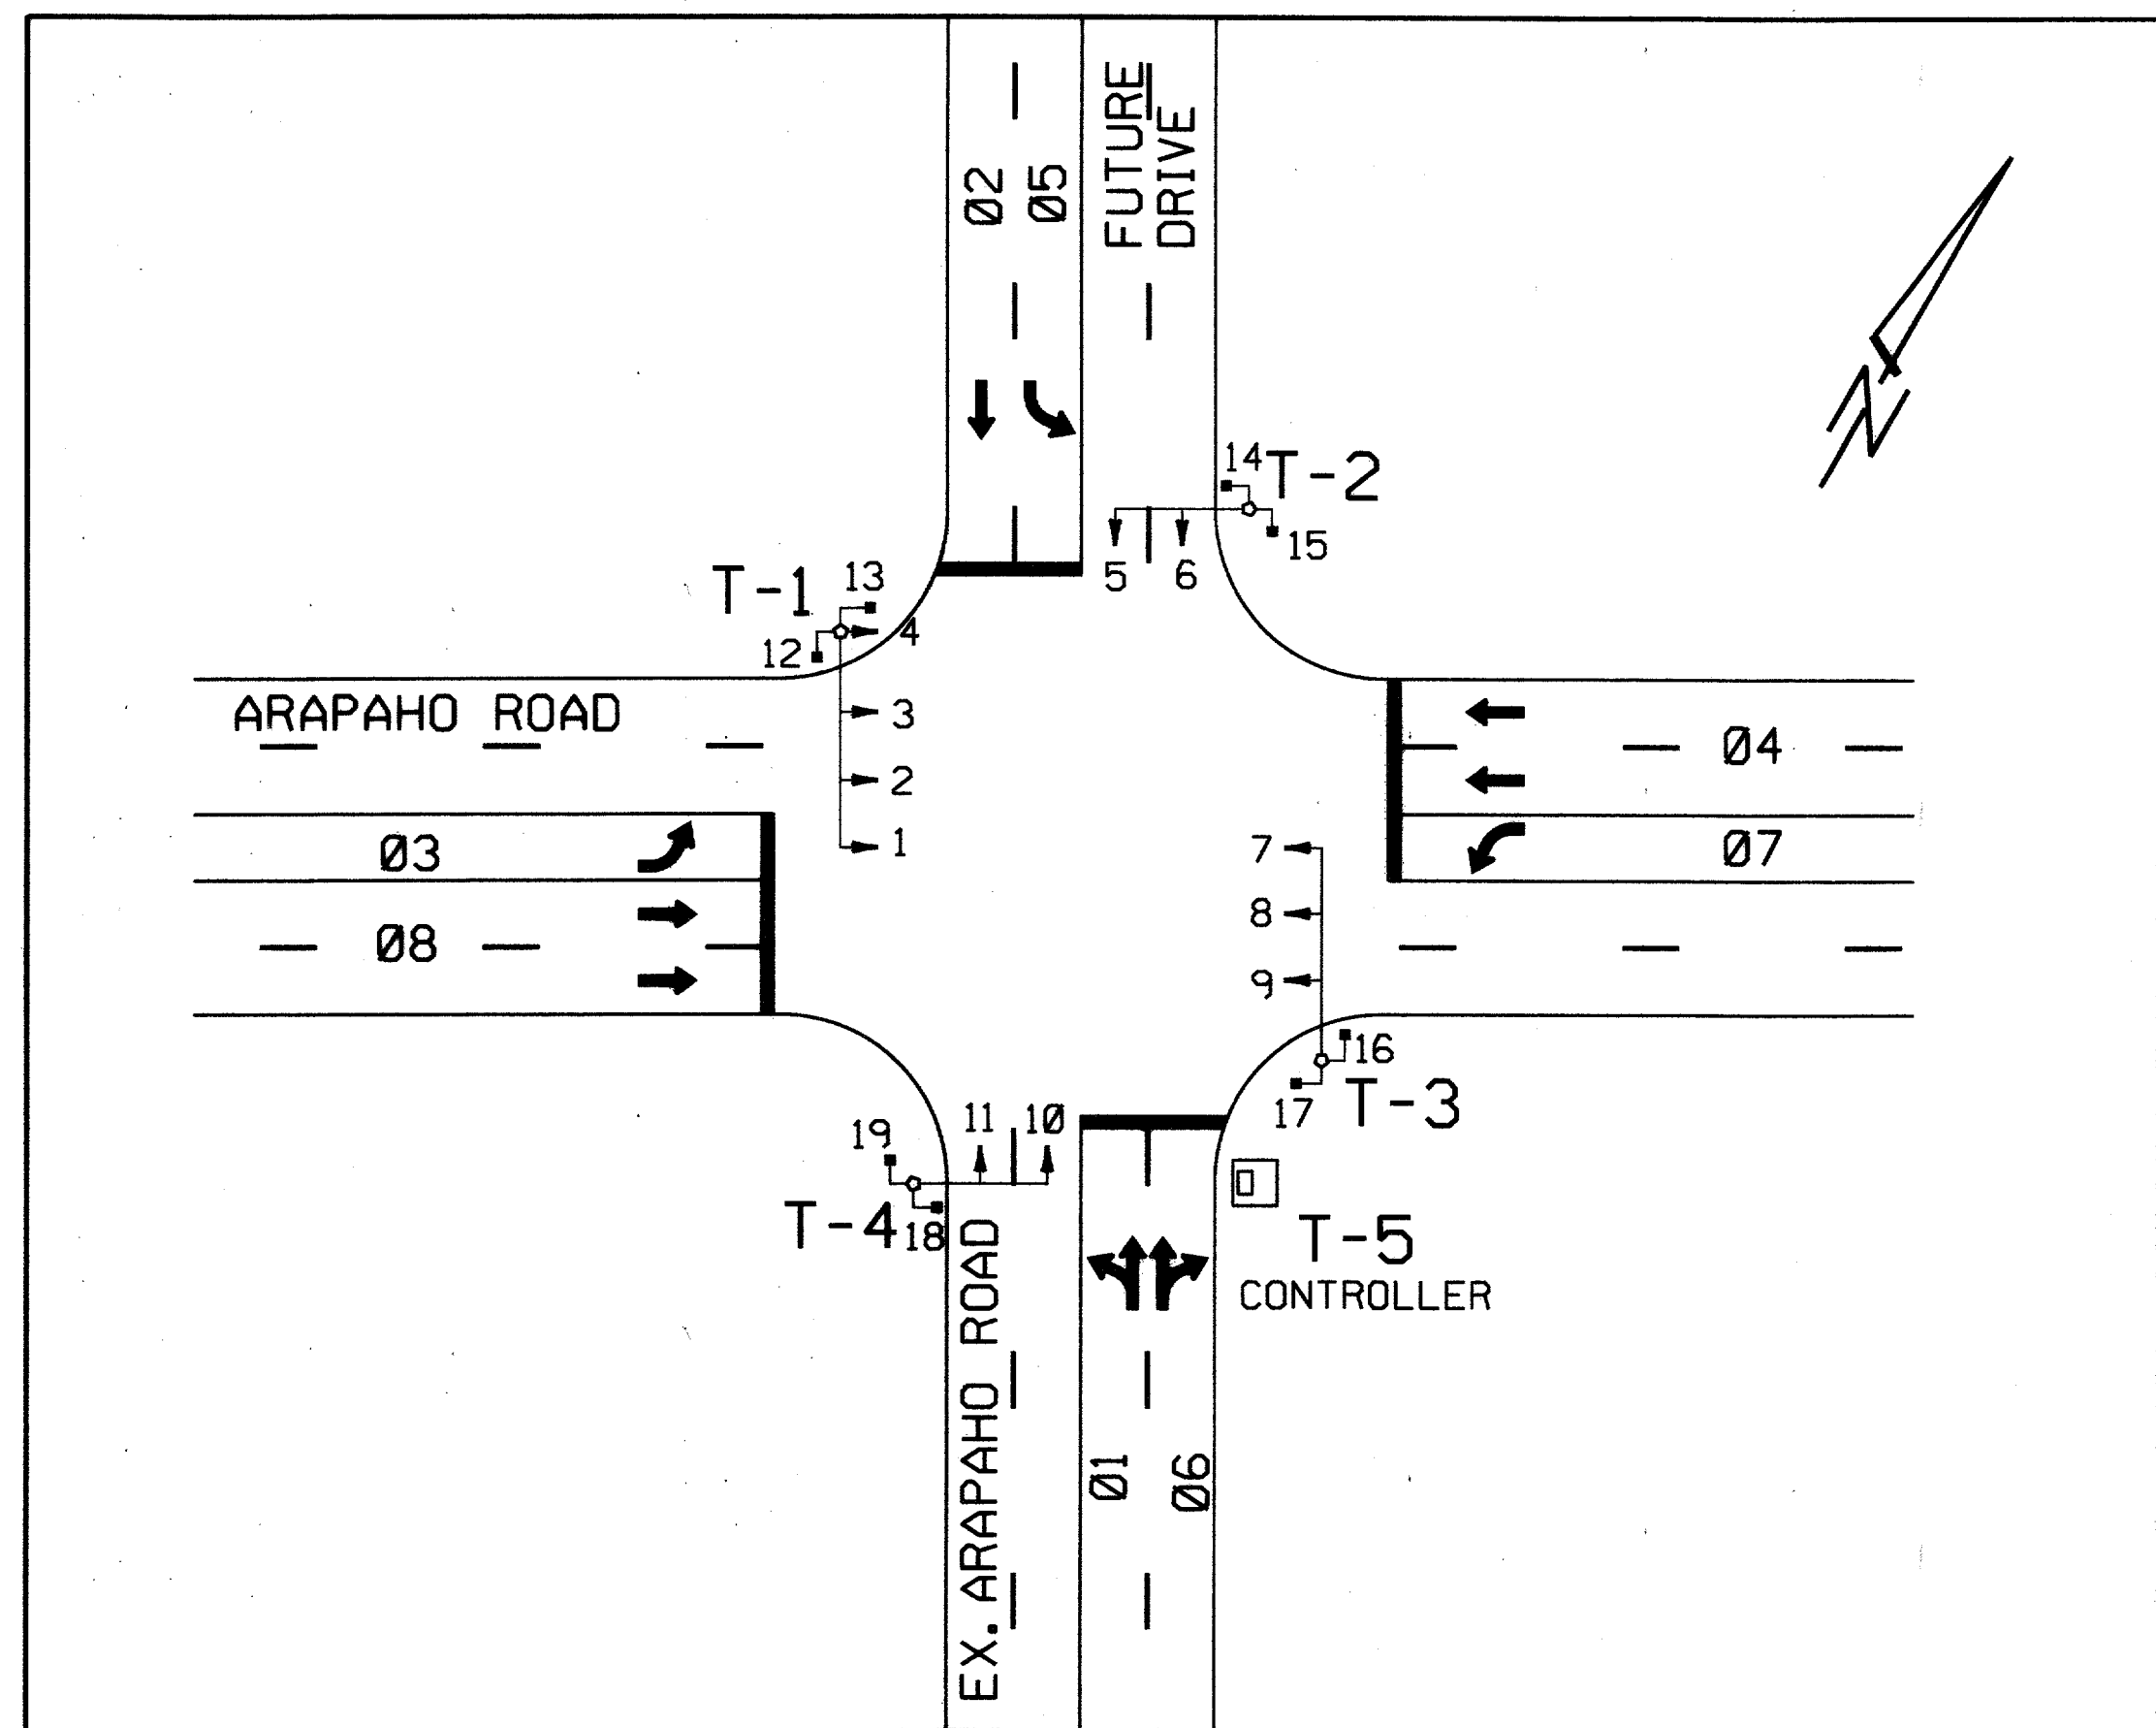


PHASE 2 RIGHT TURN WILL OVERLAP WITH PHASE 7
 PHASE 4 RIGHT TURN WILL OVERLAP WITH PHASE 1
 PHASE 6 RIGHT TURN WILL OVERLAP WITH PHASE 3
 PHASE 8 RIGHT TURN WILL OVERLAP WITH PHASE 5

COMPATIBILITY LINE

SIGNAL FACES

1	2	3	4	5	6	7	8	9	10	11	12	13	14	15	16	17	18	19	20	21	22
R	R	R	R	R	R	R	R	R	R	R	R	R	R	DW	DW	DW	DW	DW	DW	DW	DW
Y	Y	Y	Y	Y	Y	Y	Y	Y	Y	Y	Y	Y	Y	W	W	W	W	W	W	W	W
G	G	G	G	G	G	G	G	G	G	G	G	G	G								
-8				-8						-8											

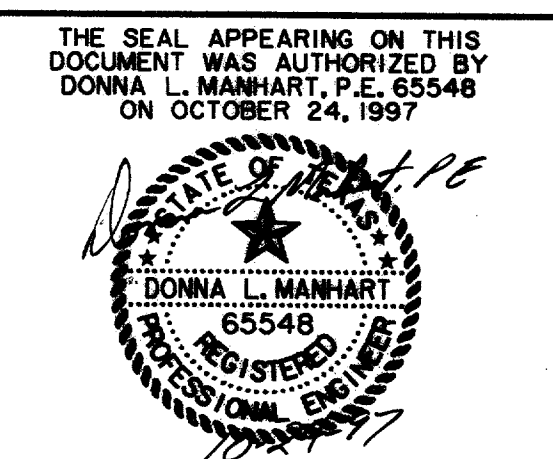

PHASE DIAGRAM
 ARAPAHO ROAD AT EXISTING ARAPAHO ROAD
ARAPAHO ROAD
 ADDISON ROAD TO DALLAS NORTH TOLLWAY
TOWN OF ADDISON, TEXAS
 Huitt-Zollars, Inc./Consulting Engineers
 Dallas, Fort Worth, Houston, Phoenix, Tustin



DESIGN	DRAWN	APPR.	SCALE	DATE	PROJECT NO.	NO.
HZI	HZI	DLM	NTS	OCT 97	1772-01	S-5

RECORD DOCUMENTS 6/9/2000
 THESE RECORD DOCUMENTS HAVE BEEN PREPARED BASED ON INFORMATION PROVIDED BY OTHERS. THE CONSULTANT HAS NOT VERIFIED THE ACCURACY AND/OR COMPLETENESS OF THIS INFORMATION AND SHALL NOT BE RESPONSIBLE FOR ANY ERRORS OR OMISSIONS THAT MAY BE INCORPORATED AS A RESULT OF ERRONEOUS INFORMATION PROVIDED BY OTHERS.

QUANTITIES		
ITEM	UNIT	QTY.
CONDUIT		
1-3" TRENCH	L.F.	269
1-2" TRENCH	L.F.	280
1-4" TRENCH	L.F.	101
PULL BOX	EA.	7
VIDEO CAMERA	EA.	4
3M OPTICOM DETECTOR	EA.	4
PEDESTRIAN PUSH BUTTON		
	EA.	8
CABLE WIRE		
5 CONDUCTOR RR	L.F.	321
7 CONDUCTOR #12	L.F.	307
5 CONDUCTOR #12	L.F.	420
16 CONDUCTOR #12	L.F.	560
COAX CABLE	L.F.	560
1 CONDUCTOR #6 GROUND	L.F.	591
2 CONDUCTOR #6 POWER	L.F.	64
3 CONDUCTOR VIDEO	L.F.	680
4 CONDUCTOR OPTICOM	L.F.	630
SIGNS		
MR10-12	EA.	4
R3-4	EA.	4
FOUNDATIONS		
CONTROLLER	EA.	1
TYPE 30-A	EA.	2
TYPE 30-B	EA.	2
POLES:		
SIGNAL PEDESTAL	EA.	-
MAST ARM POLE	EA.	-
W/ 36' ARM	EA.	2
W/ 40' ARM	EA.	2
SIGNAL HEADS:		
4 SECTION 12" LENS	EA.	8
3 SECTION 12" LENS	EA.	8
2 SECTION PEDESTRIAN	EA.	8
MISCELLANEOUS:		
CONNECT TO RAILROAD GATE CONTROLLER	L.S.	1
INSTALL TUE PEDESTAL & METER	L.S.	1

CONDUIT RUNS									
RUN NO.	SIZE/TYPE CONDUIT	CABLE TYPE						LENGTH OF CONDUIT	FINAL
		2 CND #6 XHHW WIRE POWER	#6 BARE WIRE GROUND	COAX CABLE	4 CNDR. #20 CABLE OPT	16 CNDR. CABLE	3 CNDR. VIDEO		
*A	2" PVC								
B	3" PVC		15	15	15	15	15	9	
C	3" PVC		104	104	104	104	104	98	
D	2-3" PVC	12	36	48	48	48	48	12	6
E	3" PVC	20	20	20	20	20	20	14	
F	3" PVC	20	10	10	10	10		4	
G	2" PVC							176	170
H	2" PVC	16	16					10	
I	2" PVC		80					80	74
J	2" PVC		32					32	26
K	4" PVC		107	214	214	214	214		101
L	3" PVC		24	12	12	12	12		7
M	3" PVC		126	126	126	126			120
N	3" PVC		11	11	11	11			5

* INTERCONNECT
 **SEE INTERCONNECT LAYOUT SHEET FOR INTERCONNECT QUANTITY AND ALIGNMENT

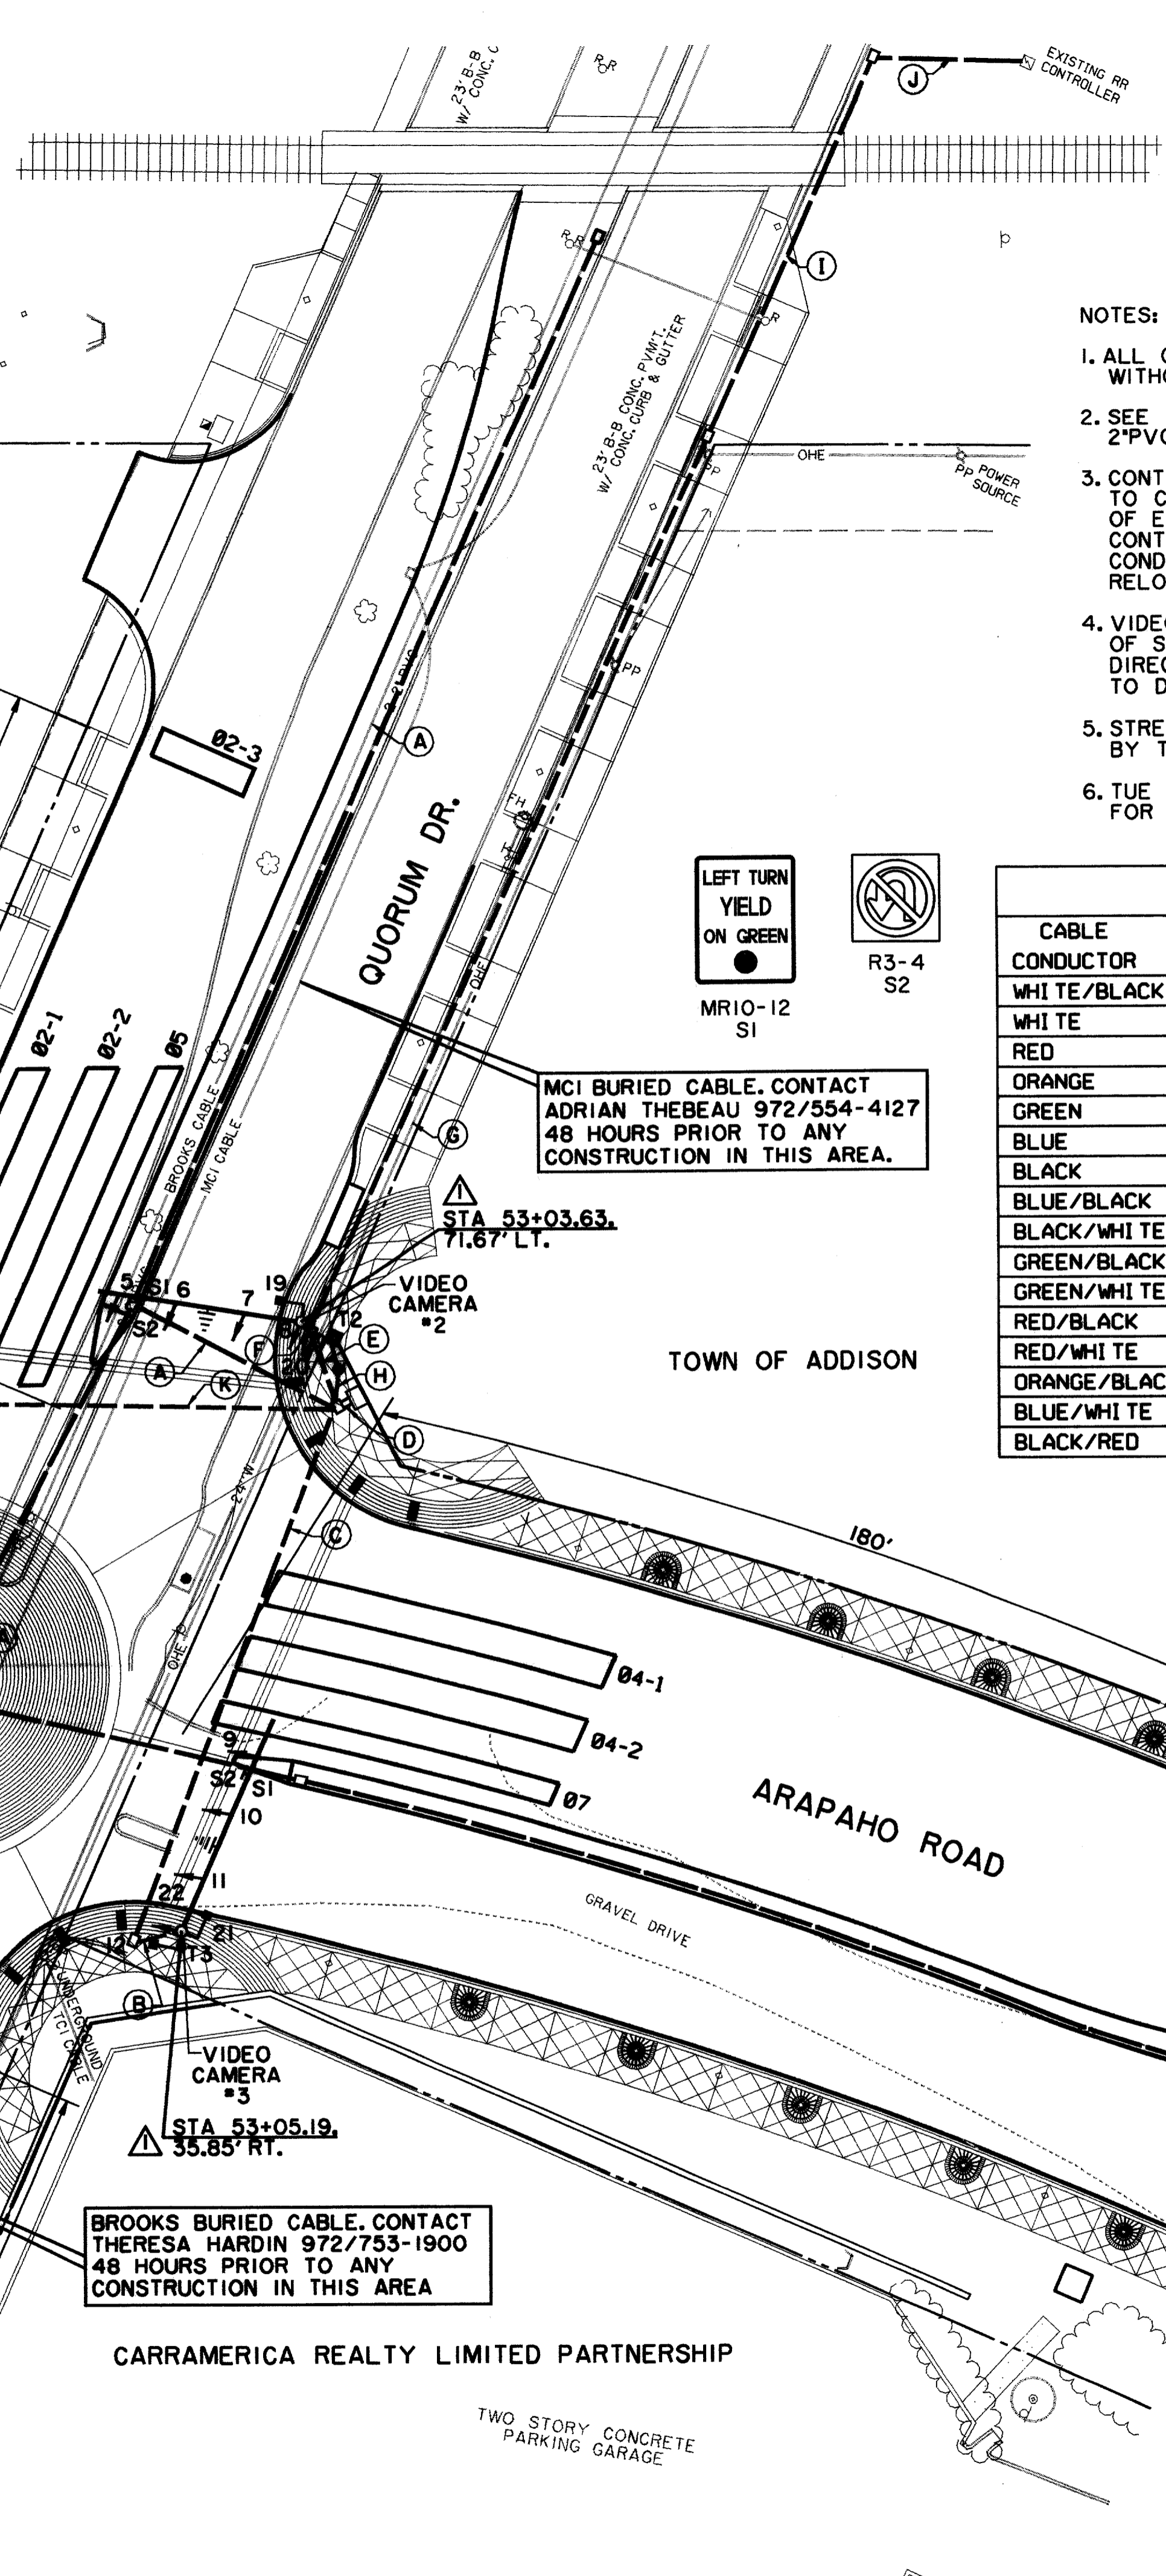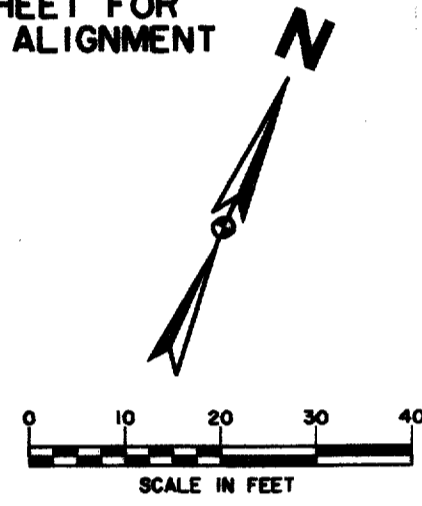


- NOTES:
- ALL CABLE SHALL BE RUN CONTINUOUSLY WITHOUT SPLICES.
 - SEE INTERCONNECT LAYOUT SHEET FOR 2" PVC RUN ALIGNMENT AND SUMMARY.
 - CONTRACTOR SHALL CONTACT TU ELECTRIC TO COORDINATE DISCONNECT AND RECONNECT OF EXISTING STREET LIGHT CIRCUIT. CONTRACTOR SHALL INSTALL NEW FOUNDATION, CONDUIT AND CONDUCTOR IF NECESSARY TO RELOCATE SERVICE POLE.
 - VIDEO CAMERAS SHALL BE MOUNTED ON TOP OF SIGNAL POLE AND AIMED IN THE SAME DIRECTION AS SIGNAL HEADS AND ALIGNED TO DETECT ZONES SHOWN ON THIS SHEET.
 - STREET NAME SIGNS WILL BE INSTALLED BY THE TOWN OF ADDISON.
 - TUE WILL PROVIDE PEDESTAL & METER FOR CONTRACTOR TO INSTALL.

SIGNAL HEADS						
NO	TYPE	PHASE	BACKPLATE		12" VEH SEC	PED SIG SEC
			3 SEC	4 SEC		
1	V4LT	07			4	
2	V3	04			3	
3	V3	04			3	
4	V4RT	04			4	
5	V4LT	01			4	
6	V3	06			3	
7	V3	06			3	
8	V4RT	06			4	
9	V4LT	03			4	
10	V3	08			3	
11	V3	08			3	
12	V4RT	08			4	
13	V4LT	05			4	
14	V3	02			3	
15	V3	02			3	
16	V4RT	02			4	
17,24	PED	02P				2
18,19	PED	04P				2
20,21	PED	06P				2
22,23	PED	08P				2
TOTALS			8	8	56	8

CABLE TERMINATION CHART								
CABLE CONDUCTOR	T-1		T-2		T-3		T-4	
	S. H. NO.	INDICATION	S. H. NO.	INDICATION	S. H. NO.	INDICATION	S. H. NO.	INDICATION
WHITE/BLACK	SPARE		SPARE		SPARE		SPARE	
WHITE	COMMON		COMMON		COMMON		COMMON	
RED	1-4	R	5-8	R	9-12	R	13-16	R
ORANGE	1-4	Y	5-8	Y	9-12	Y	13-16	Y
GREEN	1-4	G	5-8	G	9-12	G	13-16	G
BLUE	1	--G	5	--G	9	--G	3	--G
BLACK	1	--Y	5	--Y	9	--Y	3	--Y
BLUE/BLACK	4	G--	8	G--	12	G--	16	G--
BLACK/WHITE	4	Y--	8	Y--	12	Y--	16	Y--
GREEN/BLACK	17	W	19	W	21	W	23	W
GREEN/WHITE	18	W	20	W	22	W	24	W
RED/BLACK	17	DW	19	DW	21	DW	23	DW
RED/WHITE	18	DW	20	DW	22	DW	24	DW
ORANGE/BLACK	PB17	02	PB19	04	PB21	06	PB23	08
BLUE/WHITE	PB18	04	PB20	06	PB22	08	PB24	02
BLACK/RED	P. B. COM		P. B. COM		P. B. COM		P. B. COM	

- LEGEND
- PROPOSED PEDESTRIAN SIGNAL
 - H CONDUIT RUN NUMBER
 - 8 SIGNAL HEAD NUMBER
 - ↓ PROPOSED SIGNAL HEAD
 - PROPOSED SIGNAL CONDUIT
 - - - - EXISTING SIGNAL CONDUIT
 - FUTURE SIGNAL CONDUIT
 - PROPOSED PULL BOX
 - EXISTING PULL BOX
 - T3 PROPOSED SIGNAL POLE
 - ← LEFT TURN ON ARROW SIGN
 - ≡ OPTICOM
 - ▭ DETECTION ZONE FOR VIDEO
 - TUE SWITCHGEAR
 - TUE PEDESTAL SOURCE & METER

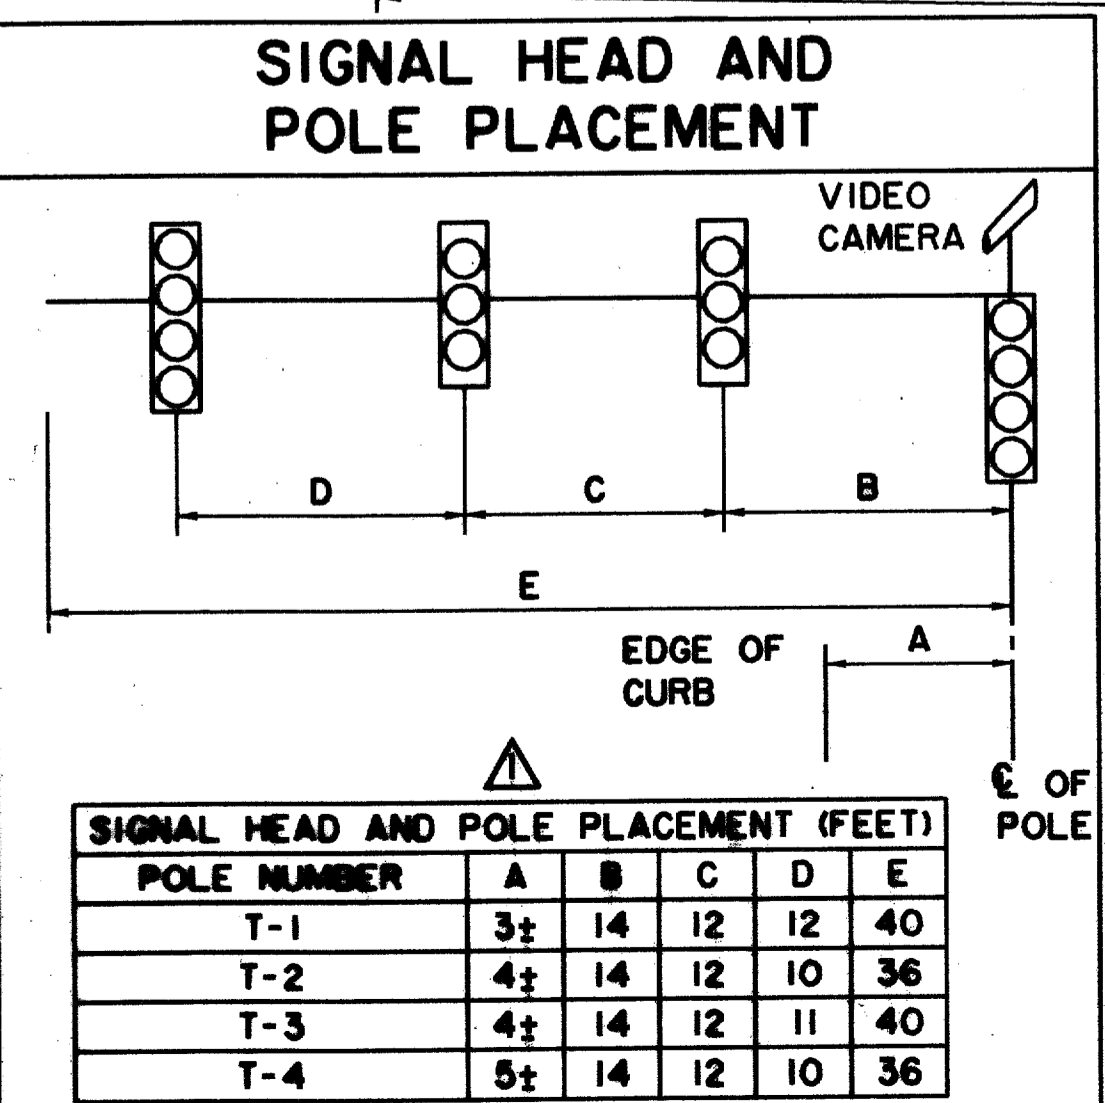

REVISED 3/16/98

THE SEAL APPEARING ON THIS DOCUMENT WAS AUTHORIZED BY DONNA L. MANHART, P.E. 65548 ON OCTOBER 24, 1997


SIGNALIZATION PLAN
ARAPAHO ROAD & QUORUM DRIVE
ARAPAHO ROAD
ADDISON ROAD TO DALLAS NORTH TOLLWAY
TOWN OF ADDISON, TEXAS

Huitt-Zollars, Inc./Consulting Engineers
 Dallas, Fort Worth, Houston, Phoenix, Tustin


DESIGN	DRAWN	APPR.	SCALE	DATE	PROJECT NO.	NO.
HZ1	HZ1	DLM	1"=20'	OCT 97	1772-01	S-6

RECORD DOCUMENTS 6/9/2000

THESE RECORD DOCUMENTS HAVE BEEN PREPARED BASED ON INFORMATION PROVIDED BY OTHERS. THE CONSULTANT HAS NOT VERIFIED THE ACCURACY AND/OR COMPLETENESS OF THIS INFORMATION AND SHALL NOT BE RESPONSIBLE FOR ANY ERRORS OR OMISSIONS THAT MAY BE INCORPORATED AS A RESULT OF ERRONEOUS INFORMATION PROVIDED BY OTHERS.

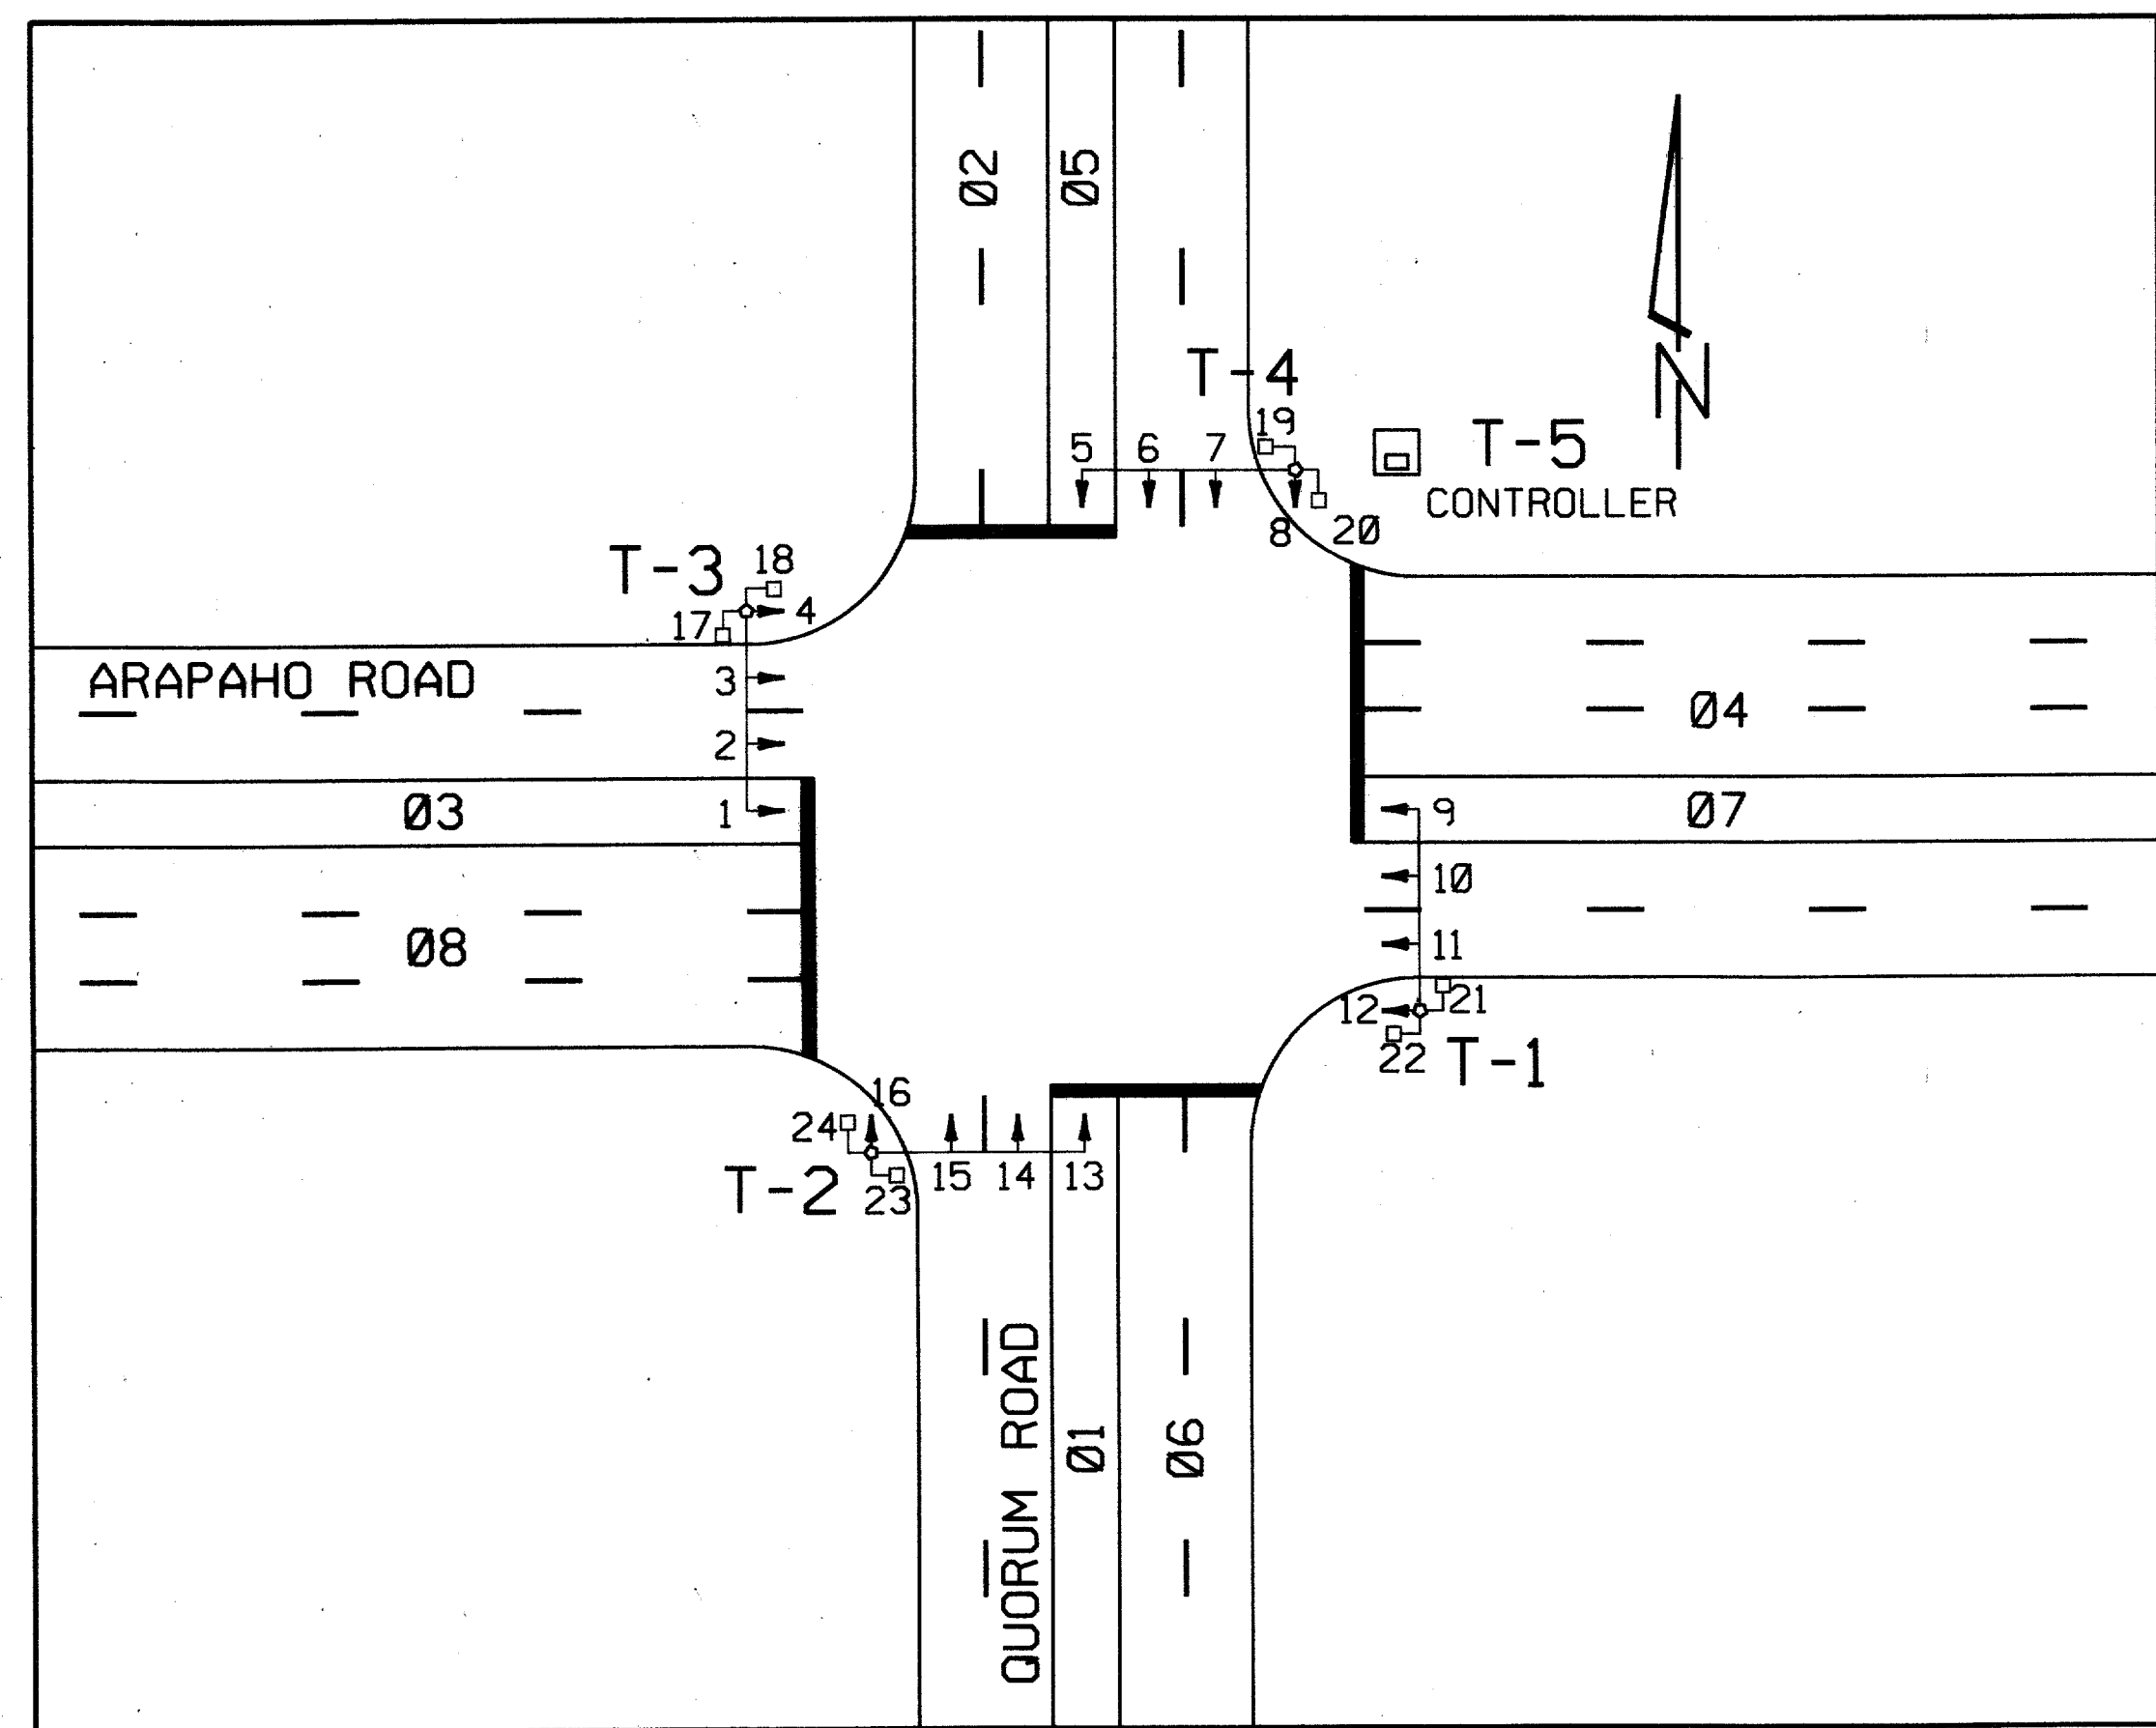


SIGNAL FACES																							
1	2	3	4	5	6	7	8	9	10	11	12	13	14	15	16	17	18	19	20	21	22	23	24
R	R	R	R	R	R	R	R	R	R	R	R	R	R	R	R	R	DW	DW	DW	DW	DW	DW	DW
Y	Y	Y	Y	Y	Y	Y	Y	Y	Y	Y	Y	Y	Y	Y	Y	Y	W	W	W	W	W	W	W
G	G	G	G	G	G	G	G	G	G	G	G	G	G	G	G	G							

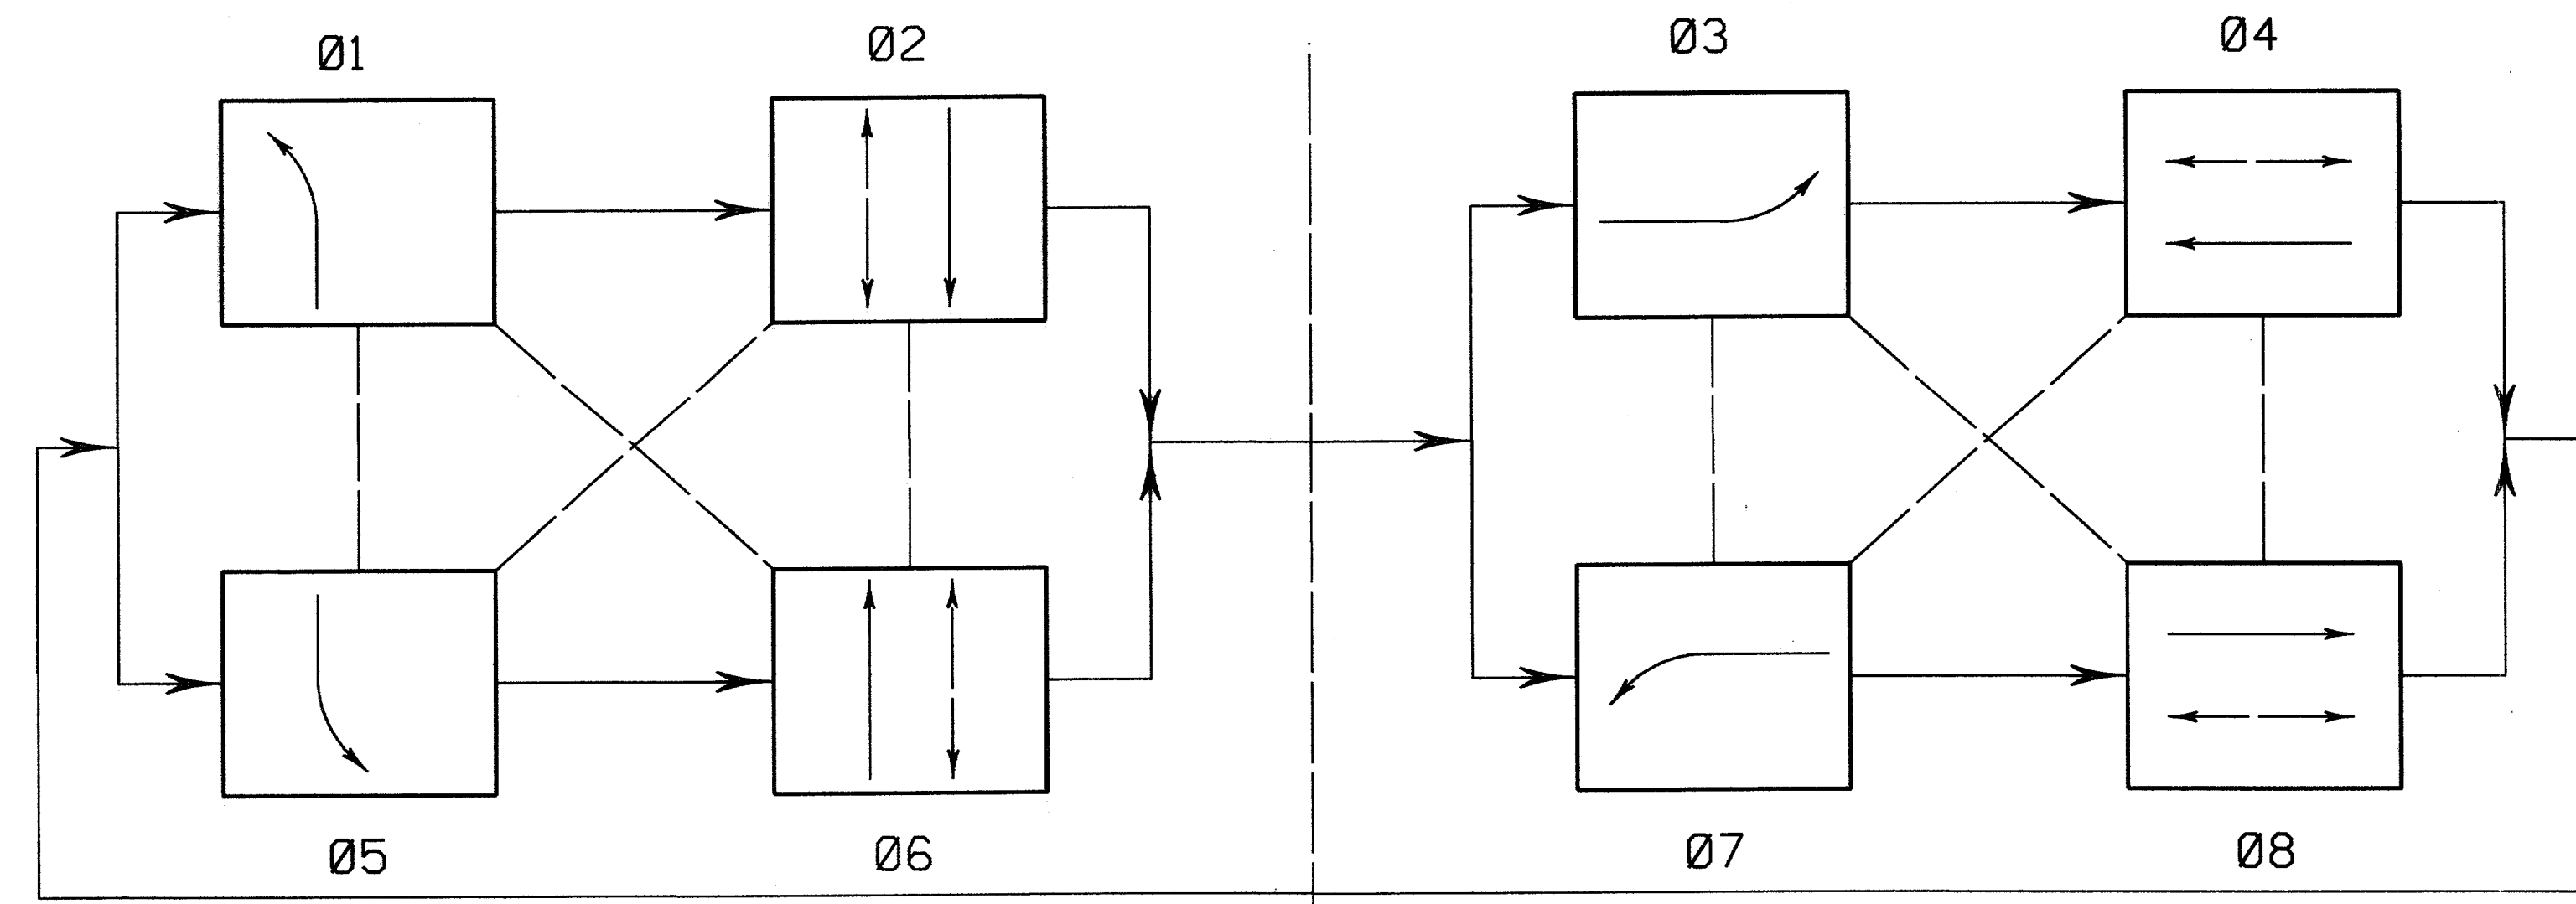


PHASE 2 RIGHT TURN WILL OVERLAP WITH PHASE 7
 PHASE 4 RIGHT TURN WILL OVERLAP WITH PHASE 1
 PHASE 6 RIGHT TURN WILL OVERLAP WITH PHASE 3
 PHASE 8 RIGHT TURN WILL OVERLAP WITH PHASE 5

COMPATIBILITY LINE

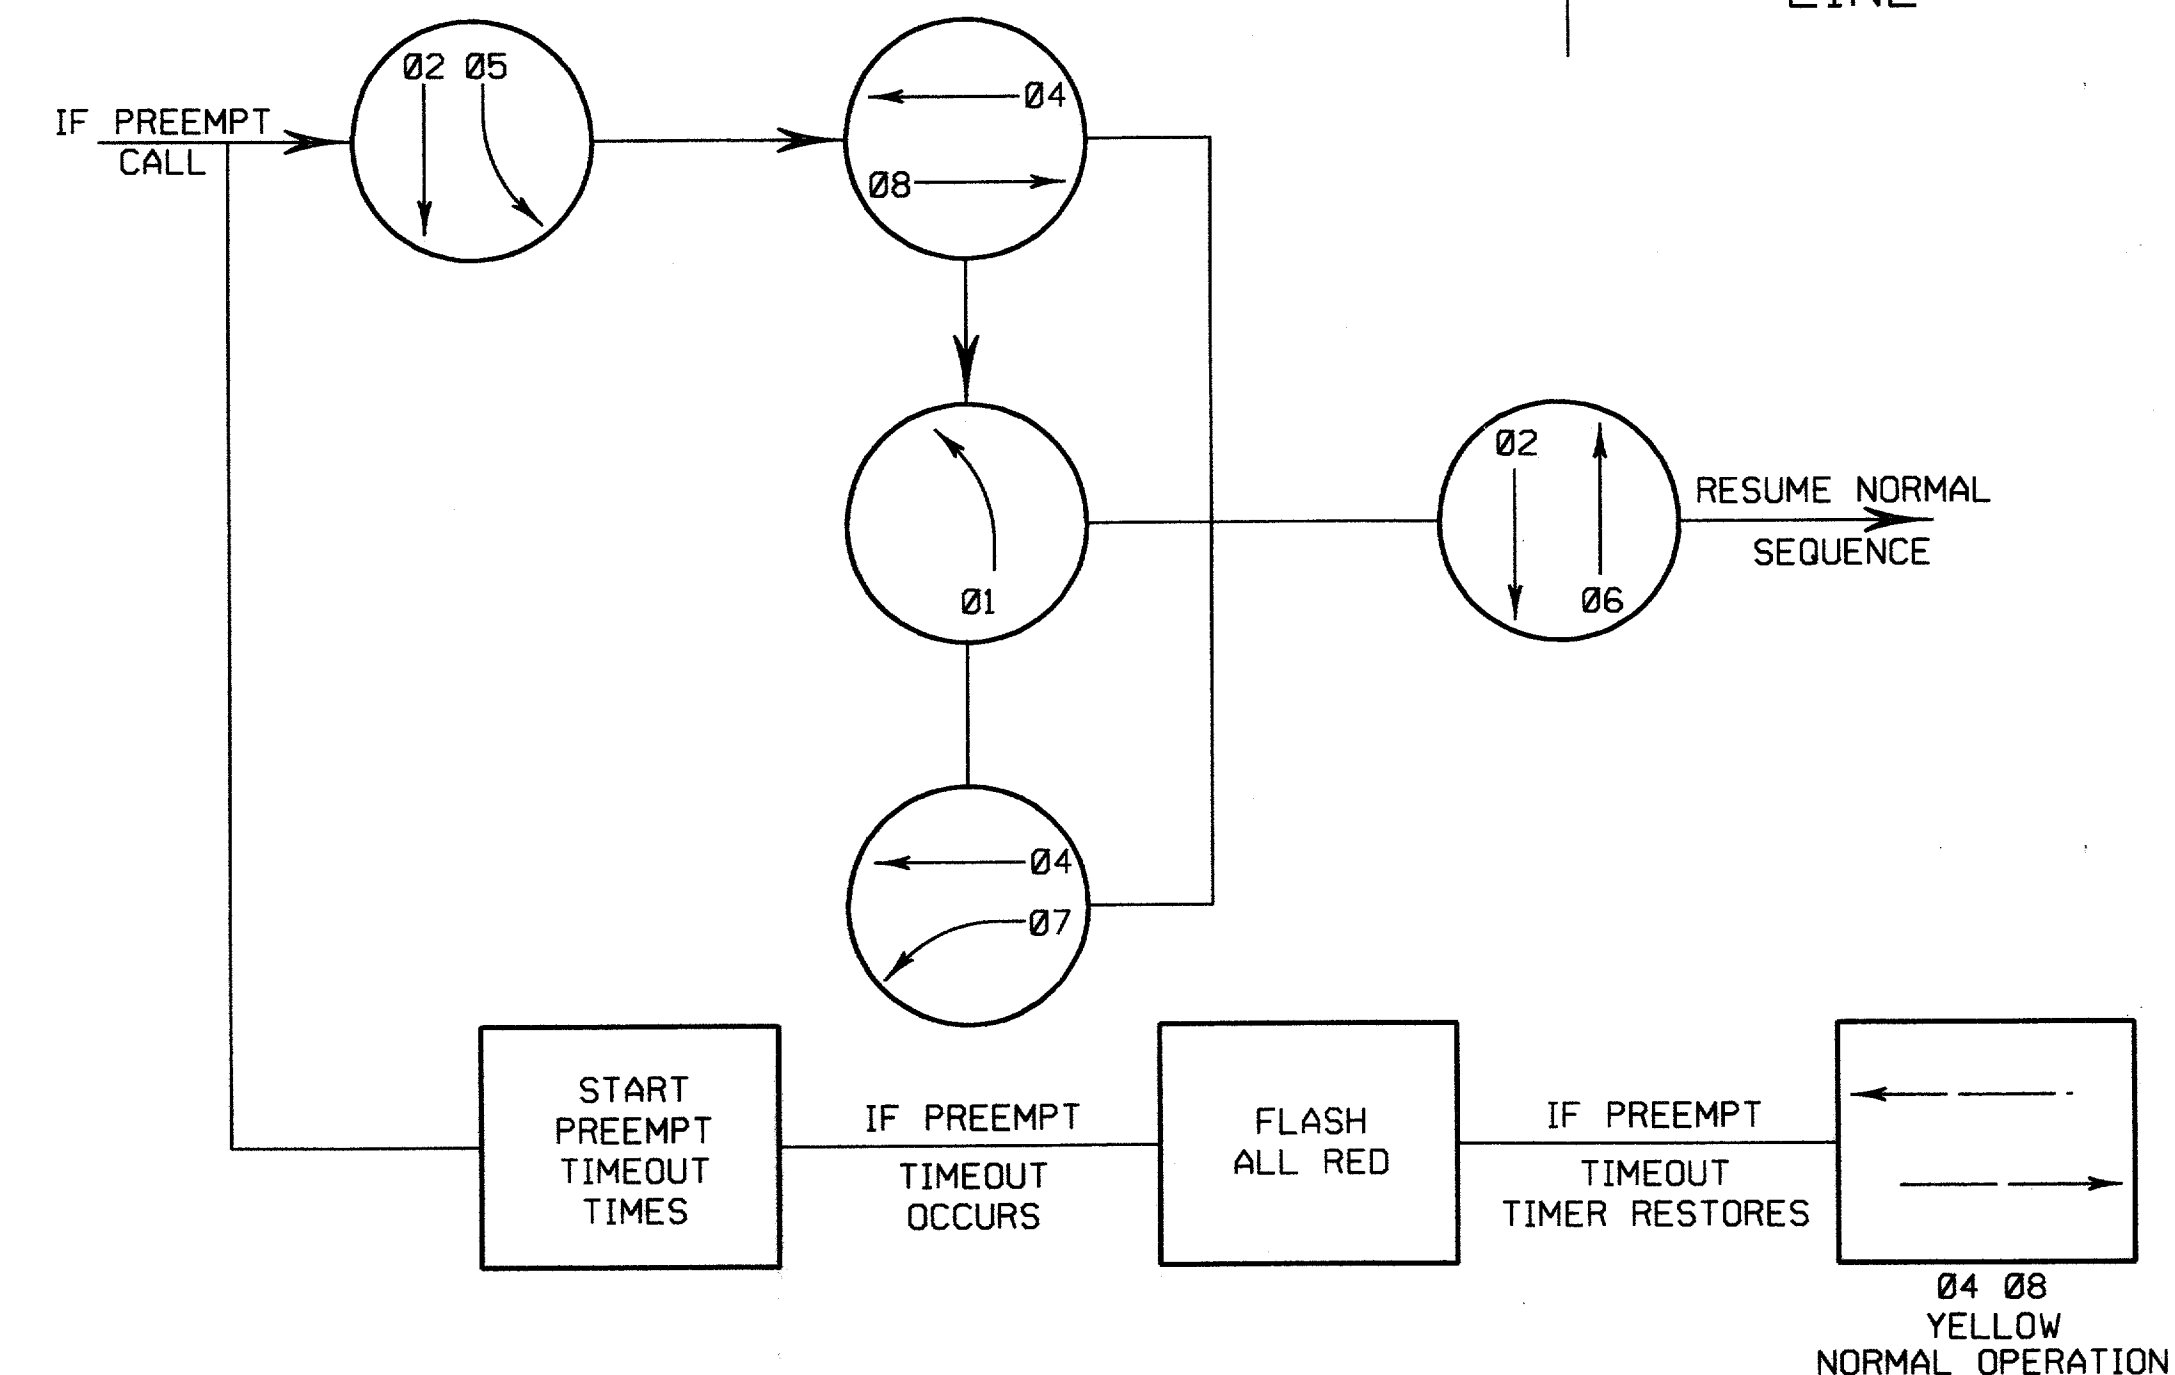


RAILROAD PRE-EMPTION PHASING DIAGRAM

RECORD DOCUMENTS 6/9/2000
 THESE RECORD DOCUMENTS HAVE BEEN PREPARED BASED ON INFORMATION PROVIDED BY OTHERS. THE CONSULTANT HAS NOT VERIFIED THE ACCURACY AND/OR COMPLETENESS OF THIS INFORMATION AND SHALL NOT BE RESPONSIBLE FOR ANY ERRORS OR OMISSIONS THAT MAY BE INCORPORATED AS A RESULT OF ERRONEOUS INFORMATION PROVIDED BY OTHERS.

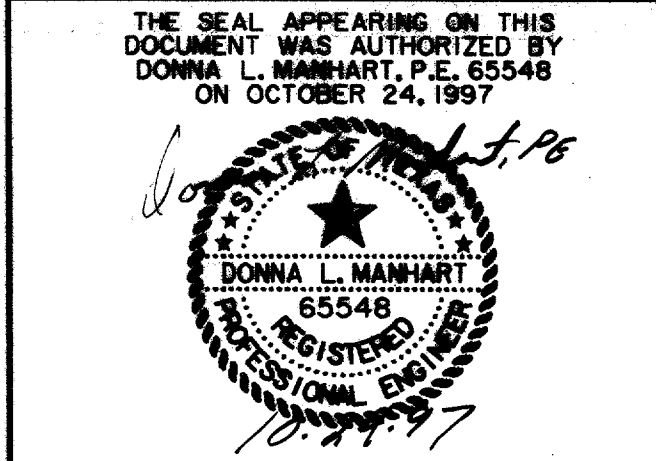


PHASE DIAGRAM ARAPAHO AT QUORUM						
ARAPAHO ROAD						
ADDISON ROAD TO DALLAS NORTH TOLLWAY						
TOWN OF ADDISON, TEXAS						
Huitt-Zollars, Inc./Consulting Engineers Dallas, Fort Worth, Houston, Phoenix, Tustin						
DESIGN	DRAWN	APPR.	SCALE	DATE	PROJECT NO.	NO.
HZI	HZI	DLM	NTS	OCT 97	1772-01	S-7

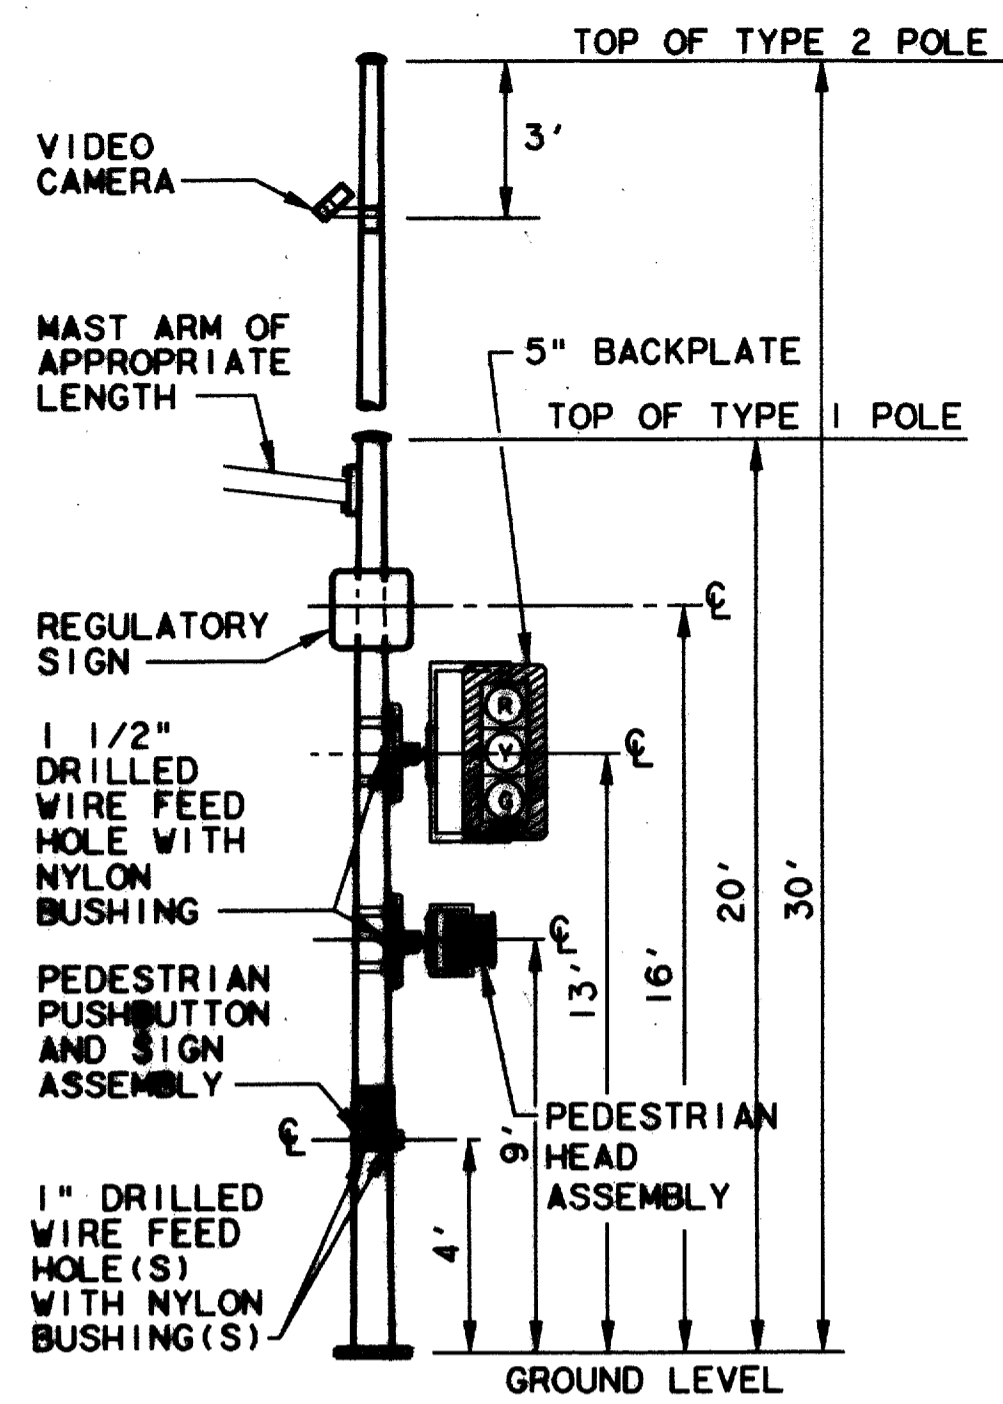




**MAST ARM POLE
(TYPE 1 AND 2)
DETAILS FOR MOUNTING SIGNAL AND
SIGN HARDWARE ON POLES**

GENERAL NOTES





1. ALL WIRE FEED HOLES SHALL BE DRILLED IN THE FIELD BY THE CONTRACTOR. THE USE OF A BLOW TORCH FOR MAKING HOLES WILL NOT BE ALLOWED. COLD GALVANIZING COMPOUND SHALL BE APPLIED TO THE PERIMETER OF ALL DRILLED HOLES, ALLOWING ADEQUATE DRYING TIME BEFORE MOUNTING ANY SIGNAL OR SIGN HARDWARE.
2. 1 1/2" DIAMETER HOLES SHALL BE DRILLED ON THE BOTTOM FACE OF NEW GALVANIZED MAST ARMS WHEN MOUNTING HORIZONTAL SIGNAL HEADS. (WHEN MOUNTING VERTICAL SIGNAL HEADS ON THE MAST ARM, THE HOLES SHALL BE DRILLED ON THE FRONT FACE OF THE ARM.)
3. SIGNAL & SIGN HARDWARE SHALL BE MOUNTED AT THE DISTANCES AND LOCATIONS SHOWN ON THE DIAGRAMS ABOVE UNLESS OTHERWISE INSTRUCTED BY DOT FIELD REPRESENTATIVE.
4. IF THE VEHICLE SIGNAL HEAD IS SKEWED WITH RESPECT TO THE MAST ARM, THE CONTRACTOR MAYBE REQUIRED TO PROVIDE EXTENDED (12") "ASTRO-BRACKET" ARMS SO THAT THE BACKPLATE CLEARS THE MAST ARM.
5. IF THE DISTANCE BETWEEN THE SIDE MOUNT VEHICLE SIGNAL HEAD AND THE MAST ARM POLE IS NOT SUFFICIENT TO INSTALL A BACK PLATE THE CONTRACTOR MAY BE REQUIRED TO PROVIDE EXTENDED (12") "ASTRO-BRACKET" ARMS.
6. A TWO-WAY UNIVERSAL MOUNTING BRACKET SHALL BE USED WHENEVER TWO PEDESTRIAN SIGNAL HEADS ARE TO BE INSTALLED ON THE SAME POLE, AND A ONE-WAY UNIVERSAL MOUNTING BRACKET SHALL BE USED WHENEVER A SINGLE PEDESTRIAN HEAD IS MOUNTED ON A POLE.
7. NYLON BUSHINGS SHALL BE INSTALLED IN ALL WIRE FEED HOLES TO PROTECT THE WIRE INSULATION.
8. POLE MOUNTED SIGNAL HEADS SHALL BE INSTALLED ON THE AWAY-FROM-TRAFFIC SIDE OF THE SIGNAL POLE.
9. ALL SIGNAL HEAD LENSES SHALL BE 12" IN DIAMETER AND POLYCARBONATE, UNLESS OTHERWISE STATED.
10. ALL TRAFFIC SIGNAL AND PEDESTRIAN SIGNAL HEADS SHALL BE BLACK.
11. ALL SIGNAL HEADS WILL HAVE FIBEROPTIC ARROWS.

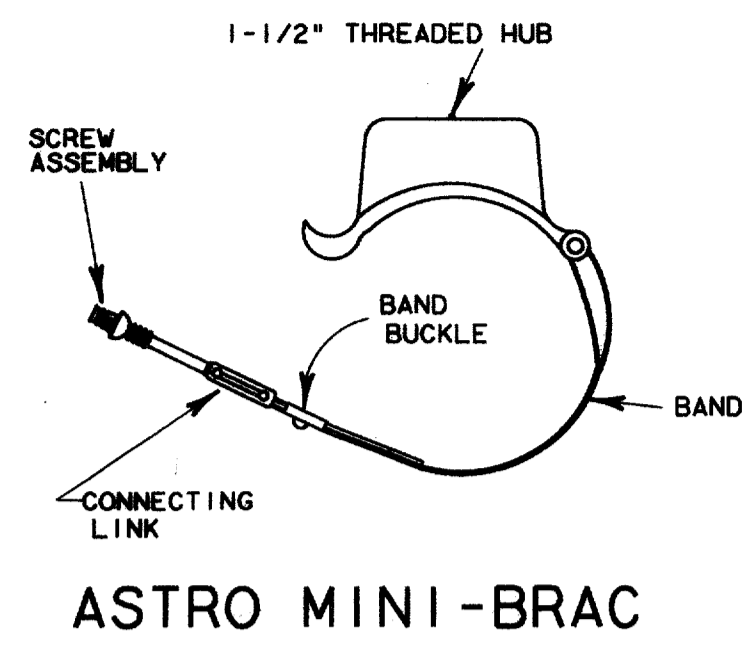

**PEDESTRIAN SIGNAL HEAD MOUNTED
FOR TWO PEDESTRIAN SIGNAL HEADS**

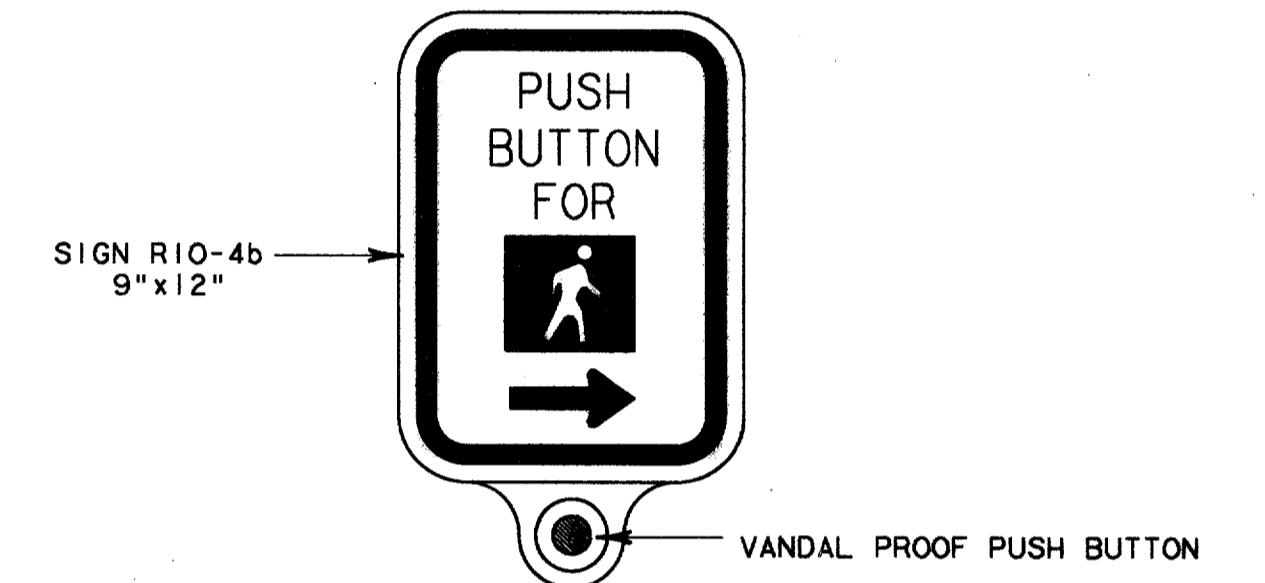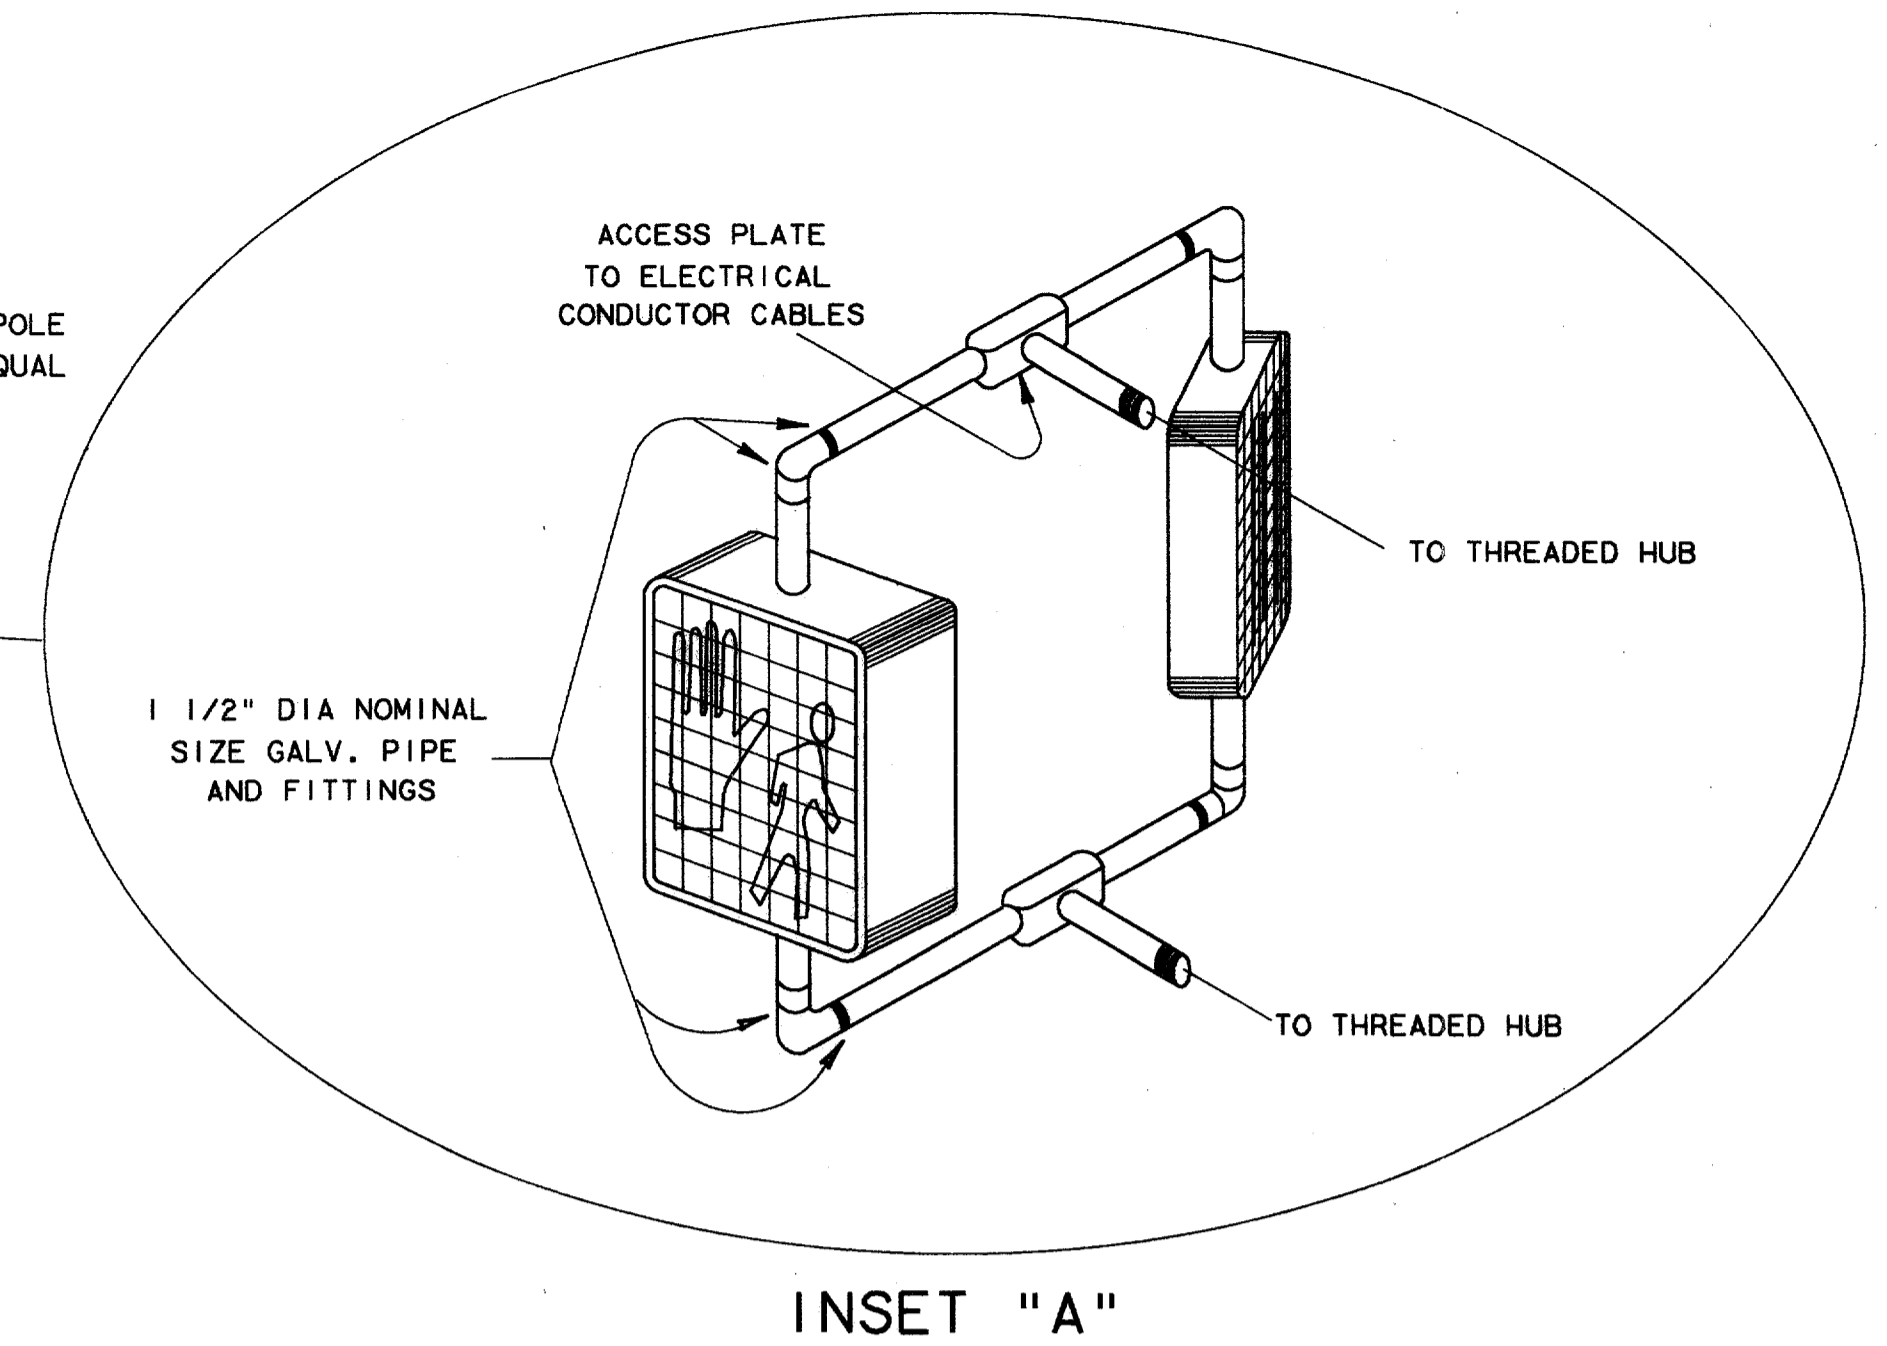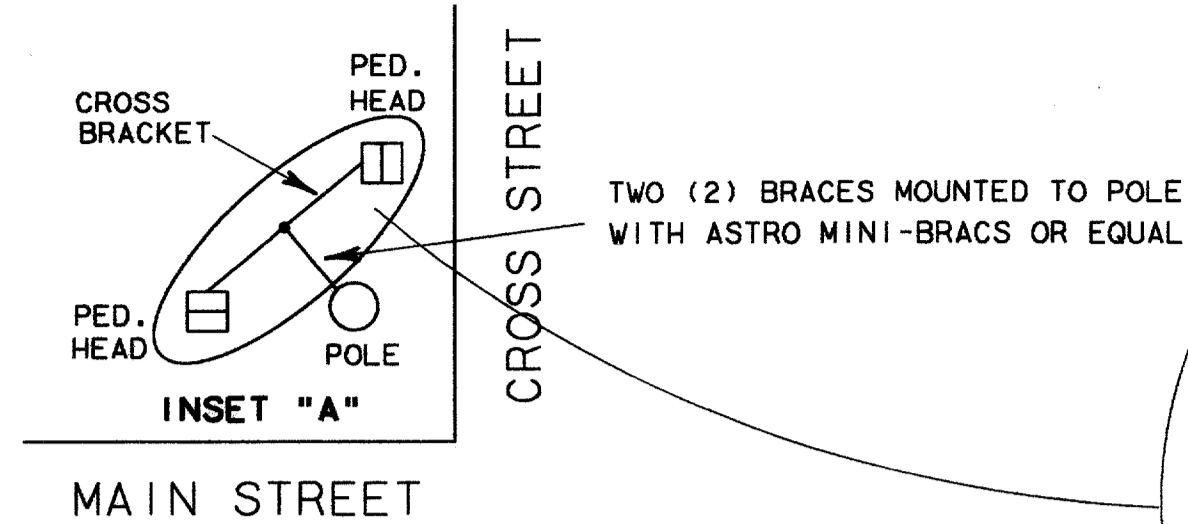

**PEDESTRIAN PUSH BUTTON
WITH INTEGRAL SIGN**

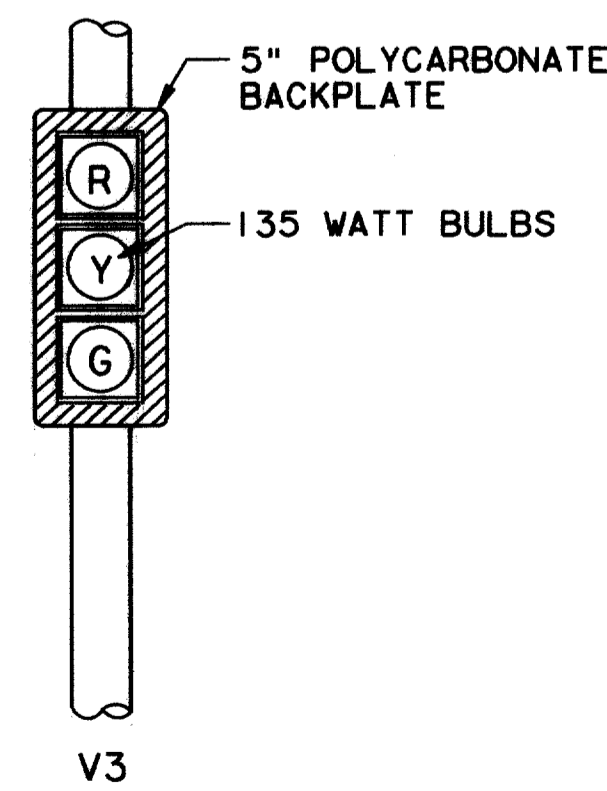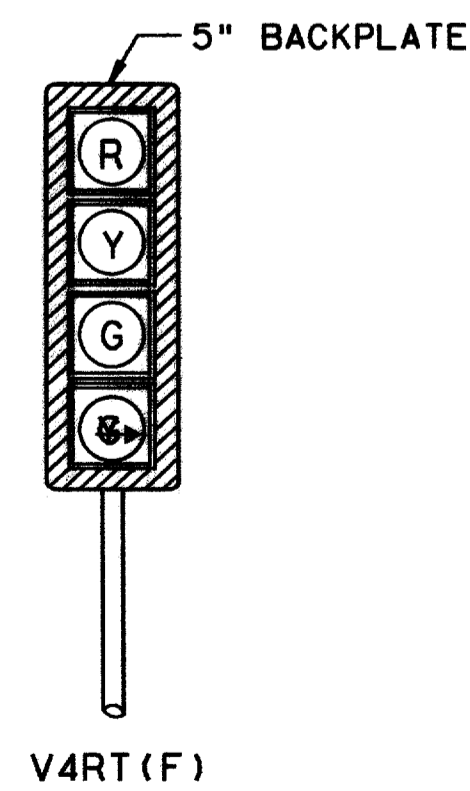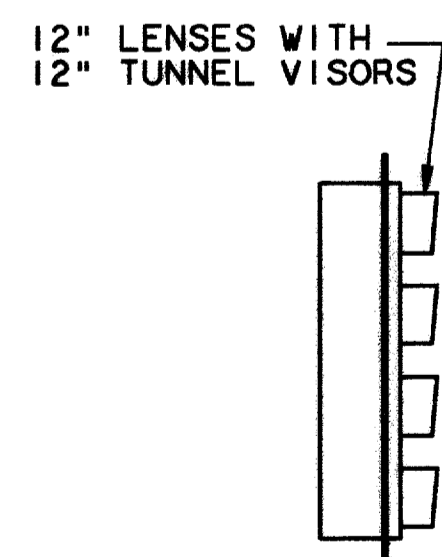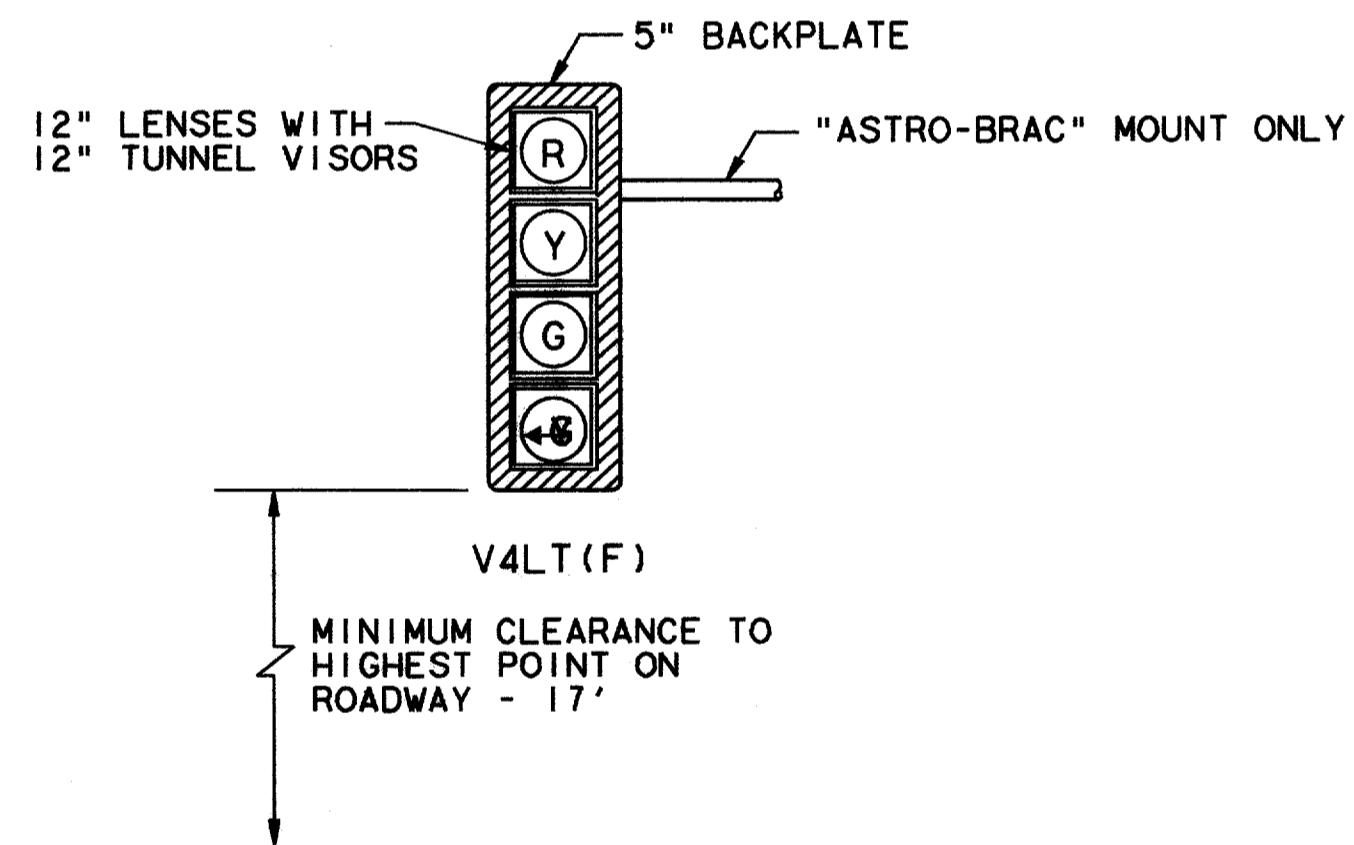


**TYPICAL SIGNAL PEDESTAL
TOP MOUNT -4- LENS HEAD**

NOTES:

1. THE CONTRACTOR SHALL FURNISH AND INSTALL 60 WATT BULBS FOR PEDESTRIAN SIGNAL HEADS.
2. FOR THIS PROJECT THE PEDESTRIAN SIGNAL HEAD AND PUSH BUTTON WILL BE MOUNTED ON THE SIGNAL POLE AS SHOWN ON THE "DETAIL OF SIGNAL POLE & MAST ARM".
3. ALL PEDESTRIAN SIGNAL HEADS SHALL BE INSTALLED ON THE AWAY-FROM-TRAFFIC SIDE OF THE PEDESTRIAN OR SIGNAL POLE.
4. ALL WIRING FOR PEDESTRIAN SIGNALS SHALL BE TOTALLY ENCLOSED WITHIN THE SIGNAL MOUNTING HARDWARE.
5. ALL PEDESTRIAN SIGNAL HEADS AND PUSH BUTTON SIGNALS SHALL DISPLAY THE SYMBOLIZED MESSAGE SHOWN ABOVE. (ADA APPROVED)
6. SYMBOLIZED MESSAGE HEIGHT SHALL BE 10 INCHES MINIMUM ON PEDESTRIAN SIGNAL HEADS.
7. V4 TURN SIGNALS SHALL HAVE FIBEROPTIC ARROWS


THE SEAL APPEARING ON THIS DOCUMENT WAS AUTHORIZED BY DONNA L. MANHART, P.E. 65548 ON OCTOBER 24, 1997

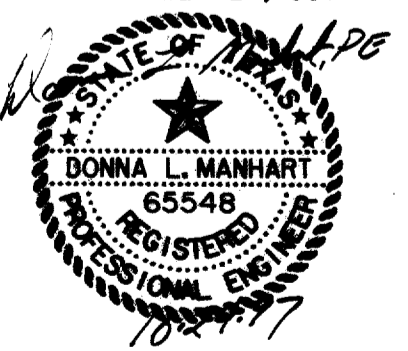


TRAFFIC SIGNAL POLES, ARMS, & HEADS DETAILS AND ELEVATIONS						
ARAPAHO ROAD						
ADDISON ROAD TO DALLAS NORTH TOLLWAY						
TOWN OF ADDISON, TEXAS						
Huiji-Zollars, Inc./Consulting Engineers Dallas, Fort Worth, Houston, Phoenix, Tustin						
DESIGN	DRAWN	APPR.	SCALE	DATE	PROJECT NO.	NO.
HZI	HZI	DLM	NTS	OCT 97	1772-01	S-8

RECORD DOCUMENTS 6/9/2000

THESE RECORD DOCUMENTS HAVE BEEN PREPARED BASED ON INFORMATION PROVIDED BY OTHERS. THE CONSULTANT HAS NOT VERIFIED THE ACCURACY AND/OR COMPLETENESS OF THIS INFORMATION AND SHALL NOT BE RESPONSIBLE FOR ANY ERRORS OR OMISSIONS THAT MAY BE INCORPORATED AS A RESULT OF ERRONEOUS INFORMATION PROVIDED BY OTHERS.

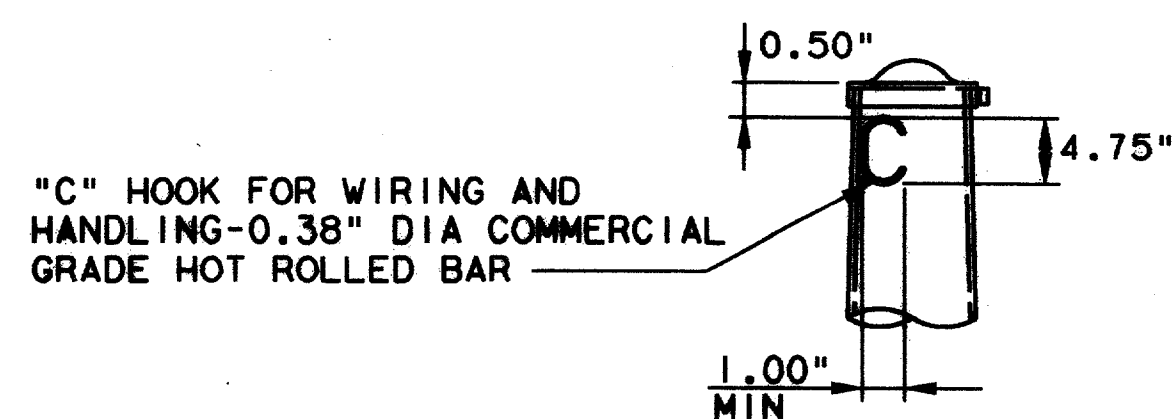

POLE TOP
NO SCALE

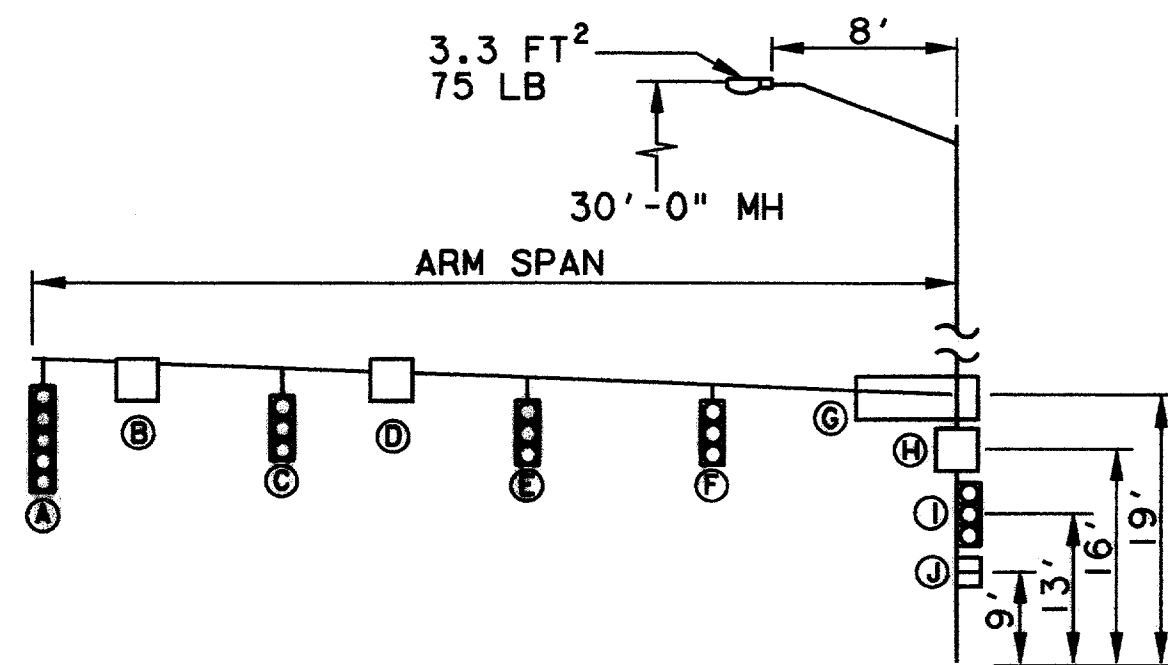


ARM SPAN	DISTANCE FROM POLE TO DEVICE (FT)						
	A	B	C	D	E	F	G
20	19	14	N.A.	N.A.	N.A.	N.A.	2
24	23	18	11	N.A.	N.A.	N.A.	2
28	27	22	15	N.A.	N.A.	N.A.	2
32	31	26	16	N.A.	N.A.	N.A.	2
36	35	24	23	12	N.A.	N.A.	2
40	39	34	26	13	N.A.	N.A.	2
44	43	28	28	20	12	N.A.	2
48	47	42	34	28	23	10	2

N.A. = NOT APPLICABLE

ALL STRUCTURES ARE DESIGNED TO THE 1985 (80 MPH) TXDOT STANDARD SPECIFICATIONS FOR STRUCTURAL SUPPORTS FOR SIGNS, LUMINAIRES, AND TRAFFIC SIGNALS.

DEVICE	DESCRIPTION	PROJ AREA (FT²)	WEIGHT (LBS)
(A) SIGNAL	12"-5 SEC WITH BACKPLATES	13.33	55
(B & D) SIGN	REGULATORY 30"x30"	6.25	15
(C & E) SIGNAL	12"-3 SEC WITH BACKPLATES	8.67	40
(G) SIGN	STREET NAME 24"x96"	16.00	50
(H) SIGN	REGULATORY 24"x24"	4.00	10
(I) SIGNAL	DUAL-12"-3 SEC WITH BACKPLATES	17.34	80
(J) SIGNAL	DUAL-PEDESTRIAN SIGNAL	8.00	60

LOADING INFORMATION

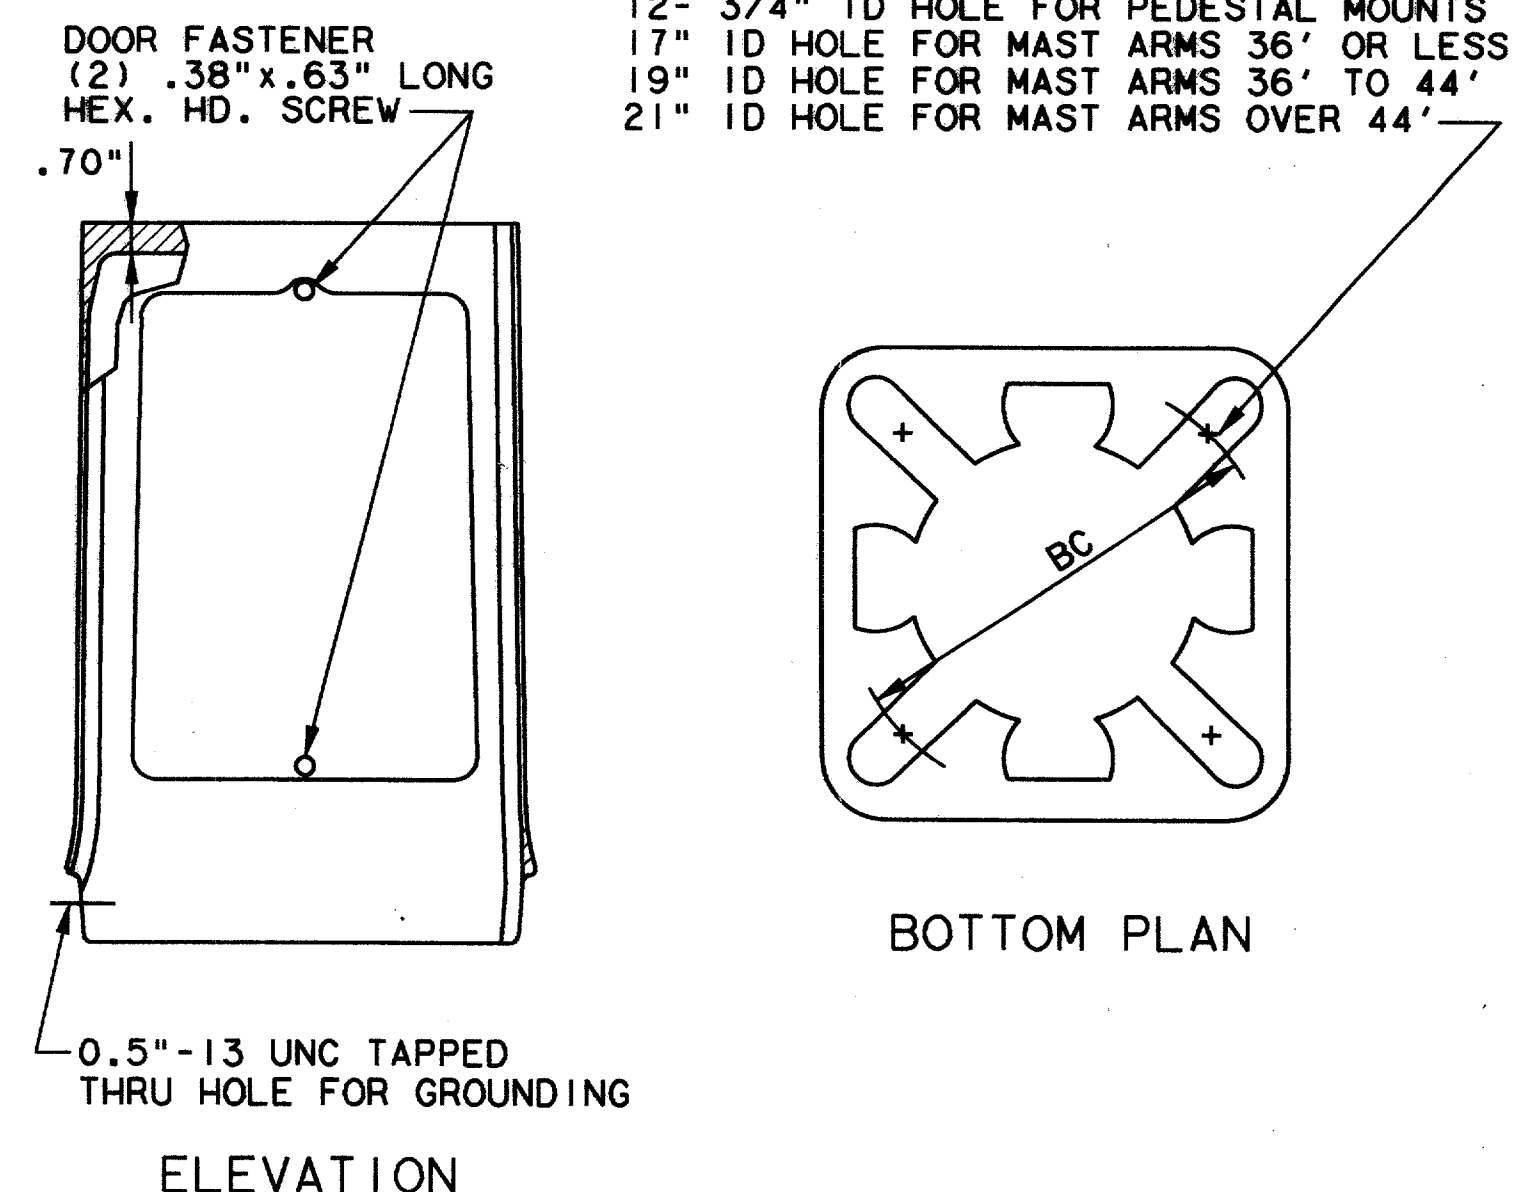



ELEVATION

BOTTOM PLAN


TRANSFORMER BASE NOTES:

- DOOR OPENING APPROXIMATELY 8" X 10 1/2" X 19 1/2"
- TOP BOLT HOLES WILL ACCOMODATE MAXIMUM 1.00" DIA BOLTS.
- (4)-2.75" O.D. X 0.500" THICK FLAT WASHERS WITH HEX. HEAD CONNECTING BOLT WITH HEX. NUTS (ASTM: A325, NUTS A563 GR DH) TOP OF TRANSFORMER BASE.
- (4)-2.50" O.D. X 0.375" THICK HOLDOWN WASHERS FINISHED TO ASTM: B695 CLASS 50 PROVIDED FOR INSTALLATION UNDER THE TRANSFORMER BASE TOP PLATE.
- (4) NUT COVERS WITH STAINLESS STEEL DRIVE SCREWS TO COVER THE HEX HEAD BOLTS ON THE TOP OF TRANSFORMER BASE.
- BASE CONFORMS TO BREAKAWAY CRITERIA OF AASHTO STANDARD SPECIFICATIONS FOR STRUCTURAL SUPPORTS, FOR HIGHWAY SIGNS, LUMINAIRES AND TRAFFIC SIGNALS (1975).

TRANSFORMER BASE
NOT TO SCALE

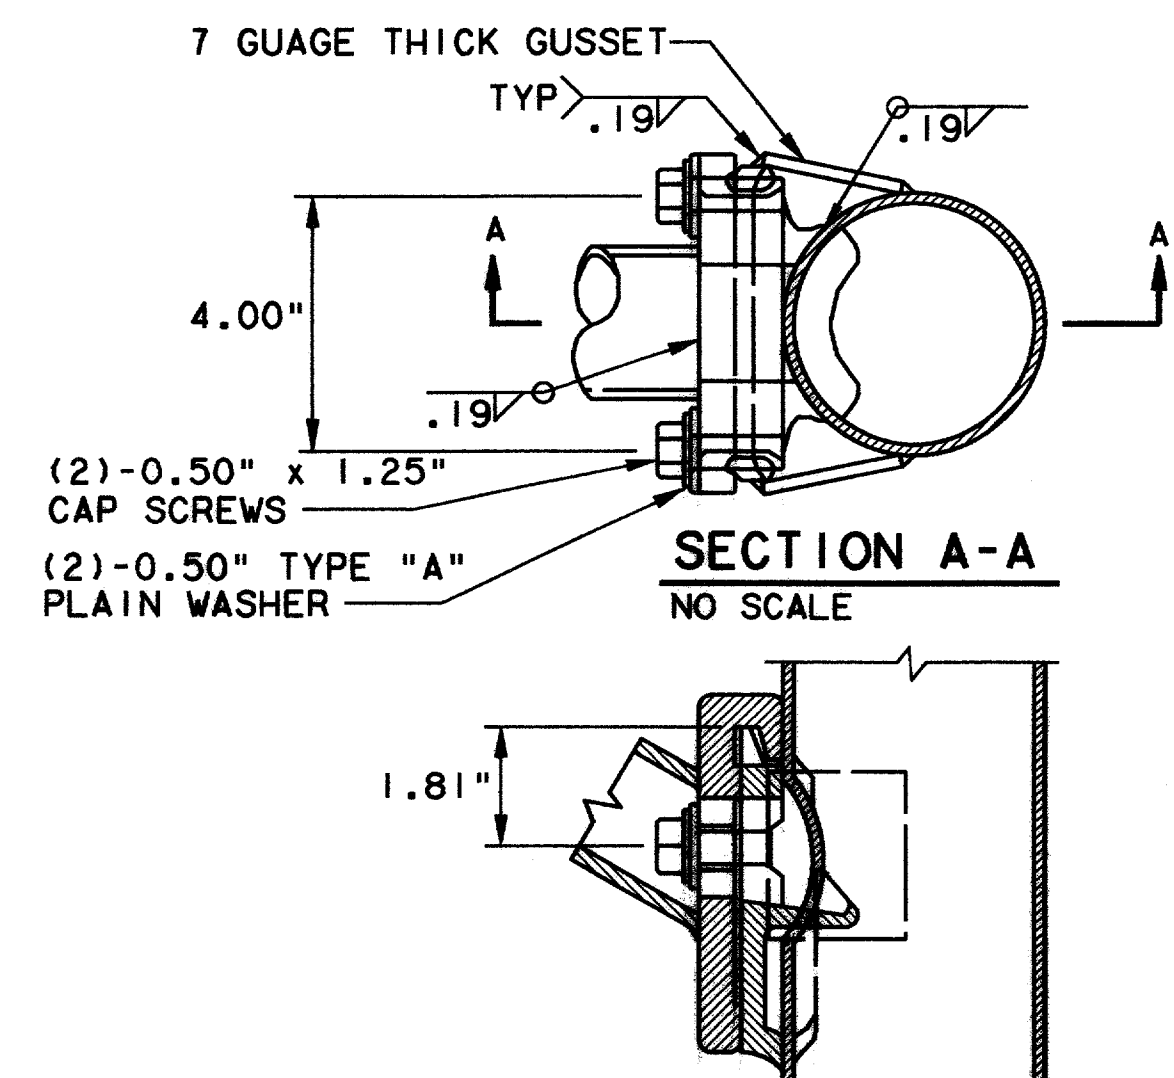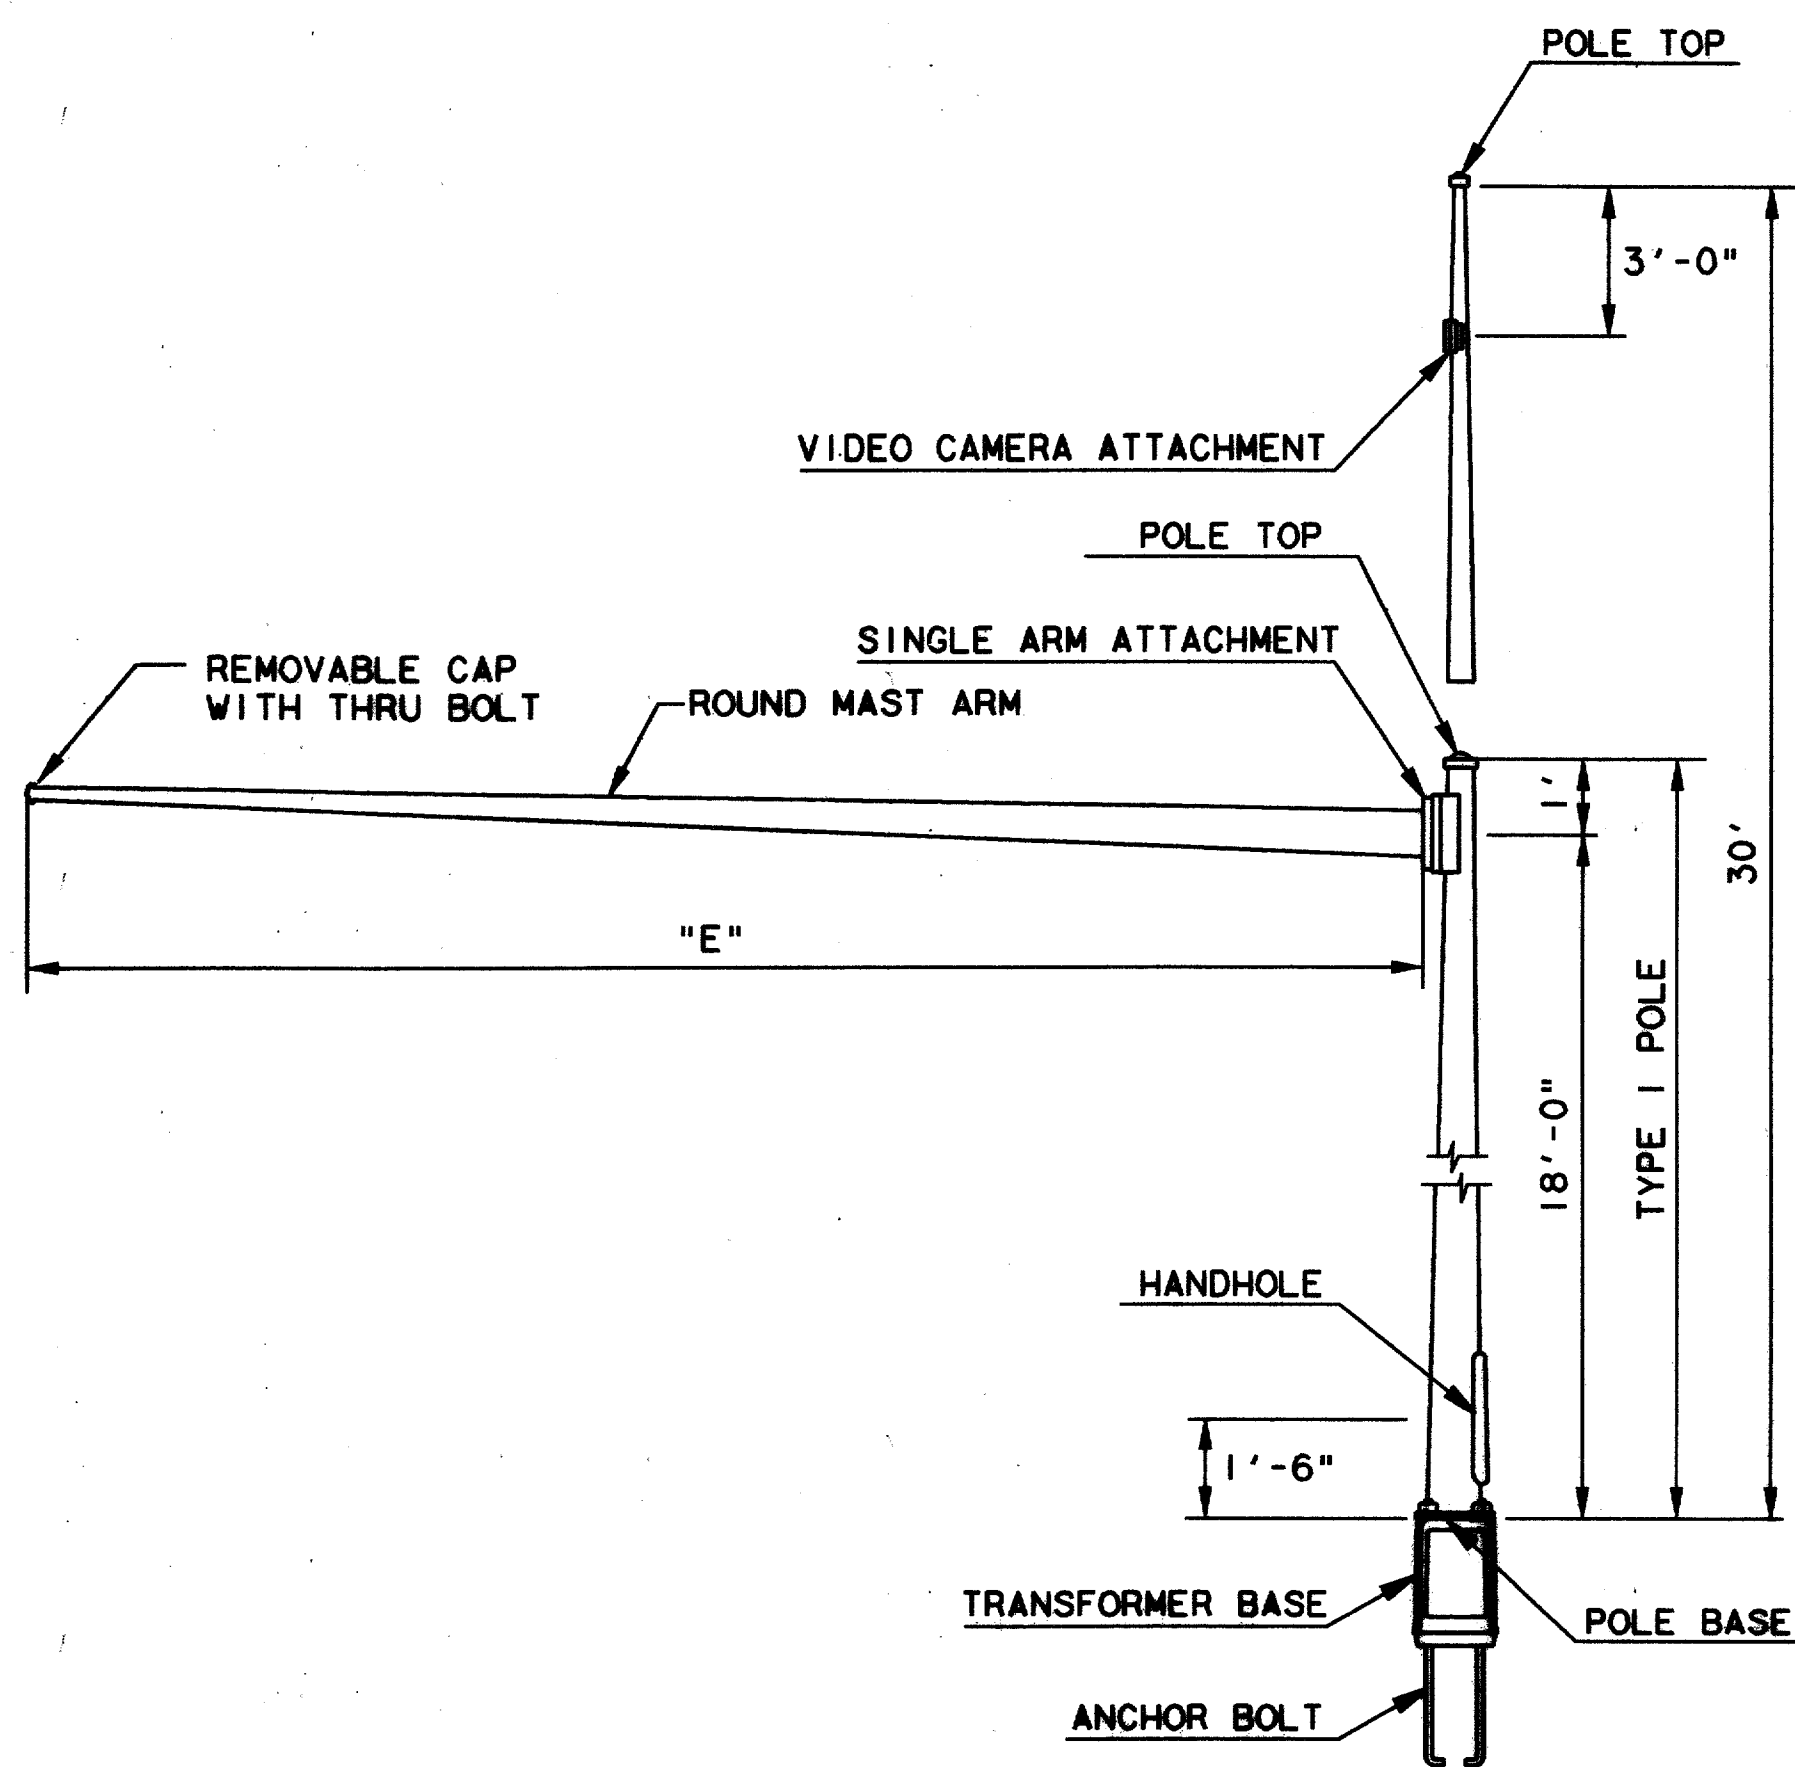


LUMINAIRE ARM ATTACHMENT
NO SCALE

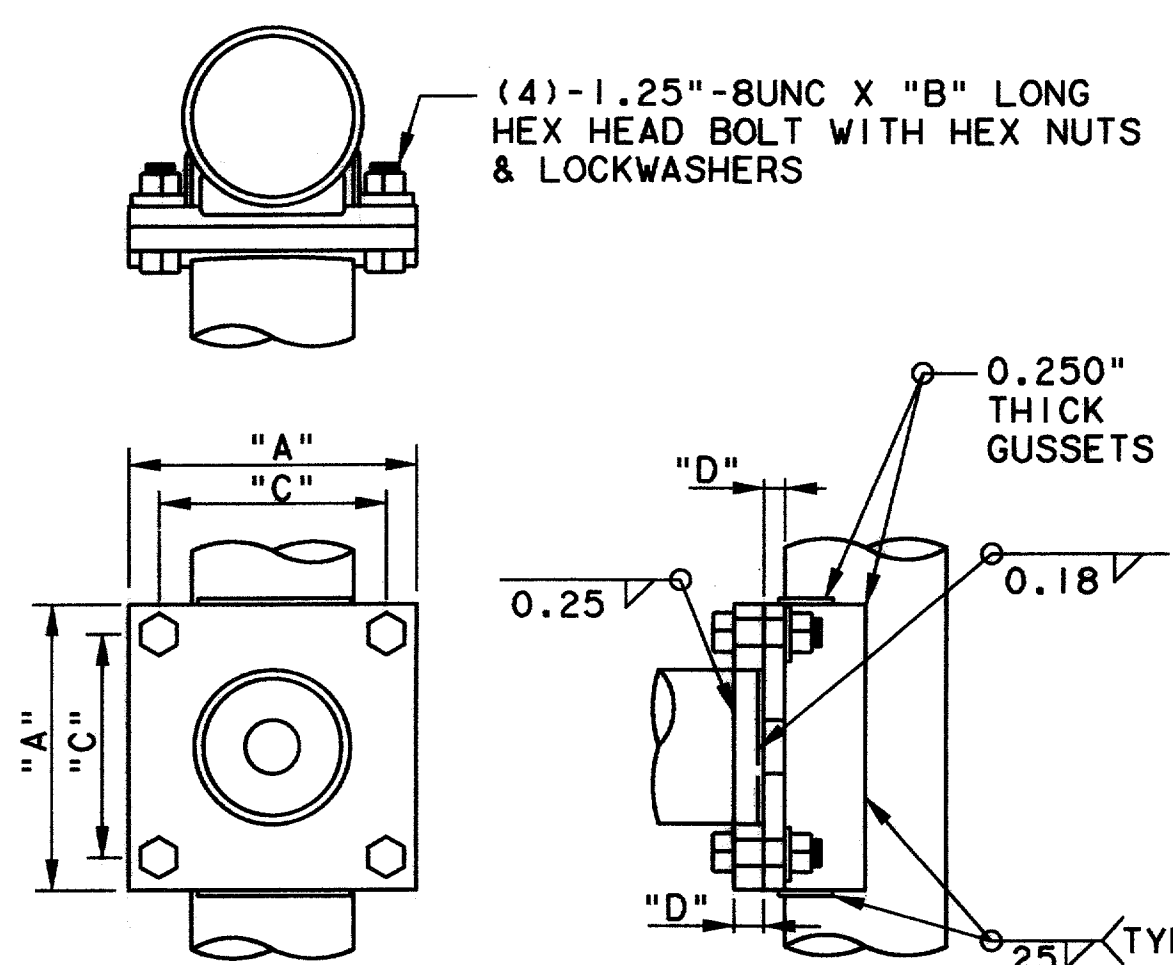

SINGLE ARM ATTACHMENT
NO SCALE


MATERIAL DATA					
COMPONENT	ASTM DESIGNATION	MIN YIELD (KSI)	COMPONENT	ASTM DESIGNATION	MIN YIELD (KSI)
TUBE - 7 & 3 GAUGE	A595 GR.A	55	POLE BASE - 7 & 3 GA.	A36	36
TUBE - ALL OTHERS	A572 GR.65	60	POLE BASE - ALL OTHERS	A572 GR.42	42
LUMINAIRE ARM PIPE	2" SCHED.40	36	SIGNAL ARM ATTACHMENT	A36	36
LUMINAIRE ARM ATTACHMENT	A27GR.65-35		SIGNAL ARM BOLTS	A325	92
ANCHOR BOLTS	A36-MOD.	55	LUMINAIRE ARM BOLTS	SAE GR.5	
GALVANIZING	A123 & A153				

POLE AND SIGNAL ARM DATA														
DESIGNATION KEY			POLE DATA				SIGNAL ARM DATA				SIGNAL ARM ATTACHMENT DATA			
POLE SERIES	POLE TYPE	SIGNAL ARM SPAN	BASE DIA	TOP DIA	LENGTH	GAUGE (THK)	FIXED END DIA	FREE END DIA	LENGTH "E"	GAUGE (INCHES)	PLATE SQUARE "A"	PLATE THICKNESS "D"	BOLT LENGTH "B"	BOLT SPACING "C"
DAL	1	20'	10.00"	7.50"	19'	0.179"	6.50"	3.80"	19.1'	0.179	11.00"	1.25"	4.50"	8.00"
DAL	1	24'	11.00"	8.50"	19'	0.179"	7.50"	4.30"	23.1'	0.179	11.00"	1.25"	4.50"	8.00"
DAL	1	28'	11.50"	9.00"	19'	0.179"	8.00"	4.20"	27.1'	0.179	11.00"	1.25"	4.50"	8.00"
DAL	1	32'	12.00"	9.50"	19'	0.179"	9.00"	4.70"	31.0'	0.179	13.00"	1.25"	4.50"	10.00"
DAL	1	36'	12.50"	10.00"	19'	0.179"	9.50"	4.60"	35.0'	0.179	13.00"	1.25"	4.50"	10.00"
DAL	1	40'	12.00"	9.50"	19'	0.239"	9.50"	4.10"	39.0'	0.239	13.00"	1.25"	4.50"	10.00"
DAL	1	44'	12.50"	10.00"	19'	0.239"	10.00"	4.10"	43.0'	0.239	14.00"	1.50"	5.00"	11.00"
DAL	1	48'	13.00"	10.50"	19'	0.239"	10.50"	4.10"	47.0'	0.239	14.00"	1.50"	5.00"	11.00"
DAL	2	20'	10.00"	5.00"	30'	0.179"	6.50"	3.80"	19.1'	0.179	11.00"	1.25"	4.50"	8.00"
DAL	2	24'	11.00"	6.80"	30'	0.179"	7.50"	4.30"	23.1'	0.179	11.00"	1.25"	4.50"	8.00"
DAL	2	28'	11.50"	7.30"	30'	0.179"	8.00"	4.20"	27.1'	0.179	11.00"	1.25"	4.50"	8.00"
DAL	2	32'	12.00"	7.80"	30'	0.179"	9.00"	4.70"	31.0'	0.179	13.00"	1.25"	4.50"	10.00"
DAL	2	36'	12.50"	8.30"	30'	0.179"	9.50"	4.60"	35.0'	0.179	13.00"	1.25"	4.50"	10.00"
DAL	2	40'	12.00"	7.80"	30'	0.239"	9.50"	4.10"	39.0'	0.239	13.00"	1.25"	4.50"	10.00"
DAL	2	44'	12.50"	8.30"	30'	0.239"	10.00"	4.10"	43.0'	0.239	14.00"	1.50"	5.00"	11.00"
DAL	2	48'	13.00"	8.80"	30'	0.239"	10.50"	4.10"	47.0'	0.239	14.00"	1.50"	5.00"	11.00"

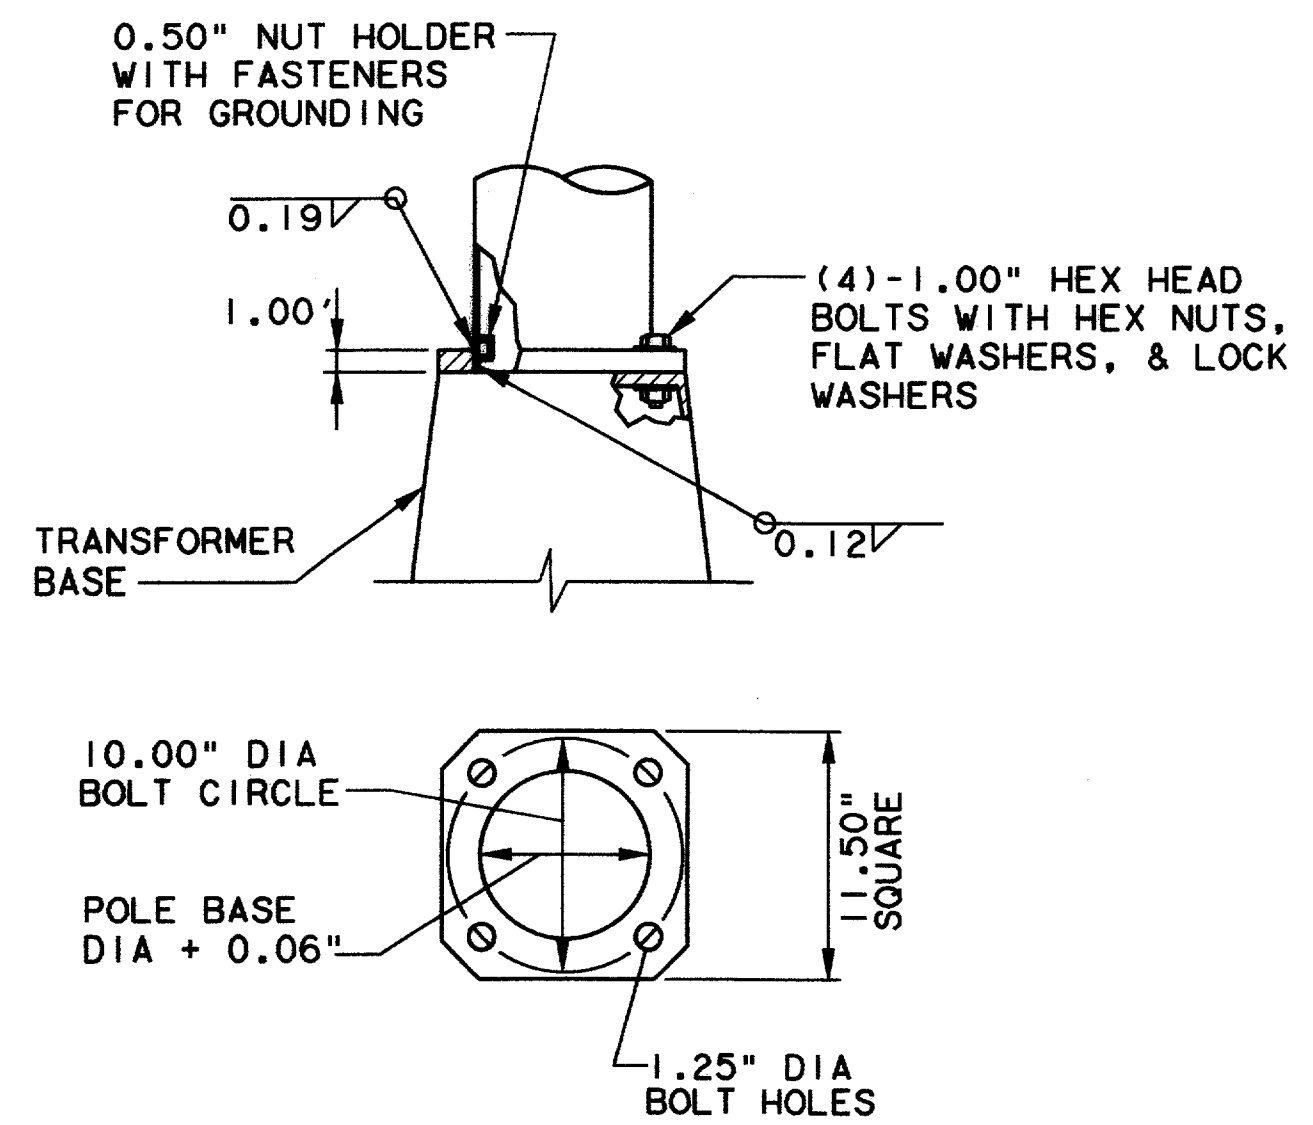


POLE BASE
NO SCALE


RECORD DOCUMENTS 6/9/2000
THESE RECORD DOCUMENTS HAVE BEEN PREPARED BASED ON INFORMATION PROVIDED BY OTHERS. THE CONSULTANT HAS NOT VERIFIED THE ACCURACY AND/OR COMPLETENESS OF THIS INFORMATION AND SHALL NOT BE RESPONSIBLE FOR ANY ERRORS OR OMISSIONS THAT MAY BE INCORPORATED AS A RESULT OF ERRONEOUS INFORMATION PROVIDED BY OTHERS.

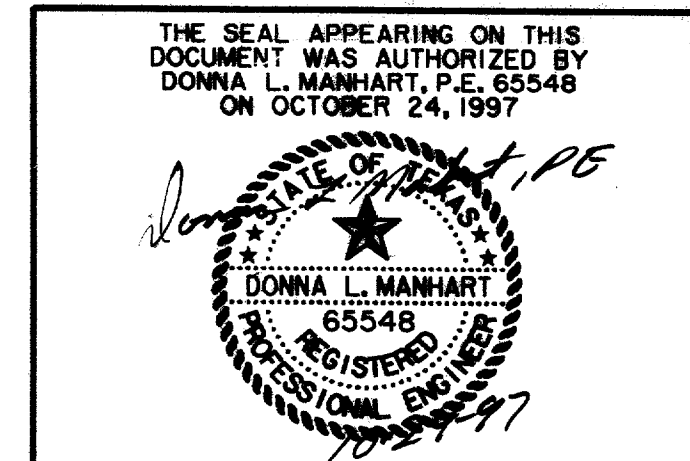

TRAFFIC SIGNAL POLE, MAST ARM AND TRANSFORMER BASE DETAILS						
ARAPAHO ROAD						
ADDISON ROAD TO DALLAS NORTH TOLLWAY						
TOWN OF ADDISON, TEXAS						
Huiit-Zollars, Inc./Consulting Engineers Dallas, Fort Worth, Houston, Phoenix, Tustin						
DESIGN	DRAWN	APPR.	SCALE	DATE	PROJECT NO.	NO.
HZI	HZI	DLM	NTS	OCT 97	1772-01	S-9

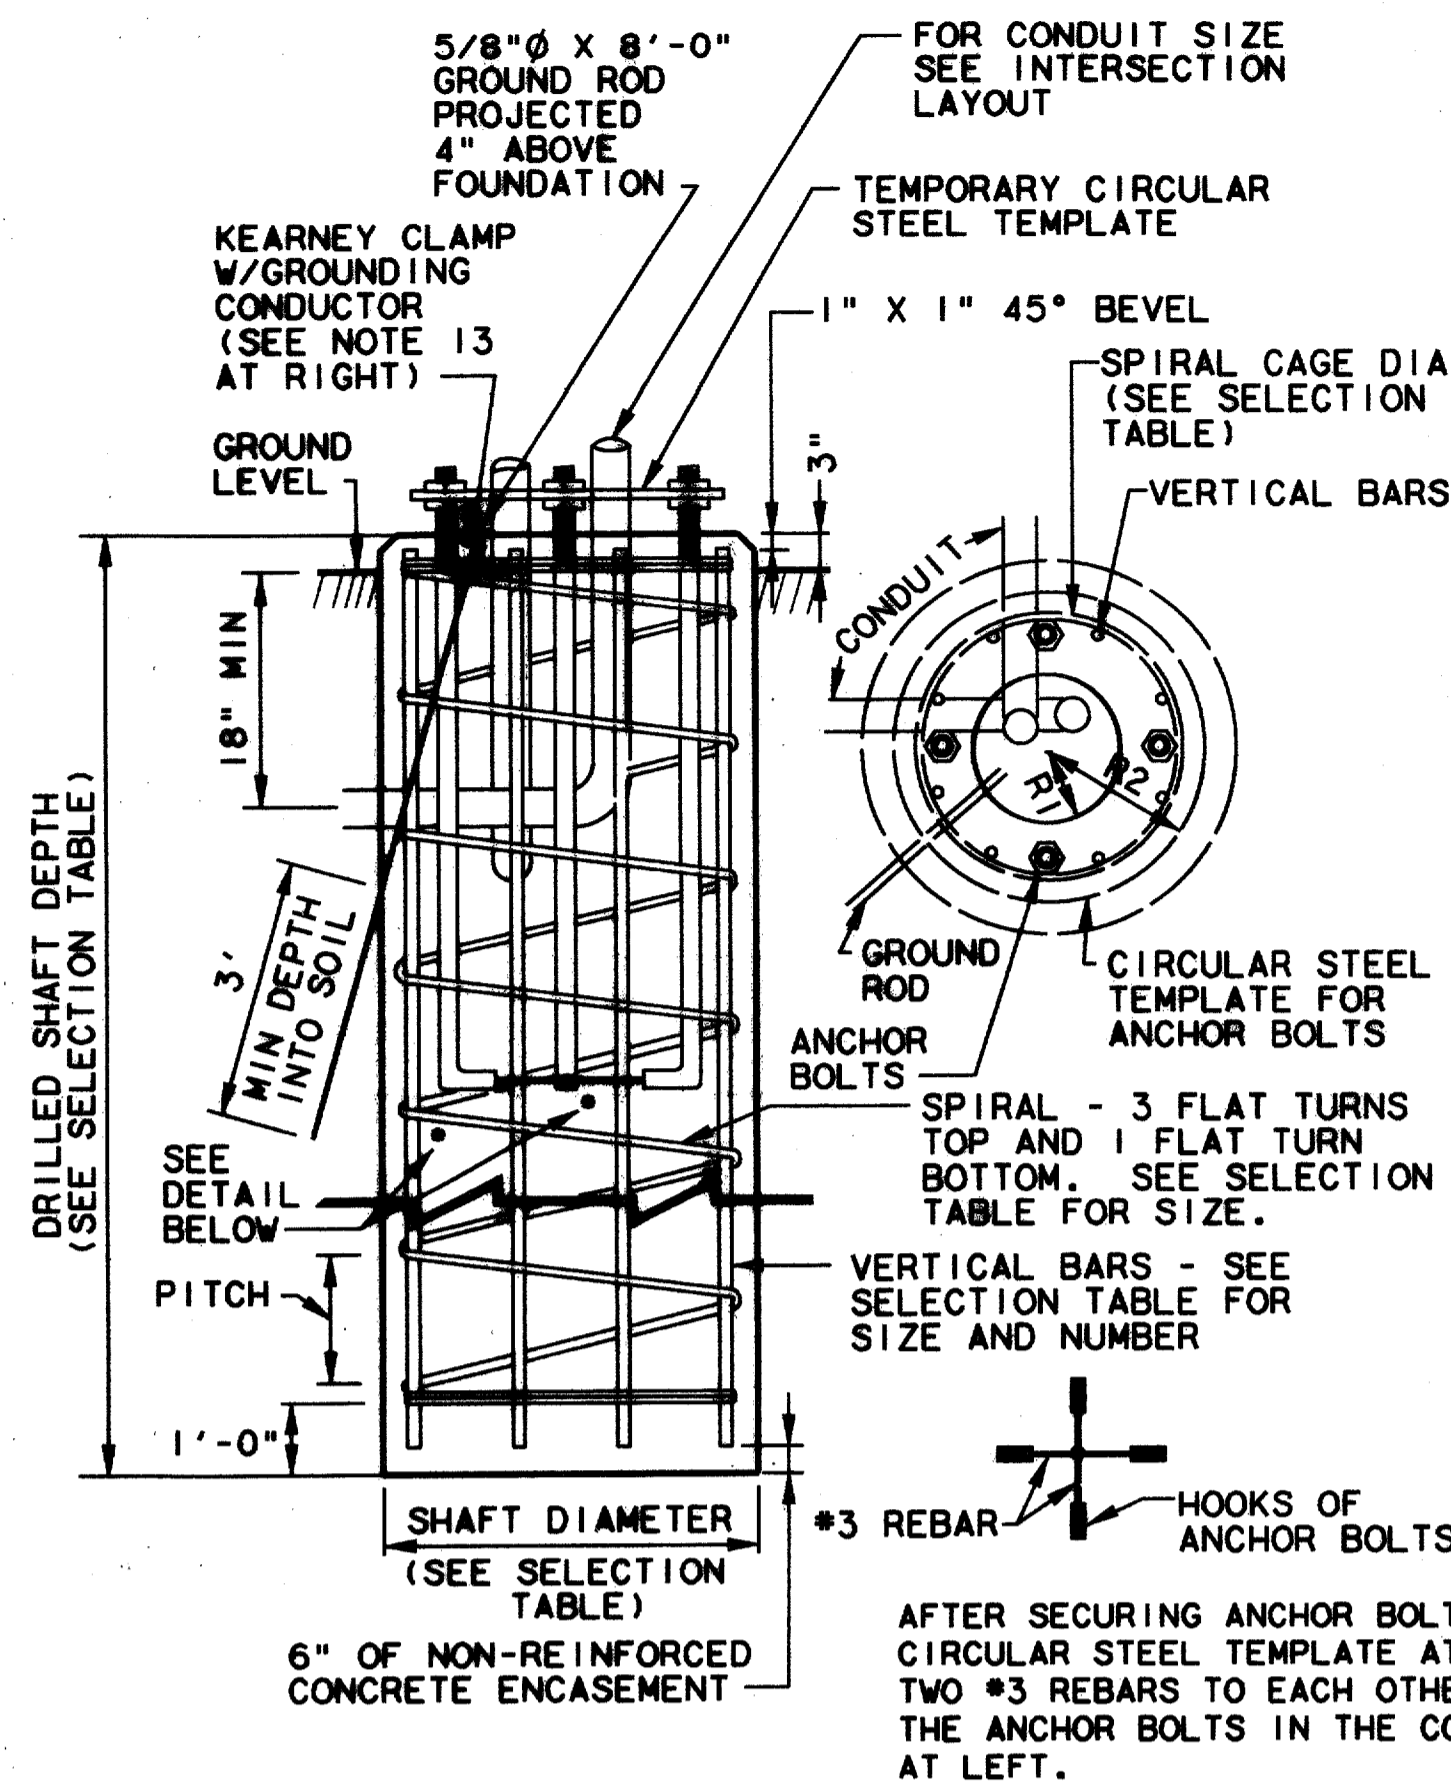

- NOTES:
1. A 1/4" THICK STEEL PLATE TEMPLATE WITH HOLES 1/16" GREATER THAN THE ANCHOR BOLT DIAMETER SHALL BE USED TO ACCURATELY POSITION ANCHOR BOLTS.
 2. CONCRETE USED FOR FOUNDATIONS SHALL BE EITHER CLASS A OR CLASS C AS DEFINED IN THE NORTH CENTRAL TEXAS COUNCIL OF GOVERNMENTS' "STANDARD SPECIFICATIONS FOR PUBLIC WORKS CONSTRUCTION" ITEM 7.4.5
 3. ALL ANCHOR BOLT HOOKS SHALL BE POINTED TOWARDS THE CENTER OF THE FOUNDATION.
 4. ALL CONDUITS PLACED IN THE FOUNDATION SHALL BE ORIENTED AS INDICATED ON THE INTERSECTION CONDUIT LAYOUT.
 5. 7" OF THE THREADED PORTION OF EACH ANCHOR BOLT SHALL PROJECT ABOVE THE TOP SURFACE OF THE FOUNDATION.
 6. A 5/8"Ø X 8'-0" COPPER CLAD STEEL GROUND ROD SHALL BE PLACED IN THE FOUNDATION WITH A MINIMUM OF 4" OF THE ROD PROJECTING ABOVE THE FOUNDATION'S TOP SURFACE.
 7. EACH GROUND ROD SHALL BE DRIVEN INTO THE SOIL FOR A MINIMUM OF 3' AS INDICATED ON THE DRAWING AT THE LEFT.
 8. WHEN SOLID ROCK IS ENCOUNTERED DURING DRILLING, THE DRILLED SHAFT SHALL EXTEND 5'-0" INTO SOLID ROCK, OR TO A DEPTH DETERMINED BY THE INSPECTOR.
 9. THE CONFIGURATION FOR ANCHOR BOLTS AND VERTICAL BARS INSIDE THE SPIRAL CAGE SHALL BE AS INDICATED ON DRAWING AT THE LEFT.
 10. SEE SELECTION TABLE FOR APPROPRIATE DRILLED SHAFT DEPTH FOR A GIVEN TYPE OF POLE AND ARM.
 11. ALL STEEL REINFORCEMENT BARS SHALL BE OF INTERMEDIATE GRADE.
 12. A 2' DEEP CIRCULAR FORM SHALL BE PLACED TO ENCASE THE TOP PORTION OF ALL CIRCULAR FOUNDATIONS.
 13. CONNECT #6 AWG STRANDED UNINSULATED COPPER GROUNDING CONDUCTOR TO GROUND ROD WITH A KEARNEY CLAMP. FOR FURTHER DETAILS CONCERNING GROUNDING CONSULT "DETAILS FOR GROUNDING CABINETS AND POLES" DRAWING.

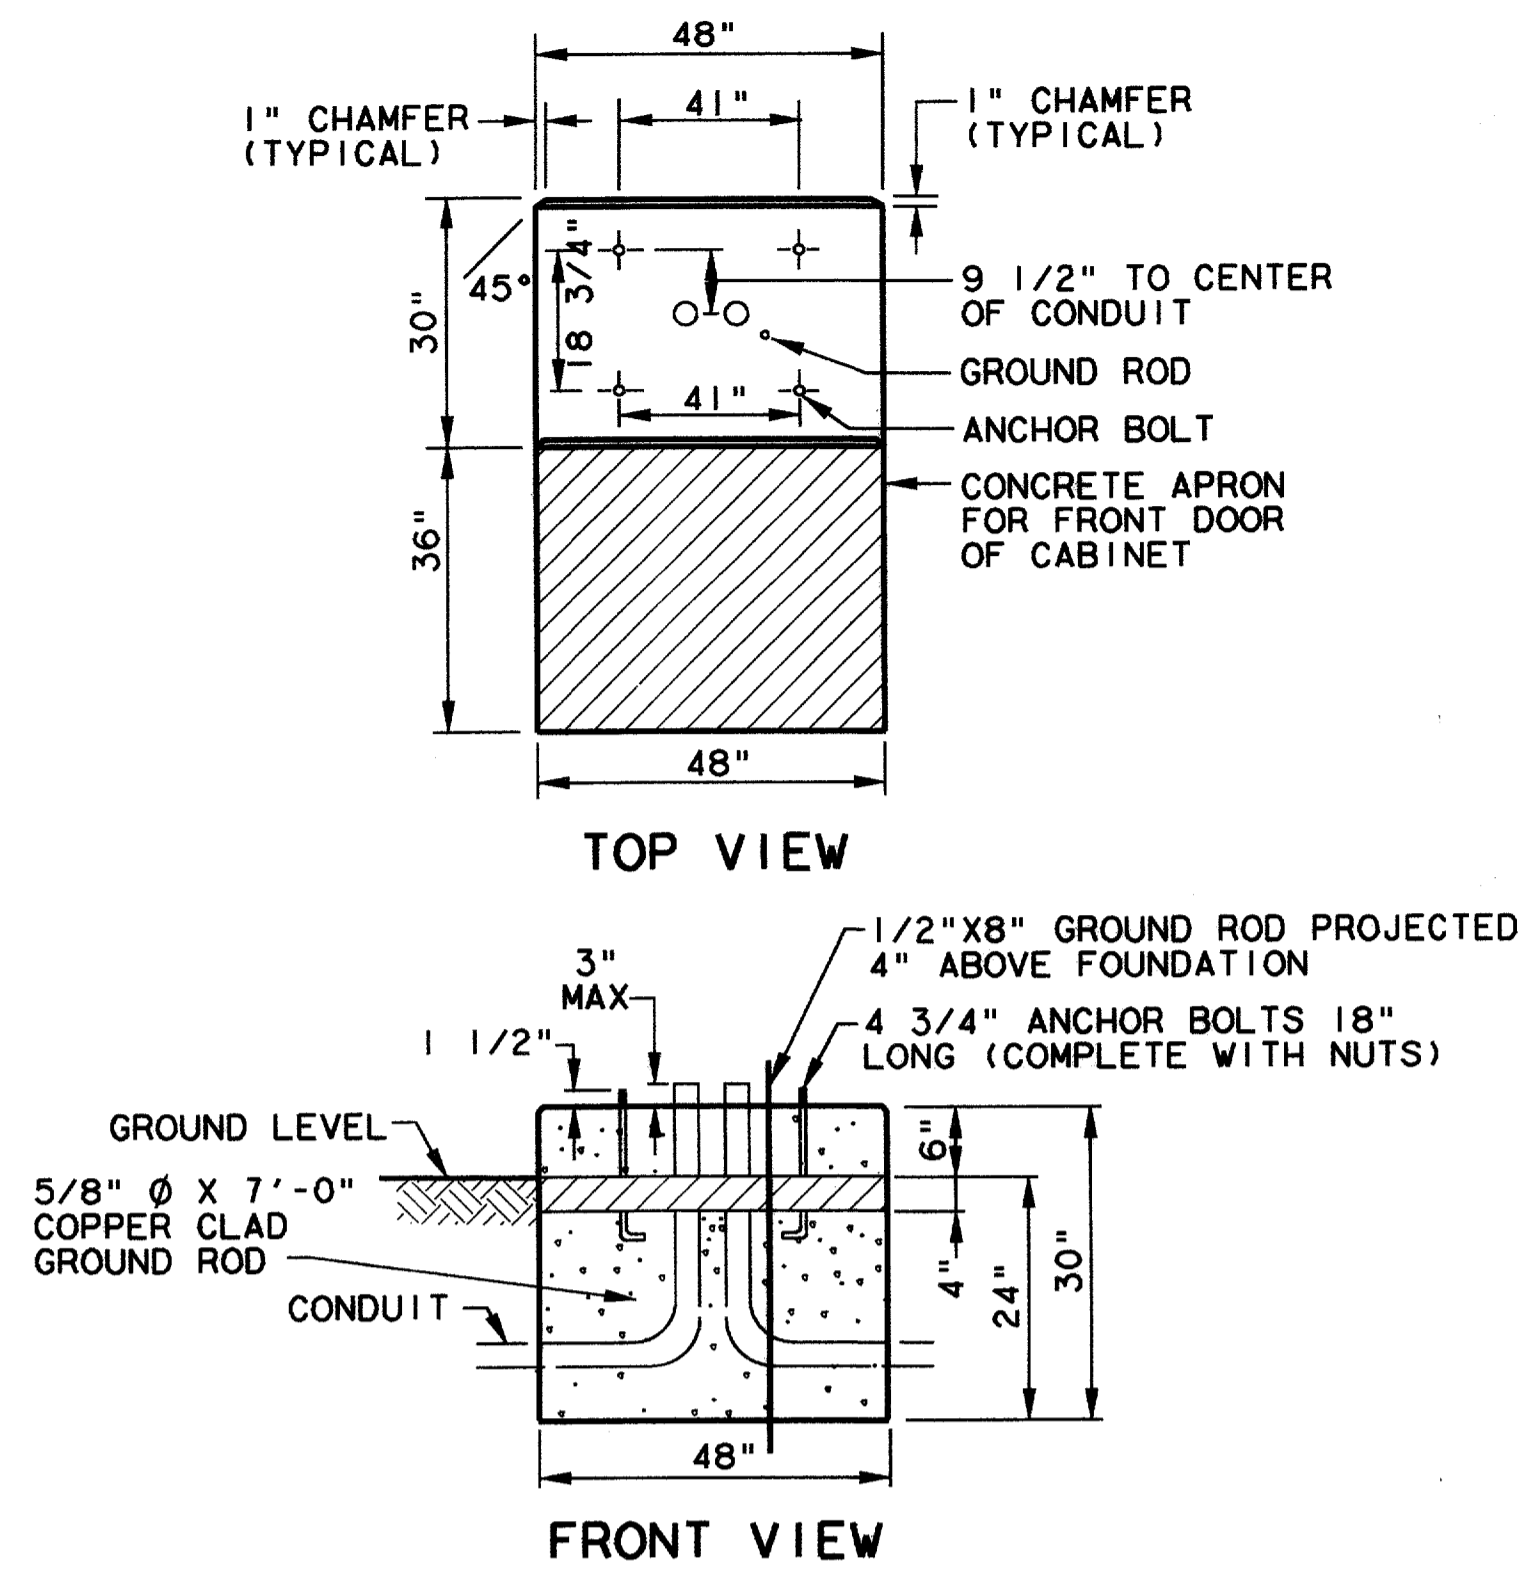

DETAILS FOR INSTALLING CONTROLLER CABINET AND FOUNDATION



FOUNDATION SELECTION TABLE

TYPE OF POLE AND MAST ARM	FOUNDATION TYPE	DRILLED SHAFT DIAMETER	SPIRAL CAGE DIAMETER	REINFORCEMENT STEEL		DRILLED SHAFT DEPTH	ANCHOR BOLT - QUANTITY AND DIMENSION	ANCHOR BOLT CIRCLE DIAMETER	TEMPLATE	
				VERT BARS	SPIRAL & PITCH				INSIDE RADIUS R1	OUTSIDE RADIUS R2 (MIN.)
TYPE I UP TO 36' ARM	30-A	30"	25"	8-#7'S	#3 AT 9"	11'-0"	(4) - 1 1/2" X 40" X 6" HOOK	17"	7"	10"
TYPE I UP TO 48' ARM	30-B	30"	25"	8-#9'S	#3 AT 9"	13'-0"	(4) - 1 3/4" X 46" X 6" HOOK	19"	7 3/4"	11 1/8"

- NOTES:
1. DRILLED SHAFT DIAMETER AND DEPTH, AND NUMBER OF VERTICAL BARS BASED ON TXDOT DISTRICT 18 STANDARDS FOR 80 MPH WINDS.
 2. SINGLE MAST ARM.


POLE FOUNDATION DETAILS FOR TRAFFIC SIGNAL STRUCTURES

- GENERAL NOTES
1. ALL CONTROLLER CABINETS AND SIGNAL POLES MOUNTED ON NEW FOUNDATIONS MUST BE GROUNDED.
 2. SIZE OF COPPER CLAD STEEL GROUND ROD SHALL BE 5/8"Ø X 8'-0".
 3. WHEN INSTALLING A GROUND ROD IN AN EXISTING FOUNDATION, DRILL 1" HOLE THROUGH THE FOUNDATION MISSING ALL ANCHOR BOLTS AND CONDUITS. AND PACK THE DRILLED HOLE WITH SALT.
 4. GROUND ROD SHALL CLEAR ALL ANCHOR BOLTS AND CONDUITS IN THE FOUNDATION. GROUND RODS SHALL EXTEND 4" ABOVE THE TOP OF FOUNDATION.

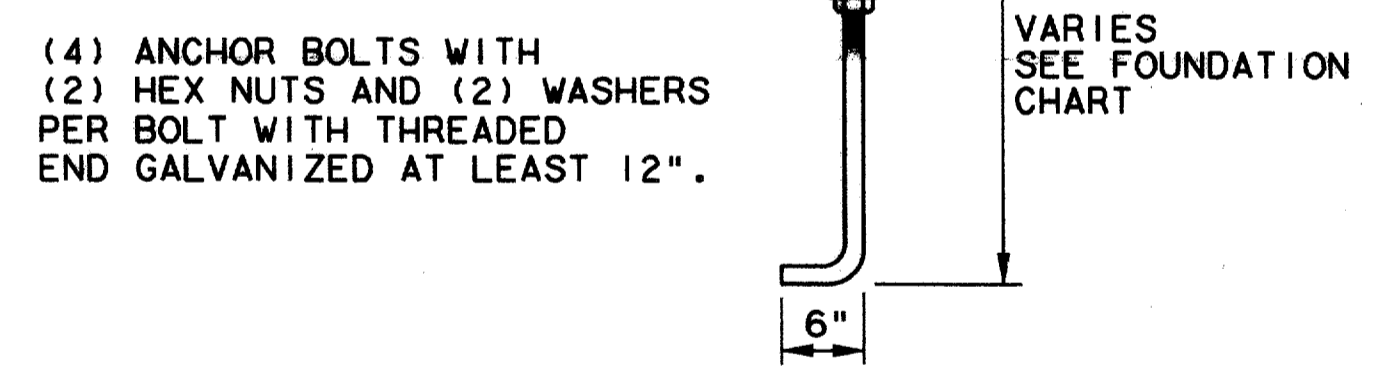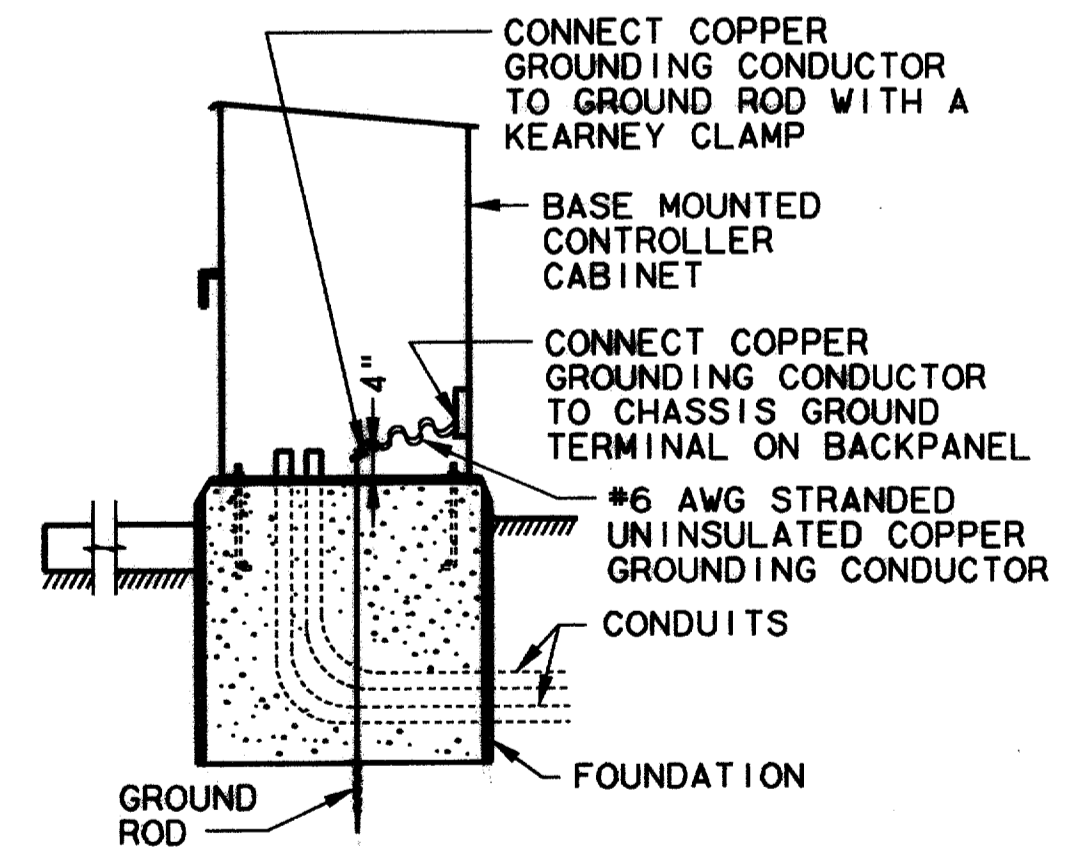

ANCHOR BOLT NO SCALE


GROUND CABINETS DETAIL

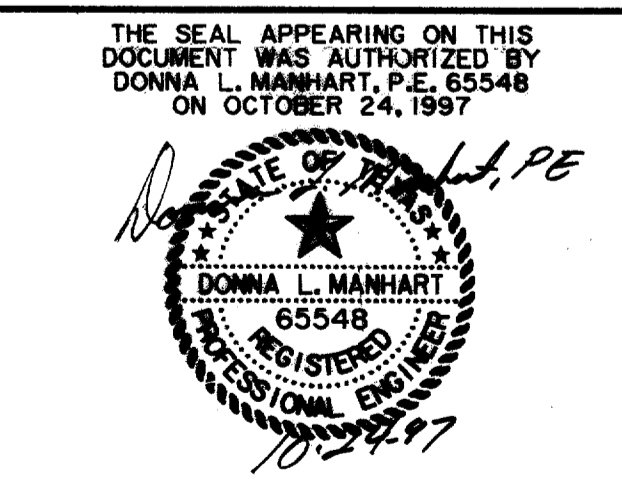

TRAFFIC SIGNAL CONTROLLER CABINET, AND SIGNAL FOUNDATION DETAILS						
ARAPAHO ROAD						
ADDISON ROAD TO DALLAS NORTH TOLLWAY						
TOWN OF ADDISON, TEXAS						
Huitt-Zollars, Inc./Consulting Engineers Dallas, Fort Worth, Houston, Phoenix, Tustin						
DESIGN	DRAWN	APPR.	SCALE	DATE	PROJECT NO.	NO.
HZI	HZI	DLM	NTS	OCT 97	1772-01	S-10

RECORD DOCUMENTS 6/9/2000


THESE RECORD DOCUMENTS HAVE BEEN PREPARED BASED ON INFORMATION PROVIDED BY OTHERS. THE CONSULTANT HAS NOT VERIFIED THE ACCURACY AND/OR COMPLETENESS OF THIS INFORMATION AND SHALL NOT BE RESPONSIBLE FOR ANY ERRORS OR OMISSIONS THAT MAY BE INCORPORATED AS A RESULT OF ERRONEOUS INFORMATION PROVIDED BY OTHERS.

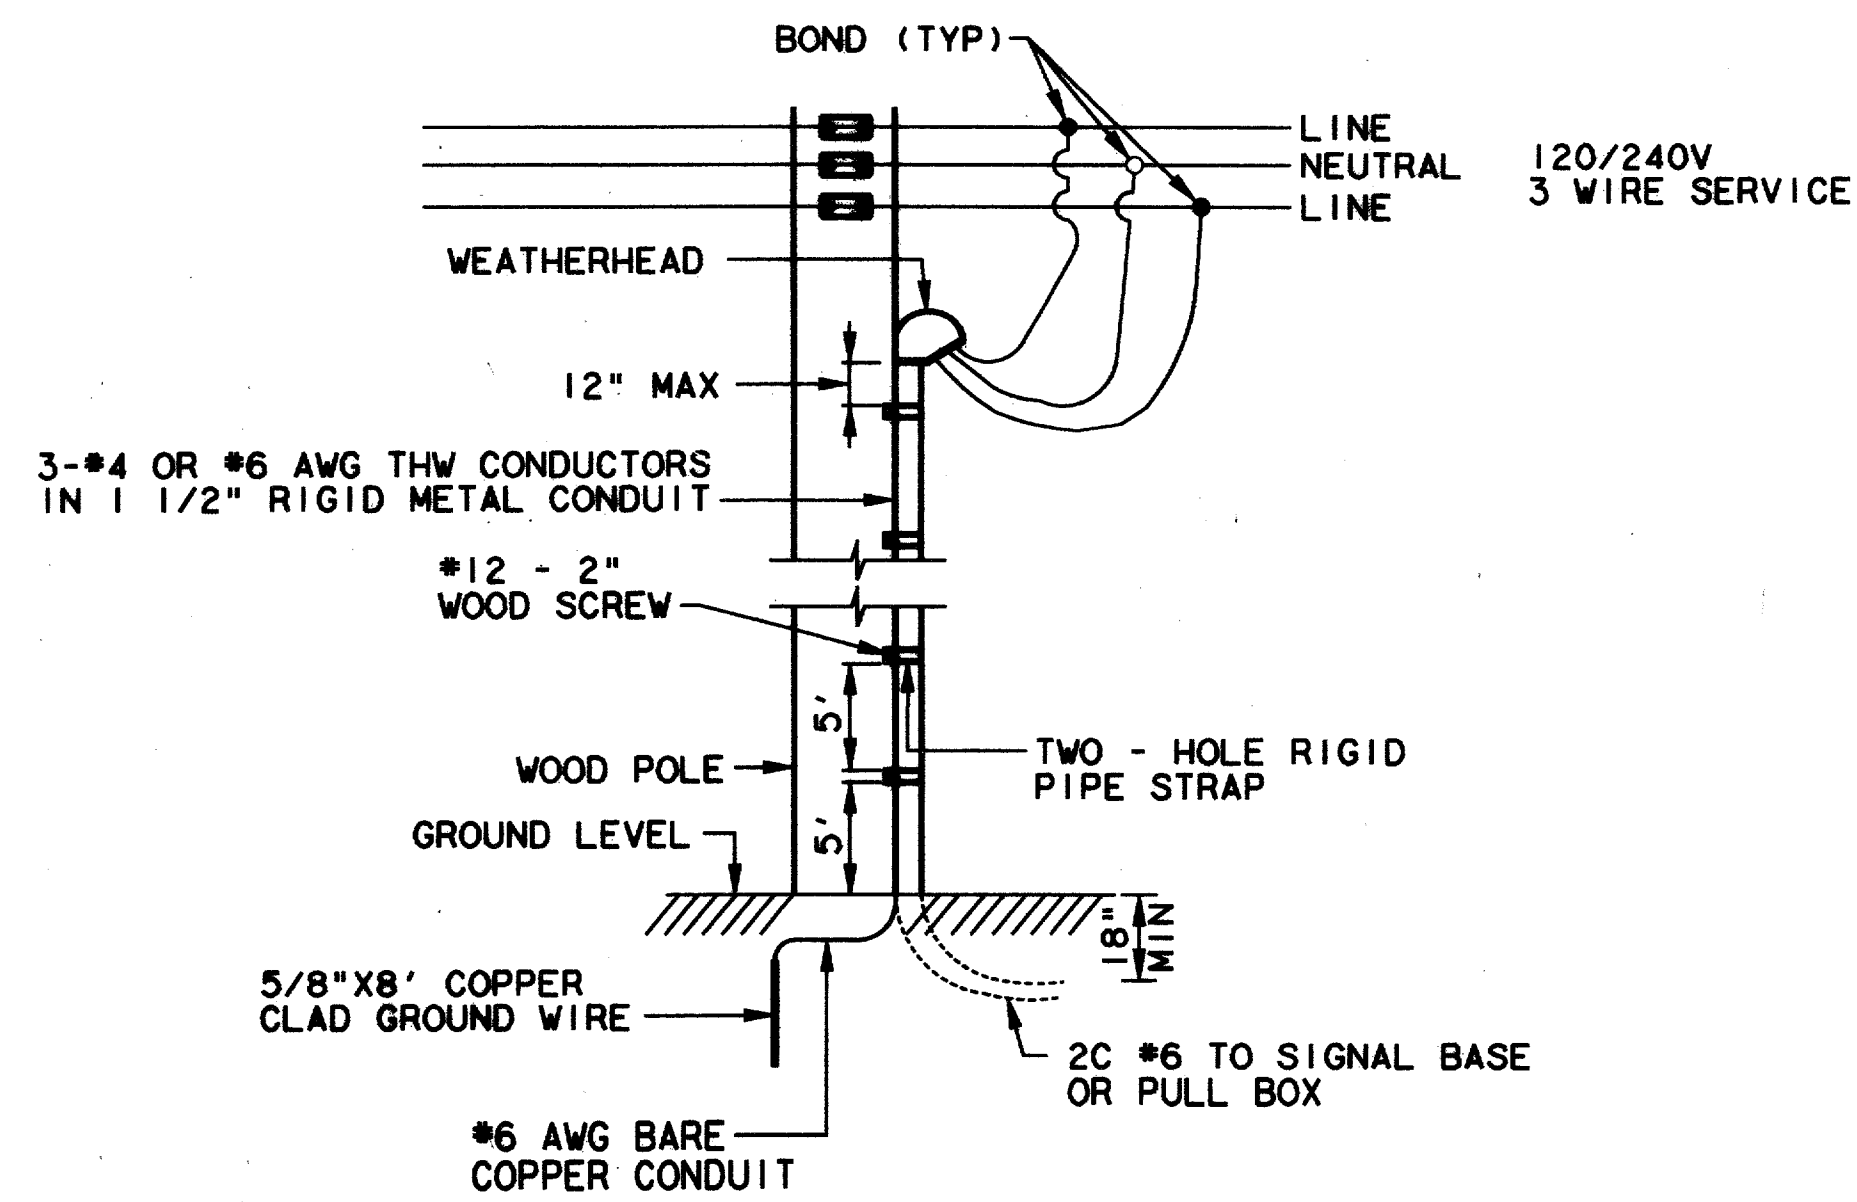

NOTE: STRAPS SHALL BE INSTALLED EVERY 5' STARTING AT GROUND


POWER SERVICE CONNECTION DETAILS

CONTRACTOR SHALL MOUNT EQUIPMENT ON POLES AS DIRECTED BY THE POWER COMPANY. IT IS THE RESPONSIBILITY OF THE CONTRACTOR TO NOTIFY TUE PRIOR TO CONSTRUCTION.

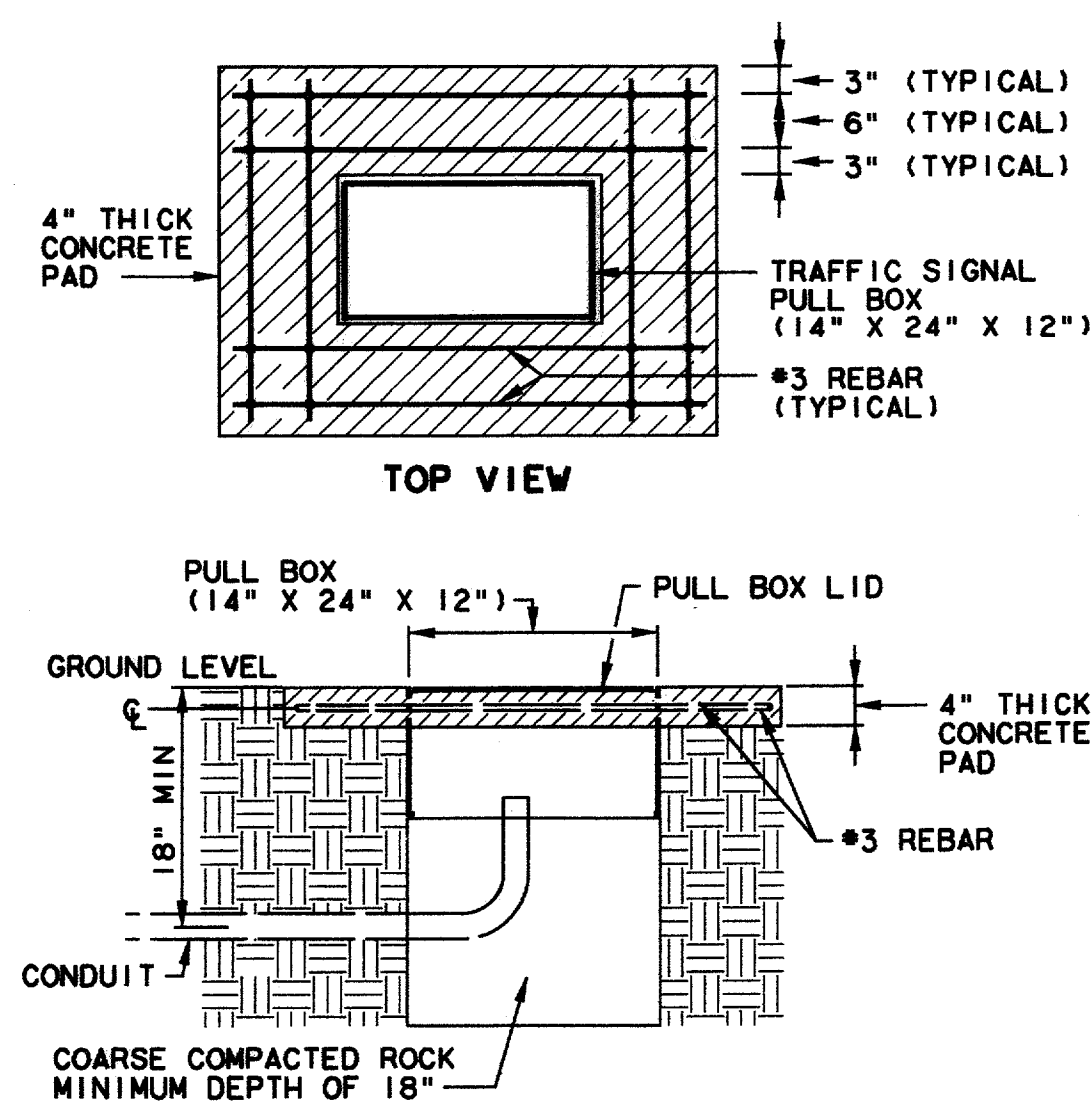


NOTES: 1. PULL BOX LID SHALL BE CAST IRON.
2. COVER SHALL BE FABRICATED TO FIT INTO A RECESSED LIP AND SECURED WITH 2 BRASS OR BRONZE BALLS AND NUTS. LIDS SHALL BE PROVIDED WITH A DROP TYPE HANDLE TO FACILITATE REMOVAL.

DETAIL OF PULL BOX

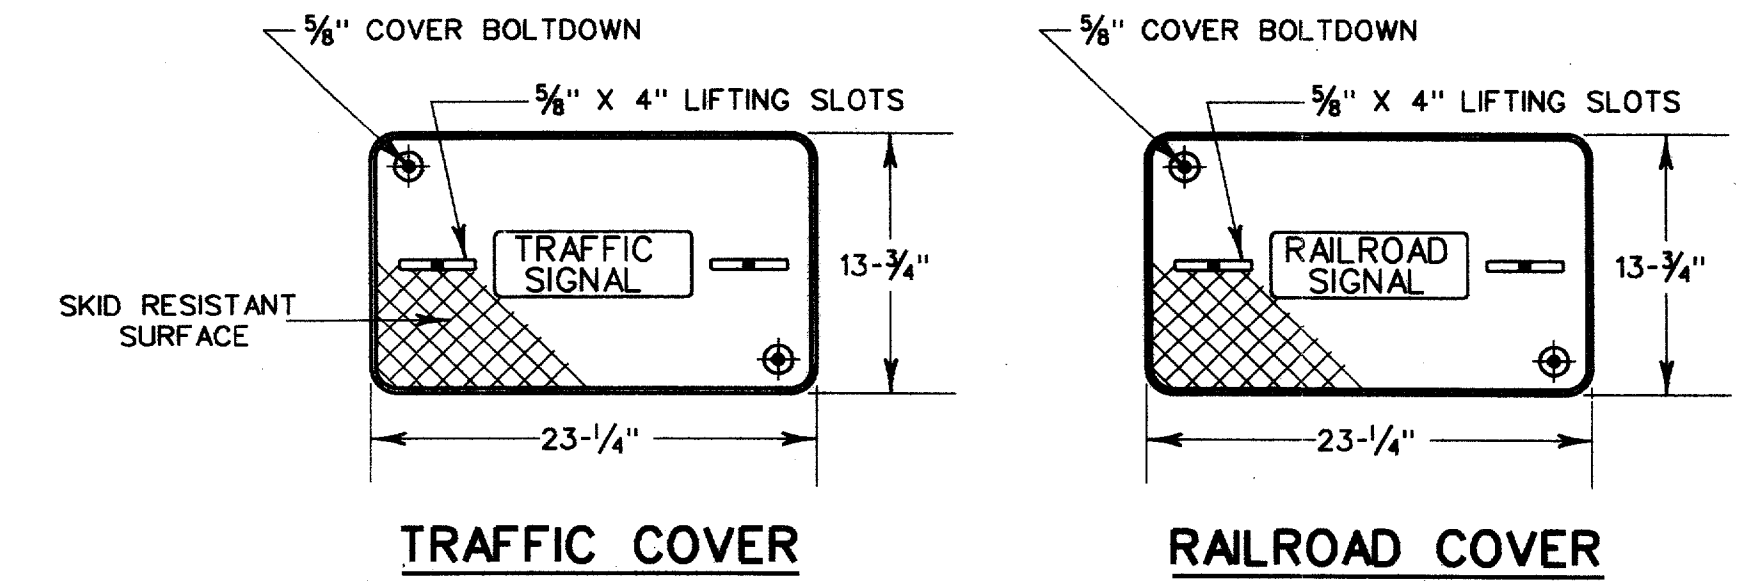


TRAFFIC COVER

RAILROAD COVER

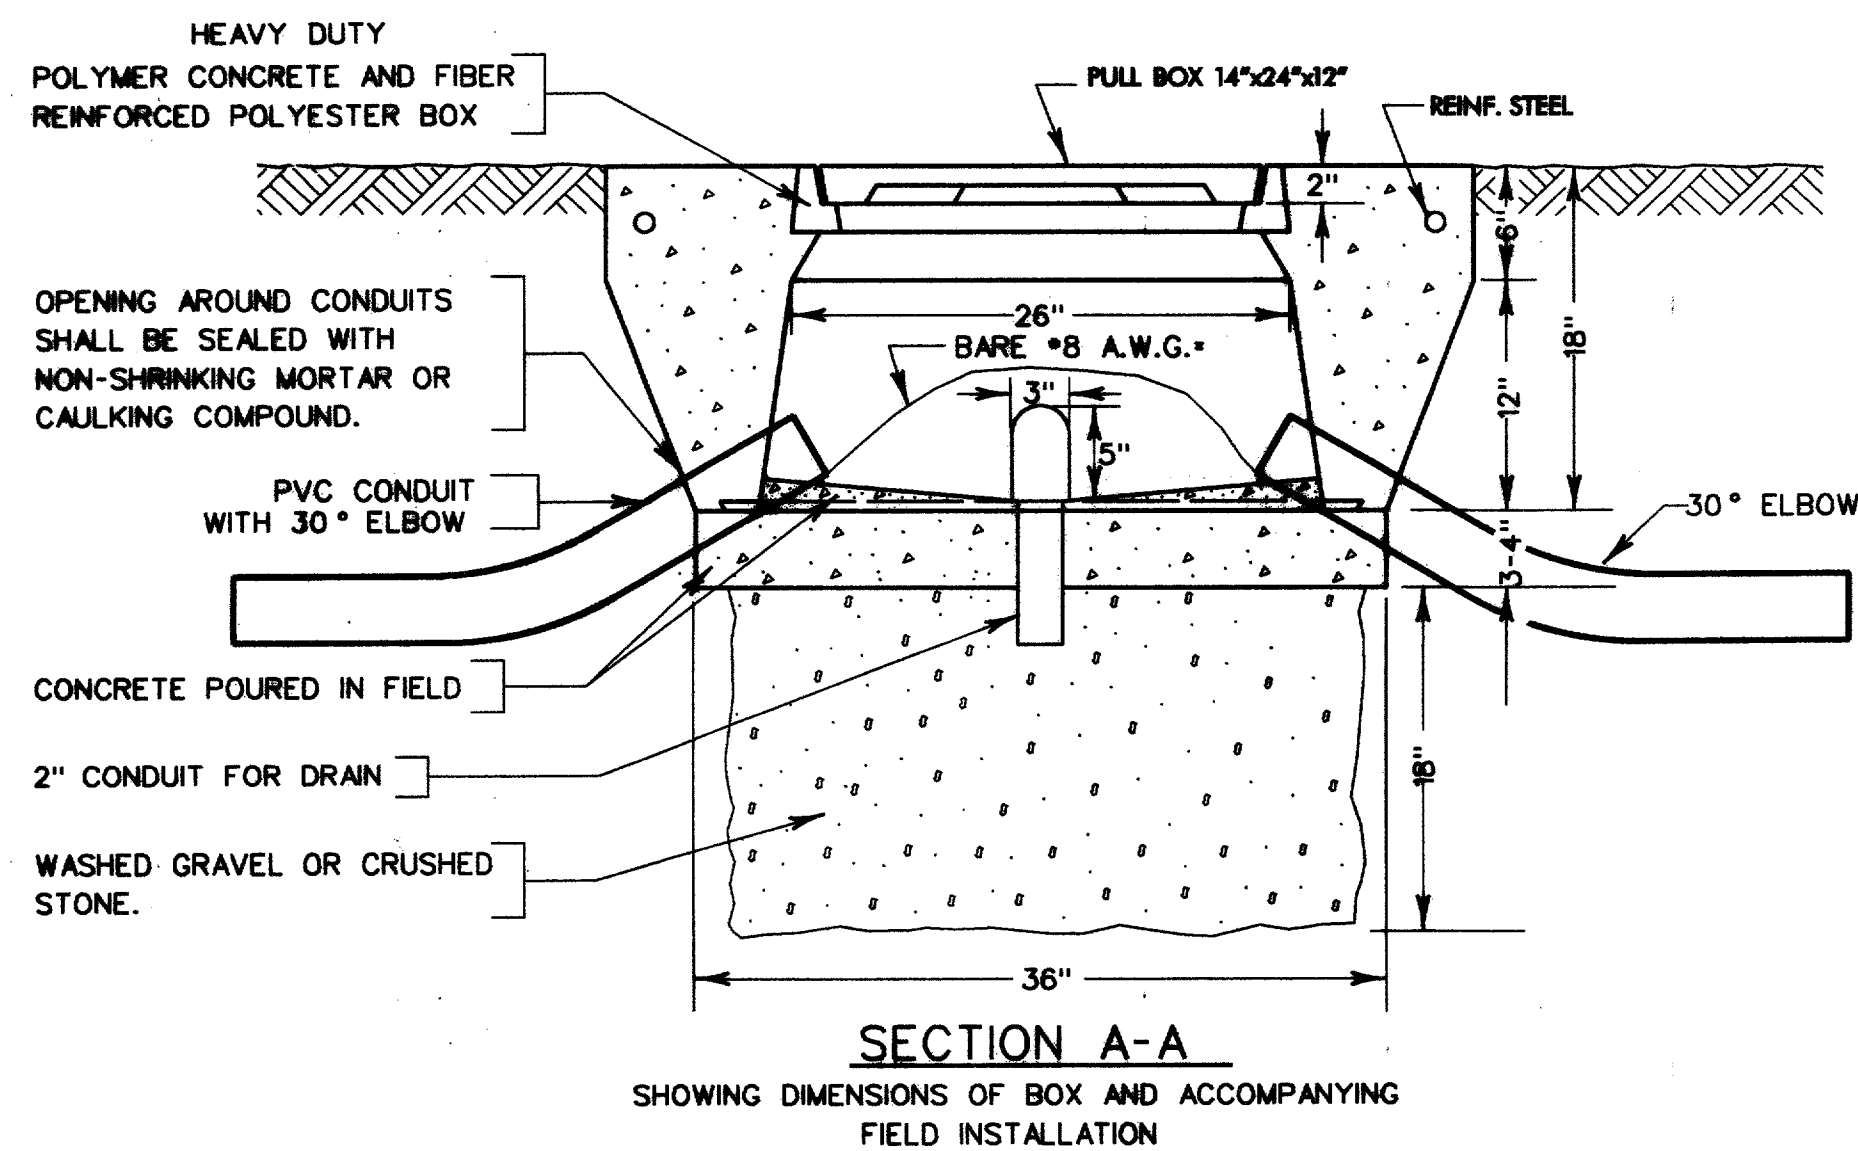

NOTES:



1. ALL PULLBOXES NOT SET IN WALKS OR PAVED MEDIANS SHALL HAVE CONCRETE APRON.
2. TYPE 'C' PULLBOXES BY ALL CONTROLLERS SHALL HAVE CONCRETE APRON.

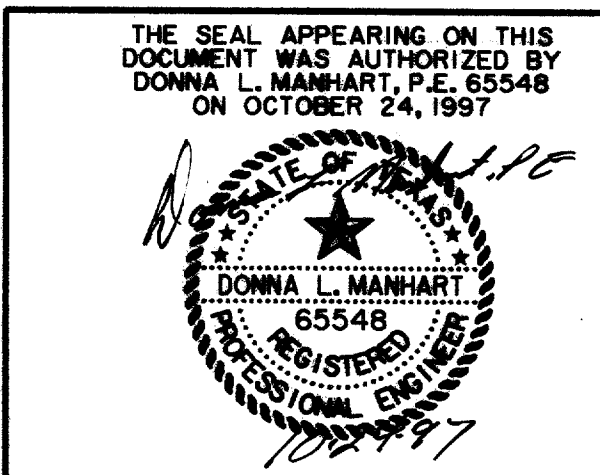


PULL BOX AND SERVICE CONNECTION DETAILS						
ARAPAHO ROAD						
ADDISON ROAD TO DALLAS NORTH TOLLWAY						
TOWN OF ADDISON, TEXAS						
Hull- Zollars, Inc./Consulting Engineers Dallas, Fort Worth, Houston, Phoenix, Tustin						
DESIGN	DRAWN	APPR.	SCALE	DATE	PROJECT NO.	NO.
HZI	HZI	DLM	NTS	OCT 97	1772-01	S-11

RECORD DOCUMENTS 6/9/2000

THESE RECORD DOCUMENTS HAVE BEEN PREPARED BASED ON INFORMATION PROVIDED BY OTHERS. THE CONSULTANT HAS NOT VERIFIED THE ACCURACY AND/OR COMPLETENESS OF THIS INFORMATION AND SHALL NOT BE RESPONSIBLE FOR ANY ERRORS OR OMISSIONS THAT MAY BE INCORPORATED AS A RESULT OF ERRONEOUS INFORMATION PROVIDED BY OTHERS.

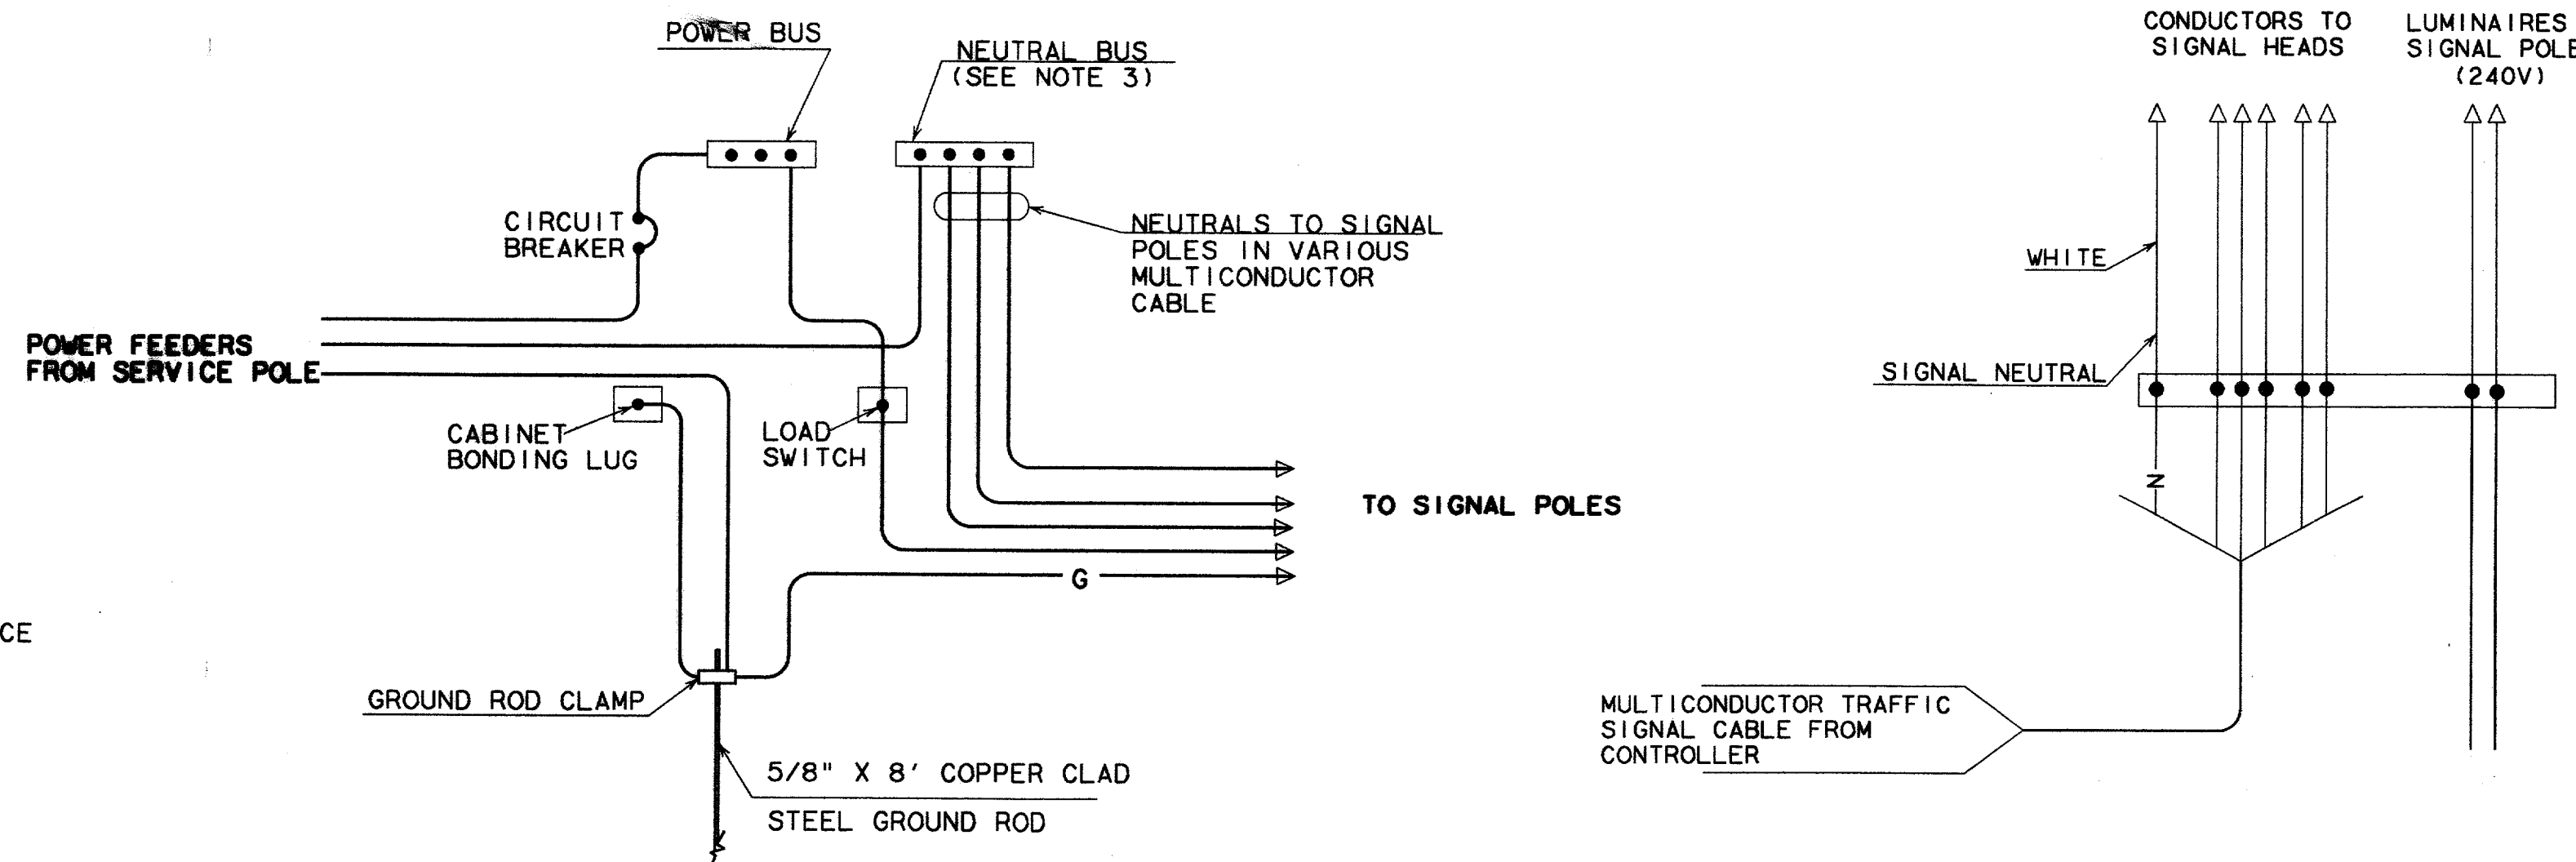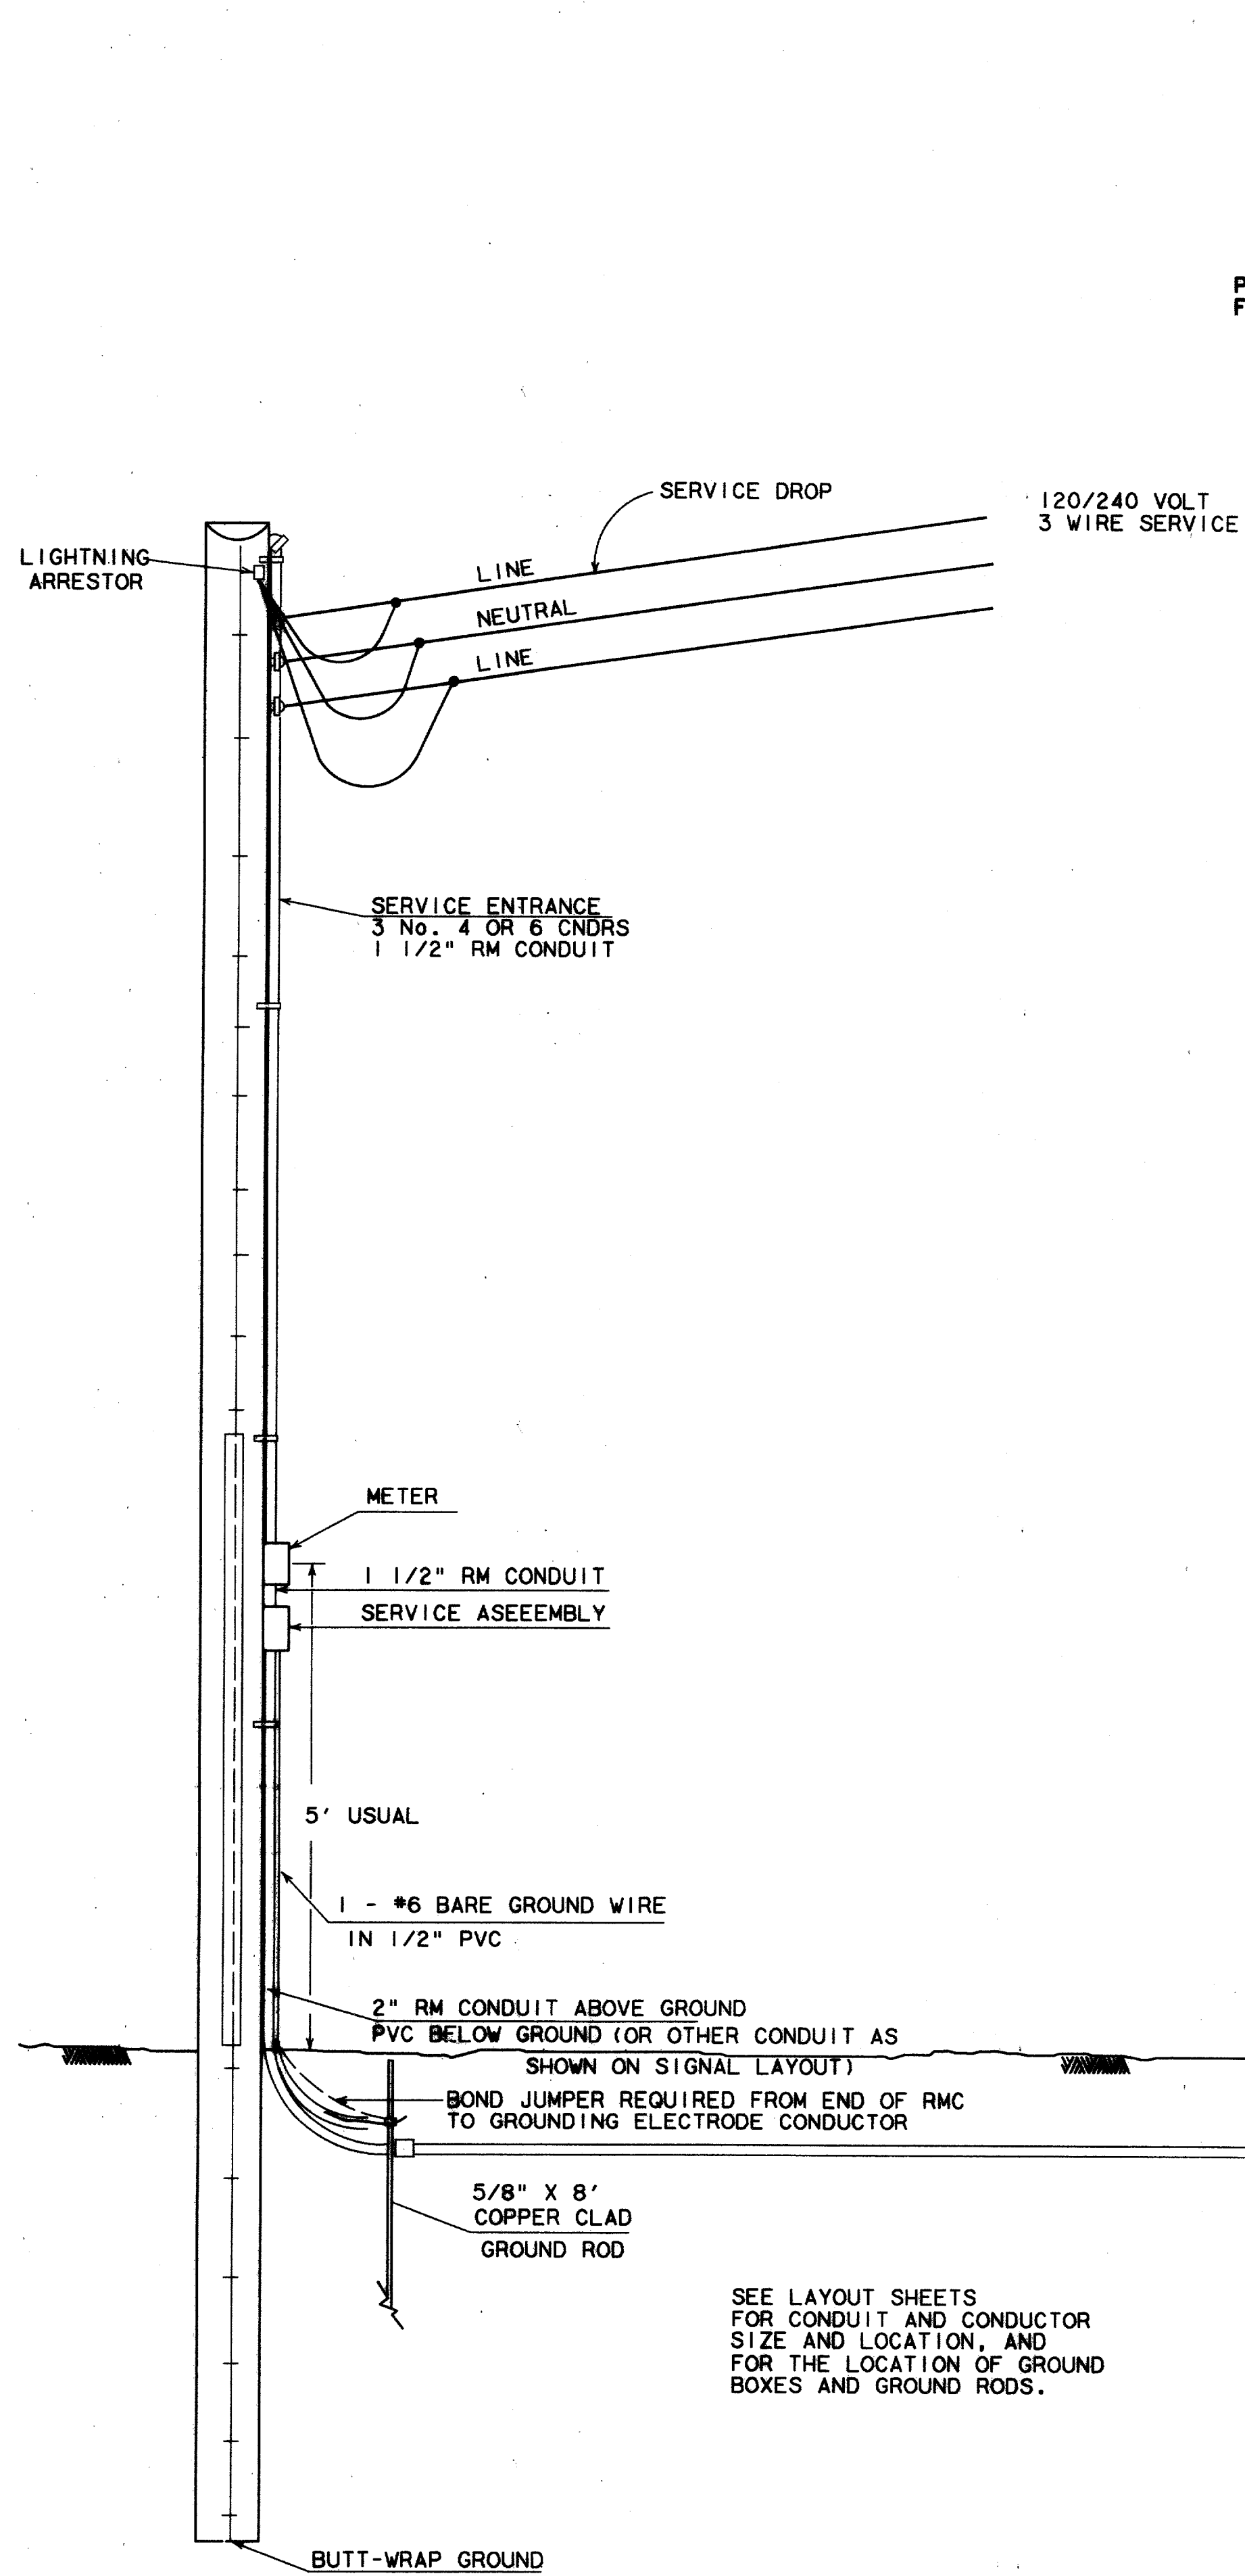

CONNECTIONS AT SIGNAL CONTROLLERS

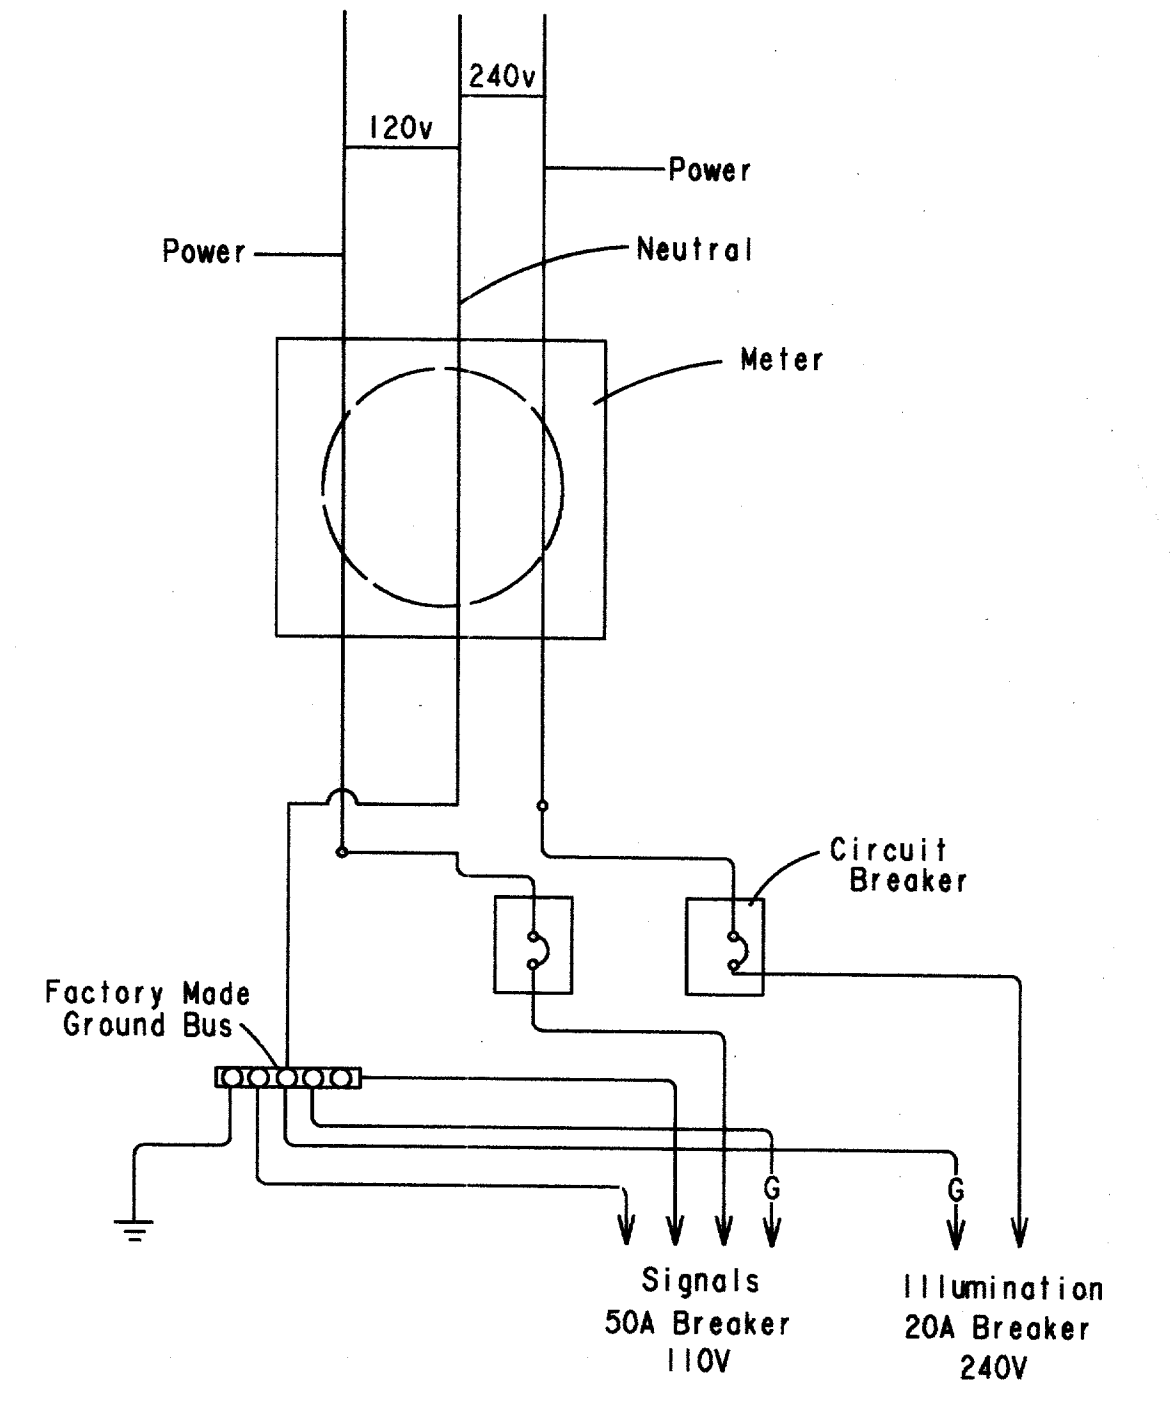


SERVICE ASSEMBLY SCHEMATIC

120/240 VOLTS - THREE WIRE
TYPE D

NOTES:

1. Luminaire conductors should not be looped through controller cabinet.
2. Electrical system to include an equipment grounding conductor noted here as "G".
arrestors and surge protectors are to be bonded to grounding conductor.
3. Bond neutral bus to cabinet bonding lug when required elsewhere on the plans or when required by the Town of Addison.
4. Internally lighted street name signs (ILSN), when required, shall be in accordance with the item "Internally Lighted Street Name Signs".

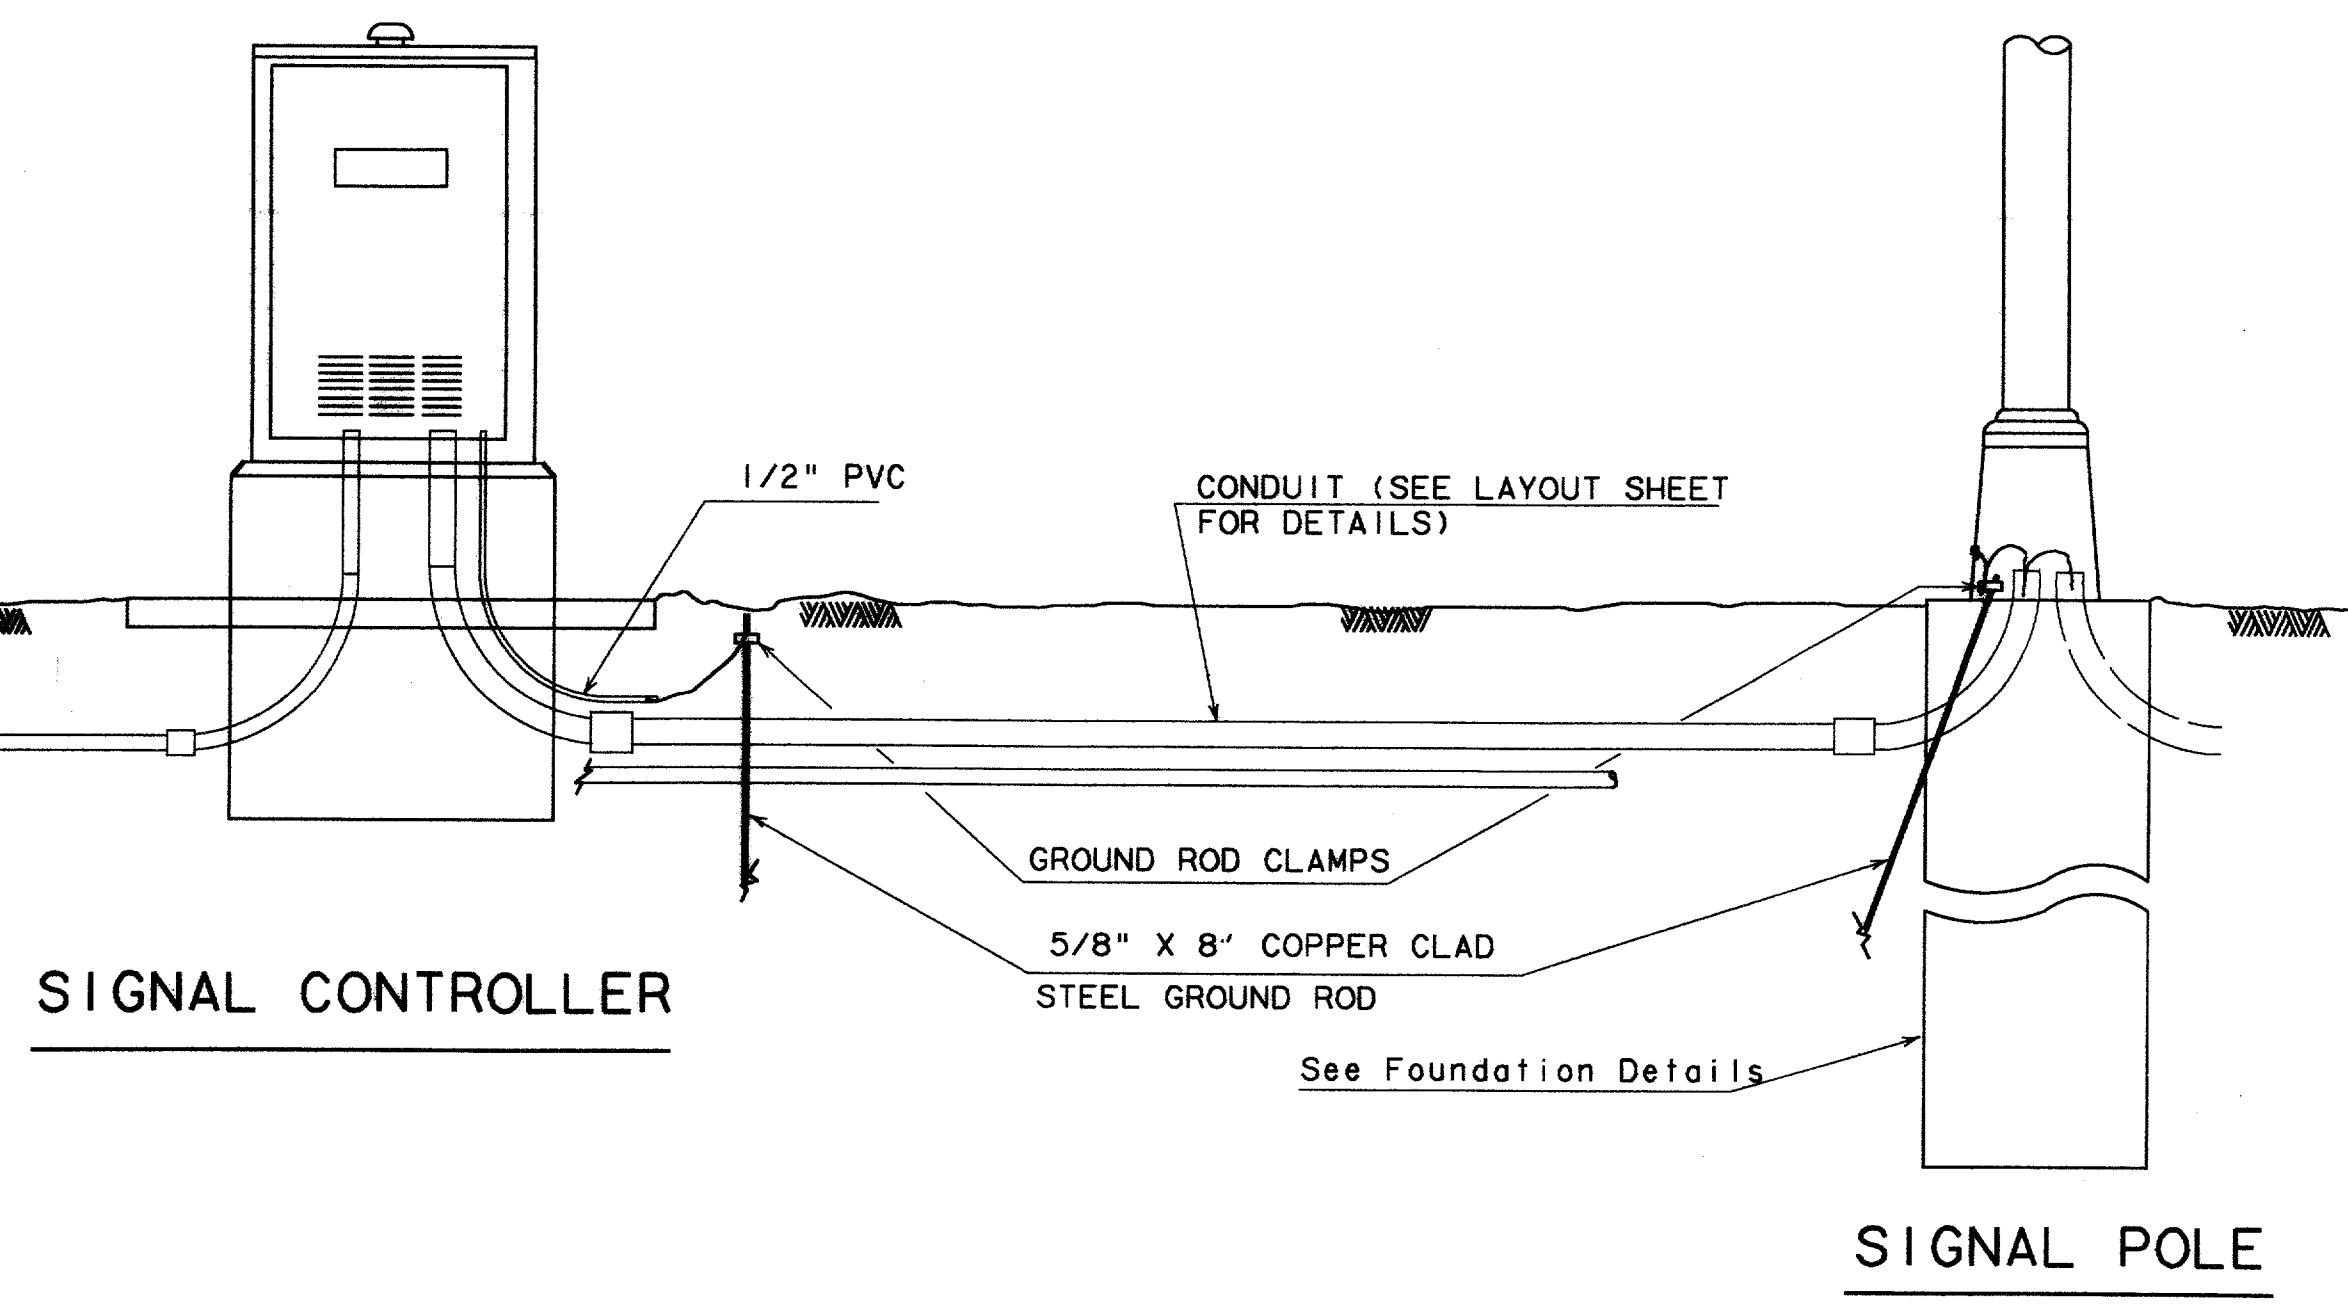


SEE LAYOUT SHEETS FOR CONDUIT AND CONDUCTOR SIZE AND LOCATION, AND FOR THE LOCATION OF GROUND BOXES AND GROUND RODS.

TYPE D SERVICE POLE


(TIMBER POLE SHOWN, SEE ELECTRICAL DETAILS, LAYOUT SHEETS, AND ELECTRICAL SERVICE DATA SHEET FOR SERVICE REQUIRED AND FOR DETAILS.)

RECORD DOCUMENTS 6/9/2000

THESE RECORD DOCUMENTS HAVE BEEN PREPARED BASED ON INFORMATION PROVIDED BY OTHERS. THE CONSULTANT HAS NOT VERIFIED THE ACCURACY AND/OR COMPLETENESS OF THIS INFORMATION AND SHALL NOT BE RESPONSIBLE FOR ANY ERRORS OR OMISSIONS THAT MAY BE INCORPORATED AS A RESULT OF ERRONEOUS INFORMATION PROVIDED BY OTHERS.

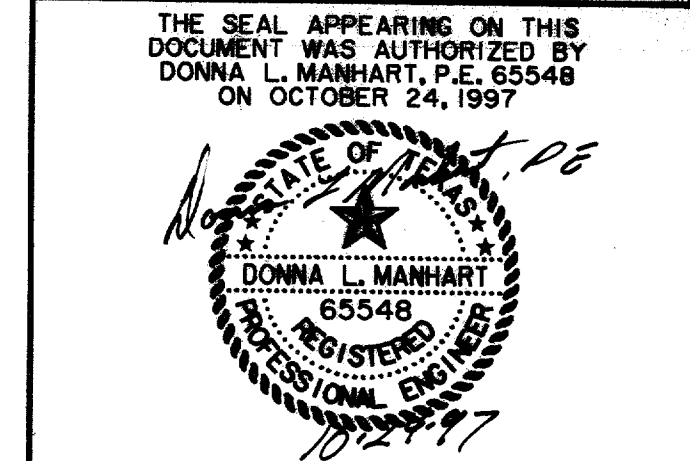


TRAFFIC SIGNAL CABINET POWER, GROUNDING AND LRT SIGNAL MOUNTING						
ARAPAHO ROAD						
ADDISON ROAD TO DALLAS NORTH TOLLWAY						
TOWN OF ADDISON, TEXAS						
Huitt-Zollars, Inc./Consulting Engineers Dallas, Fort Worth, Houston, Phoenix, Tustin						
DESIGN	DRAWN	APPR.	SCALE	DATE	PROJECT NO.	NO.
HZI	HZI	DLM	NTS	OCT 97	1772-01	S-12

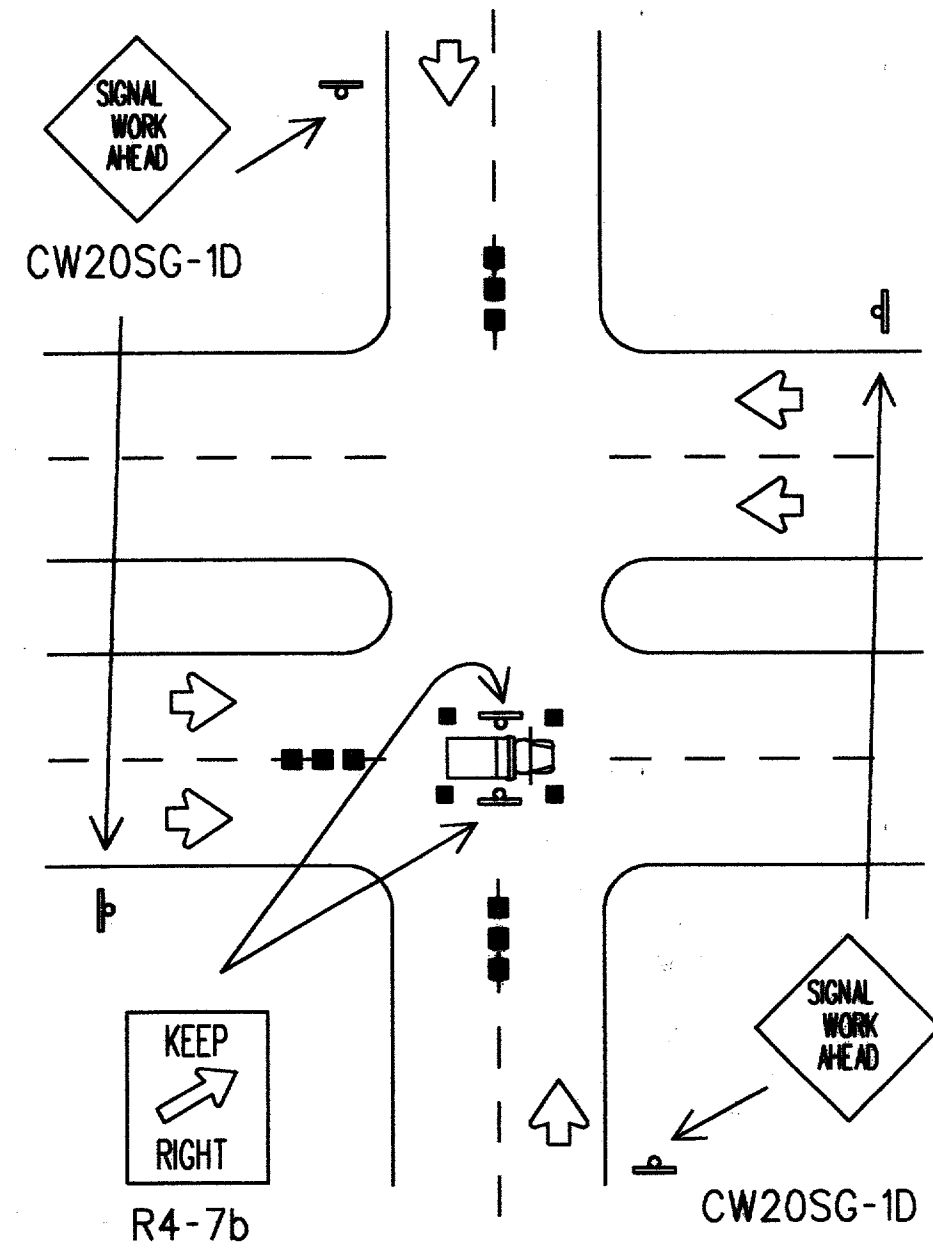

TYPICAL HANGING SIGNAL INSTALLATIONS


Advance warning channelizing devices are optional.

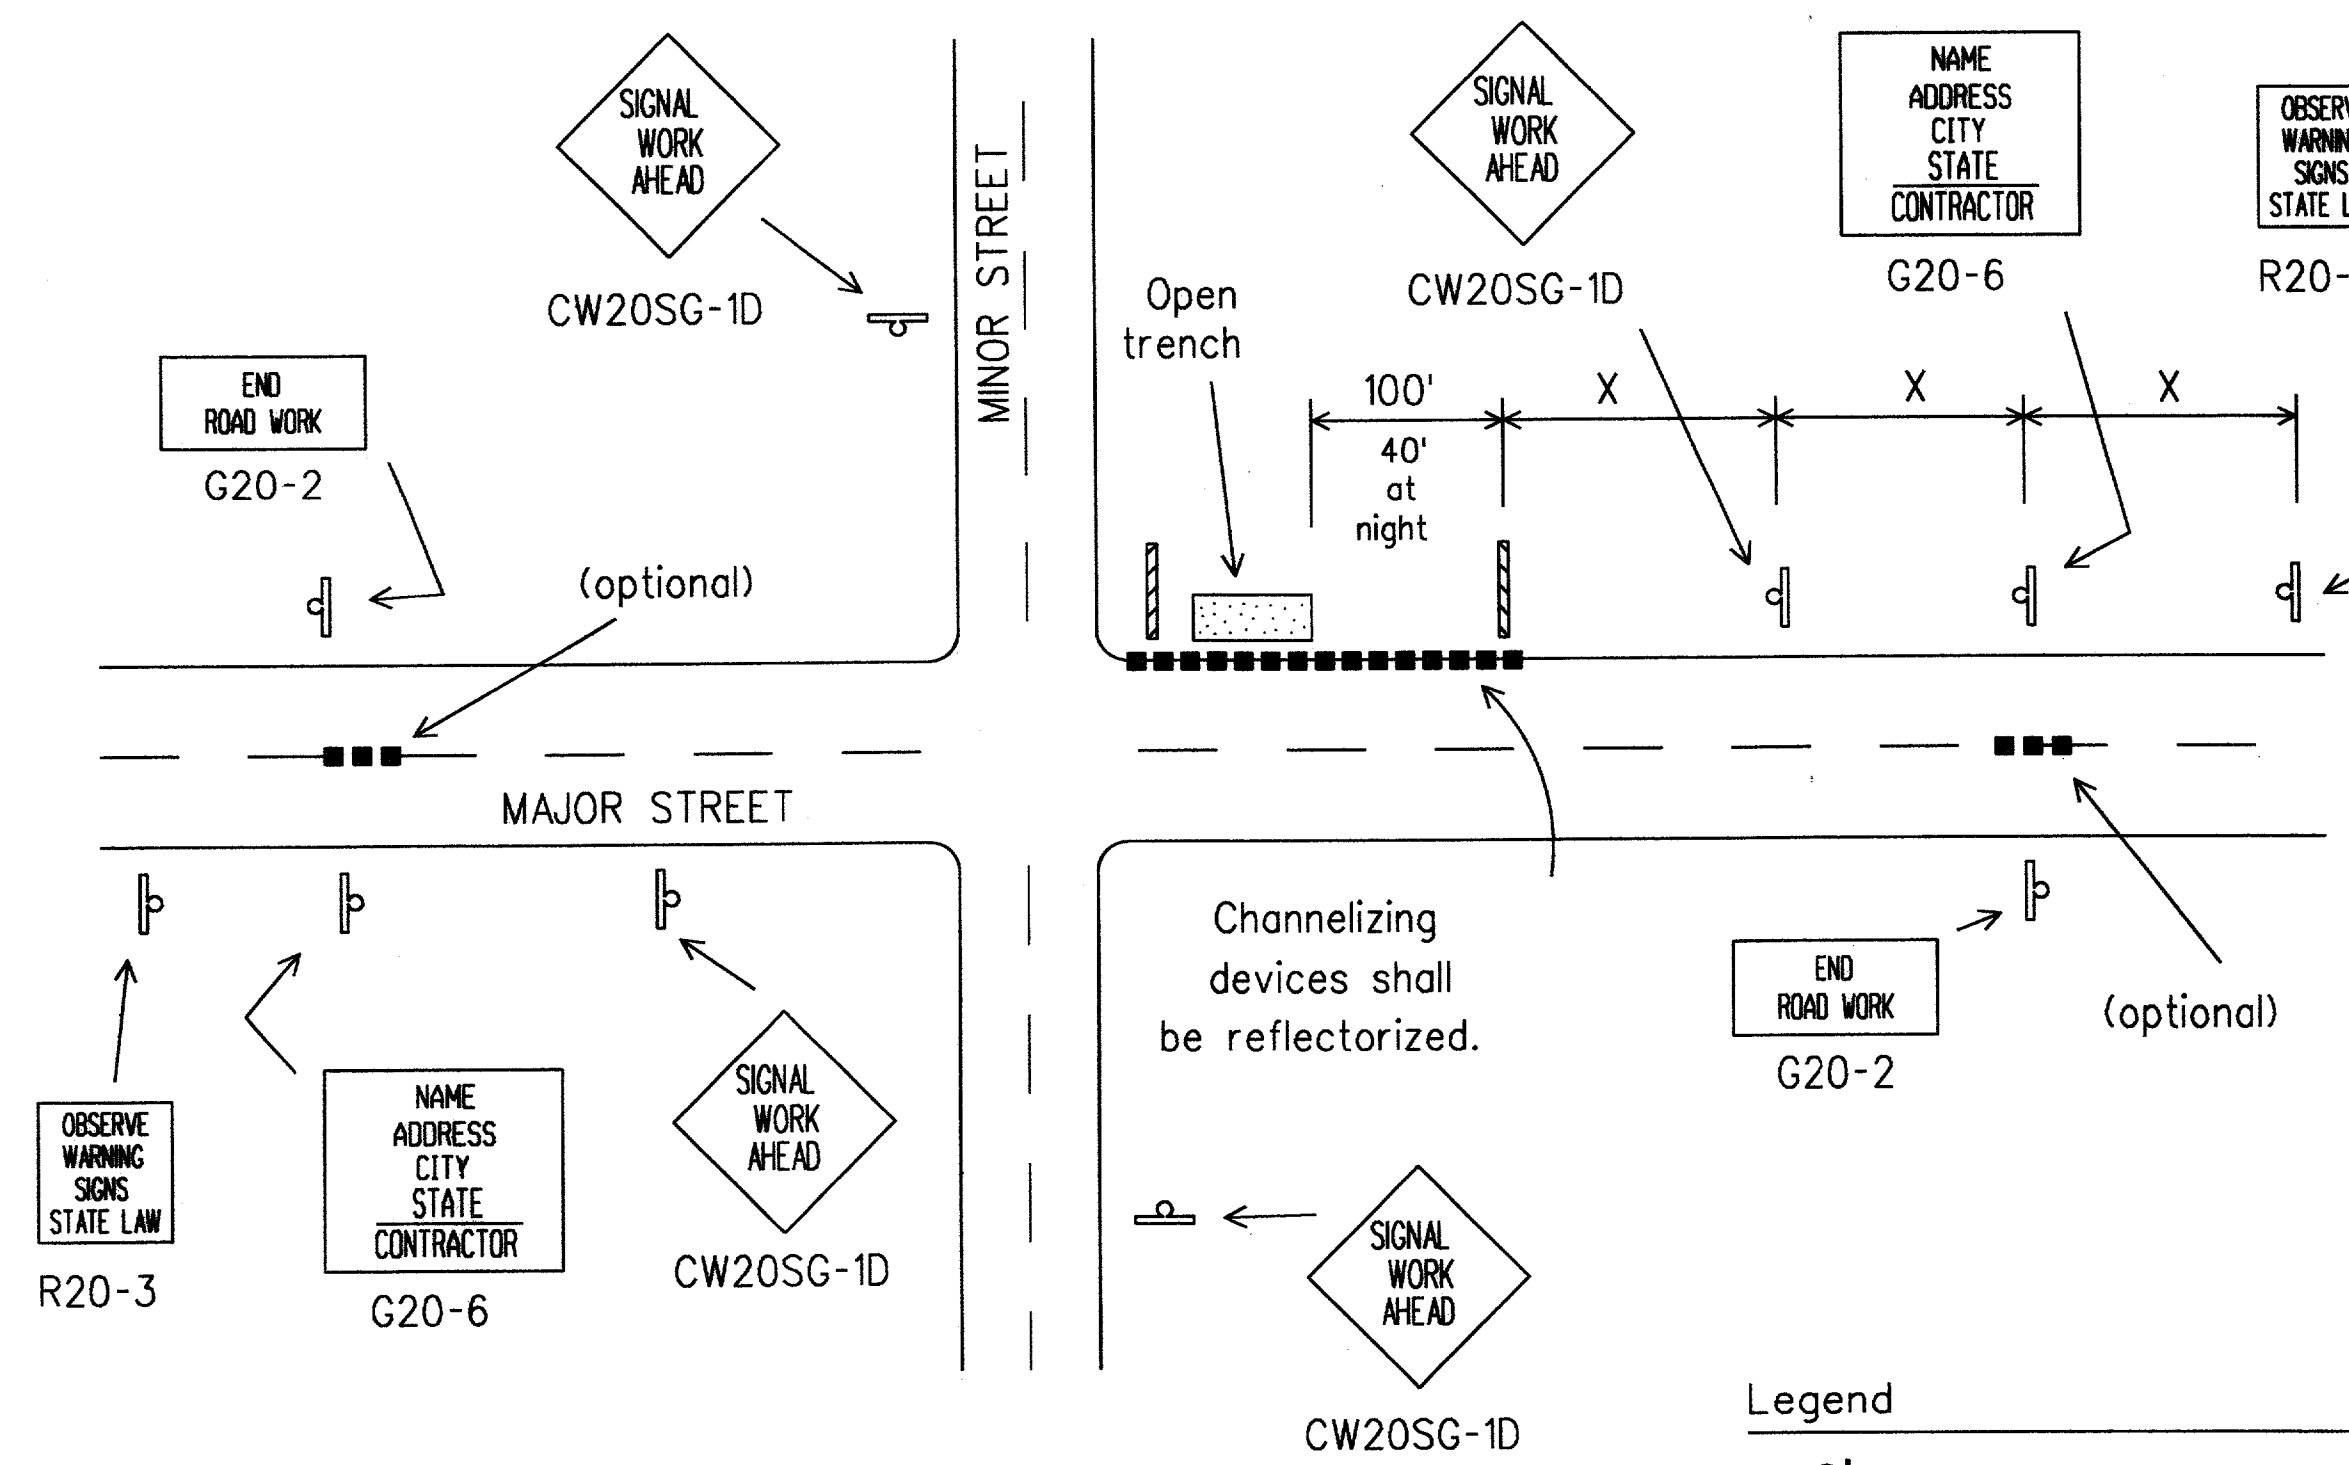

TYPICAL ADVANCE SIGNING

Legend

- Heavy Work Vehicle
- Type I Barricade
- Channelizing Devices

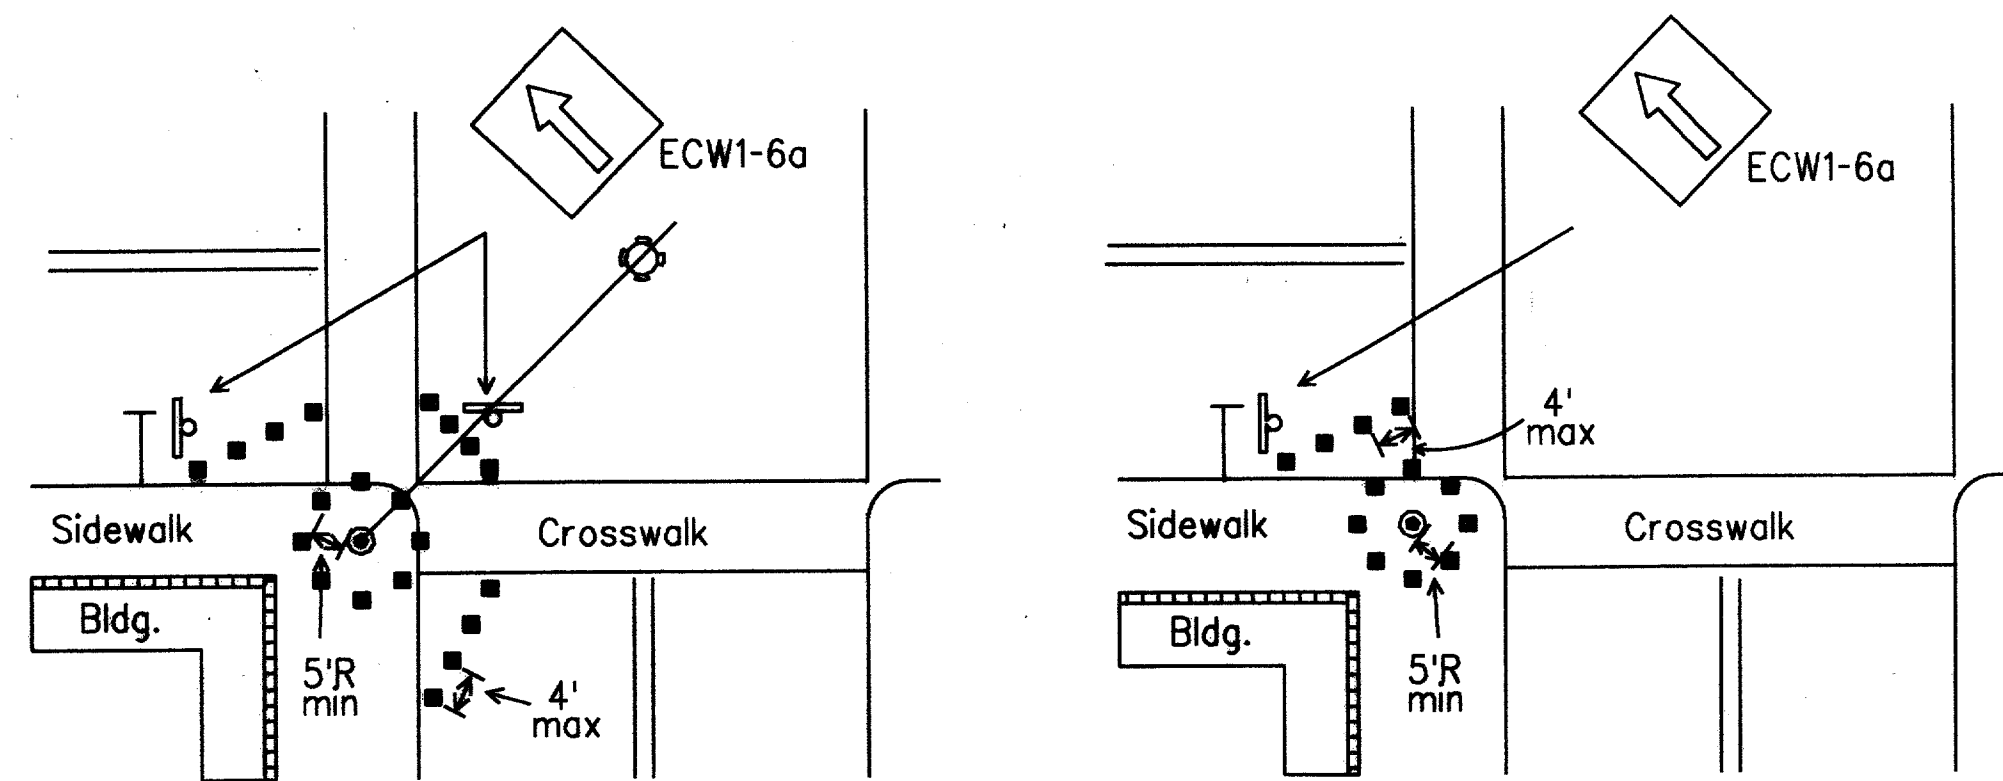

Channelizing devices should not be placed closer than 5 foot radius (minimum) to signal poles.
 Parking may be eliminated by placing channelizing devices in spaces.
 If pedestrian walkways are blocked, refer to TMUTCD.

TYPICAL RESTRICTED PEDESTRIAN MOVEMENTS

Typical channelizing device is the 28" cone. Plastic drums may be used if approved by the Engineer. Metal drums shall NOT be used as a channelizing device or sign support.

For several closely adjoining projects, advance signing may not be required in advance of each intersection, but only in advance of the intersections at the project limits. See details elsewhere in the plans for advance signing requirements.


Advance signs and barricades shall be in place when signal construction operations are in progress. The contractor may remove advance signs and barricades when no construction operations are underway if permitted elsewhere in the plans. Obstructions or hazards at the work area shall be clearly marked and delineated at all times.

All holes, trenches or other hazardous areas shall be adequately protected by barricades, lights or other protective devices. Trenches shall be covered or surrounded with orange plastic construction fence as directed by the Engineer.


Flagger and FCW20-7a sign may be required according to field conditions. Vehicles parked in roadway shall be equipped with two strobes. High level flags at corners of vehicle may also be used. Work operations that require work vehicle in traveled way 20 minutes or less may use cones, high level flags and strobes as advance warning devices. Cones should only be placed around vehicle. Flaggers may be used on high speed rural intersections.

RECORD DOCUMENTS 6/9/2000


THESE RECORD DOCUMENTS HAVE BEEN PREPARED BASED ON INFORMATION PROVIDED BY OTHERS. THE CONSULTANT HAS NOT VERIFIED THE ACCURACY AND/OR COMPLETENESS OF THIS INFORMATION AND SHALL NOT BE RESPONSIBLE FOR ANY ERRORS OR OMISSIONS THAT MAY BE INCORPORATED AS A RESULT OF ERRONEOUS INFORMATION PROVIDED BY OTHERS.

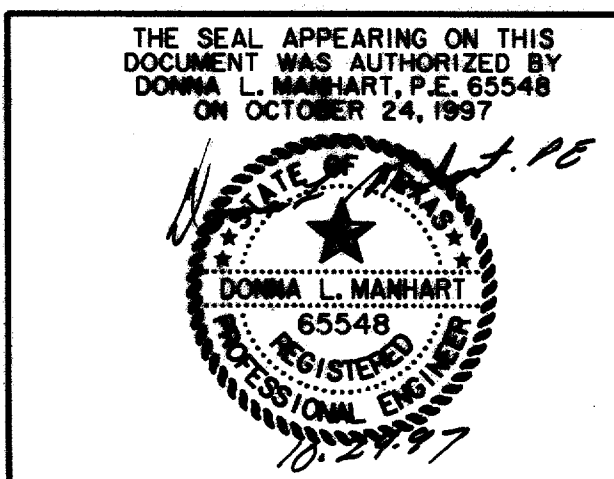


TRAFFIC SIGNAL INSTALLATION TYPICAL DETAILS						
ARAPAHO ROAD						
ADDISON ROAD TO DALLAS NORTH TOLLWAY						
TOWN OF ADDISON, TEXAS						
Hull-Zollars, Inc./Consulting Engineers Dallas, Fort Worth, Houston, Phoenix, Tulsa						
DESIGN	DRAWN	APPR.	SCALE	DATE	PROJECT NO.	NO.
HZI	HZI	DLM	NTS	OCT 97	1772-01	S-13

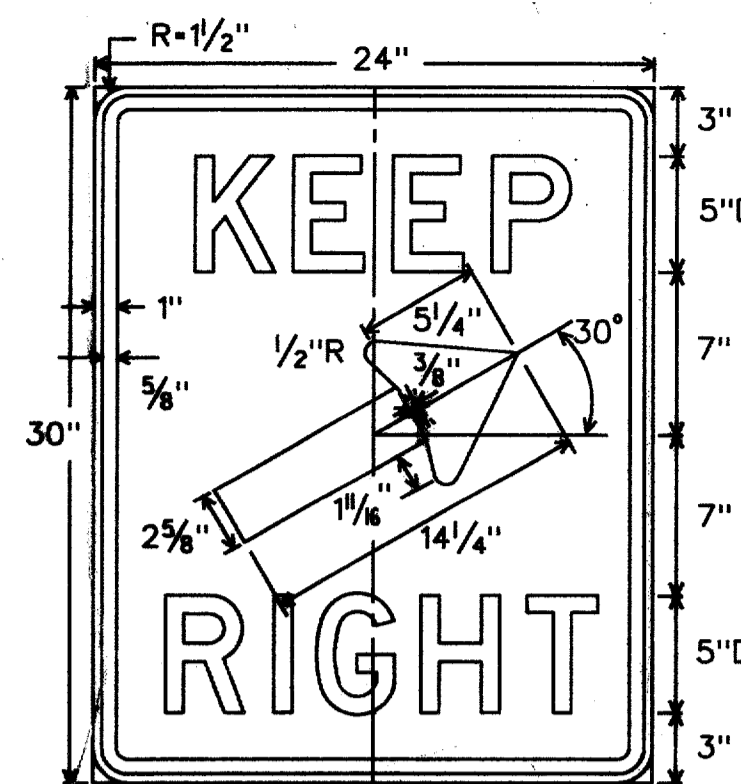


R4-7b Letters - Black
Symbol - Black
Border - Black
Background - White Refl.
24" X 30"

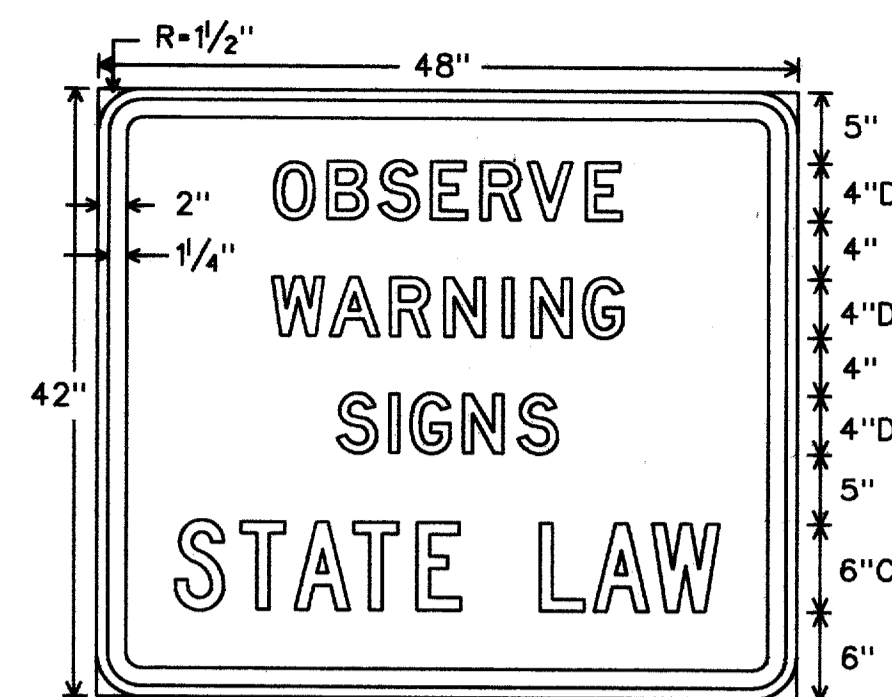


R20-3 Letters - Black
Border - Black
Background - White Refl.
48" X 42"

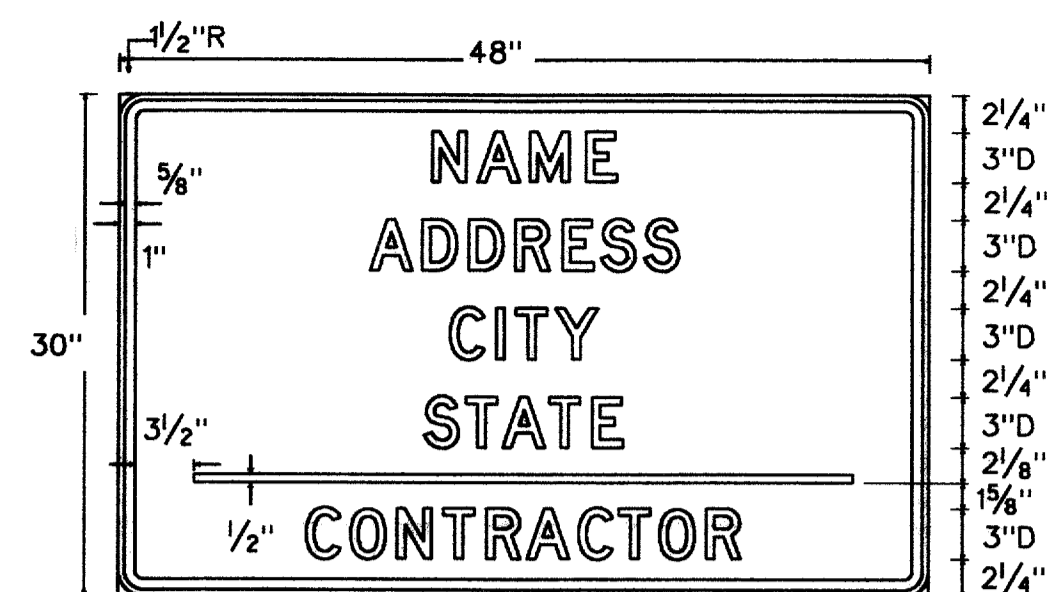


G20-6 Letters - Black
Border - Black
Background - Orange or White Refl.
48" X 30"

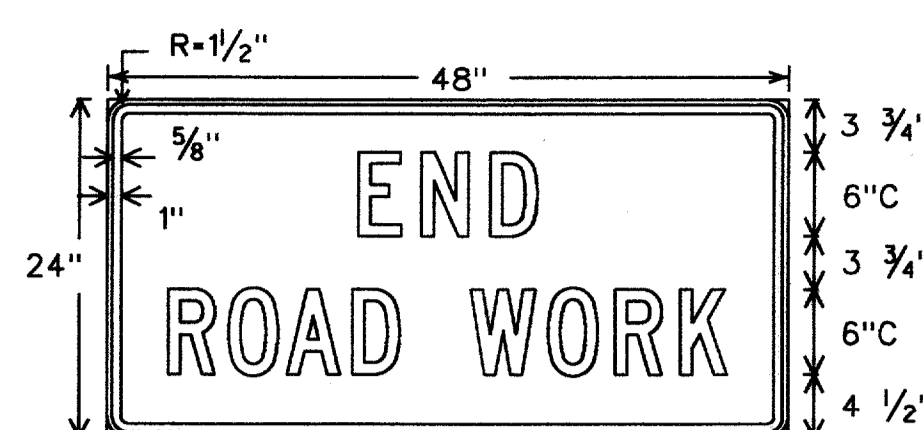

G20-2a Letters - Black
Border - Black
Background - Orange Refl.
48" X 24"

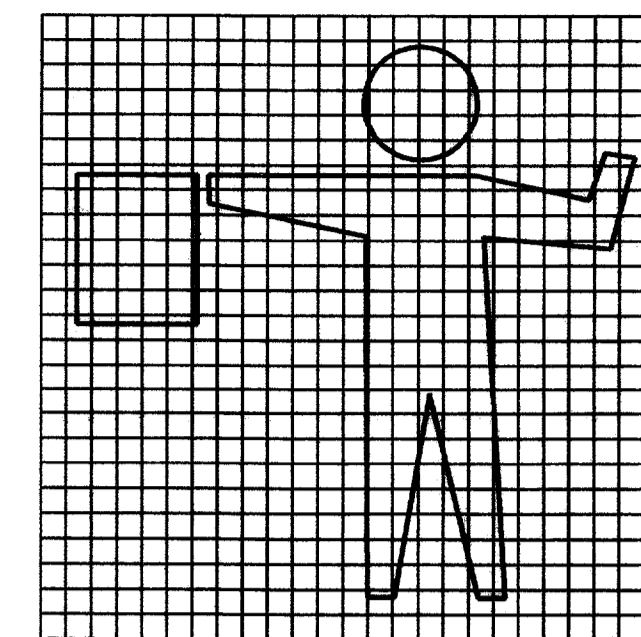


R4-8b

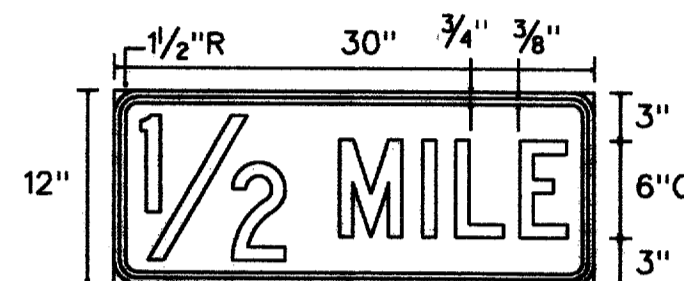

Distance Plaque
30" X 12"

Alternate legends

- 1 MILE 6" C
- 1500 FT 6" C
- 1000 FT 6" C
- 500 FT 6" C

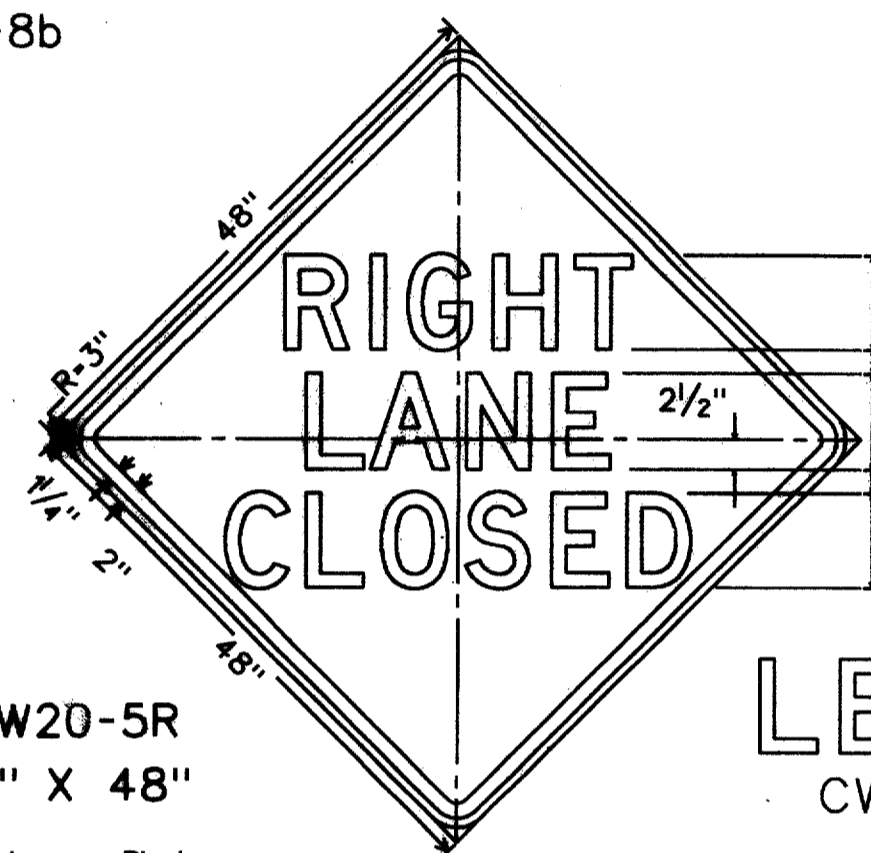


CW20-5R
48" X 48"

Legend - Black
Border - Black
Background - Orange Refl.




CW20-5L

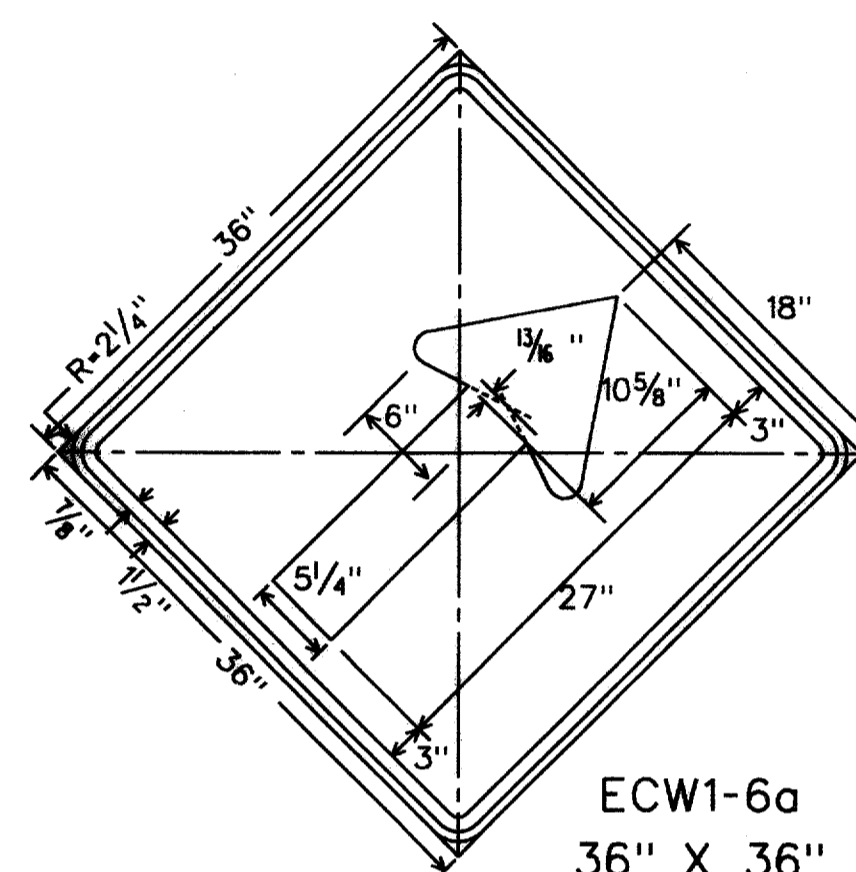

CW20SG-1D
48" X 48"

Letters - Black
Border - Black
Background - Orange Refl.

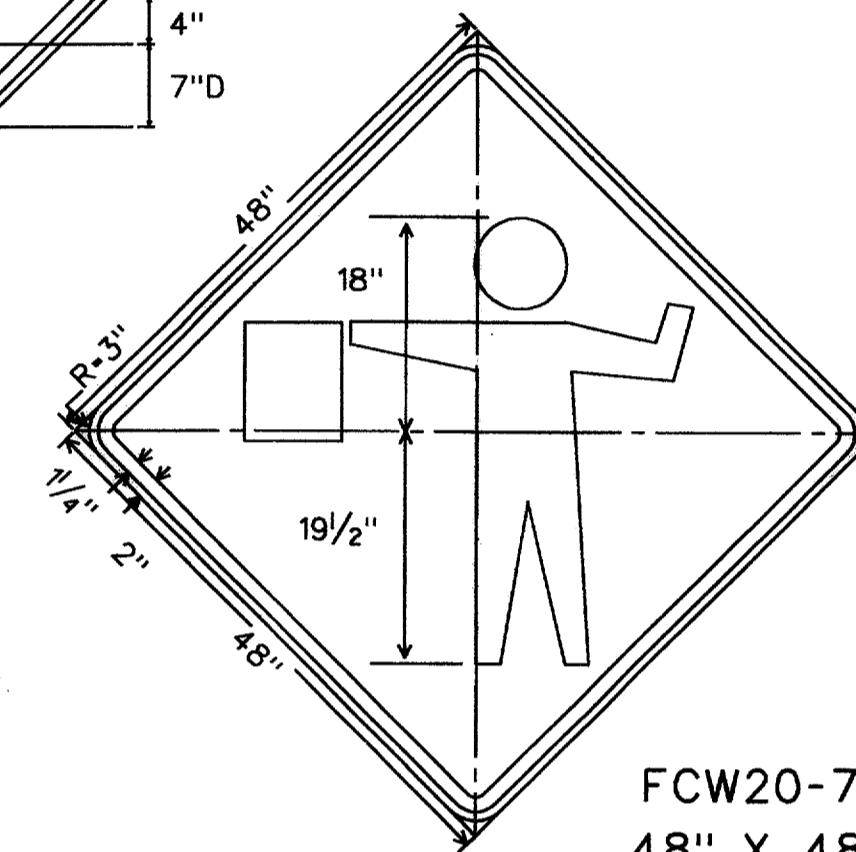


FCW20-7a
48" X 48"


Legend - Black
Border - Black
Background - Orange Refl.

TYPICAL SIGNS USED IN TRAFFIC SIGNAL CONSTRUCTION AREAS

TYPE I BARRICADES

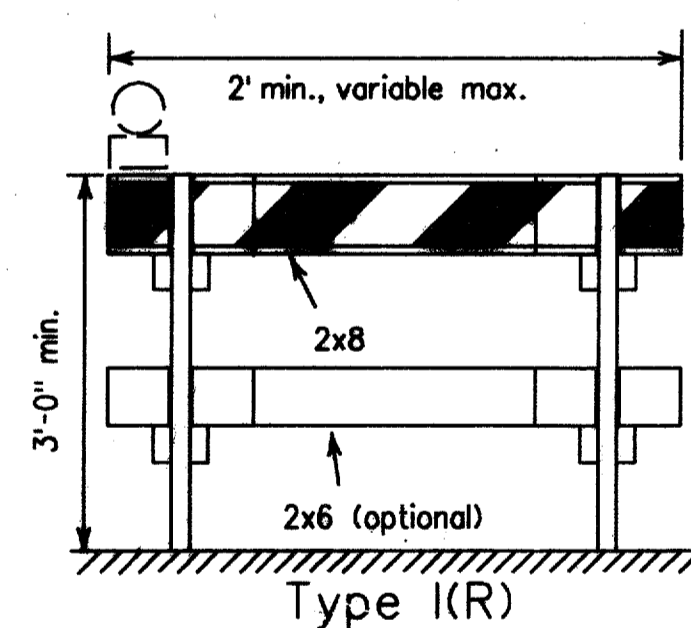

Type I(R)

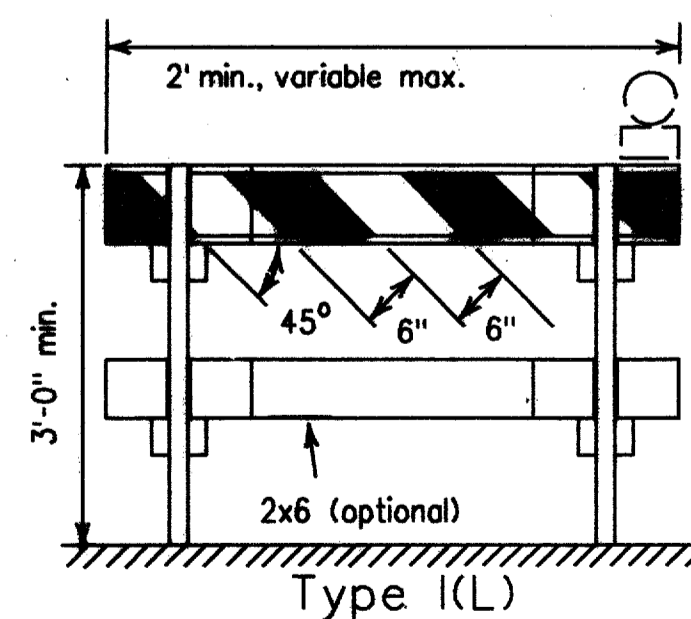


Type I(L)


For Type I and II Barricades, both sides of the rails shall have reflective orange and reflective white striping.

TYPICAL SIGN SUPPORTS

FIXED SUPPORTS

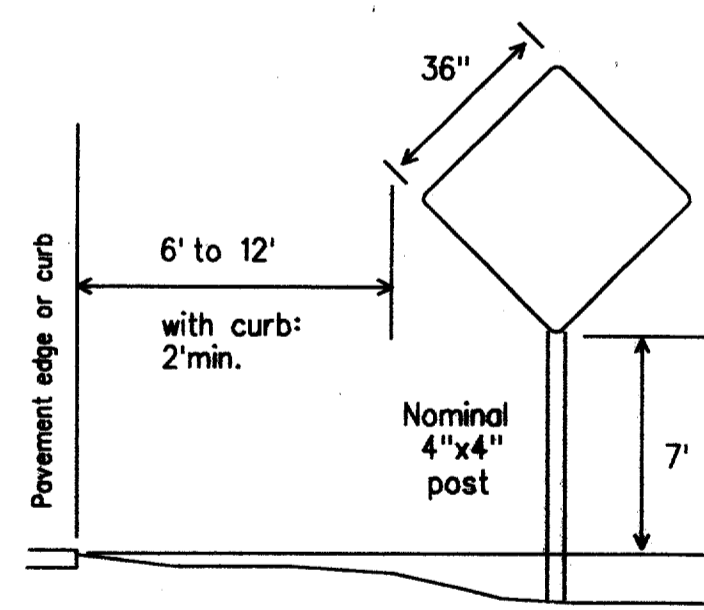


WOOD POST SIGN SUPPORT: for 36" x 36" and smaller warning signs, and other signs having an area not exceeding 10 sq.ft.

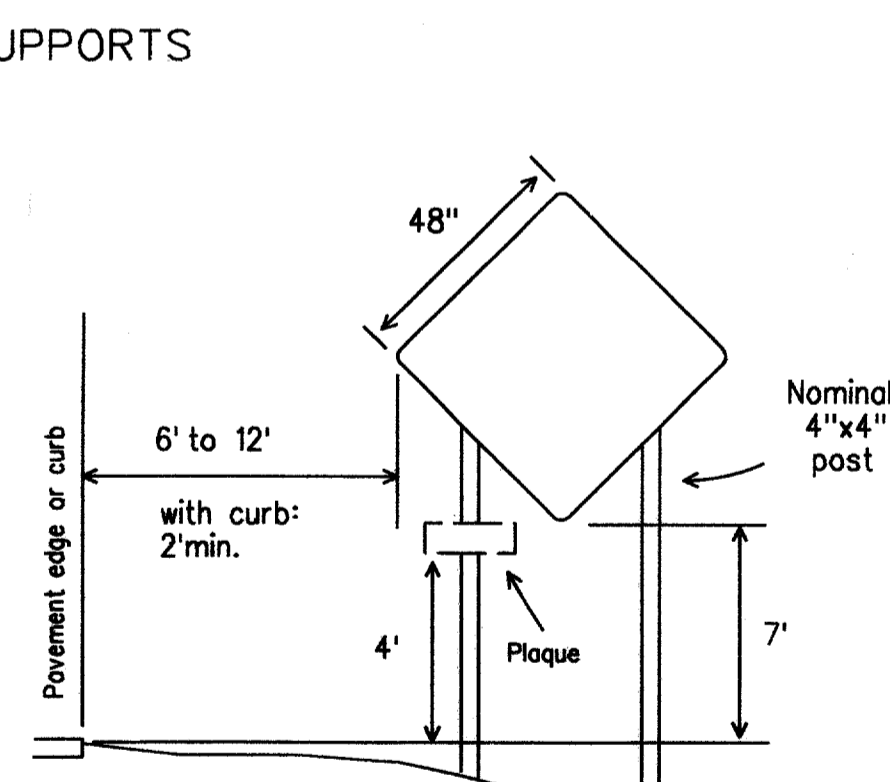

WOOD POST SIGN SUPPORT: for 48" x 48" warning sign.

Signs erected on fixed supports shall be at a minimum height of 7 feet. Embedment depth for wood sign supports and post type barricades should be 3 feet minimum, unless specified elsewhere in the plans. Driveable sign supports may be used and shall be installed in accordance with the manufacturers recommendations.

PORTABLE SUPPORTS

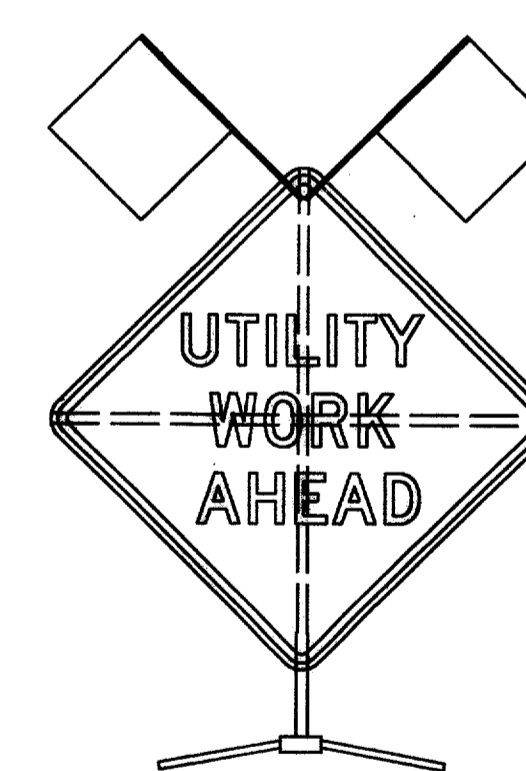

SIGN SUPPORT WEIGHTS

Where sign supports require the use of weights to keep from turning over, the use of some type of sandbag is recommended. The use of pieces of rock, concrete, iron, steel or other solid objects will not be permitted. Sandbags shall only be placed along or upon the base supports of the device and shall not be suspended above ground level or hung with rope, wire, chains or other fasteners.


REMOVING OR COVERING

When sign messages may be confusing or no longer apply, the signs and supports shall be removed from roadway and shoulder, or the signs shall be completely covered. Turning signs from motorists view will not be allowed. When signs are covered the material used shall be opaque, such as heavy mil black plastic. Burlap shall not be used to cover signs. Signs shall be removed upon completion of the work.

Duct tape or other adhesive material shall not be affixed to sign face.

RECORD DOCUMENTS 6/9/2000

THESE RECORD DOCUMENTS HAVE BEEN PREPARED BASED ON INFORMATION PROVIDED BY OTHERS. THE CONSULTANT HAS NOT VERIFIED THE ACCURACY AND/OR COMPLETENESS OF THIS INFORMATION AND SHALL NOT BE RESPONSIBLE FOR ANY ERRORS OR OMISSIONS THAT MAY BE INCORPORATED AS A RESULT OF ERRONEOUS INFORMATION PROVIDED BY OTHERS.

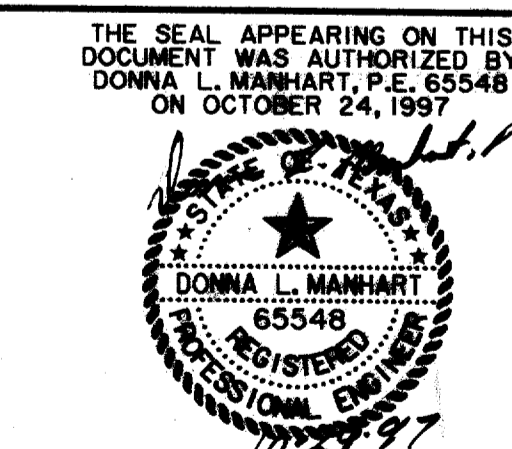


TRAFFIC SIGNAL INSTALLATION BARRICADES AND SIGNS						
ARAPAHO ROAD						
ADDISON ROAD TO DALLAS NORTH TOLLWAY						
TOWN OF ADDISON, TEXAS						
Huitt-Zollars, Inc./Consulting Engineers Dallas, Fort Worth, Houston, Phoenix, Tustin						
DESIGN	DRAWN	APPR.	SCALE	DATE	PROJECT NO.	NO.
HZI	HZI	DLM	NTS	OCT 97	1772-01	S-14

STATION	EXCAVATION AREA (SF)	EMBANKMENT AREA (SF)	EXCAVATION VOLUME (CY)	EMBANKMENT VOLUME (CY)	15% SHRINK. VOLUME (CY)	TOTAL EMBANK. VOLUME (CY)	NET VOLUME (CY)	MASS VOLUME (CY)	STATION
4,035.36	0.00	0.00	0.00	0.00	0.00	0.00	0.00	0.00	4,035.36
4,050.00	5.67	22.50	1.54	6.10	0.91	7.01	(5.48)	(5.48)	4,050.00
4,100.00	34.38	18.54	37.08	38.00	5.70	43.70	(6.62)	(12.09)	4,100.00
4,150.00	18.54	25.47	49.00	40.75	6.11	46.86	2.14	(9.96)	4,150.00
4,200.00	48.24	30.06	61.83	51.42	7.71	59.13	2.70	(7.25)	4,200.00
4,250.00	88.92	34.11	127.00	59.42	8.91	68.33	58.67	51.42	4,250.00
4,300.00	84.51	40.23	160.58	68.83	10.33	79.16	81.43	132.84	4,300.00
4,350.00	98.28	33.39	169.25	68.17	10.23	78.39	90.86	223.70	4,350.00
4,400.00	118.17	32.22	200.42	60.75	9.11	69.86	130.55	354.26	4,400.00
4,450.00	128.07	0.00	228.00	29.83	4.48	34.31	193.69	547.95	4,450.00
4,500.00	97.11	1.35	208.50	1.25	0.19	1.44	207.06	755.01	4,500.00
4,550.00	110.61	2.52	192.33	3.58	0.54	4.12	188.21	943.22	4,550.00
4,600.00	36.00	7.29	135.75	9.08	1.36	10.45	125.30	1,068.53	4,600.00
4,650.00	45.99	6.75	75.92	13.00	1.95	14.95	60.97	1,129.49	4,650.00
4,700.00	28.25	19.91	68.74	24.69	3.70	28.39	40.35	1,169.85	4,700.00
4,750.00	2.43	78.45	28.41	91.07	13.66	104.74	(76.33)	1,093.52	4,750.00
4,800.00	93.48	1.26	88.81	73.81	11.07	84.88	3.93	1,097.45	4,800.00
4,850.00	189.48	0.00	262.00	1.17	0.18	1.34	260.66	1,358.11	4,850.00
4,900.00	241.38	0.00	398.94	0.00	0.00	0.00	398.94	1,757.05	4,900.00
4,950.00	256.74	0.00	461.22	0.00	0.00	0.00	461.22	2,218.27	4,950.00
5,000.00	377.01	0.00	586.81	0.00	0.00	0.00	586.81	2,805.08	5,000.00
5,050.00	374.94	0.00	696.25	0.00	0.00	0.00	696.25	3,501.33	5,050.00
5,100.00	415.34	0.00	731.74	0.00	0.00	0.00	731.74	4,233.07	5,100.00
5,150.00	250.72	0.00	616.72	0.00	0.00	0.00	616.72	4,849.79	5,150.00
5,200.00	142.62	0.00	364.20	0.00	0.00	0.00	364.20	5,213.99	5,200.00
5,250.00	12.45	0.00	143.58	0.00	0.00	0.00	143.58	5,357.58	5,250.00
5,300.00	62.64	9.90	69.53	9.17	1.38	10.54	58.99	5,416.56	5,300.00
5,350.00	7.29	68.13	64.75	72.25	10.84	83.09	(18.34)	5,398.23	5,350.00
5,400.00	4.32	69.84	10.75	127.75	19.16	146.91	(136.16)	5,262.06	5,400.00
5,450.00	8.82	57.96	12.17	118.33	17.75	136.08	(123.92)	5,138.15	5,450.00
5,500.00	15.66	55.08	22.67	104.67	15.70	120.37	(97.70)	5,040.45	5,500.00
5,550.00	29.34	24.30	41.67	73.50	11.03	84.53	(42.86)	4,997.59	5,550.00
5,600.00	53.19	50.22	76.42	69.00	10.35	79.35	(2.93)	4,994.66	5,600.00
5,650.00	277.92	11.16	306.58	56.83	8.53	65.36	241.23	5,235.88	5,650.00
5,700.00	343.89	5.40	575.75	15.33	2.30	17.63	558.12	5,794.00	5,700.00
5,750.00	224.91	25.47	526.67	28.58	4.29	32.87	493.80	6,287.79	5,750.00
5,800.00	197.10	34.20	390.75	55.25	8.29	63.54	327.21	6,615.01	5,800.00
5,850.00	172.17	29.52	341.92	59.00	8.85	67.85	274.07	6,889.07	5,850.00
5,900.00	140.49	39.78	289.50	64.17	9.63	73.79	215.71	7,104.78	5,900.00
5,950.00	110.43	50.94	232.33	84.00	12.60	96.60	135.73	7,240.51	5,950.00
6,000.00	79.29	48.69	175.67	92.25	13.84	106.09	69.58	7,310.09	6,000.00
6,050.00	60.57	60.57	129.50	101.17	15.18	116.34	13.16	7,323.25	6,050.00
6,100.00	16.56	23.13	71.42	77.50	11.63	89.13	(17.71)	7,305.54	6,100.00
6,150.00	40.77	4.77	53.08	25.83	3.88	29.71	23.38	7,328.92	6,150.00
6,200.00	39.06	13.59	73.92	17.00	2.55	19.55	54.37	7,383.28	6,200.00
6,250.00	60.57	29.88	92.25	40.25	6.04	46.29	45.96	7,429.25	6,250.00
6,300.00	70.47	18.99	121.33	45.25	6.79	52.04	69.30	7,498.54	6,300.00
6,350.00	93.42	14.22	151.75	30.75	4.61	35.36	116.39	7,614.93	6,350.00
6,400.00	102.24	11.25	181.17	23.58	3.54	27.12	154.05	7,768.98	6,400.00
6,450.00	118.71	4.77	204.58	14.83	2.23	17.06	187.53	7,956.50	6,450.00
6,500.00	158.76	3.15	256.92	7.33	1.10	8.43	248.48	8,204.98	6,500.00
6,550.00	186.66	4.68	319.83	7.25	1.09	8.34	311.50	8,516.48	6,550.00
6,600.00	166.41	2.61	326.92	6.75	1.01	7.76	319.15	8,835.63	6,600.00
6,650.00	277.38	6.30	410.92	8.25	1.24	9.49	401.43	9,237.06	6,650.00
6,700.00	111.42	48.33	360.00	50.58	7.59	58.17	301.83	9,538.89	6,700.00
6,732.64	0.00	0.00	67.35	29.21	4.38	33.59	33.75	9,572.65	6,732.64
TOTALS			12,052.67	2,156.54	323.48	2,480.03	9,572.65	9,572.65	TOTALS

NOTE TO CONTRACTOR:
DO NOT DISPOSE OF EXCESS
EXCAVATION WITHOUT
APPROVAL FROM THE TOWN.

THE SEAL APPEARING ON THIS
DOCUMENT WAS AUTHORIZED BY
KENNETH A. ROBERTS, P.E. 55446
ON OCTOBER 24, 1997










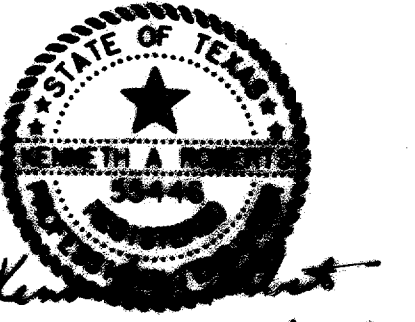


RECORD DOCUMENTS 6/9/2000

THESE RECORD DOCUMENTS HAVE BEEN PREPARED BASED ON
INFORMATION PROVIDED BY OTHERS. THE CONSULTANT HAS
NOT VERIFIED THE ACCURACY AND/OR COMPLETENESS OF THIS
INFORMATION AND SHALL NOT BE RESPONSIBLE FOR ANY
ERRORS OR OMISSIONS THAT MAY BE INCORPORATED AS A
RESULT OF ERRONEOUS INFORMATION PROVIDED BY OTHERS.


CROSS SECTIONS						
MASS VOLUME DATA						
ARAPAHO ROAD						
ADDISON ROAD TO DALLAS NORTH TOLLWAY						
TOWN OF ADDISON, TEXAS						
Huitt-Zollars, Inc./Consulting Engineers Dallas, Fort Worth, Houston, Phoenix, Tustin						
DESIGN	DRAWN	APPR.	SCALE	DATE	PROJECT NO.	NO.
HZI	HZI	KAR	NTS	OCT 97	1772-01	X-1

FULL SECTIONS ARE TAKEN EVERY 50'
HALF SECTIONS ARE TAKEN AT DRIVEWAYS

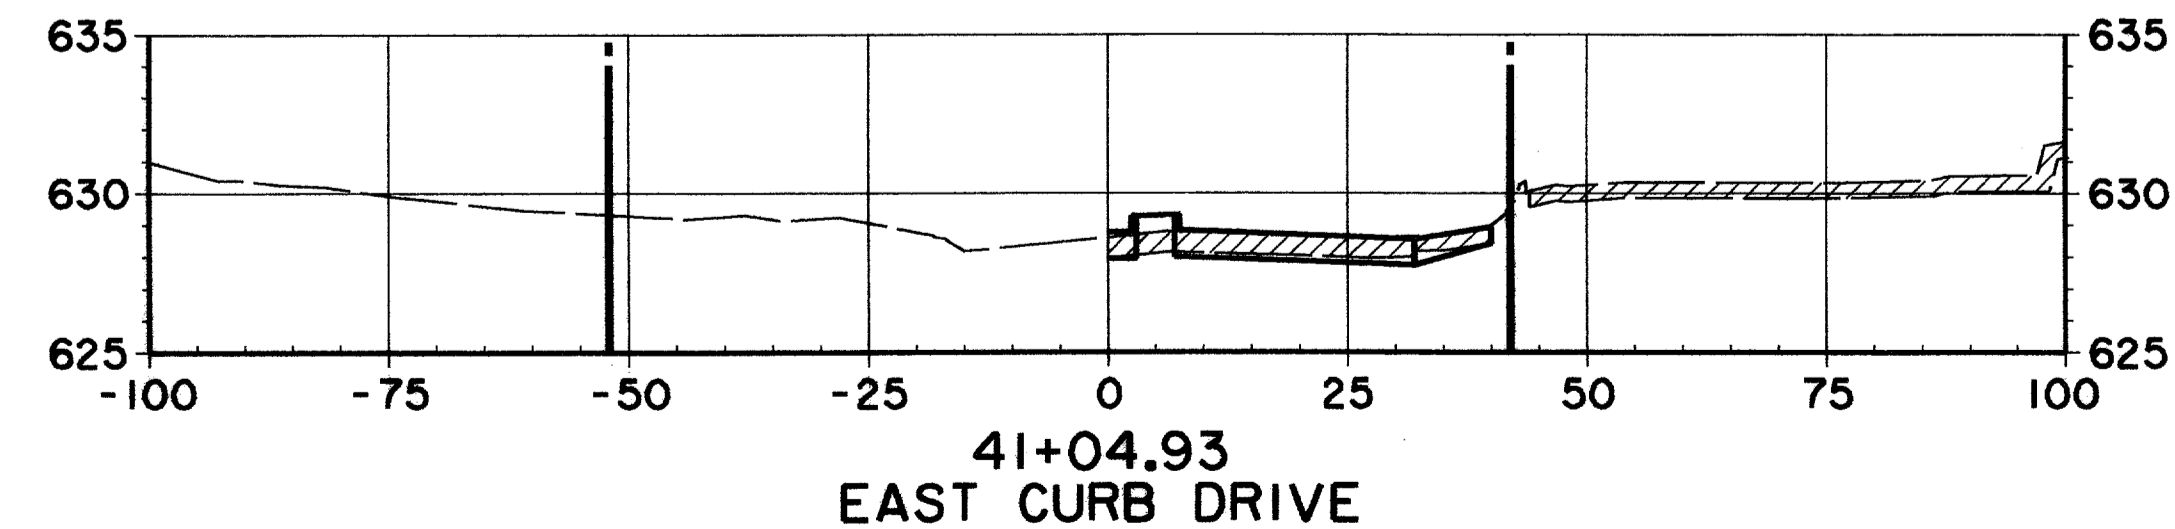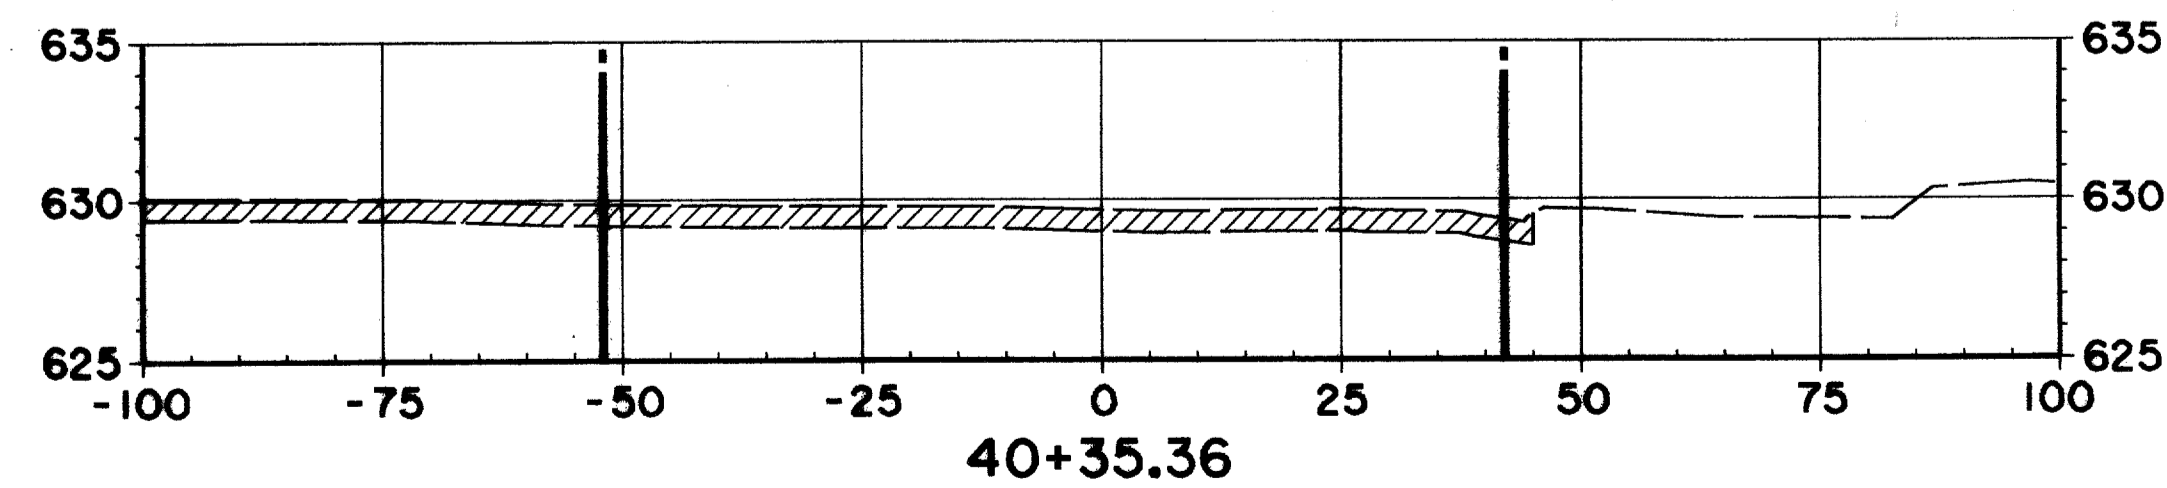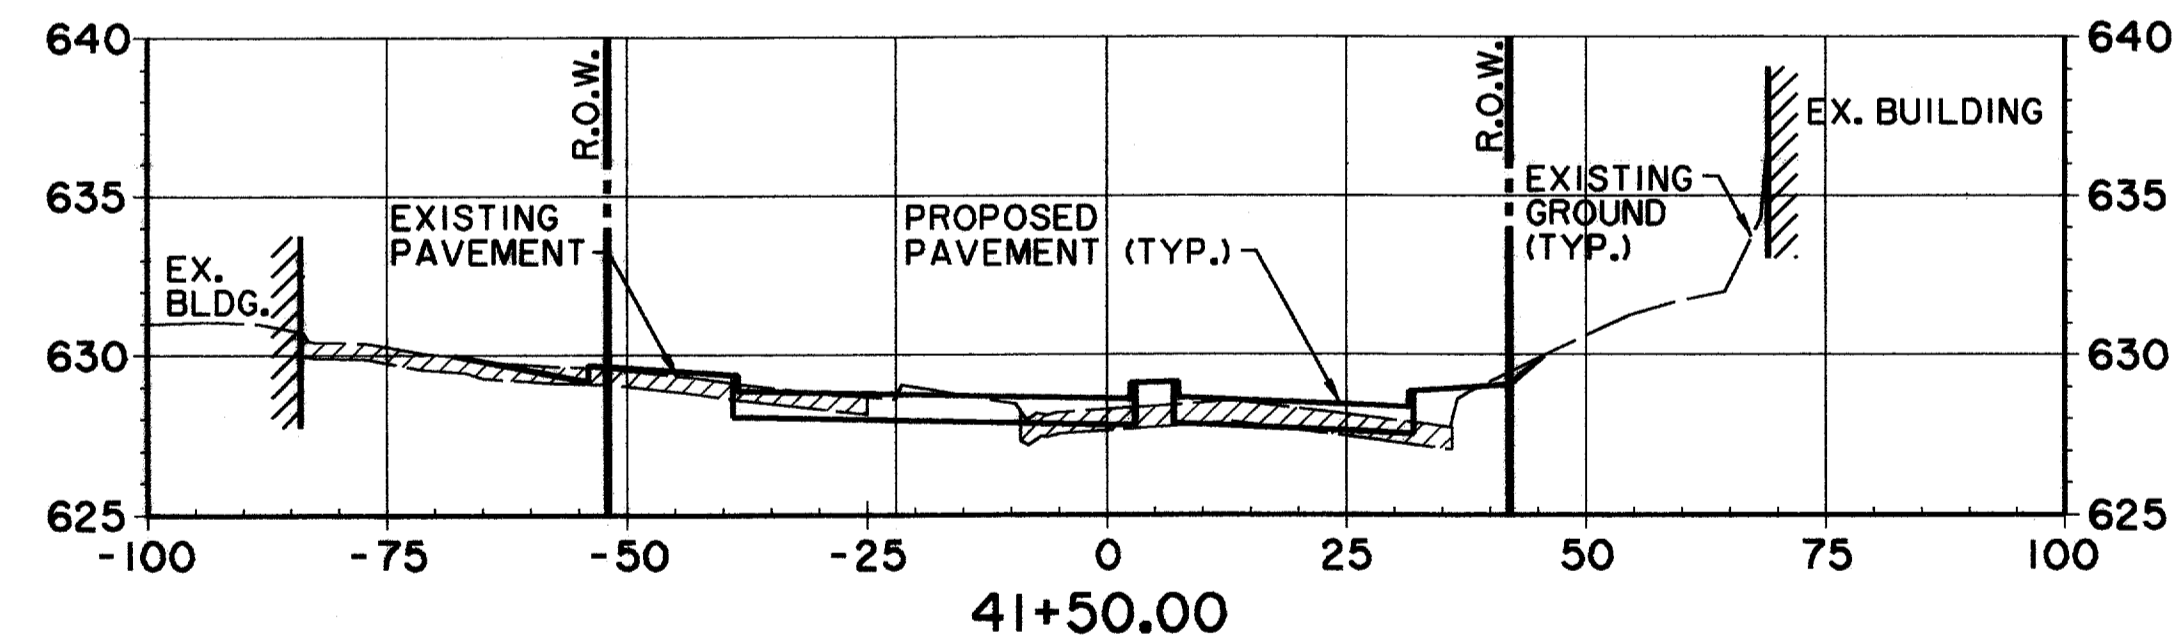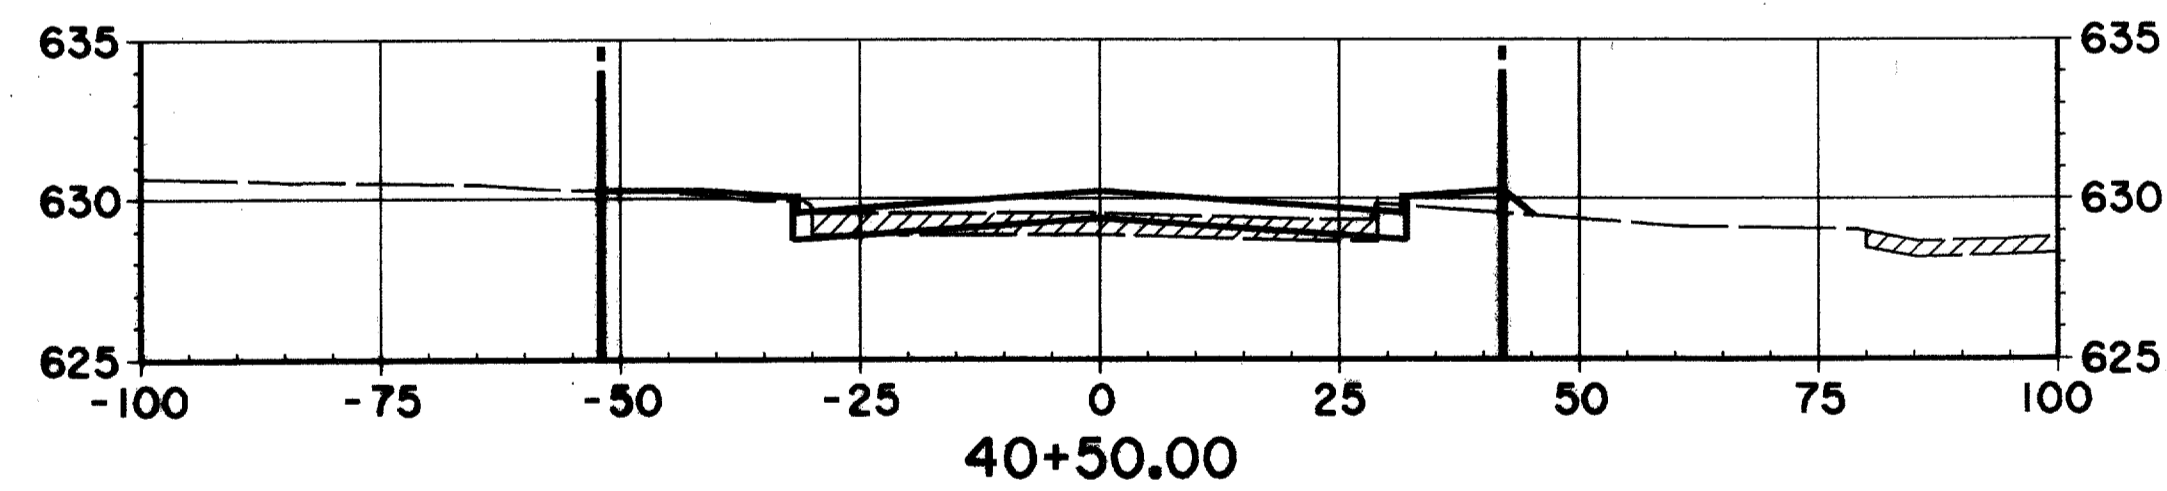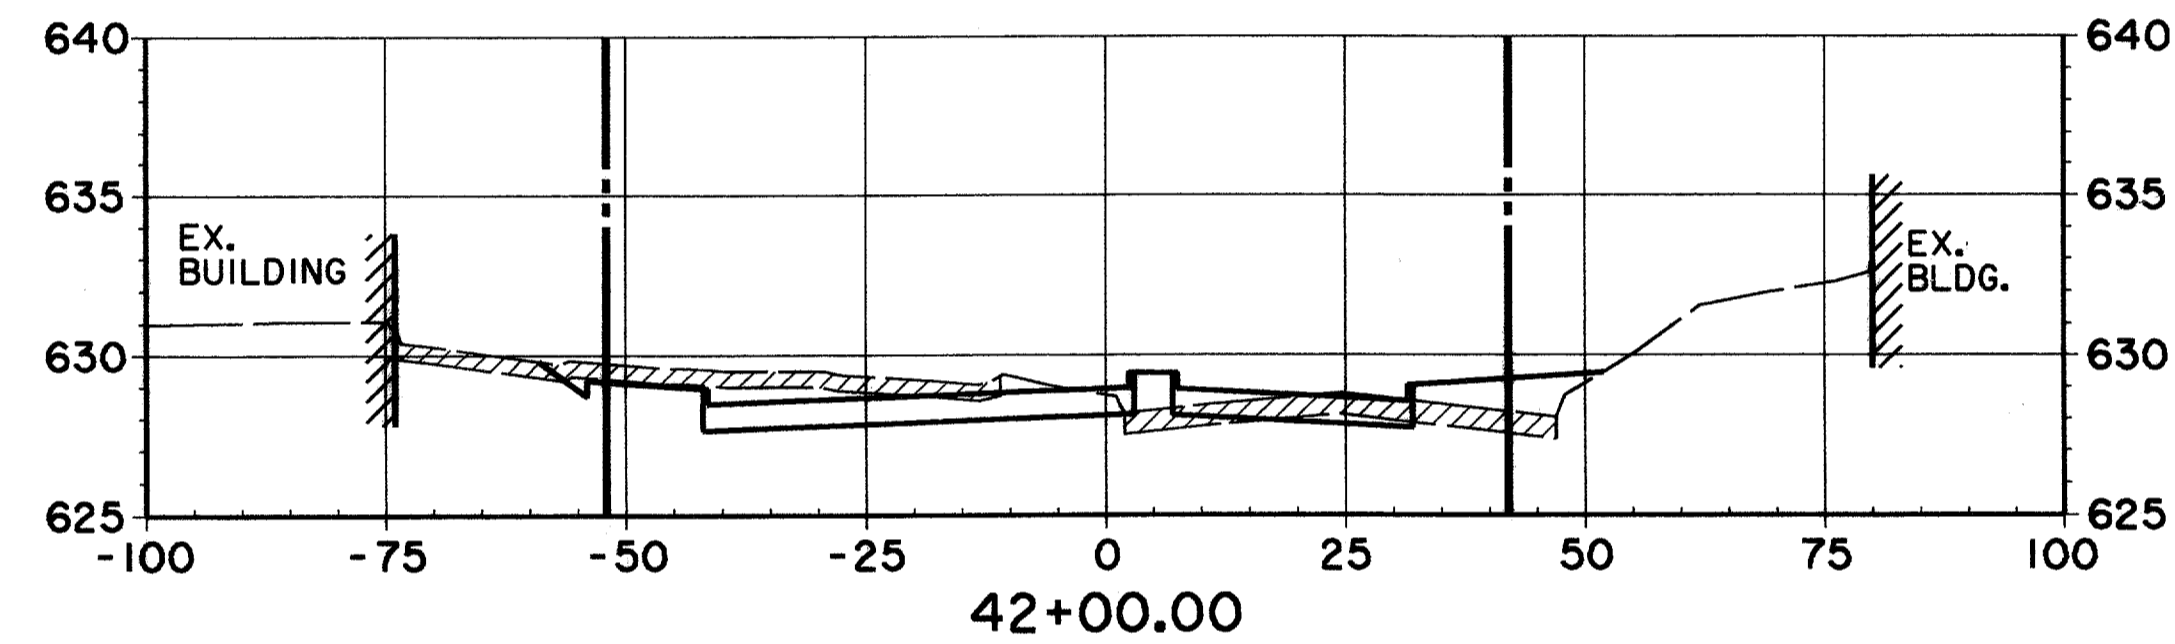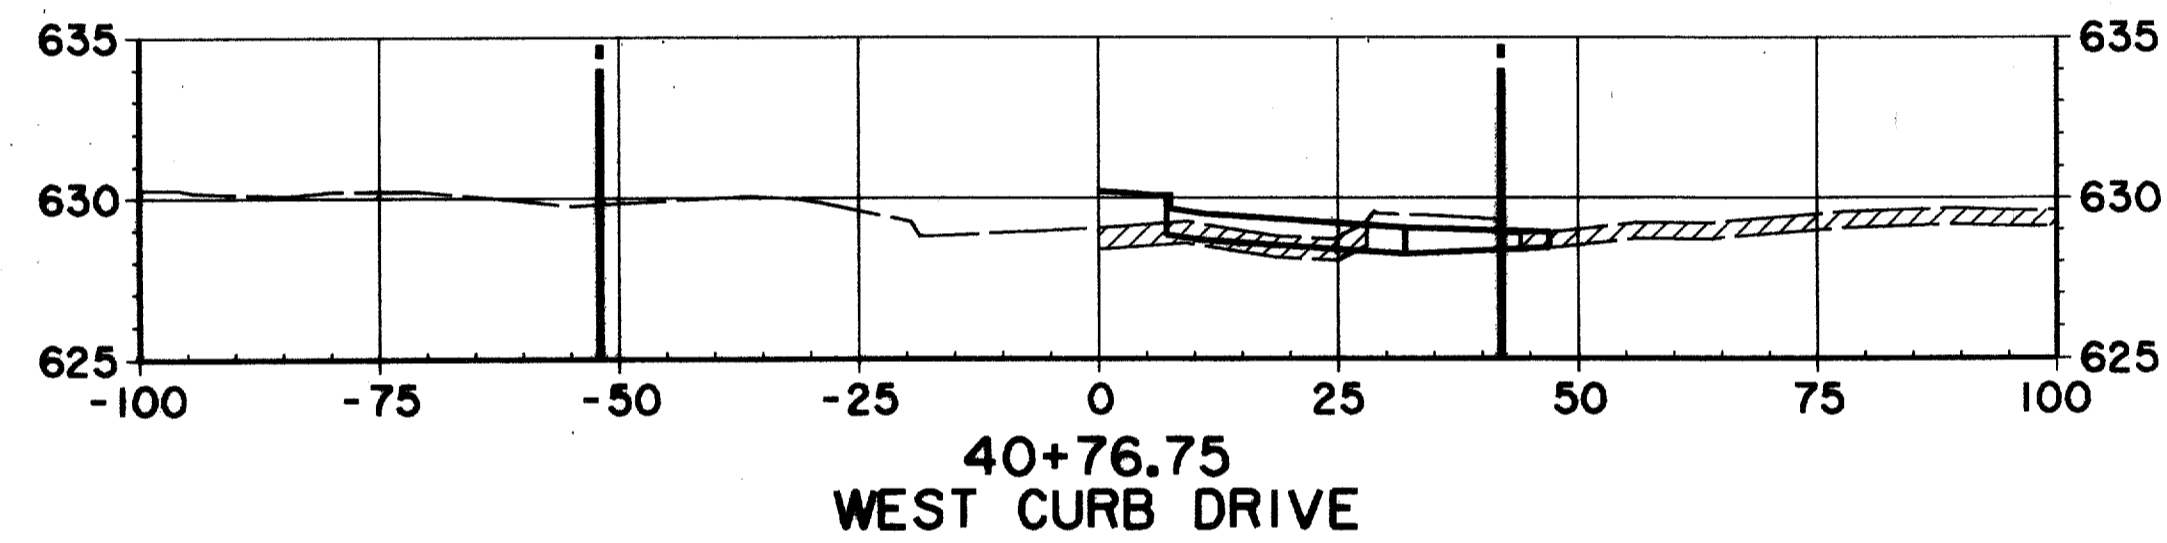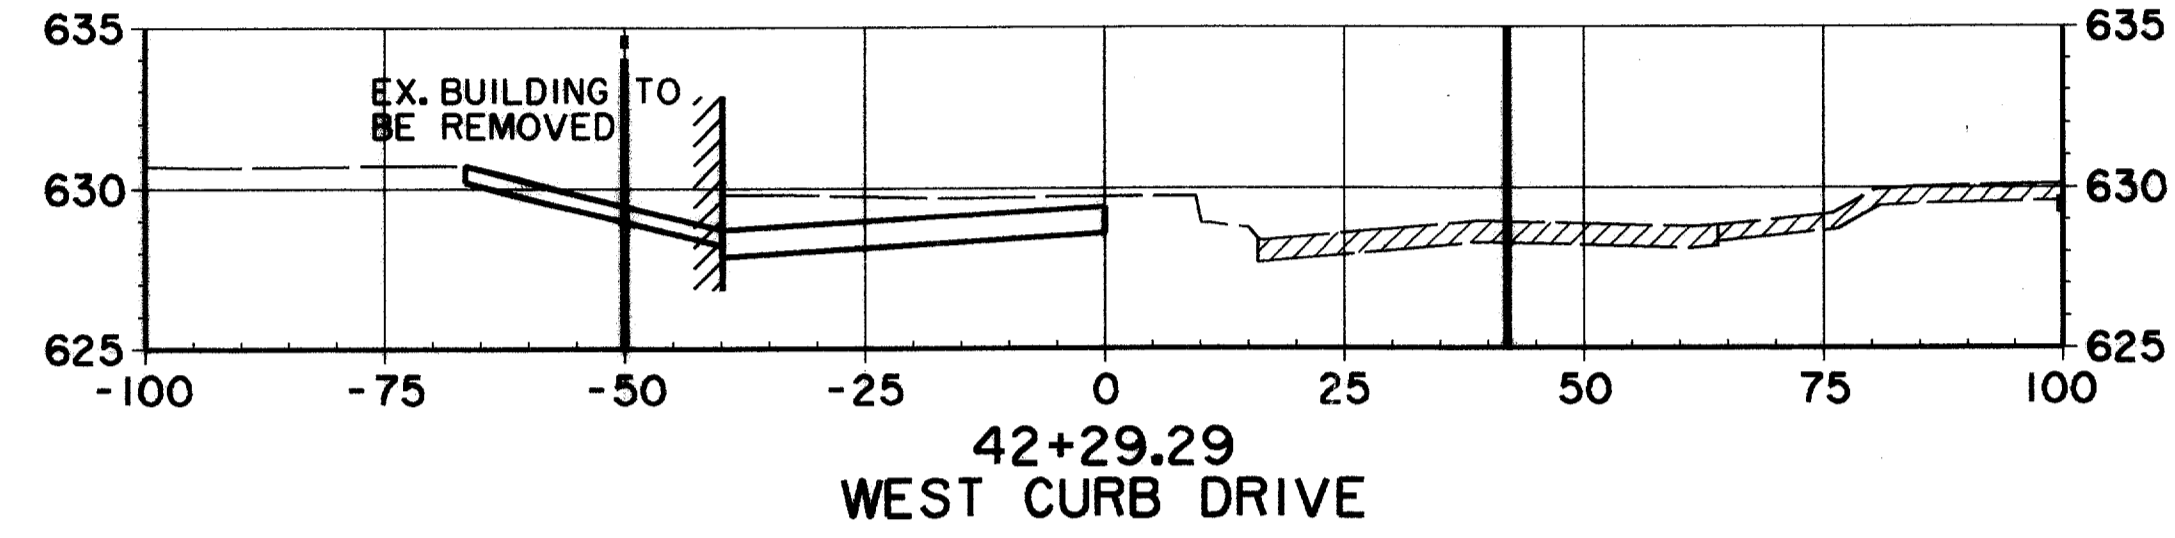
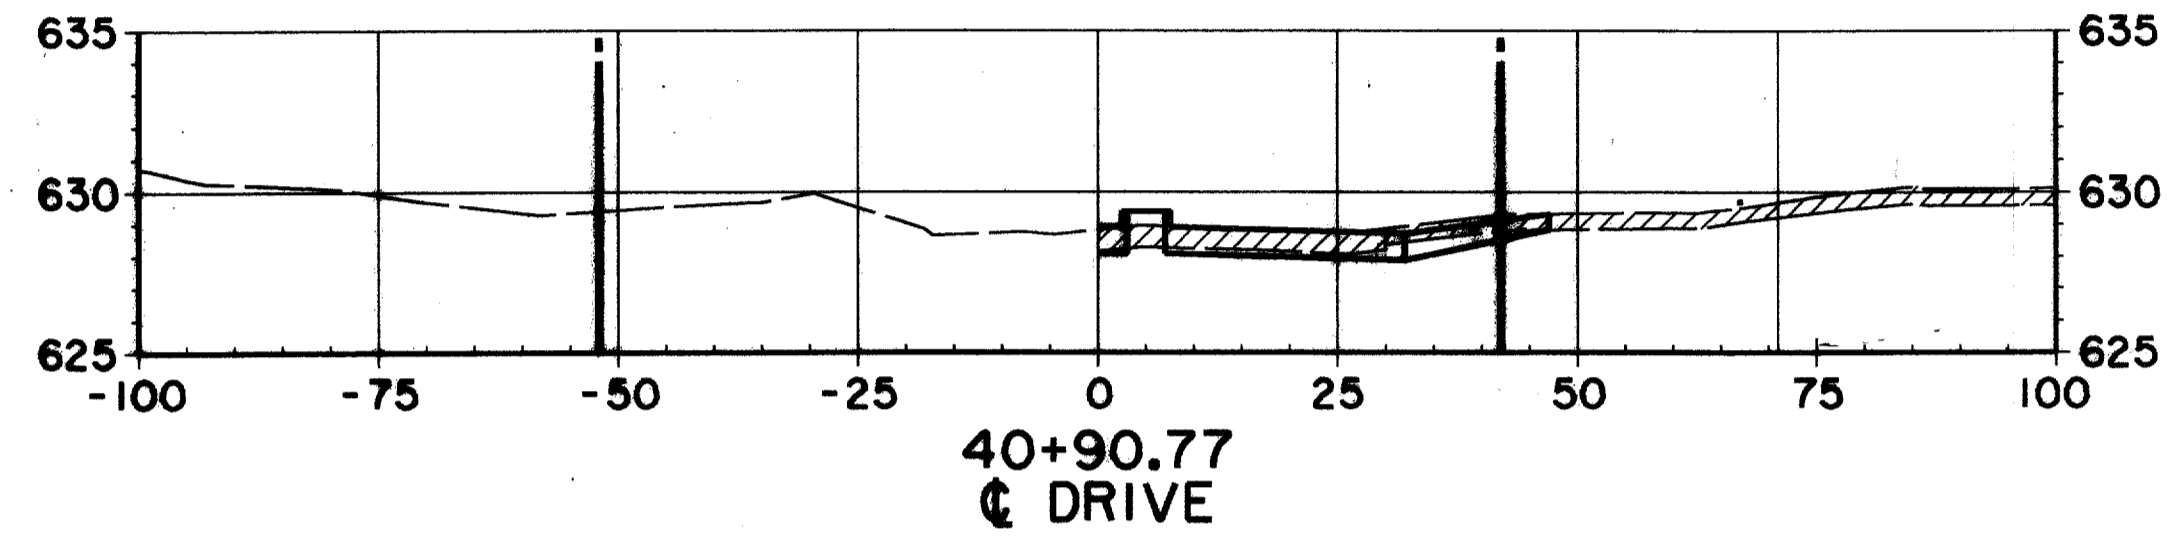
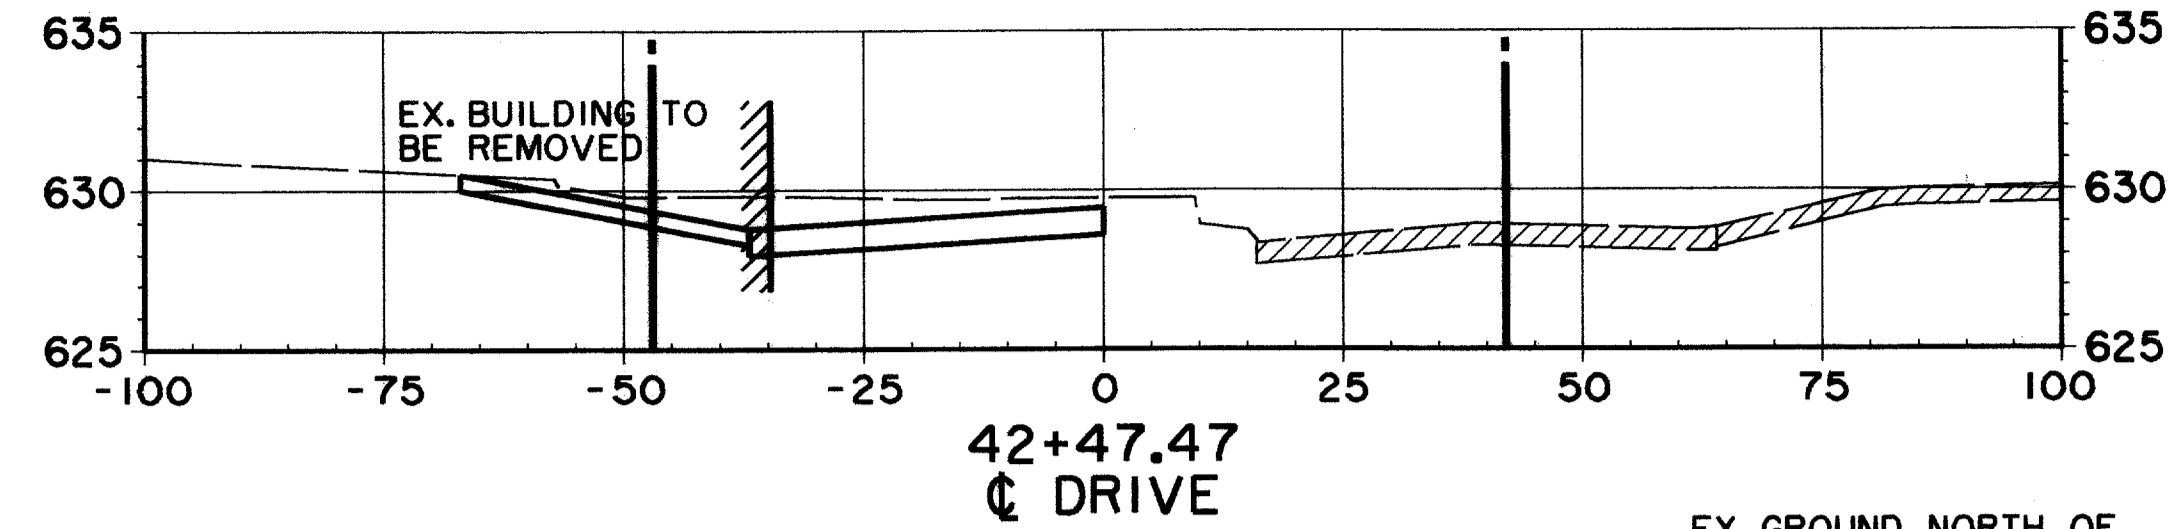
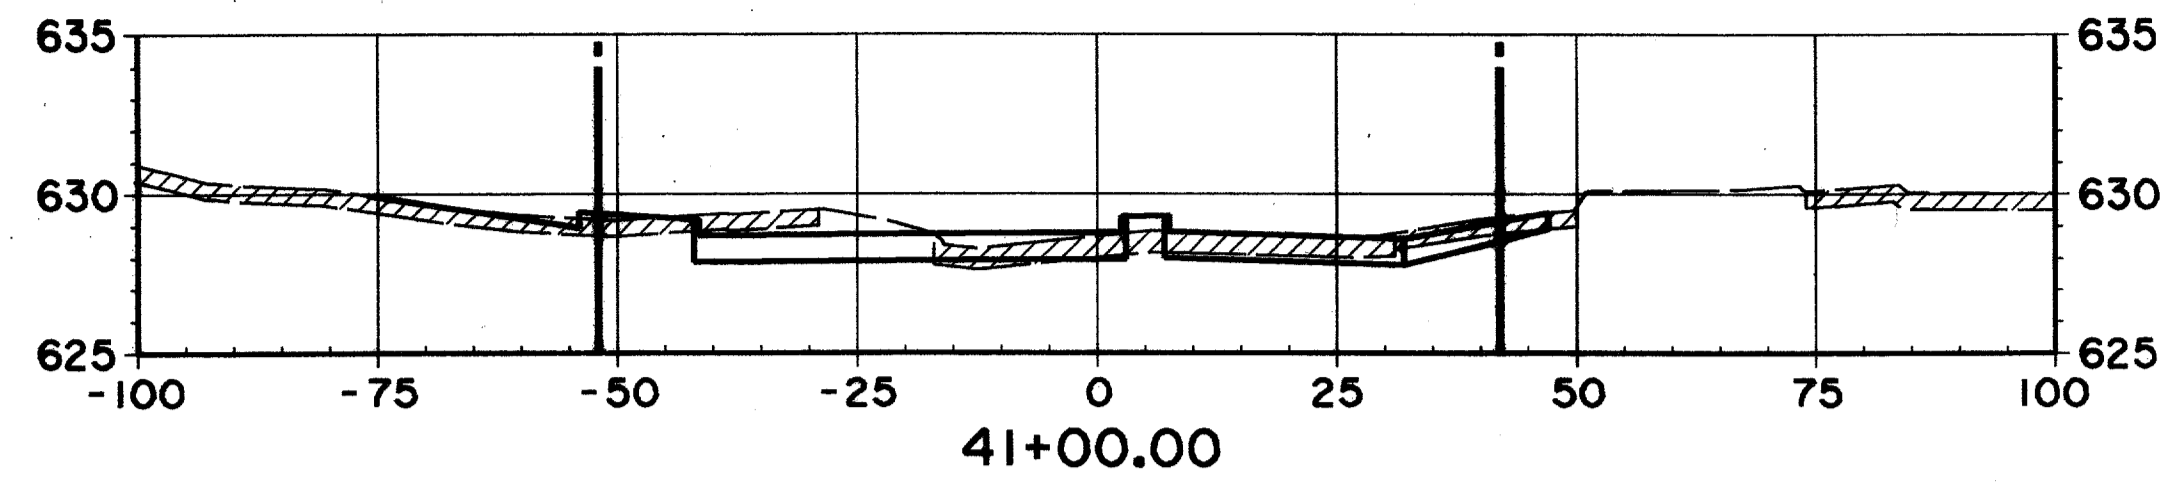


RECORD DOCUMENTS 6/9/2000







THESE RECORD DOCUMENTS HAVE BEEN PREPARED BASED ON INFORMATION PROVIDED BY OTHERS. THE CONSULTANT HAS NOT VERIFIED THE ACCURACY AND/OR COMPLETENESS OF THIS INFORMATION AND SHALL NOT BE RESPONSIBLE FOR ANY ERRORS OR OMISSIONS THAT MAY BE INCORPORATED AS A RESULT OF ERRONEOUS INFORMATION PROVIDED BY OTHERS.

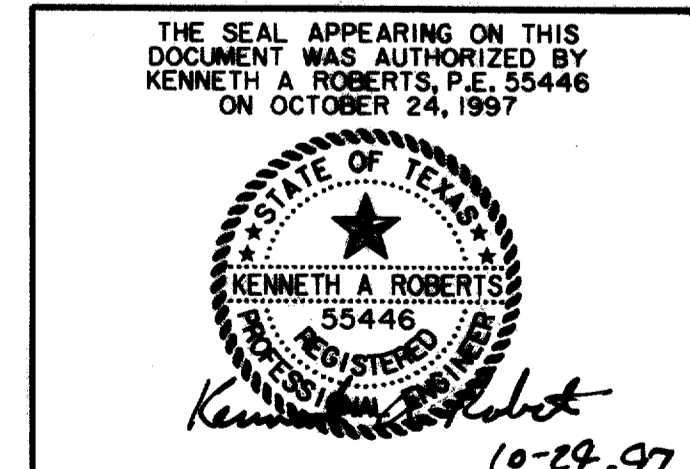


CROSS SECTIONS						
STA. 40+35.36 TO STA. 42+47.47						
ARAPAHO ROAD						
ADDISON ROAD TO DALLAS NORTH TOLLWAY						
TOWN OF ADDISON, TEXAS						
Huttl-Zollars, Inc./Consulting Engineers Dallas, Fort Worth, Houston, Phoenix, Tustin						
DESIGN	DRAWN	APPR.	SCALE	DATE	PROJECT NO.	NO.
HZ1	HZ1	KAR	H: V = 1" = 20' / 1" = 8'	OCT 97	1772-01	X-2

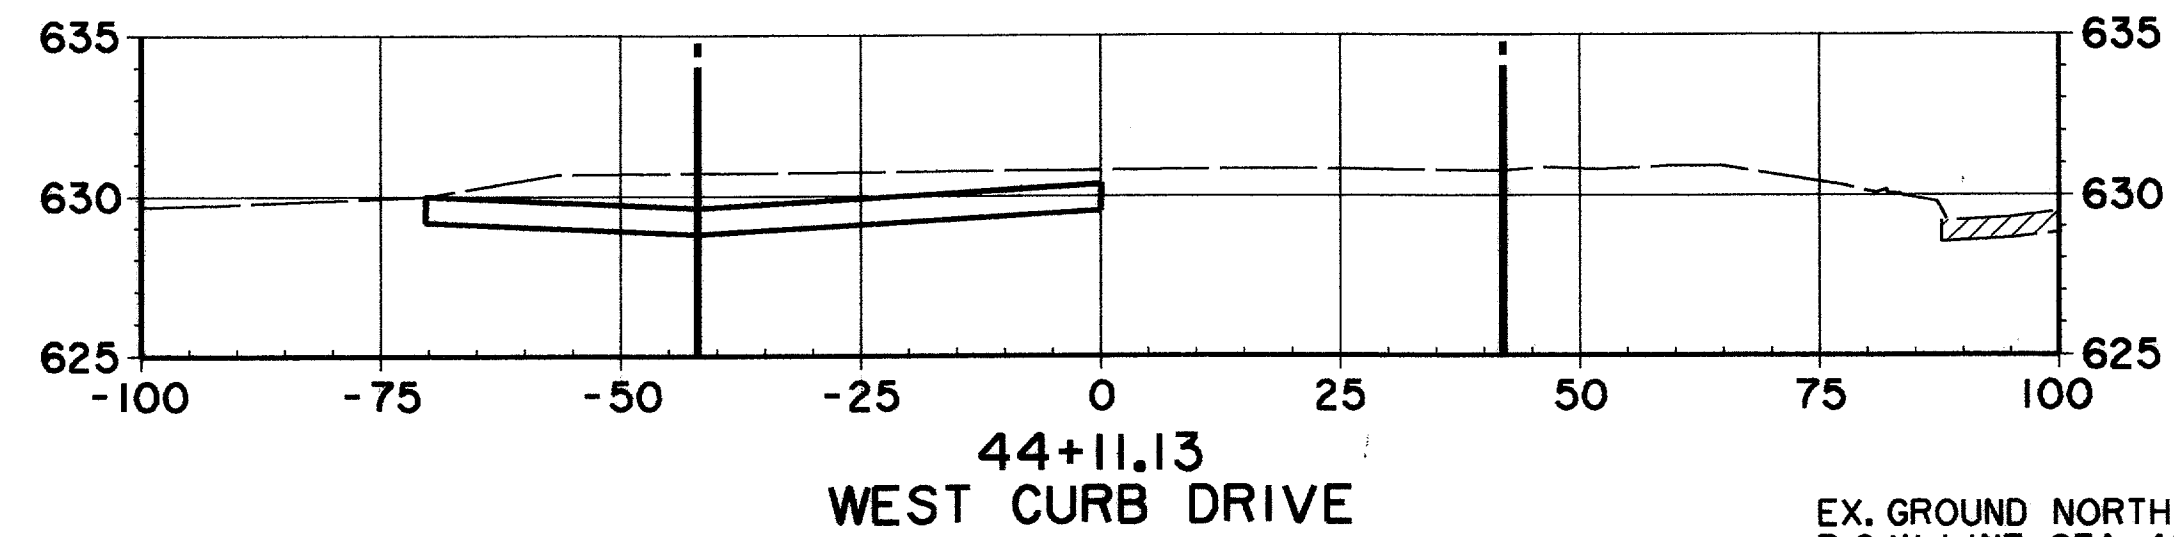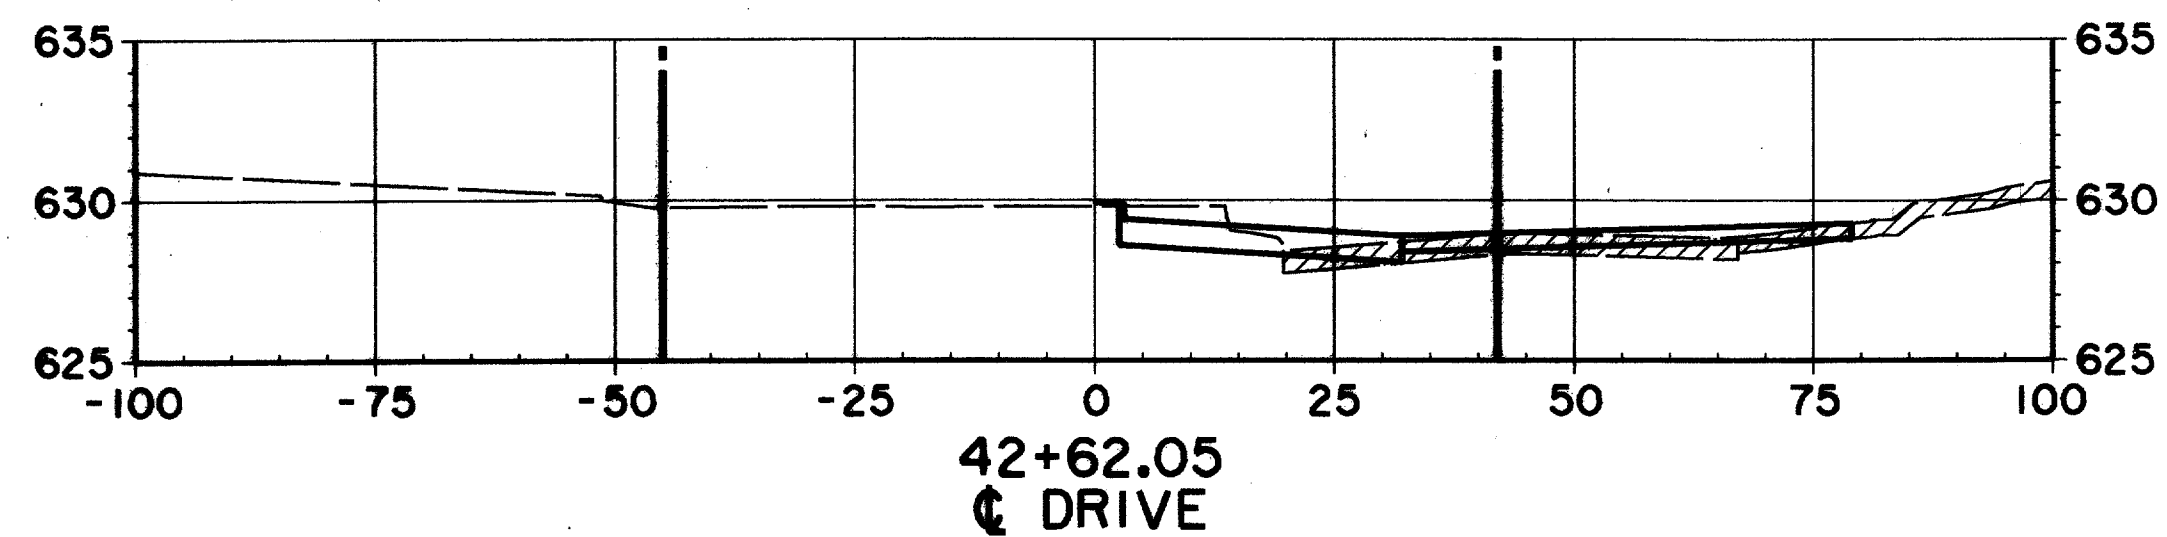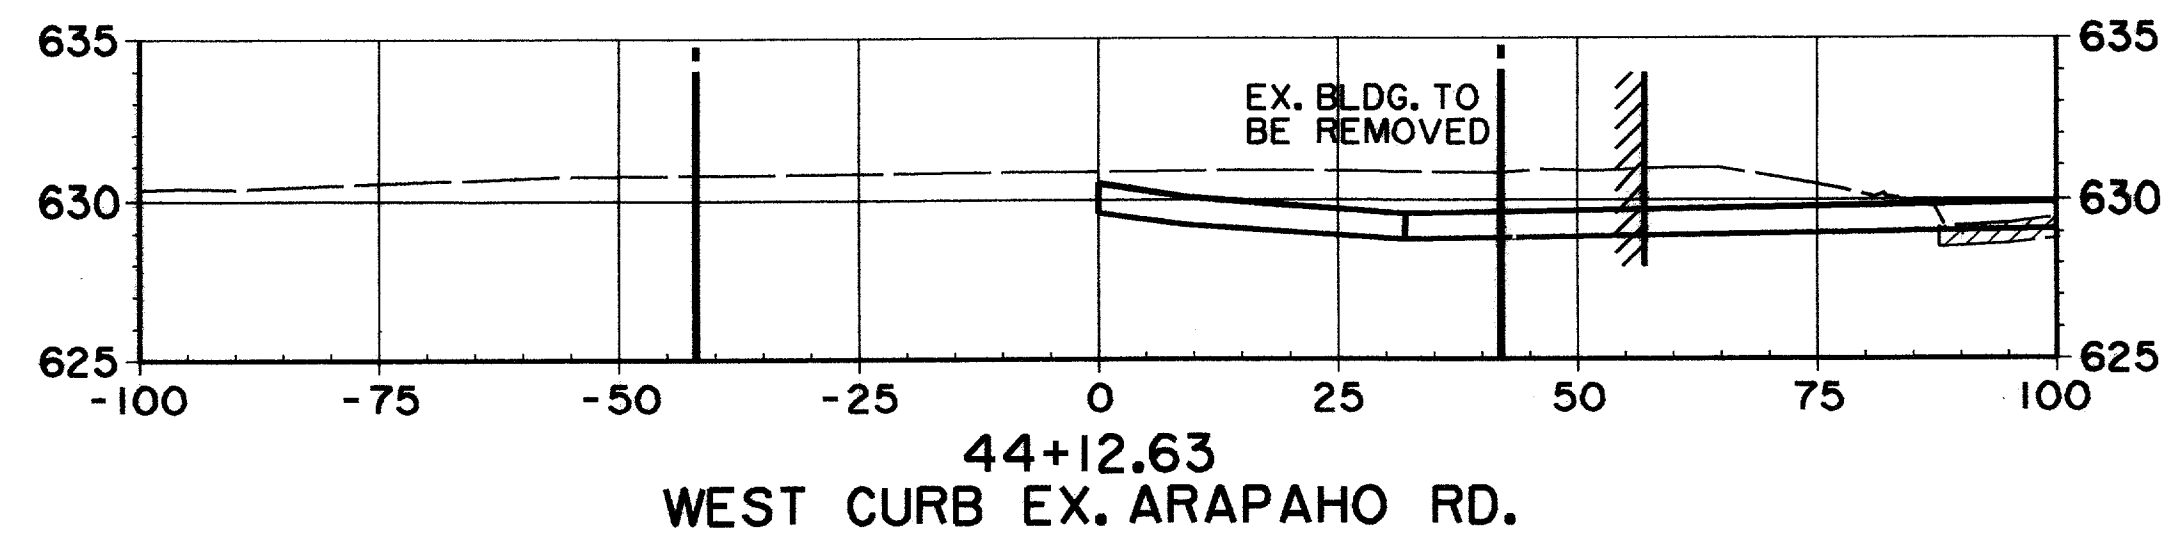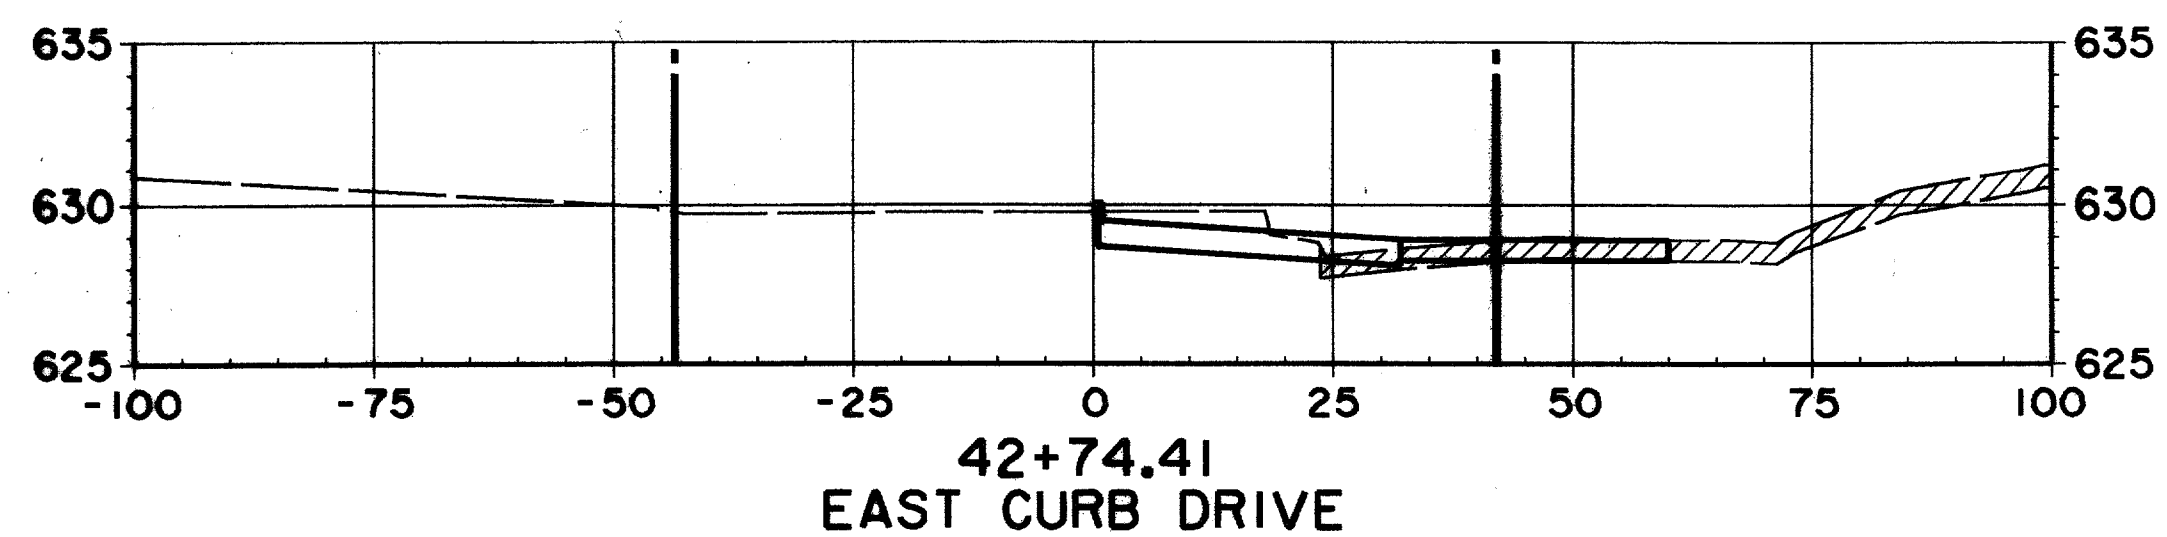





EX. GROUND NORTH OF
R.O.W. LINE STA. 42+50
TO STA. 52+00 MAY HAVE
BEEN MODIFIED DUE TO
CONSTRUCTION OF DART
TRANSIT CENTER

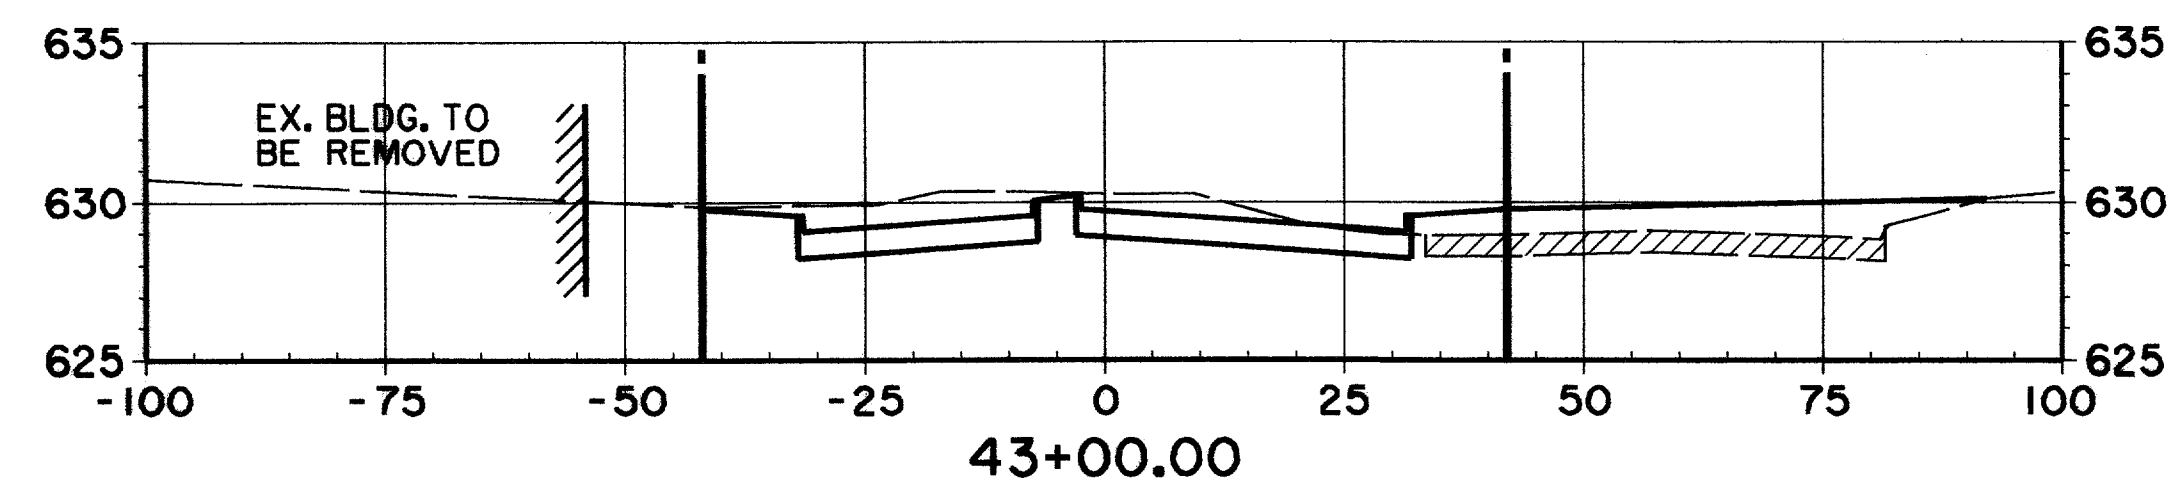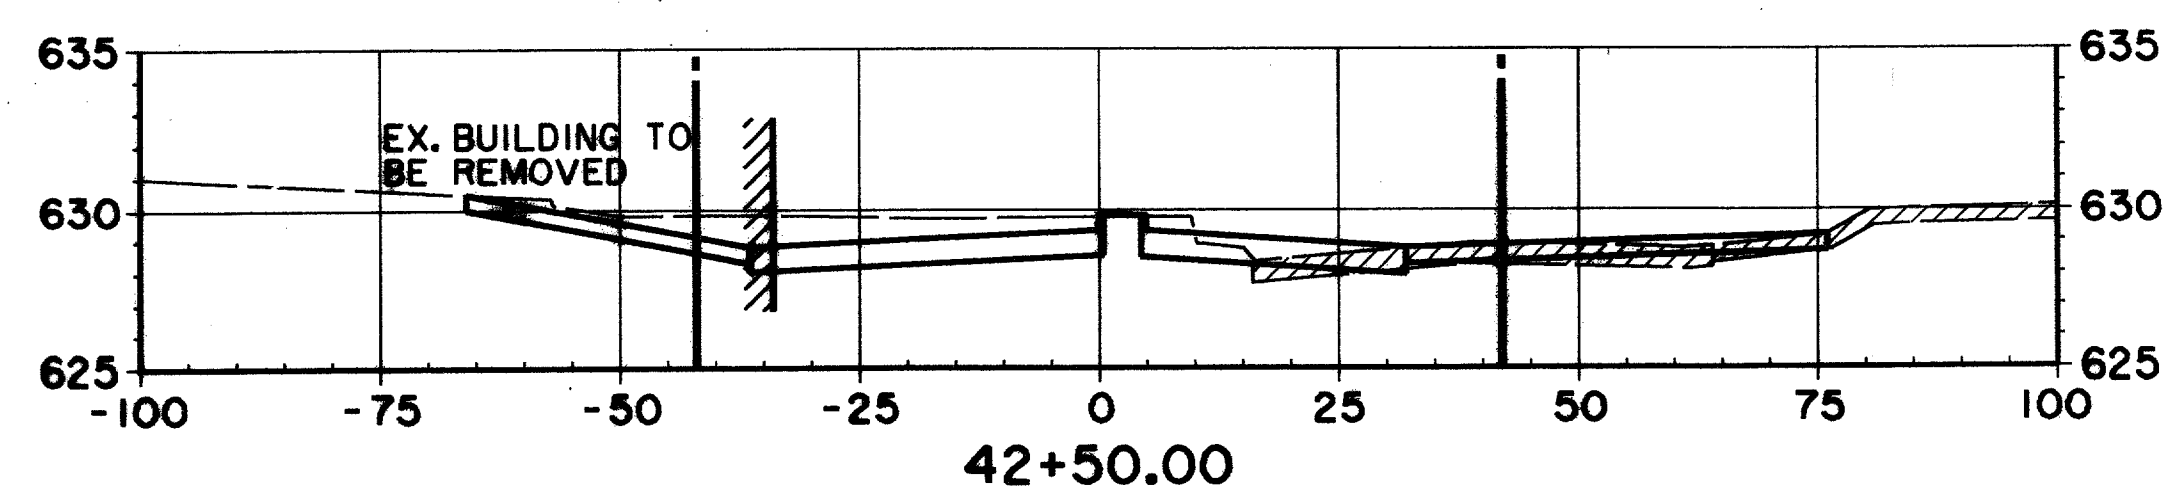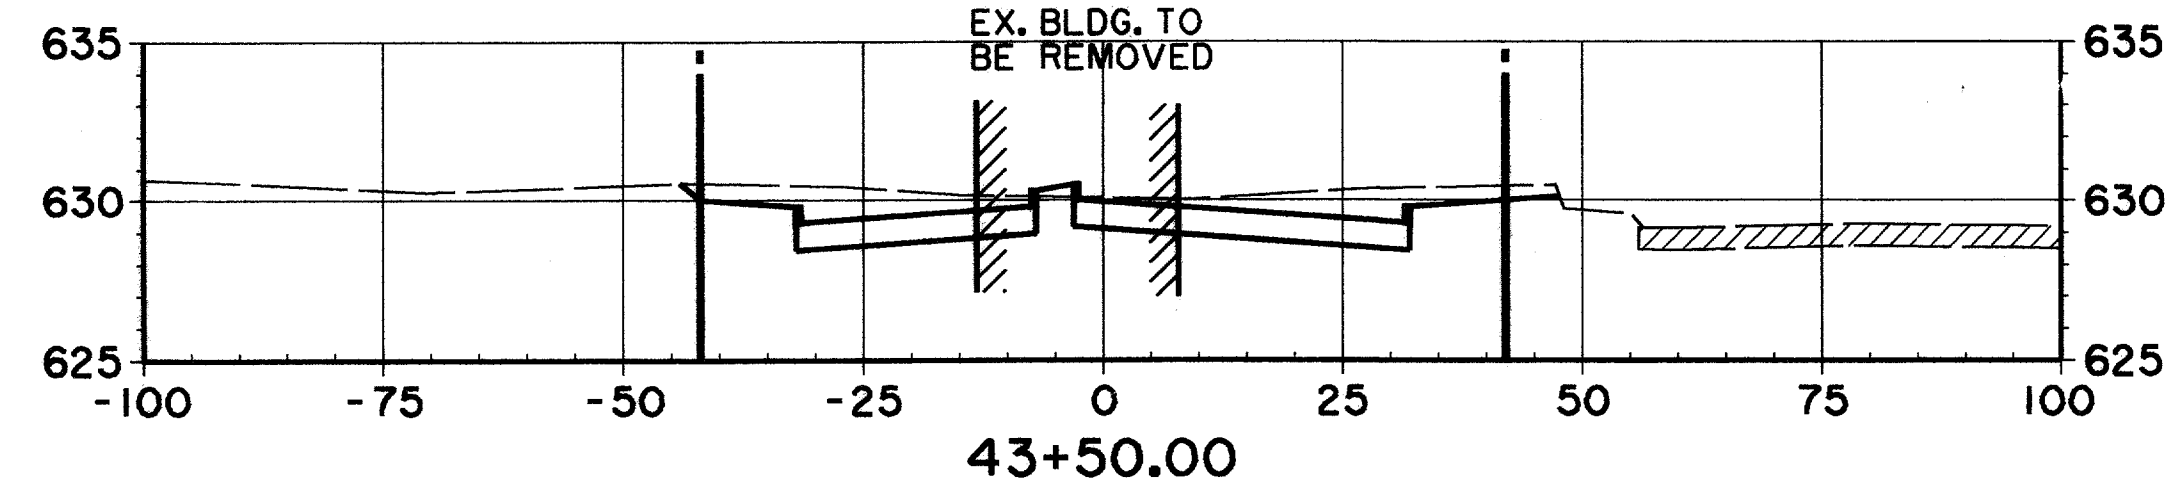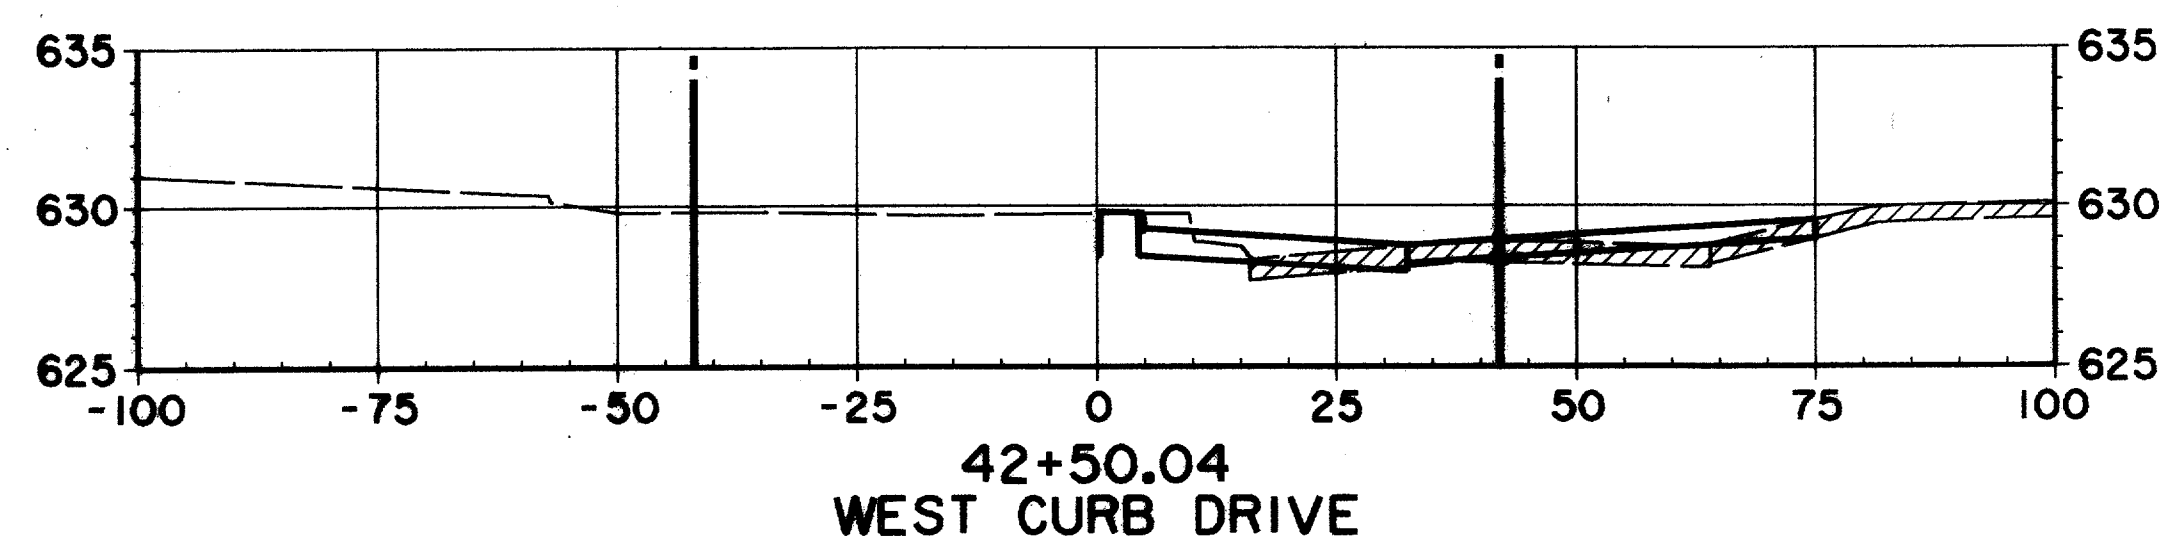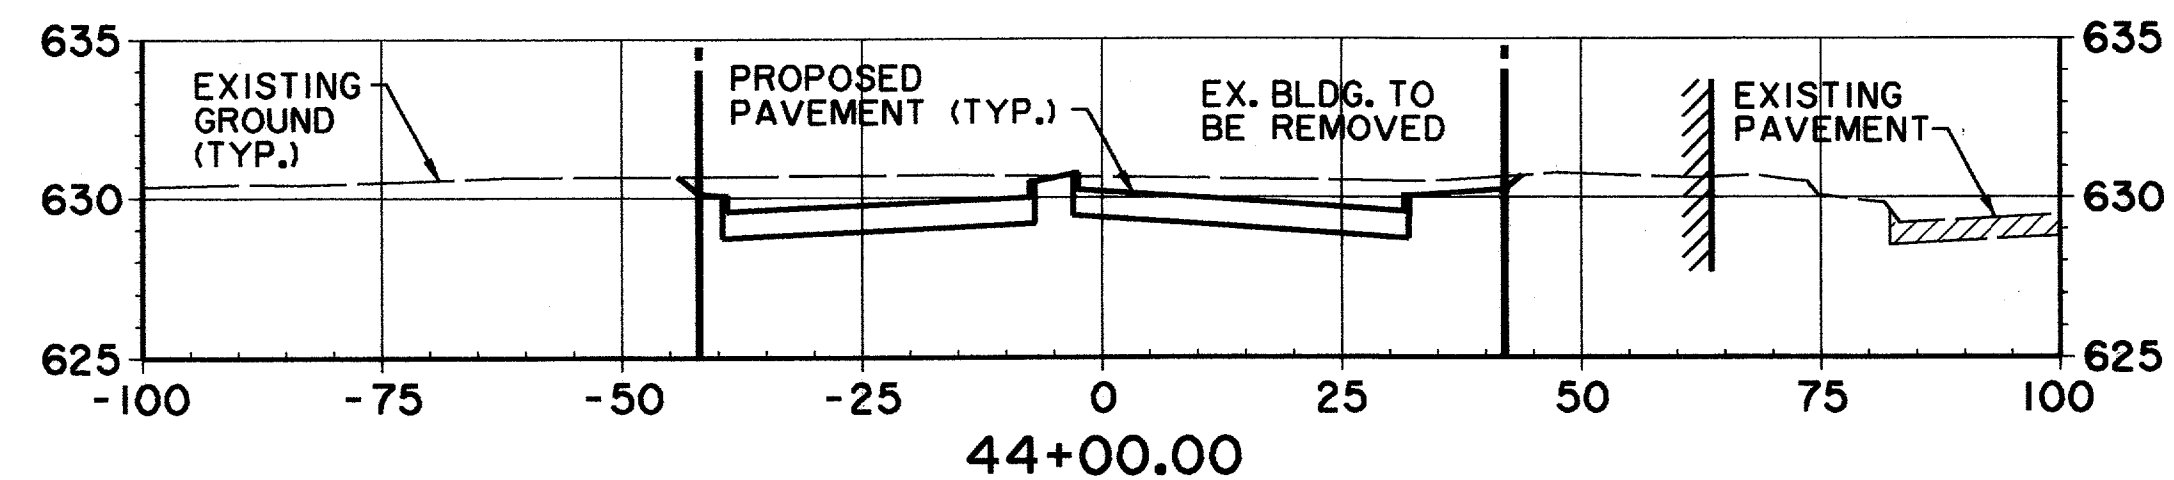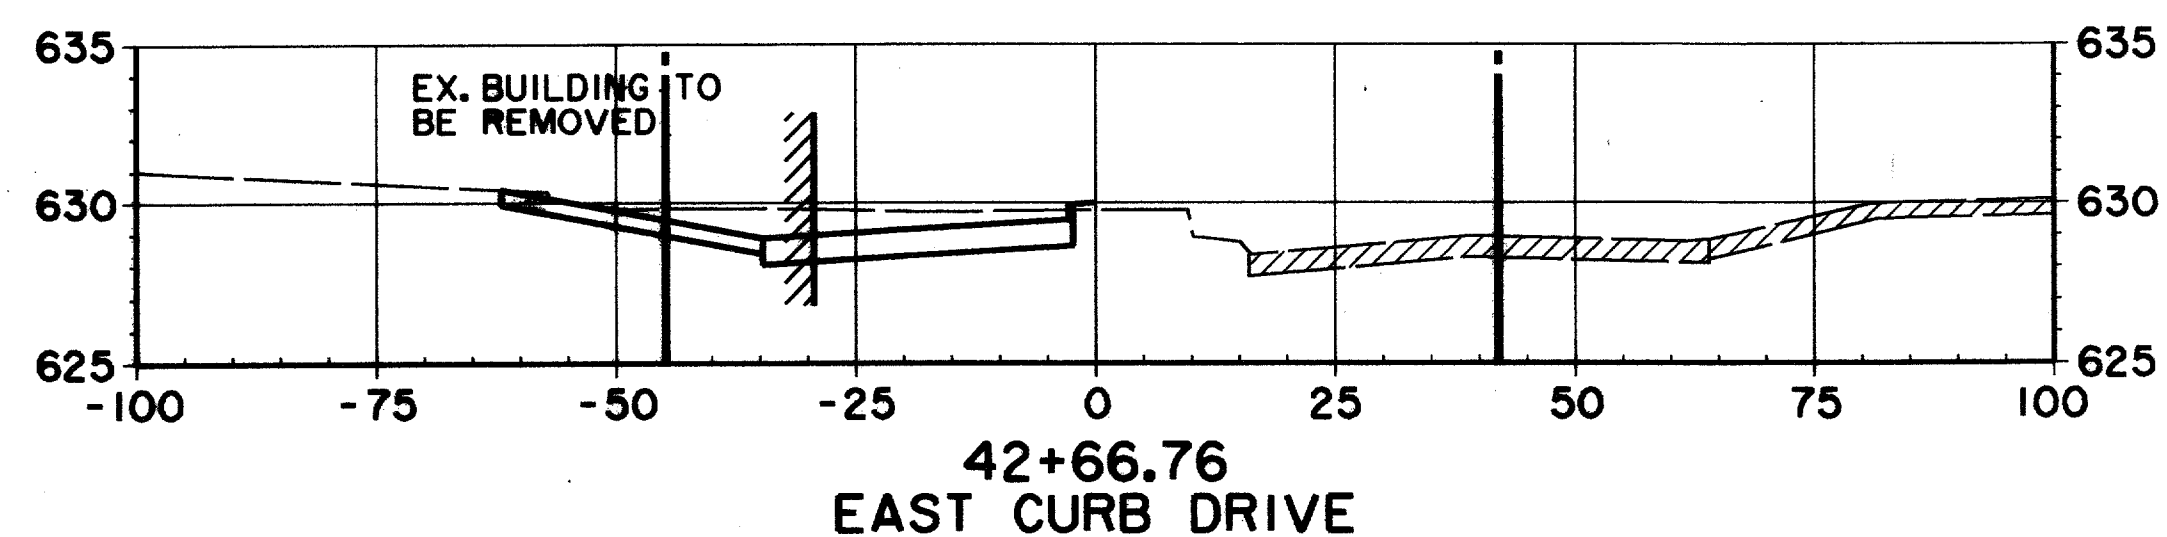







RECORD DOCUMENTS 6/9/2000
THESE RECORD DOCUMENTS HAVE BEEN PREPARED BASED ON
INFORMATION PROVIDED BY OTHERS. THE CONSULTANT HAS
NOT VERIFIED THE ACCURACY AND/OR COMPLETENESS OF THIS
INFORMATION AND SHALL NOT BE RESPONSIBLE FOR ANY
ERRORS OR OMISSIONS THAT MAY BE INCORPORATED AS A
RESULT OF ERRONEOUS INFORMATION PROVIDED BY OTHERS.

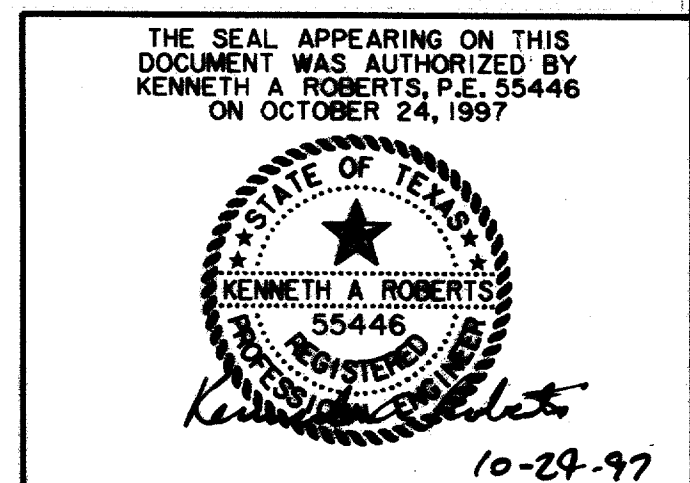

CROSS SECTIONS						
STA. 42+50 TO STA. 44+12.63						
ARAPAHO ROAD						
ADDISON ROAD TO DALLAS NORTH TOLLWAY						
TOWN OF ADDISON, TEXAS						
Huitt-Zollars, Inc./Consulting Engineers Dallas, Fort Worth, Houston, Phoenix, Tustin						
DESIGN	DRAWN	APPR.	SCALE	DATE	PROJECT NO.	NO.
HZI	HZI	KAR	H: 1"=20' V: 1"=6'	OCT 97	1772-01	X-3

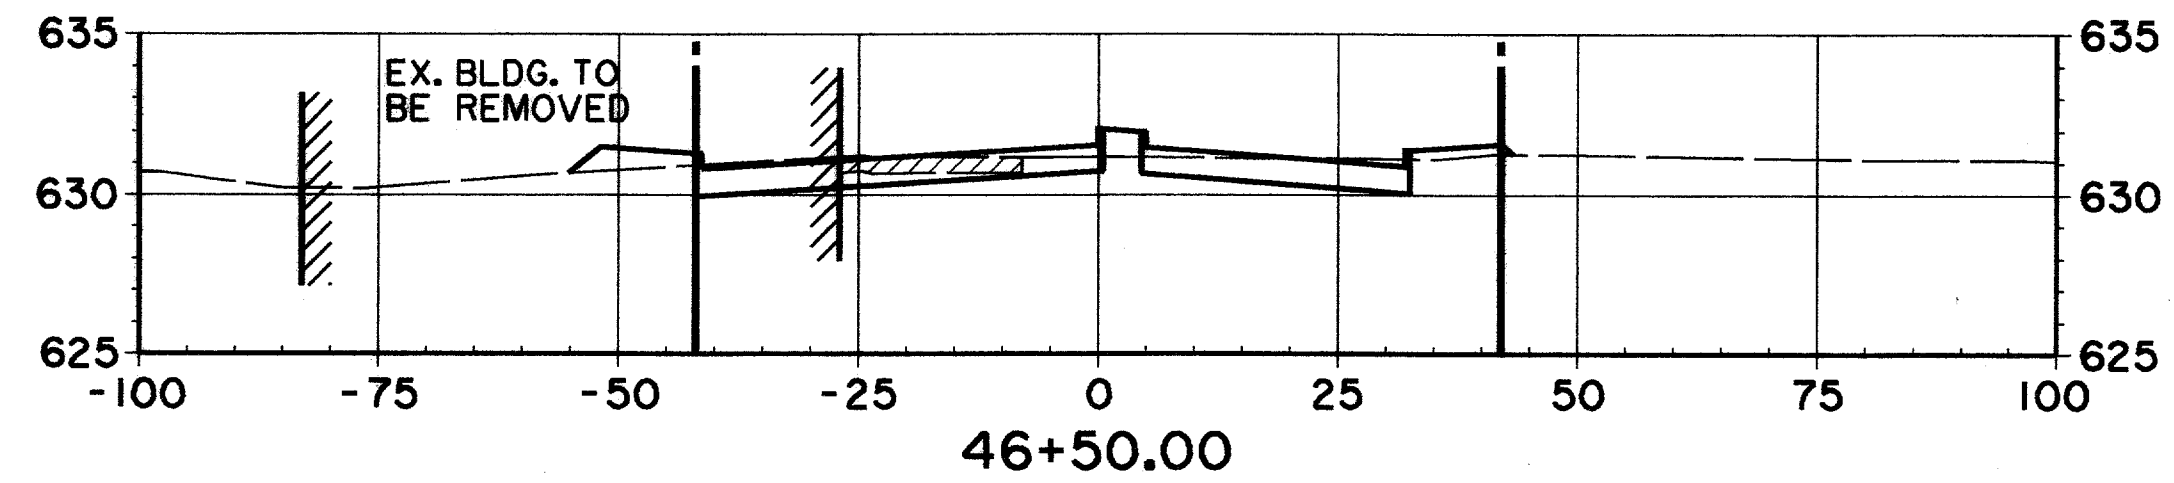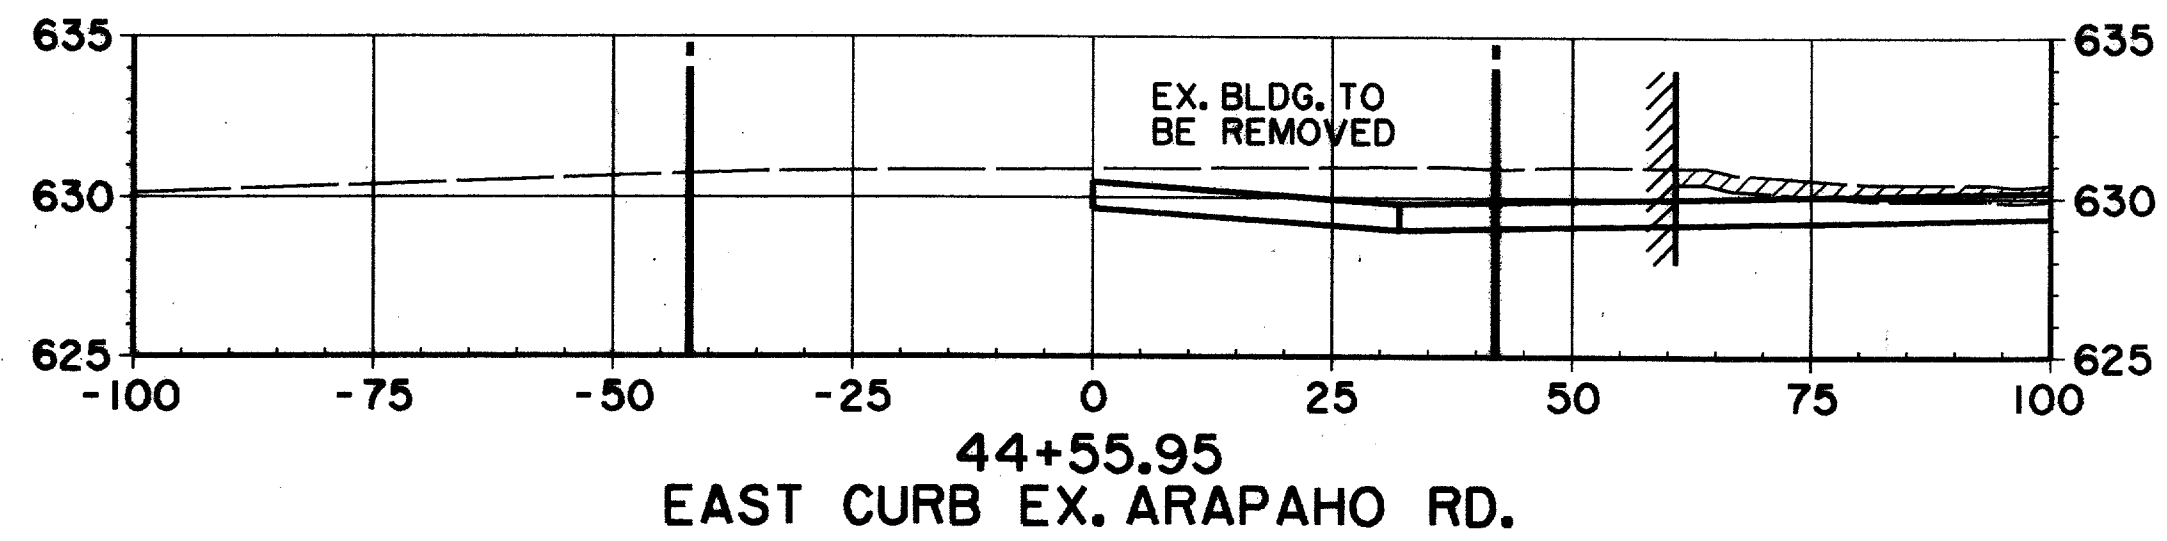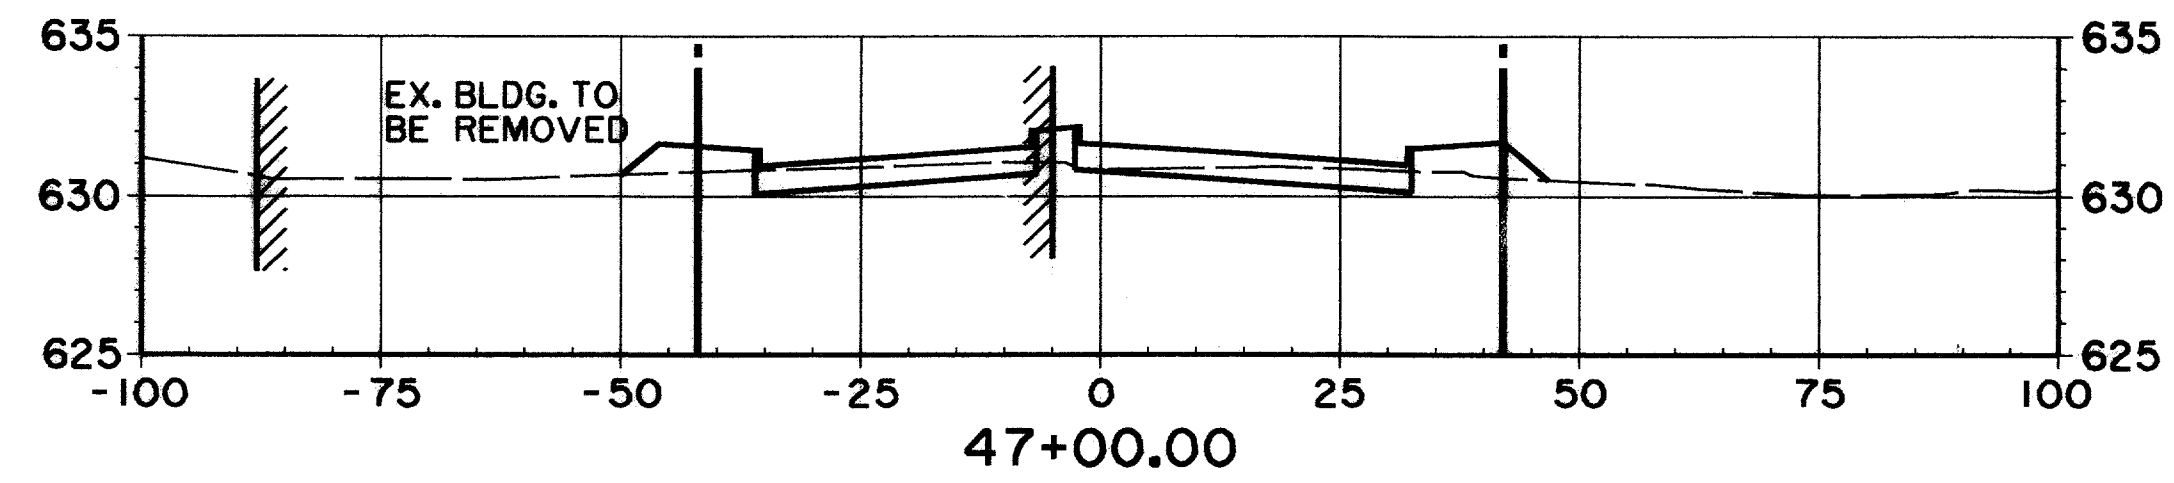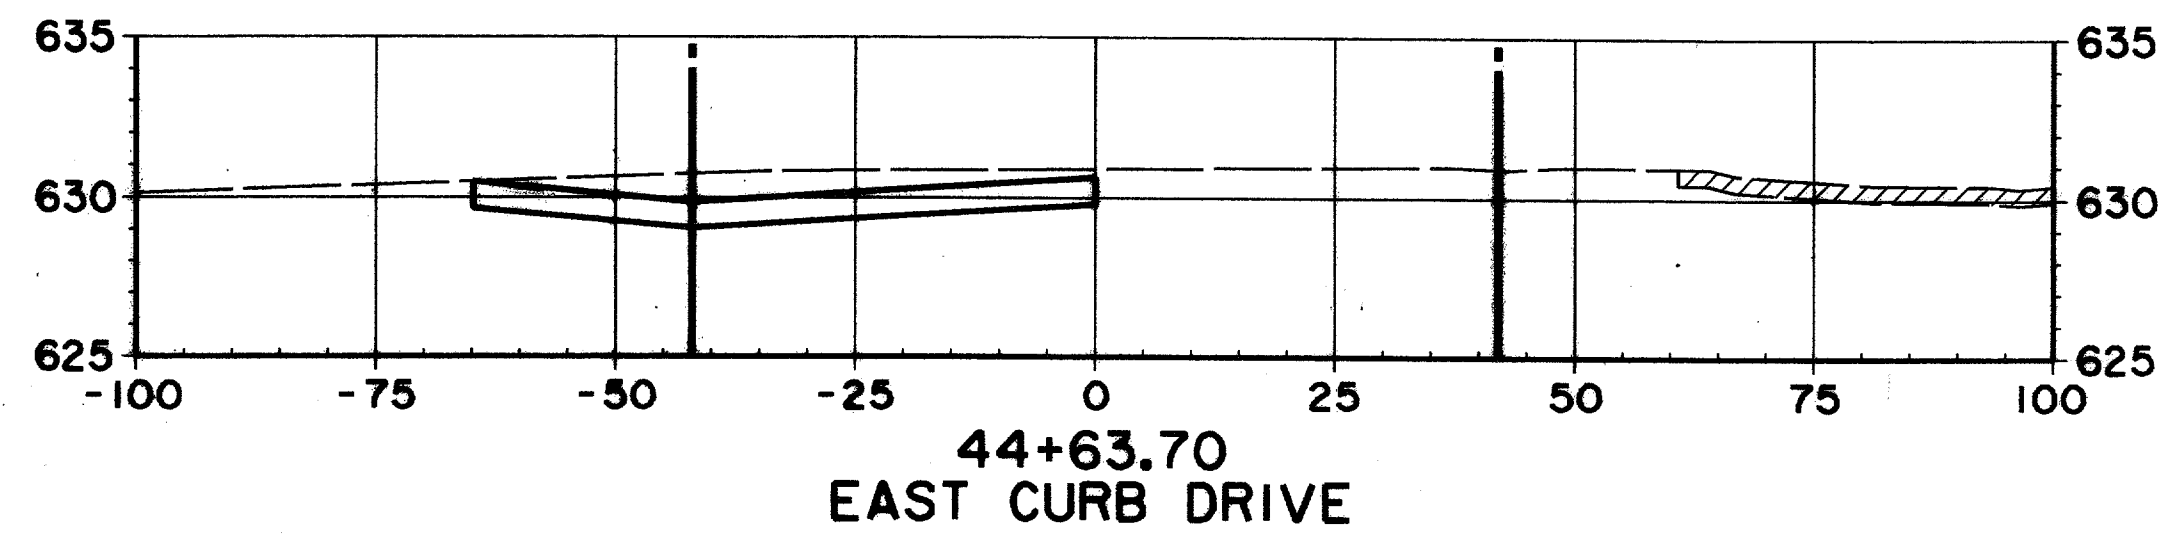

EX. GROUND NORTH OF
R.O.W. LINE STA. 42+50
TO STA. 52+00 MAY HAVE
BEEN MODIFIED DUE TO
CONSTRUCTION OF DART
TRANSIT CENTER

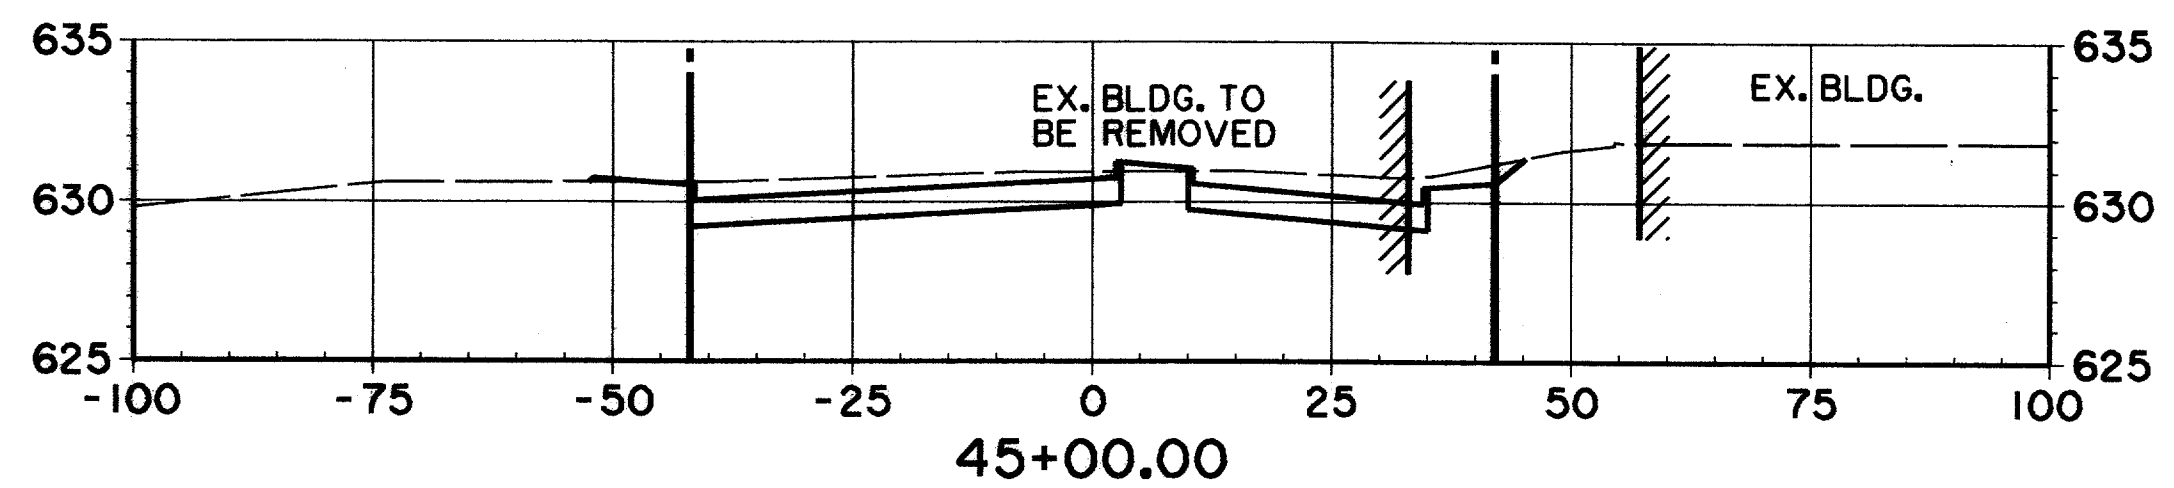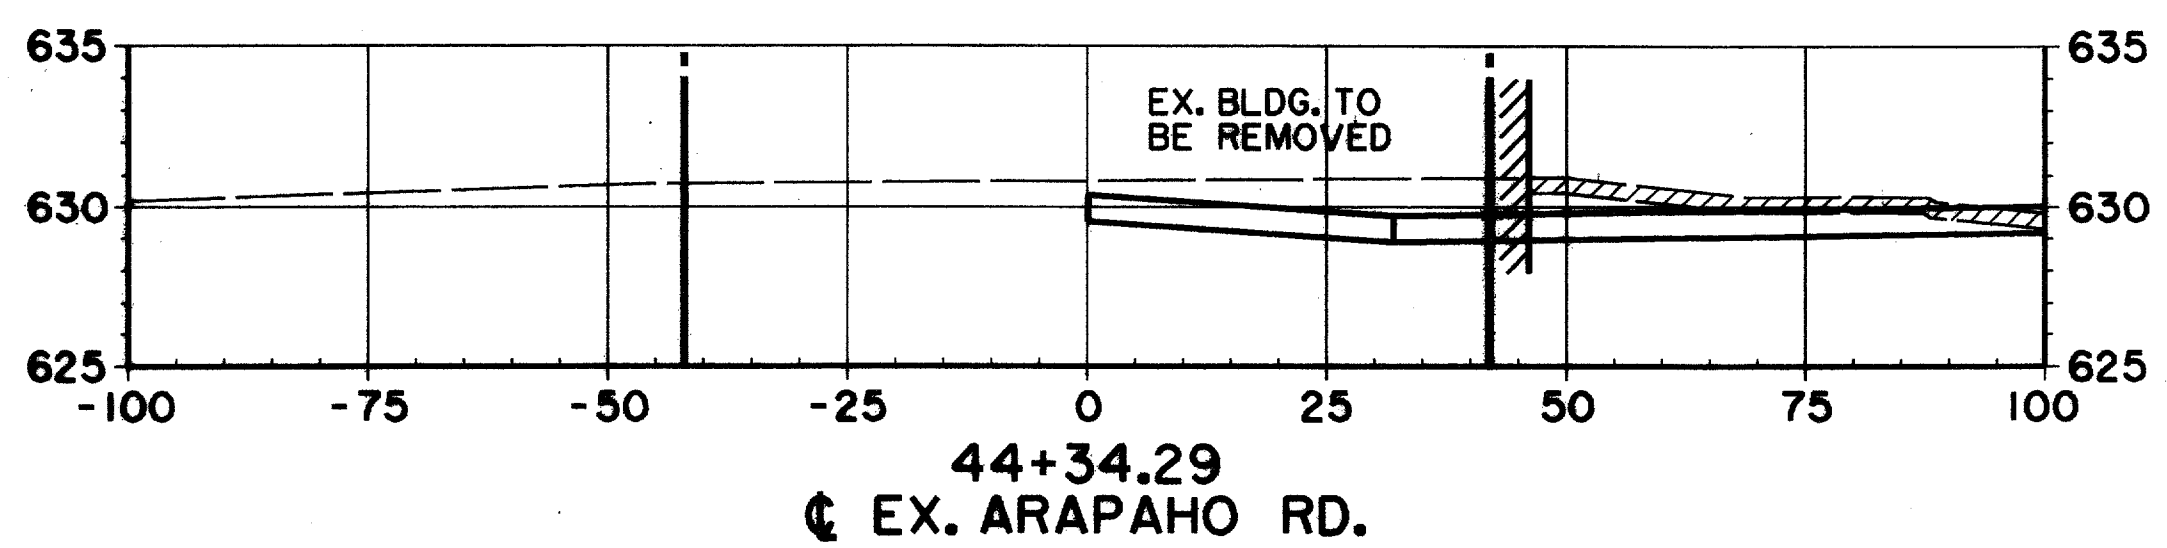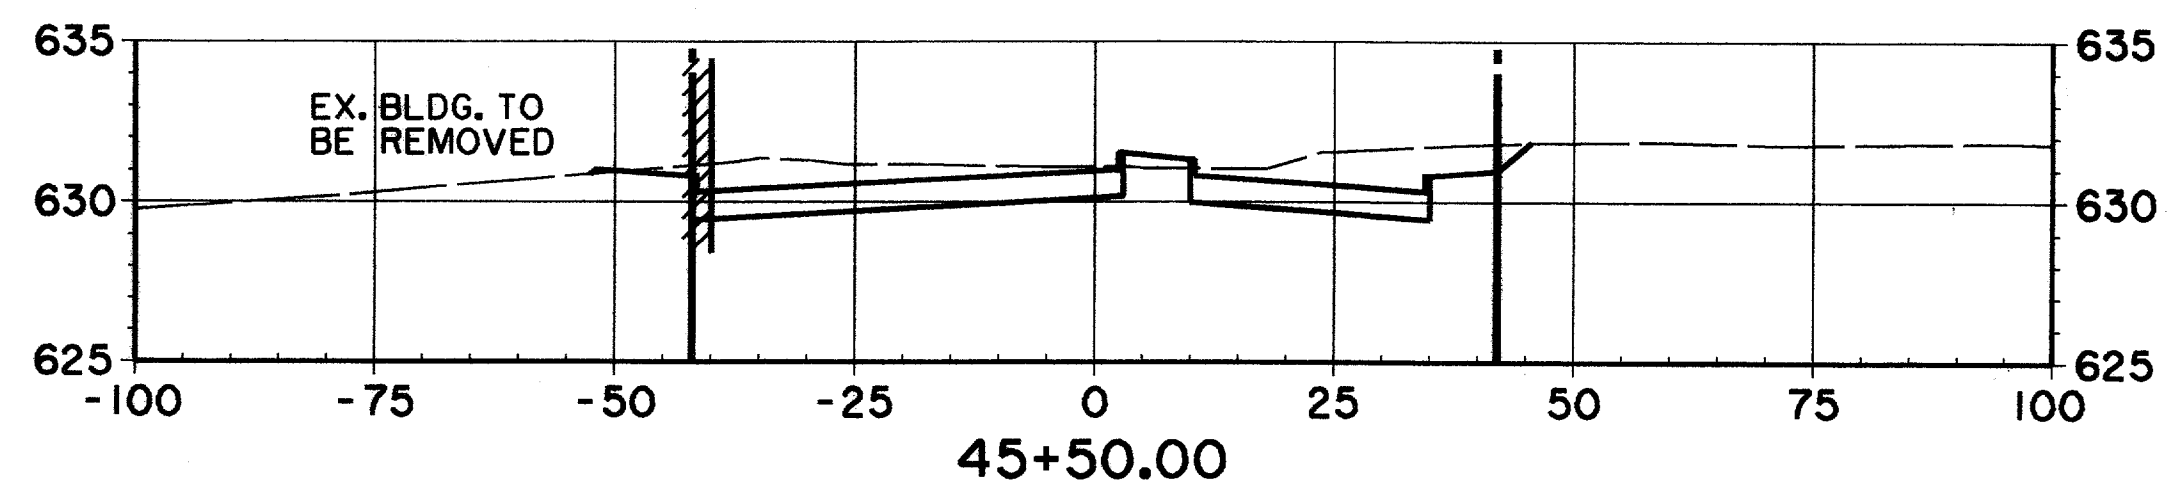
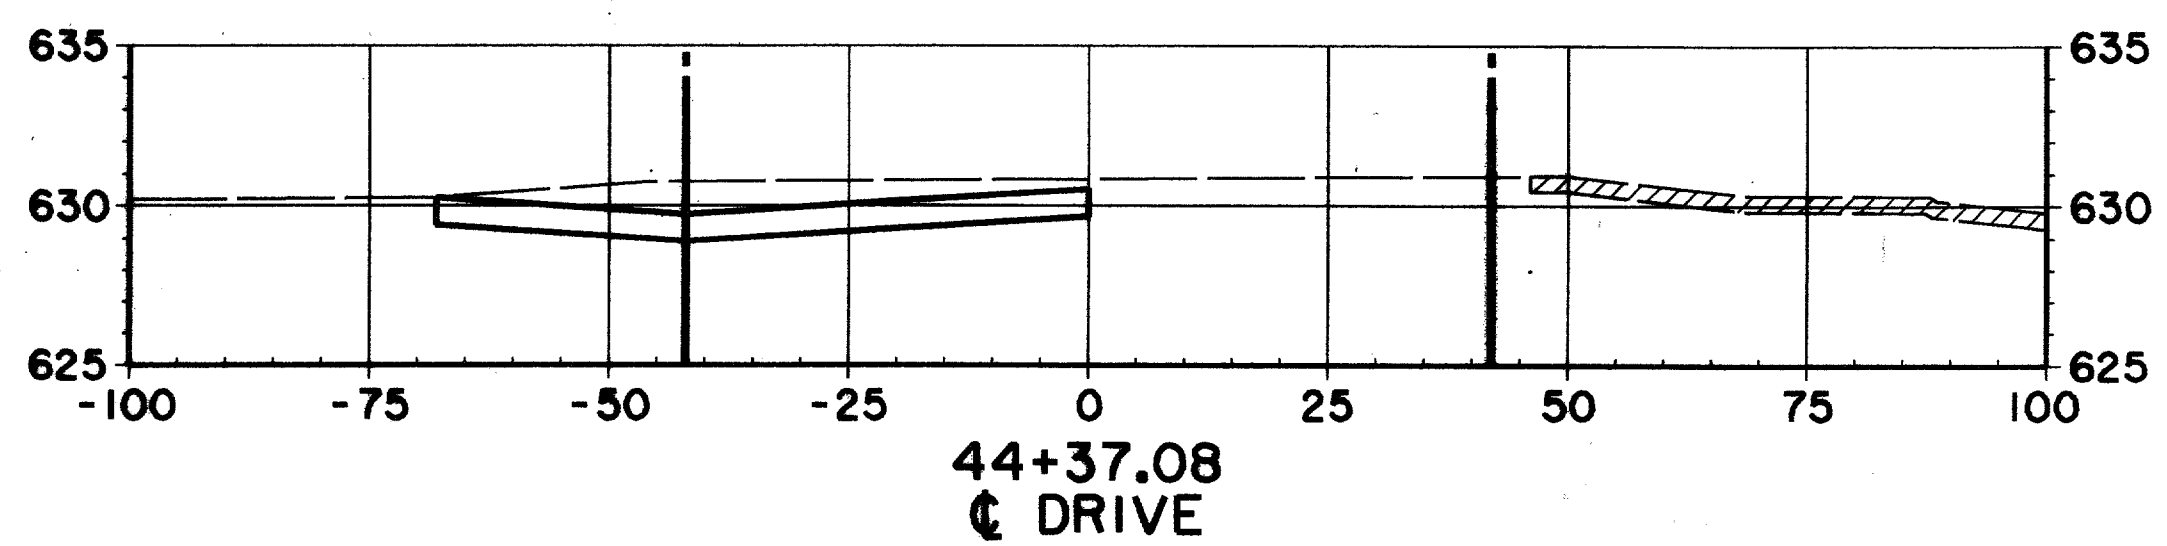
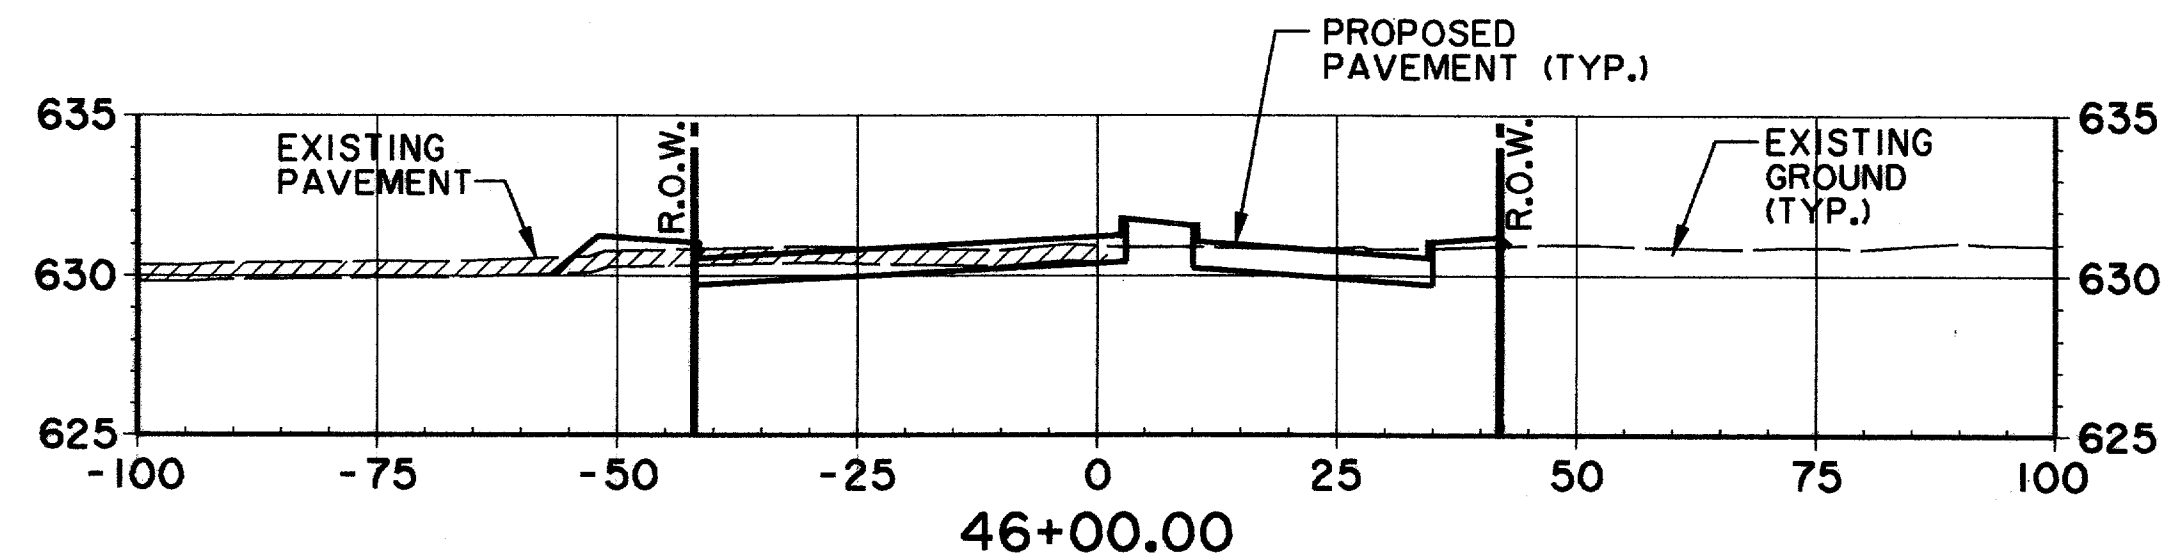
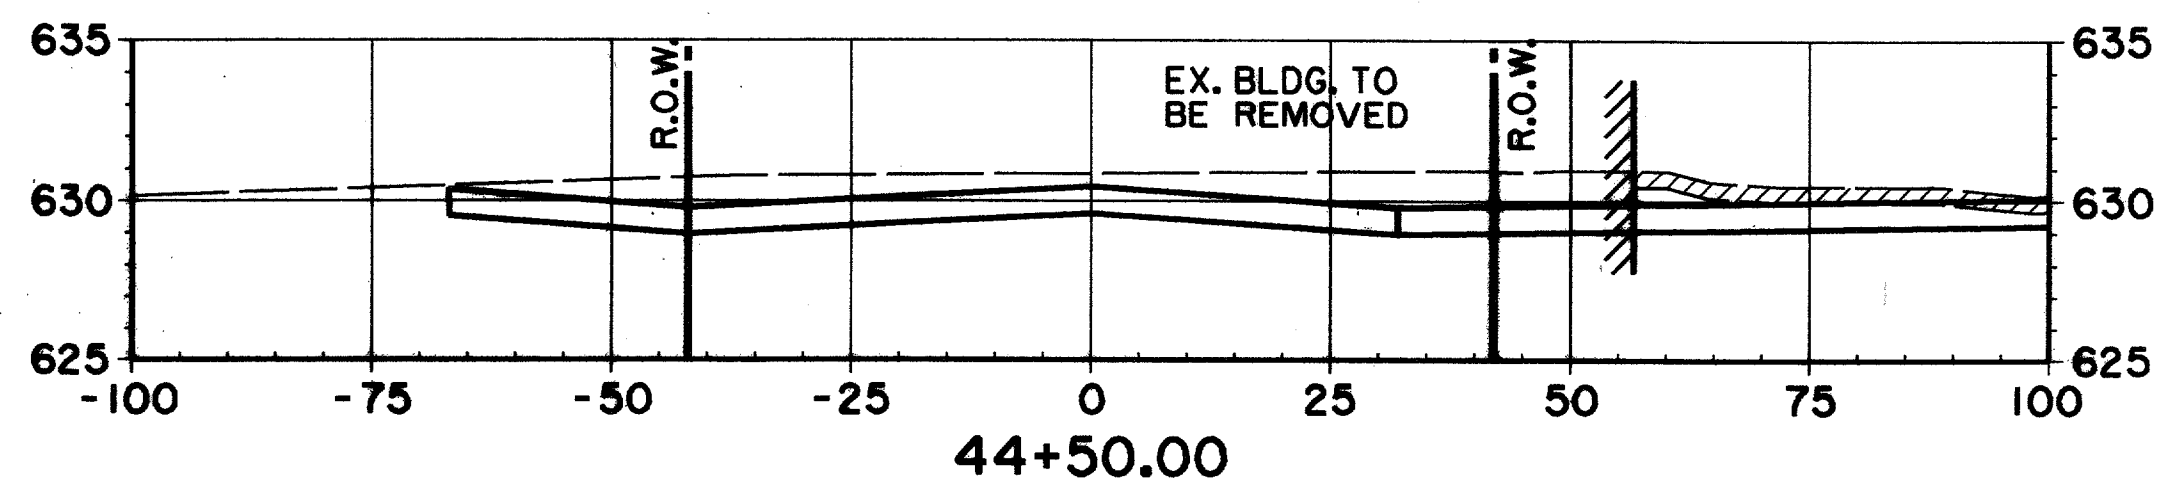


RECORD DOCUMENTS 6/9/2000
THESE RECORD DOCUMENTS HAVE BEEN PREPARED BASED ON
INFORMATION PROVIDED BY OTHERS. THE CONSULTANT HAS
NOT VERIFIED THE ACCURACY AND/OR COMPLETENESS OF THIS
INFORMATION AND SHALL NOT BE RESPONSIBLE FOR ANY
ERRORS OR OMISSIONS THAT MAY BE INCORPORATED AS A
RESULT OF ERRONEOUS INFORMATION PROVIDED BY OTHERS.







THE SEAL APPEARING ON THIS
DOCUMENT WAS AUTHORIZED BY
KENNETH A. ROBERTS, P.E. 55446
ON OCTOBER 24, 1997



CROSS SECTIONS						
STA. 44+34.29 TO STA. 47+00						
ARAPAHO ROAD						
ADDISON ROAD TO DALLAS NORTH TOLLWAY						
TOWN OF ADDISON, TEXAS						
Huitt-Zollars, Inc./Consulting Engineers						
Dallas, Fort Worth, Houston, Phoenix, Tustin						
DESIGN	DRAWN	APPR.	SCALE	DATE	PROJECT NO.	NO.
HZI	HZI	KAR	1/2"=20' 1/4"=8'	OCT 97	1772-01	X-4

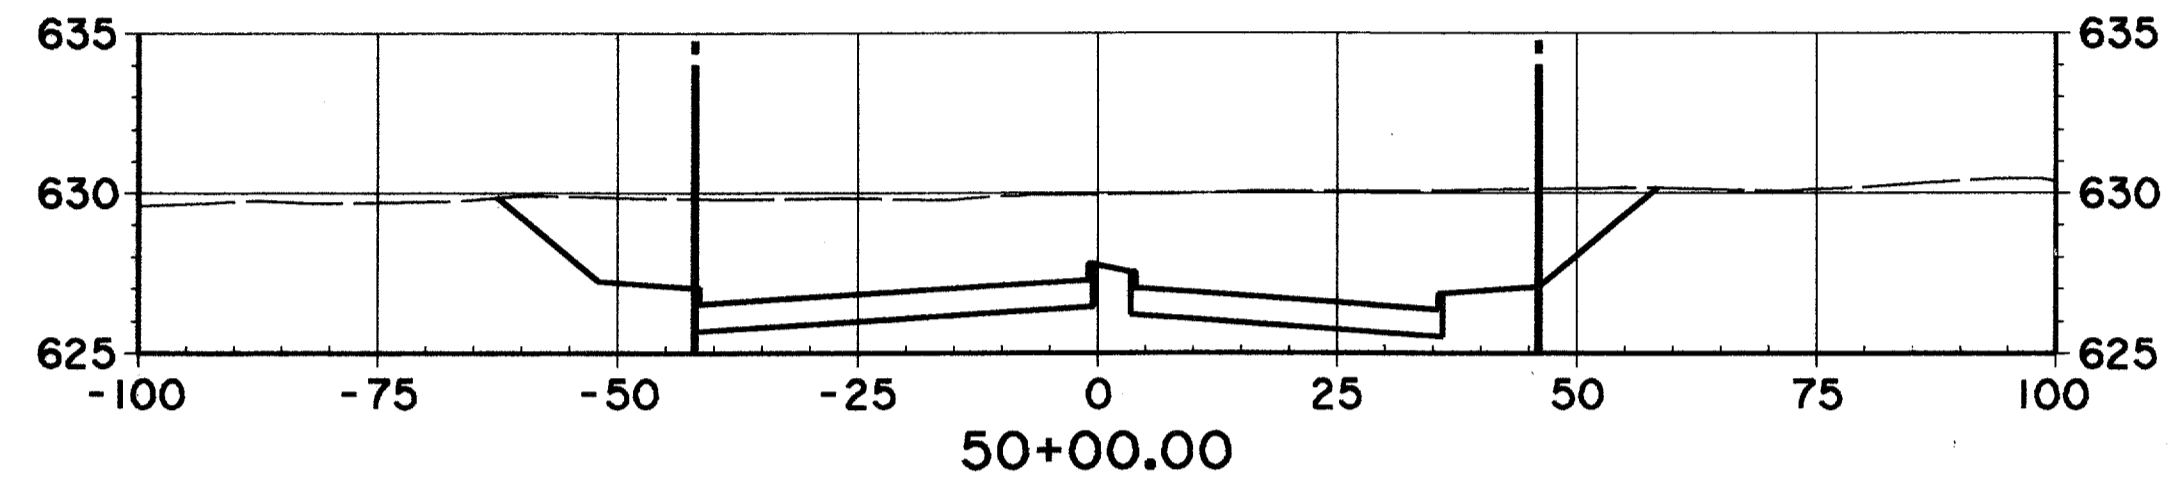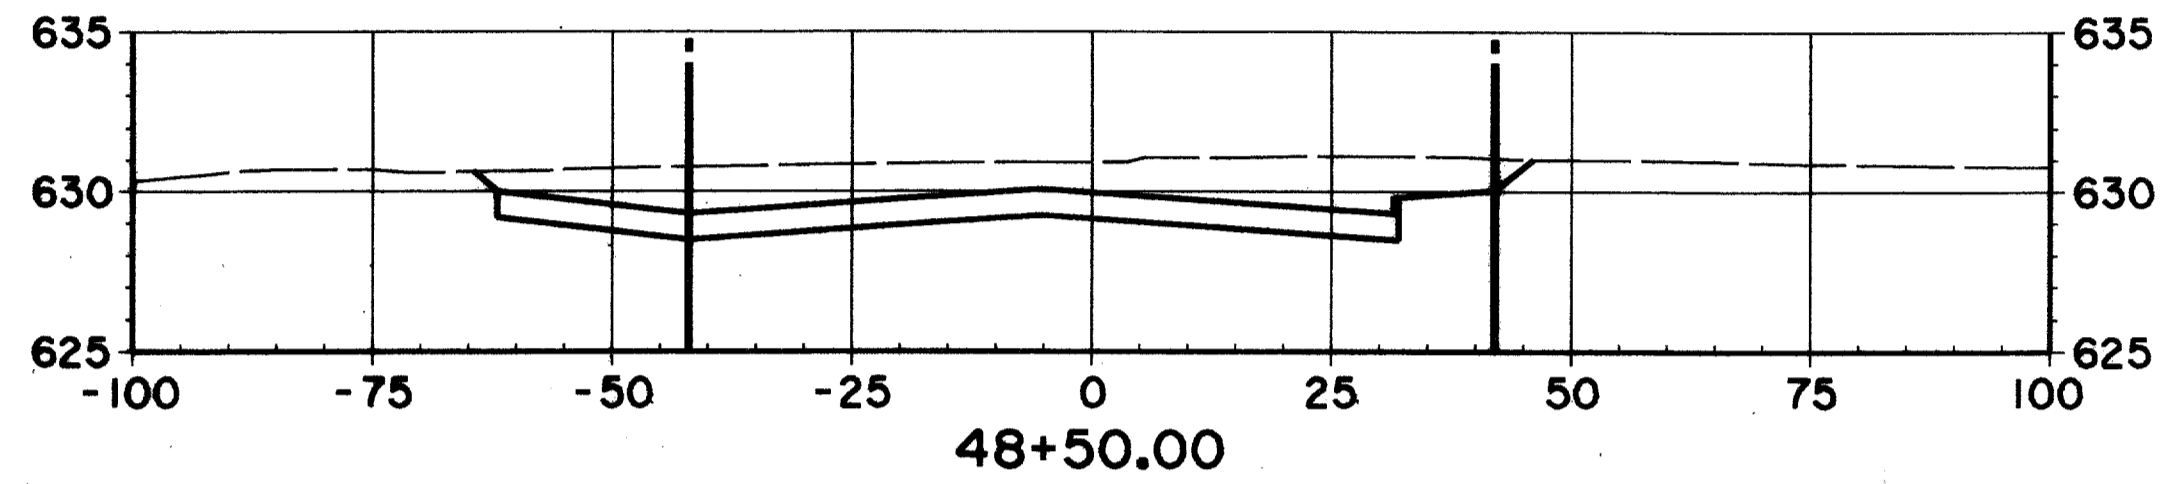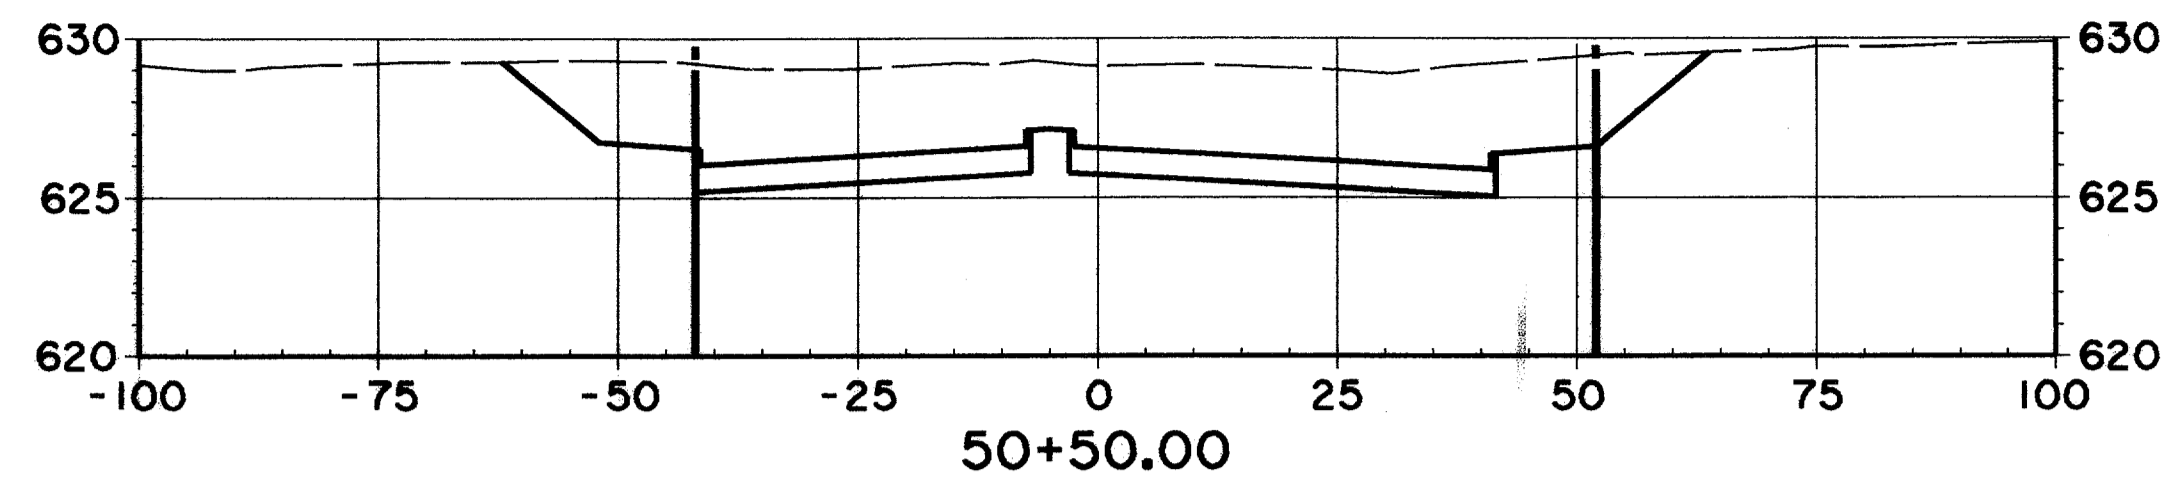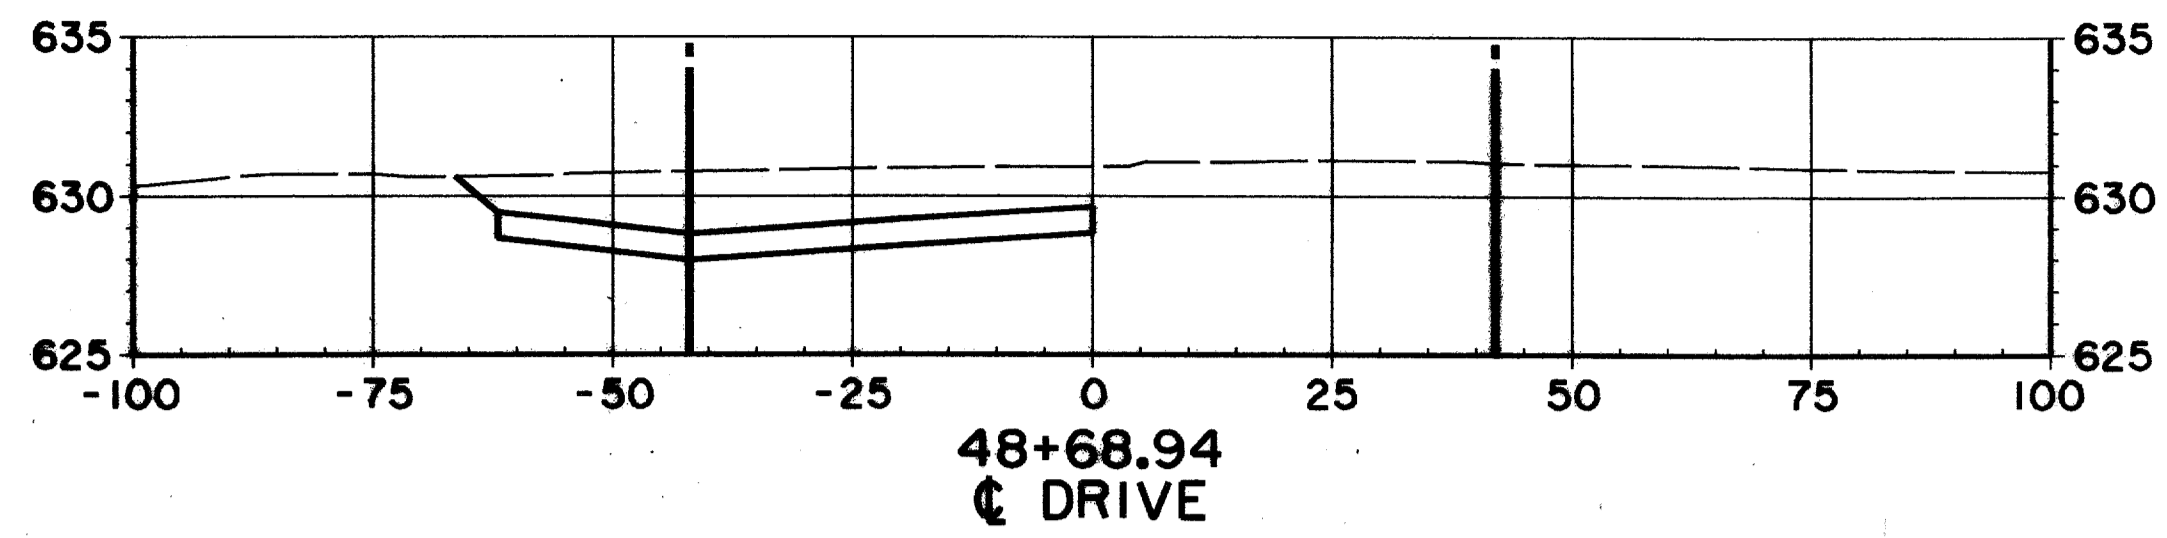

EX. GROUND NORTH OF
R.O.W. LINE STA. 42+50
TO STA. 52+00 MAY HAVE
BEEN MODIFIED DUE TO
CONSTRUCTION OF DART
TRANSIT CENTER

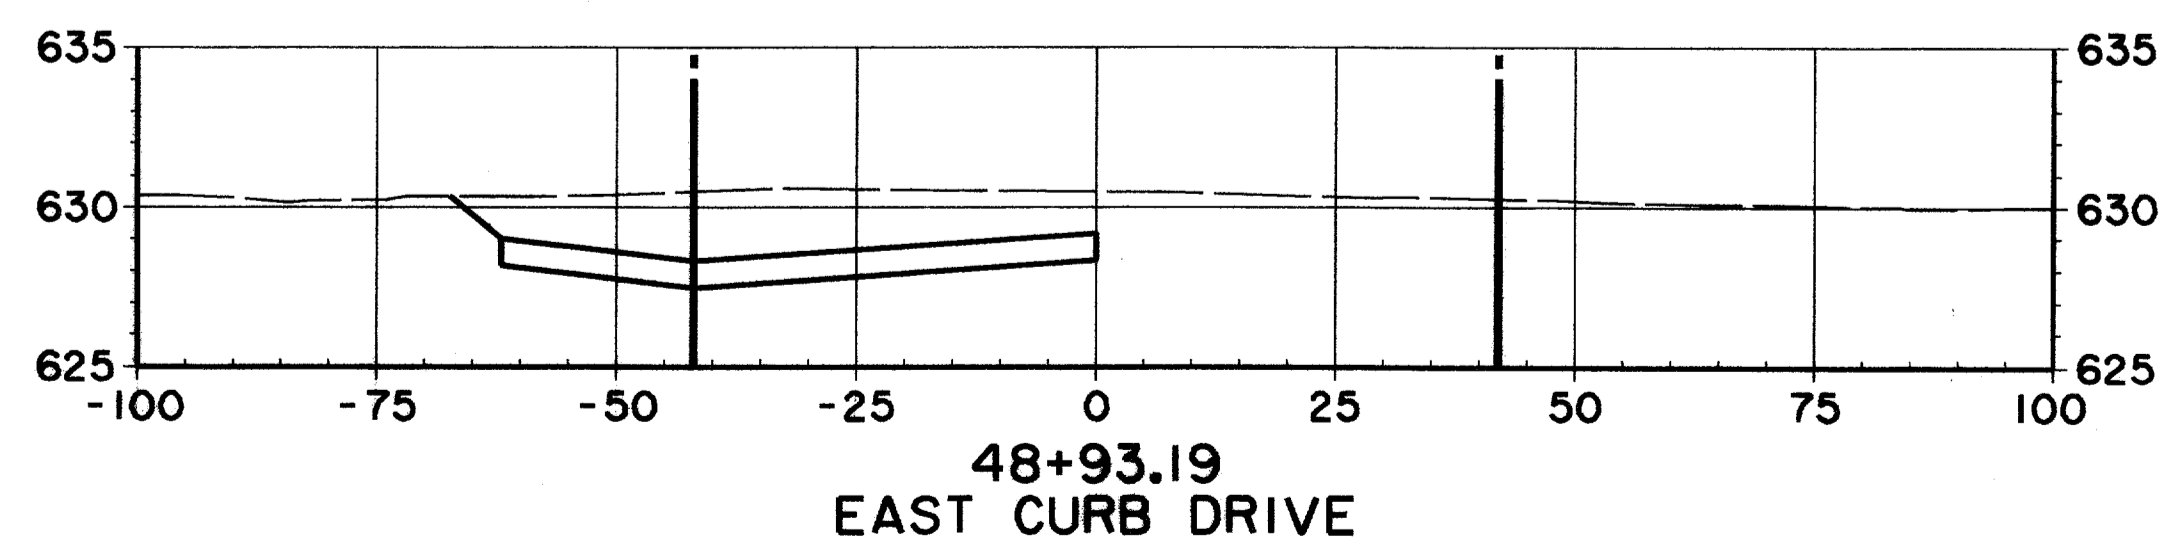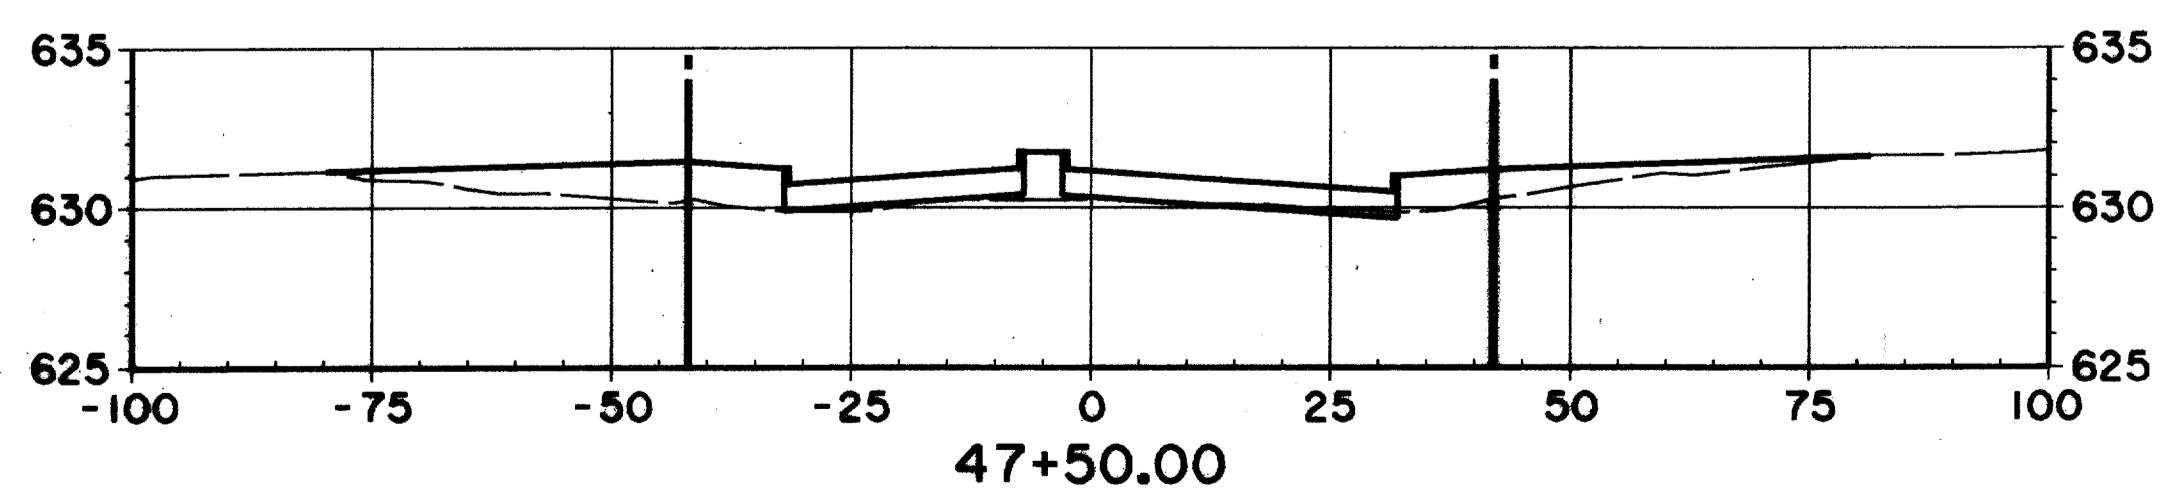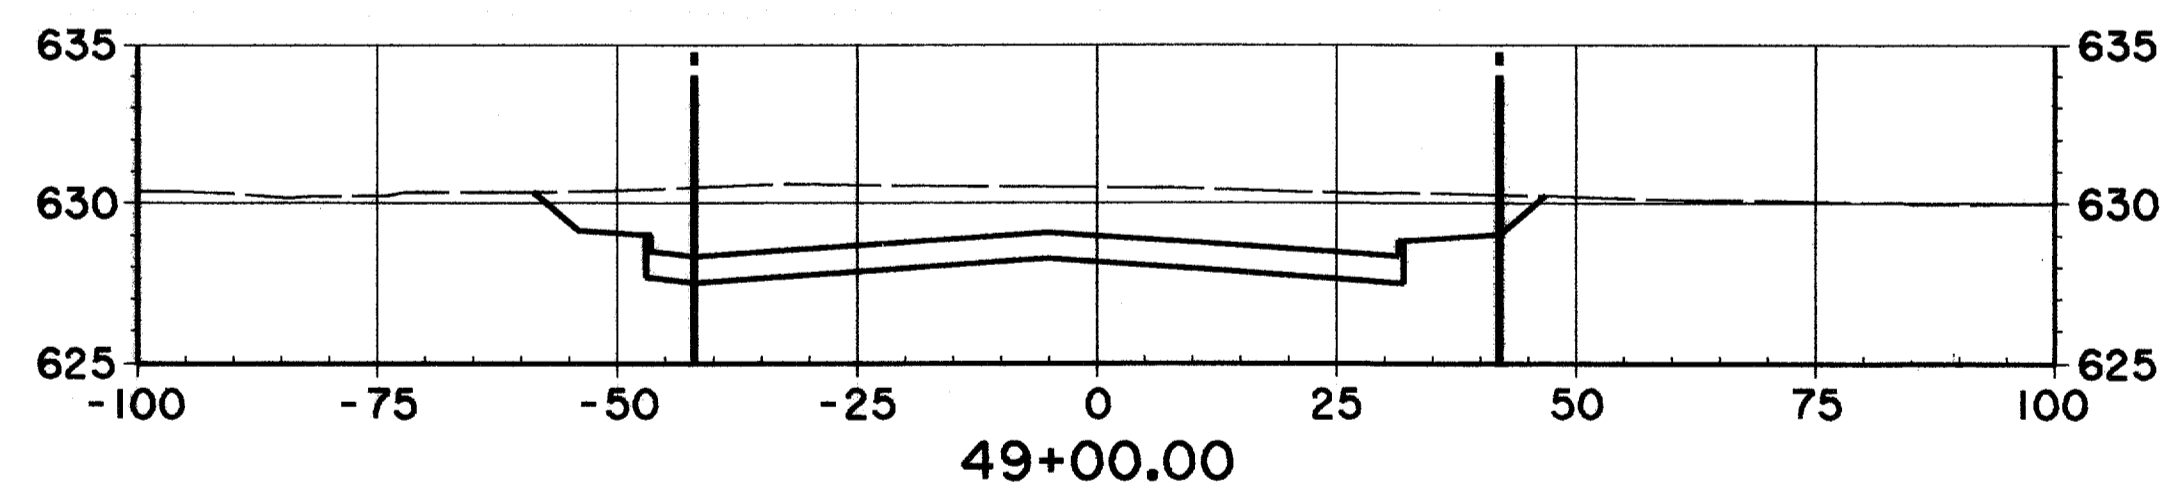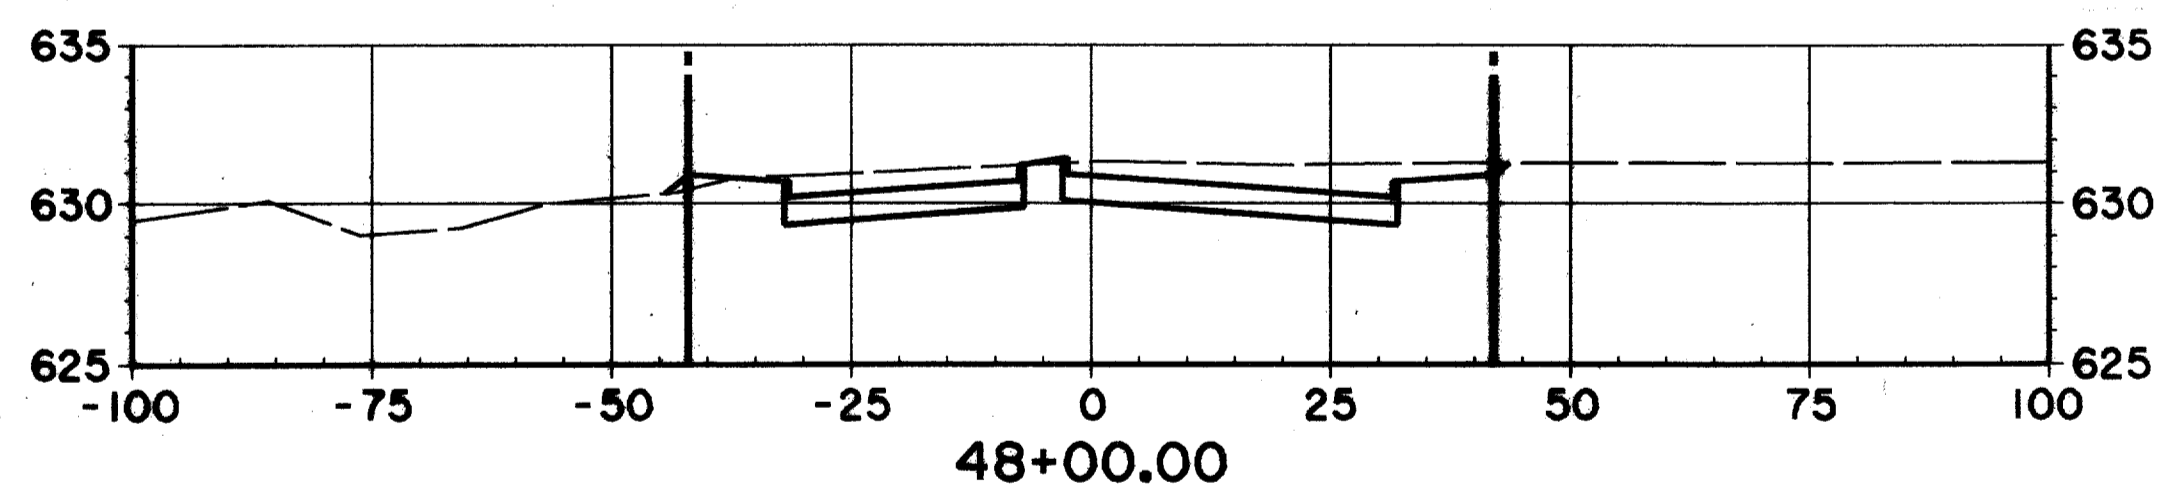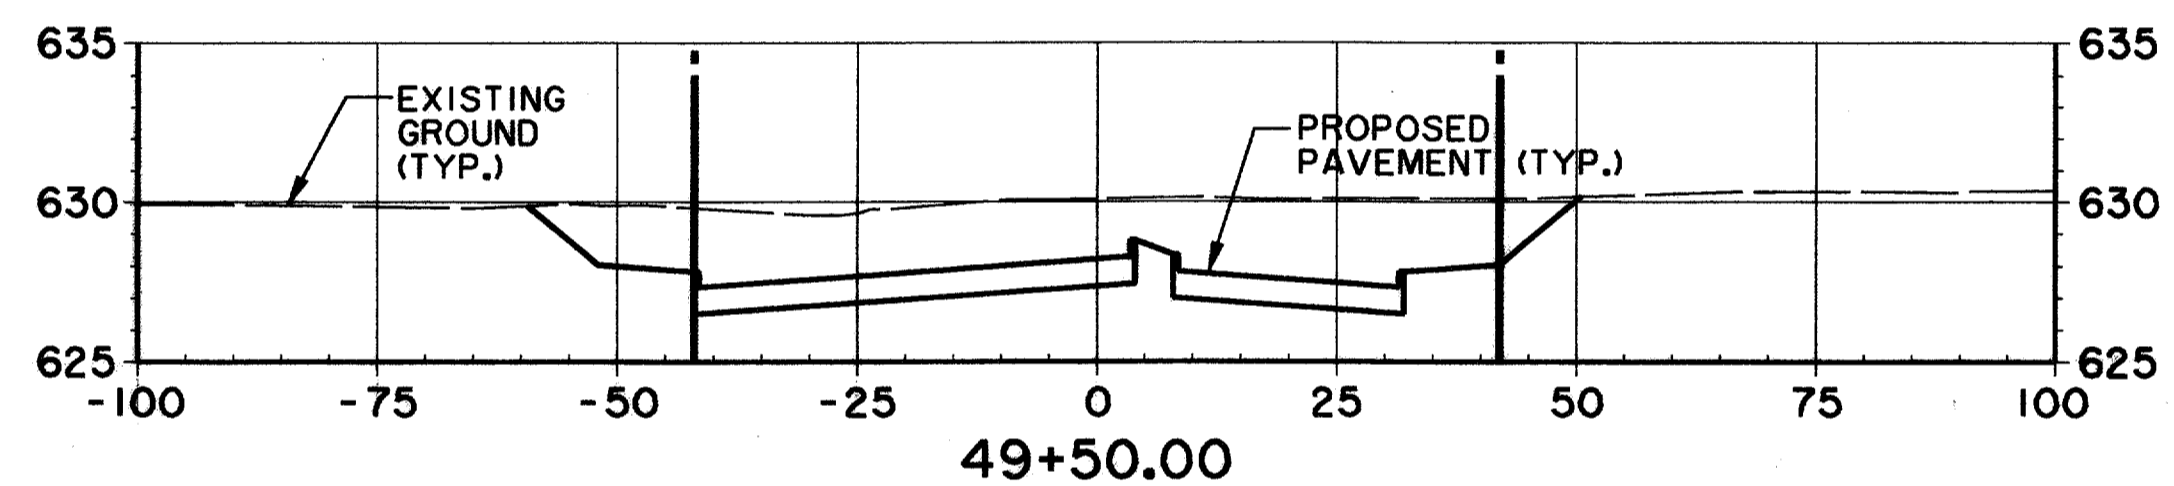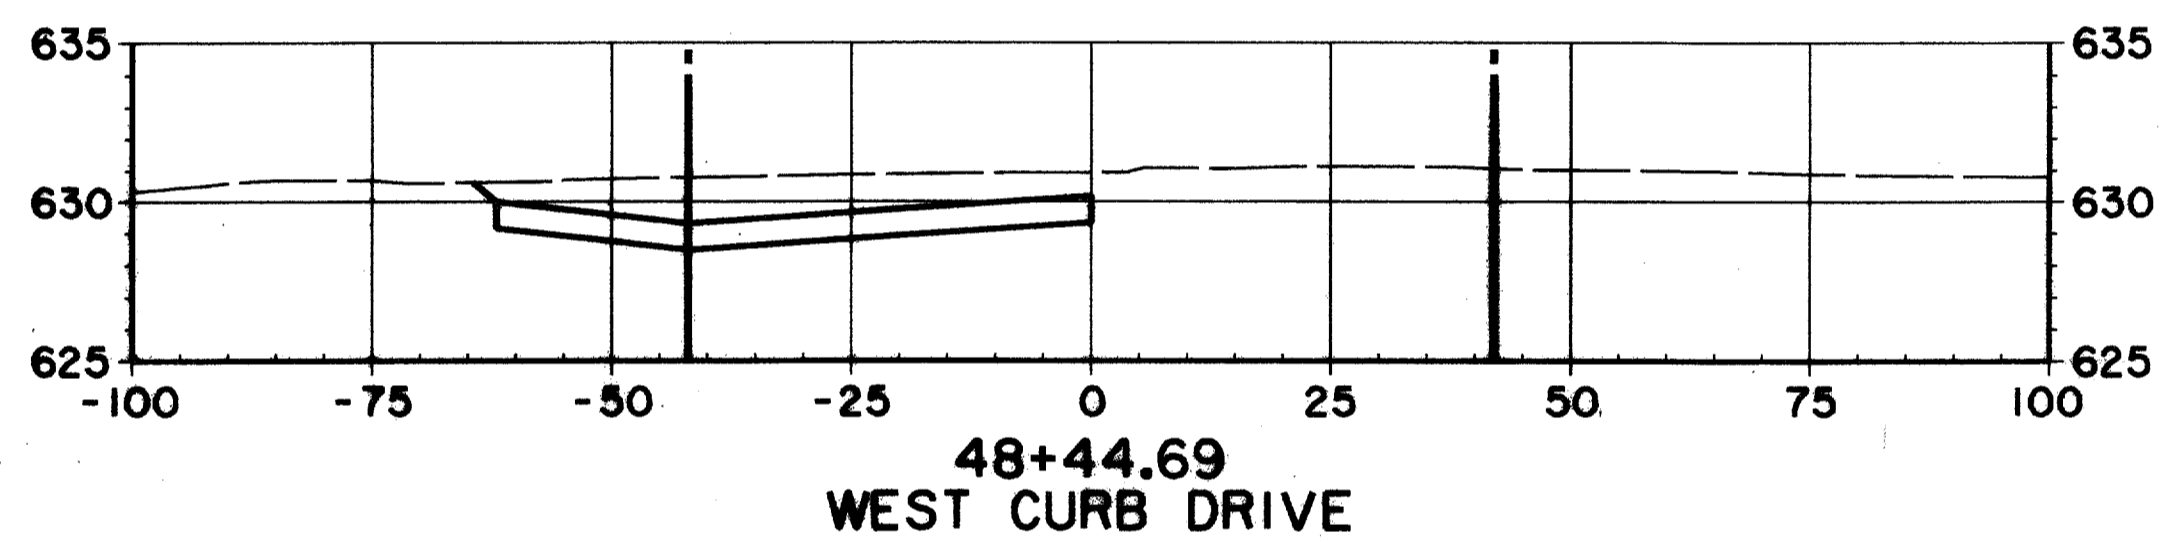

RECORD DOCUMENTS 6/9/2000







THESE RECORD DOCUMENTS HAVE BEEN PREPARED BASED ON INFORMATION PROVIDED BY OTHERS. THE CONSULTANT HAS NOT VERIFIED THE ACCURACY AND/OR COMPLETENESS OF THIS INFORMATION AND SHALL NOT BE RESPONSIBLE FOR ANY ERRORS OR OMISSIONS THAT MAY BE INCORPORATED AS A RESULT OF ERRONEOUS INFORMATION PROVIDED BY OTHERS.

THE SEAL APPEARING ON THIS DOCUMENT WAS AUTHORIZED BY KENNETH A. ROBERTS, P.E. 55446 ON OCTOBER 24, 1997







10-24-97


CROSS SECTIONS						
STA. 47+50 TO STA. 50+50						
ARAPAHO ROAD						
ADDISON ROAD TO DALLAS NORTH TOLLWAY						
TOWN OF ADDISON, TEXAS						
Huitt-Zollars, Inc./Consulting Engineers Dallas, Fort Worth, Houston, Phoenix, Tustin						
DESIGN	DRAWN	APPR.	SCALE	DATE	PROJECT NO.	NO.
HZI	HZI	KAR	1/4" = 20' 1/8" = 6'	OCT 97	1772-01	X-5

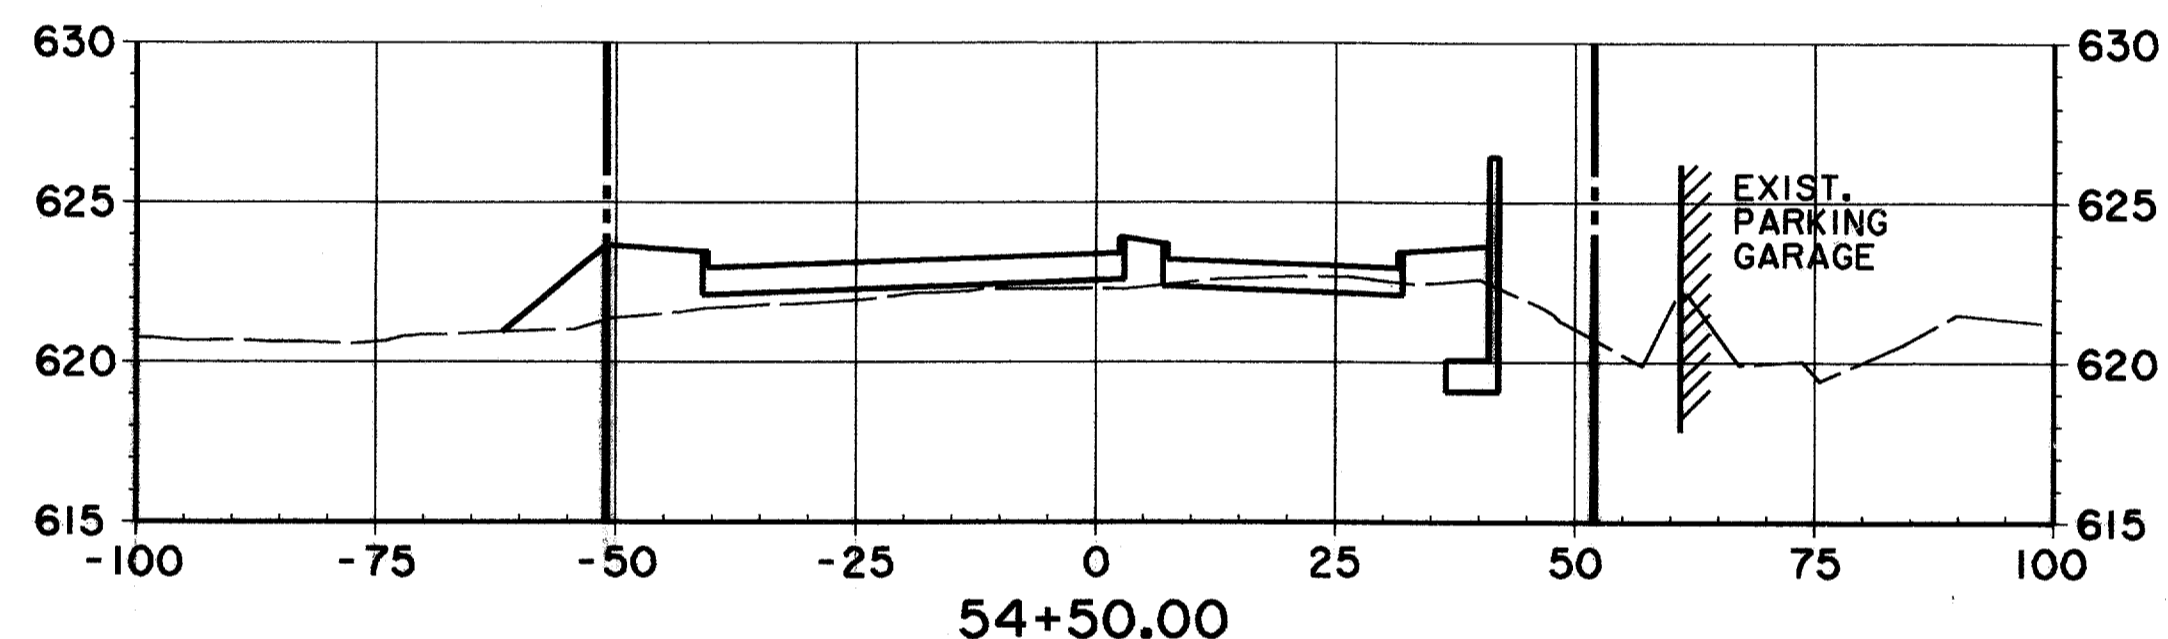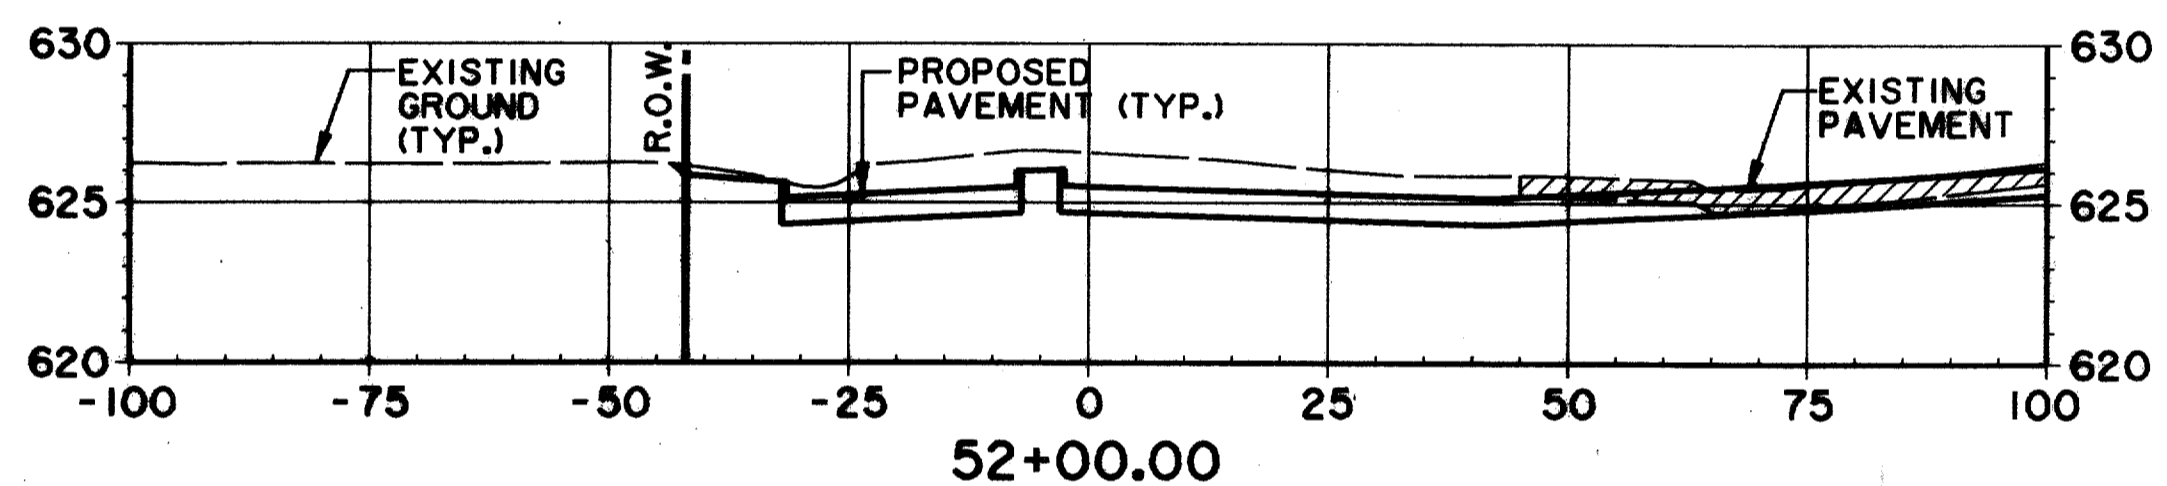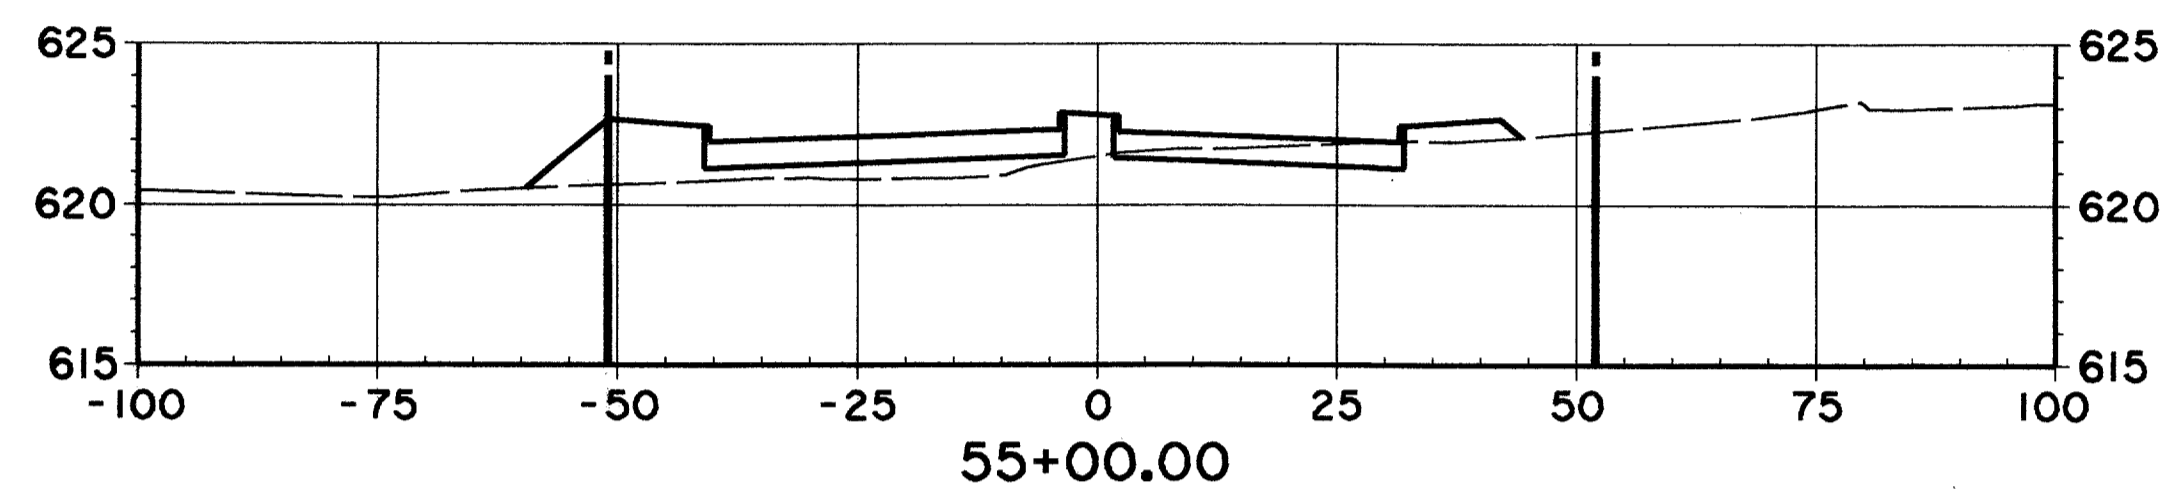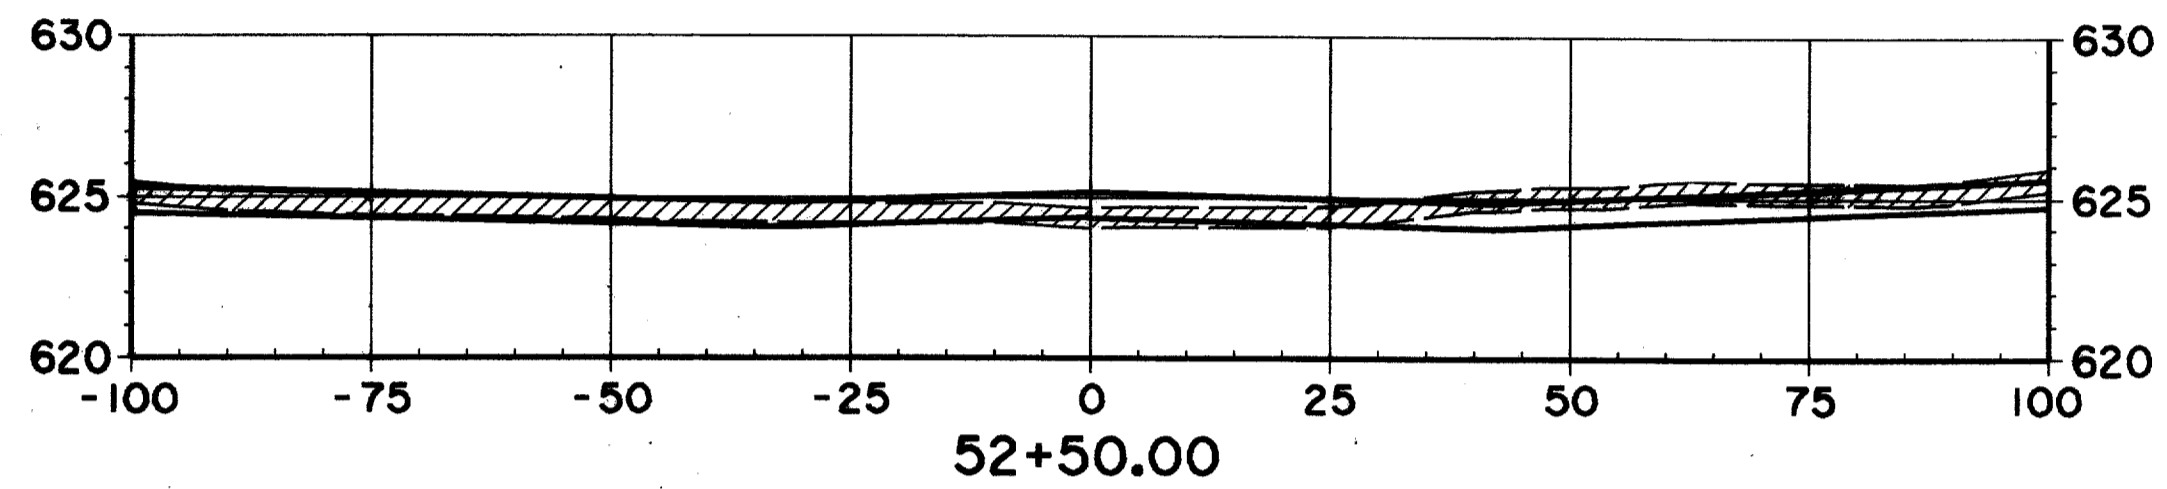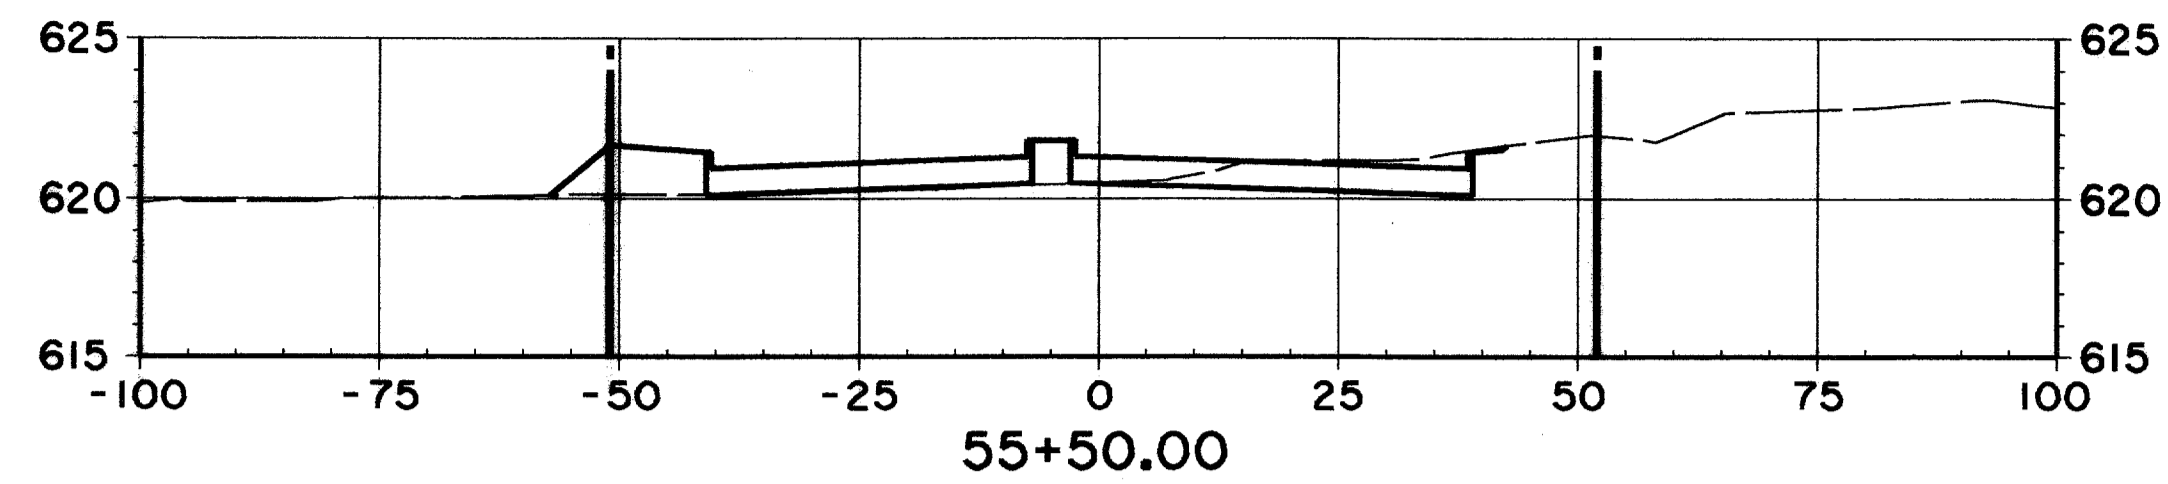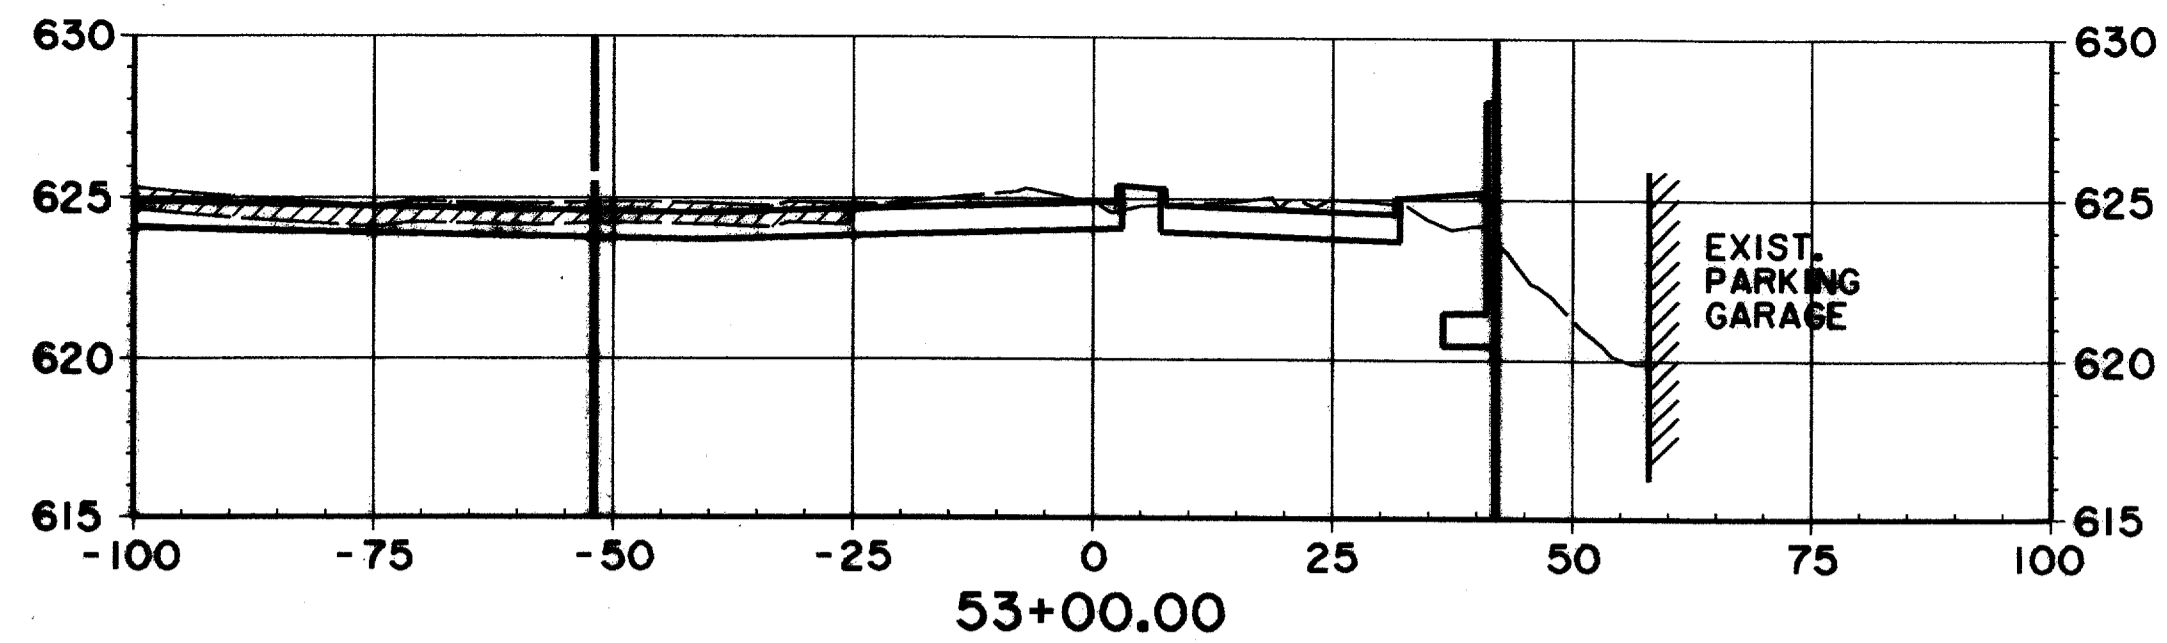


EX. GROUND NORTH OF
R.O.W. LINE STA. 42+50
TO STA. 52+00 MAY HAVE
BEEN MODIFIED DUE TO
CONSTRUCTION OF DART
TRANSIT CENTER

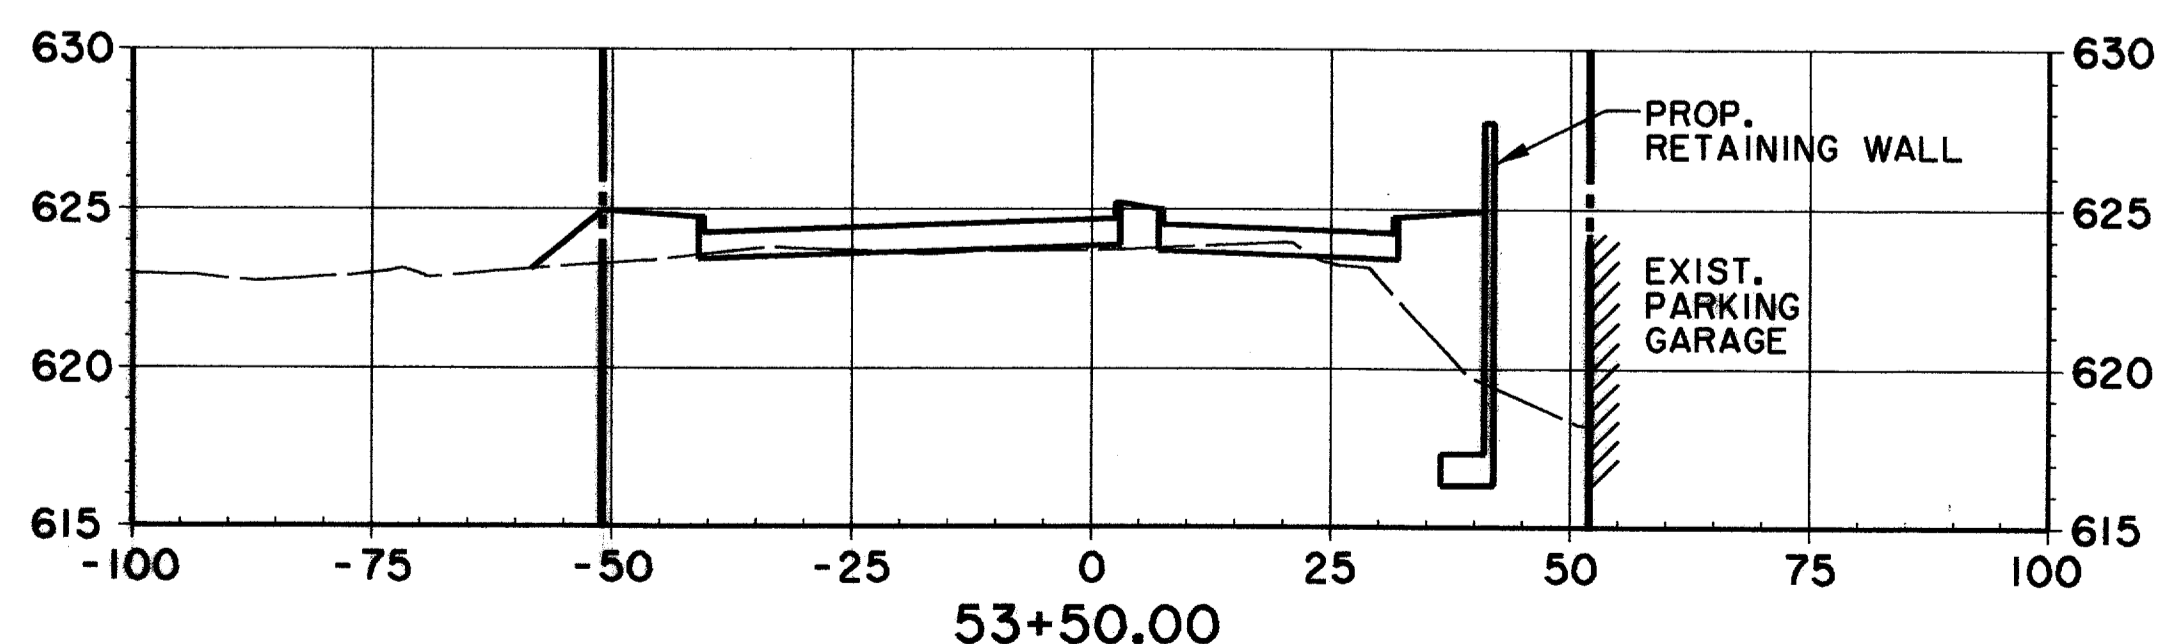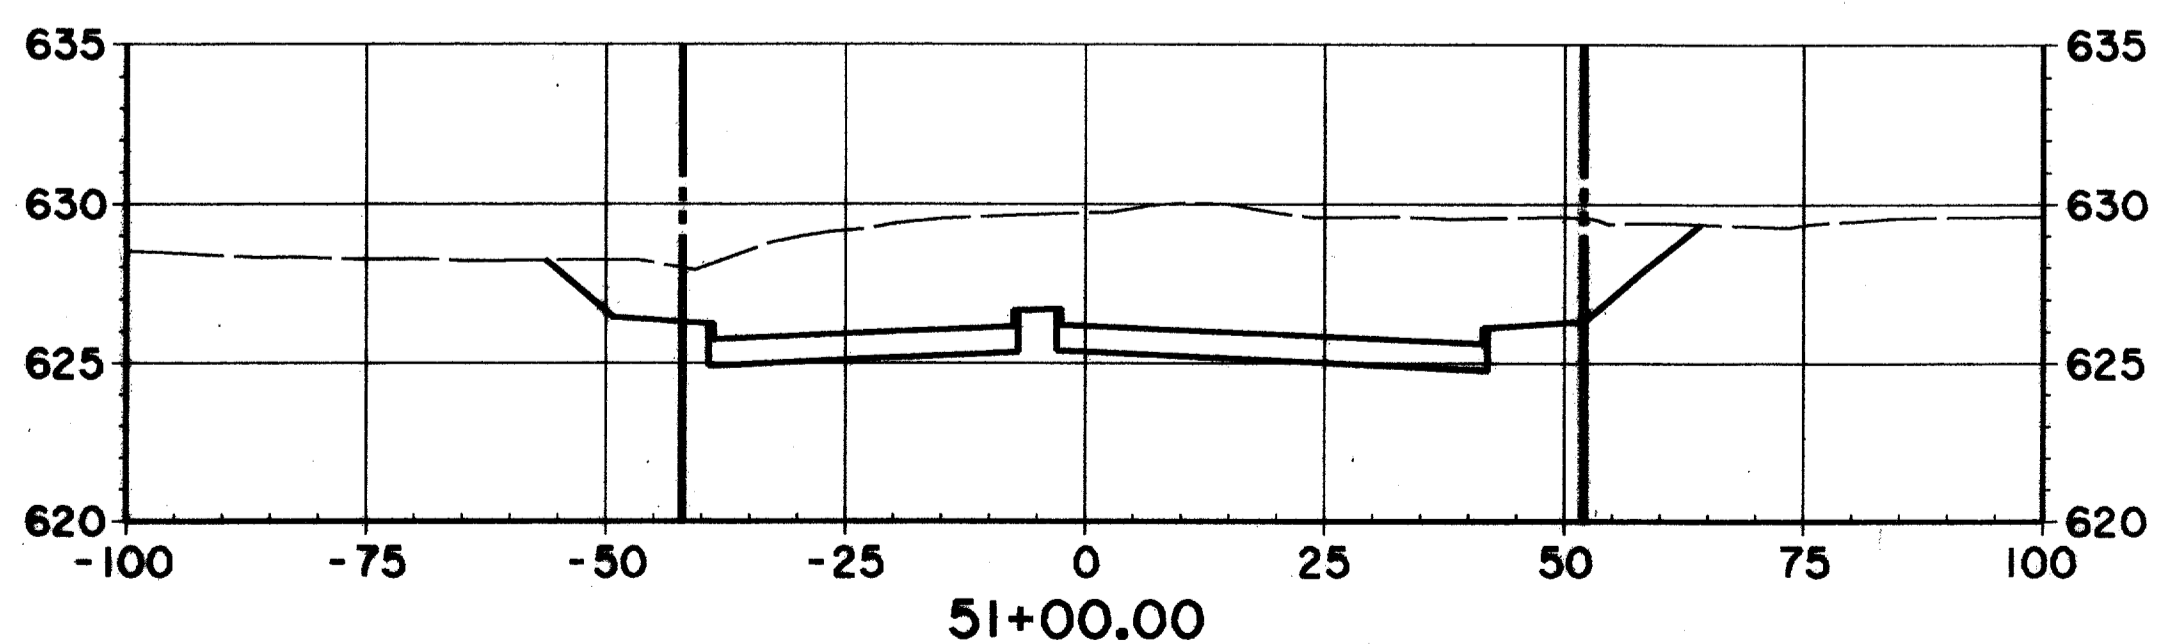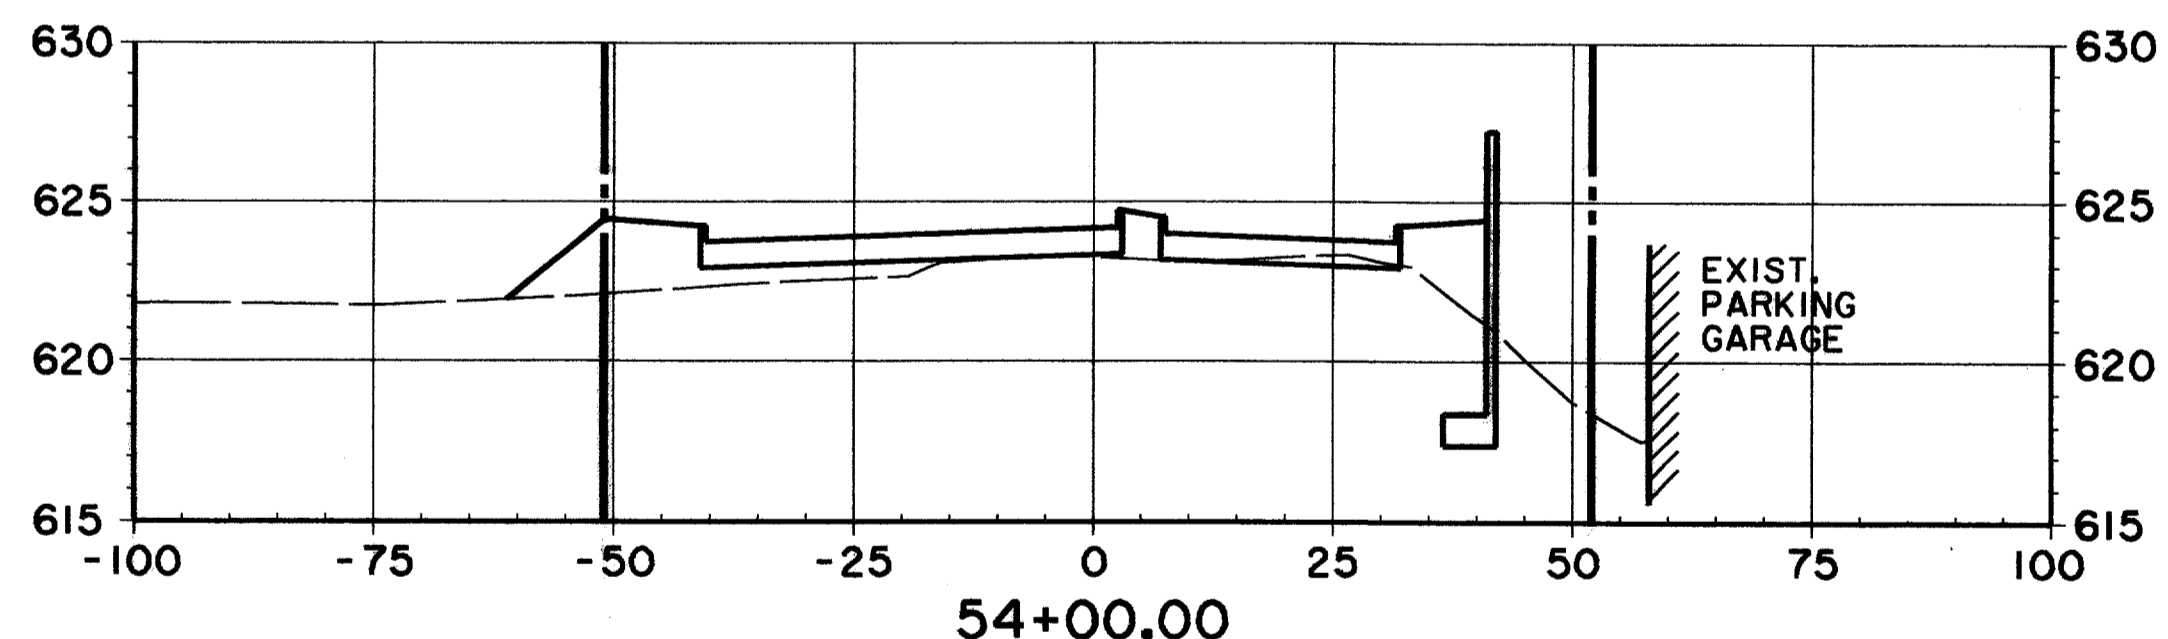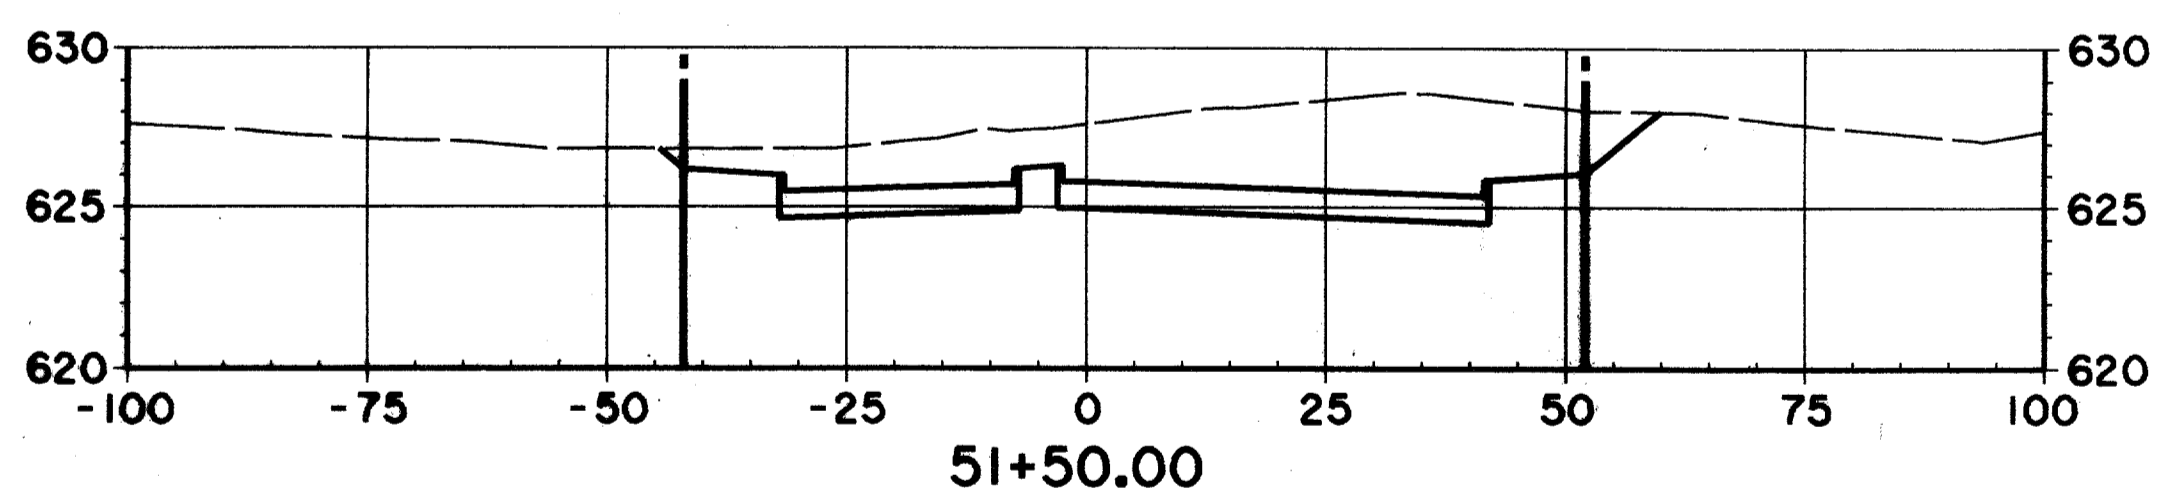


RECORD DOCUMENTS 6/9/2000
THESE RECORD DOCUMENTS HAVE BEEN PREPARED BASED ON
INFORMATION PROVIDED BY OTHERS. THE CONSULTANT HAS
NOT VERIFIED THE ACCURACY AND/OR COMPLETENESS OF THIS
INFORMATION AND SHALL NOT BE RESPONSIBLE FOR ANY
ERRORS OR OMISSIONS THAT MAY BE INCORPORATED AS A
RESULT OF ERRONEOUS INFORMATION PROVIDED BY OTHERS.

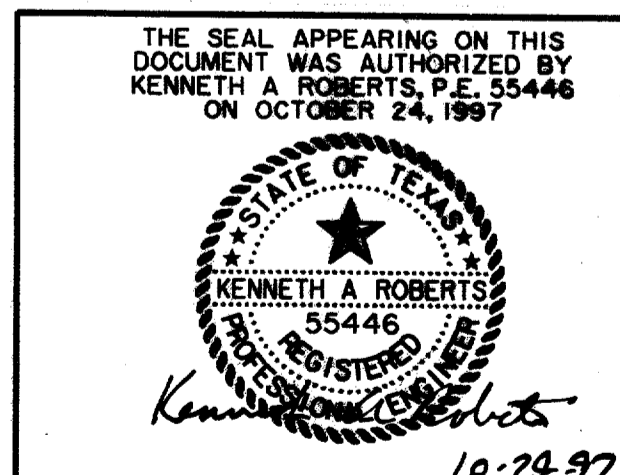

CROSS SECTIONS						
STA. 51+00 TO STA. 55+50						
ARAPAHO ROAD						
ADDISON ROAD TO DALLAS NORTH TOLLWAY						
TOWN OF ADDISON, TEXAS						
Hult-Zollars, Inc./Consulting Engineers Dallas, Fort Worth, Houston, Phoenix, Tustin						
DESIGN	DRAWN	APPR.	SCALE	DATE	PROJECT NO.	NO.
HZI	HZI	KAR	1/4"=20' 1/8"=10'	OCT 97	1772-01	X-6

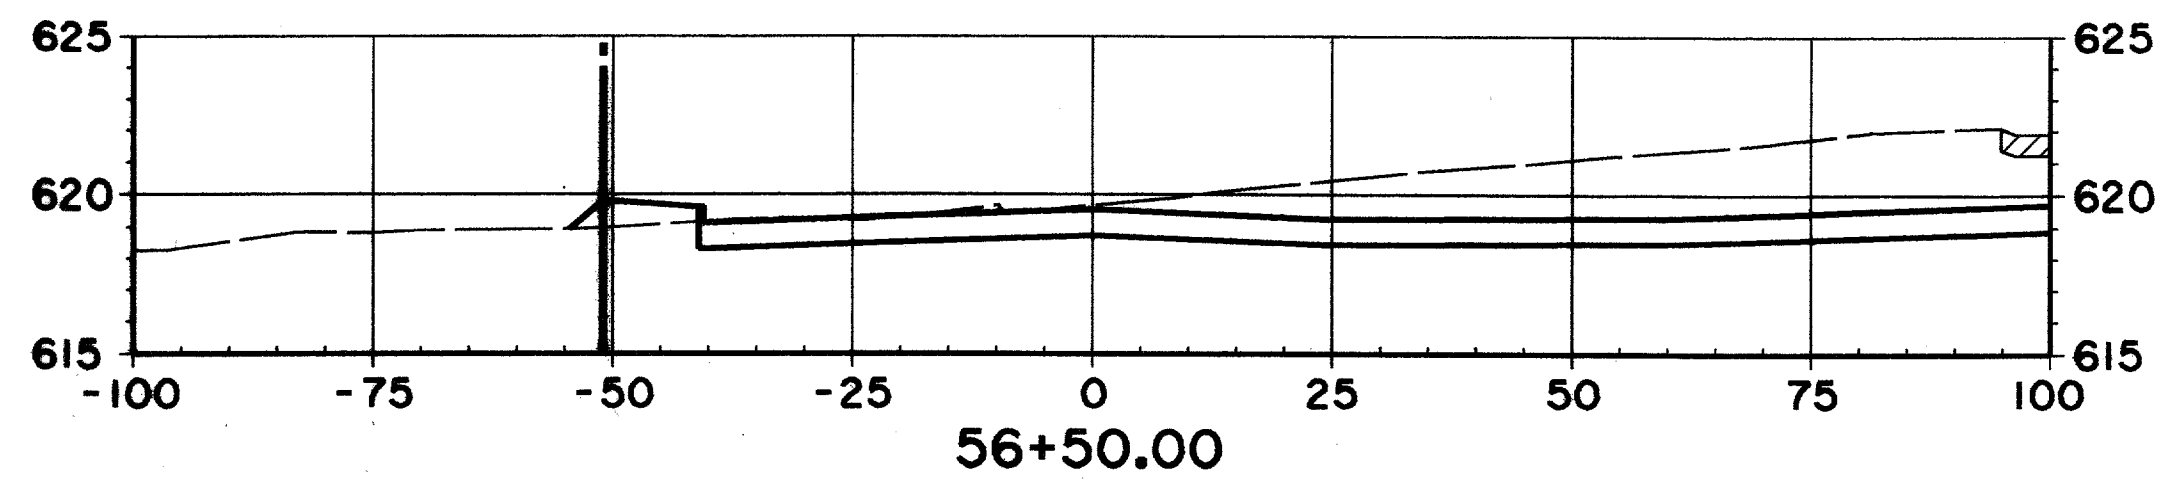


56+50.00

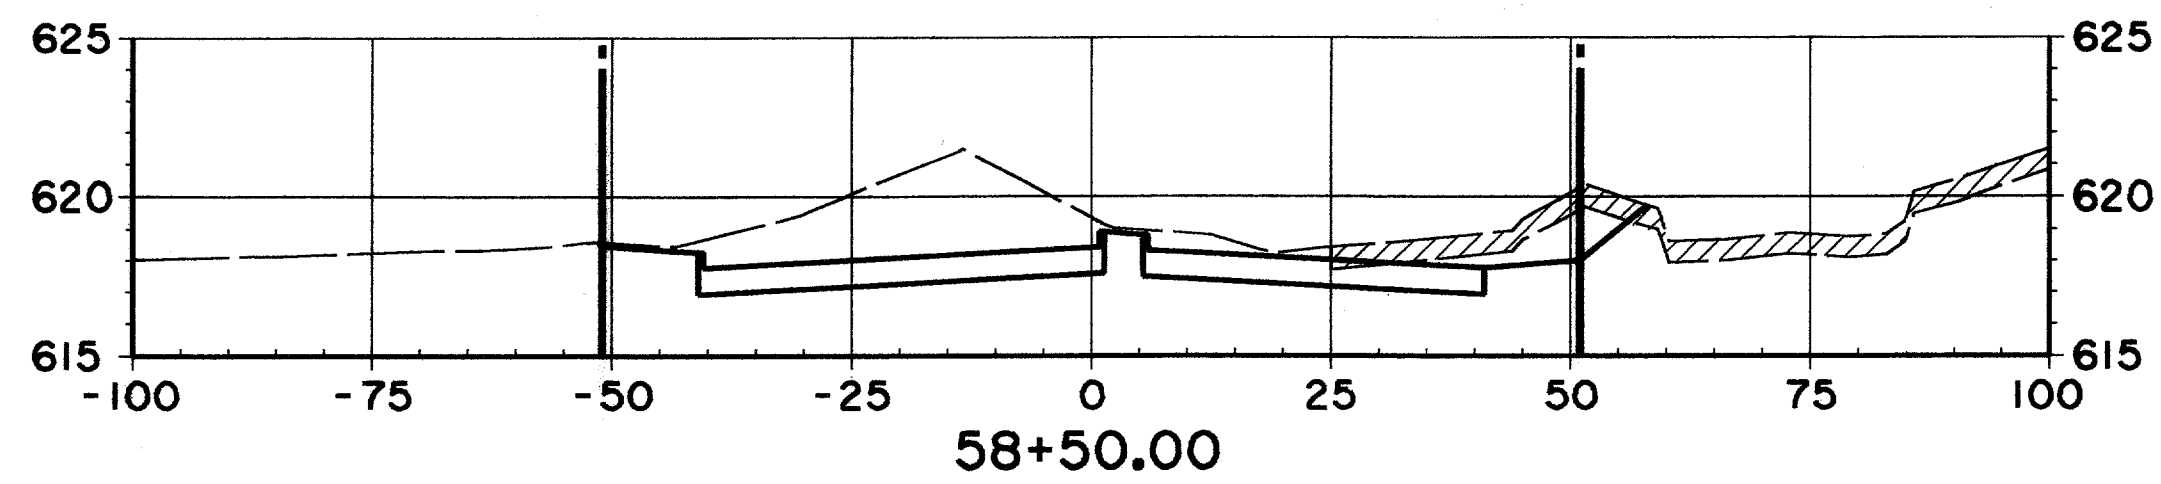


58+50.00


EX. GROUND SOUTH OF
R.O.W. LINE STA. 57+50
TO STA. 66+50 MAY HAVE
BEEN MODIFIED DUE TO
CONSTRUCTION OF THE
COLONNADE TOWER III

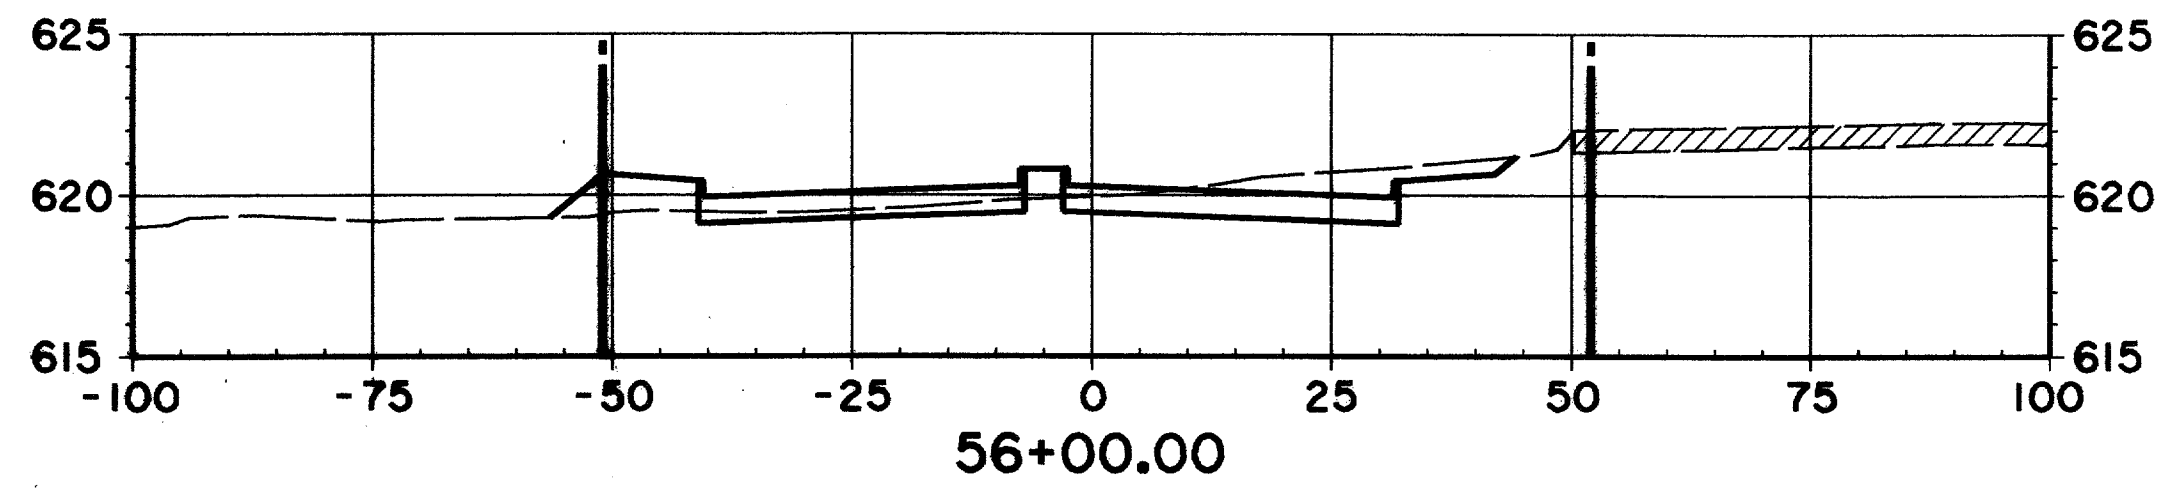


56+00.00

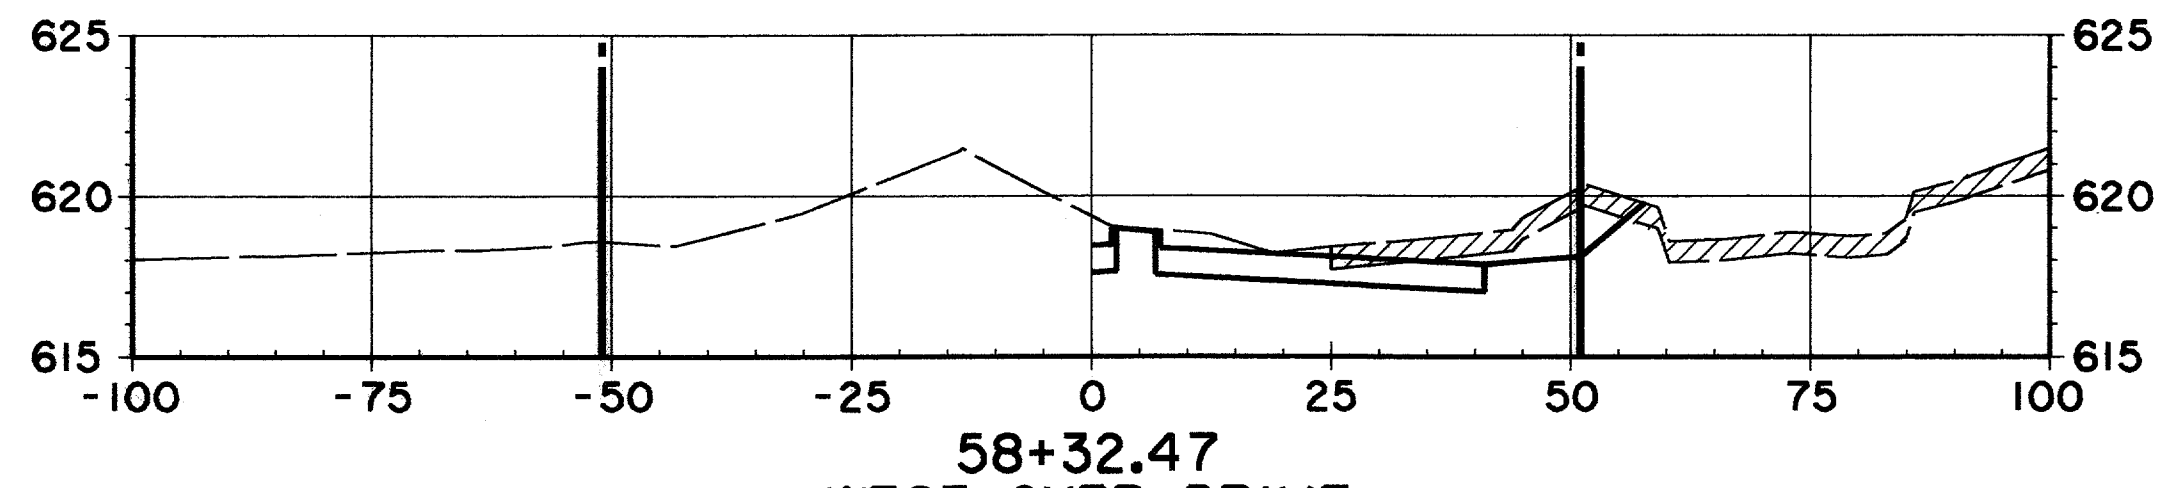


58+32.47
WEST CURB DRIVE

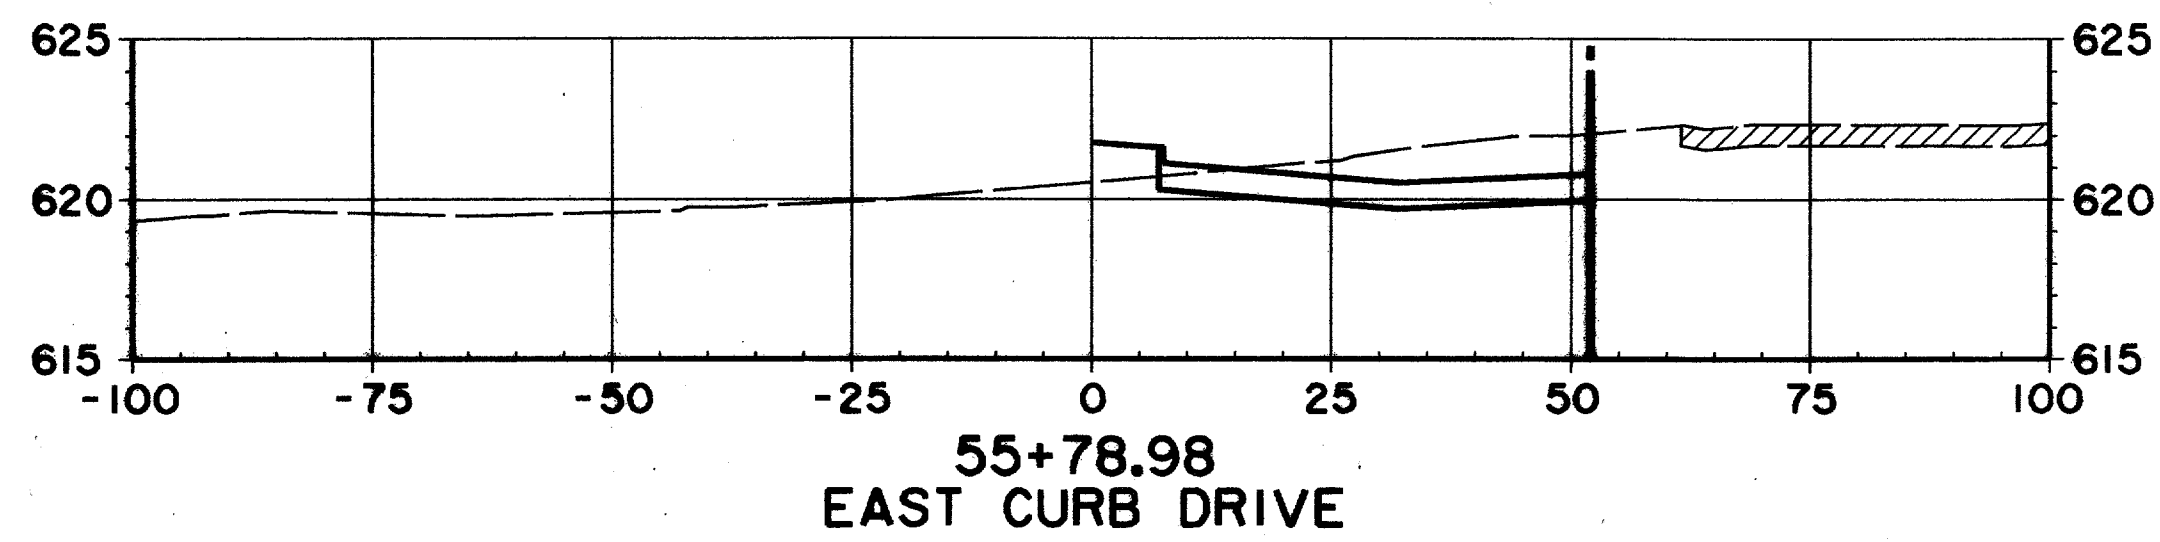


55+78.98
EAST CURB DRIVE

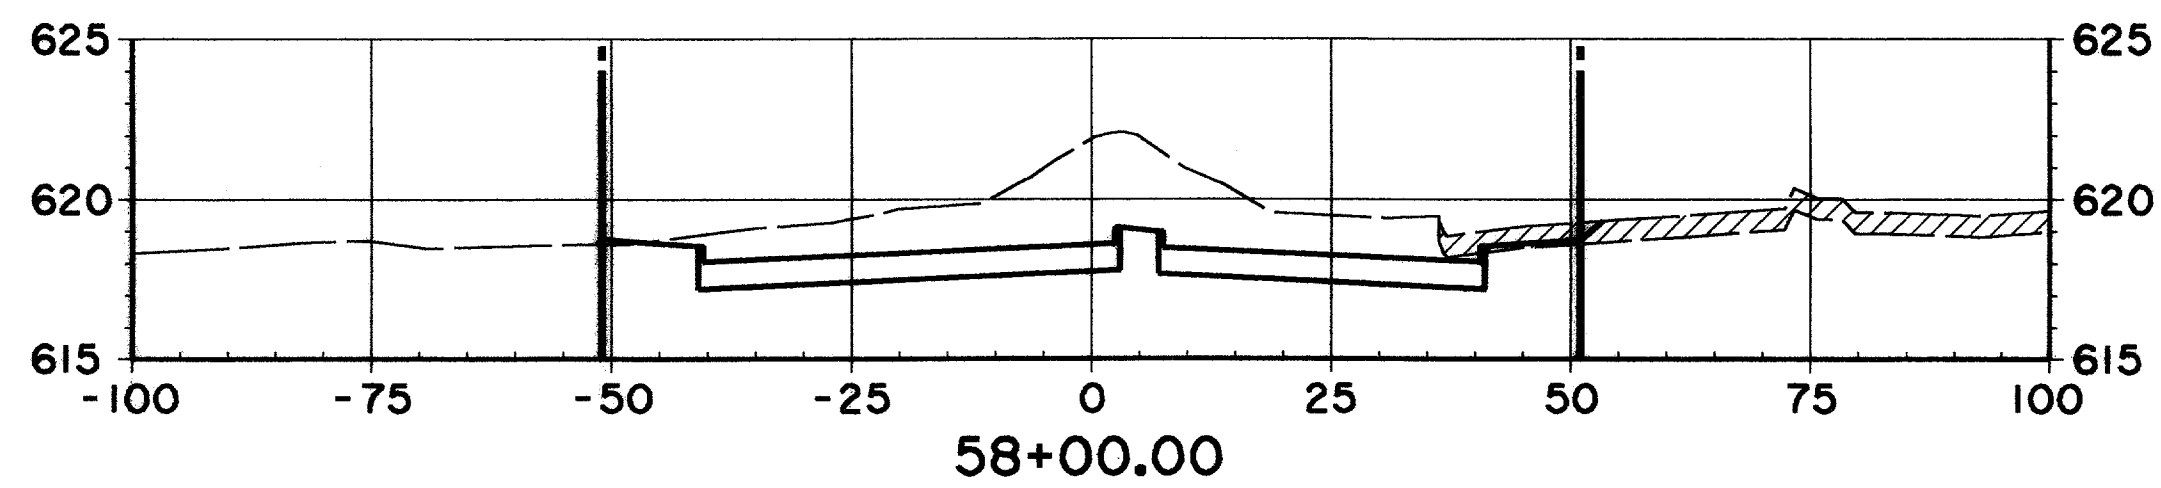


58+00.00

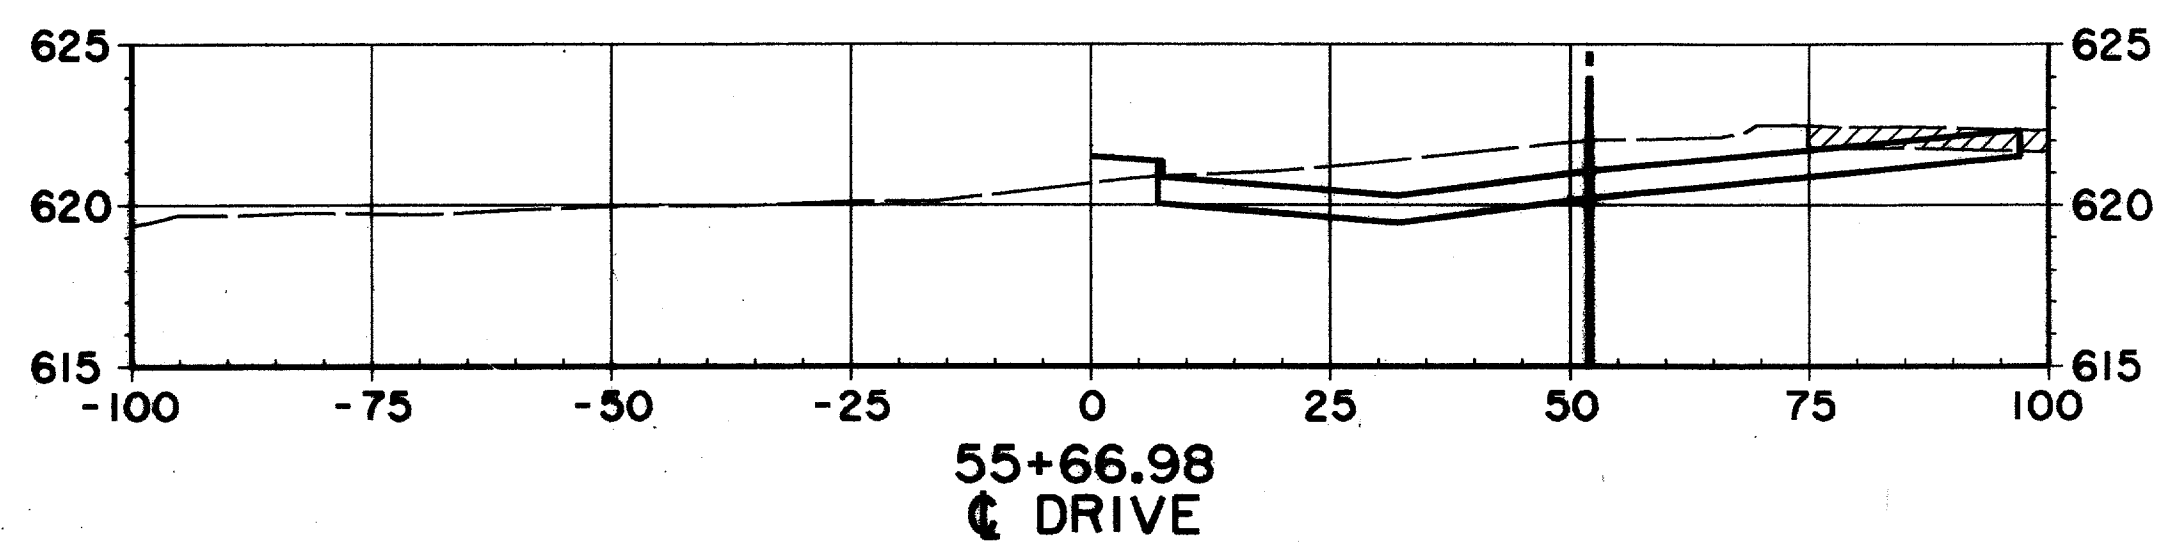


55+66.98
DRIVE

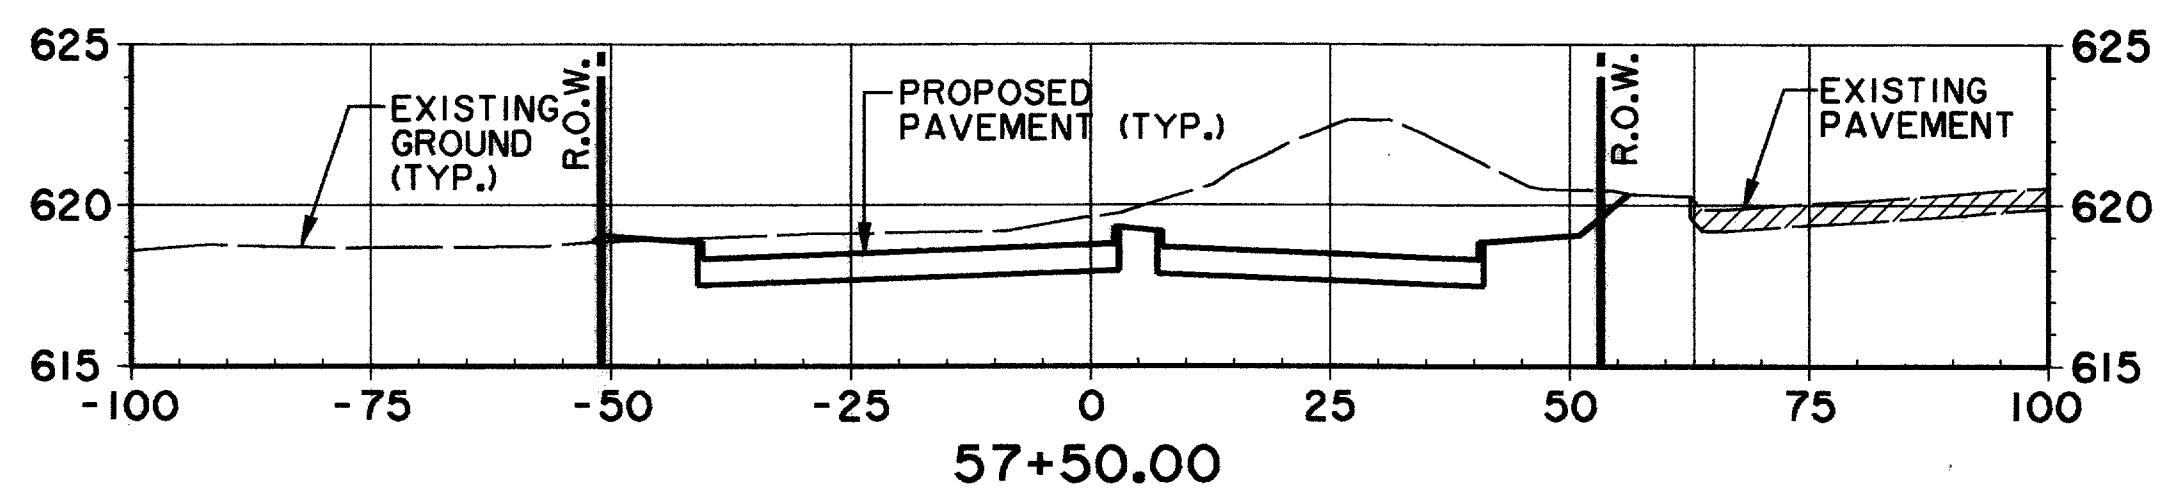

57+50.00

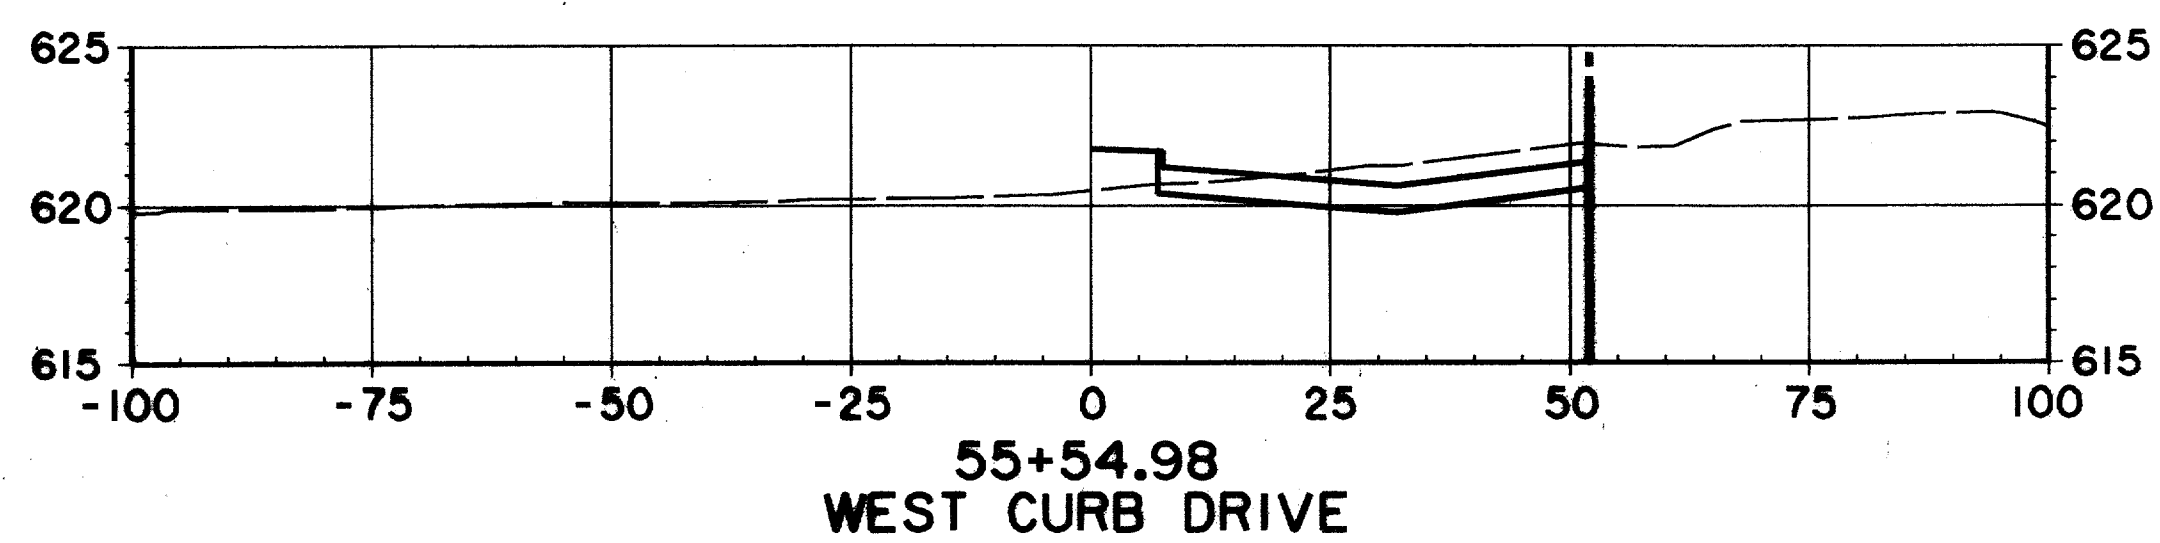


55+54.98
WEST CURB DRIVE




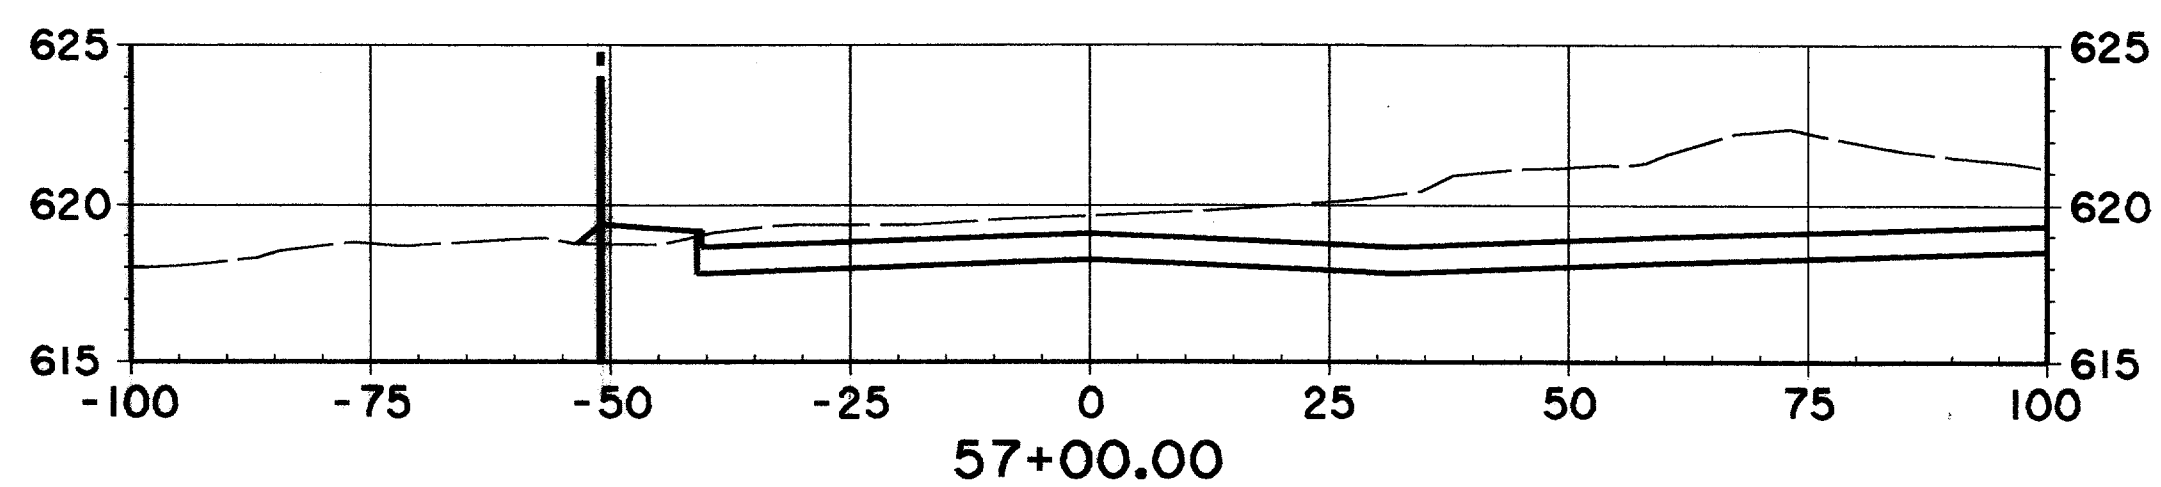


57+00.00





RECORD DOCUMENTS 6/9/2000
THESE RECORD DOCUMENTS HAVE BEEN PREPARED BASED ON INFORMATION PROVIDED BY OTHERS. THE CONSULTANT HAS NOT VERIFIED THE ACCURACY AND/OR COMPLETENESS OF THIS INFORMATION AND SHALL NOT BE RESPONSIBLE FOR ANY ERRORS OR OMISSIONS THAT MAY BE INCORPORATED AS A RESULT OF ERRONEOUS INFORMATION PROVIDED BY OTHERS.

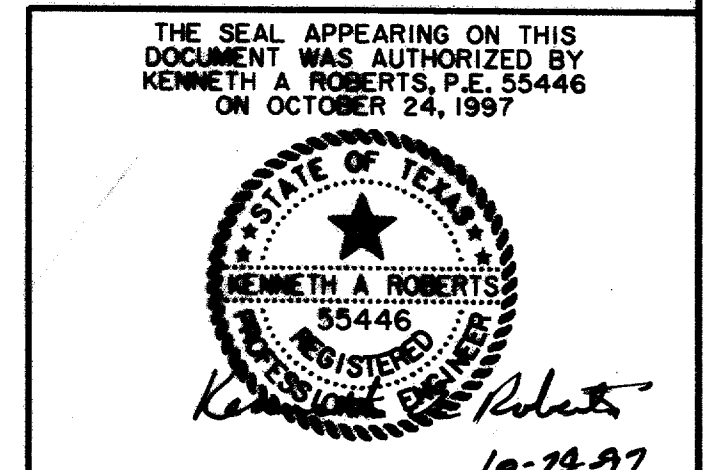

CROSS SECTIONS					
STA. 55+54.98 TO STA. 58+50					
ARAPAHO ROAD					
ADDISON ROAD TO DALLAS NORTH TOLLWAY					
TOWN OF ADDISON, TEXAS					
Huitt-Zollars, Inc./Consulting Engineers Dallas, Fort Worth, Houston, Phoenix, Tustin					
DESIGN	DRAWN	APPR.	SCALE	DATE	PROJECT NO.
HZI	HZI	KAR	H:V = 20' V:1"=40'	OCT 97	1772-01
					NO.
					X-7

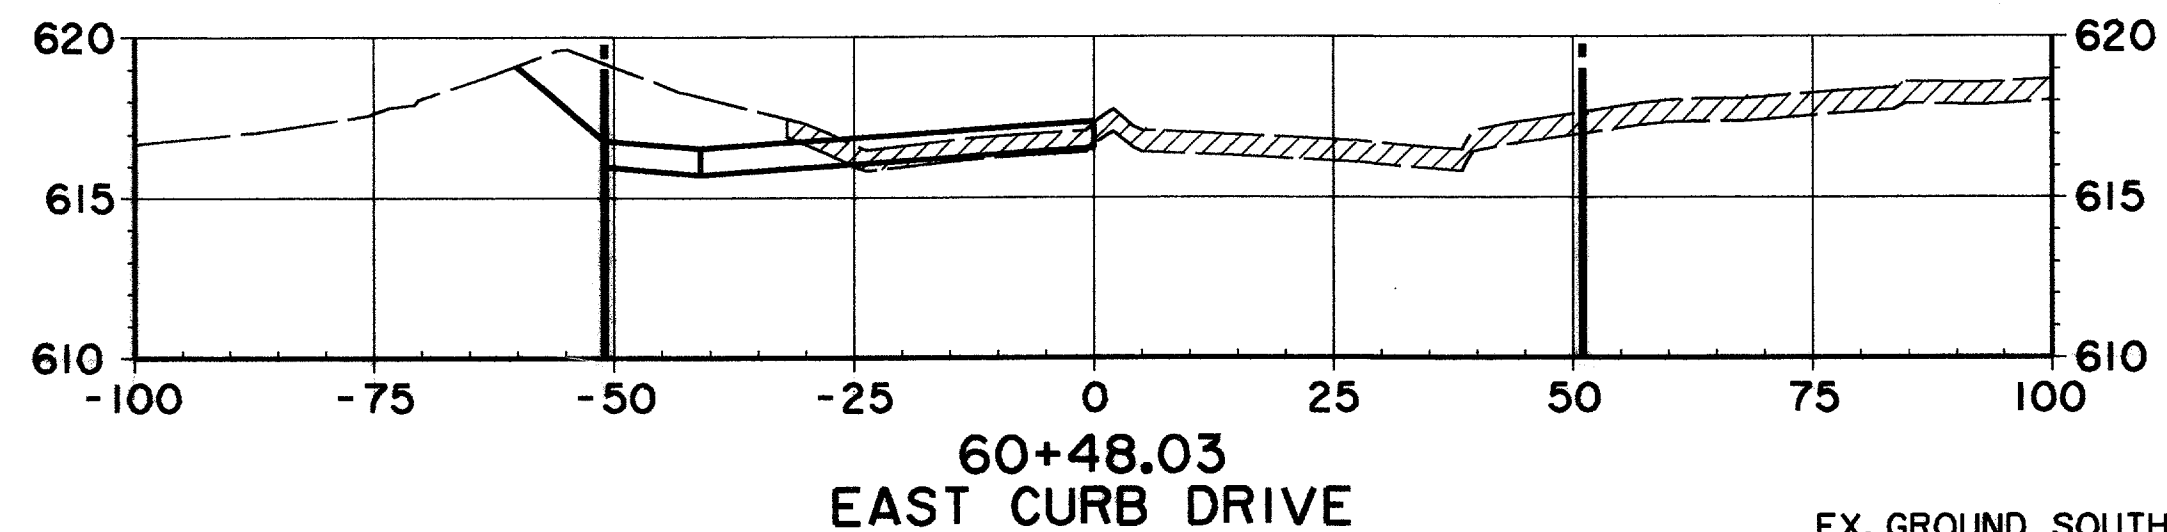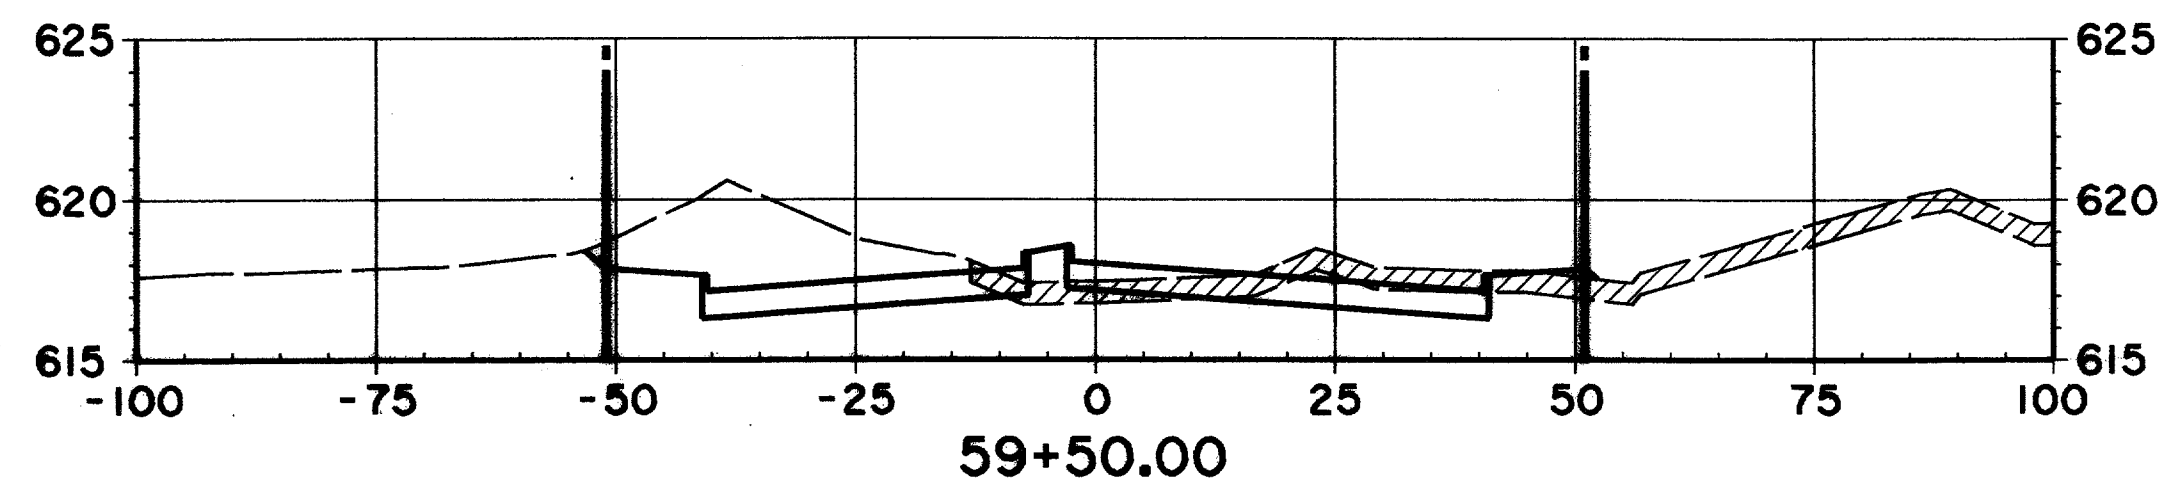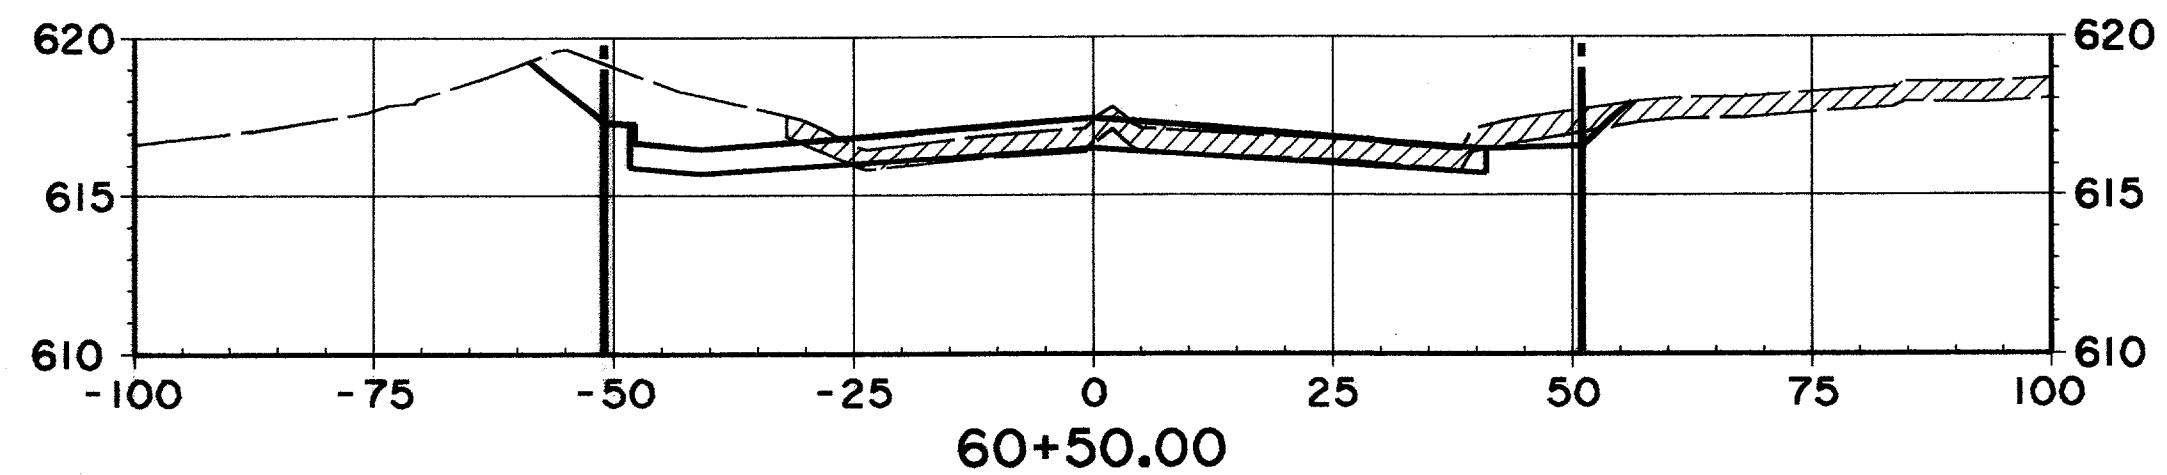
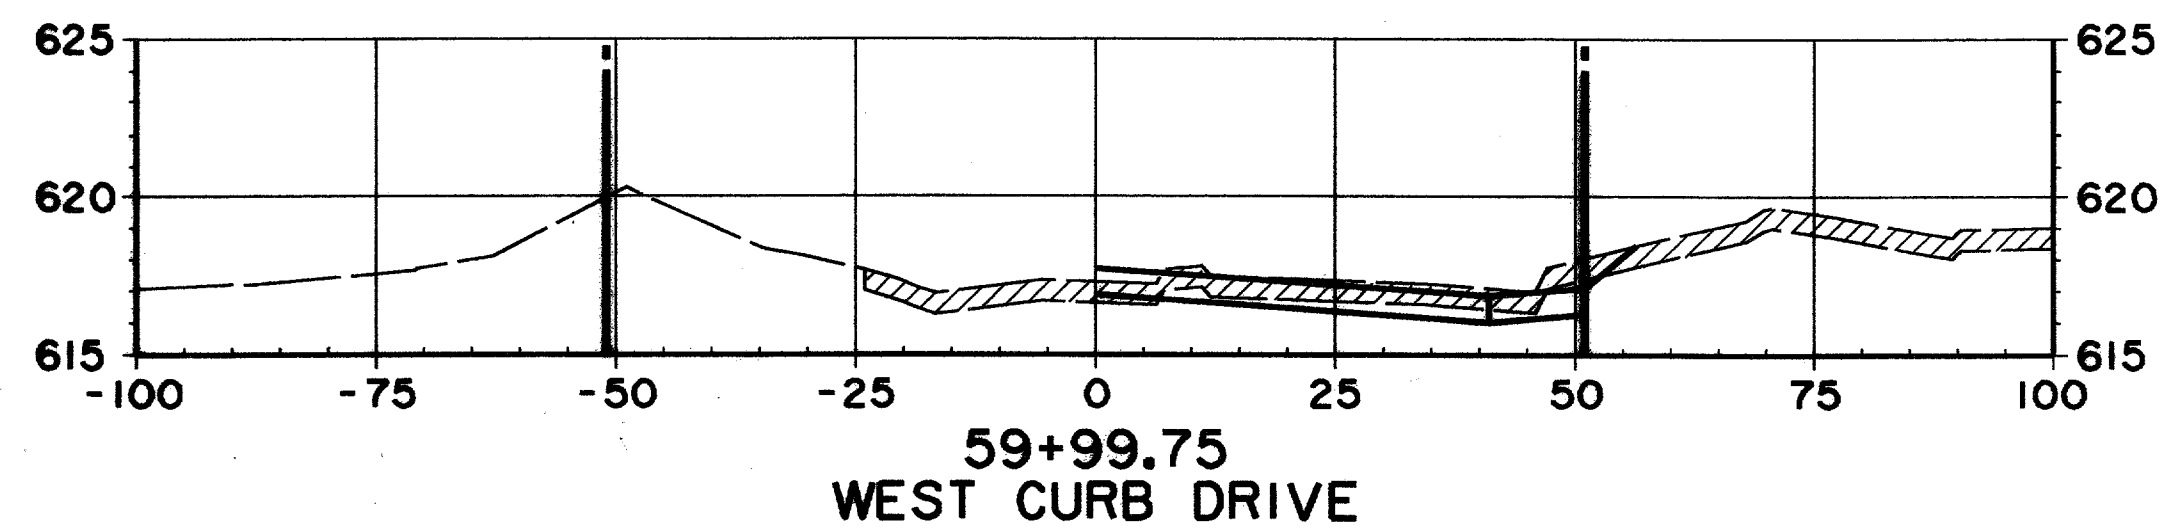


EX. GROUND SOUTH OF
R.O.W. LINE STA. 57+50
TO STA. 66+50 MAY HAVE
BEEN MODIFIED DUE TO
CONSTRUCTION OF THE
COLONNADE TOWER III

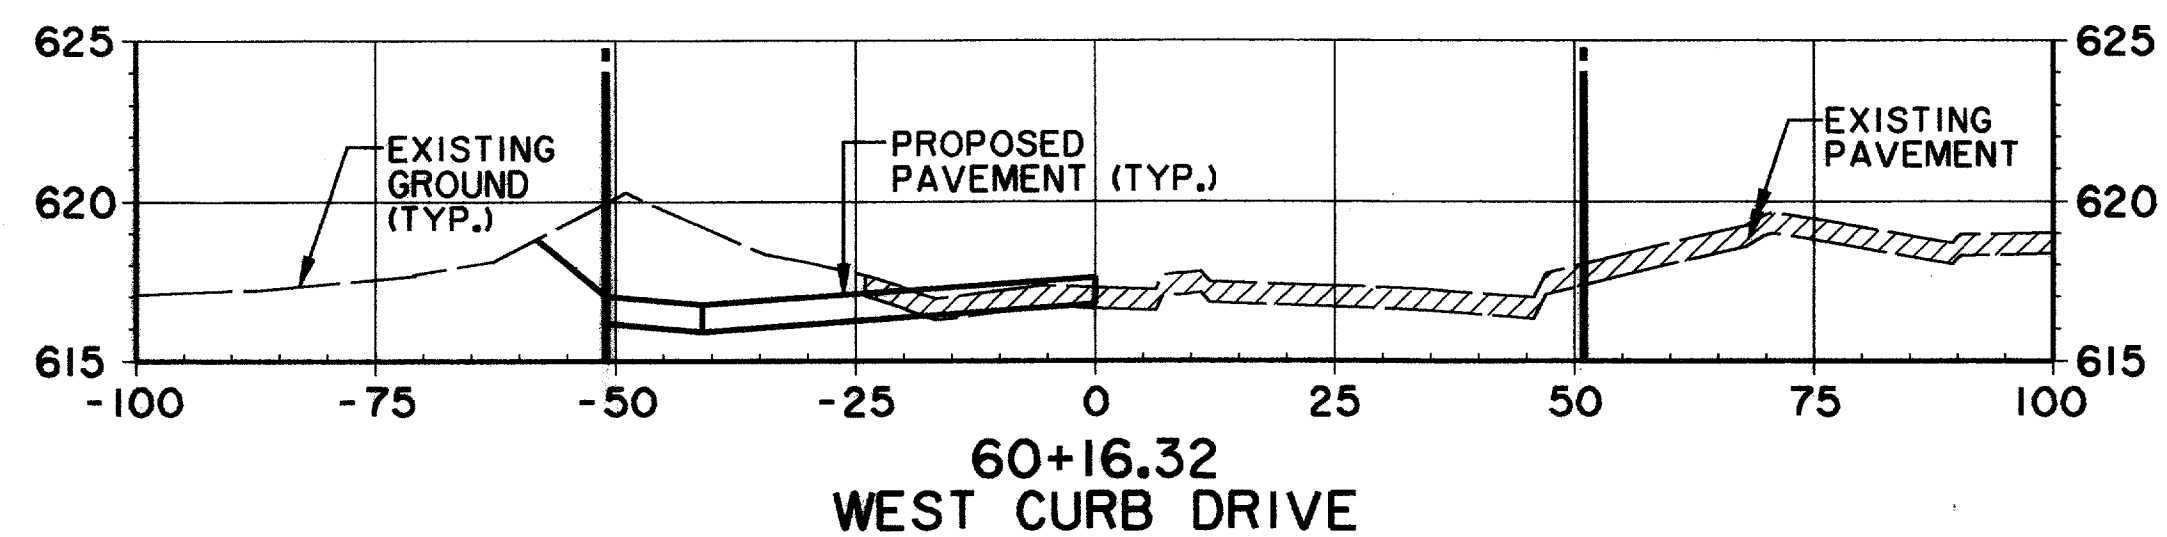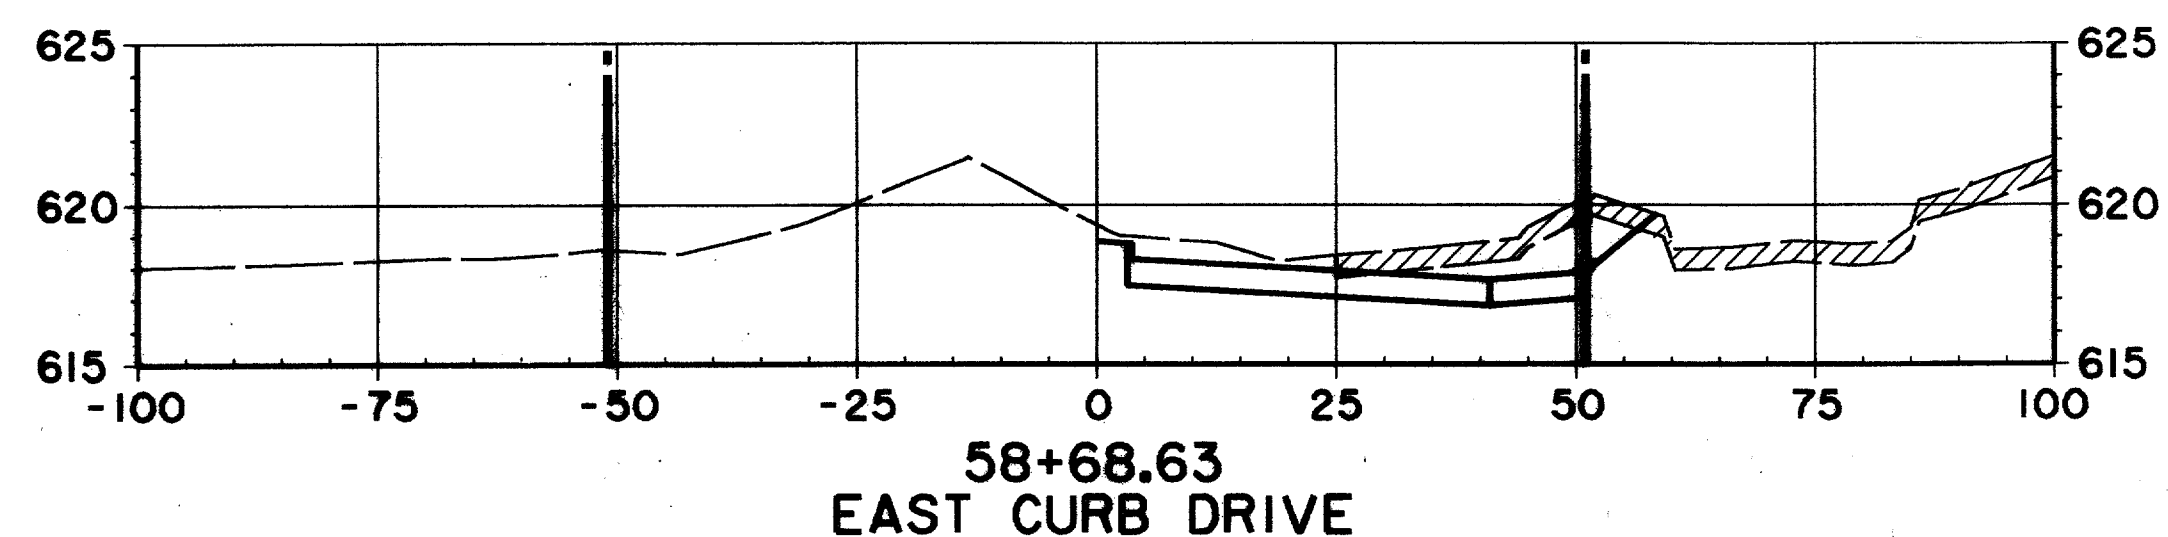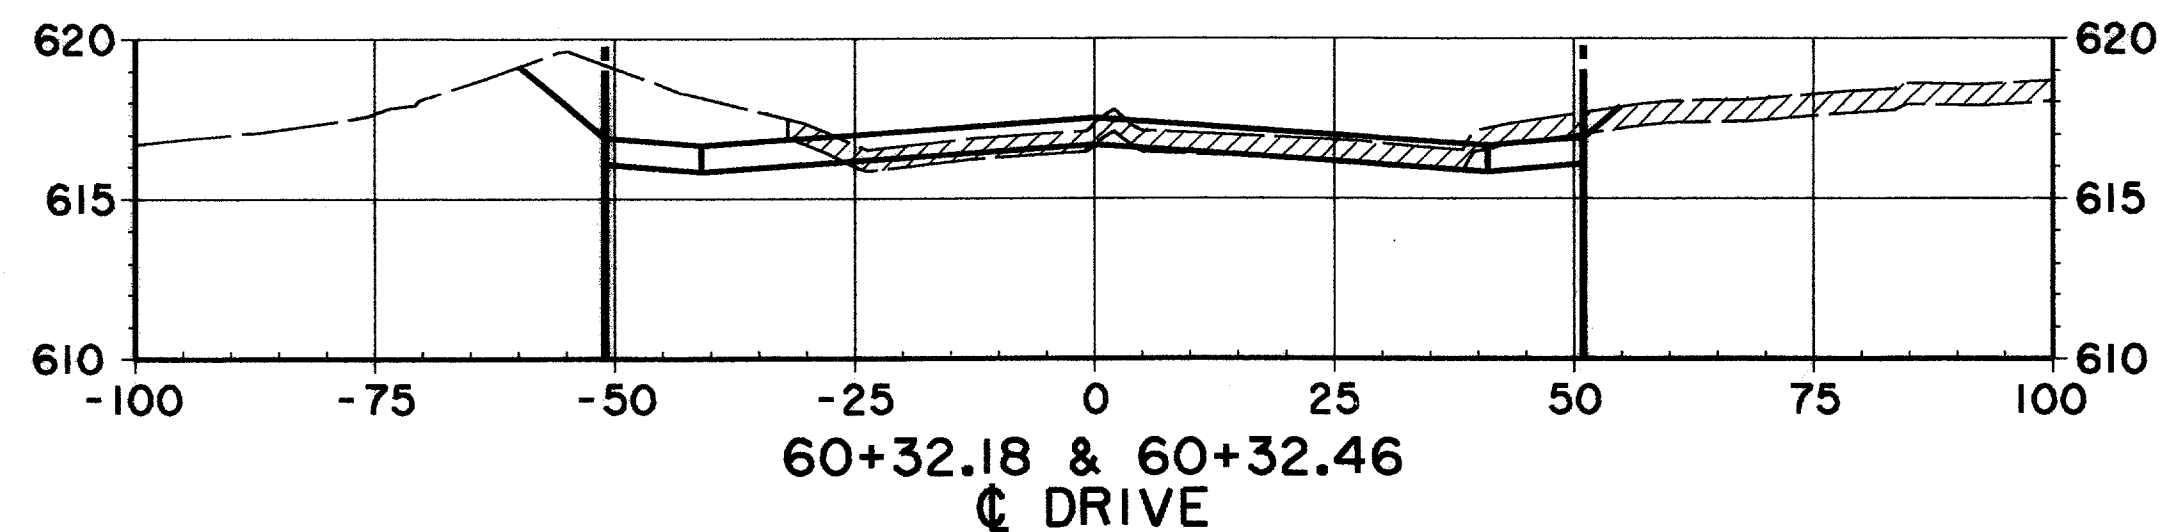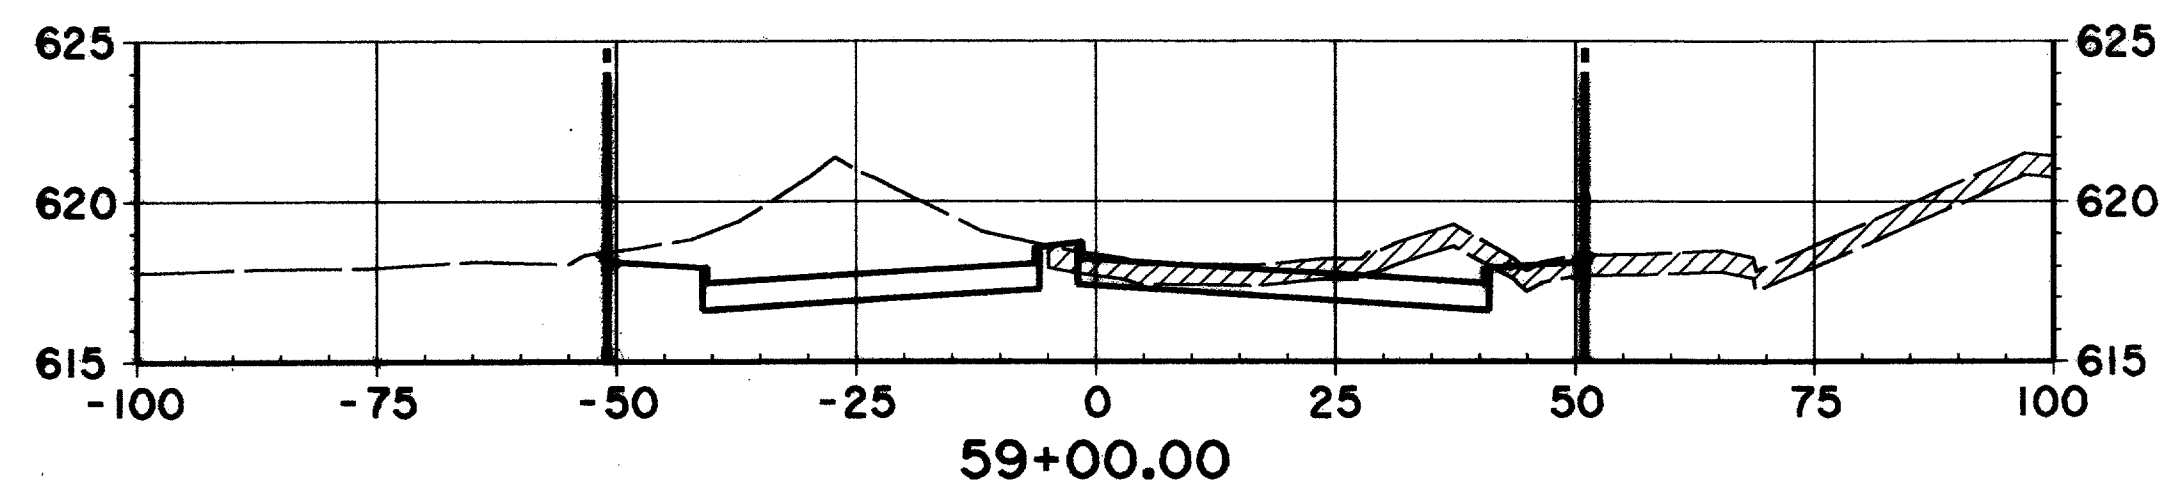


RECORD DOCUMENTS 6/9/2000





THESE RECORD DOCUMENTS HAVE BEEN PREPARED BASED ON INFORMATION PROVIDED BY OTHERS. THE CONSULTANT HAS NOT VERIFIED THE ACCURACY AND/OR COMPLETENESS OF THIS INFORMATION AND SHALL NOT BE RESPONSIBLE FOR ANY ERRORS OR OMISSIONS THAT MAY BE INCORPORATED AS A RESULT OF ERRONEOUS INFORMATION PROVIDED BY OTHERS.

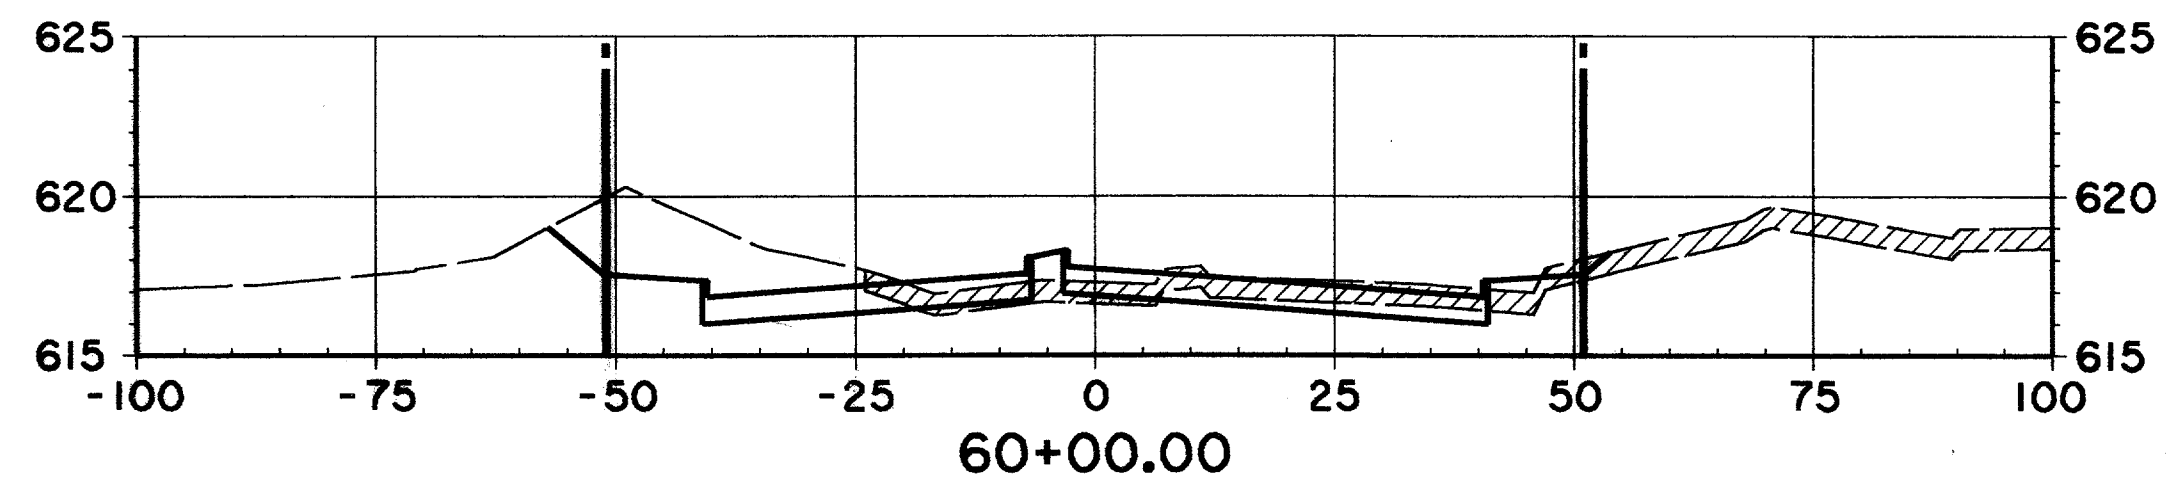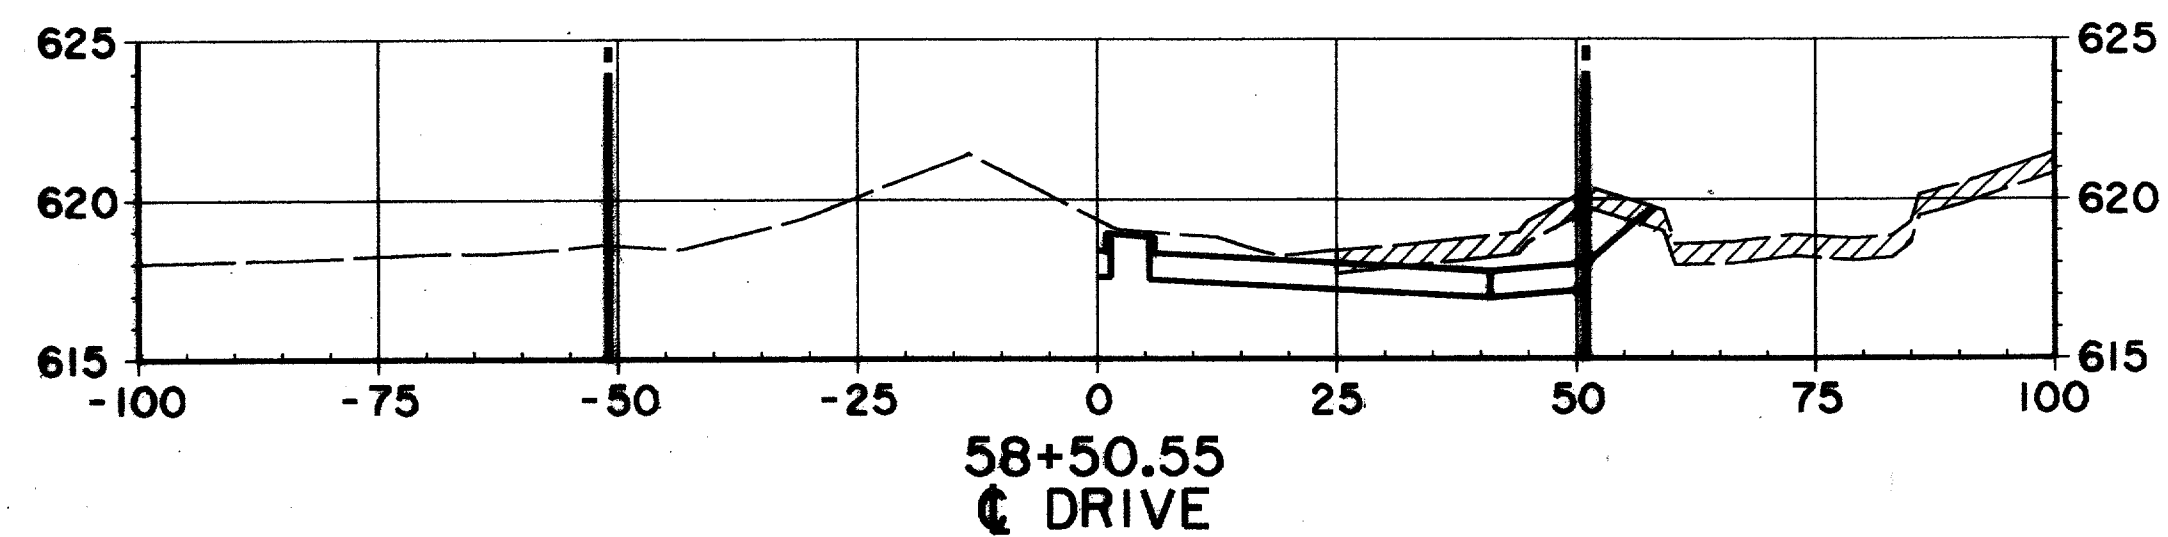







THE SEAL APPEARING ON THIS DOCUMENT WAS AUTHORIZED BY KENNETH A. ROBERTS, P.E. 55446 ON OCTOBER 24, 1997

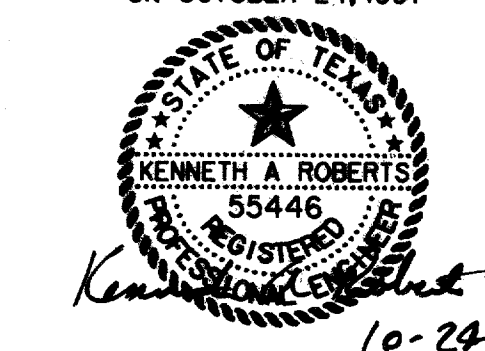

CROSS SECTIONS						
STA. 58+50.55 TO STA. 60+50						
ARAPAHO ROAD						
ADDISON ROAD TO DALLAS NORTH TOLLWAY						
TOWN OF ADDISON, TEXAS						
Huitt-Zollars, Inc./Consulting Engineers Dallas, Fort Worth, Houston, Phoenix, Tustin						
DESIGN	DRAWN	APPR.	SCALE	DATE	PROJECT NO.	NO.
HZI	HZI	KAR	H 1"=20' V 1"=8'	OCT 97	1772-01	X-8

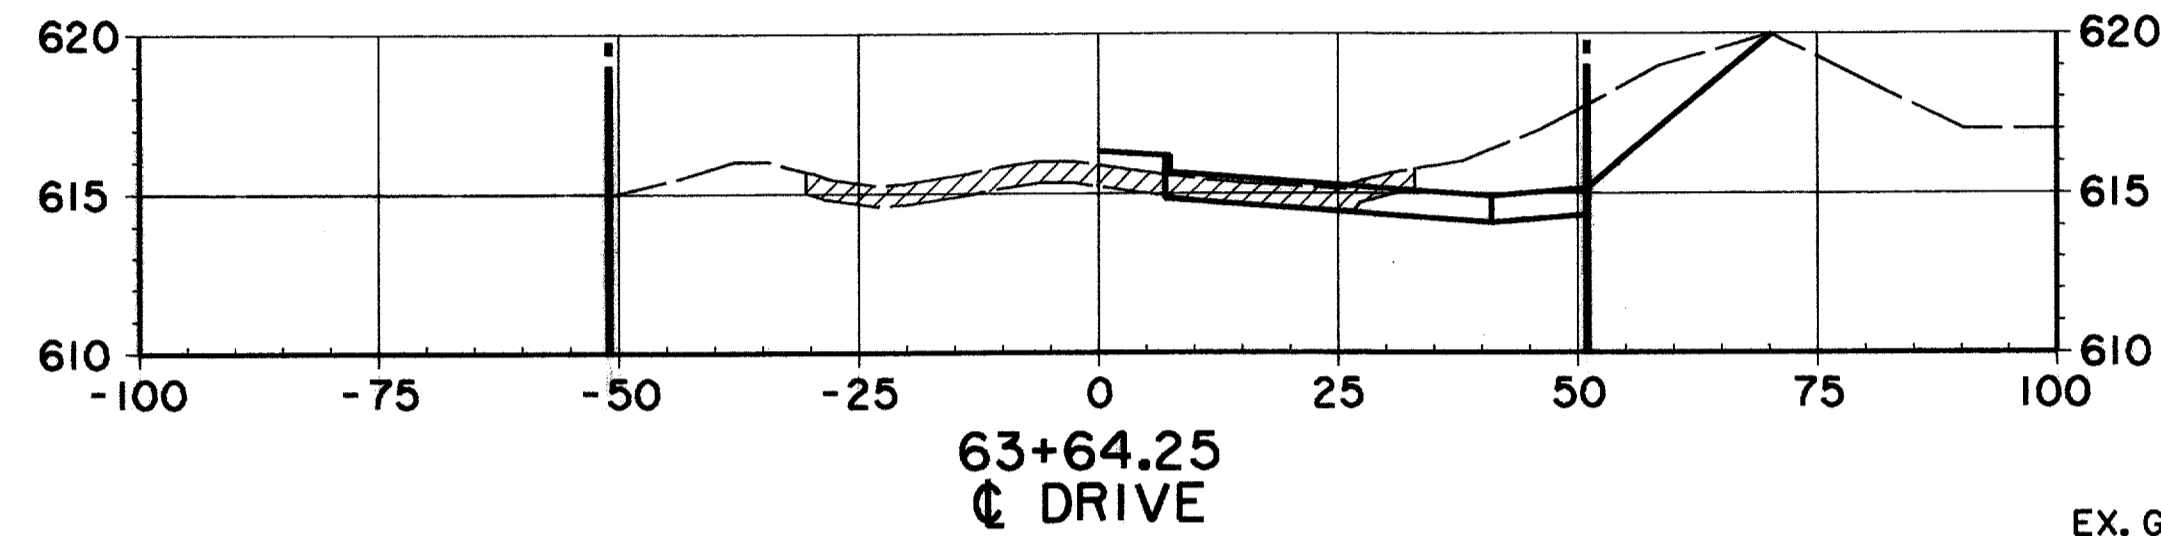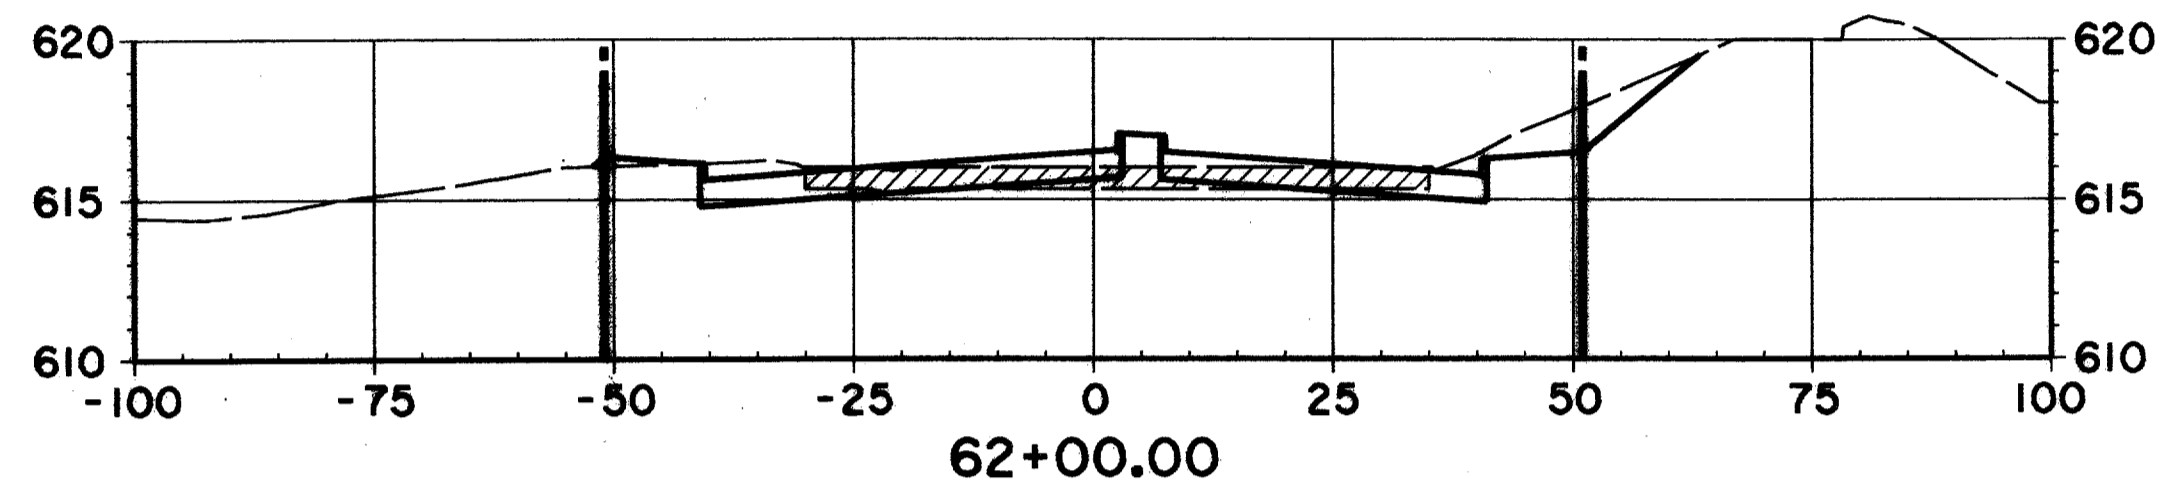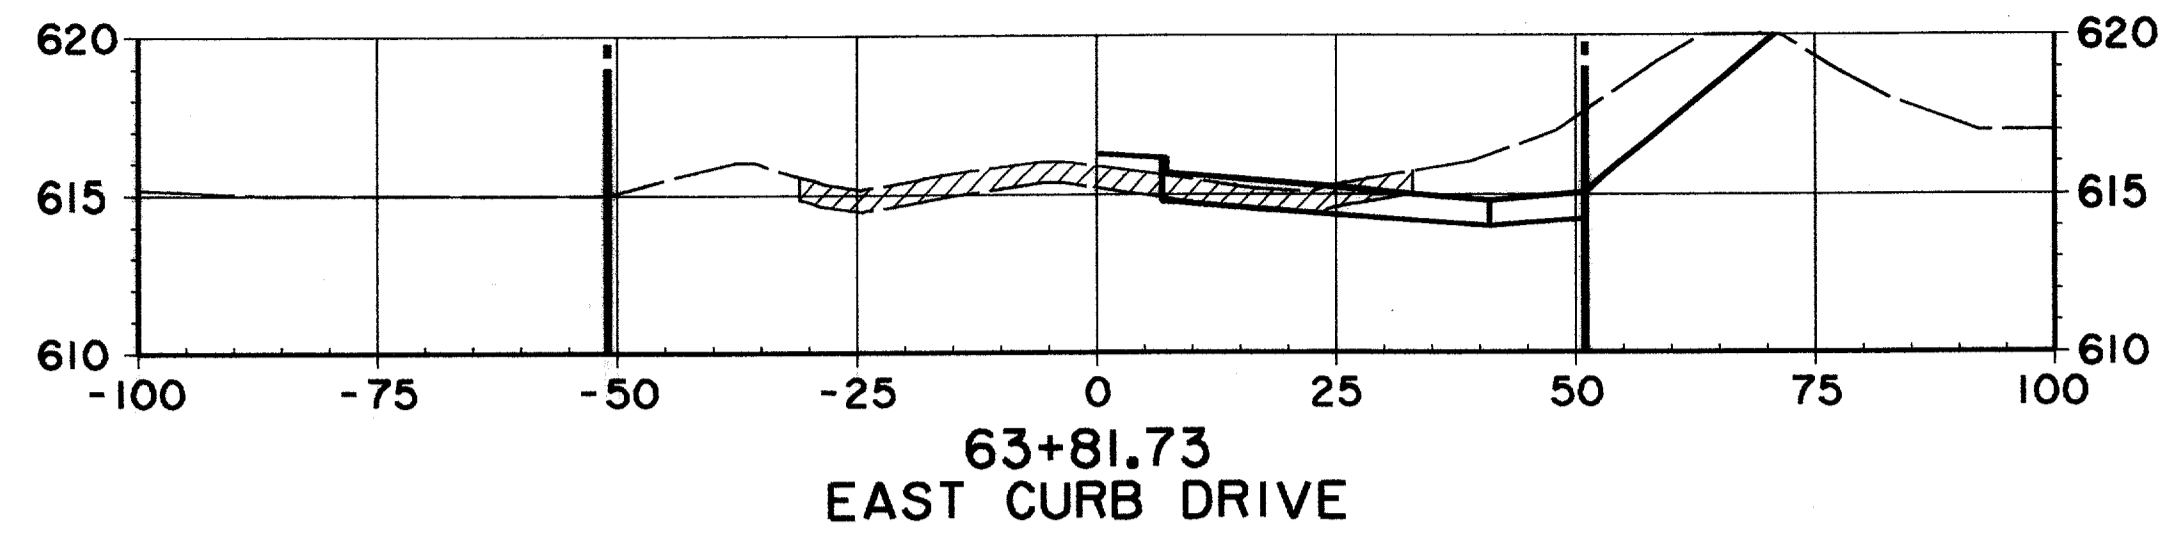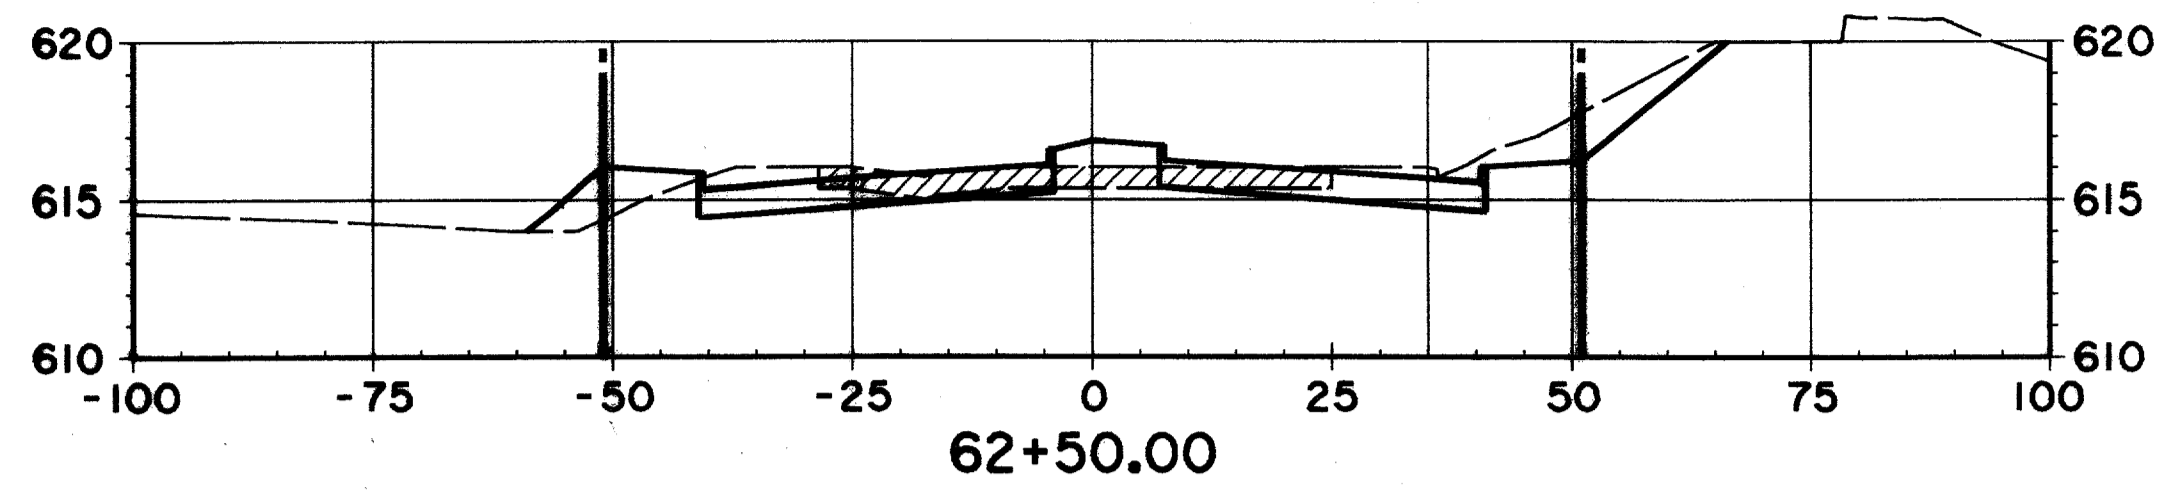

EX. GROUND SOUTH OF
R.O.W. LINE STA. 57+50
TO STA. 66+50 MAY HAVE
BEEN MODIFIED DUE TO
CONSTRUCTION OF THE
COLONNADE TOWER III

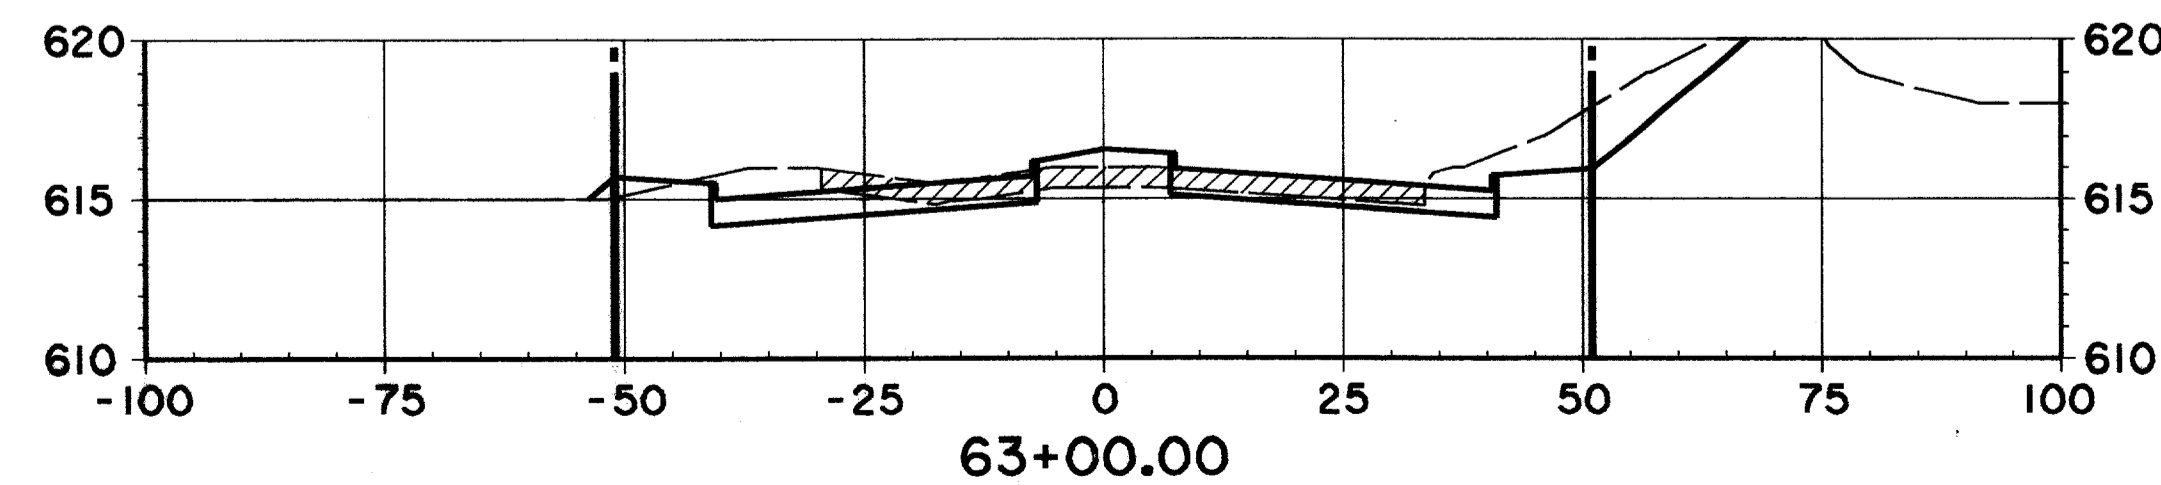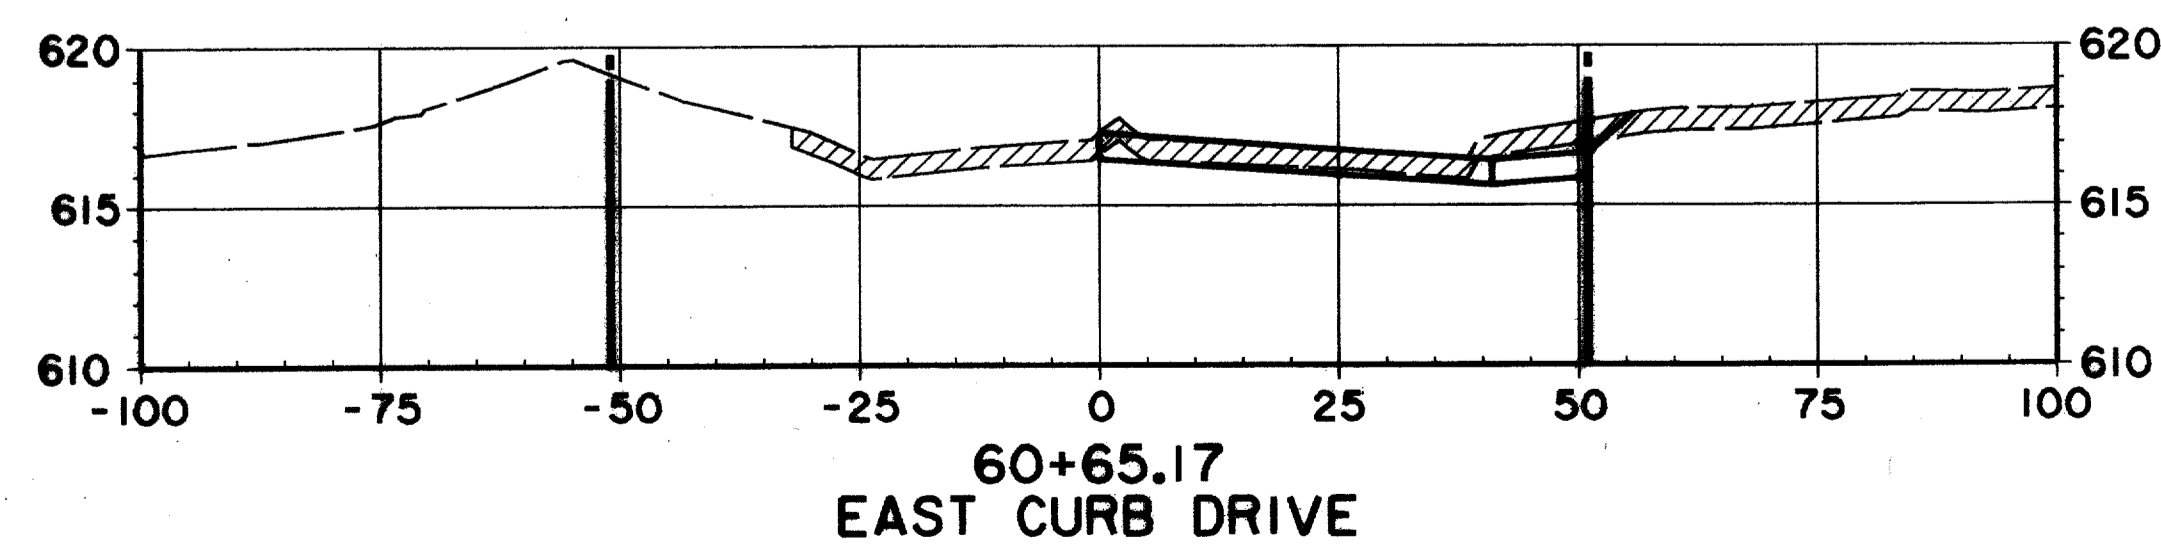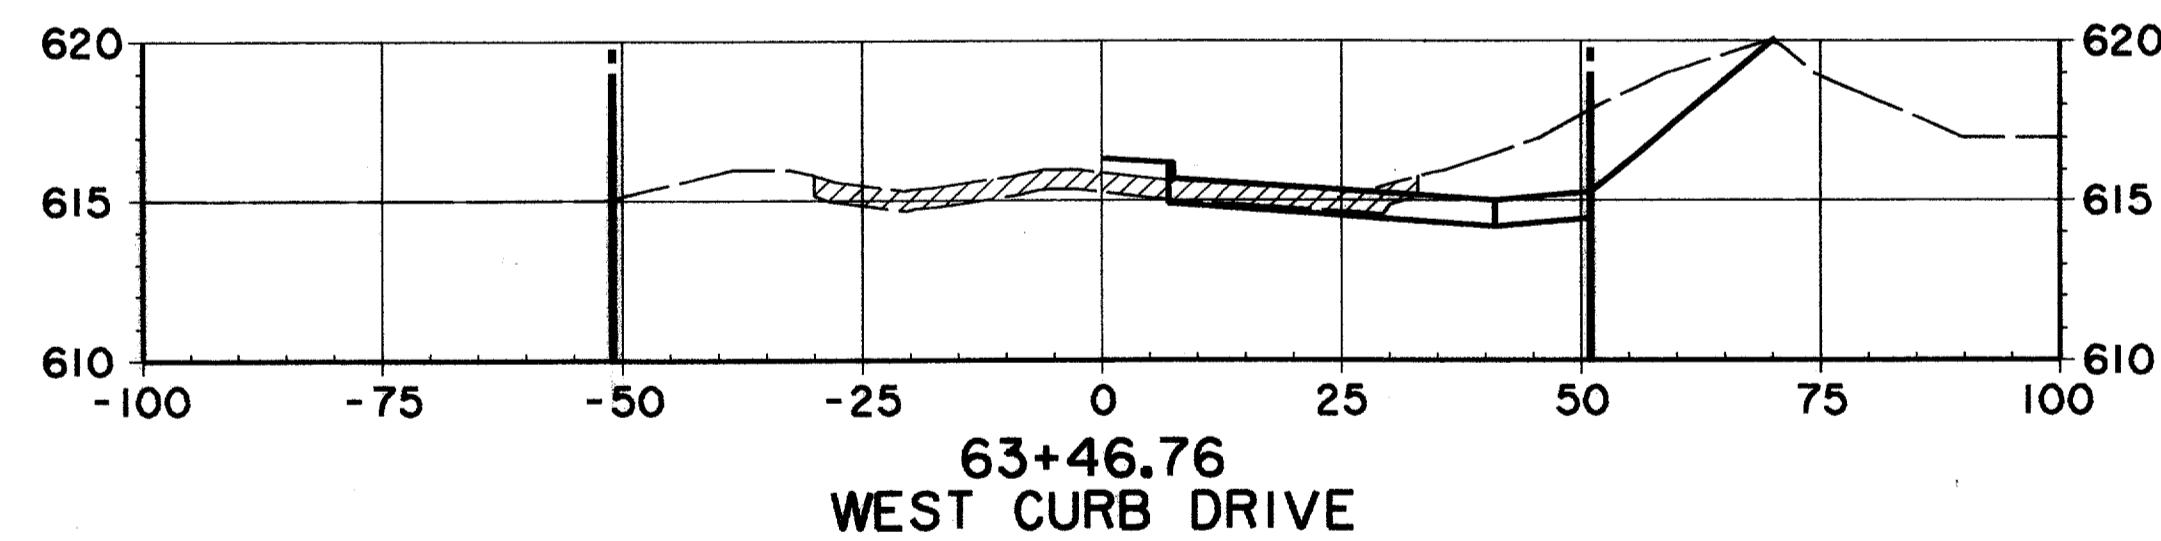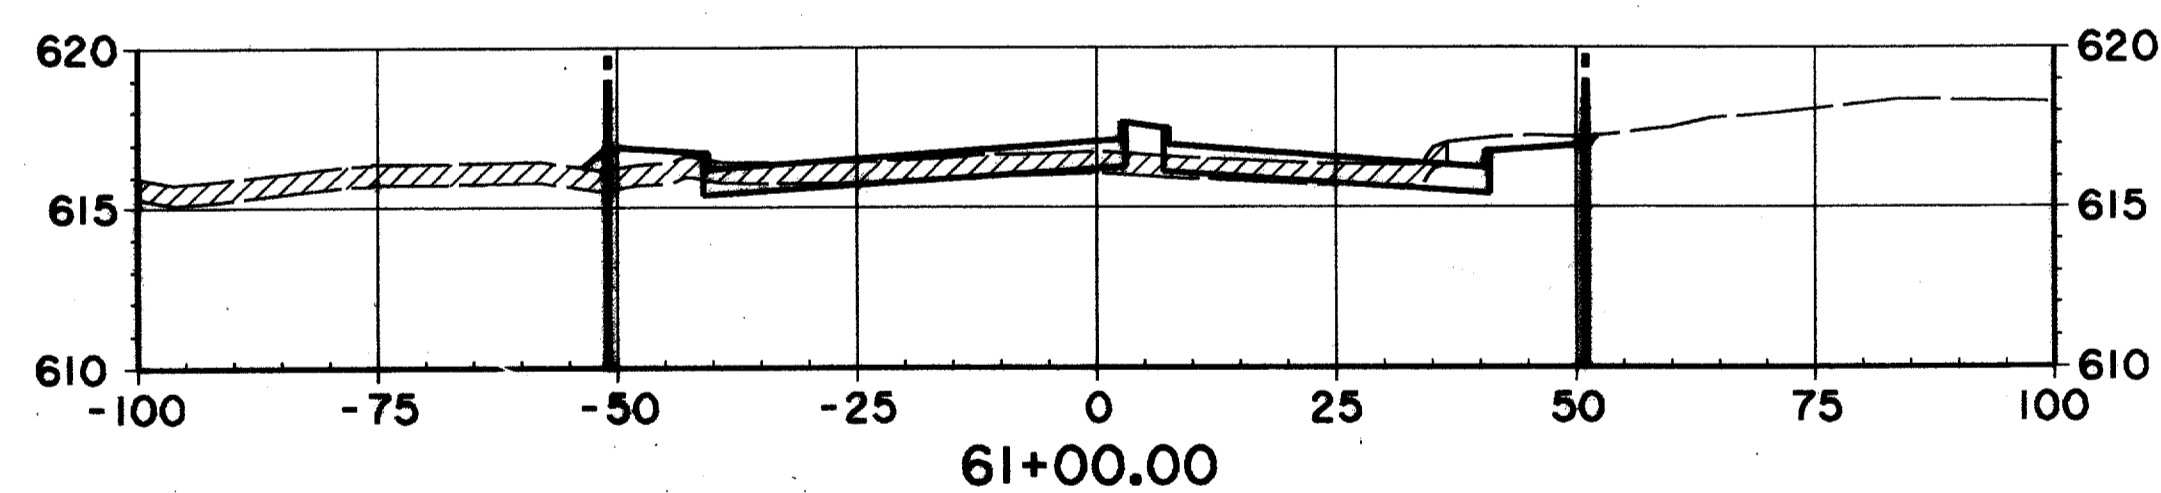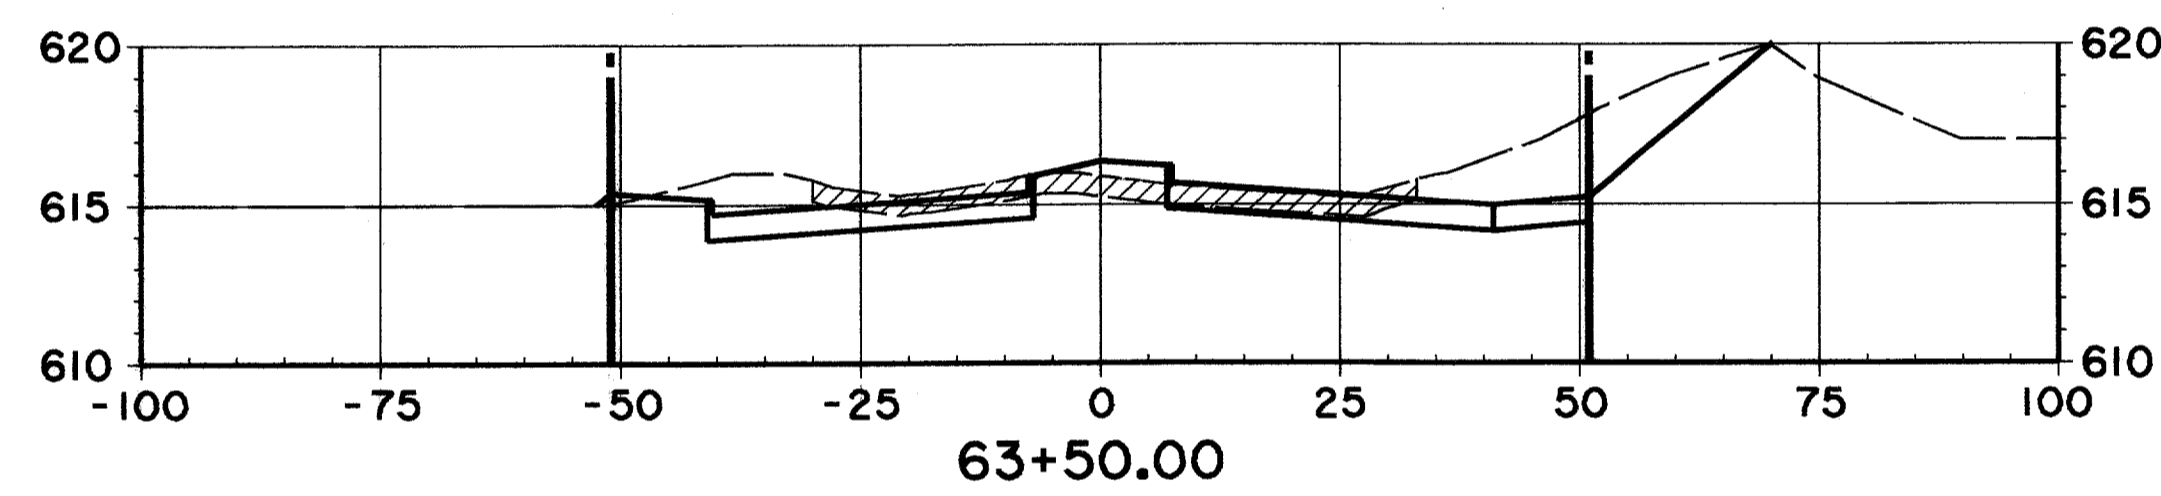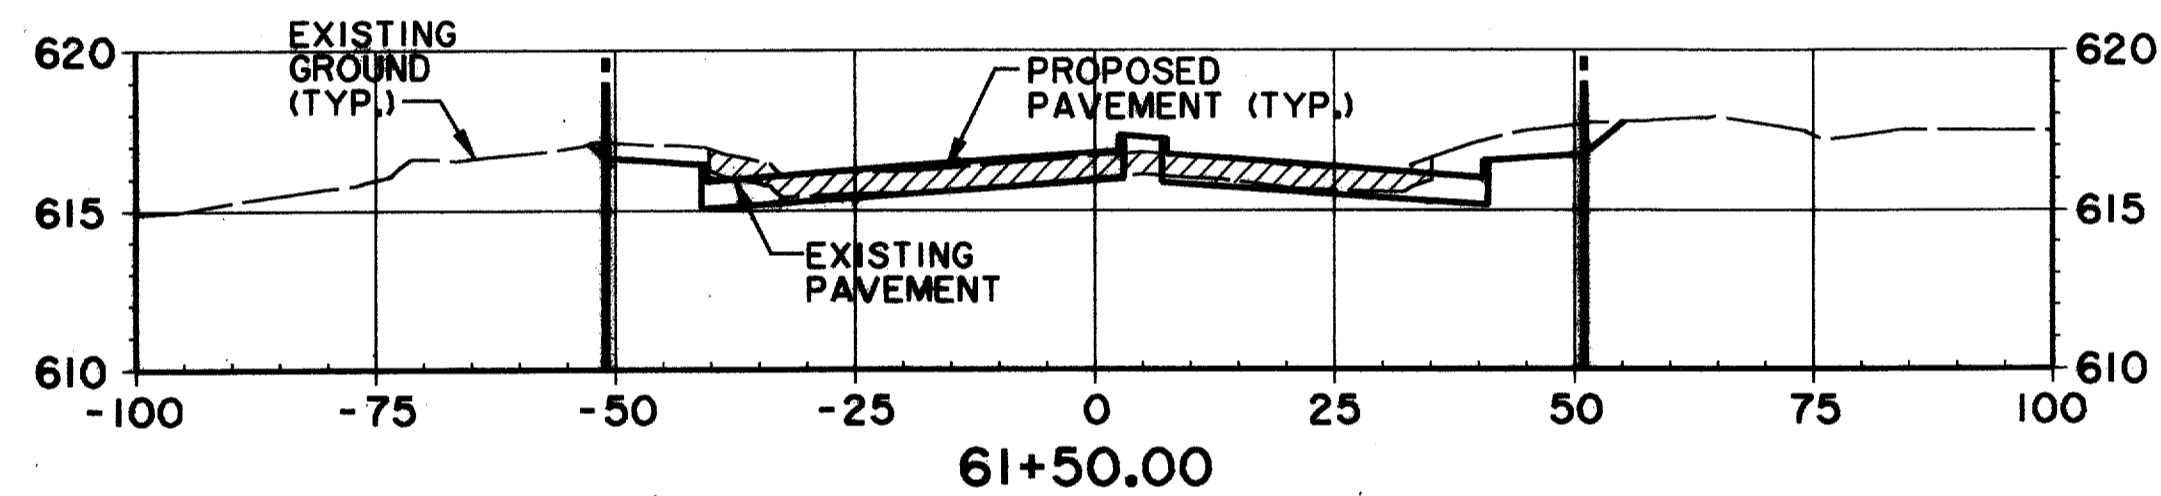











RECORD DOCUMENTS 6/9/2000

THESE RECORD DOCUMENTS HAVE BEEN PREPARED BASED ON INFORMATION PROVIDED BY OTHERS. THE CONSULTANT HAS NOT VERIFIED THE ACCURACY AND/OR COMPLETENESS OF THIS INFORMATION AND SHALL NOT BE RESPONSIBLE FOR ANY ERRORS OR OMISSIONS THAT MAY BE INCORPORATED AS A RESULT OF ERRONEOUS INFORMATION PROVIDED BY OTHERS.

THE SEAL APPEARING ON THIS DOCUMENT WAS AUTHORIZED BY KENNETH A. ROBERTS, P.E. 55446 ON OCTOBER 24, 1997

10-24-97


CROSS SECTIONS						
STA. 60+65.17 TO STA. 63+81.73						
ARAPAHO ROAD						
ADDISON ROAD TO DALLAS NORTH TOLLWAY						
TOWN OF ADDISON, TEXAS						
Huitt-Zollars, Inc./Consulting Engineers Dallas, Fort Worth, Houston, Phoenix, Tustin						
DESIGN	DRAWN	APPR.	SCALE	DATE	PROJECT NO.	NO.
HZI	HZI	KAR	H _v 1"=20' H _h 1"=8'	OCT 97	1772-01	X-9

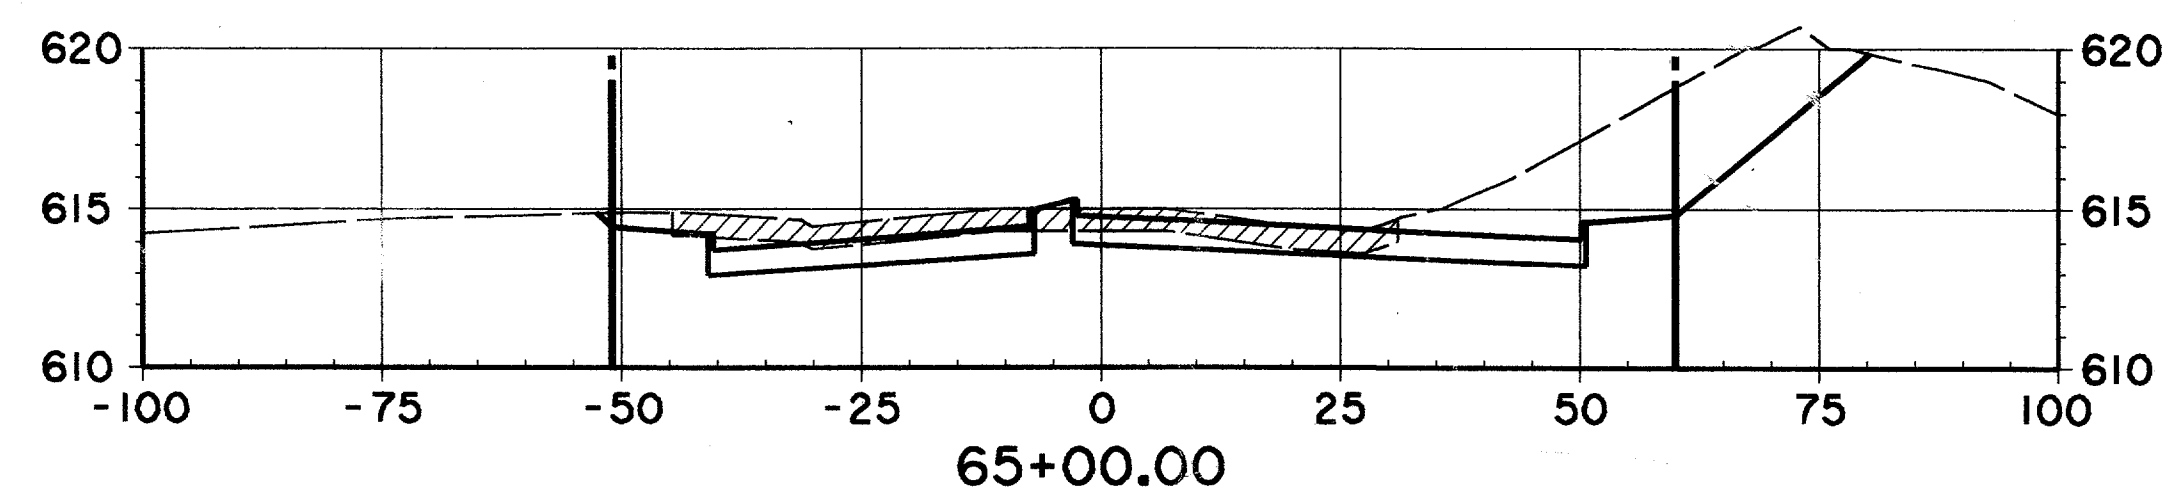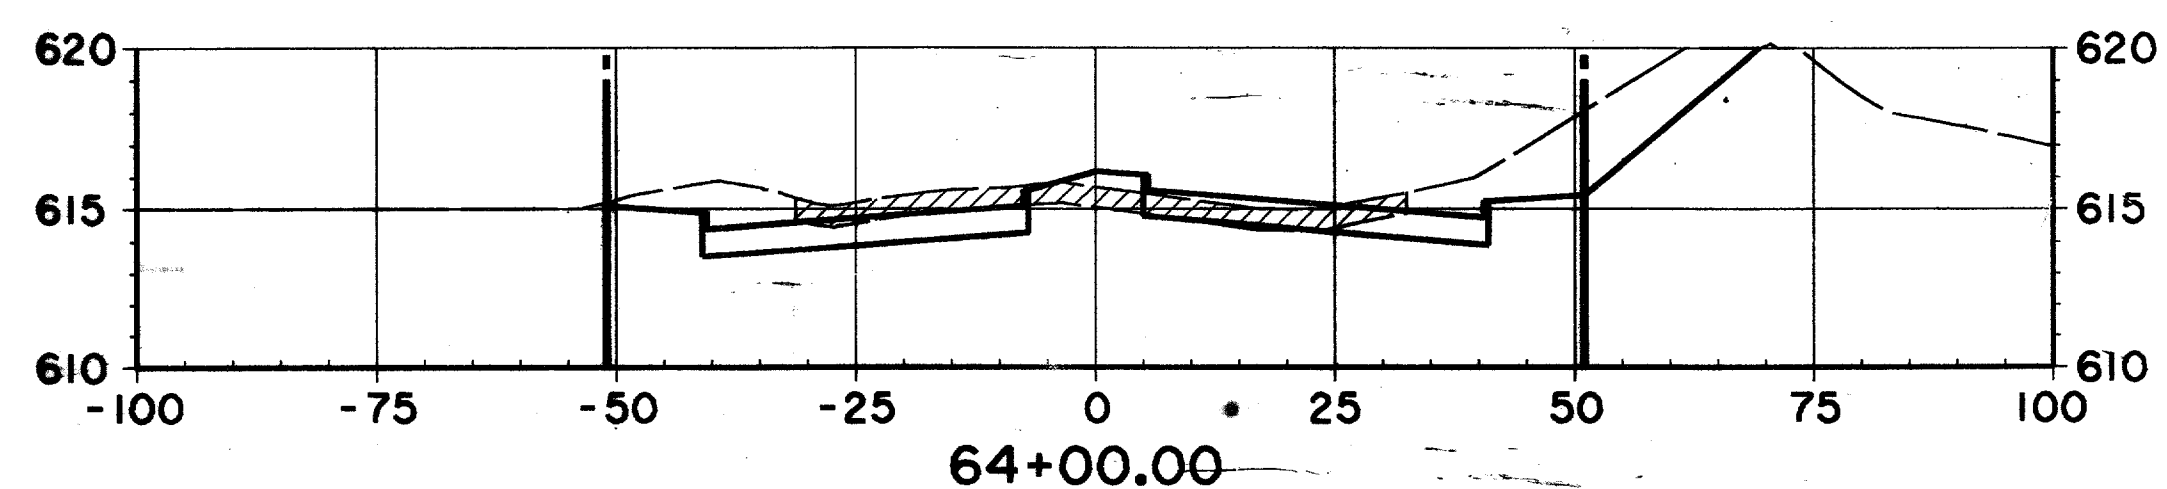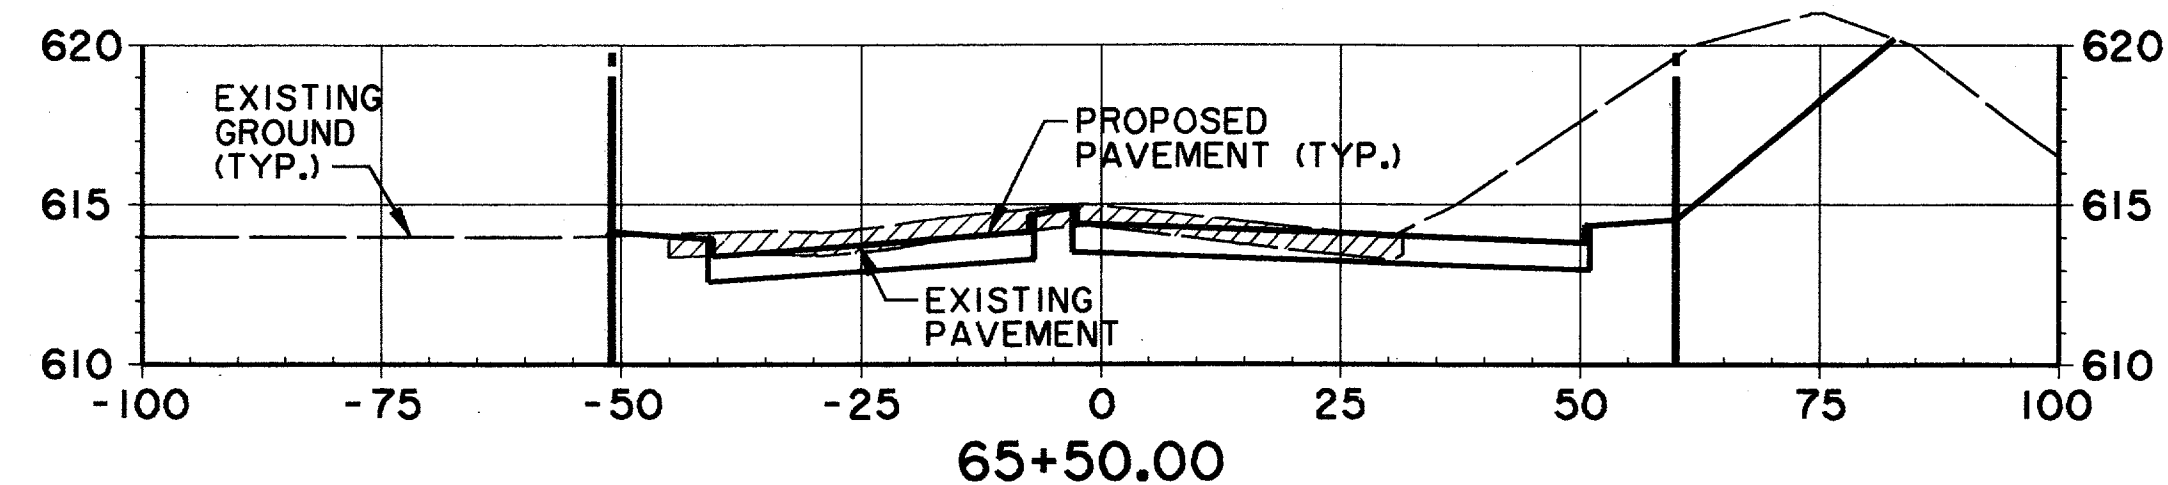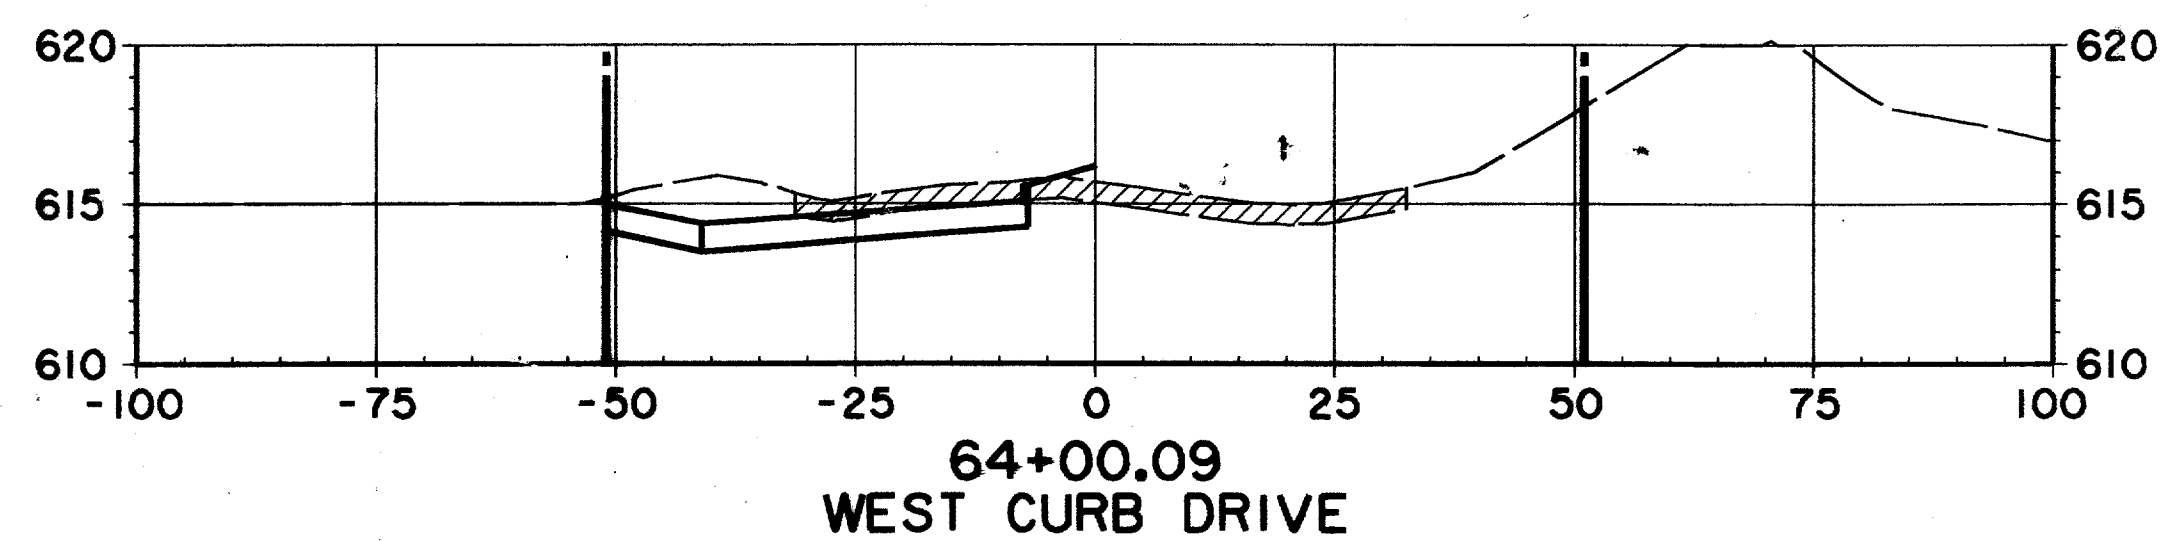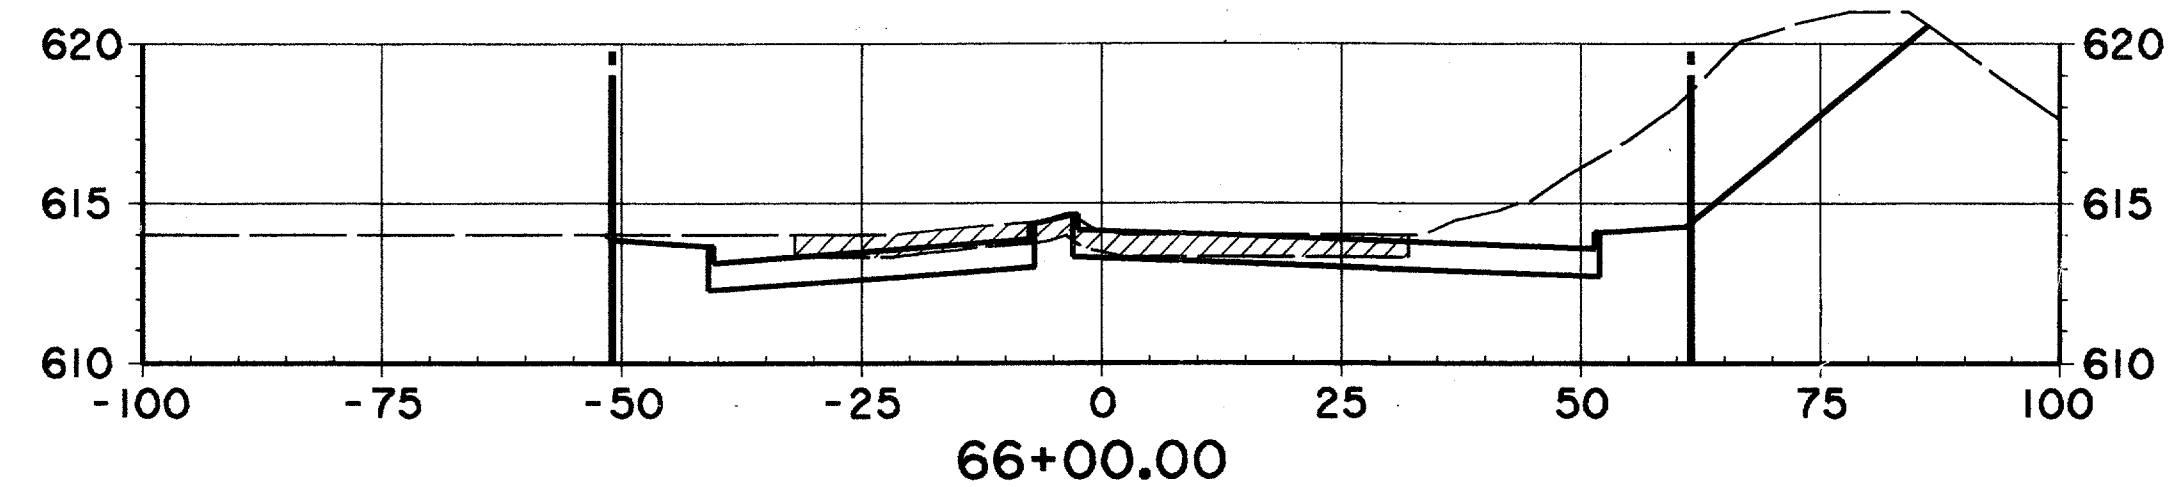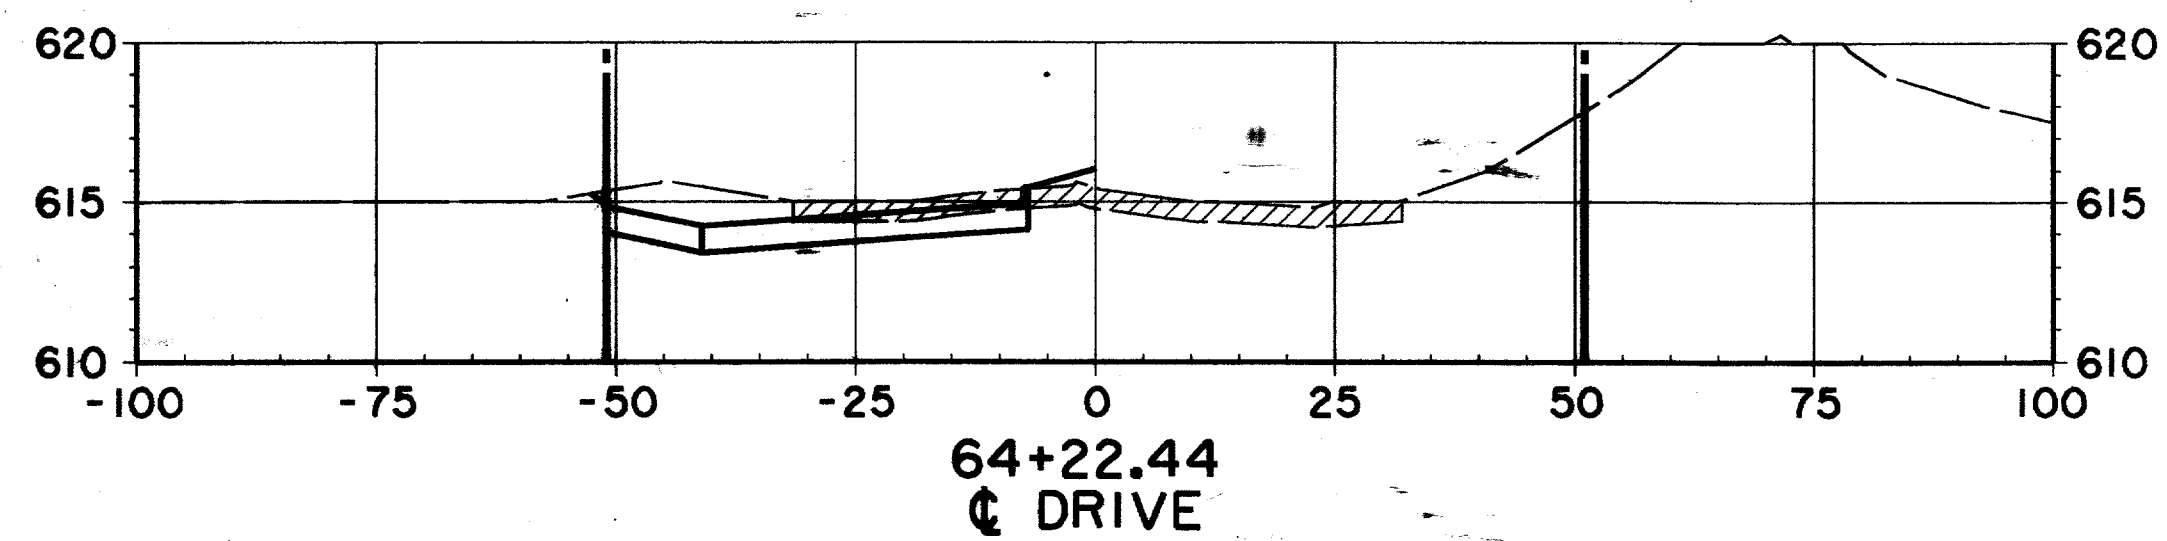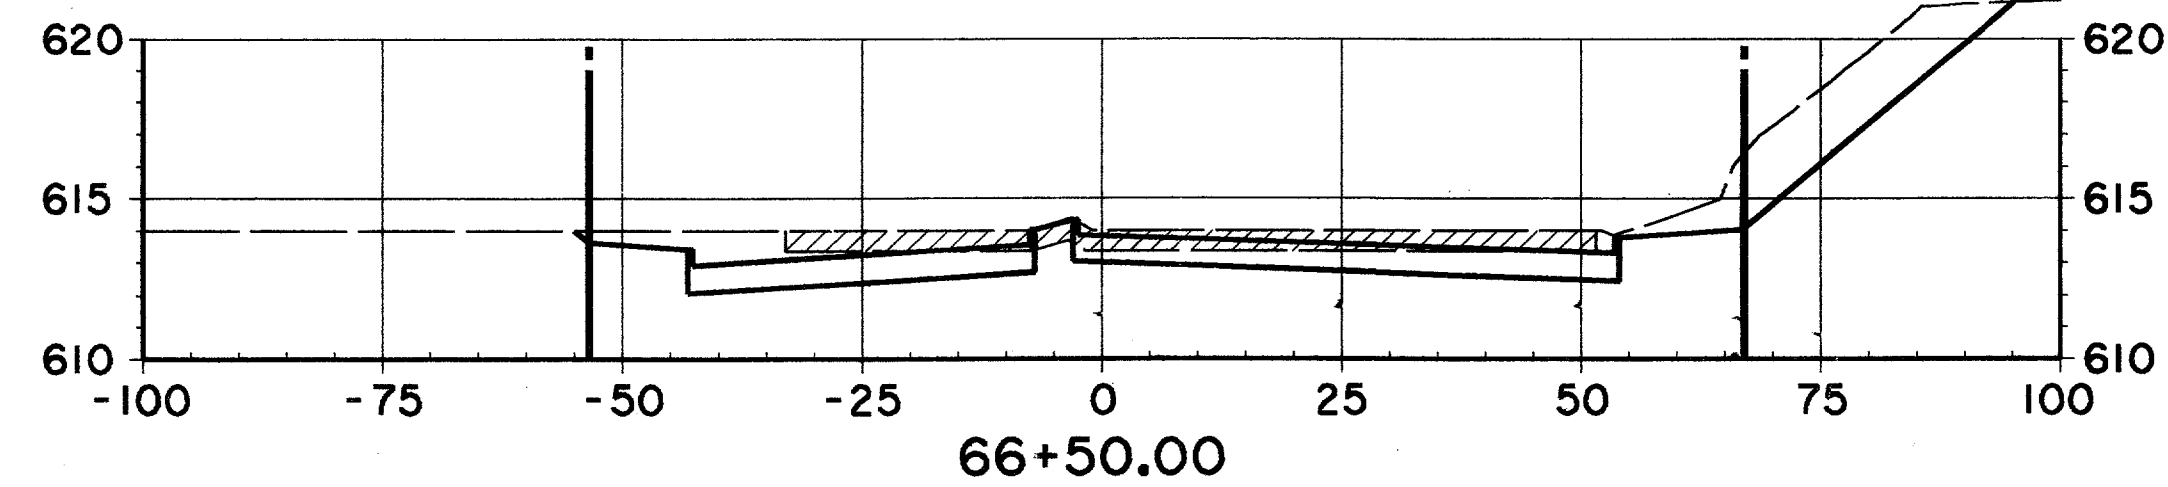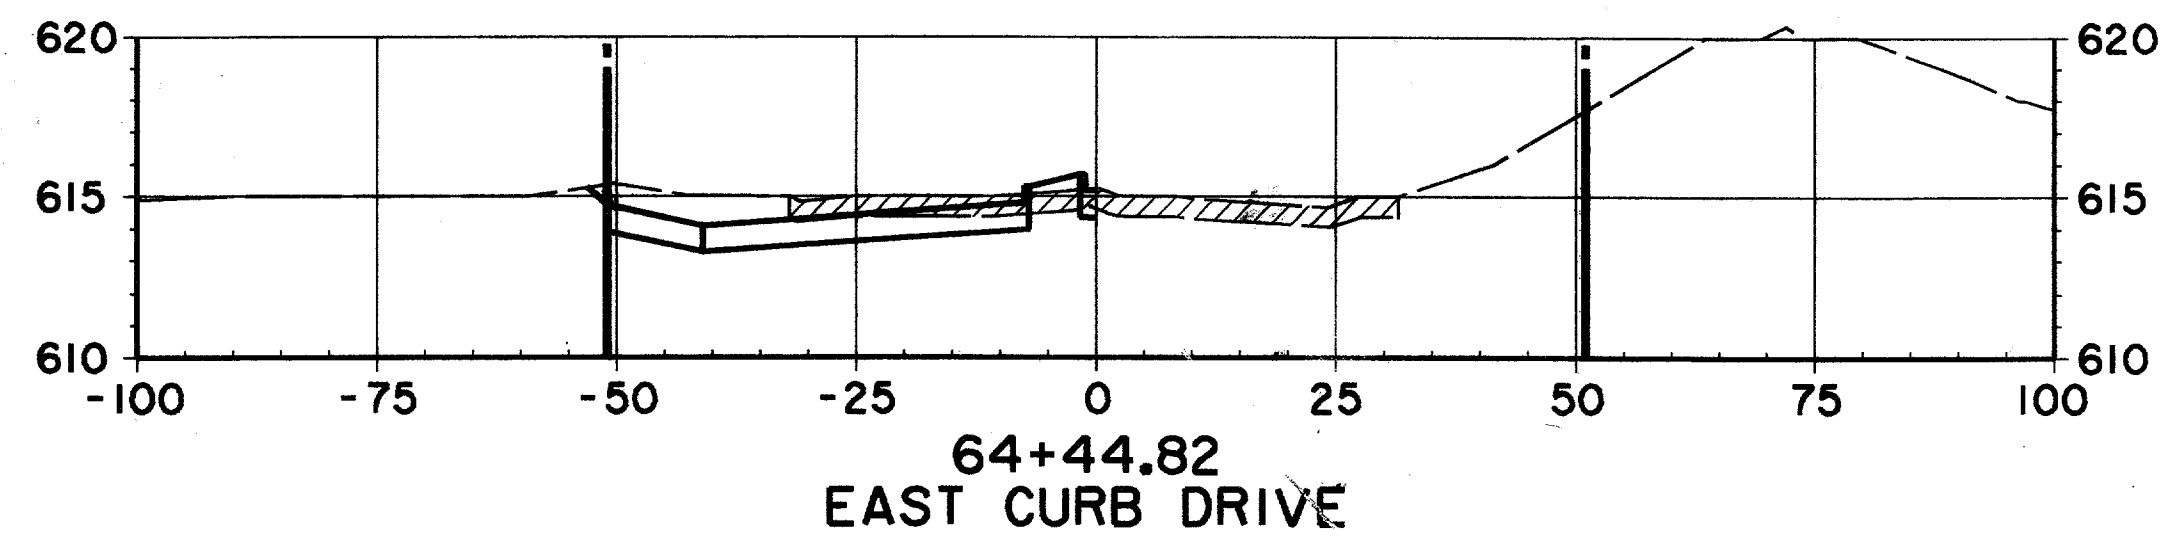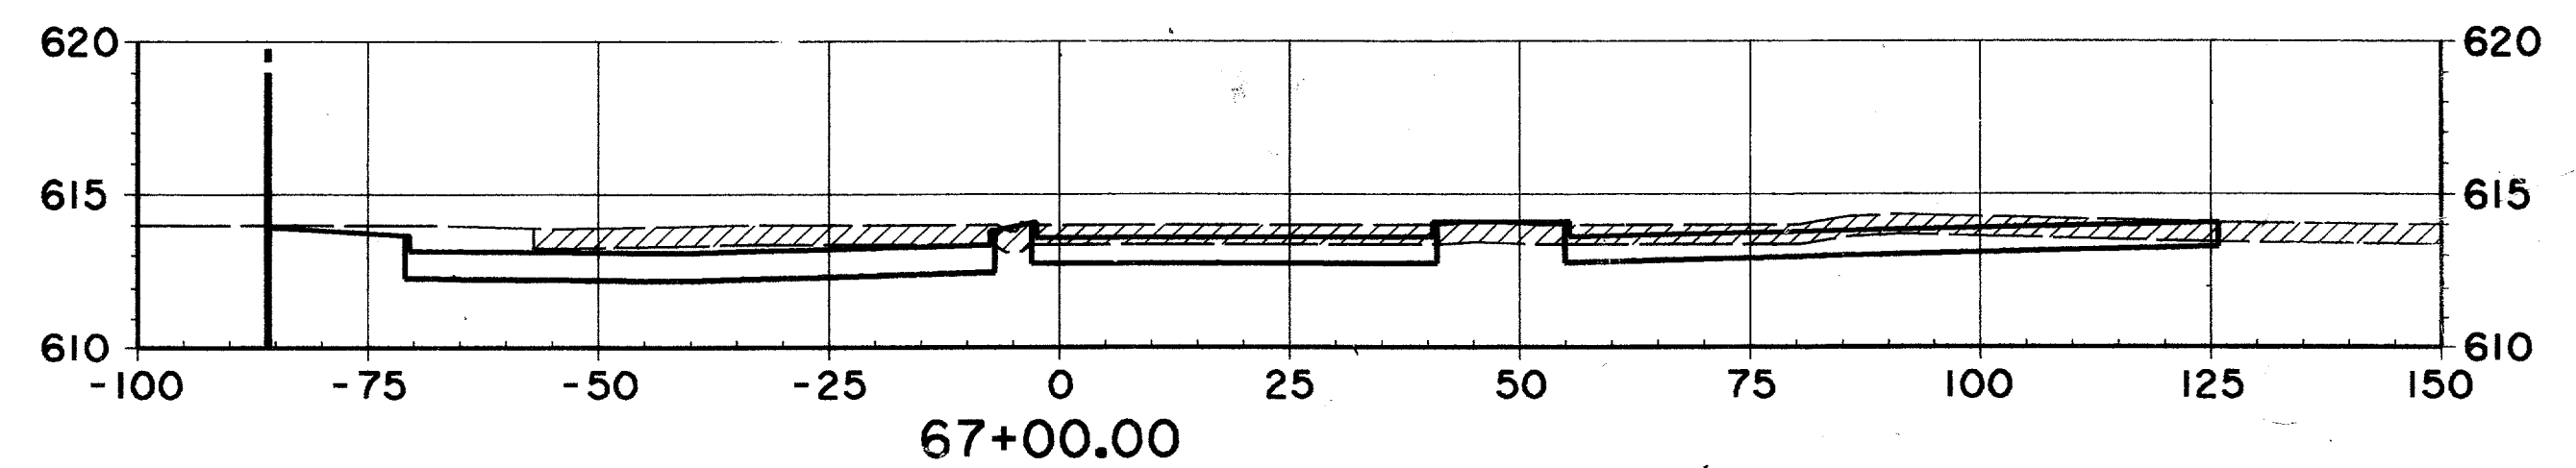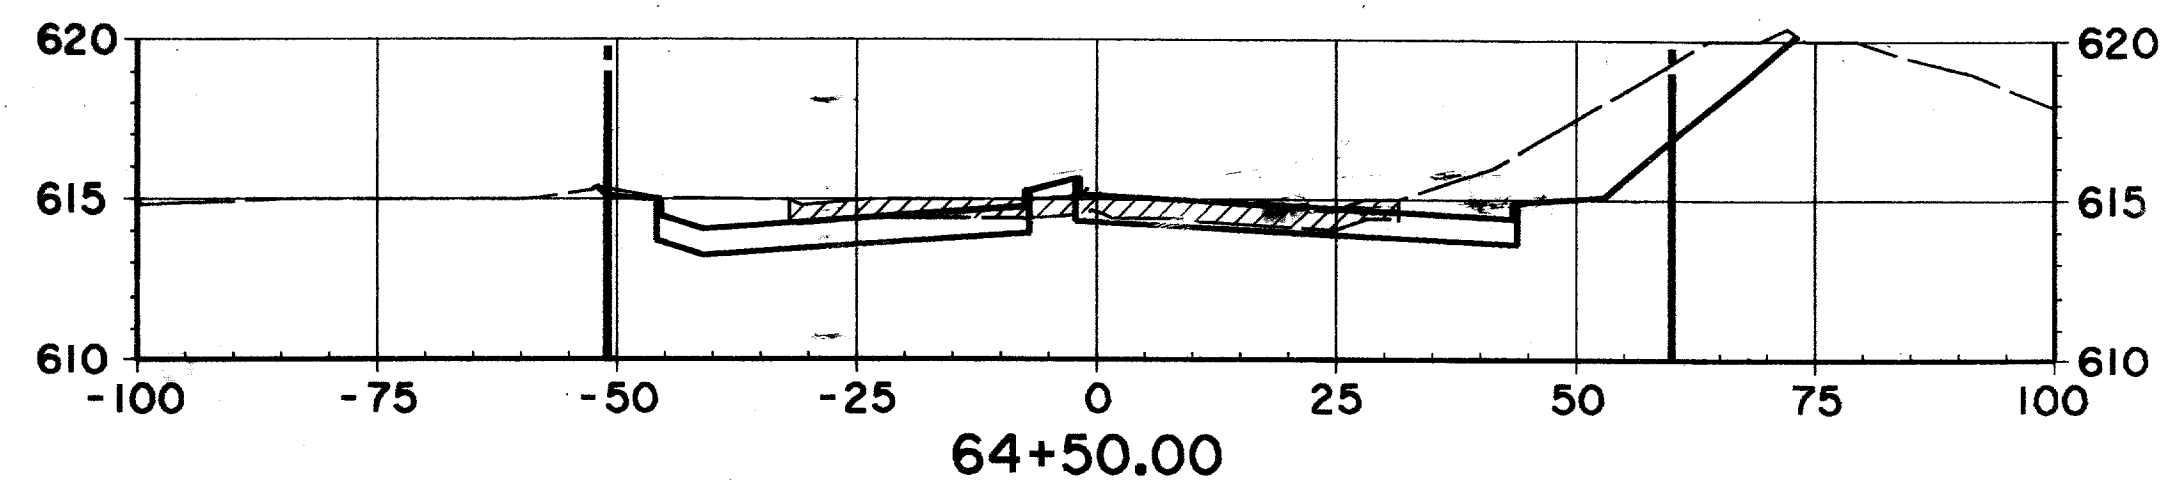

RECORD DOCUMENTS 6/9/2000

THESE RECORD DOCUMENTS HAVE BEEN PREPARED BASED ON INFORMATION PROVIDED BY OTHERS. THE CONSULTANT HAS NOT VERIFIED THE ACCURACY AND/OR COMPLETENESS OF THIS INFORMATION AND SHALL NOT BE RESPONSIBLE FOR ANY ERRORS OR OMISSIONS THAT MAY BE INCORPORATED AS A RESULT OF ERRONEOUS INFORMATION PROVIDED BY OTHERS.

EX. GROUND SOUTH OF R.O.W. LINE STA. 57+50 TO STA. 66+50 MAY HAVE BEEN MODIFIED DUE TO CONSTRUCTION OF THE COLONNADE TOWER III

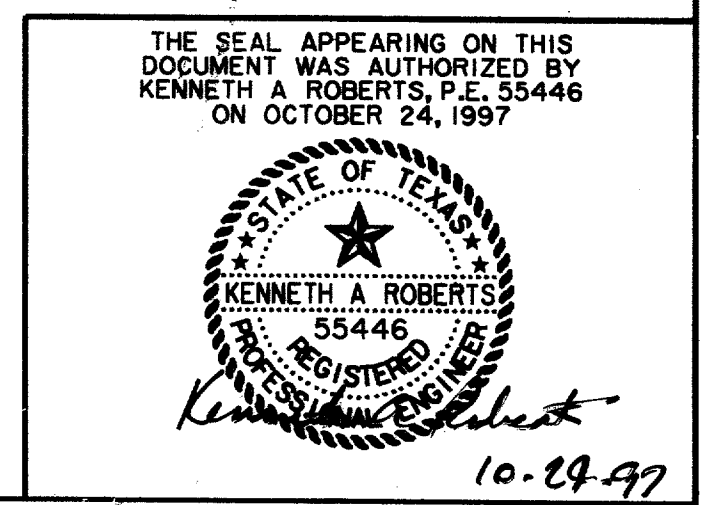

CROSS SECTIONS						
STA. 64+00 TO STA. 67+00						
ARAPAHO ROAD						
ADDISON ROAD TO DALLAS NORTH TOLLWAY						
TOWN OF ADDISON, TEXAS						
Hullif-Zollars, Inc./Consulting Engineers Dallas, Fort Worth, Houston, Phoenix, Tustin						
DESIGN	DRAWN	APPR.	SCALE	DATE	PROJECT NO.	NO.
HZI	HZI	KAR	H _v 1"=20' V ₁ 1"=6'	OCT 97	1772-01	X-10


IMPORTANT!!!

- MESA Design Group assumes no responsibility for any excavation or grading not shown on surveys or civil engineer's plans supplied to MESA Design Group.
- All proposed and finished grades provided by MESA Design Group are based on information provided by owner's surveyor and/or civil engineer. Any discrepancies in actual field measurements are to be reported to landscape architect immediately.
- Contractor shall be responsible for making himself familiar with all underground utilities, pipes, structures, and line runs.
- Prior to commencement of hardscape construction, all piers, footings, and walls are to be surveyed, laid out, and staked in field for approval by landscape architect. Contractor shall assume responsibility for any demolition, adjustments, or reconstruction resulting from unauthorized construction activities.
- Contractor is responsible for all final quantities per drawings and specifications. Any quantities provided by MESA Design Group are provided as a convenience only and shall not be considered absolute. Landscape architect should be notified if any discrepancies occur.

All median and parkway planting areas shall have 6 inches of topsoil placed prior to planting. The topsoil shall be tilled into the soil below a minimum of 4 inches deep. Backfill in the medians under the proposed topsoil shall consist of friable native material free of rocks and debris. The cost of topsoil and median backfill shall be subsidiary to the contract.

Revisions

No.	Date	Item
1	03/10/98	CITY REVISIONS AS LISTED IN APPENDUM NO. 5
2	05/18/98	ADDITION OF TREE DRAINS.

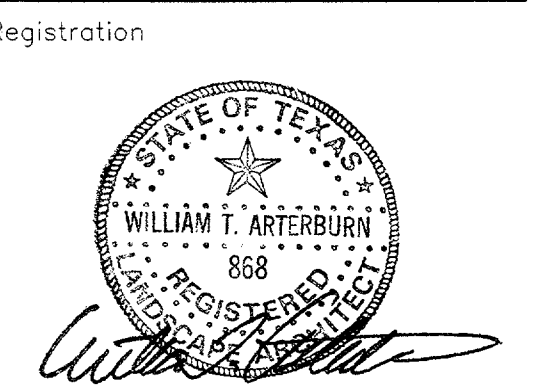


Drawn: **KDH/RFM**
Checked: **97018** Date: **05/18/98**
Project No. Date

Sheet Title: **TREWELL DRAINS/PLANTING PLAN**


Sheet No.: **PL-1**

DALLAS AREA
RAPID TRANSIT

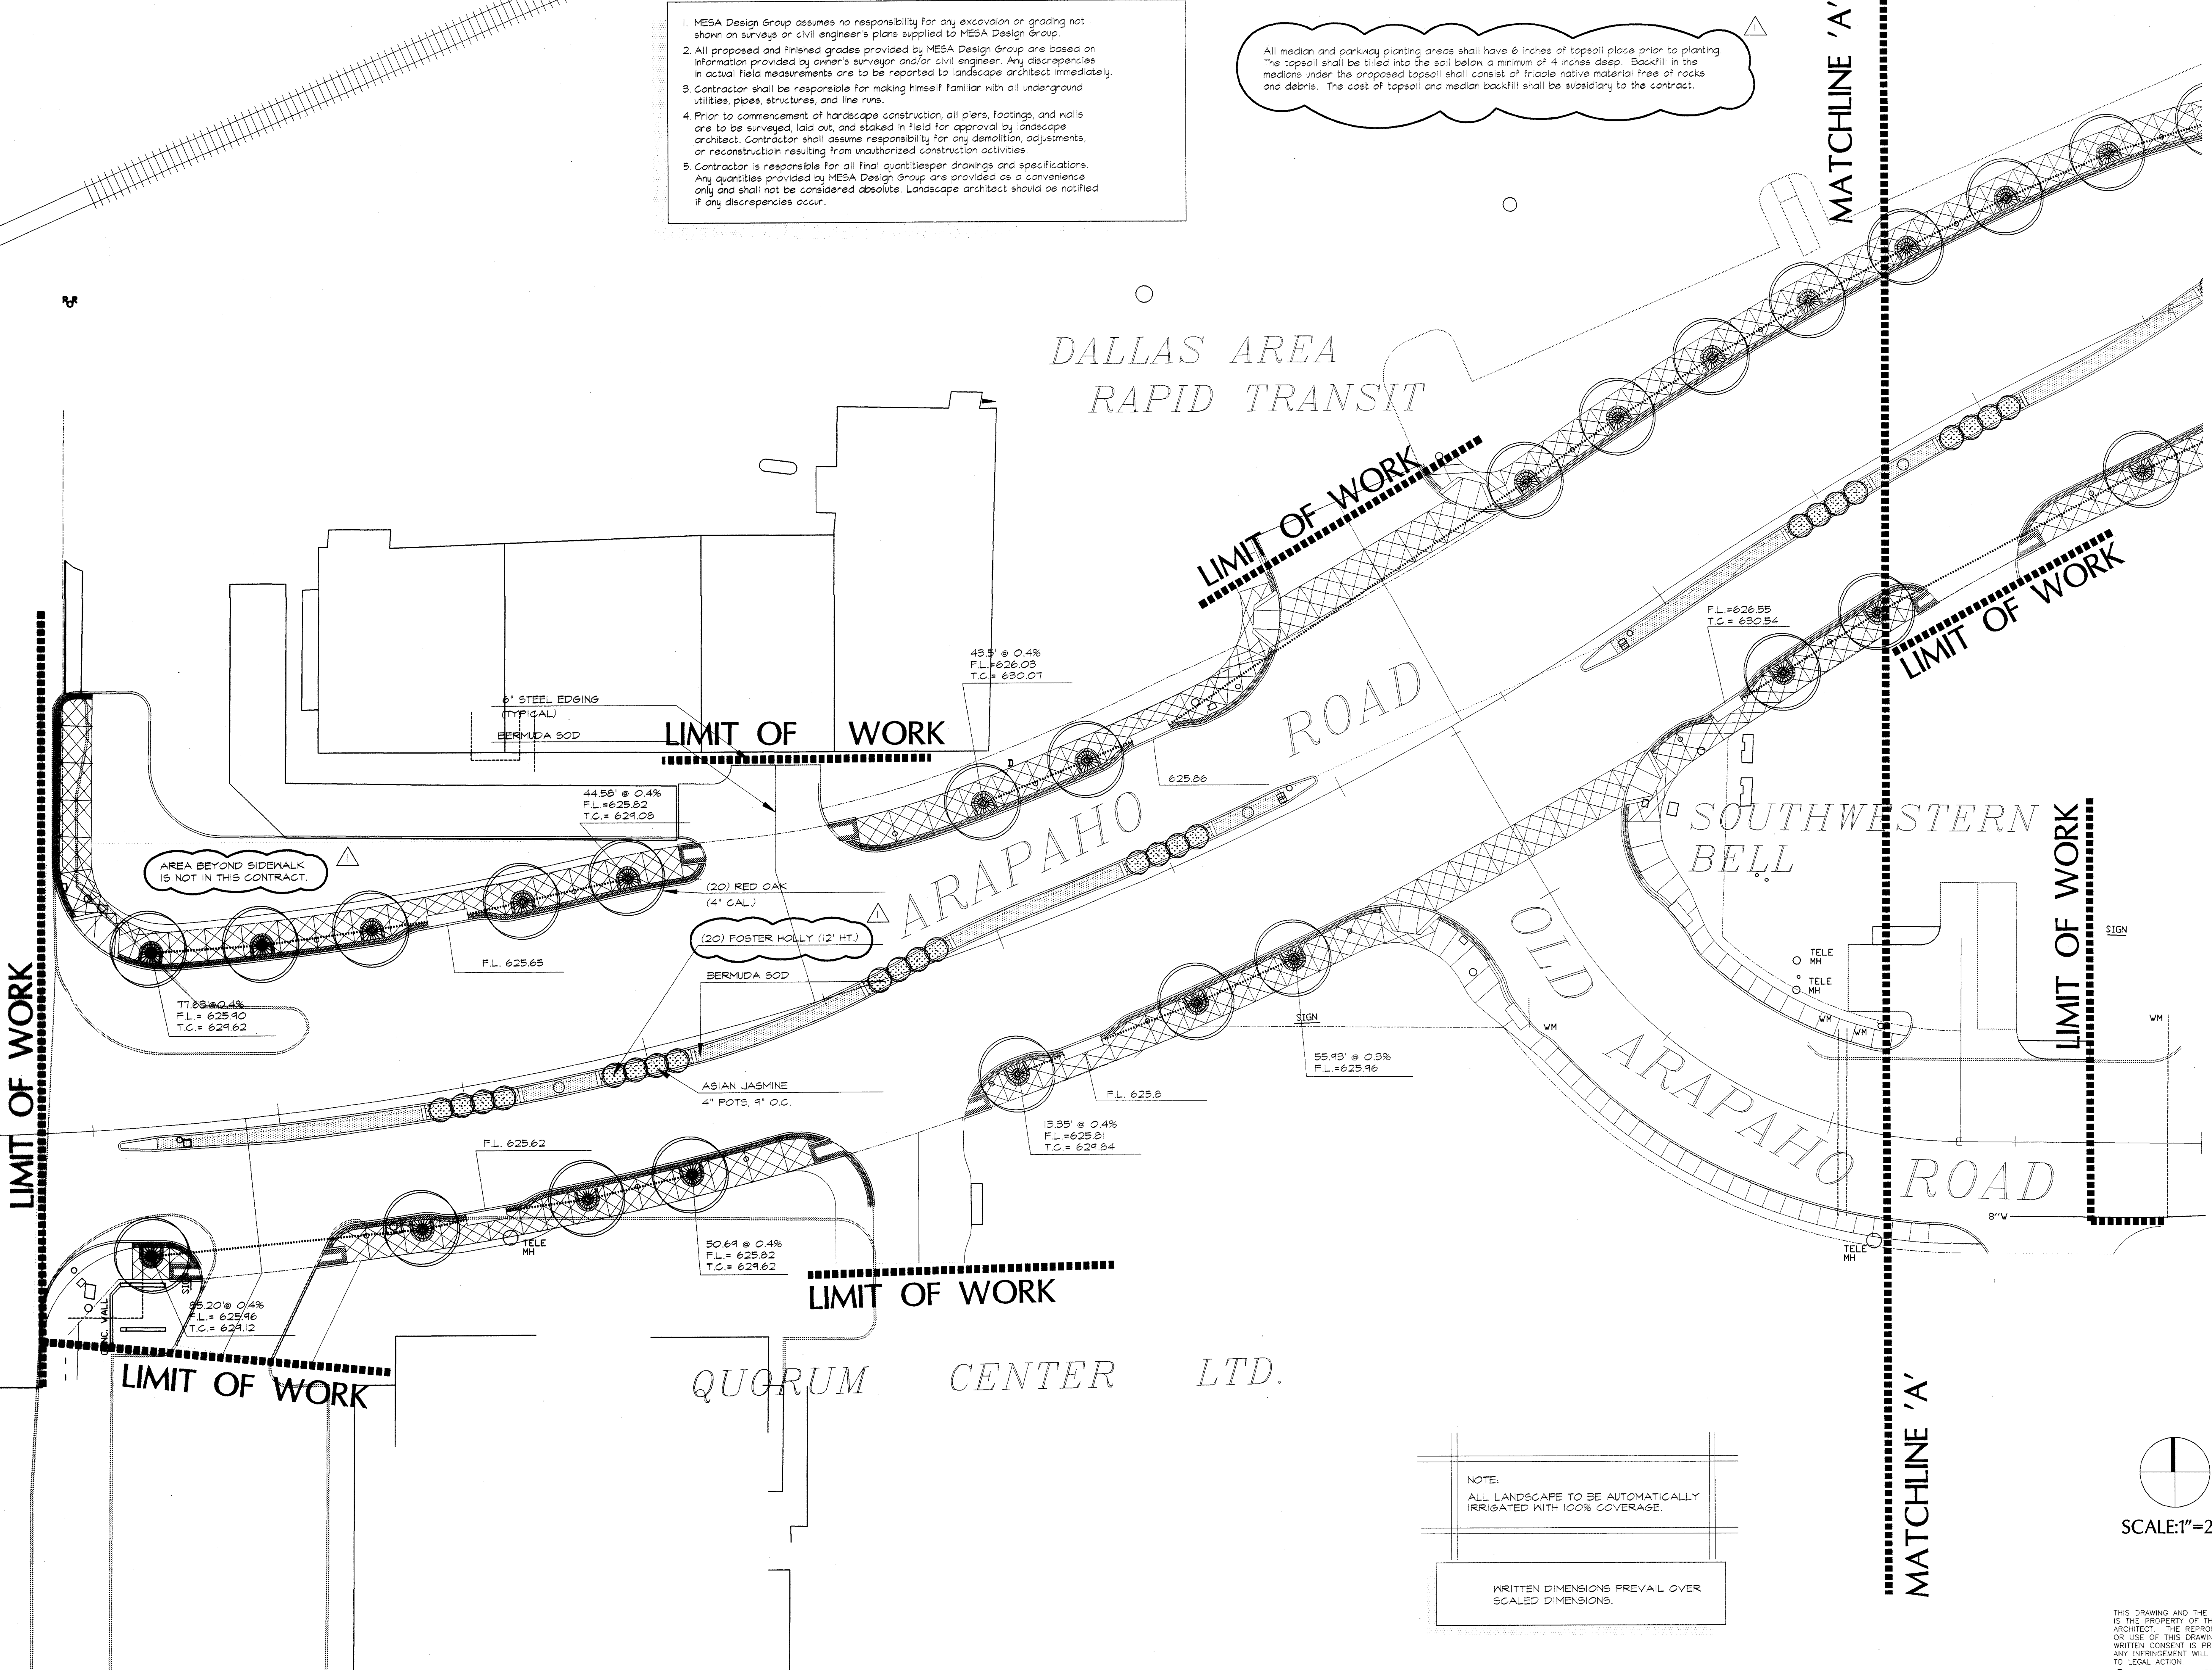

NOTE:
ALL LANDSCAPE TO BE AUTOMATICALLY IRRIGATED WITH 100% COVERAGE.

WRITTEN DIMENSIONS PREVAIL OVER SCALED DIMENSIONS.

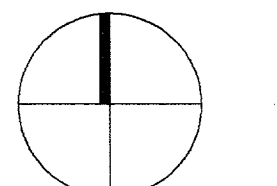

SCALE: 1"=20'

THIS DRAWING AND THE DESIGN SHOWN IS THE PROPERTY OF THE LANDSCAPE ARCHITECT. THE REPRODUCTION, COPYING, OR USE OF THIS DRAWING WITHOUT WRITTEN CONSENT IS PROHIBITED AND ANY INFRINGEMENT WILL BE SUBJECT TO LEGAL ACTION.
© Copyright 1997 MESA Design Group

IMPORTANT!!!


1. MESA Design Group assumes no responsibility for any excavation or grading not shown on surveys or civil engineer's plans supplied to MESA Design Group.
2. All proposed and finished grades provided by MESA Design Group are based on information provided by owner's surveyor and/or civil engineer. Any discrepancies in actual field measurements are to be reported to landscape architect immediately.
3. Contractor shall be responsible for making himself familiar with all underground utilities, pipes, structures, and line runs.
4. Prior to commencement of hardscape construction, all piers, footings, and walls are to be surveyed, laid out, and staked in field for approval by landscape architect. Contractor shall assume responsibility for any demolition, adjustments, or reconstruction resulting from unauthorized construction activities.
5. Contractor is responsible for all final quantities per drawings and specifications. Any quantities provided by MESA Design Group are provided as a convenience only and shall not be considered absolute. Landscape architect should be notified if any discrepancies occur.

All median and parkway planting areas shall have 6 inches of topsoil place prior to planting. The topsoil shall be tilled into the soil below a minimum of 4 inches deep. Backfill in the medians under the proposed topsoil shall consist of friable native material free of rocks and debris. The cost of topsoil and median backfill shall be subsidiary to the contract.

DALLAS AREA
RAPID TRANSIT

3100 McKinnon Street
Suite 905
Dallas, Texas 75201
(214) 871-0568 Fax: 871-1507

ARAPAHO ROAD
STREETSCAPE
CITY-OF-ADDISON, TEXAS

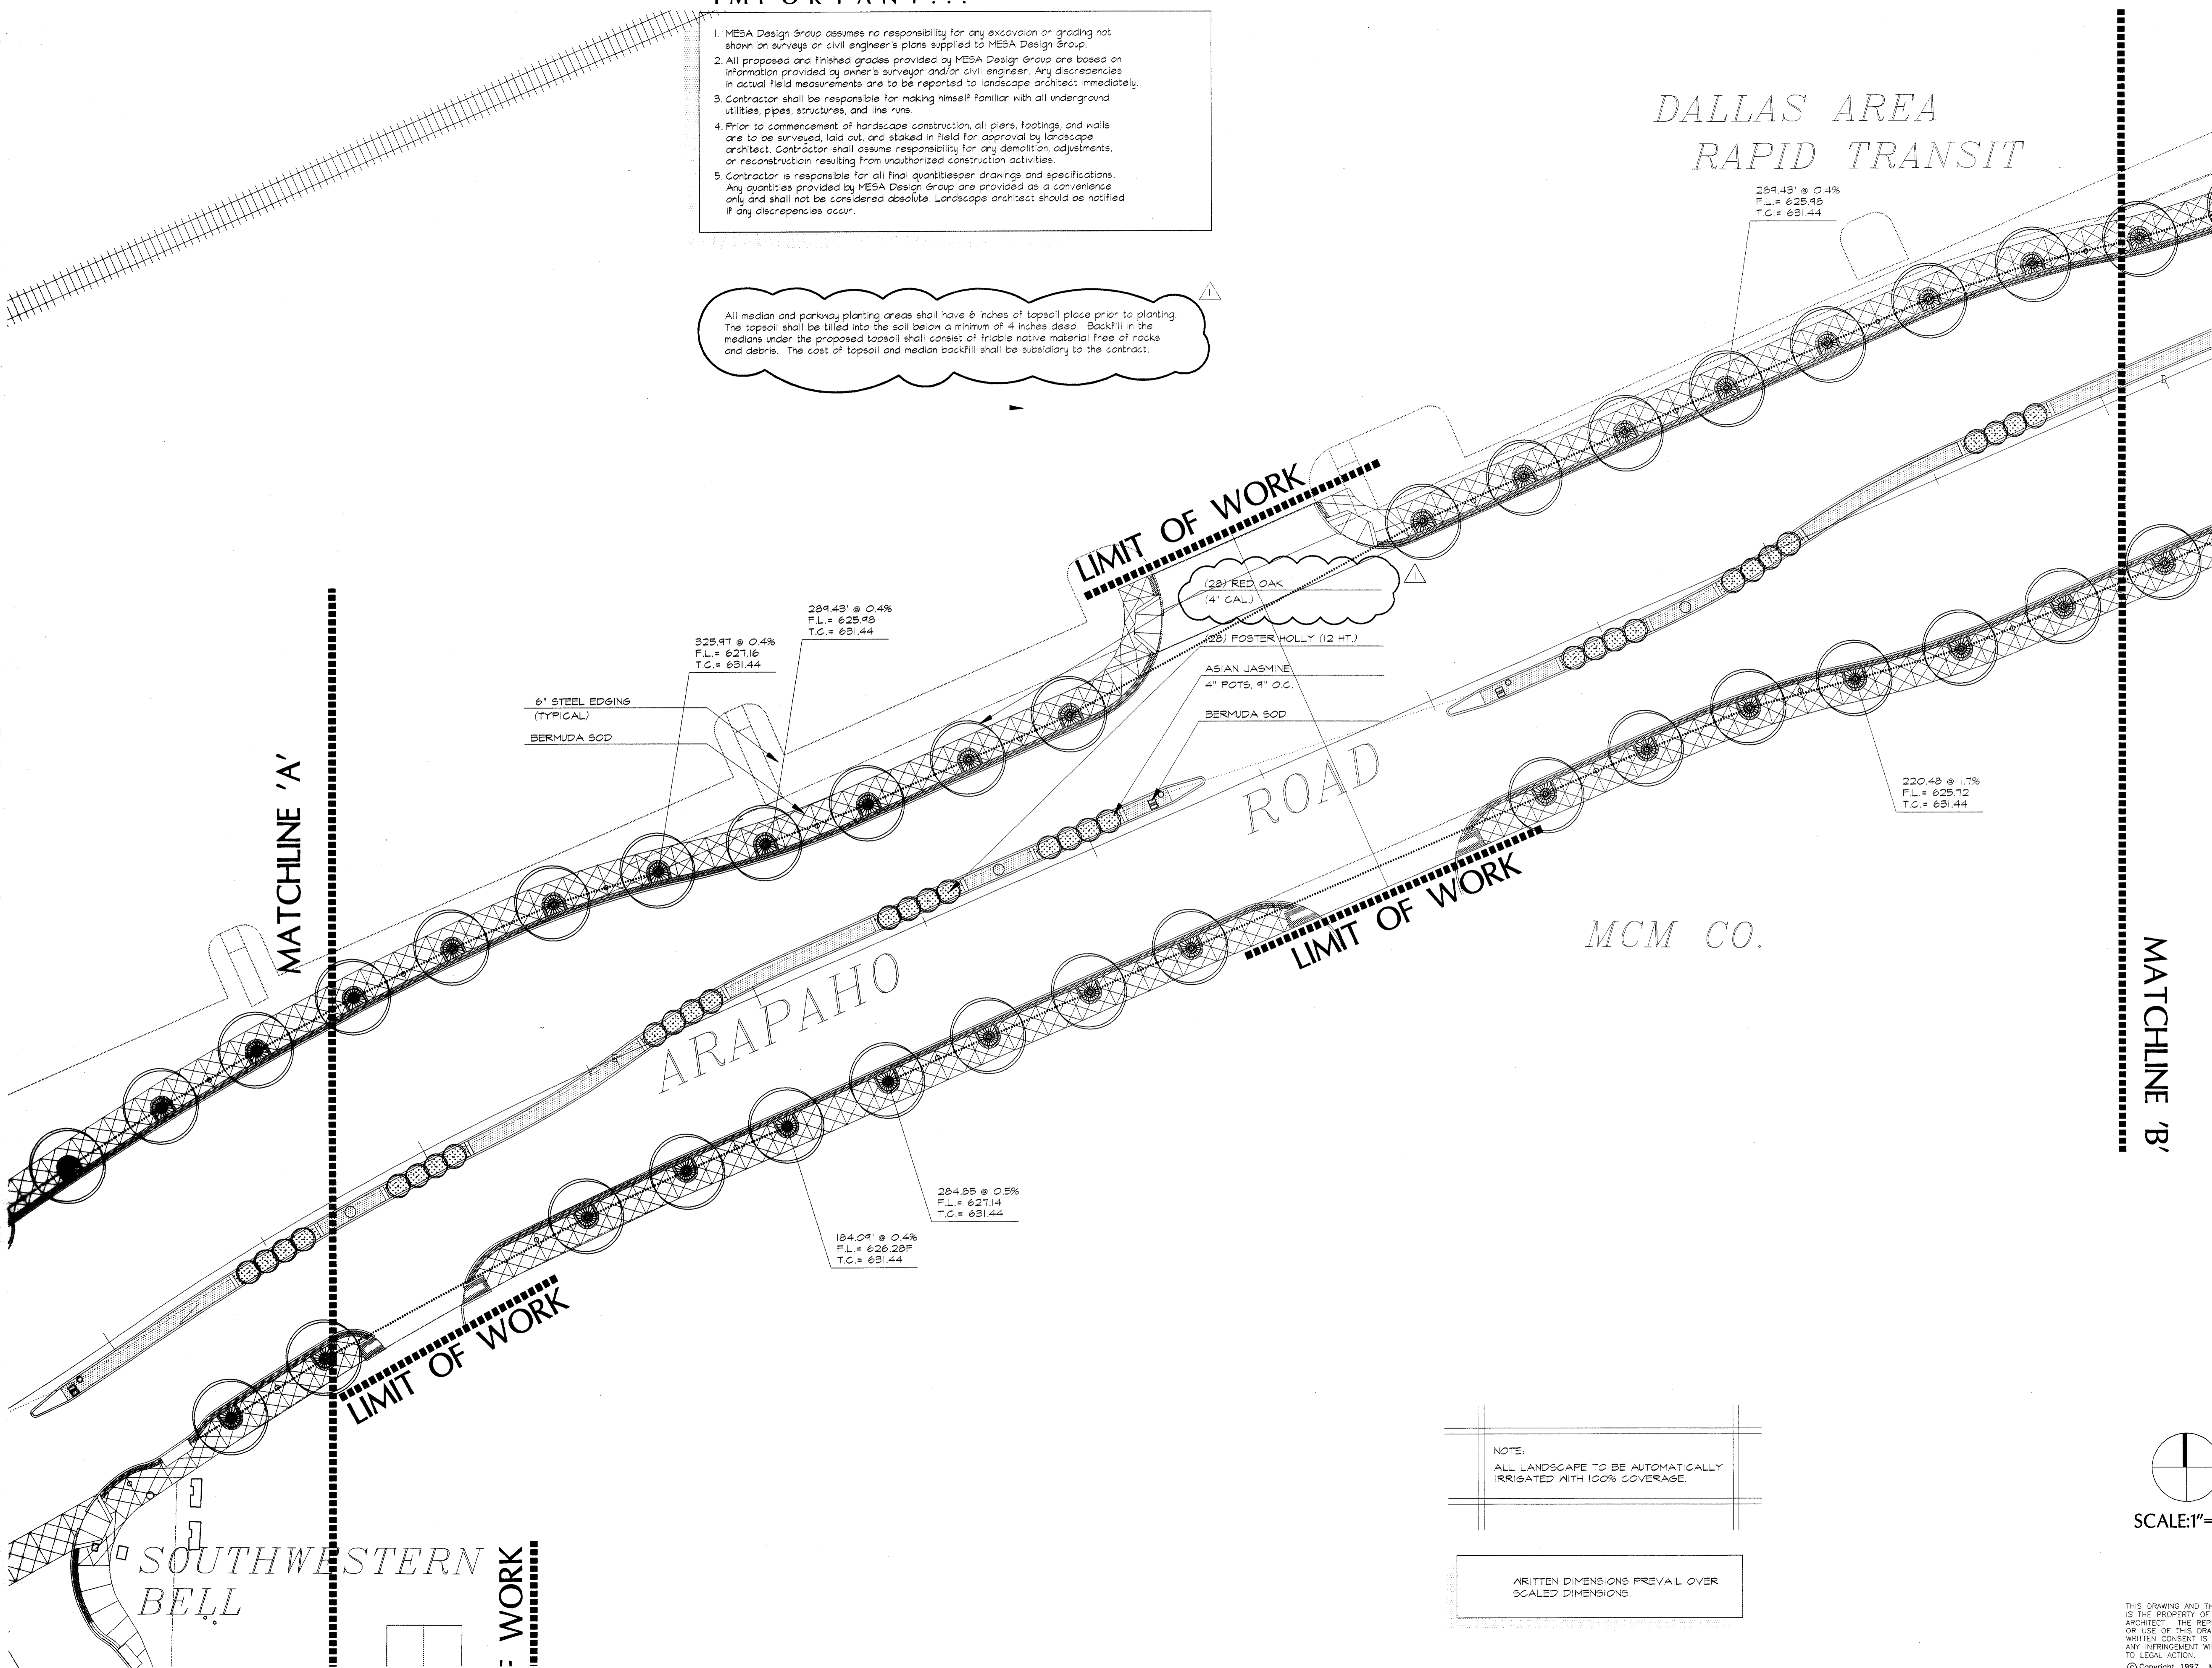

325.97 @ 0.4%
F.L. = 627.16
T.C. = 631.44

289.43' @ 0.4%
F.L. = 625.98
T.C. = 631.44

284.85 @ 0.5%
F.L. = 627.14
T.C. = 631.44

184.09' @ 0.4%
F.L. = 626.28F
T.C. = 631.44

220.48 @ 1.7%
F.L. = 625.72
T.C. = 631.44

(20) RED OAK
(4" CAL.)

(25) FOSTER HOLLY (12 HT.)

ASIAN JASMINE
4" POTS, 9" O.C.

BERMUDA SOD


6" STEEL EDGING
(TYPICAL)

BERMUDA SOD

MCM CO.

NOTE:
ALL LANDSCAPE TO BE AUTOMATICALLY
IRRIGATED WITH 100% COVERAGE.

WRITTEN DIMENSIONS PREVAIL OVER
SCALED DIMENSIONS.

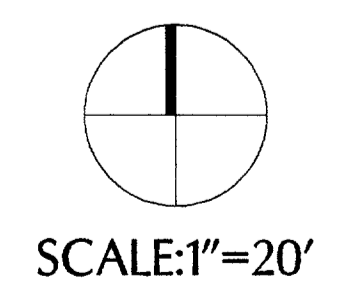

Revisions

No.	Date	Item
△	03/10/98	CITY REVISIONS AS LISTED IN ADDENDUM NO. 5
	05/18/98	ADDITION OF TREE DRAINS.

Registration

STATE OF TEXAS
WILLIAM T. ARTERBURN
REGISTERED
868
William T. Arterburn

KDH/RFM
Drawn

Checked
97018 05/18/98
Project No. Date

Sheet Title

TREWELL
DRAINS/
PLANTING
PLAN

Sheet No.

PL-2

THIS DRAWING AND THE DESIGN SHOWN IS THE PROPERTY OF THE LANDSCAPE ARCHITECT. THE REPRODUCTION, COPYING, OR USE OF THIS DRAWING WITHOUT WRITTEN CONSENT IS PROHIBITED AND ANY INFRINGEMENT WILL BE SUBJECT TO LEGAL ACTION.
© Copyright 1997 MESA Design Group

ARAPAHO ROAD
STREETSCAPE
CITY-OF-ADDISON, TEXAS

MATCHLINE 'C'

MATCHLINE 'C'

100.68' @ 2.0%
F.L. = 618.66
T.C. = 624.75

120.37' @ 2.0%
F.L. = 618.65
T.C. = 624.75

- (26) RED OAK
(4" CAL.)
- (36) FOSTER HOLLY (12' HT.)
- ASIAN JASMINE
- 4" POTS, 9" O.C.
- BERMUDA SOD

All median and parkway planting areas shall have 6 inches of topsoil placed prior to planting. The topsoil shall be tilled into the soil below a minimum of 4 inches deep. Backfill in the medians under the proposed topsoil shall consist of friable native material free of rocks and debris. The cost of topsoil and median backfill shall be subsidiary to the contract.

TOWN OF
ADDISON

CARRAMERICA LIMITED
PARTNERSHIP

119.91' @ 1.0%
F.L. = 619.26

120.00' @ 1.0%
F.L. = 619.25

6" STEEL EDGINGS
(TYPICAL)

BERMUDA SOD

LIMIT OF WORK

Delete per
Jim Pierce

Fire Hydrant

Valve

QUORUM

DRIVE

DALLAS AREA
RAPID TRANSIT

MCM CO.


F.L. = 621.68
T.C. = 625.68

F.L. = 621.97
T.C. = 625.97

NOTE:
ALL LANDSCAPE TO BE AUTOMATICALLY
IRRIGATED WITH 100% COVERAGE.

MATCHLINE 'B'

MATCHLINE 'B'

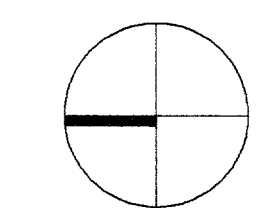

SCALE: 1"=20'

WRITTEN DIMENSIONS PREVAIL OVER
SCALED DIMENSIONS.

THIS DRAWING AND THE DESIGN SHOWN
IS THE PROPERTY OF THE LANDSCAPE
ARCHITECT. THE REPRODUCTION, COPYING,
OR USE OF THIS DRAWING WITHOUT
WRITTEN CONSENT IS PROHIBITED AND
ANY INFRINGEMENT WILL BE SUBJECT
TO LEGAL ACTION.
© Copyright 1997 MESA Design Group

Revisions

No.	Date	Item
△	02/10/98	CITY REVISIONS AS LISTED IN ADDENDUM NO. 5
	05/18/98	ADDITION OF TREE DRAINS

Registration

W. T. Arterburn

KDH/RFM
Drawn

Checked
97018
Project No.

12/12/97
Date

Sheet Title

TREWELL
DRAINS/
PLANTING
PLAN

Sheet No.

PL-3

ARAPAHO ROAD
STREETSCAPE
CITY-OF-ADDISON, TEXAS

Revisions

No.	Date	Item
1	03/10/98	CITY REVISIONS AS LISTED IN ADDENDUM NO. 5
2	05/18/98	ADDITION OF TREE DRAINS

Registration

STATE OF TEXAS
WILLIAM T. ARTERBURN
REGISTERED PROFESSIONAL LANDSCAPE ARCHITECT
868

KDH/RFM
Drawn

Checked
97018 12/12/97
Project No. Date

Sheet Title


TREEWELL
DRAINS/
PLANTING
PLAN

Sheet No.


PL-4

C:/PROJECTS/97018/ADDBASE

All median and parkway planting areas shall have 6 inches of topsoil placed prior to planting. The topsoil shall be tilled into the soil below a minimum of 4 inches deep. Backfill in the medians under the proposed topsoil shall consist of friable native material free of rocks and debris. The cost of topsoil and median backfill shall be subsidiary to the contract.

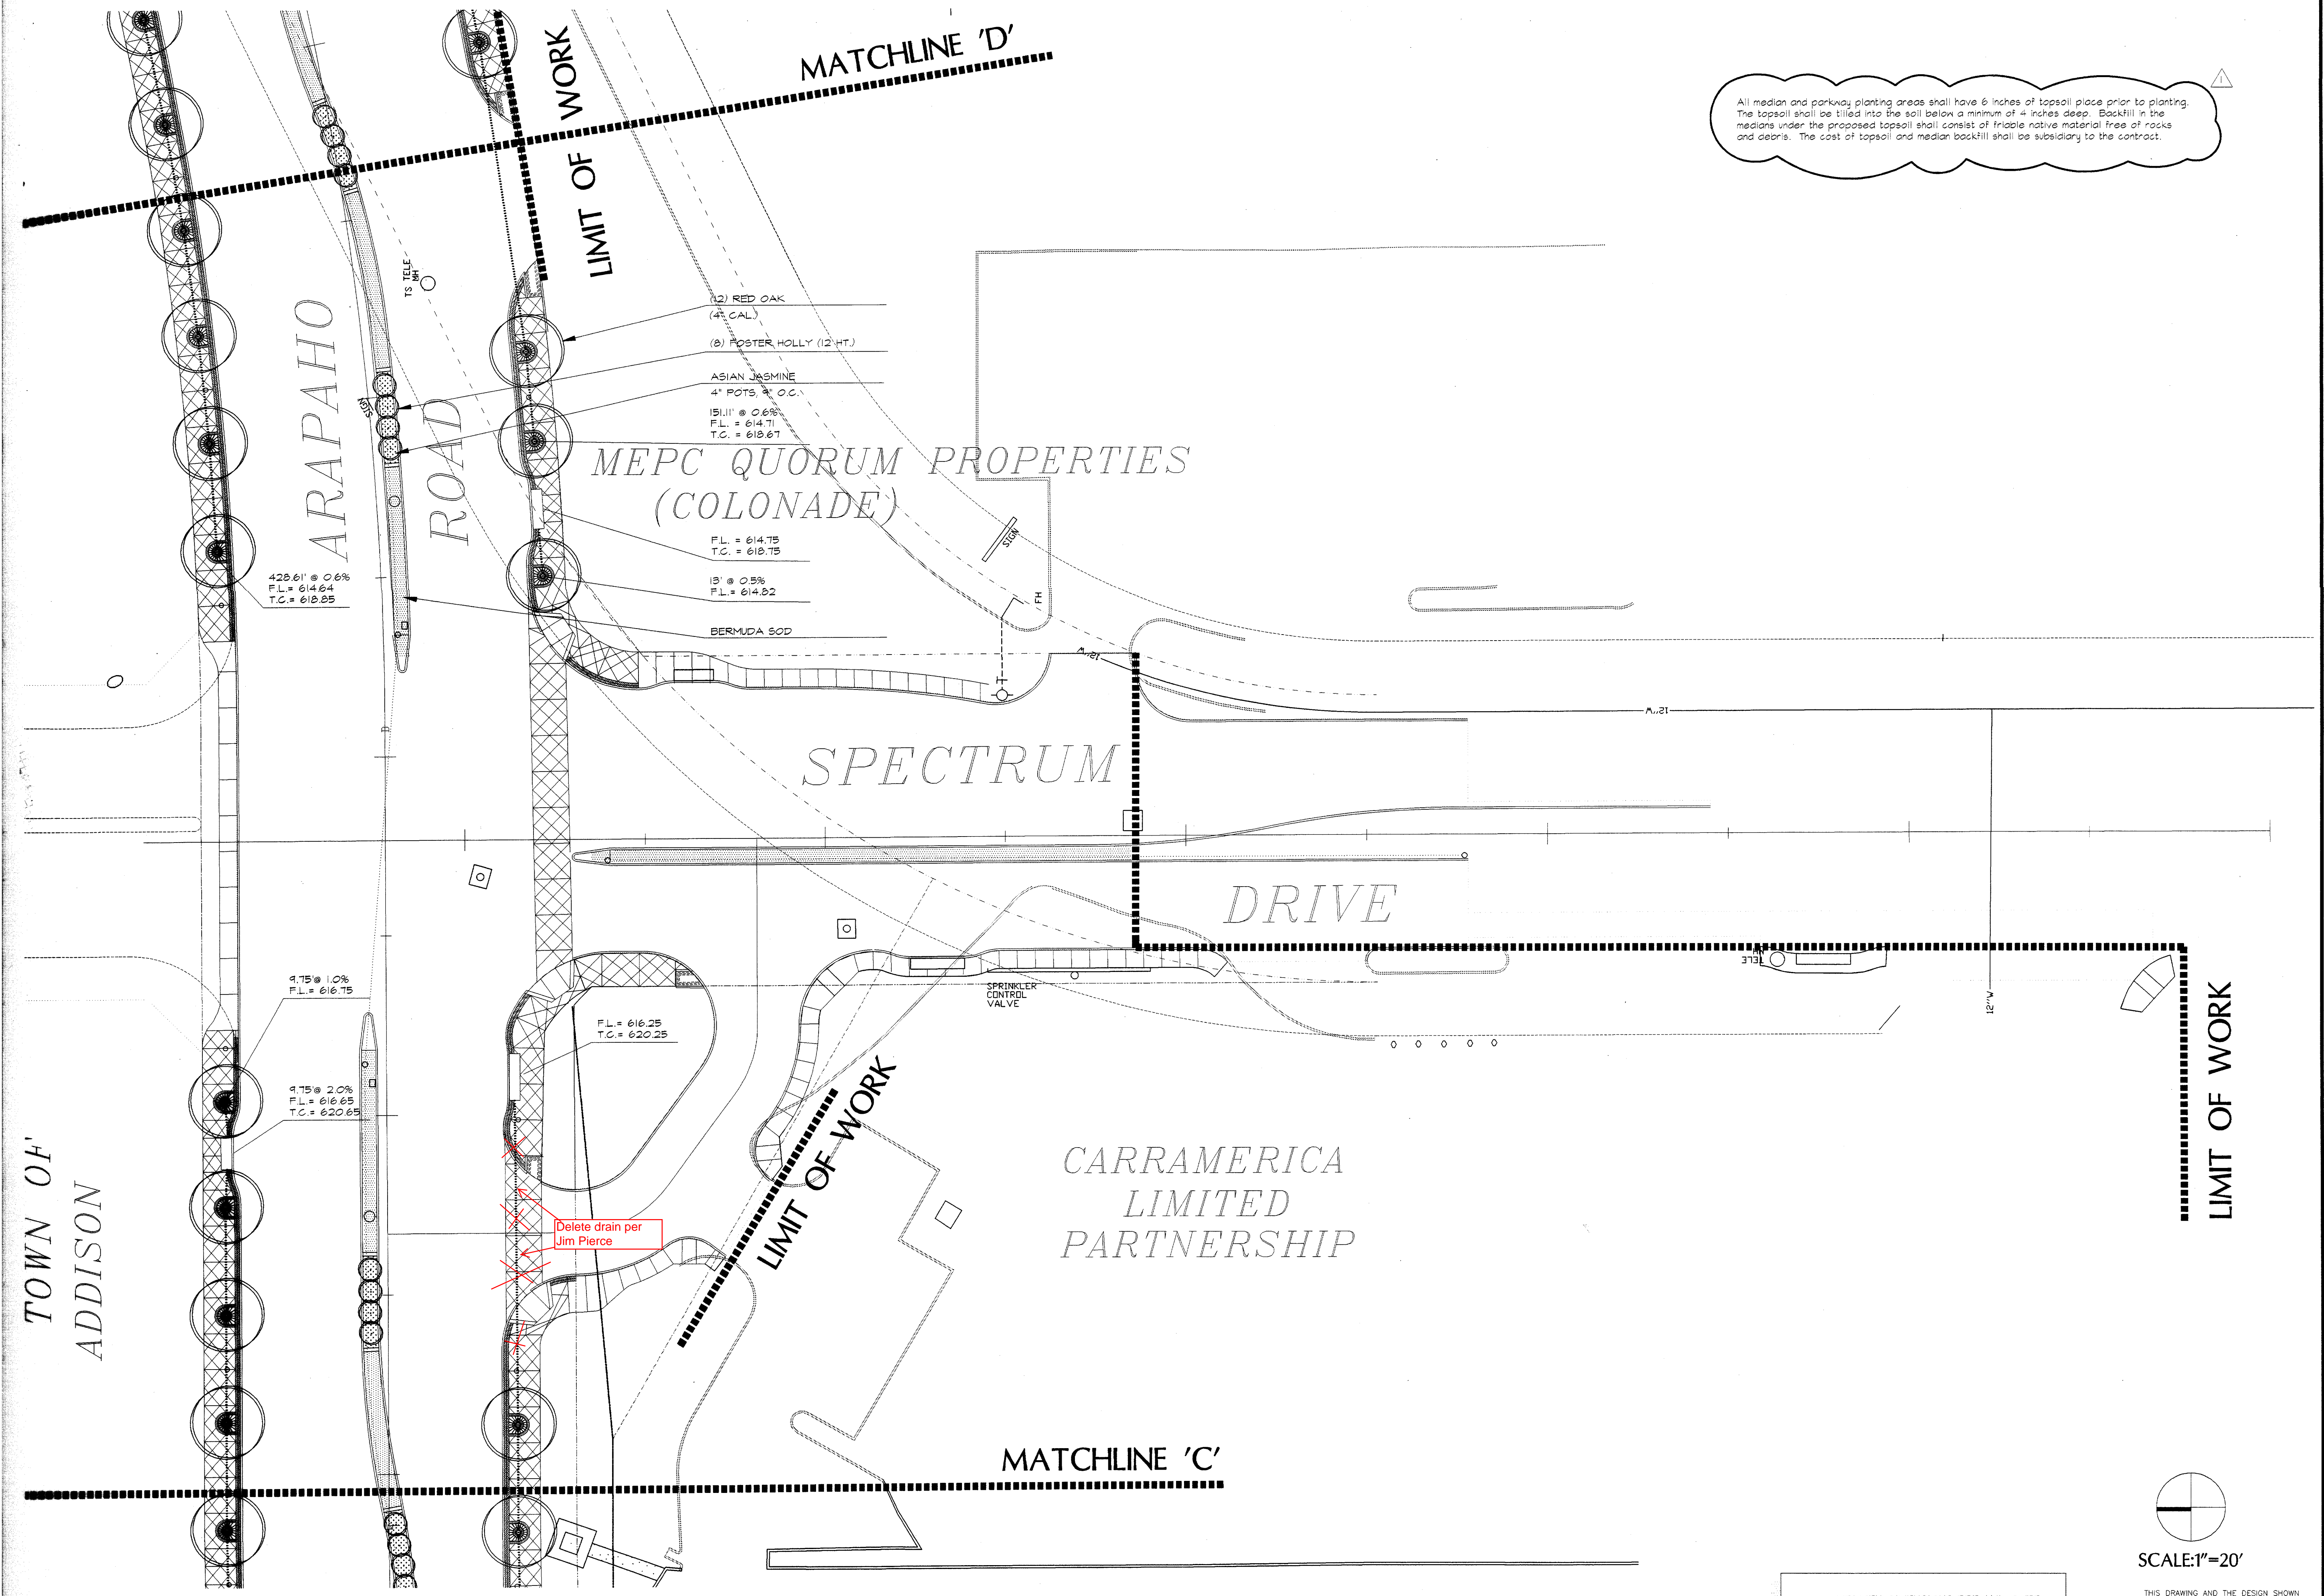

WRITTEN DIMENSIONS PREVAIL OVER SCALED DIMENSIONS.

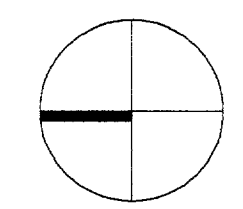

SCALE: 1"=20'

THIS DRAWING AND THE DESIGN SHOWN IS THE PROPERTY OF THE LANDSCAPE ARCHITECT. THE REPRODUCTION, COPYING, OR USE OF THIS DRAWING WITHOUT WRITTEN CONSENT IS PROHIBITED AND ANY INFRINGEMENT WILL BE SUBJECT TO LEGAL ACTION.
© Copyright 1997 MESA Design Group

TOWN OF
ADDISON

ARAPAHO
ROAD

MEPC QUORUM PROPERTIES
(COLONADE)

SPECTRUM
DRIVE

CARRAMERICA
LIMITED
PARTNERSHIP

MATCHLINE 'C'

MATCHLINE 'D'

LIMIT OF WORK

LIMIT OF WORK

LIMIT OF WORK

(2) RED OAK
(4" CAL.)
(8) FOSTER HOLLY (12' HT.)
ASIAN JASMINE
4" POTS @ O.C.
15' @ 0.6%
F.L. = 614.71
T.C. = 618.67

F.L. = 614.75
T.C. = 618.75
13' @ 0.5%
F.L. = 614.52

BERMUDA SOD

428.61' @ 0.6%
F.L. = 614.64
T.C. = 618.85


4.75' @ 1.0%
F.L. = 616.75

4.75' @ 2.0%
F.L. = 616.65
T.C. = 620.65

F.L. = 616.25
T.C. = 620.25

Delete drain per
Jim Pierce

SPRINKLER
CONTROL
VALVE

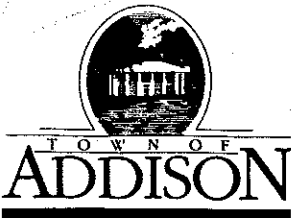

Public Works / Engineering

16801 Westgrove • P.O. Box 144

Addison, Texas 75001

Telephone: (214) 450-2871 • Fax: (214) 931-6643

Keep/Toss
 Return

LETTER OF TRANSMITTAL

DATE	11-3-98	JOB NO.
ATTENTION		
RE:	Arapaho Rd Tree Drains	

TO Nelson Mitchell
Ed Bell Const

GENTLEMAN:

WE ARE SENDING YOU

Shop Drawings

Copy of letter

Attached

Prints

Change order

Under separate cover via _____ the following items:

Plans

Samples

Specifications

COPIES	DATE	NO.	DESCRIPTION
3			Arapaho Rd Streetscape Sheets PL-5 & PL-6 by MESA Design Group

THESE ARE TRANSMITTED as checked below:

For approval

For your use

As requested

For review and comment

FOR BIDS DUE _____ 19____

Approved as submitted

Approved as noted

Returned for corrections

Resubmit _____ copies for approval

Submit _____ copies for distribution

Return _____ corrected prints

PRINTS RETURNED AFTER LOAN TO US

REMARKS These drawings, submitted previously, did not have tree drain elevations shown. The elevations are shown on the attached. Some alternate elevations are shown "bucking" street grade. We do not want to buck grade.

COPY TO Dave Wilde w drawings
Rob Weber w/o drawings

SIGNED: Jim Lewis


If enclosures are not as noted, please notify us at once.

1. MESA Design Group assumes no responsibility for any excavation or grading not shown on surveys or civil engineer's plans supplied to MESA Design Group.
2. All proposed and finished grades provided by MESA Design Group are based on information provided by owner's surveyor and/or civil engineer. Any discrepancies in actual field measurements are to be reported to landscape architect immediately.
3. Contractor shall be responsible for making himself familiar with all underground utilities, pipes, structures, and line runs.
4. Prior to commencement of hardscape construction, all piers, footings, and walls are to be surveyed, laid out, and staked in field for approval by landscape architect. Contractor shall assume responsibility for any demolition, adjustments, or reconstruction resulting from unauthorized construction activities.
5. Contractor is responsible for all final quantities per drawings and specifications. Any quantities provided by MESA Design Group are provided as a convenience only and shall not be considered absolute. Landscape architect should be notified if any discrepancies occur.

All median and parkway planting areas shall have 6 inches of topsoil place prior to planting. The topsoil shall be tilled into the soil below a minimum of 4 inches deep. Backfill in the medians under the proposed topsoil shall consist of friable native material free of rocks and debris. The cost of topsoil and median backfill shall be subsidiary to the contract.

ARAPAHO ROAD
STREETSCAPE
CITY-OF-ADDISON, TEXAS


No.	Date	Item
1	03/10/98	CITY REVISIONS AS LISTED IN APPENDUM NO. 5
2	05/18/98	ADDITION OF TREE DRAINS.

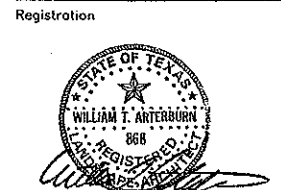

KDH/RFM
Drawn
Checked
97018
Project No.
05/18/98
Date
Sheet Title


TREEWELL
DRAINS/
PLANTING
PLAN

SHEET PL-5

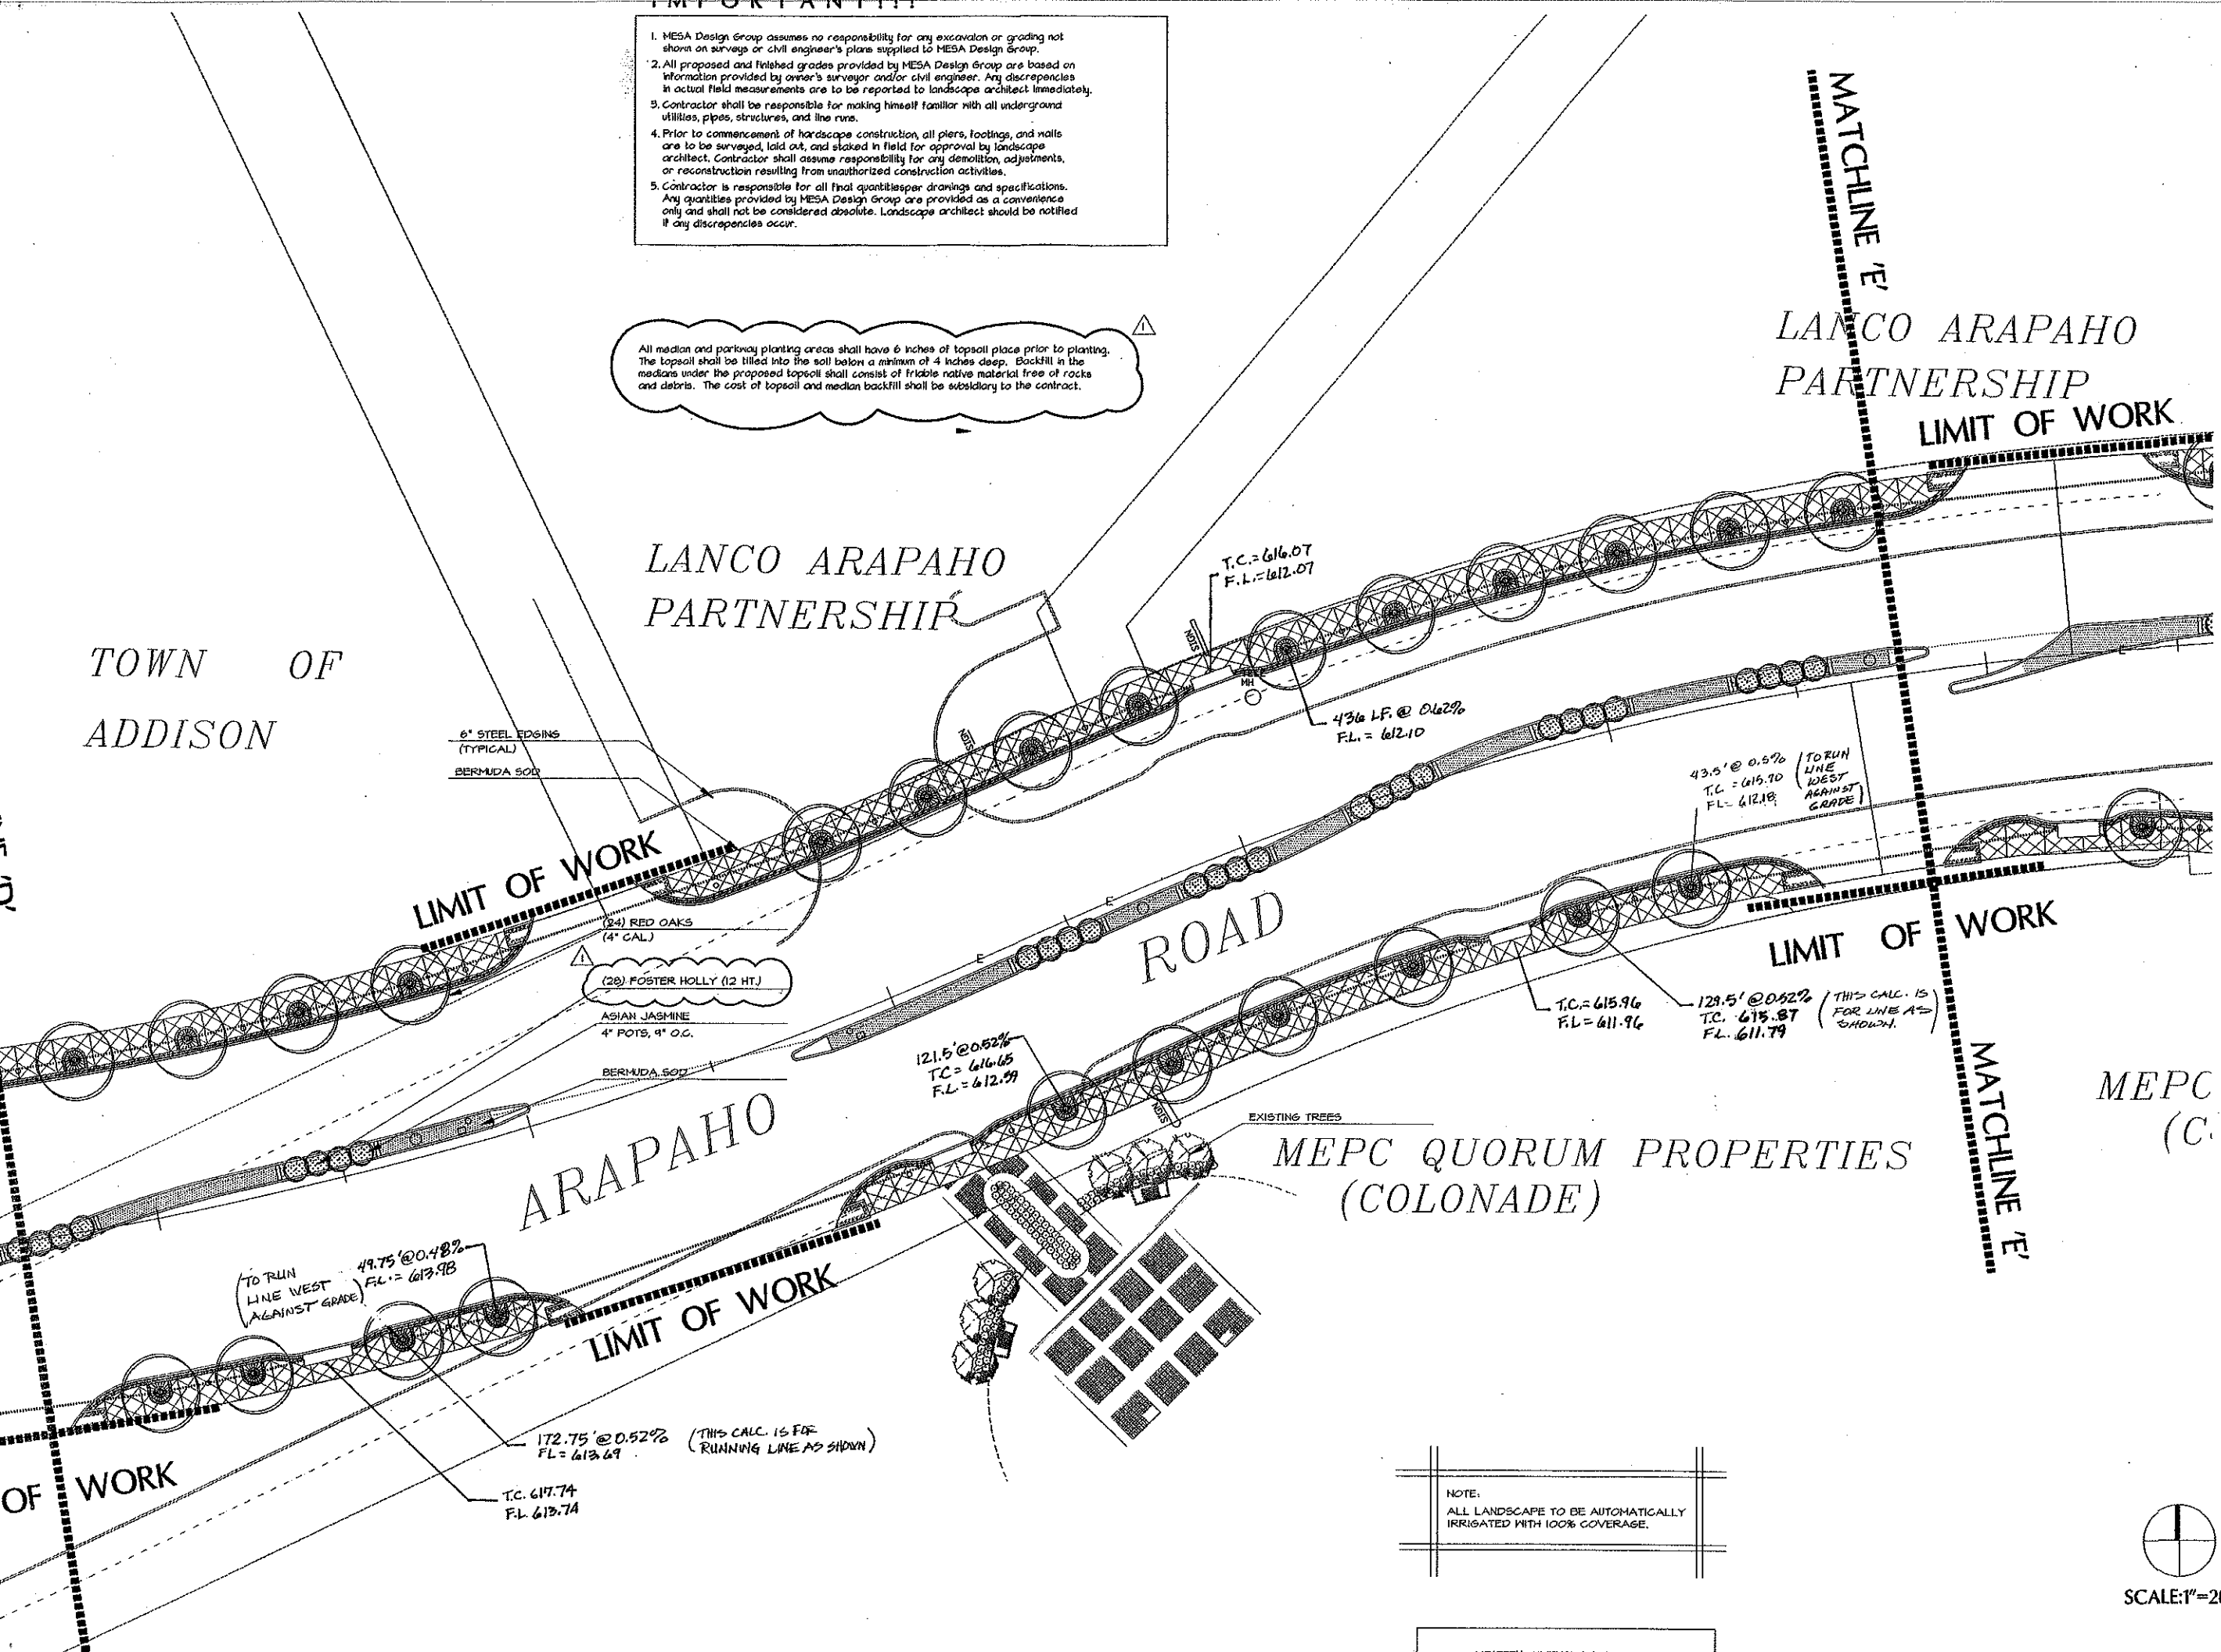

- IMPORTANT:
1. MESA Design Group assumes no responsibility for any excavation or grading not shown on surveys or civil engineer's plans supplied to MESA Design Group.
 2. All proposed and finished grades provided by MESA Design Group are based on information provided by owner's surveyor and/or civil engineer. Any discrepancies in actual field measurements are to be reported to landscape architect immediately.
 3. Contractor shall be responsible for making himself familiar with all underground utilities, pipes, structures, and line runs.
 4. Prior to commencement of hardscape construction, all piers, footings, and walls are to be surveyed, laid out, and staked in field for approval by landscape architect. Contractor shall assume responsibility for any demolition, adjustments, or reconstruction resulting from unauthorized construction activities.
 5. Contractor is responsible for all final quantities per drawings and specifications. Any quantities provided by MESA Design Group are provided as a convenience only and shall not be considered absolute. Landscape architect should be notified if any discrepancies occur.

All median and parkway planting areas shall have 6 inches of topsoil placed prior to planting. The topsoil shall be tilled into the soil below a minimum of 4 inches deep. Backfill in the medians under the proposed topsoil shall consist of friable native material free of rocks and debris. The cost of topsoil and median backfill shall be subsidiary to the contract.

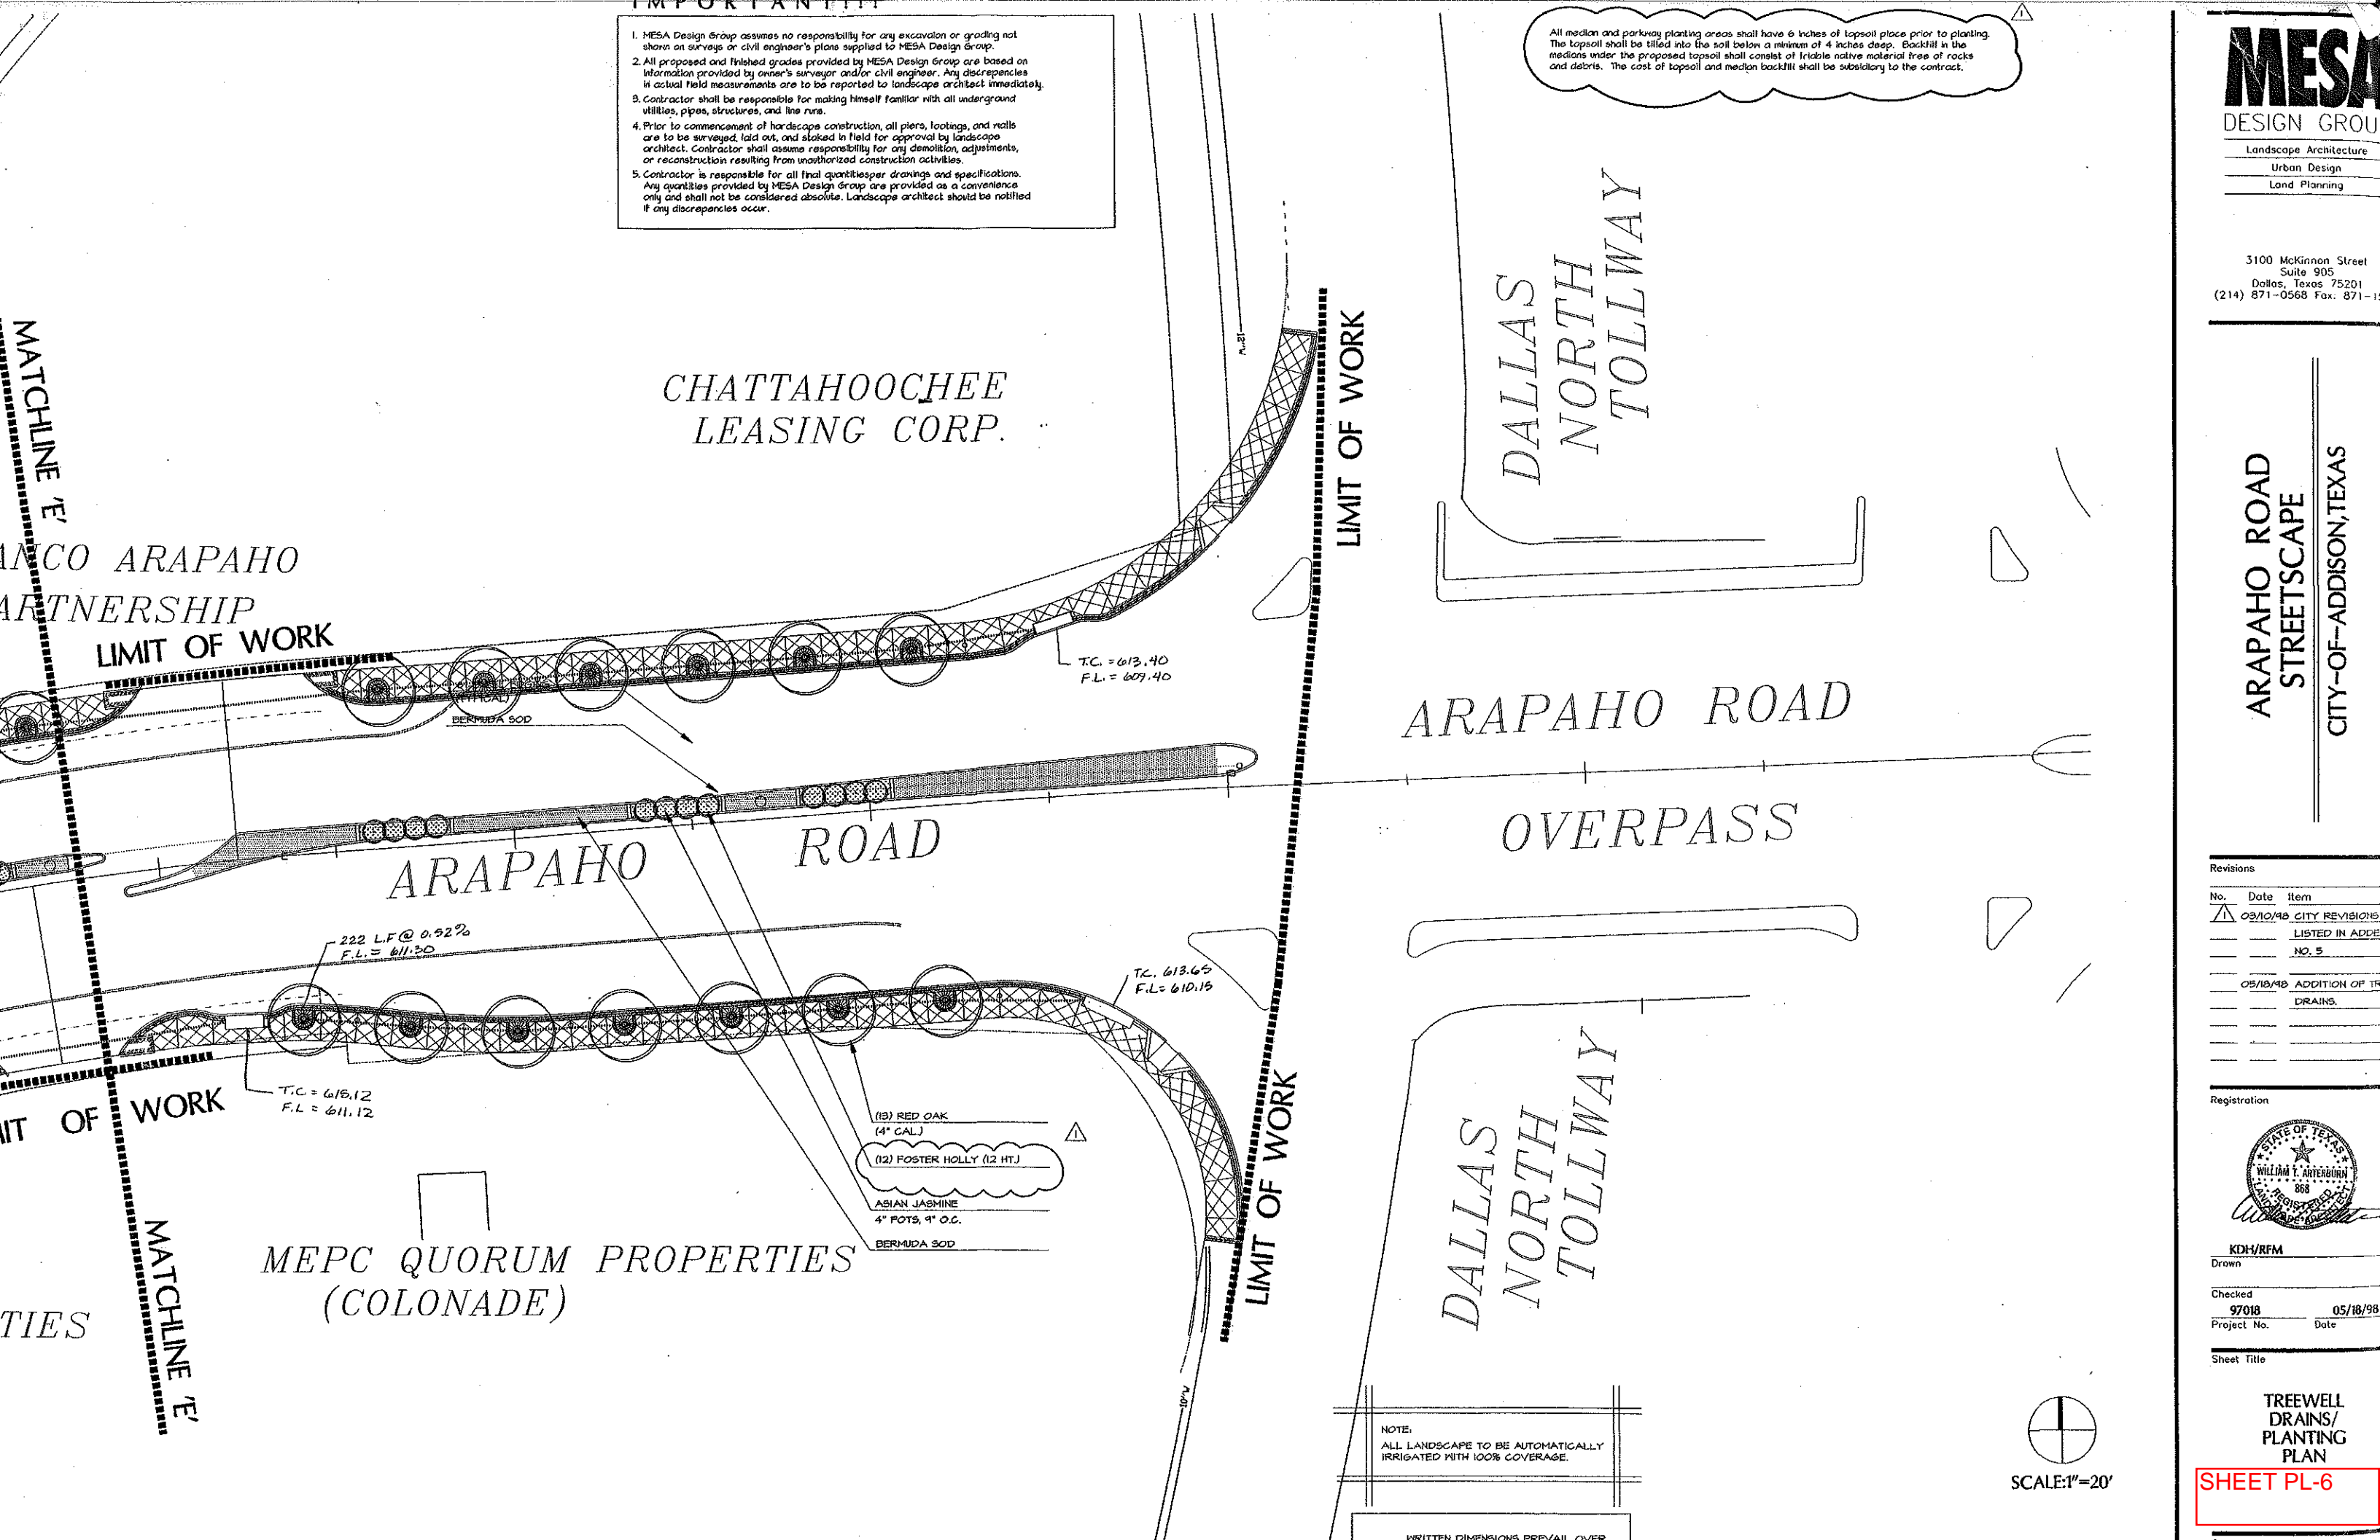

- (13) RED OAK (4" CAL.)
- (12) FOSTER HOLLY (12 HT.)
- ASIAN JASMINE
- 4" POTS, 9" O.C.
- BERMUDA SOD

NOTE:
ALL LANDSCAPE TO BE AUTOMATICALLY IRRIGATED WITH 100% COVERAGE.


SCALE: 1"=20'

3100 McKinnon Street
Suite 905
Dallas, Texas 75201
(214) 871-0568 Fax: 871-1111

ARAPAHO ROAD
STREETSCAPE
CITY-OF-ADDISON, TEXAS

Revisions


No.	Date	Item
1	03/10/98	CITY REVISIONS LISTED IN ADDITION TO NO. 5
2	05/18/98	ADDITION OF TREE DRAINS.

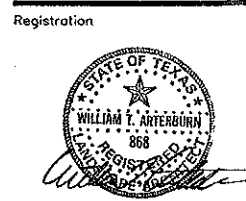


KDH/RFM
Drawn
Checked
97018
Project No. 05/18/98
Date

Sheet Title
TREWELL
DRAINS/
PLANTING
PLAN


SHEET PL-6

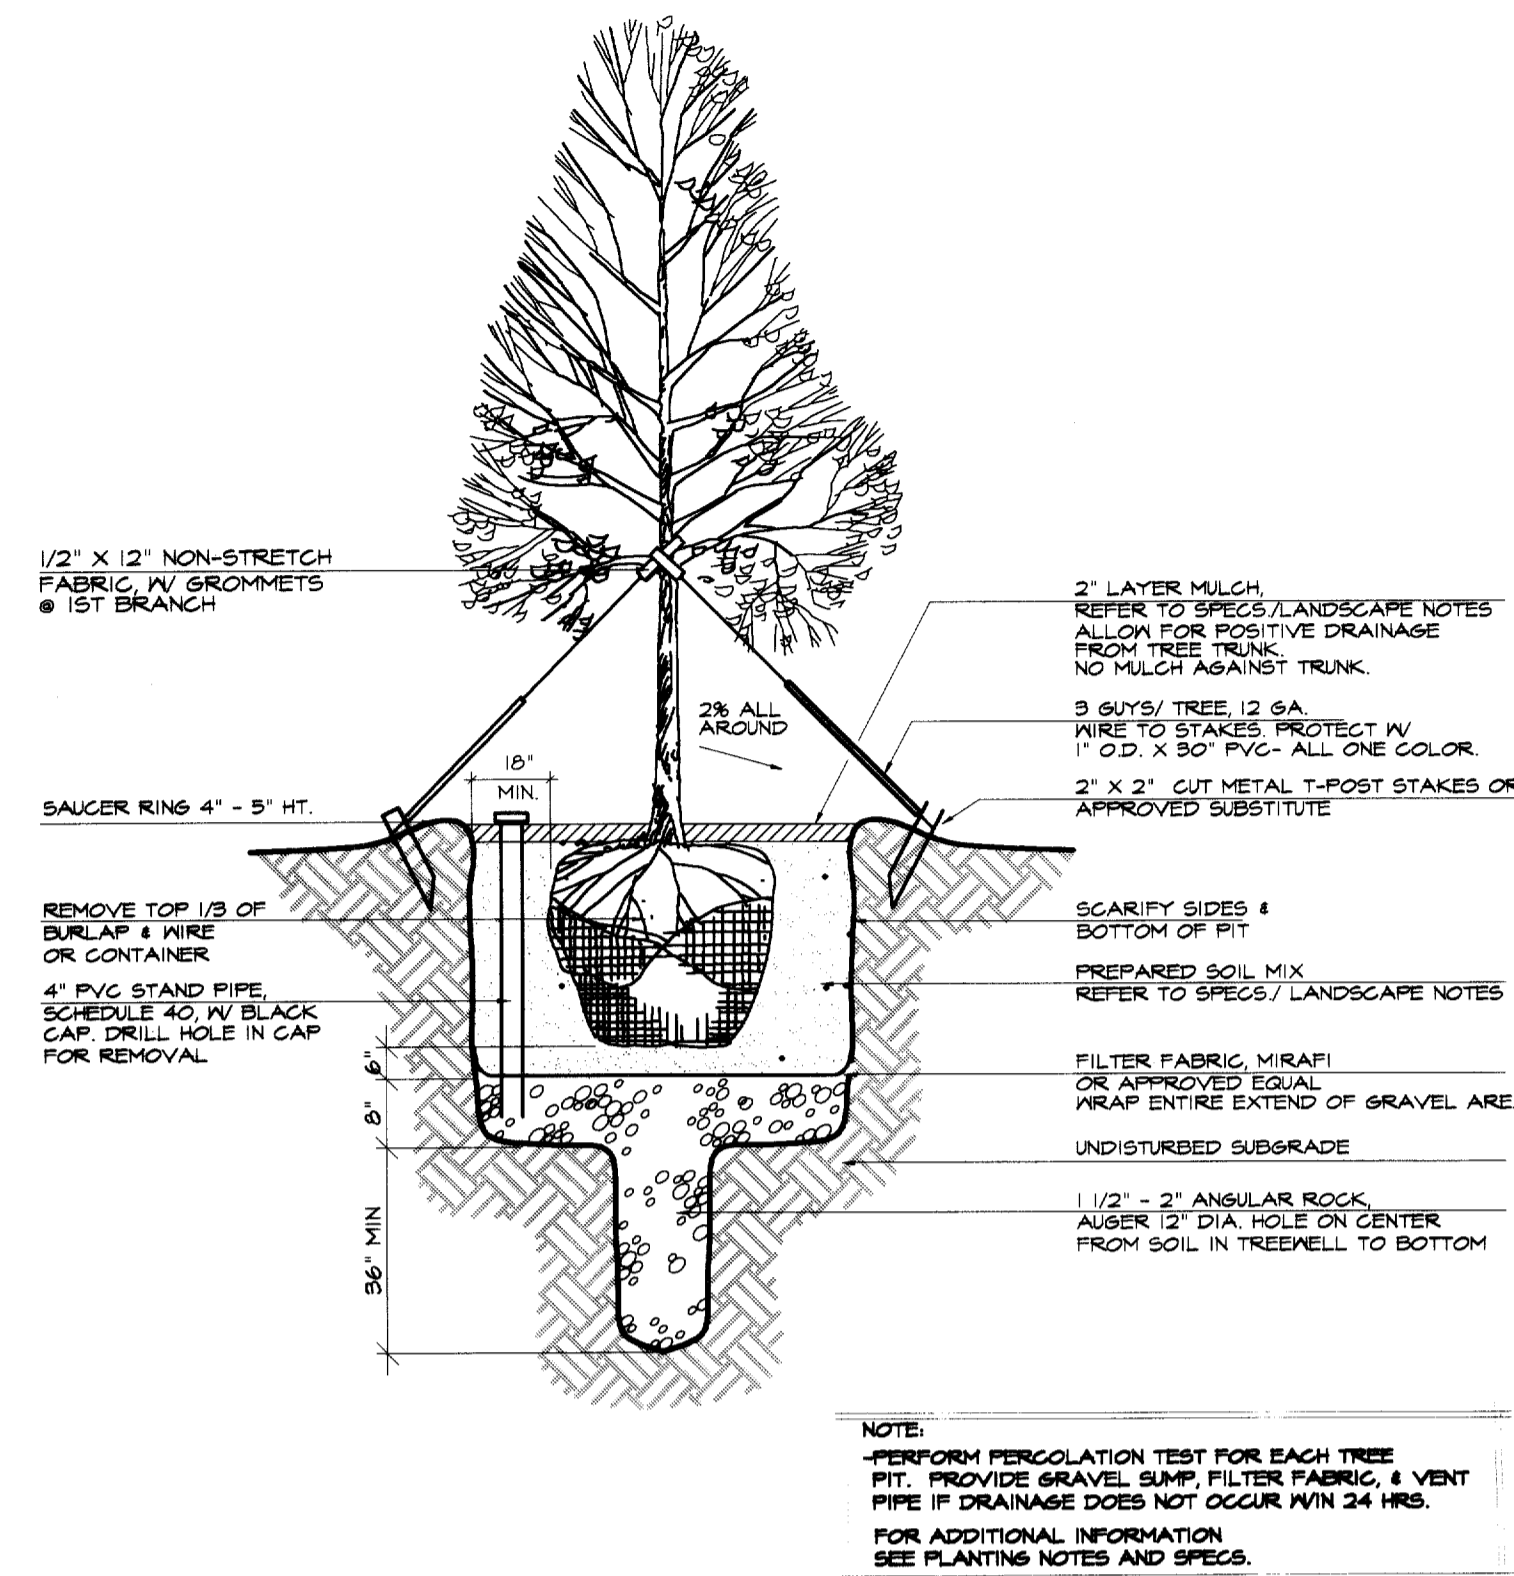

A ORNAMENTAL TREE PLANTING DETAIL
HORNBEAM / HOLLY

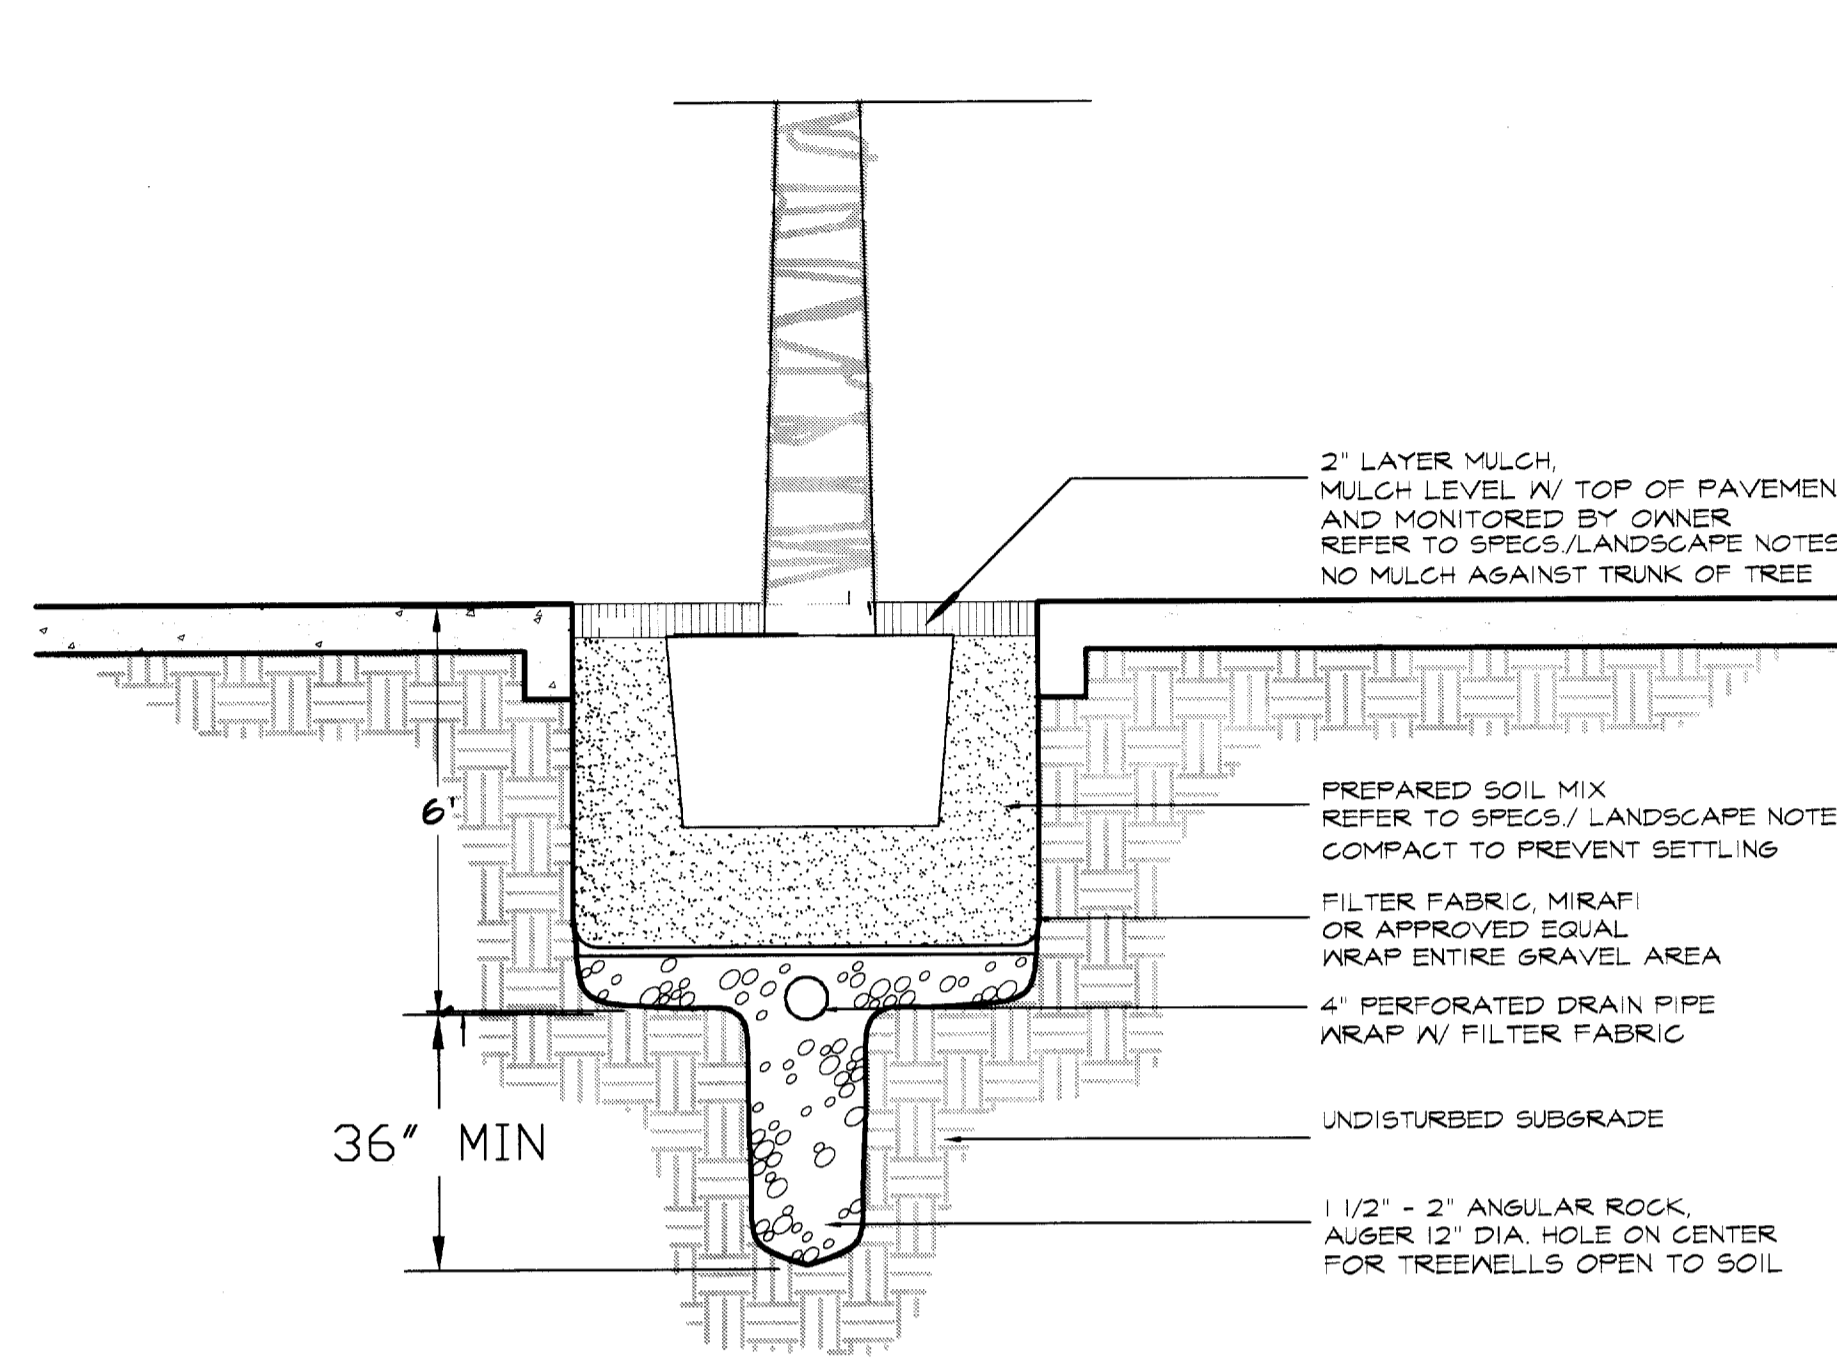

B TREE WELL PLANTING DETAIL
RED OAKS ALONG QUORUM DRIVE

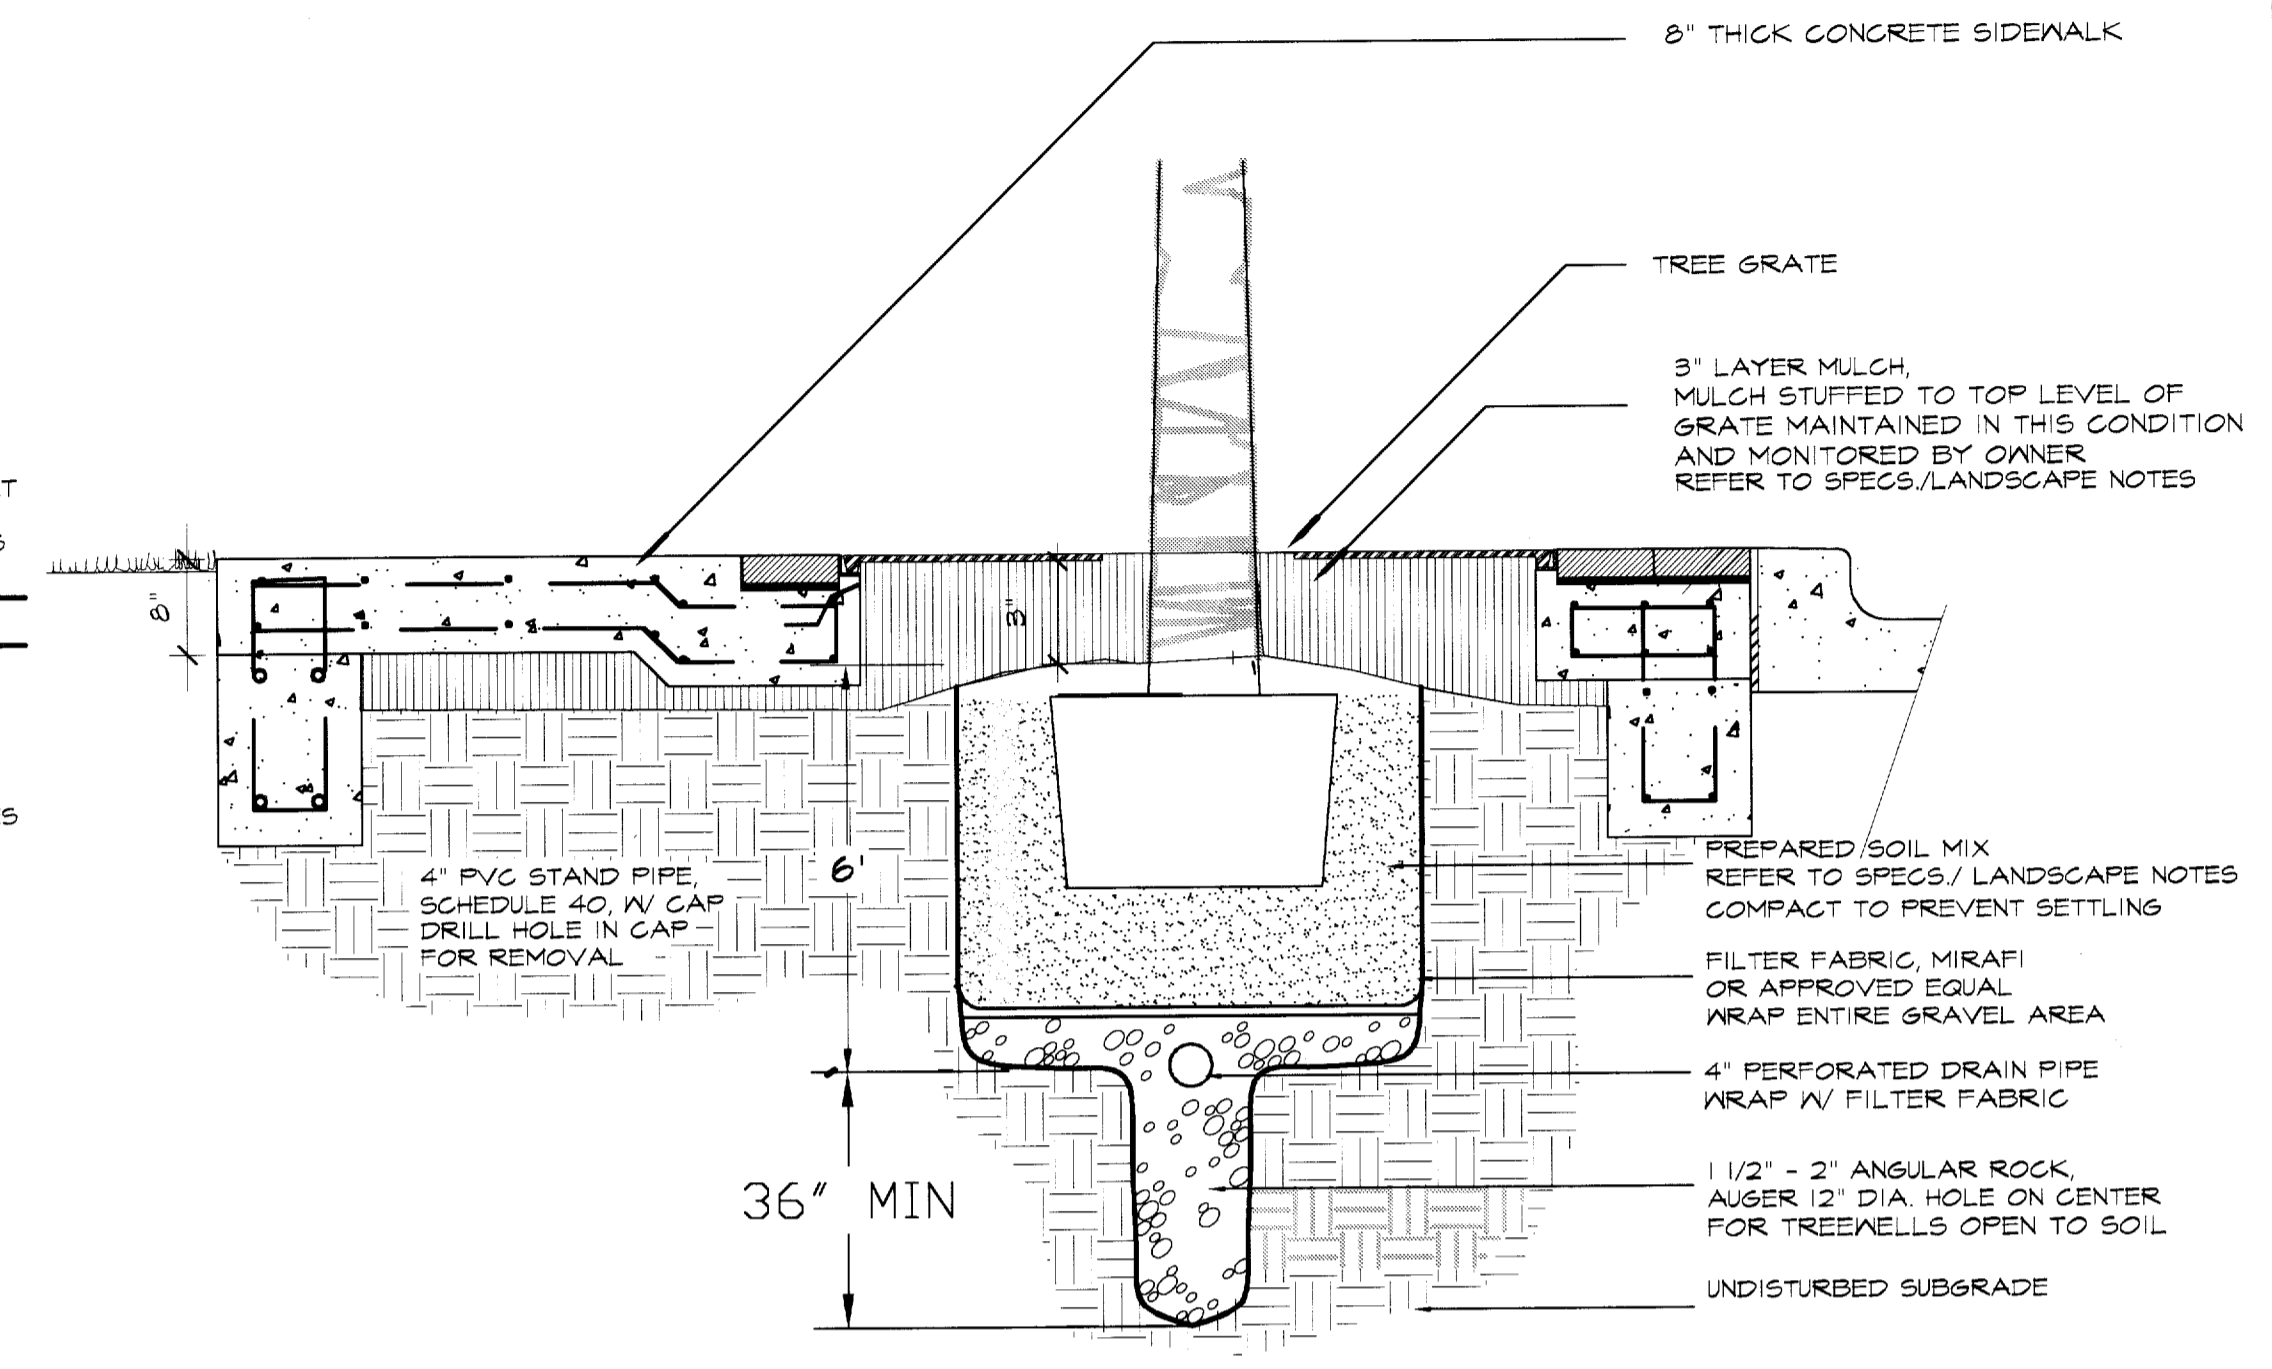

C TREE GRATE PLANTING DETAIL
RED OAKS ALONG ARAPAHO ROAD

LANDSCAPE NOTES

PREPARATION
LANDSCAPE CONTRACTOR AND REPRESENTATIVE OF OWNER SHALL BE RESPONSIBLE FOR VERIFYING THE CORRECT LOCATION OF ALL UNDERGROUND UTILITIES, PIPES, STRUCTURES, AND LINE RUNS IN THE FIELD PRIOR TO THE INSTALLATION OF ANY PLANT MATERIALS.

PLANT LOCATIONS
REFER TO PLANTING PLAN FOR PLANTING LOCATIONS AND PLANT MATERIAL LEGEND FOR SPECIFICATIONS. PLANT MATERIAL LOCATION TO BE STAKED IN THE FIELD AND APPROVED BY LANDSCAPE ARCHITECT PRIOR TO PLANTING.

GRADING AND DRAINAGE
MESA DESIGN GROUP ASSUMES NO RESPONSIBILITY FOR FAILURE OF ANY HARDSCAPE ELEMENT SUCH AS WALKS, ENTRANCES TO STRUCTURES, AND PLANTER BEDS FORMED OR ENCLOSED BY EDGINGS AND PLANTINGS WHICH DO NOT DRAIN DUE TO IMPROPER SET UP OF ELEVATIONS DURING CONSTRUCTION. LANDSCAPE CONTRACTOR IS RESPONSIBLE FOR FINE GRADING, VERIFYING THAT WATER DRAINS.

COORDINATION
LANDSCAPE CONTRACTOR SHALL BE RESPONSIBLE FOR ANY COORDINATION WITH OTHER CONTRACTORS ON SITE AS REQUIRED TO ACCOMPLISH ALL PLANTING OPERATIONS.

MAINTENANCE
LANDSCAPE CONTRACTOR SHALL BE RESPONSIBLE FOR MAINTAINING ALL PLANTING BEDS IN A NEED AND DEBRIS FREE CONDITION AND SHALL ACCOMPLISH WATERING BY HAND AS DEEMED NECESSARY UNTIL SUBSTANTIAL COMPLETION AND ACCEPTANCE BY THE OWNER. THE CONTRACTOR SHALL MAINTAIN ALL WORK FOR A PERIOD OF 90 DAYS AFTER FINAL ACCEPTANCE.

VERIFICATION
CONTRACTOR IS RESPONSIBLE FOR ALL QUANTITIES PER DRAWINGS AND SPECIFICATIONS BY THE LANDSCAPE ARCHITECT. PLANT QUANTITIES HAVE BEEN PROVIDED AS A CONVENIENCE ONLY AND SHALL NOT BE CONSIDERED ABSOLUTE. LANDSCAPE ARCHITECT TO BE NOTIFIED IF DISCREPANCIES OCCUR. OTHERWISE, THE CONTRACTOR IS TO BID THEIR OWN VERIFIED QUANTITIES.

PLANTING BEDS
ALL BED AREAS ARE TO BE LEFT 3" ABOVE FINISHED GRADE OF ADJACENT PAVEMENT TO INCLUDE 3" OF MULCH AFTER COMPACTION AND SETTLEMENT. ALL BED AREAS SHALL BE ROTOTILLED TO A DEPTH OF 6", ADDING PREPARED SOIL MIXTURE AS REQUIRED.

MULCH
AFTER SETTLEMENT AND COMPACTION ALL PLANTING BEDS SHALL RECEIVE A MINIMUM 2" LAYER OF MULCH.
ALL AREAS DISTURBED BY PLANTING OPERATIONS SHALL BE FINE GRADED AND SEEDED.

STANDARDS
ALL PLANT MATERIAL SHALL CONFORM TO THE SIZES GIVEN IN THE PLANT LIST AND SHALL BE NURSERY GROWN IN ACCORDANCE WITH THE "USA STANDARD FOR NURSERY STOCK", LATEST EDITION. ALL PLANTING SHALL BE IN ACCORDANCE WITH STANDARD AMERICAN ASSOCIATION OF NURSERYMEN PROCEDURES AND SPECIFICATIONS. ANY PLANT SUBSTITUTION SHALL BE APPROVED BY LANDSCAPE ARCHITECT.

PRUNING
ALL TREES TO BE PRUNED AT INSTALLATION TO REMOVE DEAD AND UNSIGHTLY LIMBS. ALL TREES ARE TO MATCH IN HEIGHT, SPREAD, AND CLEAR TRUNK AND SHALL HAVE STRAIGHT TRUNKS.

PLANTING SOIL MIXTURE
PLANTING SOIL MIXTURE TO BE AS FOLLOWS: (AVAILABLE LIVING EARTH TECHNOLOGY)
TREES, SHRUBS, AND GROUNDCOVER
45% COMPOST
45% COMPOSTED FINE BARK
10% SANDY LOAM
3 1/2% ORGANIC FERTILIZER
GARDENVILLE 122 MIX, AVAILABLE
MARSHALL DISTRIBUTING (817) 654-0220

FERTILIZER
ADD FERTILIZER TABLETS TO ALL TREES AND SHRUBS, ONE TABLET PER 1/2" CALIPER FOR TREES AND ONE TABLET PER 12" OF HEIGHT OR SPREAD FOR EACH SHRUB AT INSTALLATION.

WARRANTY
ALL PLANT MATERIAL TO BE GUARANTEED FOR A PERIOD OF ONE YEAR FROM SUBSTANTIAL COMPLETION AND ACCEPTANCE BY THE OWNER.

IRRIGATION
CONTRACTOR TO INSTALL NEW IRRIGATION SYSTEM TO PROVIDE 100% COVERAGE FOR AFFECTED TURF, TREES AND BED AREAS. INSTALL PER PLAN AND CITY OF ADDISON IRRIGATION SPECIFICATIONS. THE CONTRACTOR SHALL VISIT SITE TO DETERMINE REQUIREMENTS PRIOR TO BID.

SANDY LOAM
SANDY LOAM SHALL BE NATURAL, FERTILE, FRIABLE SOIL POSSESSING CHARACTERISTICS OF REPRESENTATIVE PRODUCTIVE SOILS IN THE VICINITY. IT SHALL NOT BE EXCESSIVELY ACID OR ALKALINE OR CONTAIN TOXIC SUBSTANCES WHICH MAY BE HARMFUL TO PLANT GROWTH. TOPSOIL SHALL BE WITHOUT ADMIXTURE OF SUBSOIL AND SHALL CONTAIN A MINIMUM OF LUMPS, STONE, STUMPS, ROOTS OF SIMILAR SUBSTANCES ONE INCH OR MORE IN DIAMETER. LOAM SHALL BE FREE FROM WEEDS AND OTHER NOXIOUS MATERIALS. LOAM SHALL NOT BE STRIPPED, COLLECTED OR DEPOSITED WHILE WET.

STAKES, GUYS
ALL TREES ARE TO BE STAKED AND GUYED THROUGH THE ONE YEAR WARRANTY AT WHICH TIME THE OWNER SHALL DETERMINE IF REMOVAL IS NECESSARY (REFER TO PLANTING DETAILS).

PLANT LIST


PLANT	PLANT QUANTITY	COMMON NAME BOTANICAL NAME	SIZE	HEIGHT	SPREAD	COMMENTS
LARGE TREES- INSTALL PER DETAIL PL-1, A & B						
127		RED OAK QUERCUS SHUMARDII	4" CAL 100 GAL	14'-16'	8'-10'	SINGLE STRAIGHT TRUNK. FULL ROUND CANOPY, WELL BRANCHED, MATCHING & CONTAINER GROWN. MESA/CITY OF ADDISON TO APPROVE SOURCE & TAG. APPROVED SOURCES: MARION GARDENS, AMMD TREE FARMS, SKINNERS OR APPROVED EQUAL.
128		FOSTER'S HOLLY ILEX ATTENUATA FOSTERI	100 GAL	12'	4'-5'	SINGLE TRUNK STRONG CENTRAL LEADER. FULL, WELL BRANCHED TO GROUND. MATCHING & CONTAINER GROWN. MESA/CITY OF ADDISON TO APPROVE SOURCE & TAG. APPROVED SOURCES: CHERRY LAKE TREE FARM, OR APPROVED EQUAL.
GROUNDCOVER- INSTALL PER L-2, C						
2800		ASIAN JASMINE TRACHELOSPERMUM ASIATICUM	4" POTS 9" O.C.			12" RUNNERS MIN. HEALTHY, VIGOROUS, WELL ROOTED.
		BERMUDA SOG CYNODON DACTYLON 'TEX TURF 10'				REFER TO SPECIFICATIONS & PLANS PER LOCATION. MESA/CITY OF ADDISON TO APPROVE SOURCE & SAMPLES. SOURCE: A1 GRASS COMPANY OR APPROVED EQUAL.

SOURCES:

MARION GARDENS 619 N. STATE ROAD 50 GROVELAND, FL 34736 (952) 429-4151	CHERRY LAKE TREE FARMS 1836 CHERRY LAKE ROAD GROVELAND, FL 34736 (800) 429-2171	A1 GRASS COMPANY 1320 EAST 14TH STREET PLANO, TX (972) 423-8814
AMMD TREE FARM HWY. 19, SOUTH CANTON, TX 75103 (800) 465-5622	INDIAN GREEK TREE FARM 2222 PARKER ROAD CARROLLTON, TX 75010 (972) 344-4846	
SKINNERS RT. 1, BOX 225 BUNNELL, FL 32110 (800) 741-2020	PRINCETON NURSERY P.O. BOX 85 ALLENTOWN, NJ 08501 (609) 259-7671	

Revisions

No.	Date	Item
1	08/10/18	CITY REVISIONS AS LISTED IN APPENDUM NO.5

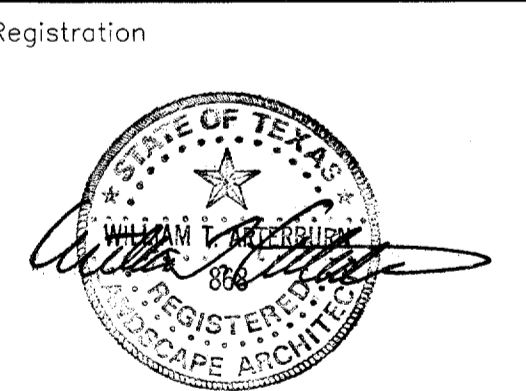


RFM
Drawn
WGM
Checked
97018
Project No.
12/12/97
Date
Sheet Title

PLANTING DETAILS

Sheet No.

IMPORTANT!!!

1. MESA Design Group assumes no responsibility for any excavation or grading not shown on surveys or civil engineer's plans supplied to MESA Design Group.
2. All proposed and finished grades provided by MESA Design Group are based on information provided by owner's surveyor and/or civil engineer. Any discrepancies in actual field measurements are to be reported to landscape architect immediately.
3. Contractor shall be responsible for making himself familiar with all underground utilities, pipes, structures, and line runs.
4. Prior to commencement of hardscape construction, all piers, footings, and walls are to be surveyed, laid out, and staked in field for approval by landscape architect. Contractor shall assume responsibility for any demolition, adjustments, or reconstruction resulting from unauthorized construction activities.
5. Contractor is responsible for all final quantities per drawings and specifications. Any quantities provided by MESA Design Group are provided as a convenience only and shall not be considered absolute. Landscape architect should be notified if any discrepancies occur.

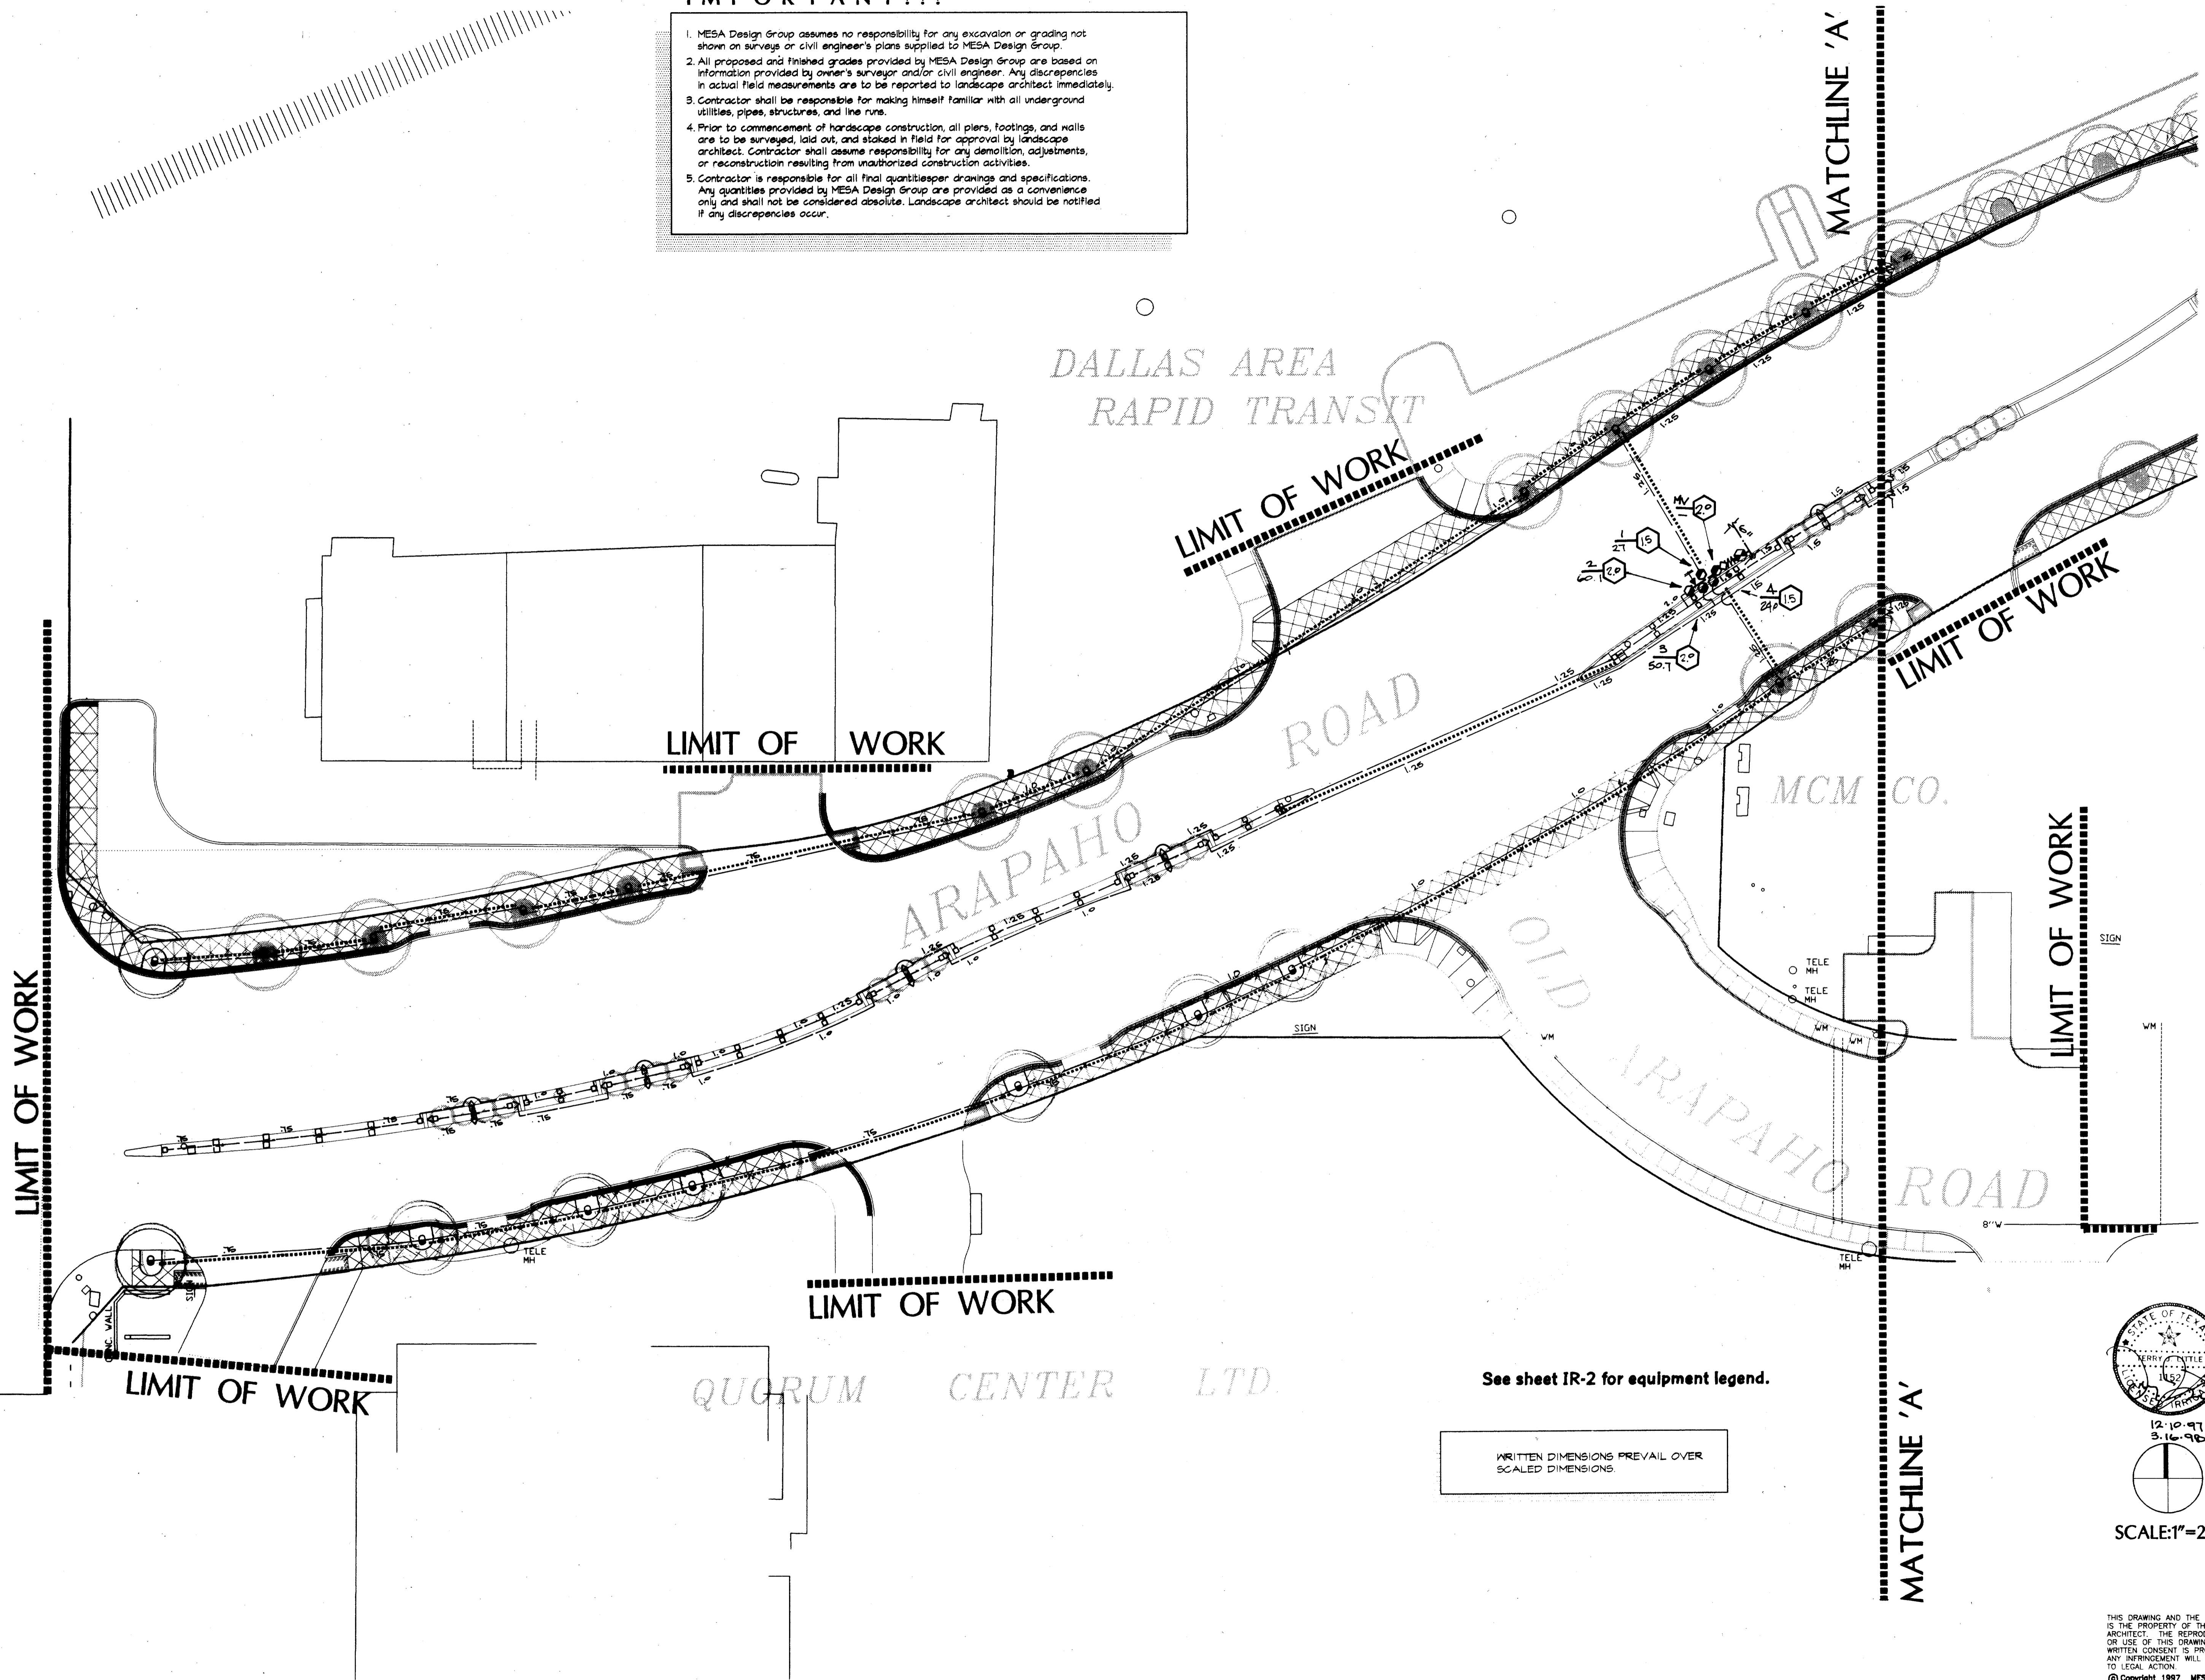

3100 McKinnon Street
Suite 905
Dallas, Texas 75201
(214) 871-0568 Fax: 871-1507

**ARAPAHO ROAD
STREETSCAPE**
CITY-OF-ADDISON, TEXAS

Revisions

No.	Date	Item
3	16-98	TREE WELL & MED.


Registration

KDH/RFM TL
Drawn


Checked
97018 11/13/97
Project No. Date

Sheet Title

**IRRIGATION
PLAN**

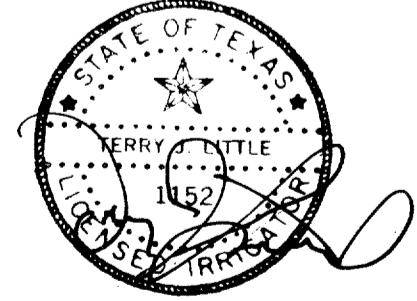

12-10-97
3-16-98 REV.

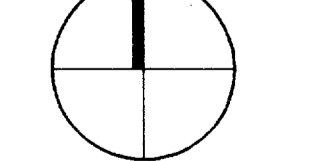

SCALE: 1" = 20'

THIS DRAWING AND THE DESIGN SHOWN IS THE PROPERTY OF THE LANDSCAPE ARCHITECT. THE REPRODUCTION, COPYING, OR USE OF THIS DRAWING WITHOUT WRITTEN CONSENT IS PROHIBITED AND ANY INFREINGEMENT WILL BE SUBJECT TO LEGAL ACTION.
© Copyright 1997 MESA Design Group


IMPORTANT!!!

1. MESA Design Group assumes no responsibility for any excavation or grading not shown on surveys or civil engineer's plans supplied to MESA Design Group.
2. All proposed and finished grades provided by MESA Design Group are based on information provided by owner's surveyor and/or civil engineer. Any discrepancies in actual field measurements are to be reported to landscape architect immediately.
3. Contractor shall be responsible for making himself familiar with all underground utilities, pipes, structures, and line runs.
4. Prior to commencement of hardscape construction, all piers, footings, and walls are to be surveyed, laid out, and staked in field for approval by landscape architect. Contractor shall assume responsibility for any demolition, adjustments, or reconstruction resulting from unauthorized construction activities.
5. Contractor is responsible for all final quantities per drawings and specifications. Any quantities provided by MESA Design Group are provided as a convenience only and shall not be considered absolute. Landscape architect should be notified if any discrepancies occur.

DALLAS AREA
RAPID TRANSIT

3100 McKinnon Street
Suite 905
Dallas, Texas 75201
(214) 871-0568 Fax: 871-1507

ARAPAHO ROAD
STREETSCAPE
CITY-OF-ADDISON, TEXAS

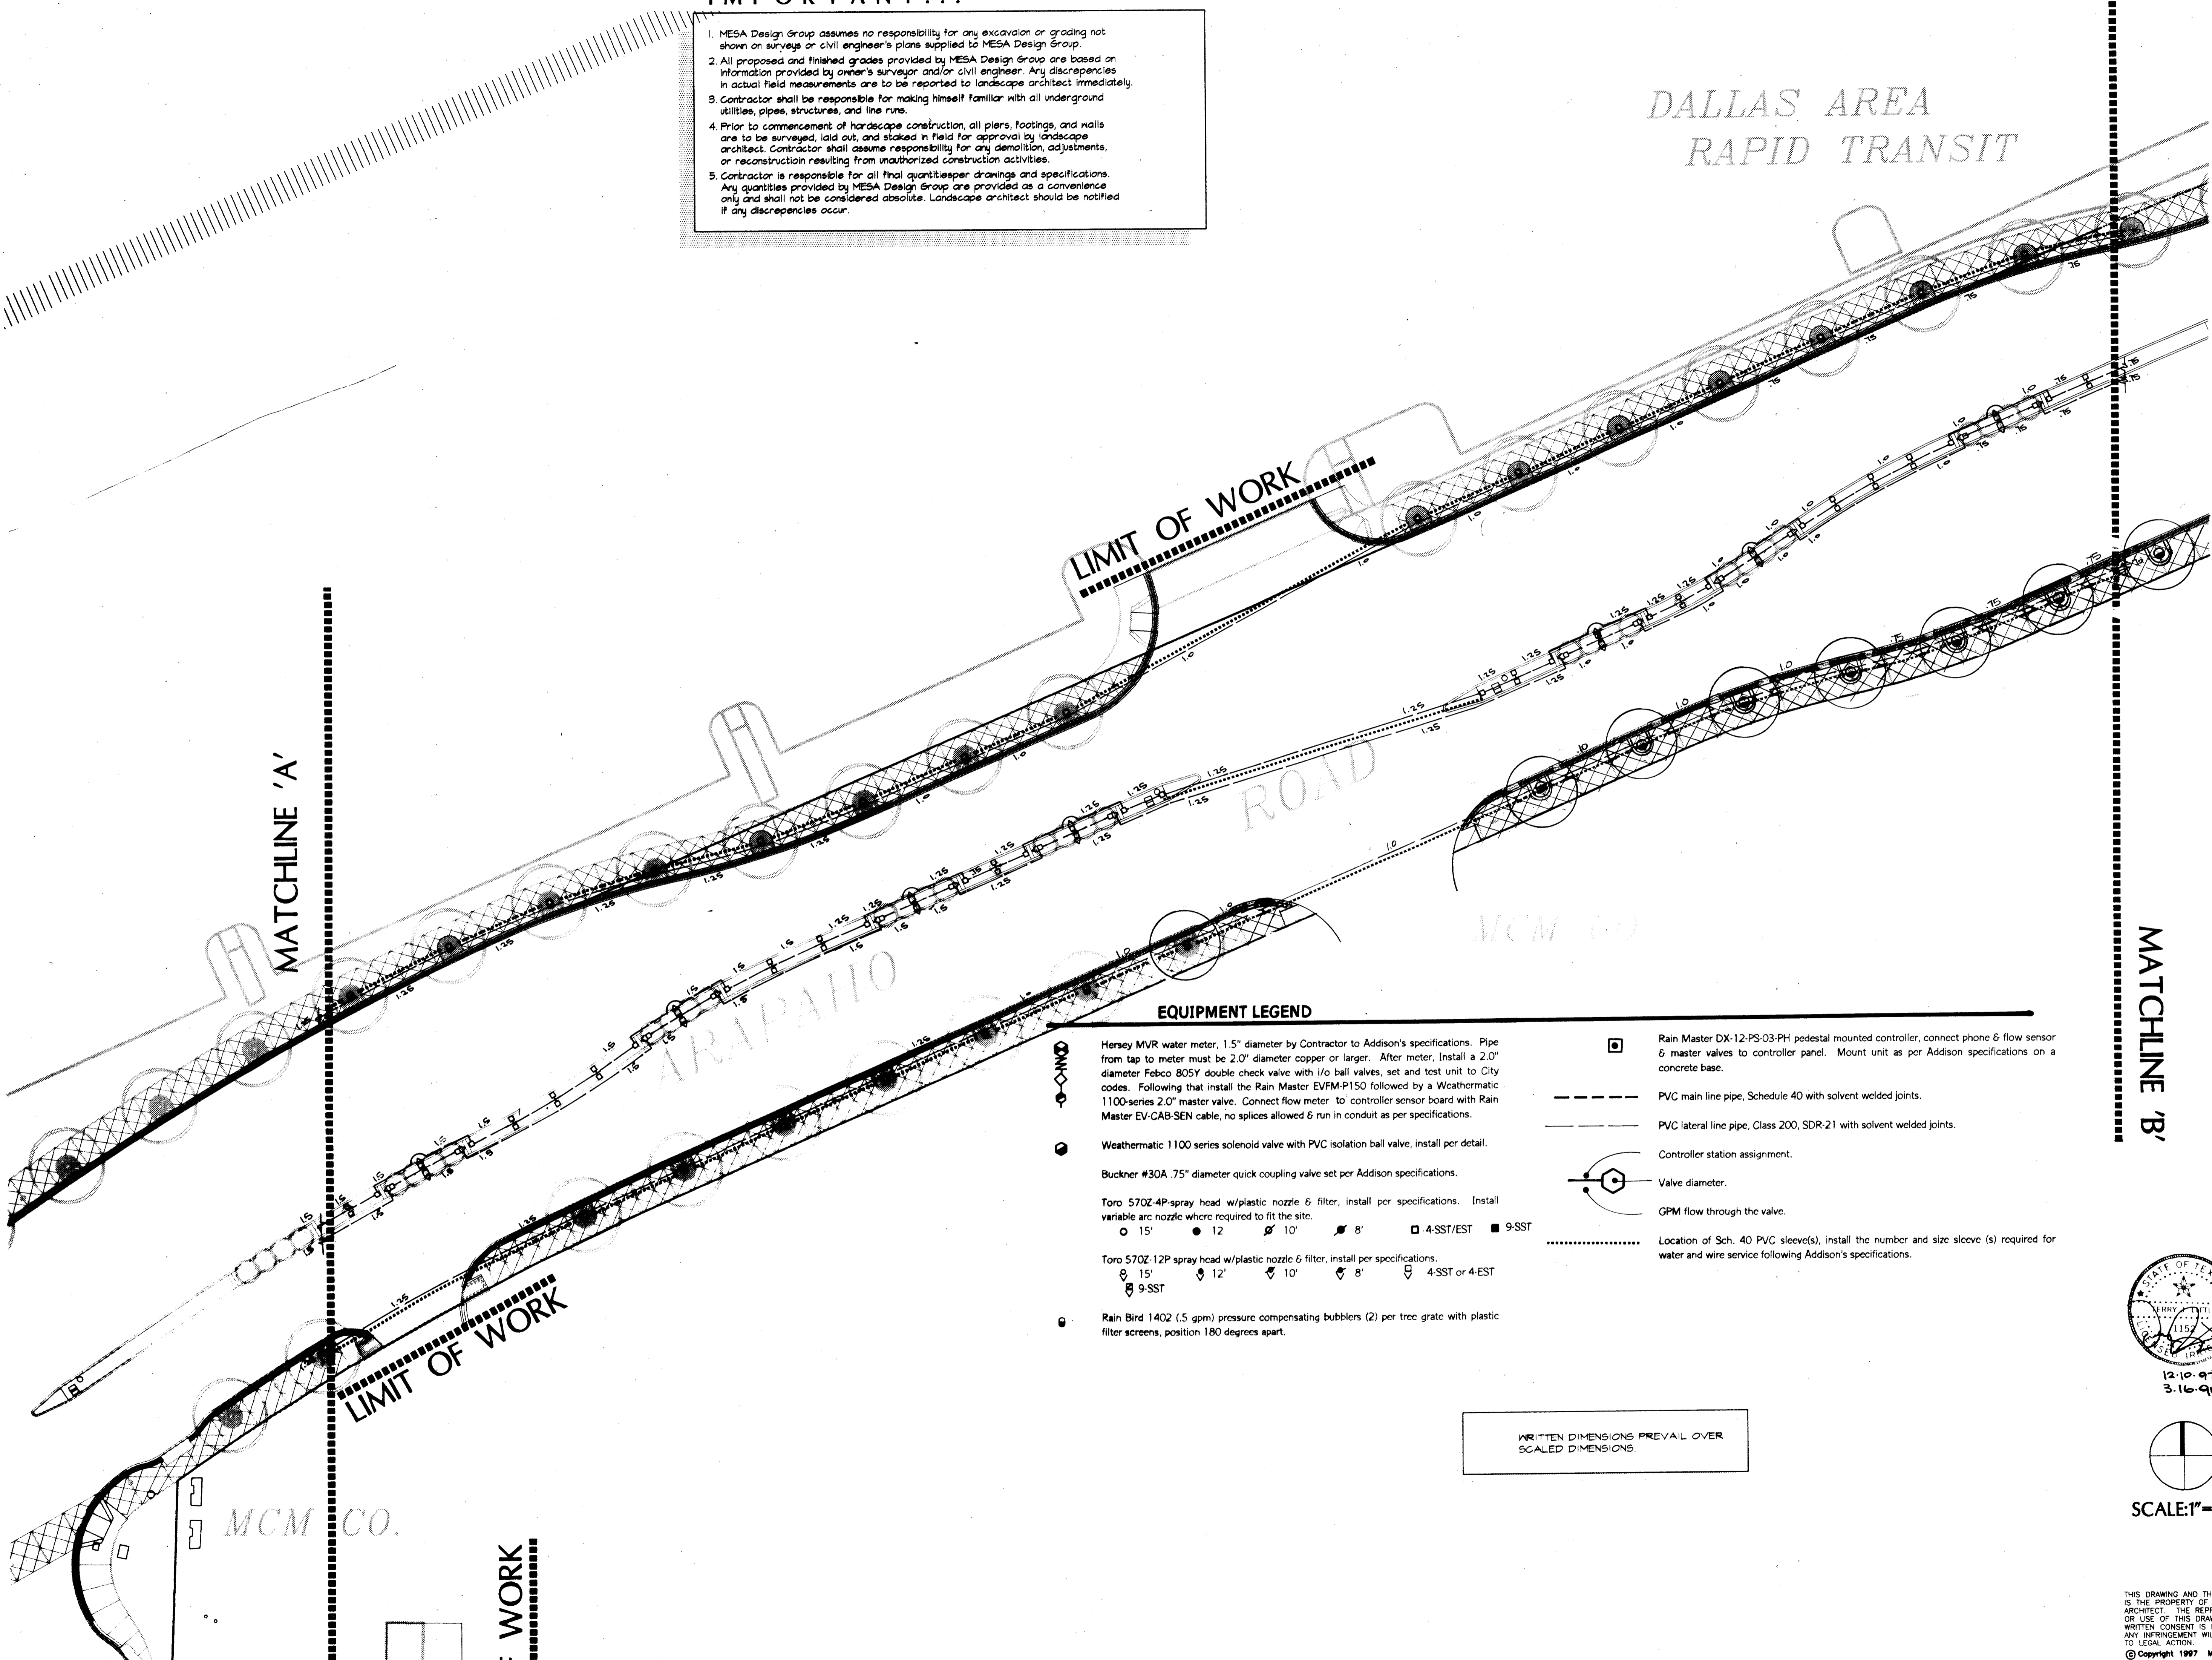

LIMIT OF WORK

MATCHLINE 'A'


MATCHLINE 'B'

EQUIPMENT LEGEND

- Hersey MVR water meter, 1.5" diameter by Contractor to Addison's specifications. Pipe from tap to meter must be 2.0" diameter copper or larger. After meter, install a 2.0" diameter Febco 805Y double check valve with i/o ball valves, set and test unit to City codes. Following that install the Rain Master EVFM-P150 followed by a Weathermatic 1100-series 2.0" master valve. Connect flow meter to controller sensor board with Rain Master EV-CAB-SEN cable, no splices allowed & run in conduit as per specifications.
- Weathermatic 1100 series solenoid valve with PVC isolation ball valve, install per detail.
- Buckner #30A .75" diameter quick coupling valve set per Addison specifications.
- Toro 570Z-4P spray head w/plastic nozzle & filter, install per specifications. Install variable arc nozzle where required to fit the site.
 - 15'
 - 12'
 - ⊗ 10'
 - ⊗ 8'
 - 4-SST/EST
 - 9-SST
- Toro 570Z-12P spray head w/plastic nozzle & filter, install per specifications.
 - ⊗ 15'
 - ⊗ 12'
 - ⊗ 10'
 - ⊗ 8'
 - ⊗ 4-SST or 4-EST
 - ⊗ 9-SST
- Rain Bird 1402 (.5 gpm) pressure compensating bubblers (2) per tree grate with plastic filter screens, position 180 degrees apart.
- Rain Master DX-12-PS-03-PH pedestal mounted controller, connect phone & flow sensor & master valves to controller panel. Mount unit as per Addison specifications on a concrete base.
- PVC main line pipe, Schedule 40 with solvent welded joints.
- PVC lateral line pipe, Class 200, SDR-21 with solvent welded joints.
- Controller station assignment.
- Valve diameter.
- GPM flow through the valve.
- Location of Sch. 40 PVC sleeve(s), install the number and size sleeve (s) required for water and wire service following Addison's specifications.

WRITTEN DIMENSIONS PREVAIL OVER
SCALED DIMENSIONS.

12-10-97
3-16-98 REV.

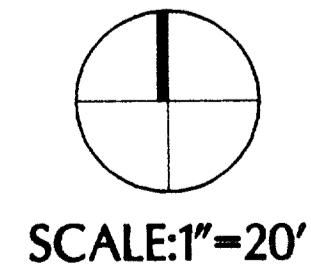

Revisions

No.	Date	Item
3-16-98		TREE WELLS & MED.

Registration

KDH/RFM TL
Drawn

Checked
97018
Project No.

11/13/97
Date

Sheet Title

IRRIGATION
PLAN

THIS DRAWING AND THE DESIGN SHOWN IS THE PROPERTY OF THE LANDSCAPE ARCHITECT. THE REPRODUCTION, COPYING, OR USE OF THIS DRAWING WITHOUT WRITTEN CONSENT IS PROHIBITED AND ANY INFRINGEMENT WILL BE SUBJECT TO LEGAL ACTION.

**ARAPAHO ROAD
STREETSCAPE**
CITY-OF-ADDISON, TEXAS

MATCHLINE 'C'

MATCHLINE 'C'

TOWN OF
ADDISON

ARAPAHO
ROAD

CARRAMERICA LIMITED
PARTNERSHIP

EVOLUTION DX-12-PS-03-PH
CONTROLLER, PROVIDE 120 V.
POWER AND PHONE CONNECTION.

LIMIT OF WORK

NOTE: RUN WIRES 1410' TO EXISTING IRRIGPOL (E)
CONTROLLER, S.E. QUADRANT OF OLD
ARAPAHO AND QUORUM DRIVE.

QUORUM
DRIVE


EXISTING METER, D.C. AND MAIN.

LIMIT OF WORK


See sheet IR-2 for equipment legend.

MATCHLINE 'B'

MATCHLINE 'B'

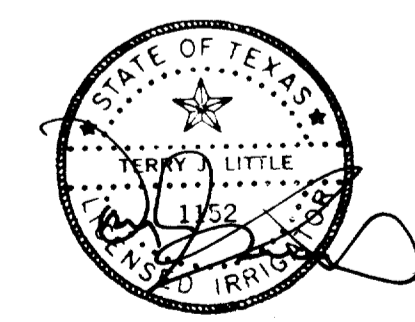

12-10-97
3-16-98 REV.

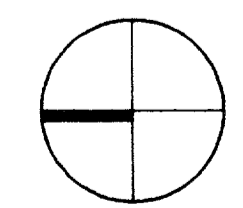

SCALE: 1"=20'

WRITTEN DIMENSIONS PREVAIL OVER
SCALED DIMENSIONS.

Revisions

No.	Date	Item
3-16-98		Tree Wells + MGD.

Registration

KDH TL
Drawn

Checked
97018 11/13/97
Project No. Date

Sheet Title

**IRRIGATION
PLAN**

Sheet No.

IR-3

THIS DRAWING AND THE DESIGN SHOWN
IS THE PROPERTY OF THE LANDSCAPE
ARCHITECT. THE REPRODUCTION, COPYING,
OR USE OF THIS DRAWING WITHOUT
WRITTEN CONSENT IS PROHIBITED AND
ANY INFRINGEMENT WILL BE SUBJECT
TO LEGAL ACTION.
© Copyright 1997 MESA Design Group

ARAPAHO ROAD STREETSCAPE CITY-OF-ADDISON, TEXAS

Revisions

No.	Date	Item
3-16-98		Tree Wells + HD.

Registration

Drawn KDH TL
Checked 97018 11/13/97
Project No. Date

Sheet Title

IRRIGATION PLAN

Sheet No.



IR-4

SYSTEM NOTES

1. Field verify all dimensions prior to installing the system. If discrepancies exist notify the designer before proceeding. Copies of the planting, utilities and road construction plans shall be with the installer in the field at all times.
2. Verify a 65 psi static water pressure at each point of connection before installation is started. If lower, notify the irrigation designer for instructions as to how to proceed. Failure to do so will result in the Contractor liable for all expenses in making the system operational.
3. This layout is diagrammatic in some areas for graphic clarity. All piping, valves, etc. shall be installed with a minimum clearance of three (2) feet from the edge of the curb. Multiple valve boxes in the same area shall be installed in a straight line and evenly spaced apart. Units must be flush to finish grade and soil compacted around the box. Install nonwooden supports (bricks) under all valve boxes for stability.
4. All piping shall be flushed of all debris prior to installing heads and nozzles. Filter screens must be under each spray nozzle and caps on spray head units must be sealed.
5. Set heads perpendicular to the finish grade. Compact soil firmly around each head for stability.
6. No wire splices will be allowed between the controller and the solenoid valves. The valve "common" wire shall be spliced only at the solenoid valve and within the valve box. Flow meter wiring must be run in .75" diameter or larger gray PVC conduit as per specifications. There are two flow sensors and master valves required on this project.
7. Coordinate the installation of the system with the Landscape contractor to ensure all plant material will be irrigated in accordance with the intent of the plans and specifications. Landscape contractor must stake the outline of all planting beds before the irrigation contractor is to install any piping.


See sheet IR-2 for equipment legend.

WRITTEN DIMENSIONS PREVAIL OVER
SCALED DIMENSIONS

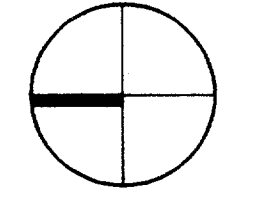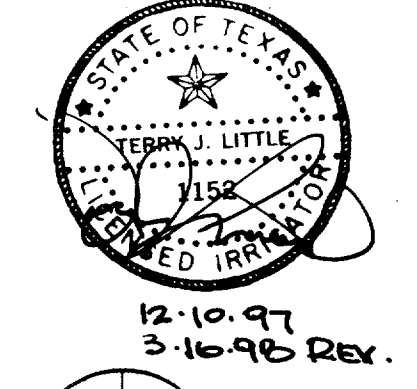

SCALE: 1" = 20'

THIS DRAWING AND THE DESIGN SHOWN IS THE PROPERTY OF THE LANDSCAPE ARCHITECT. THE REPRODUCTION, COPYING, OR USE OF THIS DRAWING WITHOUT WRITTEN CONSENT IS PROHIBITED AND ANY INFRINGEMENT WILL BE SUBJECT TO LEGAL ACTION.
© Copyright 1997 MESA Design Group

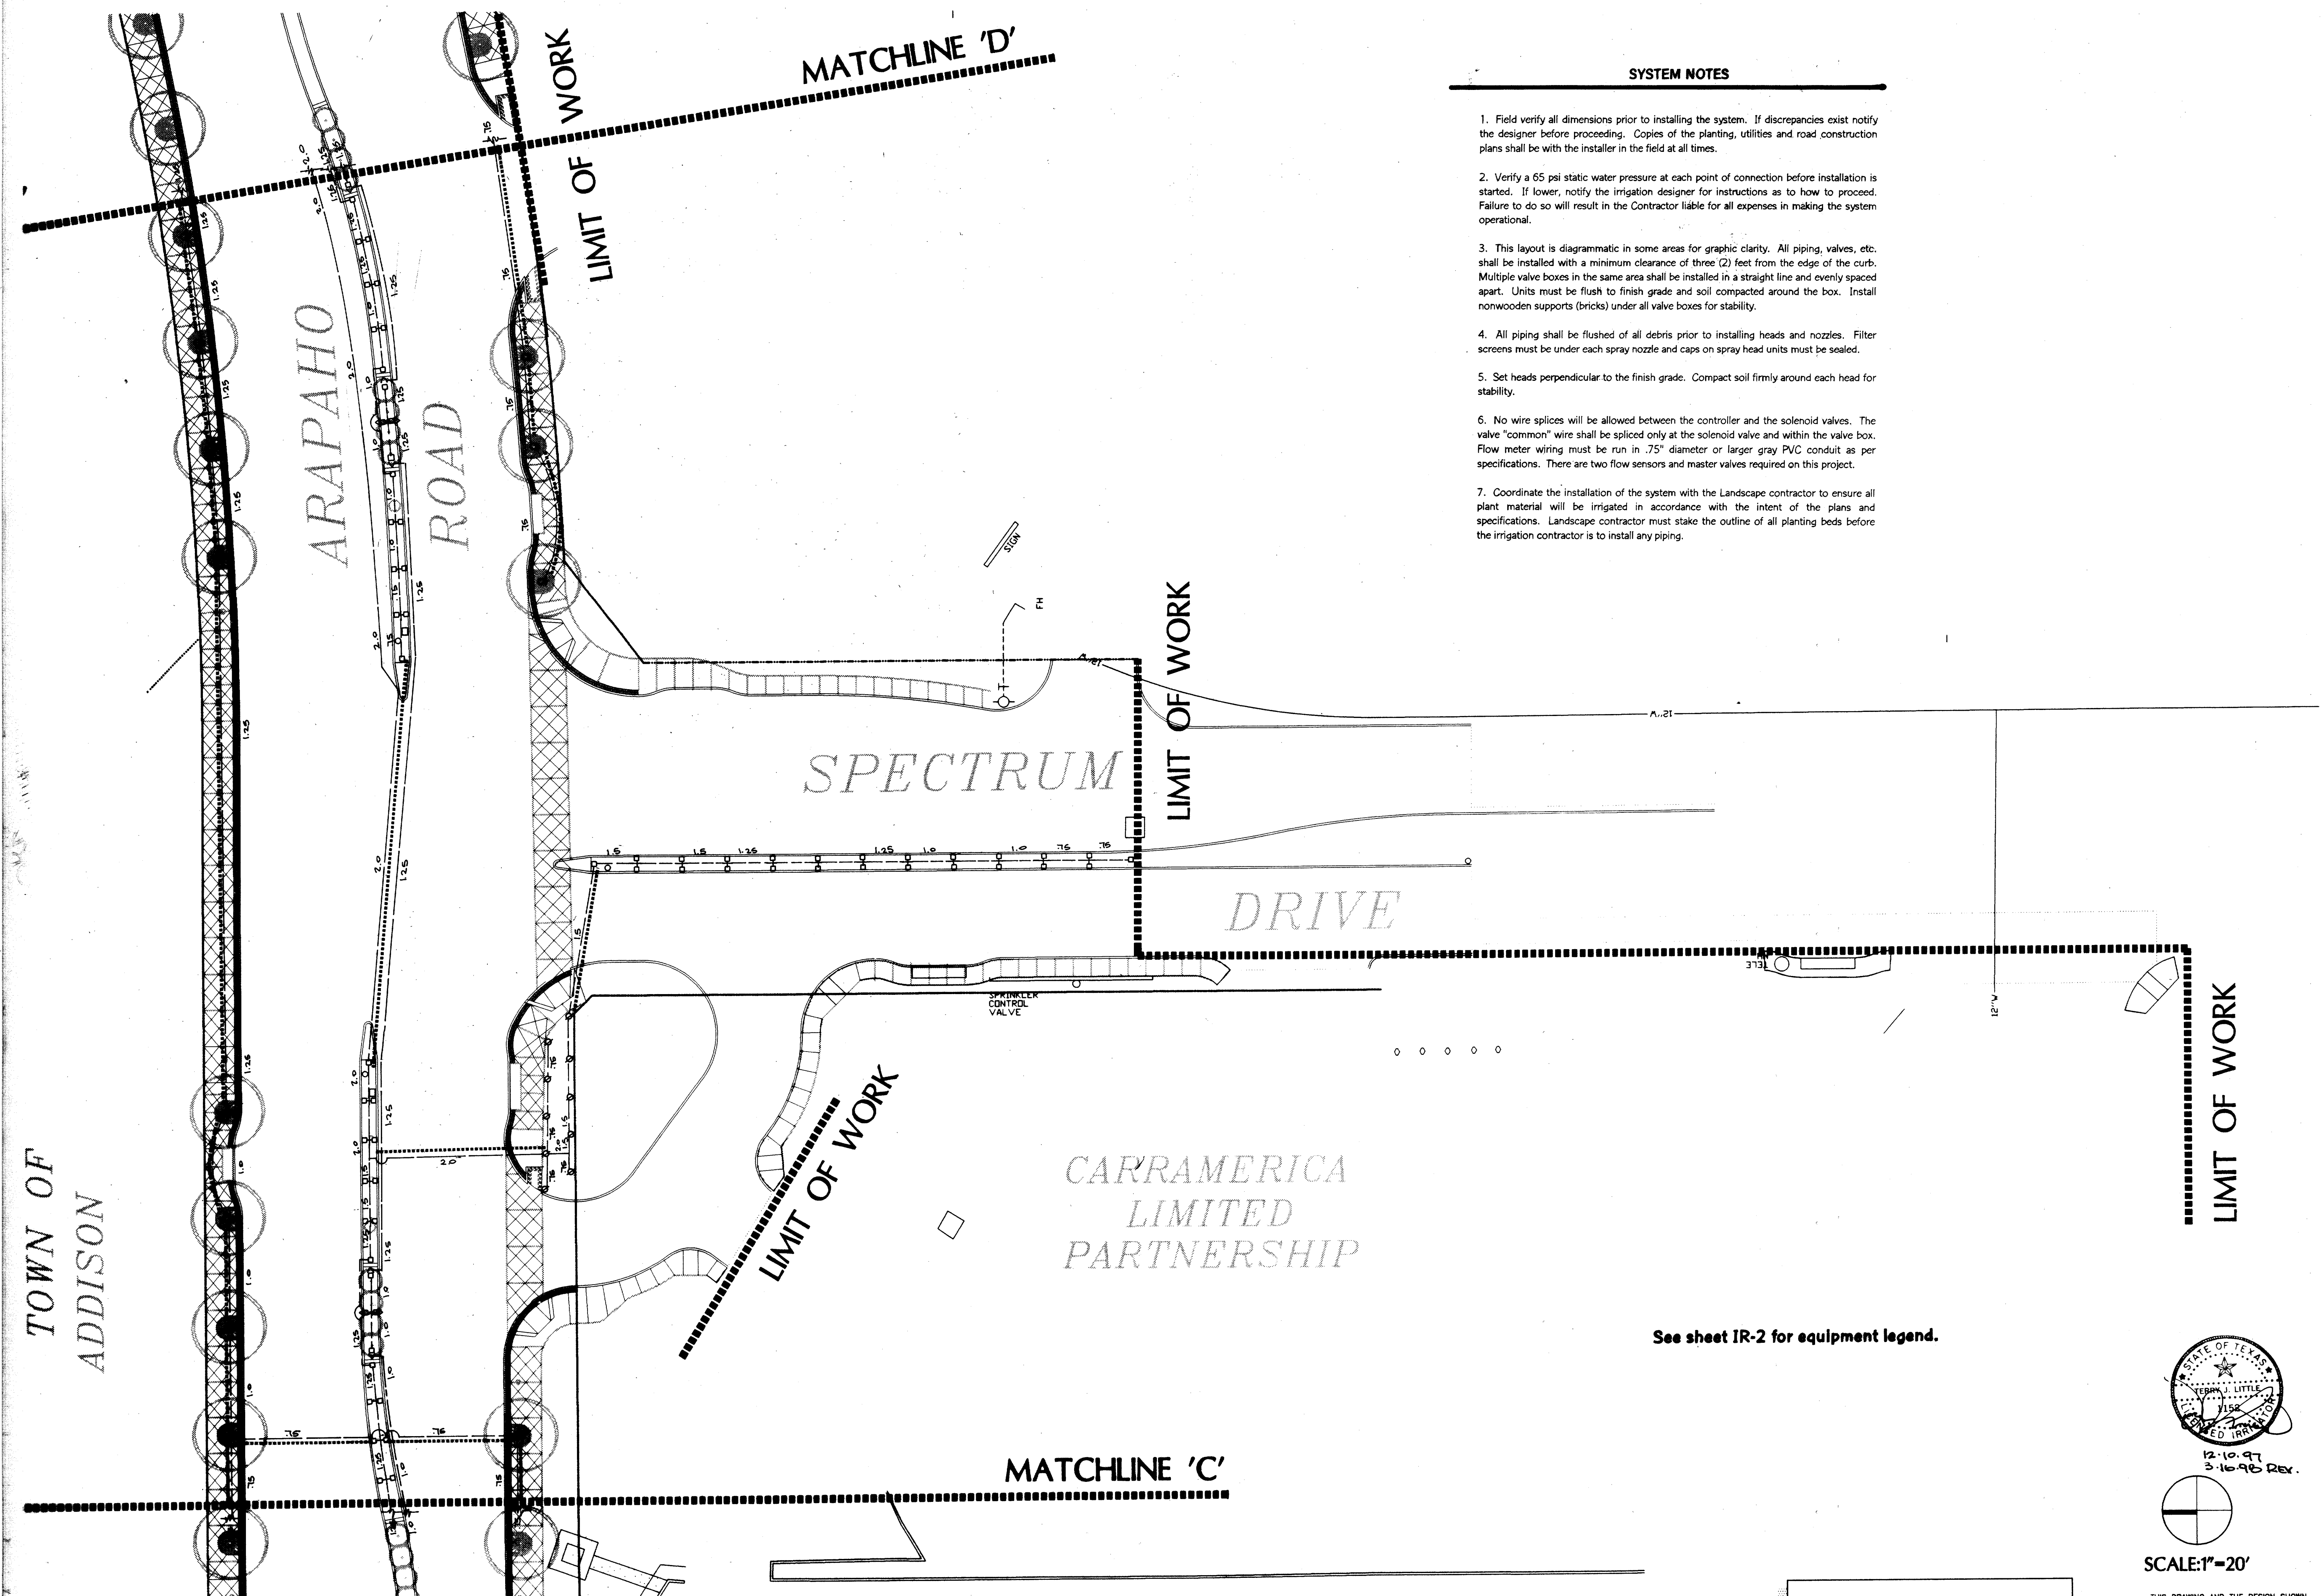

IMPORTANT!!!

1. MESA Design Group assumes no responsibility for any excavation or grading not shown on surveys or civil engineer's plans supplied to MESA Design Group.
2. All proposed and finished grades provided by MESA Design Group are based on information provided by owner's surveyor and/or civil engineer. Any discrepancies in actual field measurements are to be reported to landscape architect immediately.
3. Contractor shall be responsible for making himself familiar with all underground utilities, pipes, structures, and line runs.
4. Prior to commencement of hardscape construction, all piers, footings, and walls are to be surveyed, laid out, and staked in field for approval by landscape architect. Contractor shall assume responsibility for any demolition, adjustments, or reconstruction resulting from unauthorized construction activities.
5. Contractor is responsible for all final quantities per drawings and specifications. Any quantities provided by MESA Design Group are provided as a convenience only and shall not be considered absolute. Landscape architect should be notified if any discrepancies occur.

3100 McKinnon Street
Suite 905
Dallas, Texas 75201
(214) 871-0568 Fax: 871-1507

**ARAPAHO ROAD
STREETSCAPE**
CITY-OF-ADDISON, TEXAS

Revisions

No.	Date	Item
1	3-16-98	TREE WELLS + MED.


Registration

Drawn KDH/RFM TL
Checked 97018 Date 11/13/97
Project No. _____
Sheet Title _____

IRRIGATION PLAN


Sheet No.

IR-5

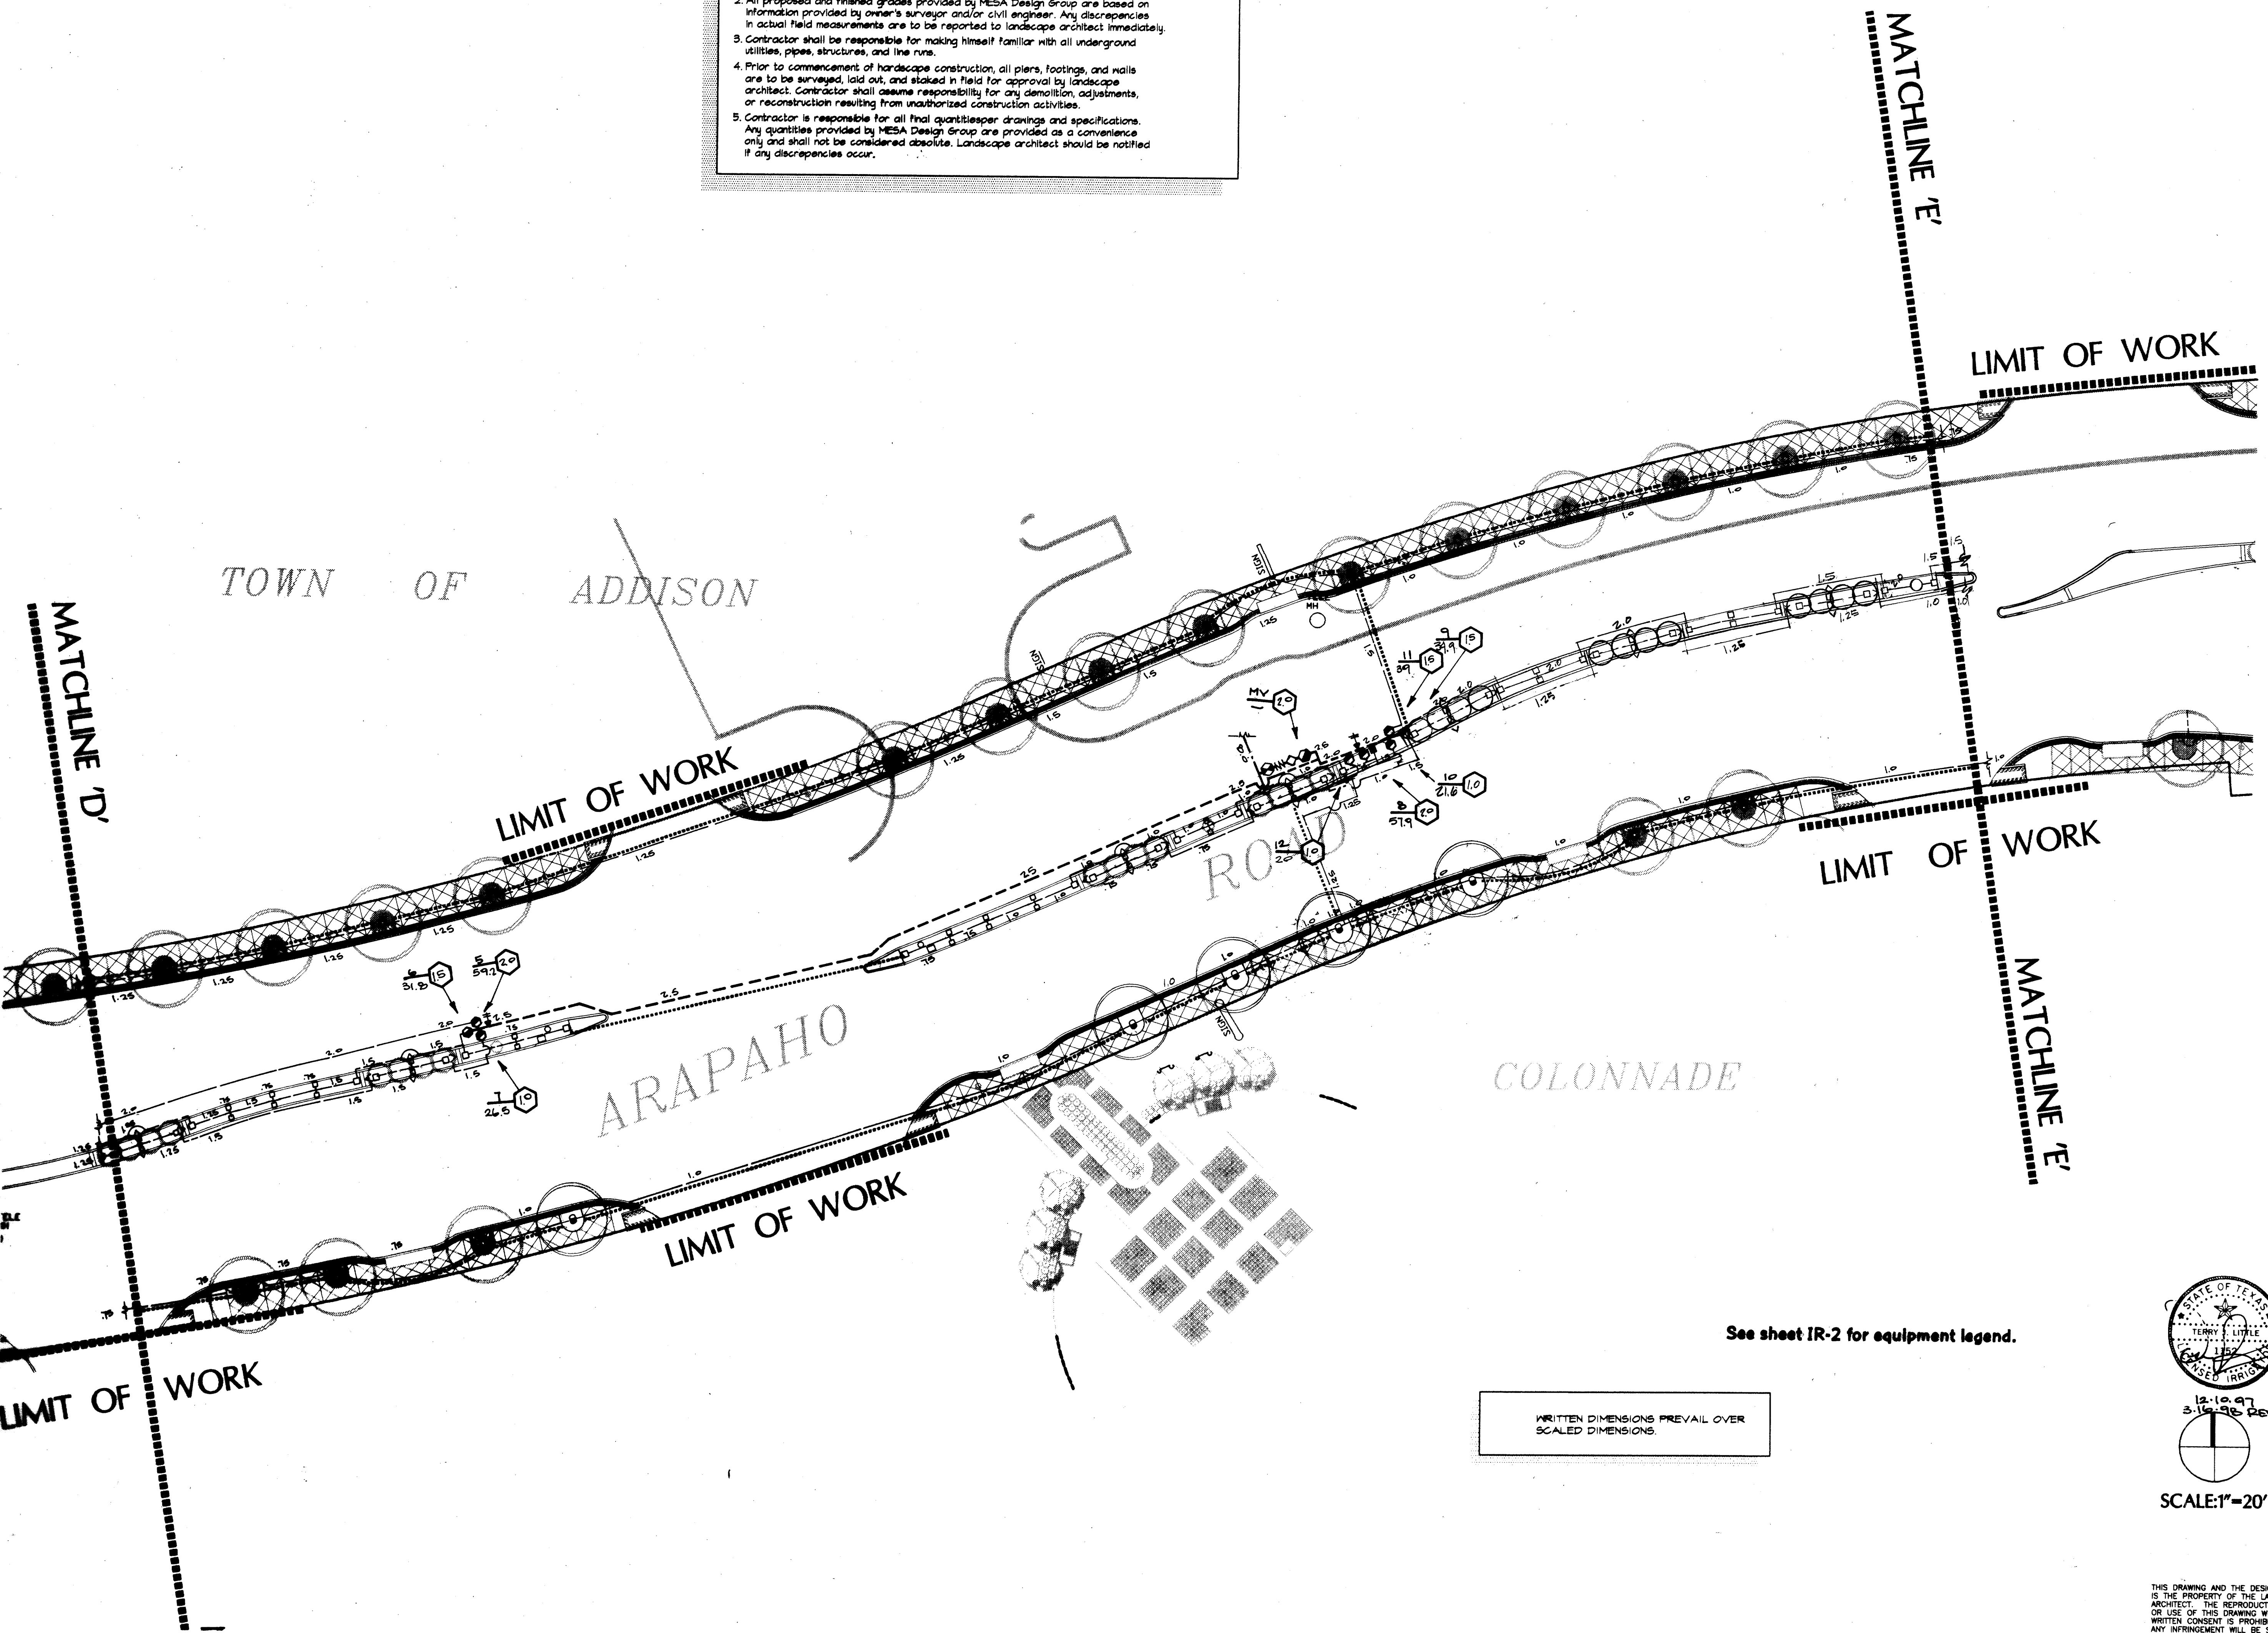

See sheet IR-2 for equipment legend.

WRITTEN DIMENSIONS PREVAIL OVER
SCALED DIMENSIONS.

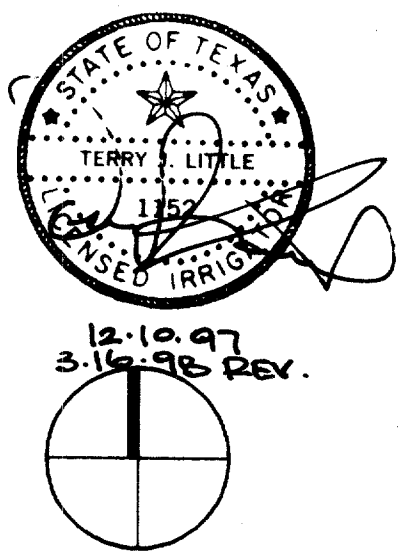


SCALE: 1" = 20'

THIS DRAWING AND THE DESIGN SHOWN IS THE PROPERTY OF THE LANDSCAPE ARCHITECT. THE REPRODUCTION, COPYING, OR USE OF THIS DRAWING WITHOUT WRITTEN CONSENT IS PROHIBITED AND ANY INFRINGEMENT WILL BE SUBJECT TO LEGAL ACTION.
© Copyright 1997 MESA Design Group

IMPORTANT!!!

- MESA Design Group assumes no responsibility for any excavation or grading not shown on surveys or civil engineer's plans supplied to MESA Design Group.
- All proposed and finished grades provided by MESA Design Group are based on information provided by owner's surveyor and/or civil engineer. Any discrepancies in actual field measurements are to be reported to landscape architect immediately.
- Contractor shall be responsible for making himself familiar with all underground utilities, pipes, structures, and line runs.
- Prior to commencement of hardscape construction, all piers, footings, and walls are to be surveyed, laid out, and staked in field for approval by landscape architect. Contractor shall assume responsibility for any demolition, adjustments, or reconstruction resulting from unauthorized construction activities.
- Contractor is responsible for all final quantities per drawings and specifications. Any quantities provided by MESA Design Group are provided as a convenience only and shall not be considered absolute. Landscape architect should be notified if any discrepancies occur.

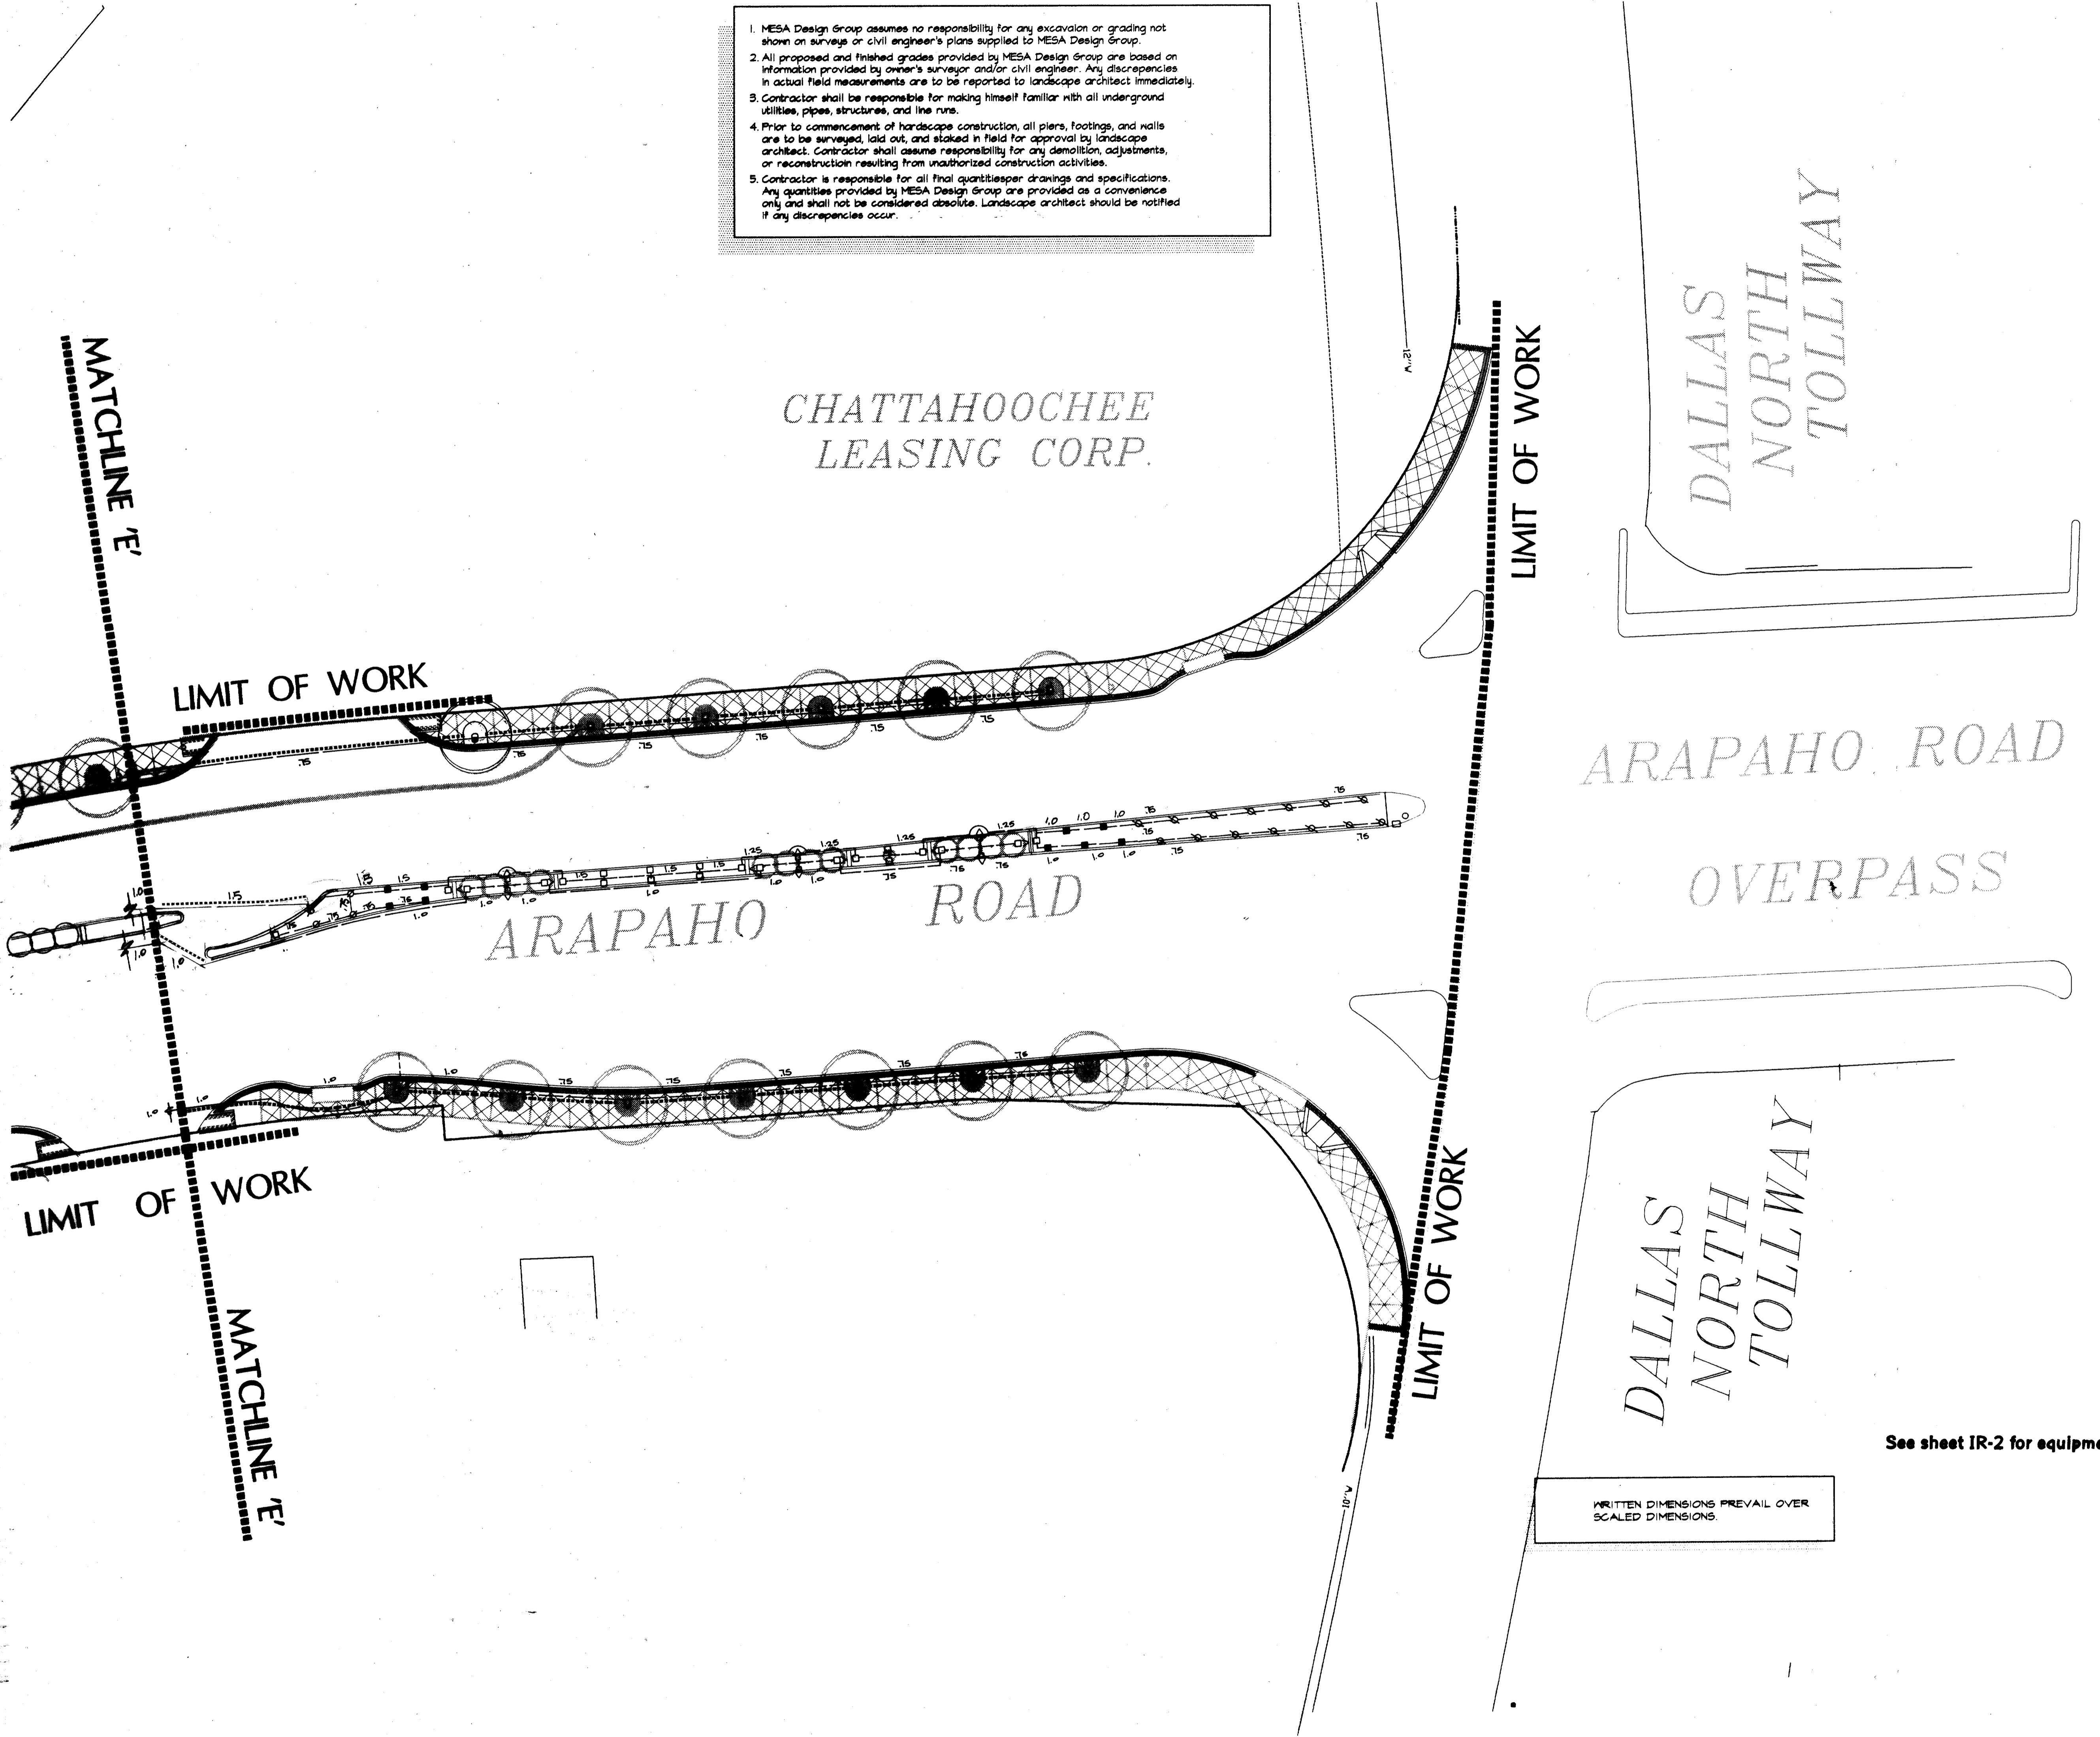

3100 McKinnon Street
Suite 905
Dallas, Texas 75201
(214) 871-0568 Fax: 871-1507

ARAPAHO ROAD
STREETSCAPE
CITY-OF-ADDISON, TEXAS

Revisions


No.	Date	Item
1	3-16-98	TREE WELLS + MOD.

Registration


KDH/RFM TL
Drawn

Checked
97018 11/13/97
Project No. Date

Sheet Title

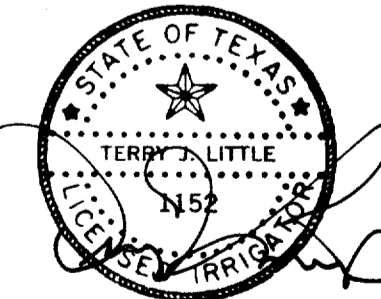


12.10.97
3-16-98 Rev.

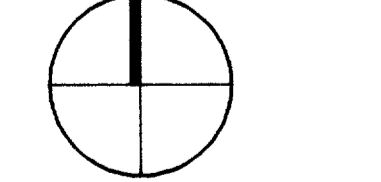


SCALE: 1" = 20'

See sheet IR-2 for equipment legend.


THIS DRAWING AND THE DESIGN SHOWN IS THE PROPERTY OF THE LANDSCAPE ARCHITECT. THE REPRODUCTION, COPYING, OR USE OF THIS DRAWING WITHOUT WRITTEN CONSENT IS PROHIBITED AND ANY INFRINGEMENT WILL BE SUBJECT TO LEGAL ACTION.
© Copyright 1997 MESA Design Group

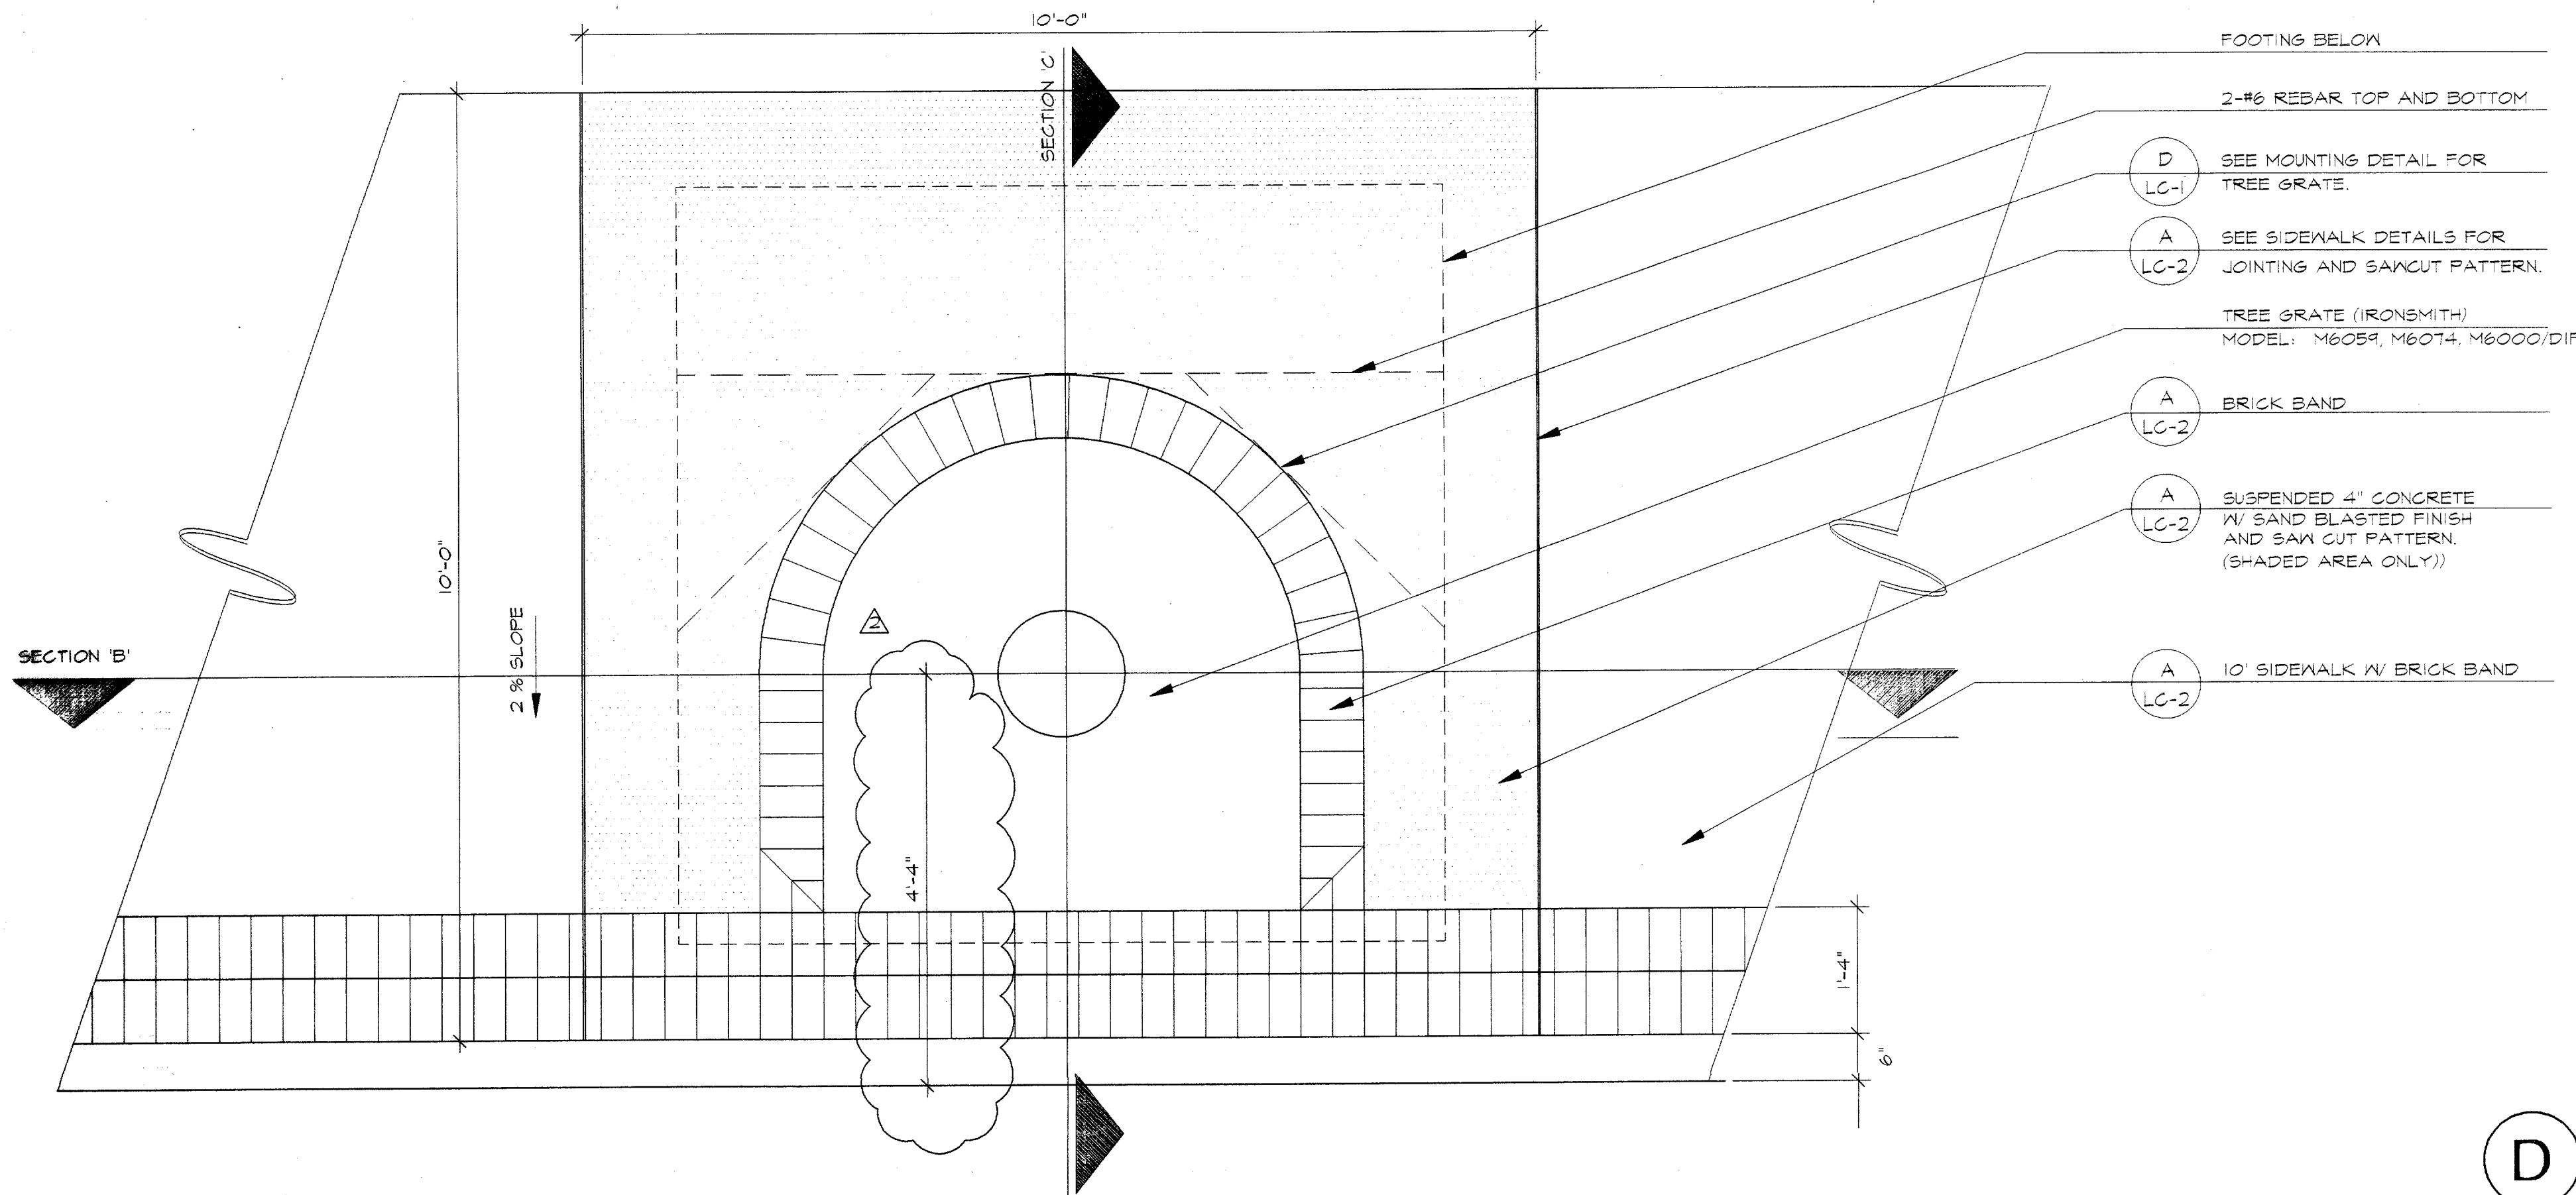

A TREE GRATE PLAN
3/4" = 1'-0"

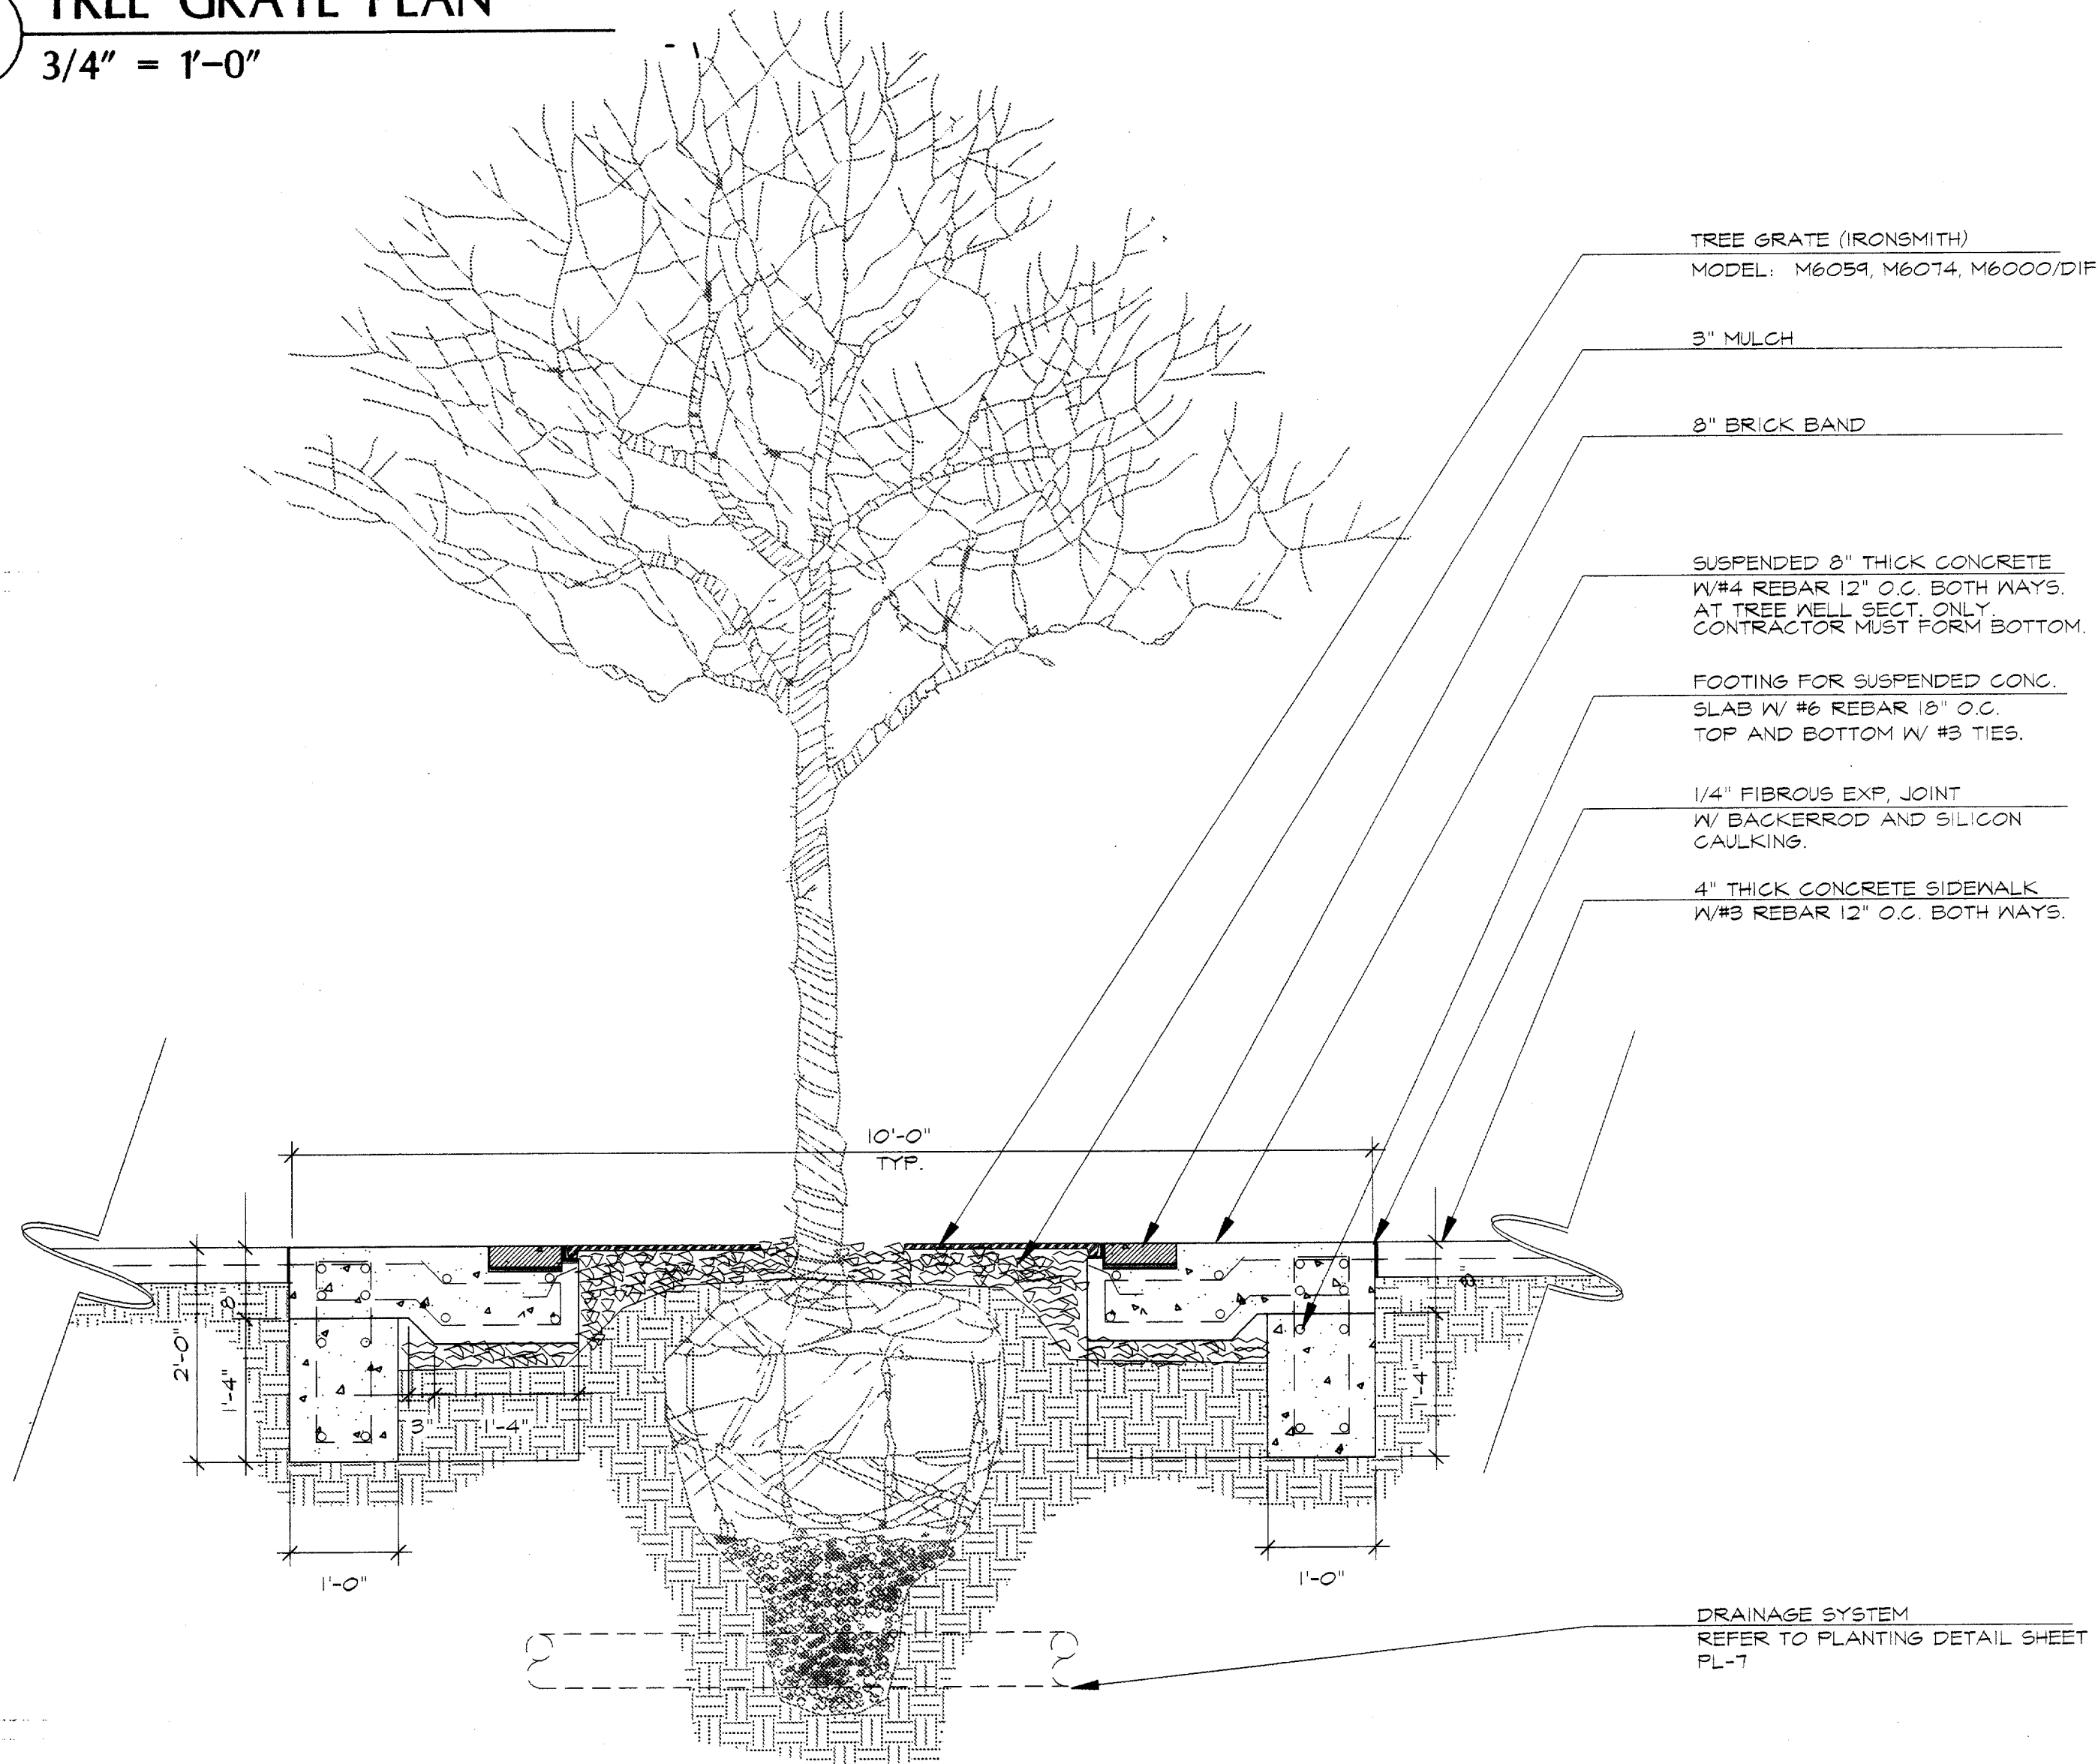


B TREE GRATE SECTION
3/4" = 1'-0"

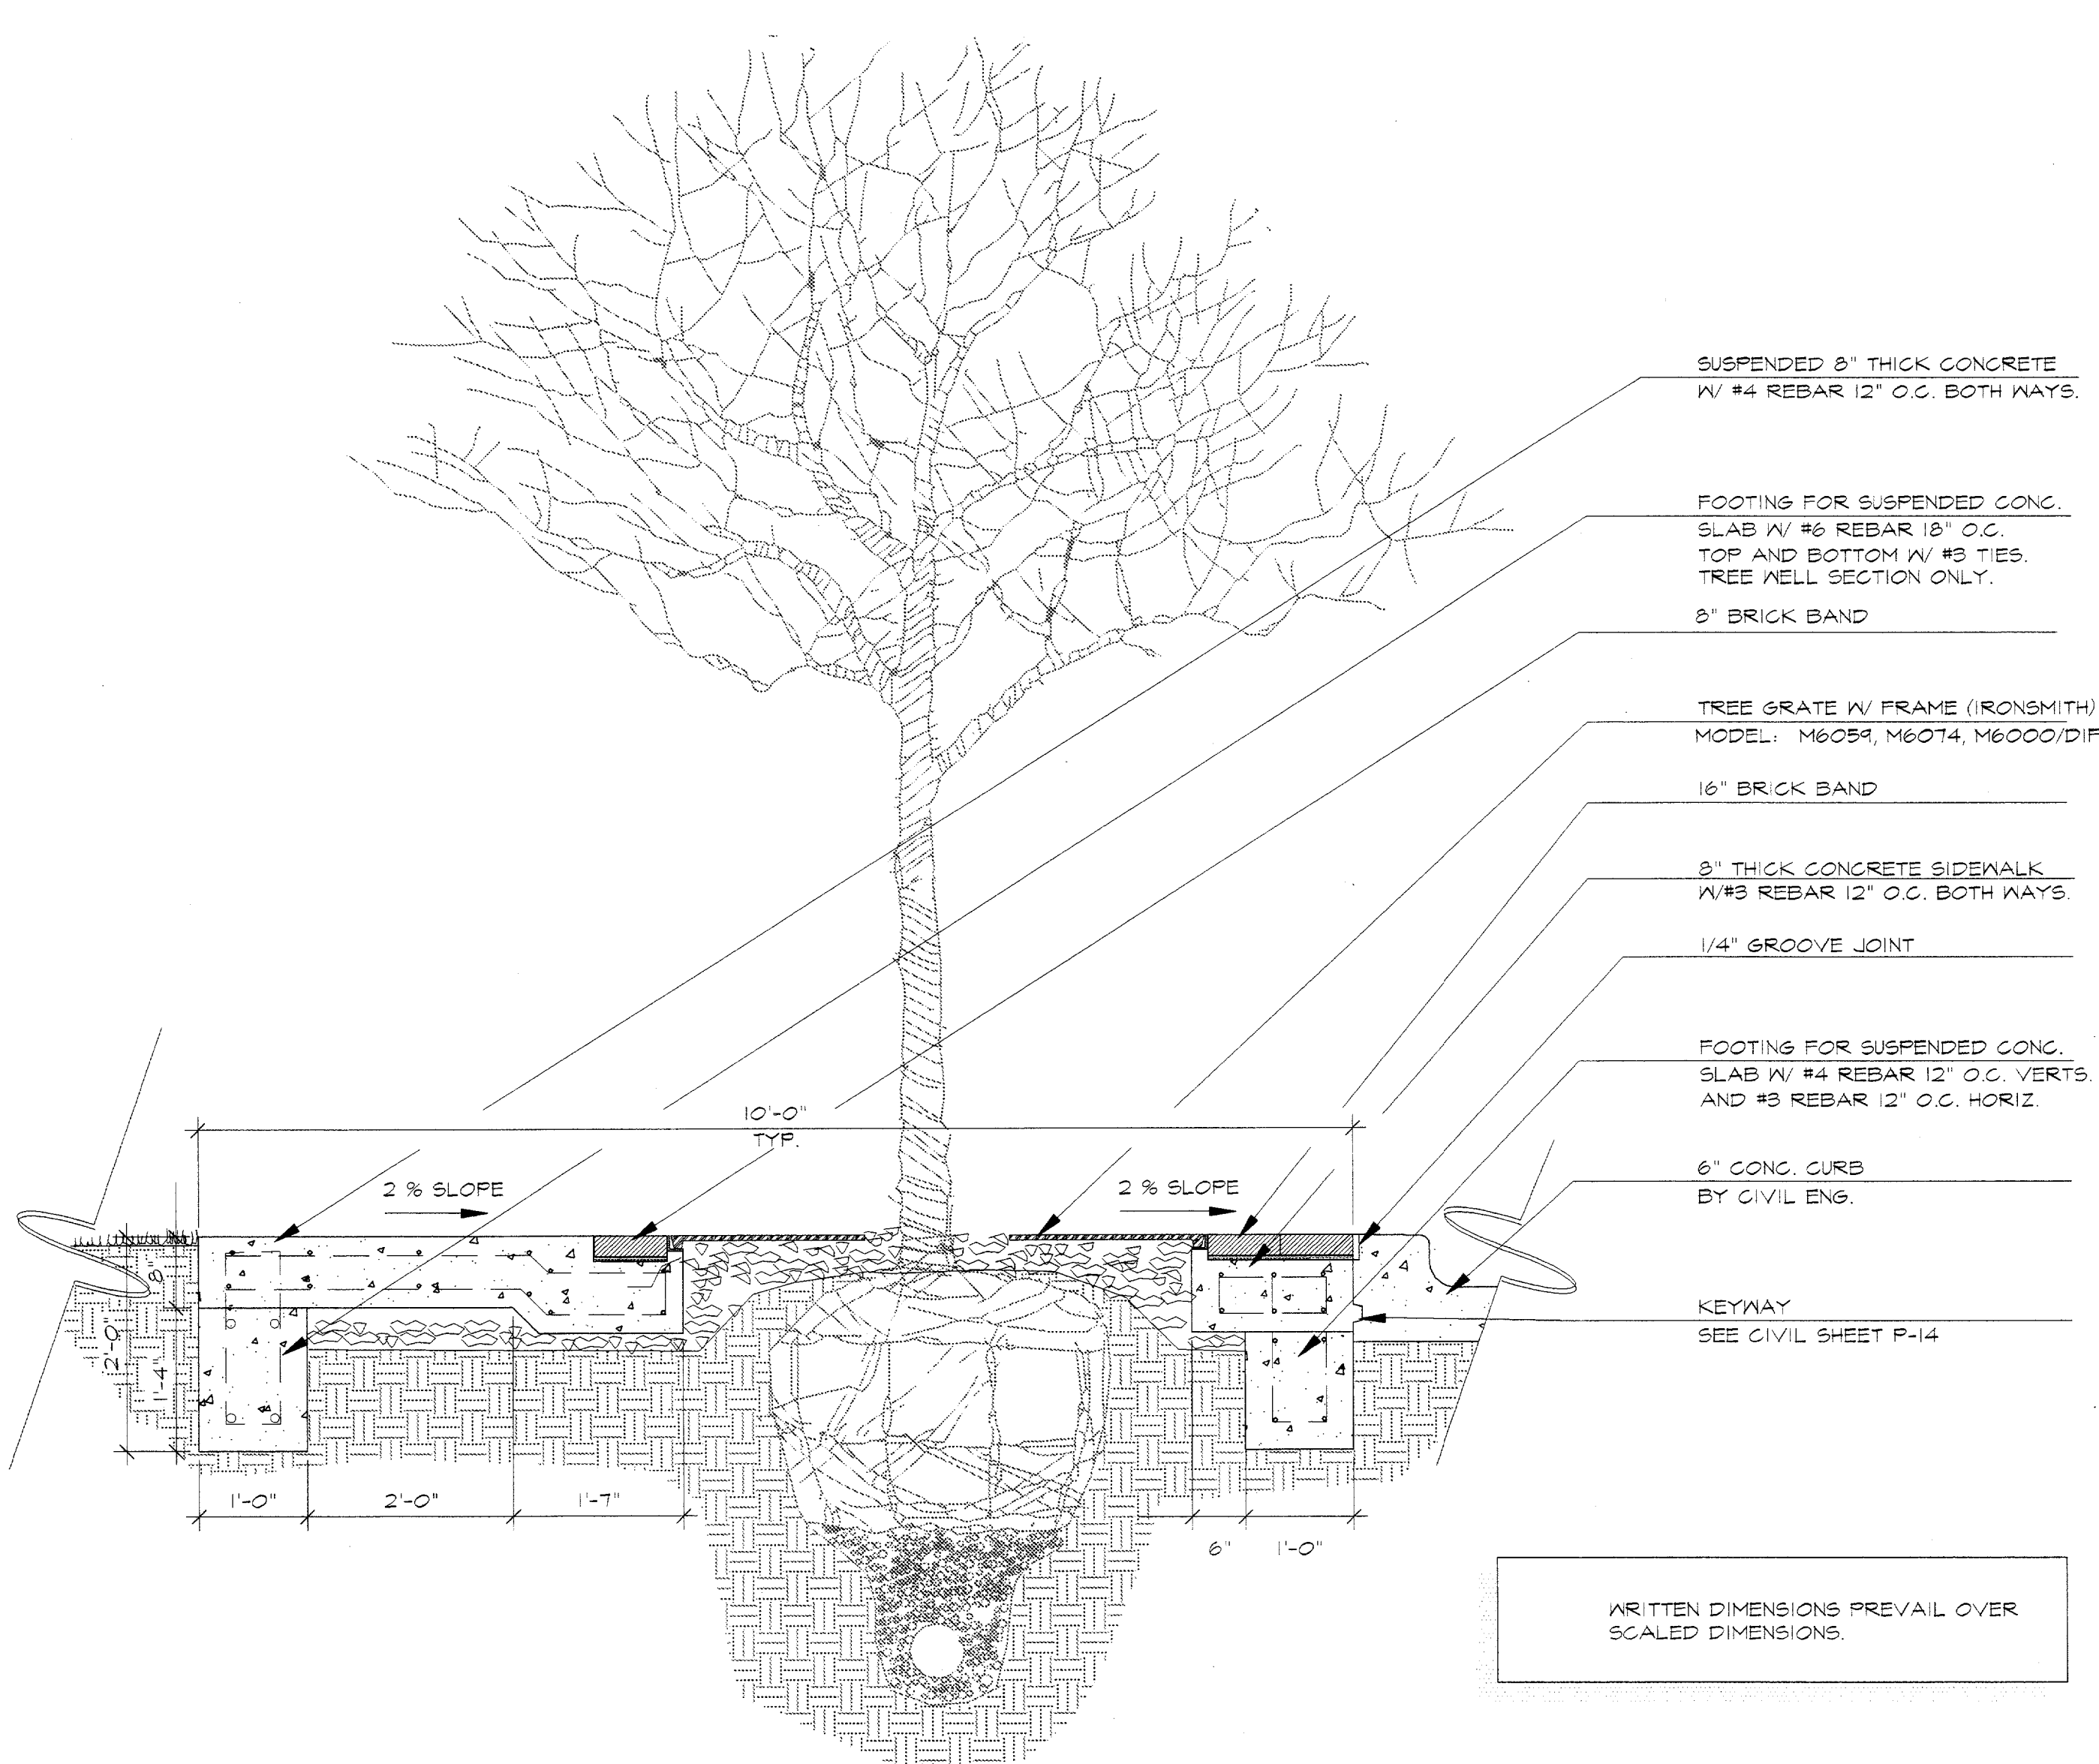

C TREE GRATE SECTION
3/4" = 1'-0"

IMPORTANT!!!

- MESA Design Group assumes no responsibility for any excavation or grading not shown on surveys or civil engineer's plans supplied to MESA Design Group.
- All proposed and finished grades provided by MESA Design Group are based on information provided by owner's surveyor and/or civil engineer. Any discrepancies in actual field measurements are to be reported to landscape architect immediately.
- Contractor shall be responsible for making himself familiar with all underground utilities, pipes, structures, and line runs.
- Prior to commencement of hardscape construction, all plans, footings, and walls are to be surveyed, laid out, and staked in field for approval by landscape architect. Contractor shall assume responsibility for any demolition, adjustments, or reconstruction resulting from unauthorized construction activities.
- Contractor is responsible for all final quantities drawings and specifications. Any quantities provided by MESA Design Group are provided as a convenience only and shall not be considered absolute. Landscape architect should be notified if any discrepancies occur.

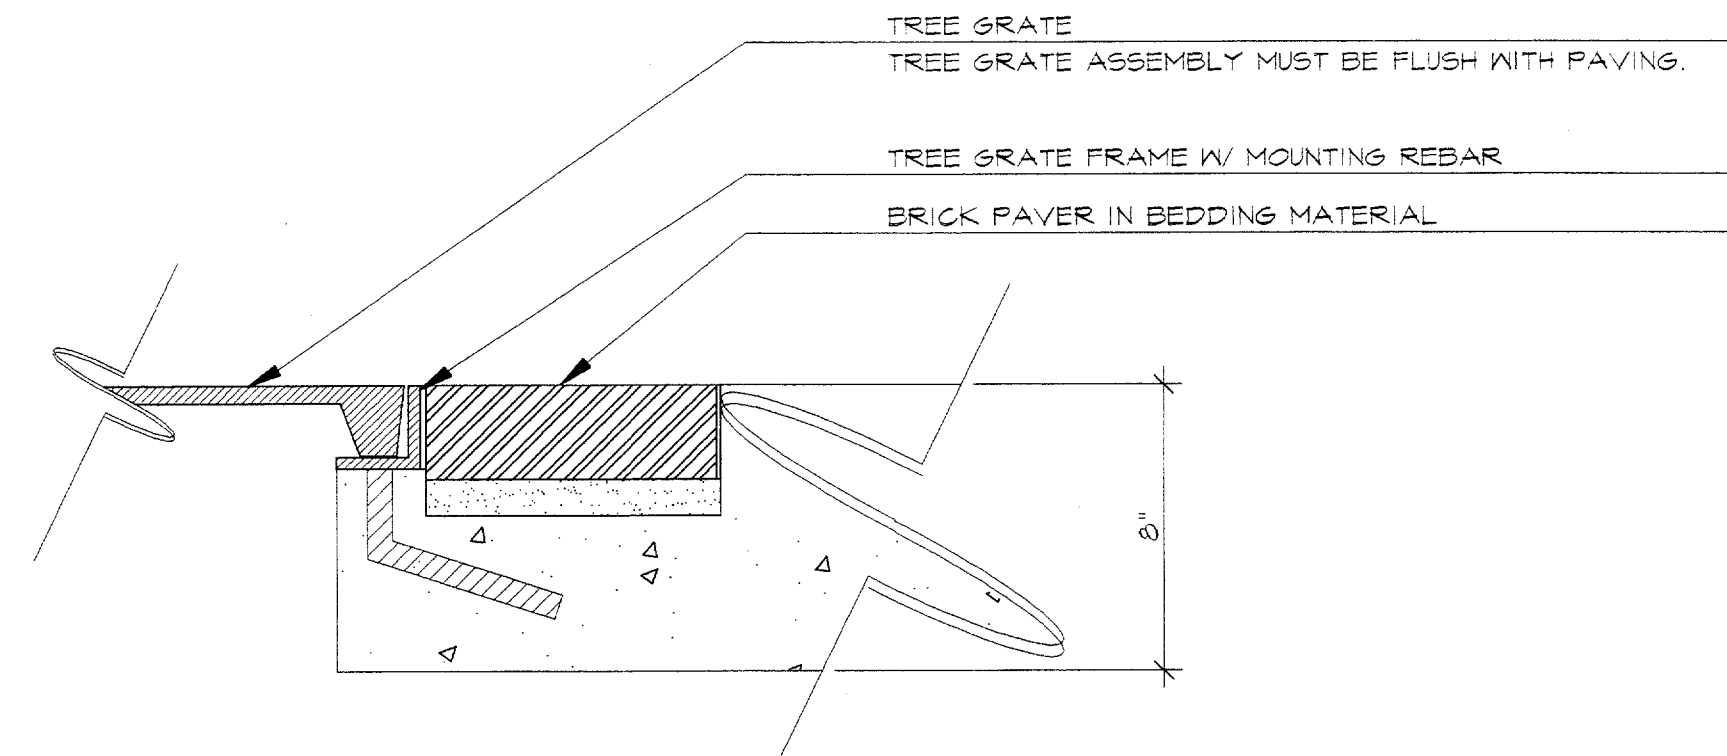

D TREE GRATE MOUNTING DETAIL
3" = 1'-0" CONTRACTOR TO DISCUSS WITH LANDSCAPE ARCHITECT PRIOR TO CONSTRUCTION.

No.	Date	Item
Δ	05/12/98	CORRECTED DIMENSION ON TREE GRATE

Registration


RFM
Drawn
WGM
Checked
97018
Project No.
12/12/97
Date

Sheet Title

TREE GRATE
DETAILS


Sheet No.

LC-1

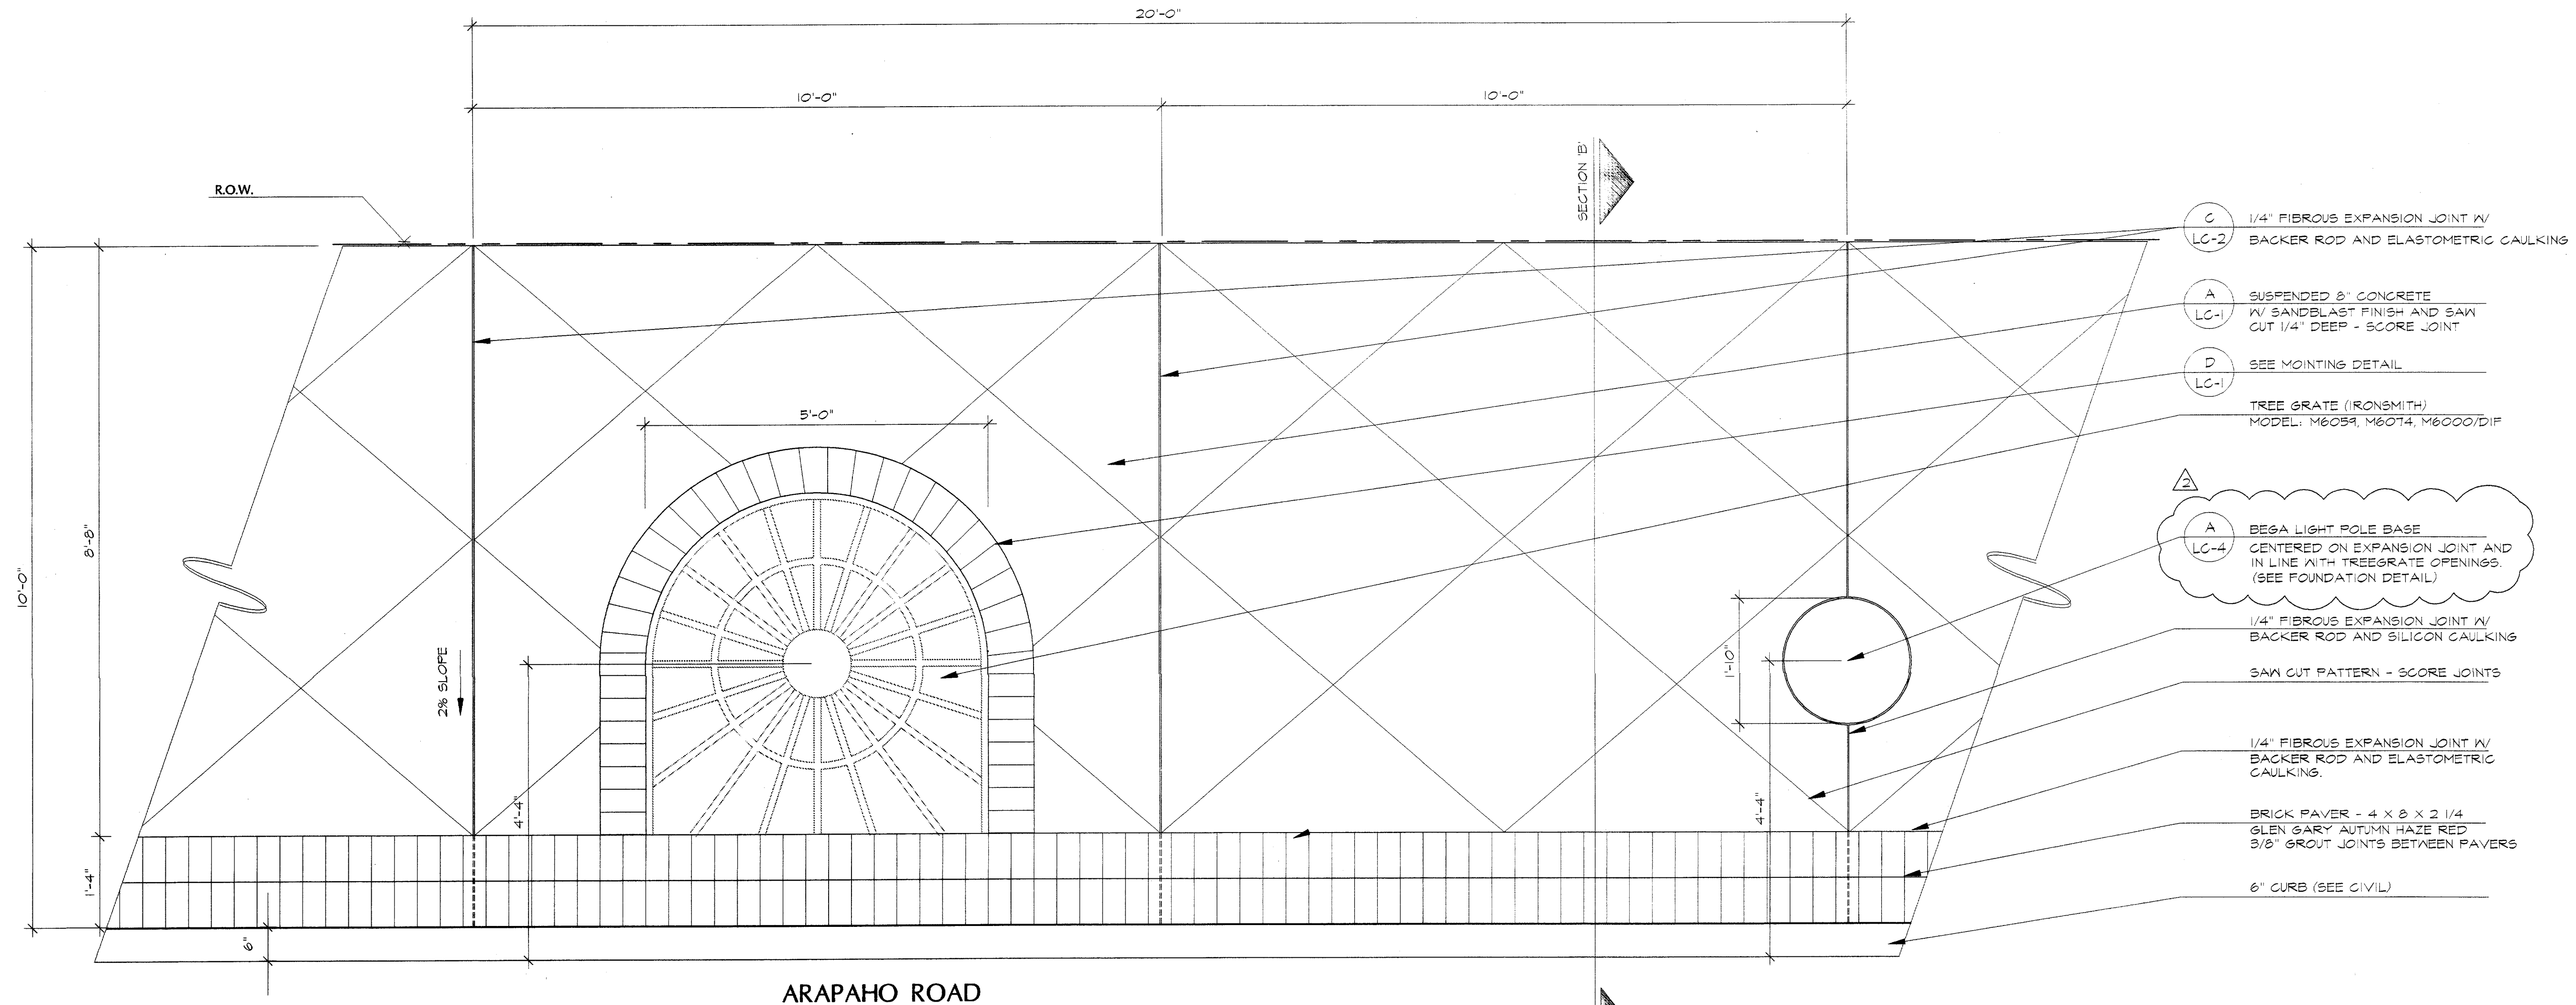

- C LC-2 1/4" FIBROUS EXPANSION JOINT W/ BACKER ROD AND ELASTOMETRIC CAULKING
- A LC-1 SUSPENDED 8" CONCRETE W/ SANDBLAST FINISH AND SAW CUT 1/4" DEEP - SCORE JOINT
- D LC-1 SEE MOUNTING DETAIL
- △ TREE GRATE (IRONSMTIH) MODEL: M6059, M6074, M6000/DIF
- A LC-4 BEGA LIGHT POLE BASE CENTERED ON EXPANSION JOINT AND IN LINE WITH TREEGRATE OPENINGS. (SEE FOUNDATION DETAIL)
- 1/4" FIBROUS EXPANSION JOINT W/ BACKER ROD AND SILICON CAULKING
- SAW CUT PATTERN - SCORE JOINTS
- 1/4" FIBROUS EXPANSION JOINT W/ BACKER ROD AND ELASTOMETRIC CAULKING.
- BRICK PAVER - 4 X 8 X 2 1/4 GLEN GARY AUTUMN HAZE RED 3/8" GROUT JOINTS BETWEEN PAVERS
- 6" CURB (SEE CIVIL)

A TYPICAL ARAPAHO SIDEWALK PLAN DETAIL
3/4" = 1'-0"

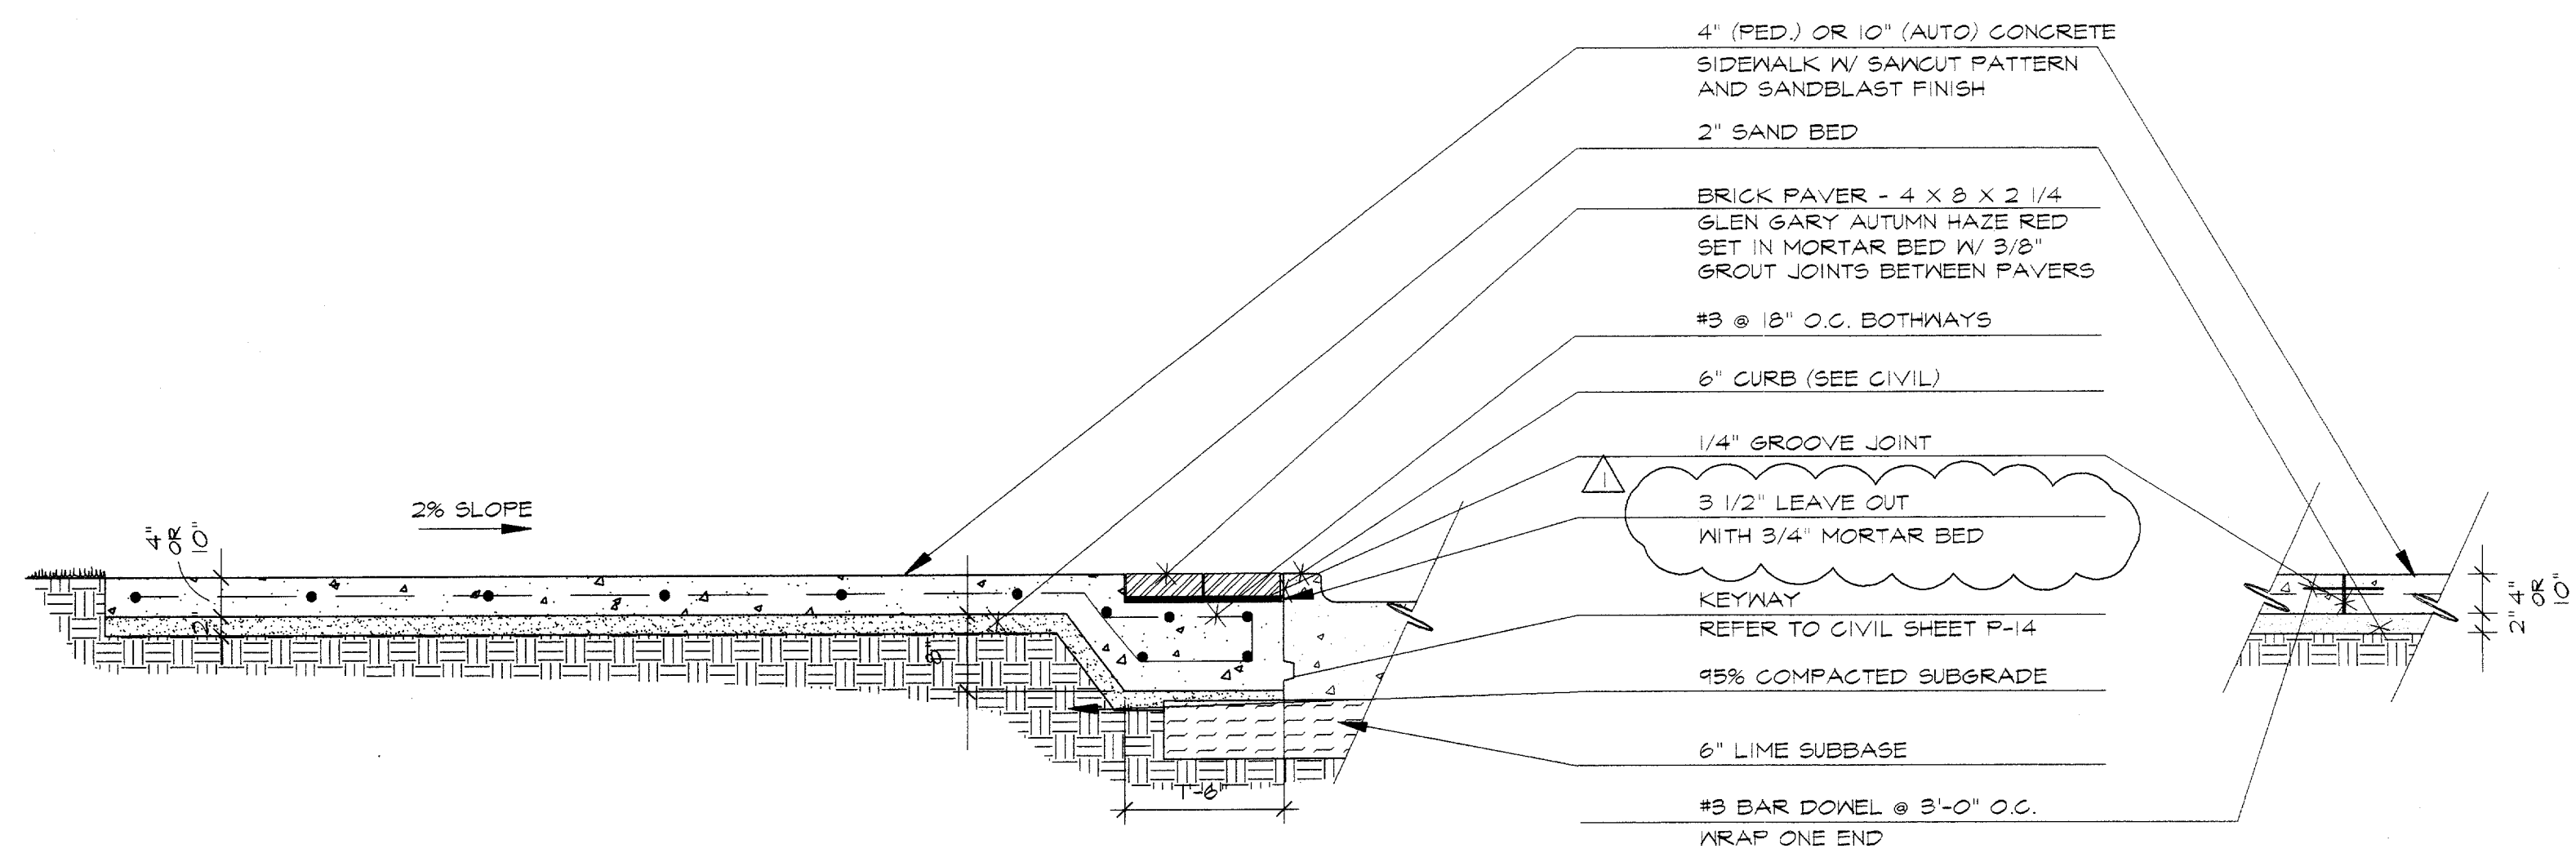

B TYPICAL ARAPAHO SIDEWALK SECTION
3/4" = 1'-0"

C TYPICAL SIDEWALK EXPANSION JOINT
3/4" = 1'-0"


WRITTEN DIMENSIONS PREVAIL OVER SCALED DIMENSIONS.

IMPORTANT!!!

1. MESA Design Group assumes no responsibility for any excavation or grading not shown on survey or civil engineer's plans supplied to MESA Design Group.
2. All proposed and finished grades provided by MESA Design Group are based on information provided by owner's surveyor and/or civil engineer. Any discrepancies in actual field measurements are to be reported to landscape architect immediately.
3. Contractor shall be responsible for making himself familiar with all underground utilities, pipes, structures, and line runs.
4. Prior to commencement of landscape construction, all pins, footings, and nails are to be surveyed, laid out, and staked in field for approval by landscape architect. Contractor shall assume responsibility for any demolition, adjustments, or reconstruction resulting from unauthorized construction activities.
5. Contractor is responsible for all final quantities, drawings and specifications. Any quantities provided by MESA Design Group are provided as a convenience only and shall not be considered absolute. Landscape architect should be notified if any discrepancies occur.

No.	Date	Item
△	03/10/98	CITY REVISIONS AS LISTED IN ADDENDUM NO. 5.
△	05/18/98	ADDED LOCATION OF BEGA LIGHT BASE

Registration

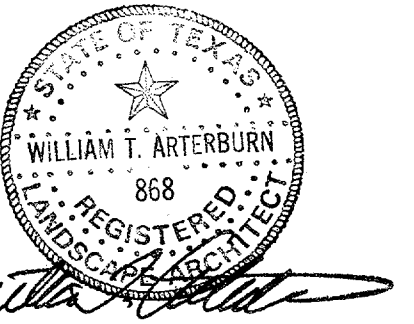


RFM/ISP
Drawn
WGM
Checked
97018
Project No.
05/18/98
Date

Sheet Title


ARAPAHO SIDEWALK
PLAN/SECTIONS

Sheet No.

LC-2

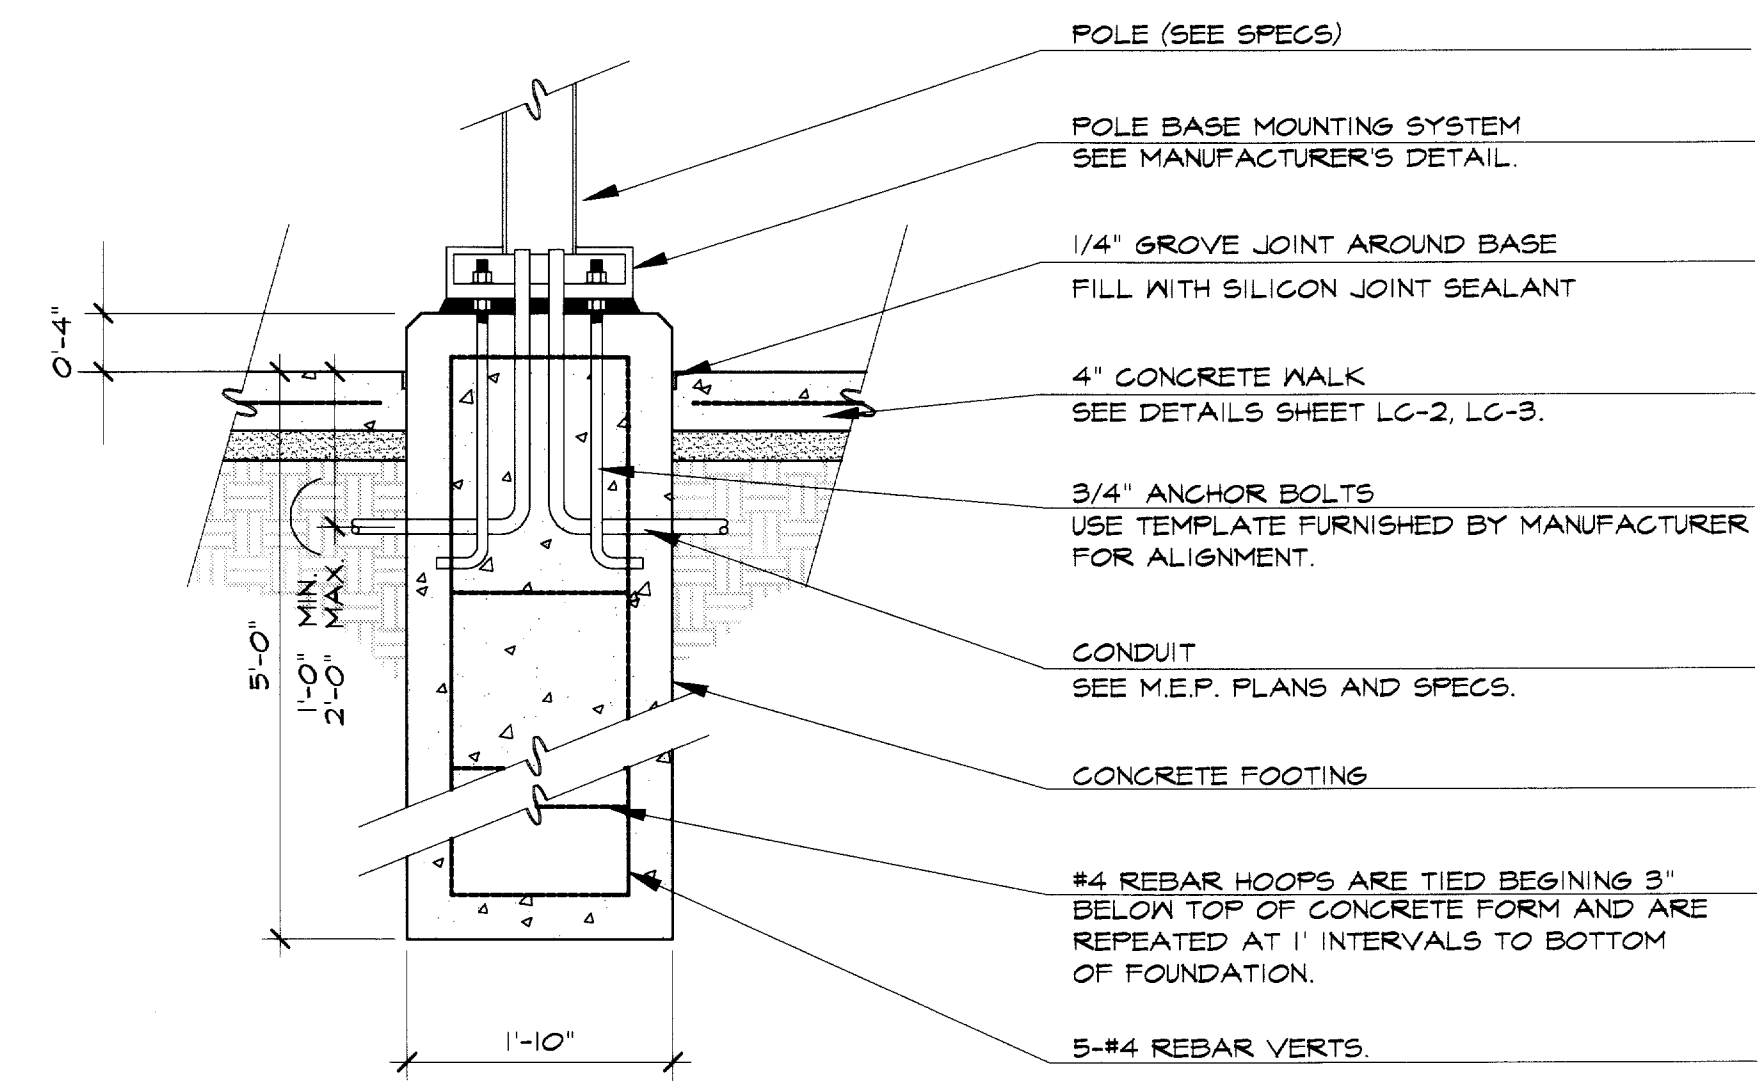

A STREET LIGHT FOUNDATION DETAIL
3/4"=1'-0"

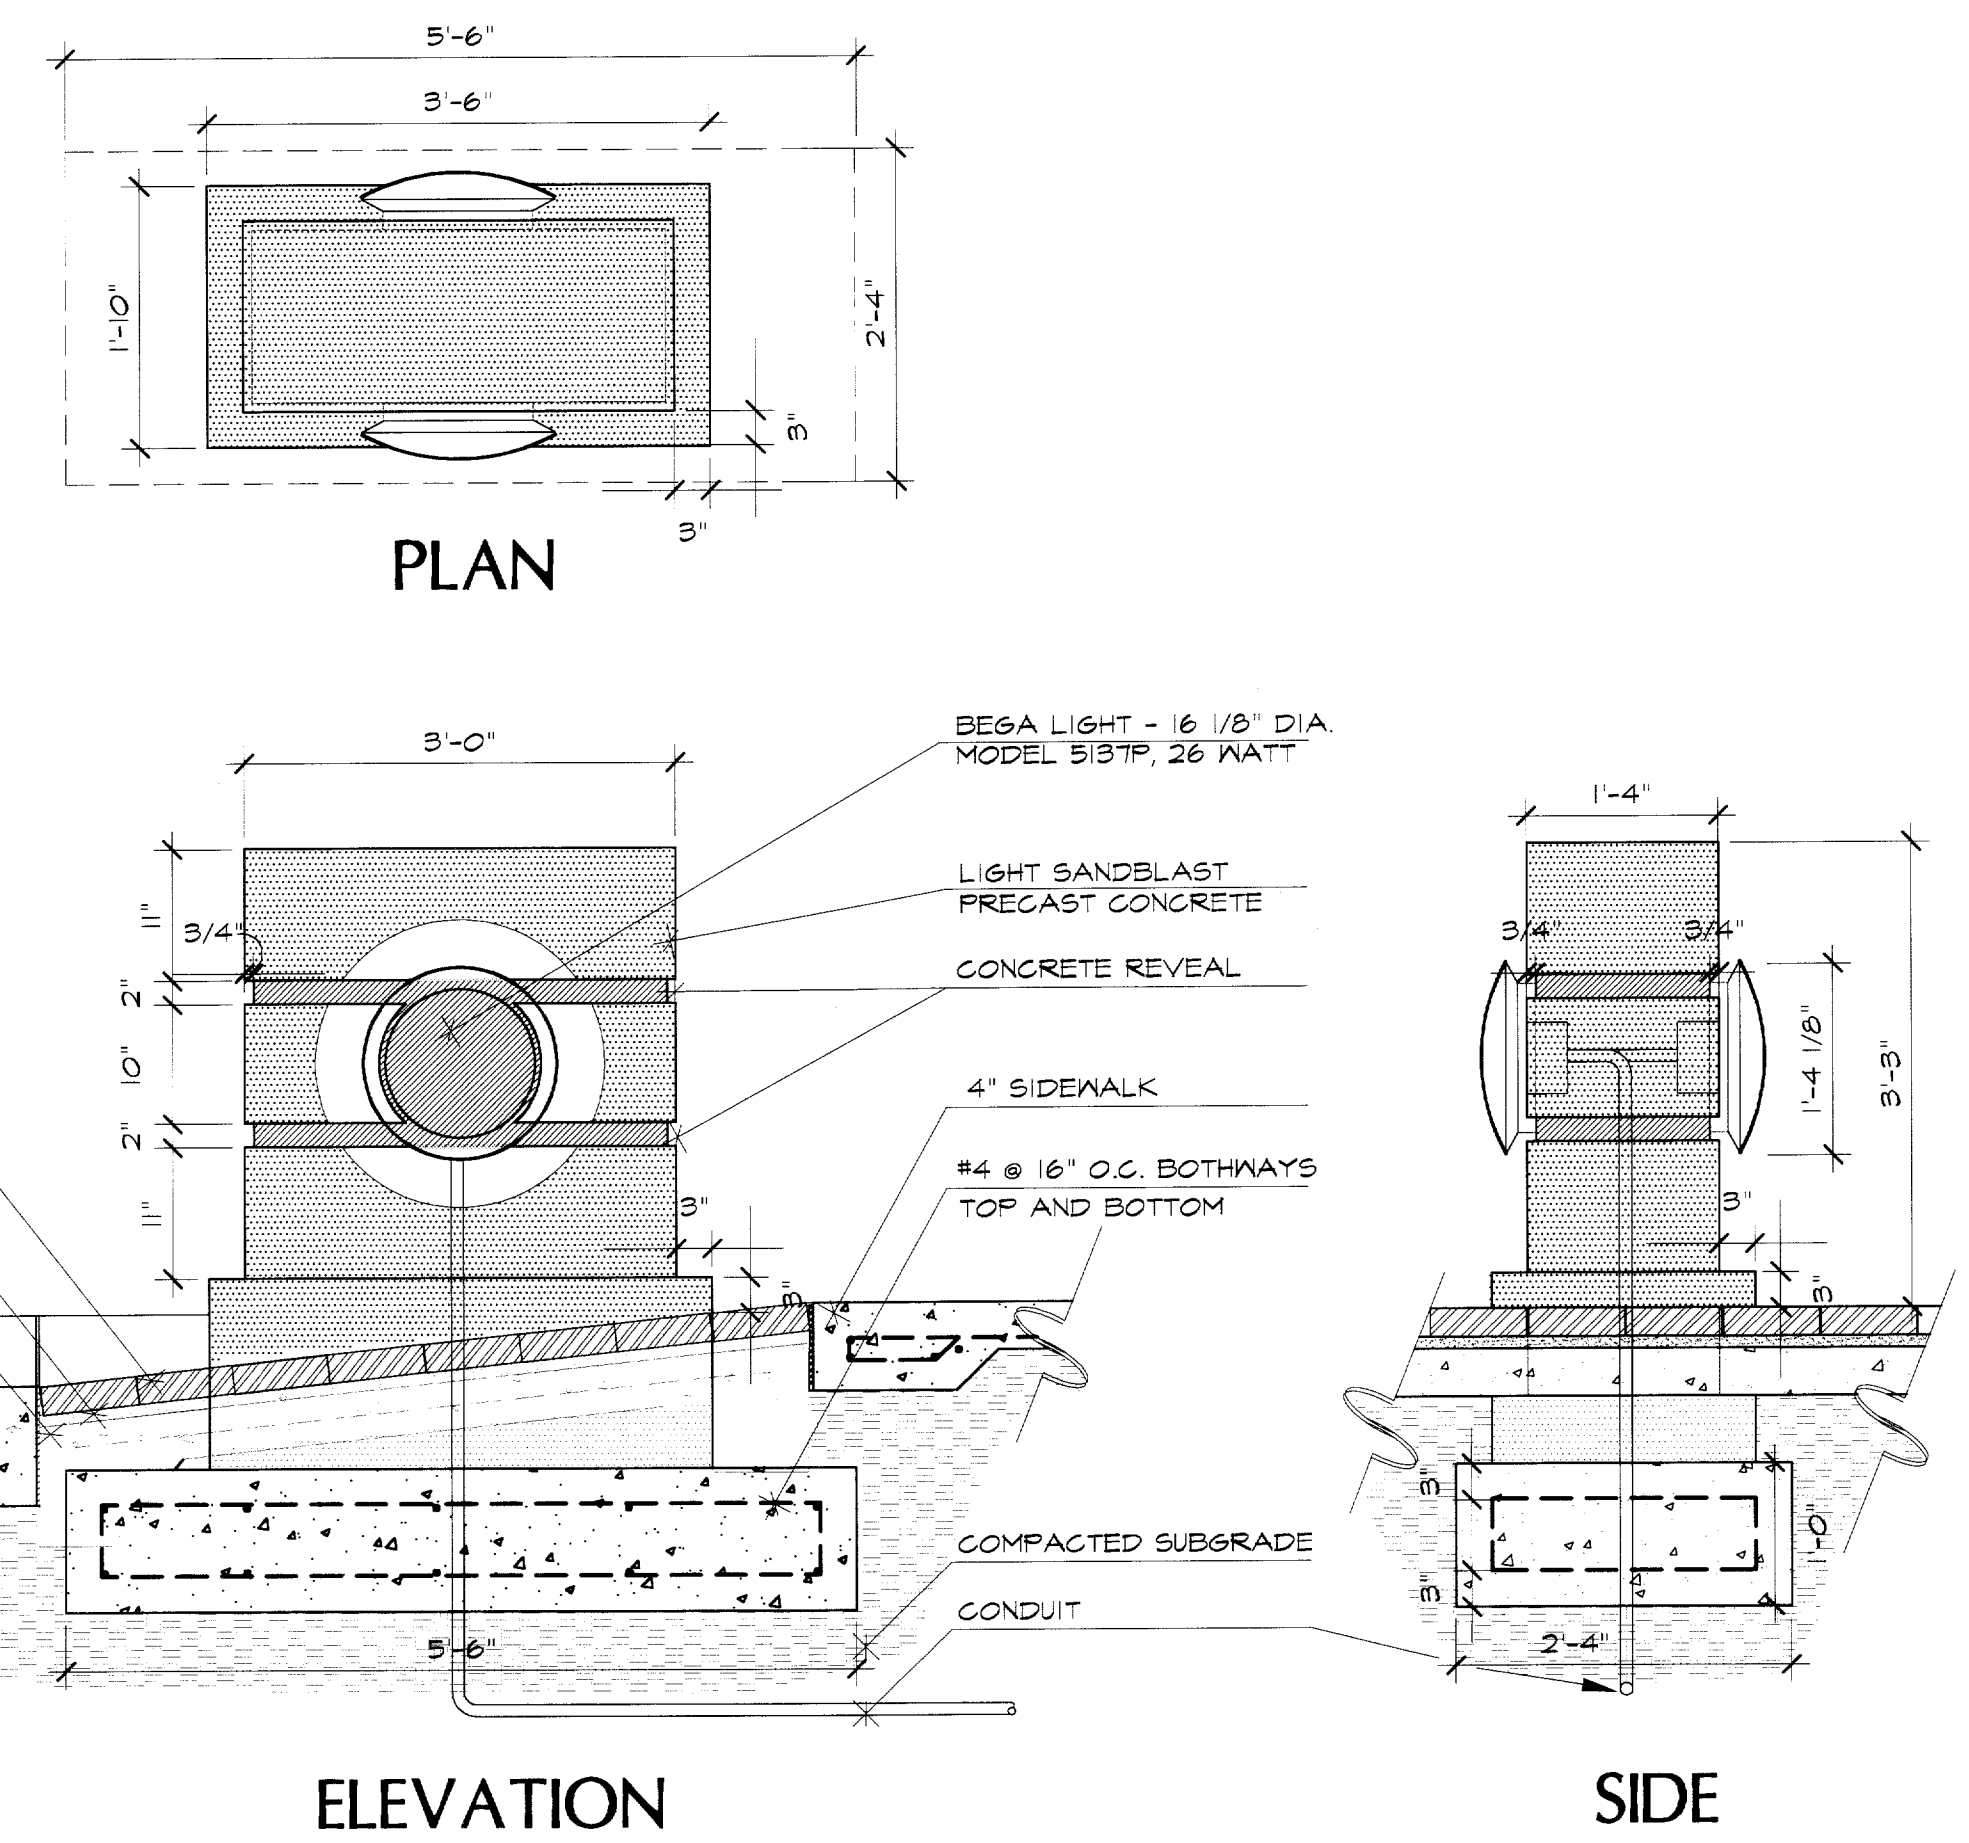

B CUSTOM PRE-CAST CONCRETE BOLLARD
3/4"=1'-0" CONTRACTOR MUST PROVIDE SHOP DRAWING ON THIS ITEM.


Revisions

No.	Date	Item

Registration

RFM/ISP
Drawn
WGM
Checked
97018
Project No. 12/12/97
Date

Sheet Title

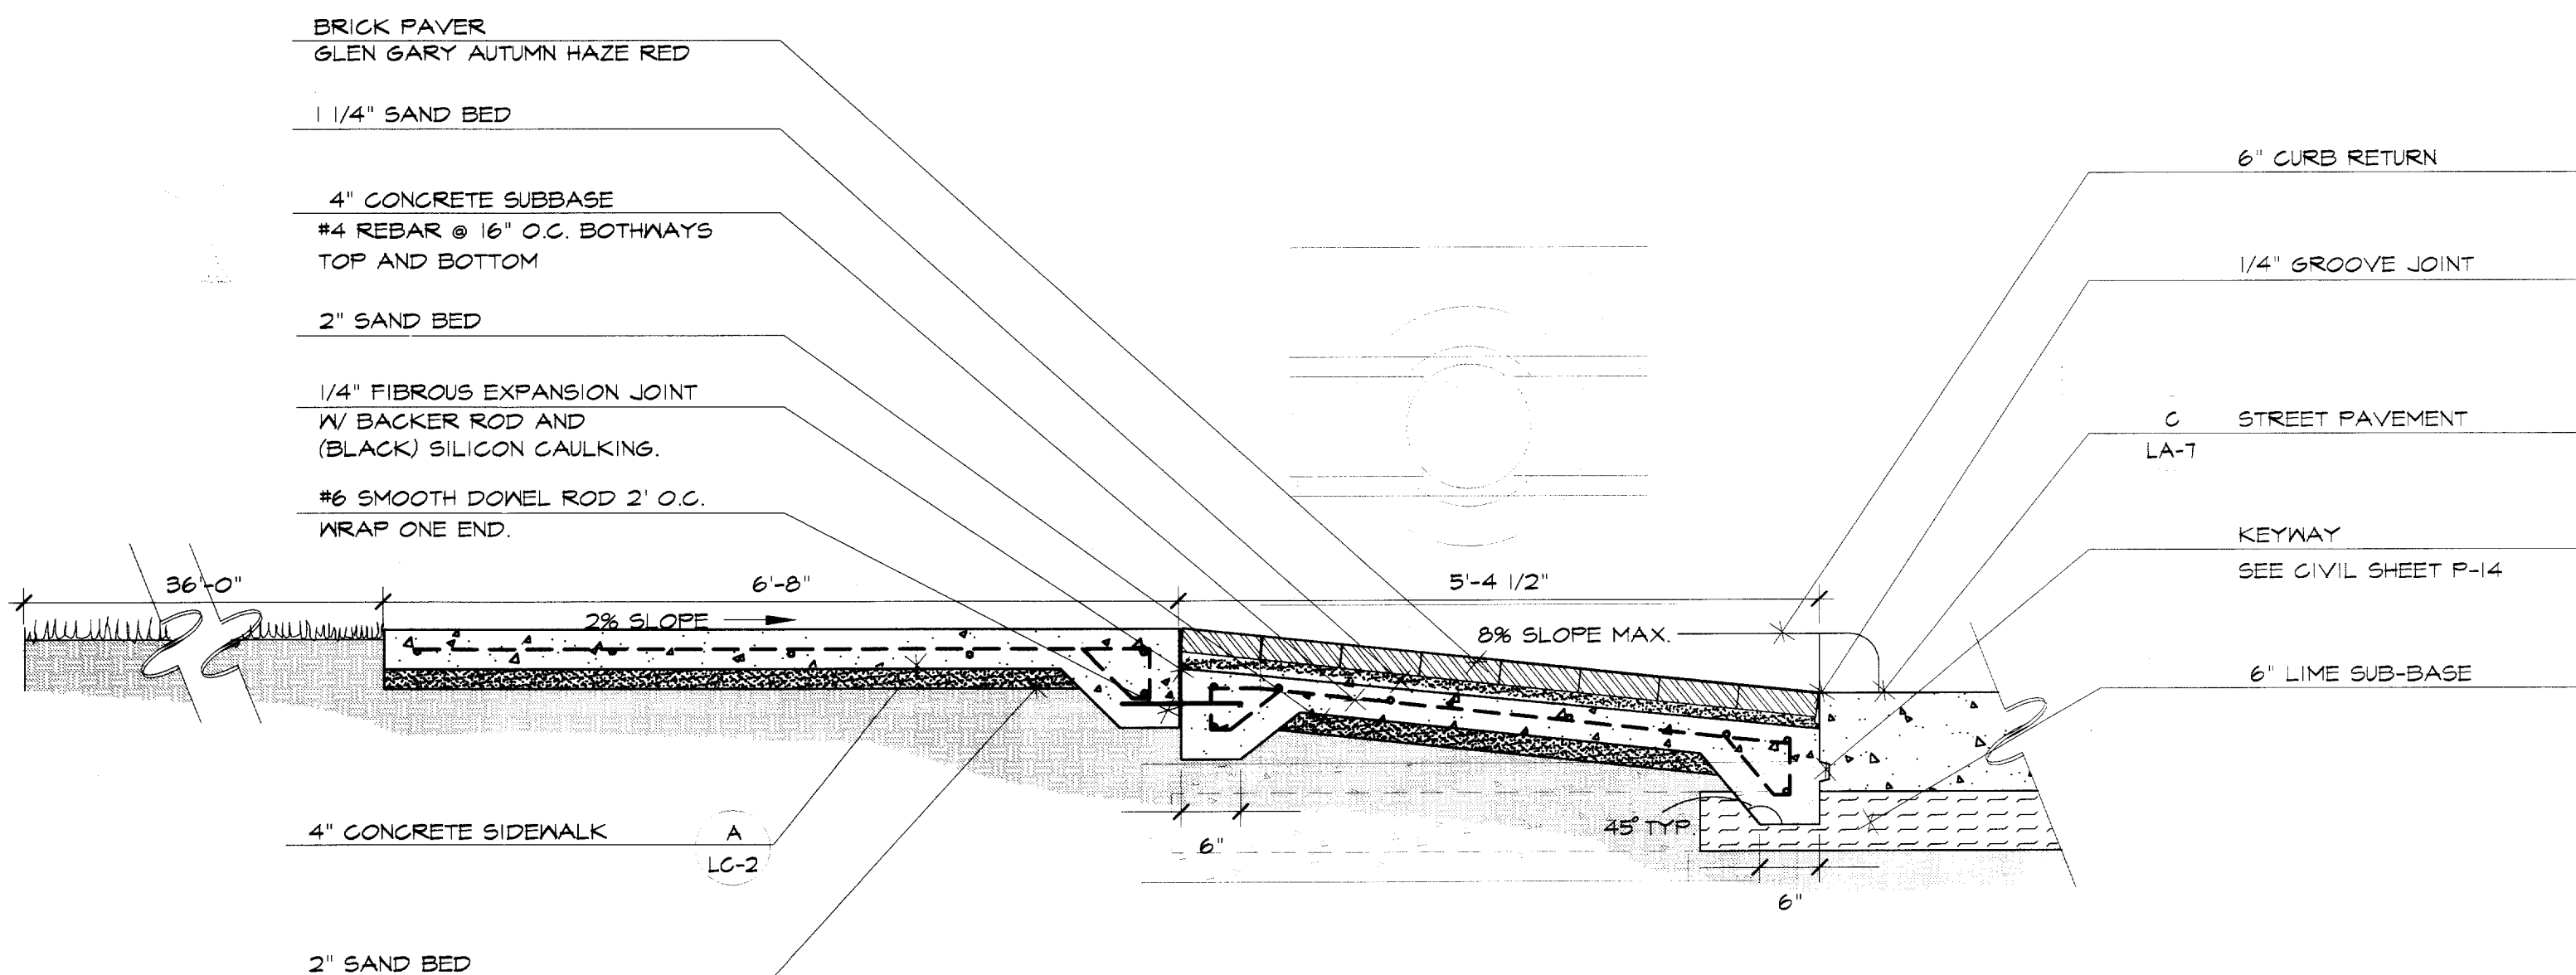

C TYPICAL ARAPAHO/QUORUM CORNER SECTION
3/4"=1'-0"

- IMPORTANT!!!**
- MESA Design Group assumes no responsibility for any excavation or grading not shown on survey or civil engineer's plans supplied to MESA Design Group.
 - All proposed and finished grades provided by MESA Design Group are based on information provided by owner's surveyor and/or civil engineer. Any discrepancies in actual field measurements are to be reported to landscape architect immediately.
 - Contractor shall be responsible for making himself familiar with all underground utilities, pipes, structures, and line runs.
 - Prior to commencement of landscape construction, all plans, footings, and walls are to be surveyed, laid out, and staked in field for approval by landscape architect. Contractor shall assume responsibility for any demolition, adjustments, or reconstruction resulting from unanticipated construction activities.
 - Contractor is responsible for all final quantities drawings and specifications. Any quantities provided by MESA Design Group are provided as a convenience only and shall not be considered absolute. Landscape architect should be notified if any discrepancies occur.

WRITTEN DIMENSIONS PREVAIL OVER SCALED DIMENSIONS.

THIS DRAWING AND THE DESIGN SHOWN IS THE PROPERTY OF THE LANDSCAPE ARCHITECT. THE REPRODUCTION, COPYING, OR USE OF THIS DRAWING WITHOUT WRITTEN CONSENT IS PROHIBITED AND ANY INFRINGEMENT WILL BE SUBJECT TO LEGAL ACTION.
© Copyright 1997 MESA Design Group

LIGHT FOUNDATION/BOLLARD DETAILS


Sheet No.

LC-4

PROJECTS/97018/07018LC-04


IMPORTANT!!!

- MESA Design Group assumes no responsibility for any excavation or grading not shown on surveys or civil engineer's plans supplied to MESA Design Group.
- All proposed and finished grades provided by MESA Design Group are based on information provided by owner's surveyor and/or civil engineer. Any discrepancies in actual field measurements are to be reported to landscape architect immediately.
- Contractor shall be responsible for making himself familiar with all underground utilities, pipes, structures, and line runs.
- Prior to commencement of hardscape construction, all piers, footings, and walls are to be surveyed, laid out, and staked in field for approval by landscape architect. Contractor shall assume responsibility for any demolition, adjustments, or reconstruction resulting from unauthorized construction activities.
- Contractor is responsible for all final quantities per drawings and specifications. Any quantities provided by MESA Design Group are provided as a convenience only and shall not be considered absolute. Landscape architect should be notified if any discrepancies occur.

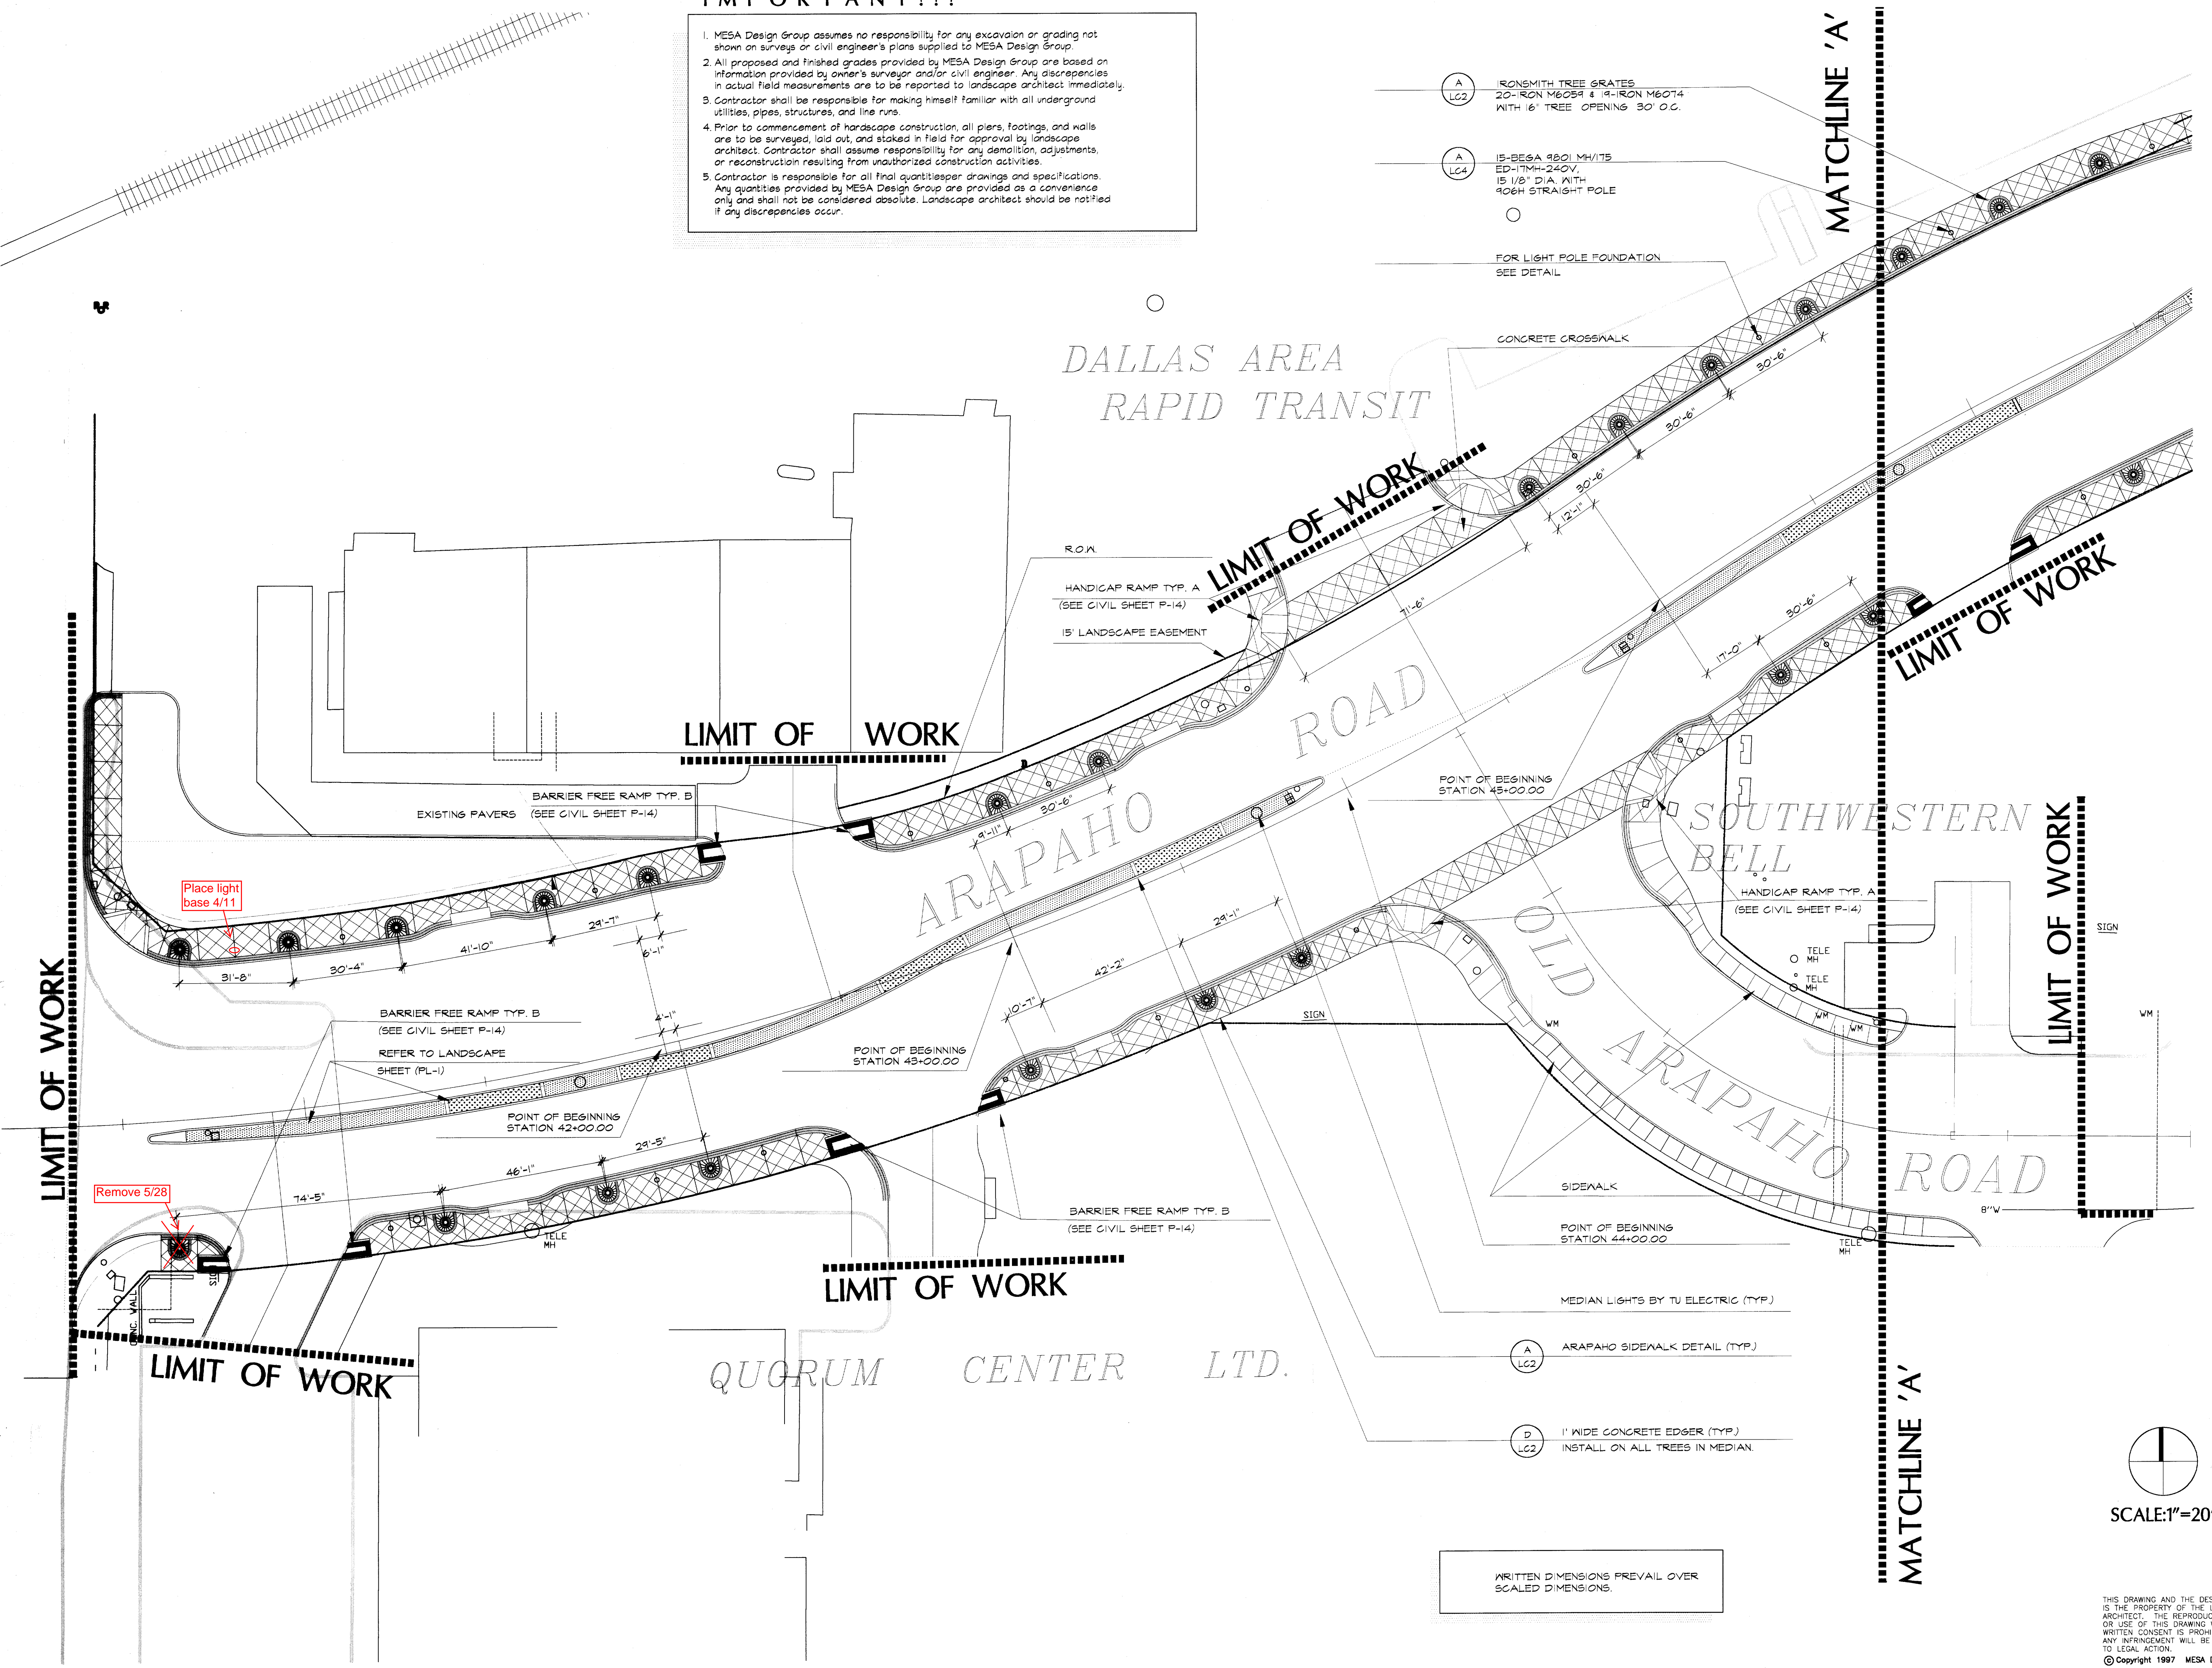

Revisions

No.	Date	Item
△	03/10/98	CITY REVISIONS AS LISTED IN ADDENDUM NO. 5

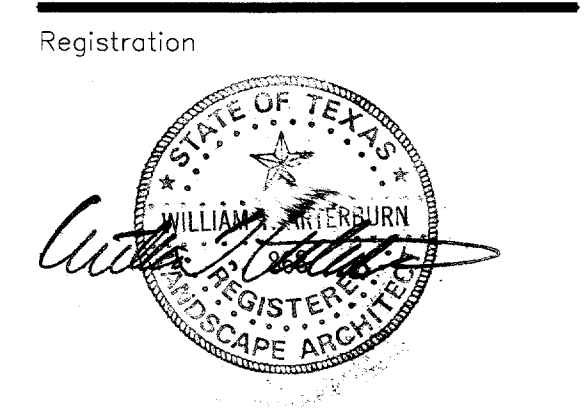

KDH/RFM
Drawn

Checked
97018 **12/12/97**
Project No. Date

Sheet Title

LAYOUT PLAN

Sheet No.

LA-1

THIS DRAWING AND THE DESIGN SHOWN IS THE PROPERTY OF THE LANDSCAPE ARCHITECT. THE REPRODUCTION, COPYING, OR USE OF THIS DRAWING WITHOUT WRITTEN CONSENT IS PROHIBITED AND ANY INFRINGEMENT WILL BE SUBJECT TO LEGAL ACTION.
© Copyright 1997 MESA Design Group


IMPORTANT!!!

- MESA Design Group assumes no responsibility for any excavation or grading not shown on surveys or civil engineer's plans supplied to MESA Design Group.
- All proposed and finished grades provided by MESA Design Group are based on information provided by owner's surveyor and/or civil engineer. Any discrepancies in actual field measurements are to be reported to landscape architect immediately.
- Contractor shall be responsible for making himself familiar with all underground utilities, pipes, structures, and line runs.
- Prior to commencement of hardscape construction, all piers, footings, and walls are to be surveyed, laid out, and staked in field for approval by landscape architect. Contractor shall assume responsibility for any demolition, adjustments, or reconstruction resulting from unauthorized construction activities.
- Contractor is responsible for all final quantities per drawings and specifications. Any quantities provided by MESA Design Group are provided as a convenience only and shall not be considered absolute. Landscape architect should be notified if any discrepancies occur.

DALLAS AREA
RAPID TRANSIT

3100 McKinnon Street
Suite 905
Dallas, Texas 75201
(214) 871-0568 Fax: 871-1507


ARAPAHO ROAD
STREETSCAPE
CITY-OF-ADDISON, TEXAS

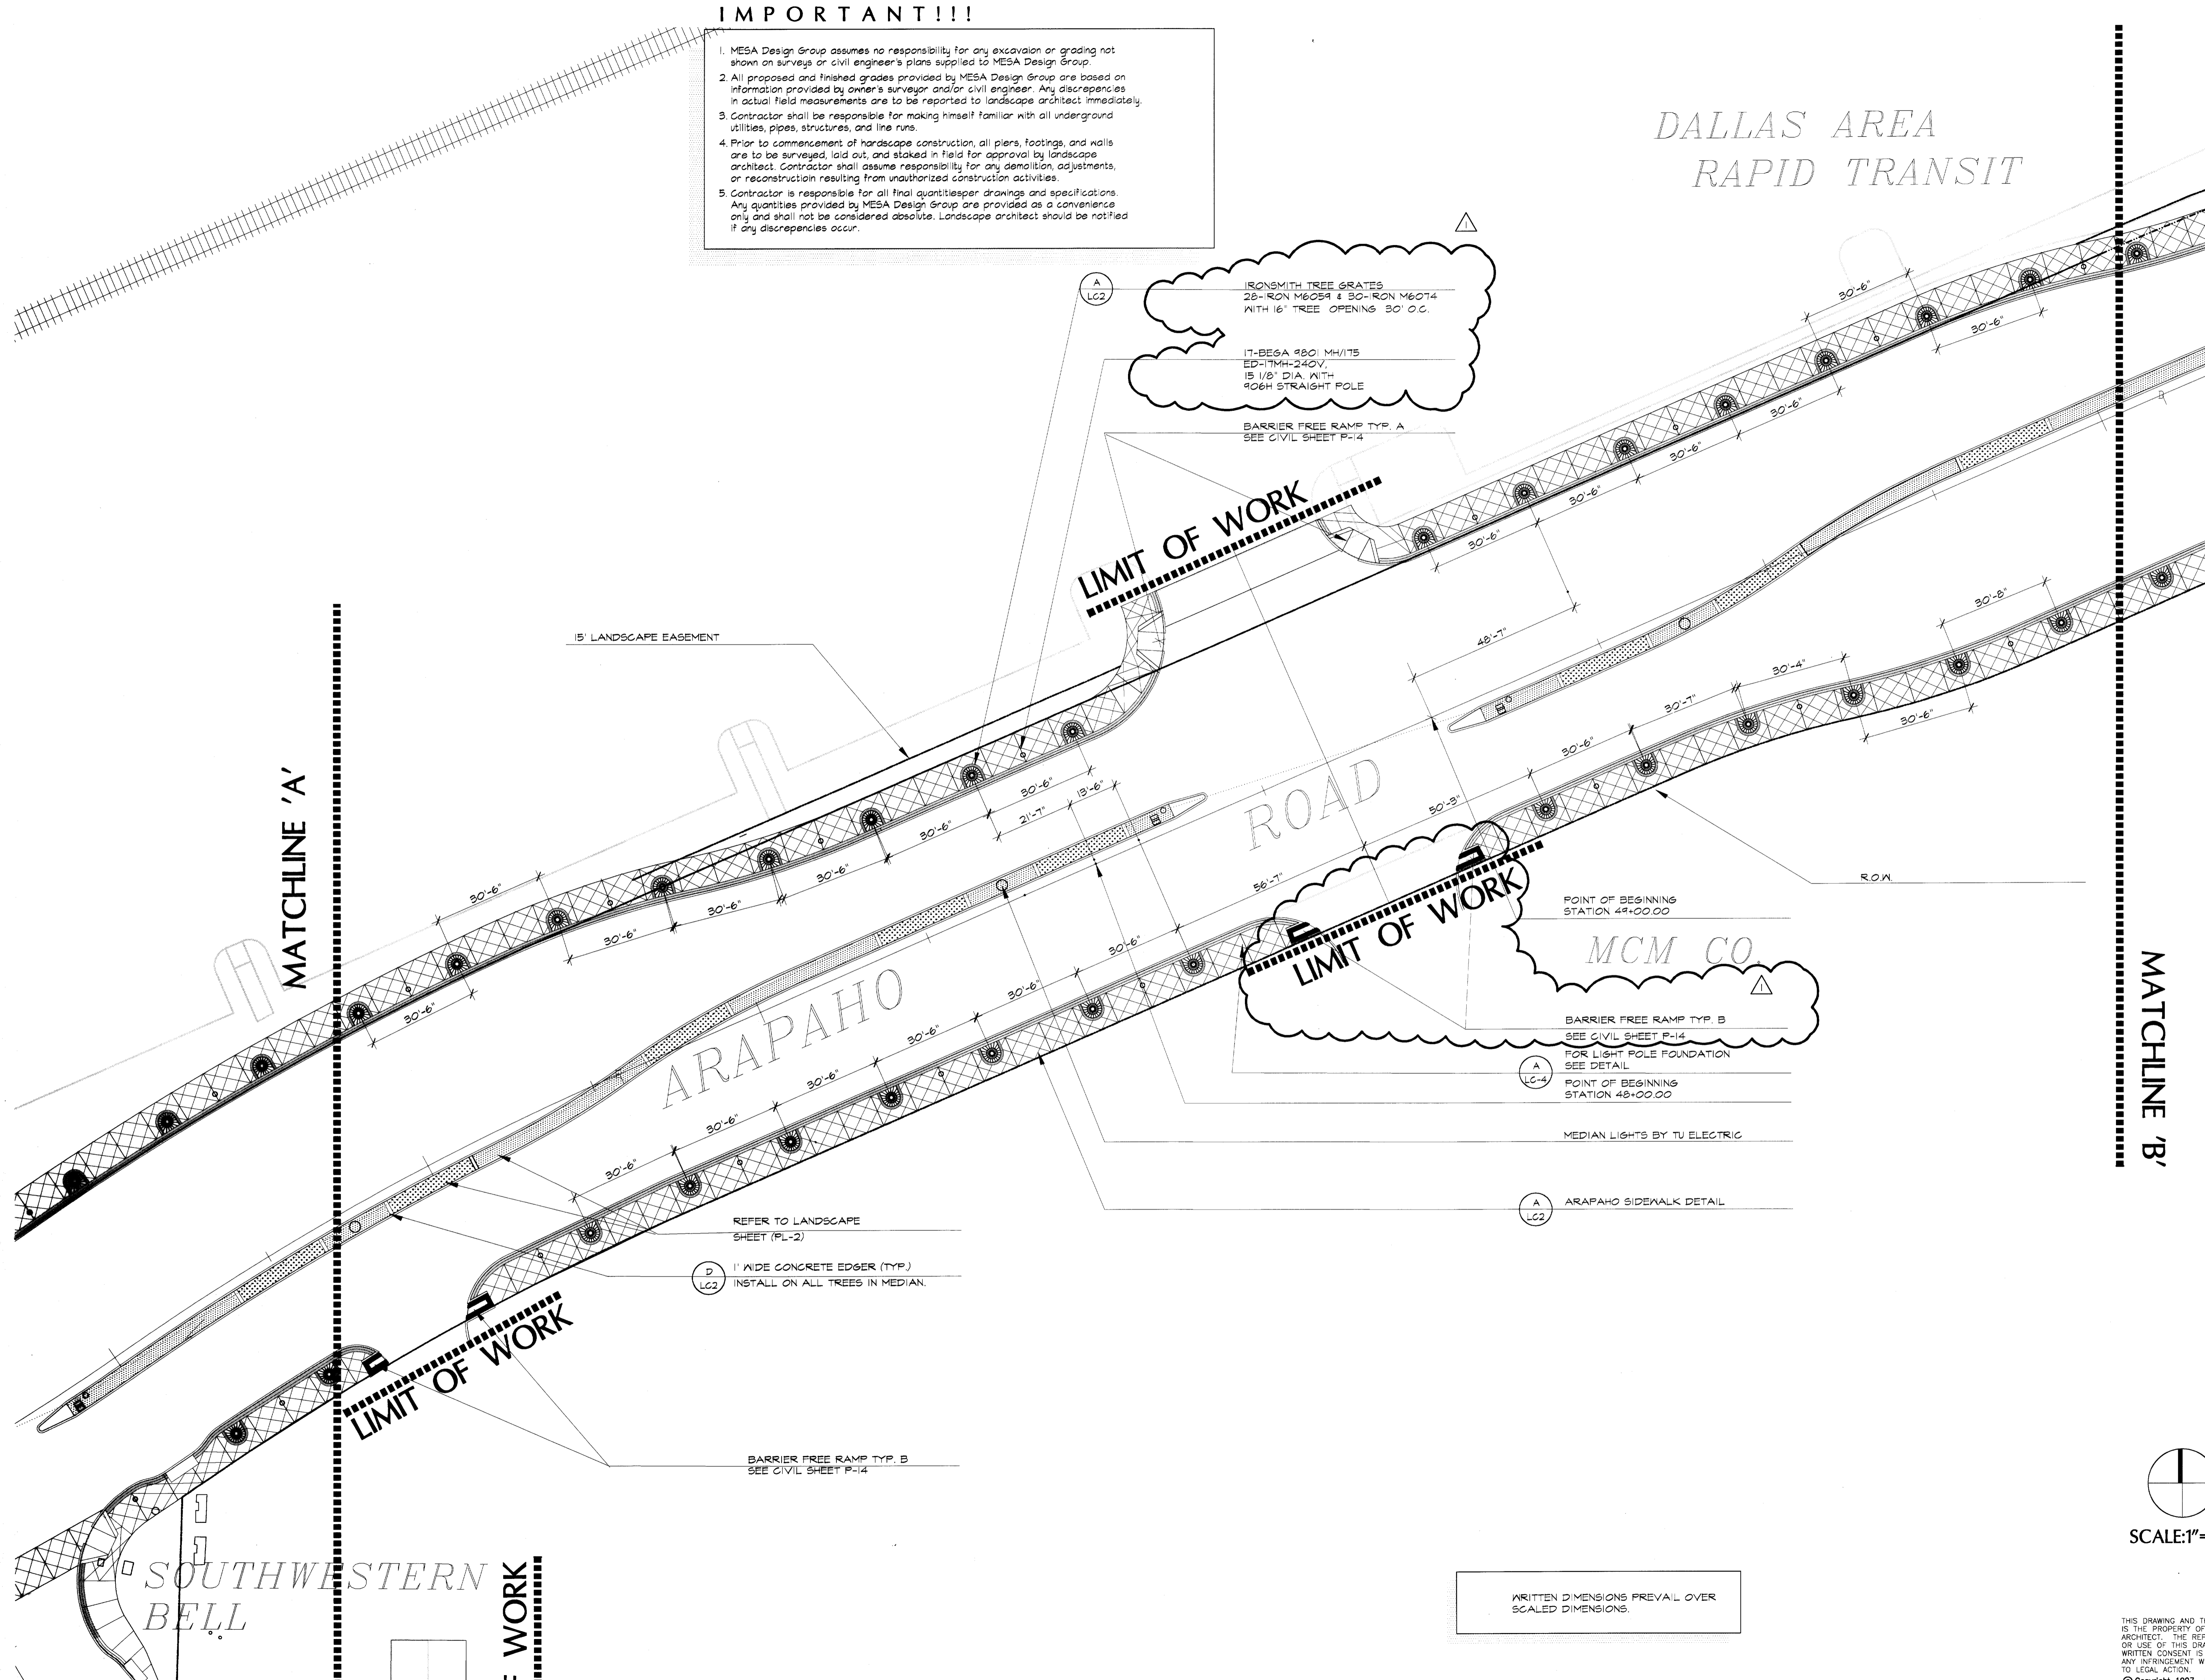

Revisions

No.	Date	Item
△	03/10/98	CITY REVISIONS AS LISTED IN ADDENDUM NO. 5

Registration

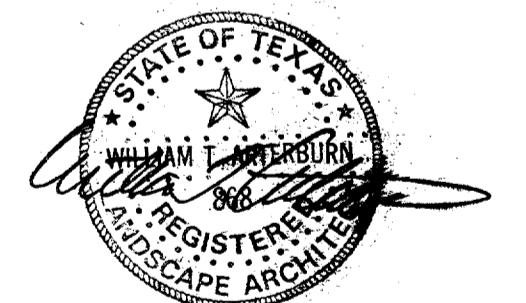

KDH/RFM

Drawn


Checked: 97018 Date: 12/12/97
Project No. Date

Sheet Title

LAYOUT PLAN

Sheet No.

LA-2

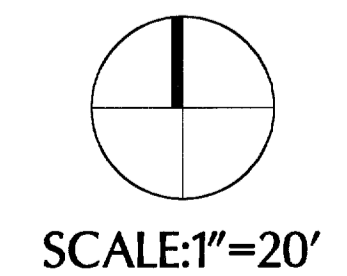


WRITTEN DIMENSIONS PREVAIL OVER SCALED DIMENSIONS.

THIS DRAWING AND THE DESIGN SHOWN IS THE PROPERTY OF THE LANDSCAPE ARCHITECT. THE REPRODUCTION, COPYING, OR USE OF THIS DRAWING WITHOUT WRITTEN CONSENT IS PROHIBITED AND ANY INFRINGEMENT WILL BE SUBJECT TO LEGAL ACTION.
© Copyright 1997 MESA Design Group

**ARAPAHO ROAD
STREETSCAPE
CITY-OF-ADDISON, TEXAS**


IMPORTANT!!!

1. MESA Design Group assumes no responsibility for any excavation or grading not shown on surveys or civil engineer's plans supplied to MESA Design Group.
2. All proposed and finished grades provided by MESA Design Group are based on information provided by owner's surveyor and/or civil engineer. Any discrepancies in actual field measurements are to be reported to landscape architect immediately.
3. Contractor shall be responsible for making himself familiar with all underground utilities, pipes, structures, and line runs.
4. Prior to commencement of hardscape construction, all piers, footings, and walls are to be surveyed, laid out, and staked in field for approval by landscape architect. Contractor shall assume responsibility for any demolition, adjustments, or reconstruction resulting from unauthorized construction activities.
5. Contractor is responsible for all final quantities per drawings and specifications. Any quantities provided by MESA Design Group are provided as a convenience only and shall not be considered absolute. Landscape architect should be notified if any discrepancies occur.

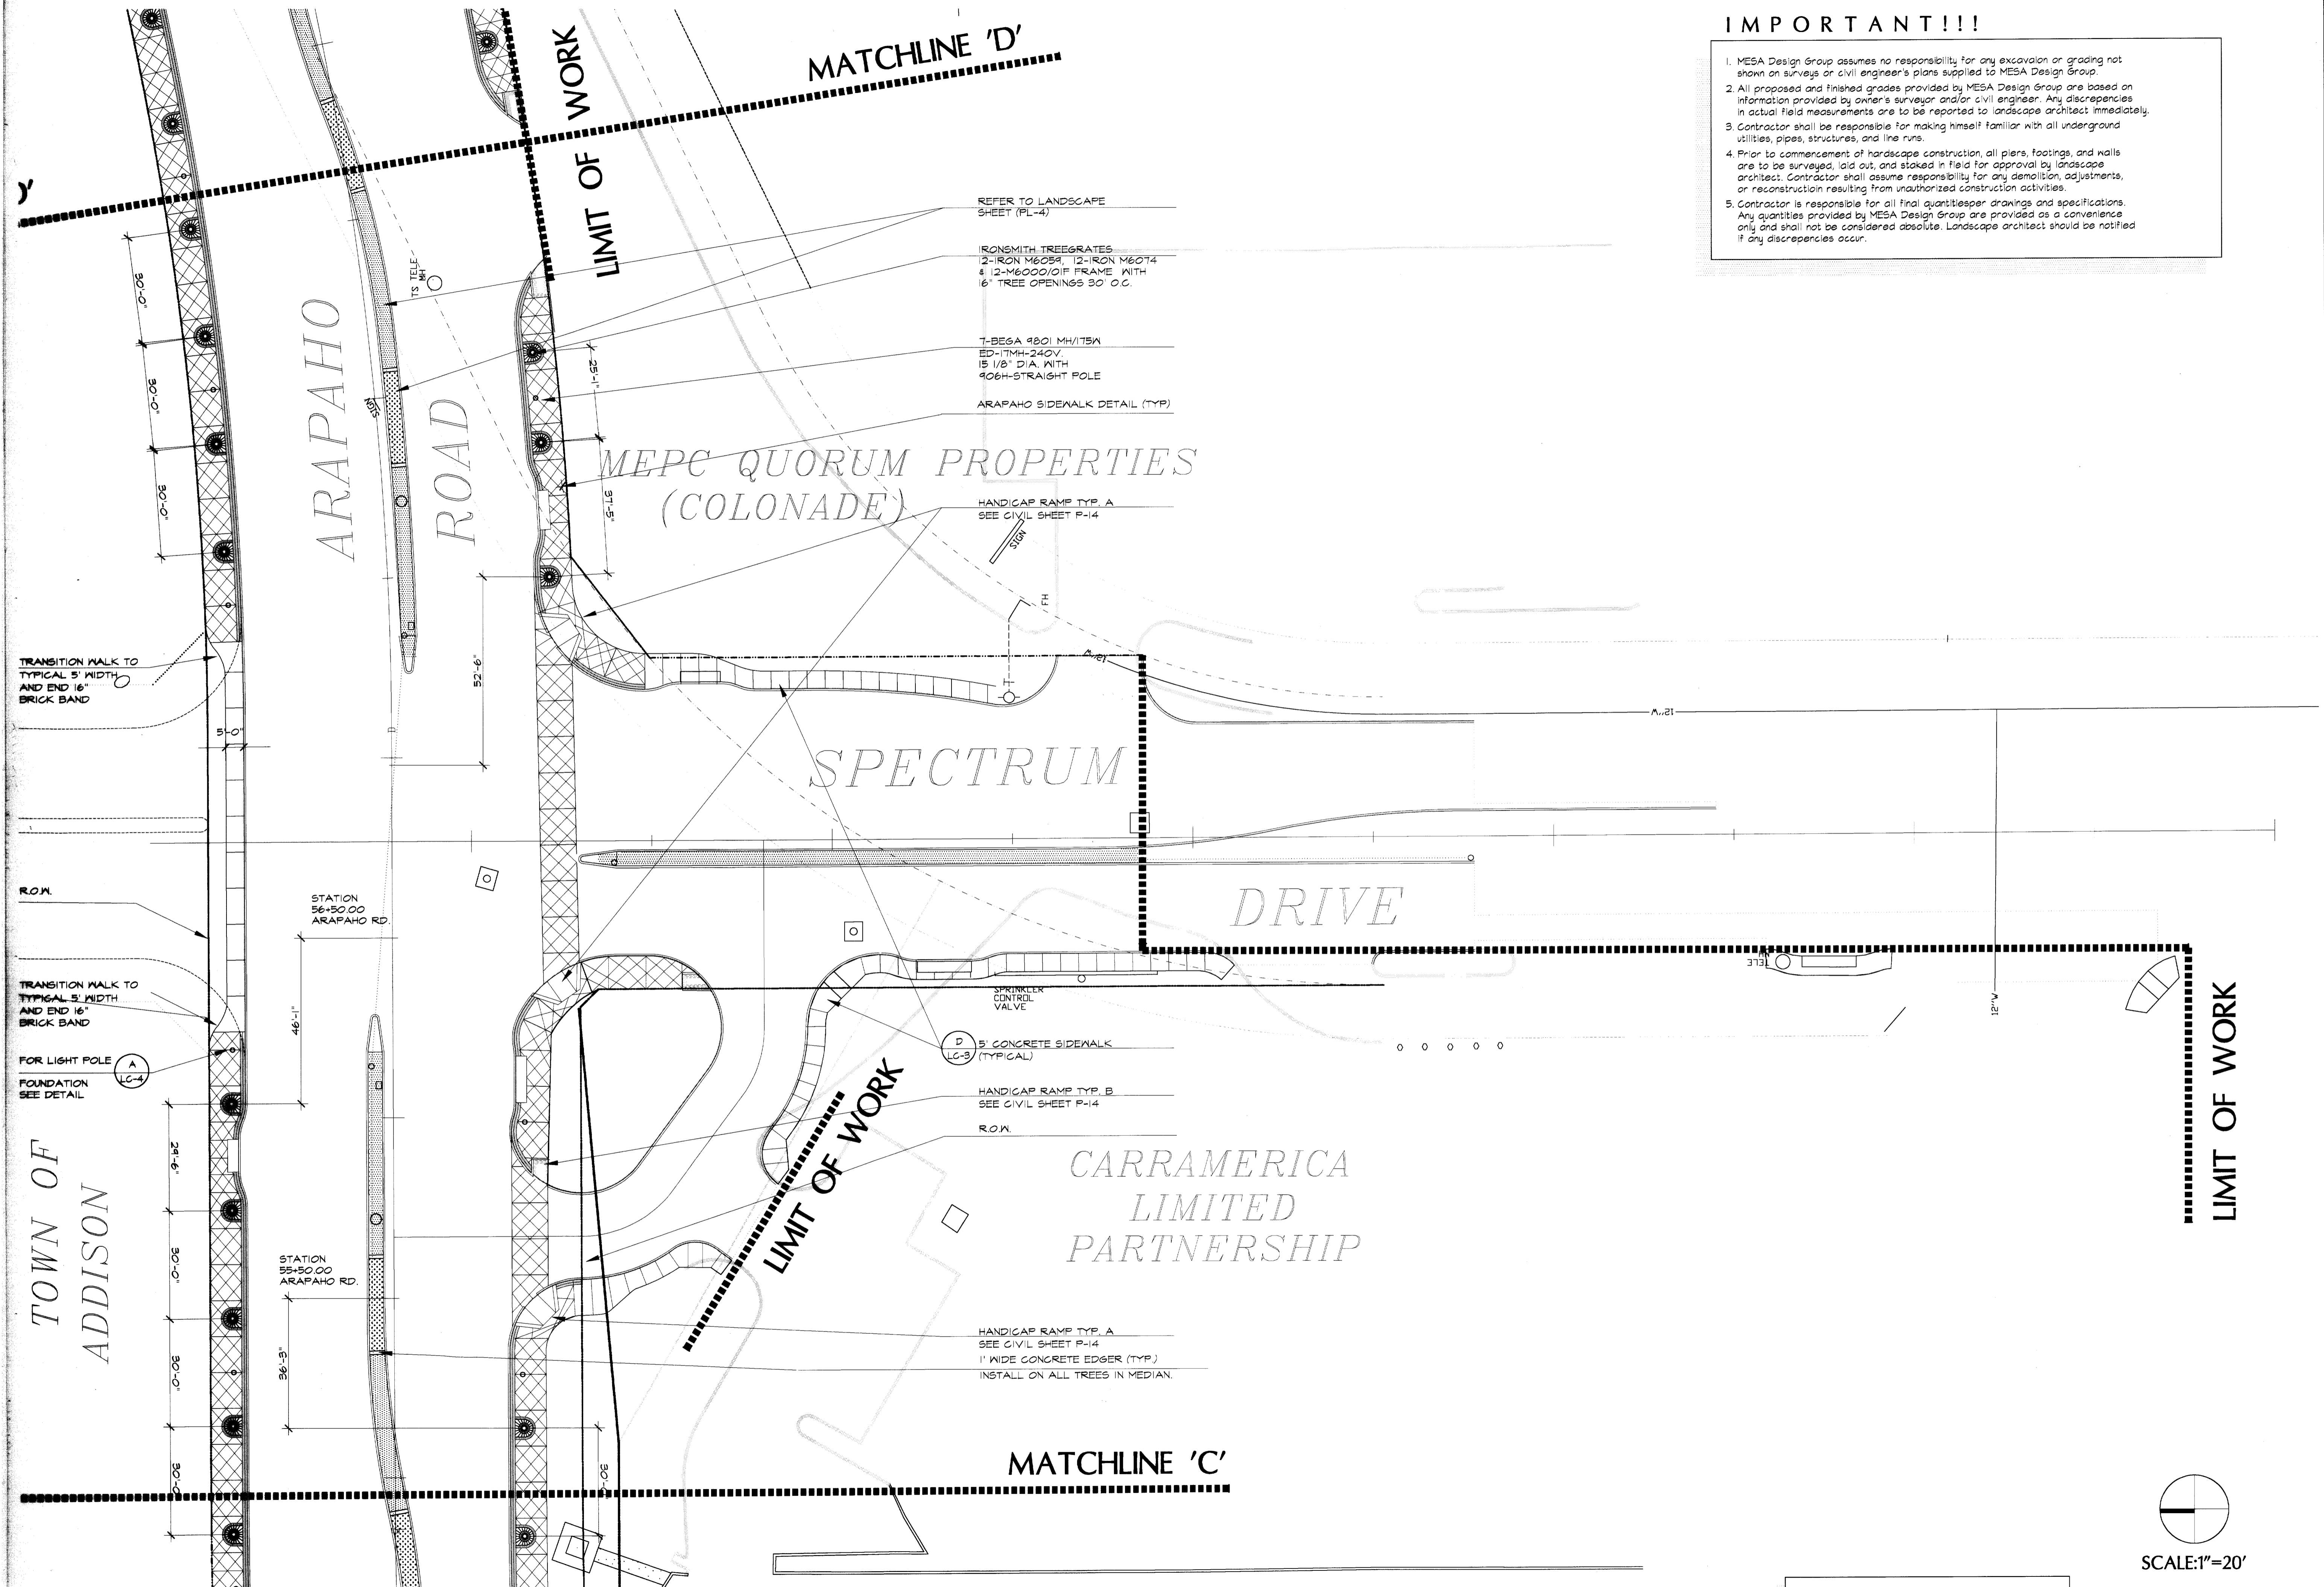

Revisions

No.	Date	Item
△	03/10/98	CITY REVISIONS AS LISTED IN APPENDUM NO. 5

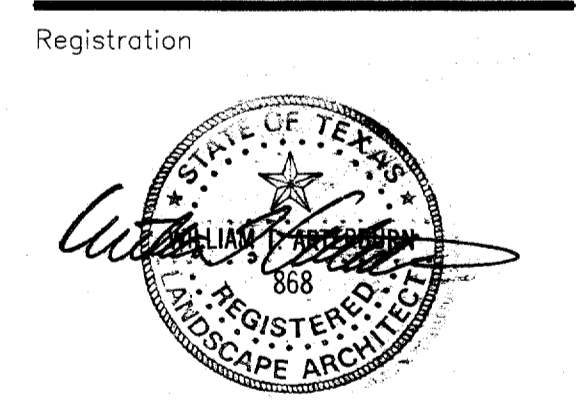


KDH/RFM
Drawn

Checked
97018 **12/12/97**
Project No. Date

Sheet Title

LAYOUT PLAN

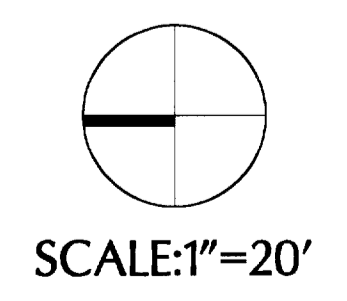


SCALE: 1"=20'

WRITTEN DIMENSIONS PREVAIL OVER SCALED DIMENSIONS.

THIS DRAWING AND THE DESIGN SHOWN IS THE PROPERTY OF THE LANDSCAPE ARCHITECT. THE REPRODUCTION, COPYING, OR USE OF THIS DRAWING WITHOUT WRITTEN CONSENT IS PROHIBITED AND ANY INFRINGEMENT WILL BE SUBJECT TO LEGAL ACTION.
© Copyright 1997 MESA Design Group

IMPORTANT!!!

1. MESA Design Group assumes no responsibility for any excavation or grading not shown on surveys or civil engineer's plans supplied to MESA Design Group.
2. All proposed and finished grades provided by MESA Design Group are based on information provided by owner's surveyor and/or civil engineer. Any discrepancies in actual field measurements are to be reported to landscape architect immediately.
3. Contractor shall be responsible for making himself familiar with all underground utilities, pipes, structures, and line runs.
4. Prior to commencement of hardscape construction, all piers, footings, and walls are to be surveyed, laid out, and staked in field for approval by landscape architect. Contractor shall assume responsibility for any demolition, adjustments, or reconstruction resulting from unauthorized construction activities.
5. Contractor is responsible for all final quantities, drawings and specifications. Any quantities provided by MESA Design Group are provided as a convenience only and shall not be considered absolute. Landscape architect should be notified if any discrepancies occur.

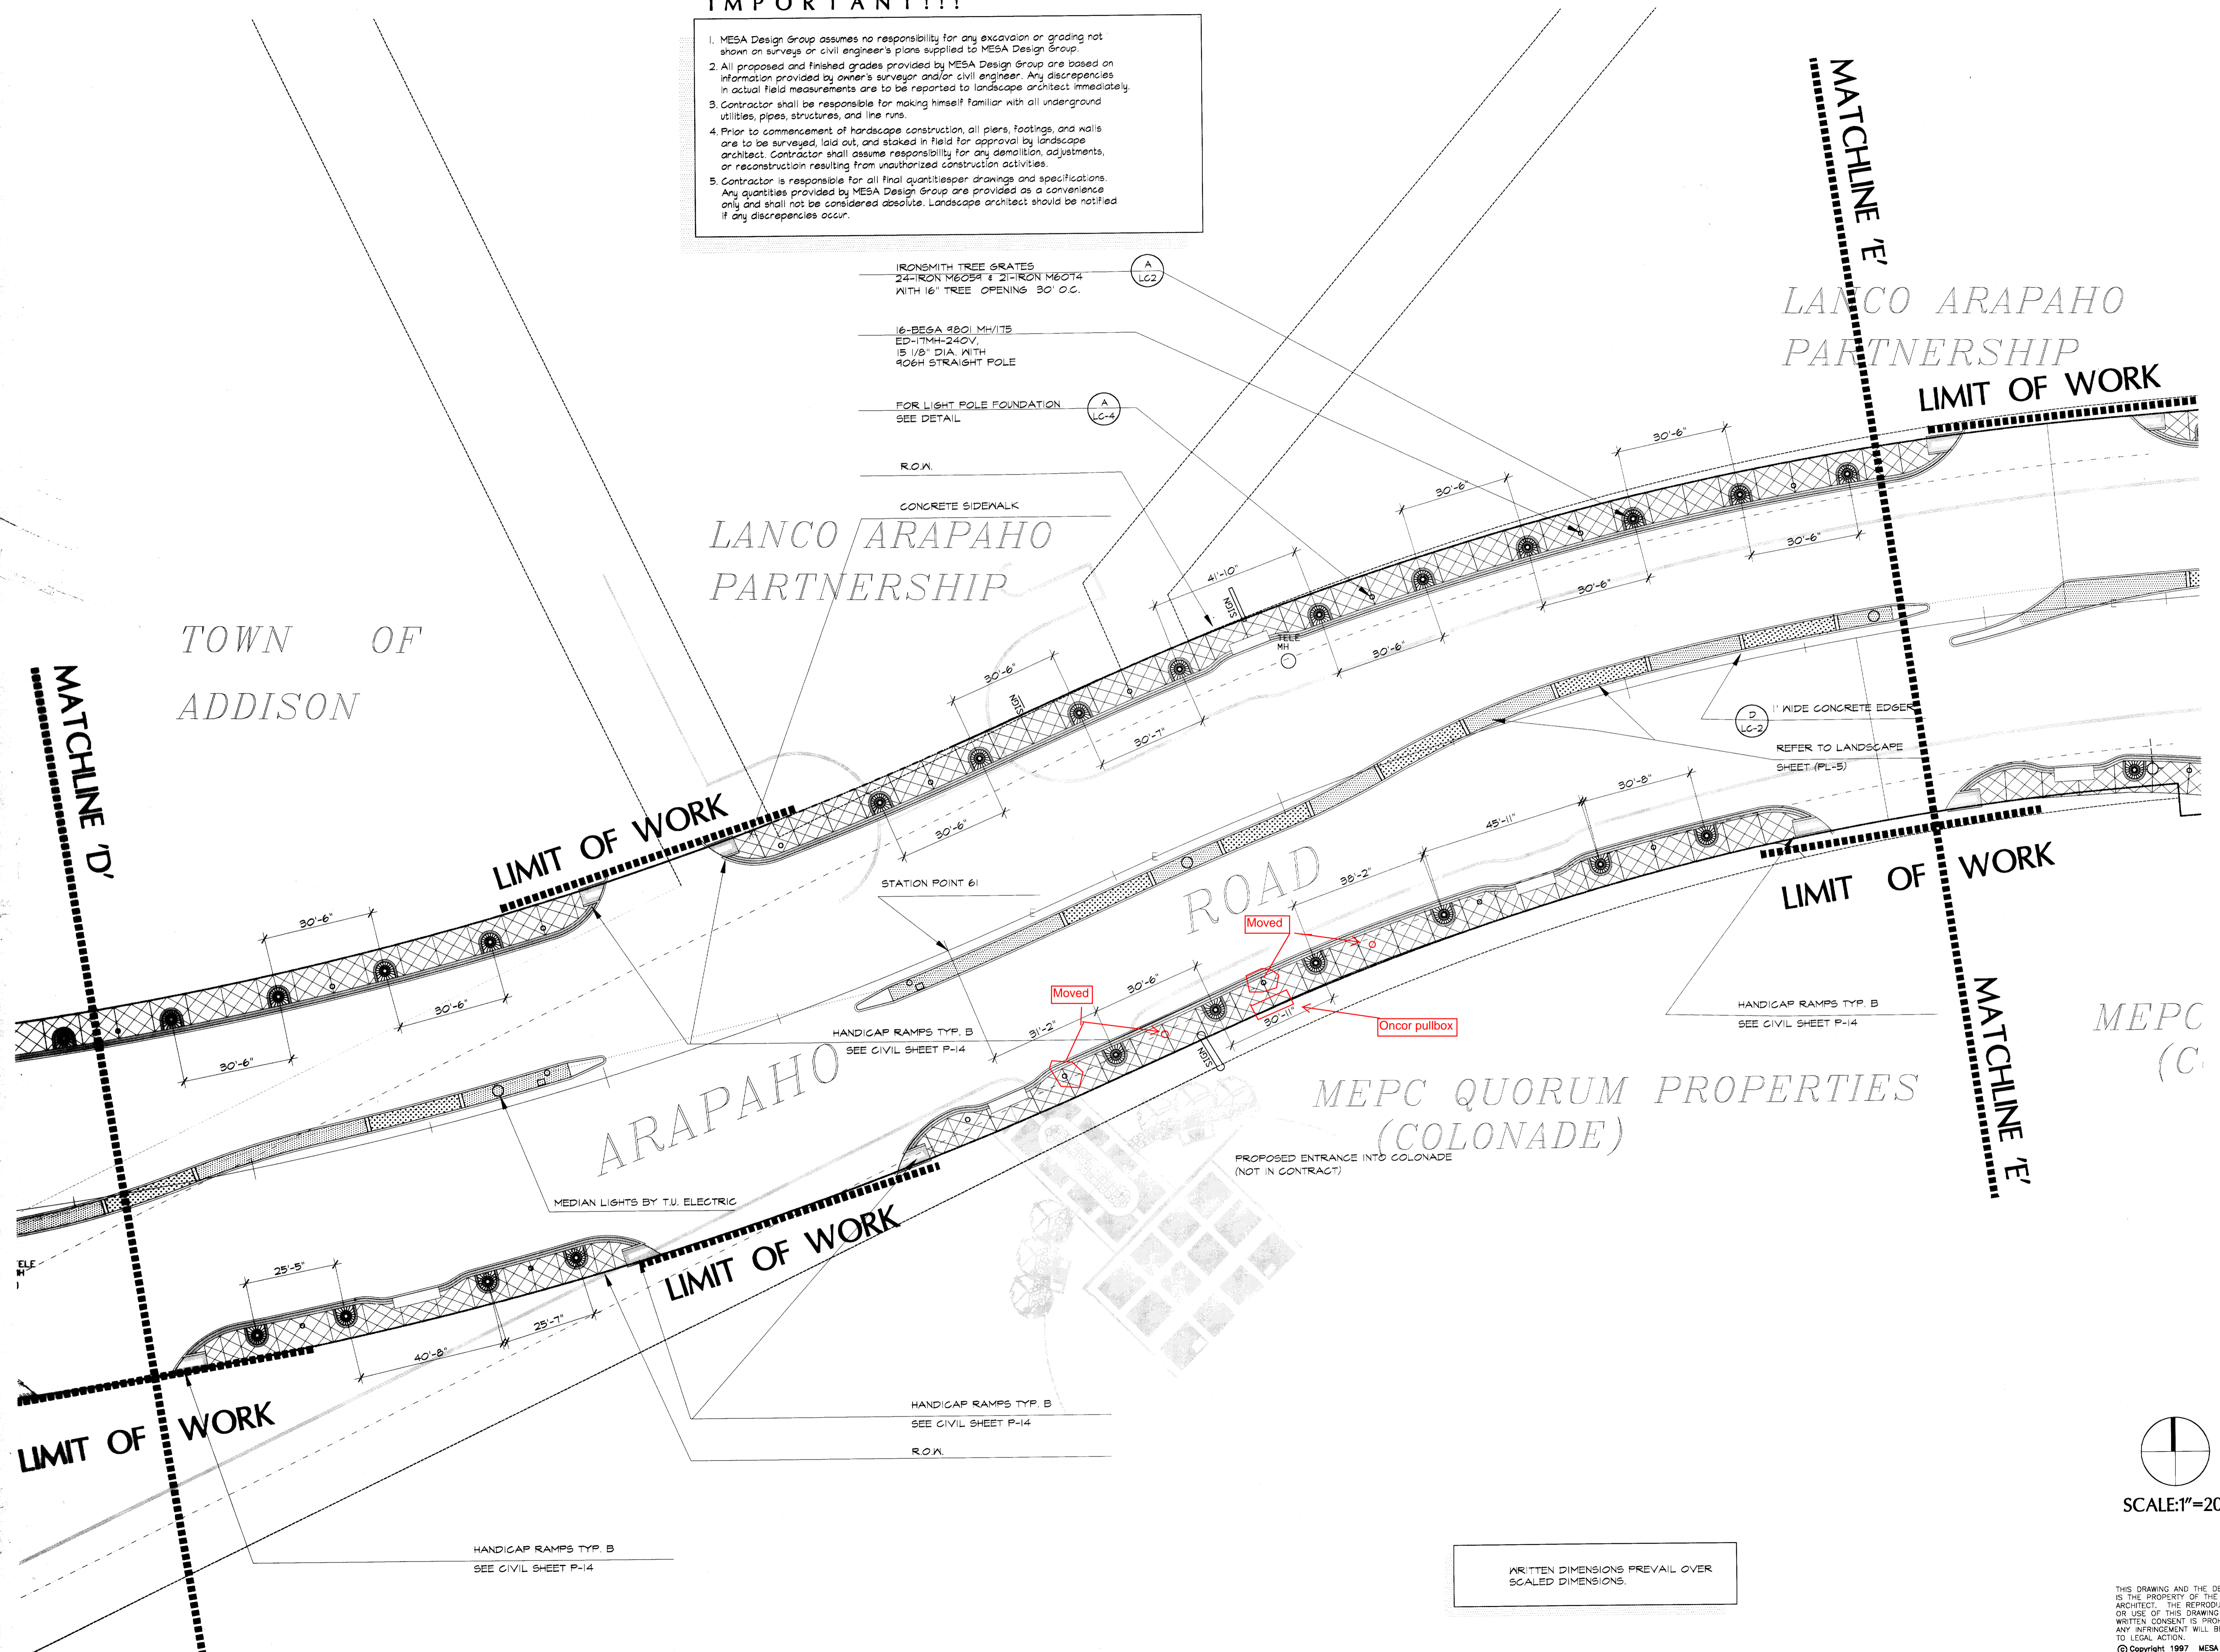


3100 McKinnon Street
Suite 905
Dallas, Texas 75201
(214) 871-0568 Fax: 871-1507

**ARAPAHO ROAD
STREETSCAPE**
CITY-OF-ADDISON, TEXAS


Revisions

No.	Date	Item
△	03/10/98	CITY REVISIONS AS LISTED IN APPENDUM NO. 5

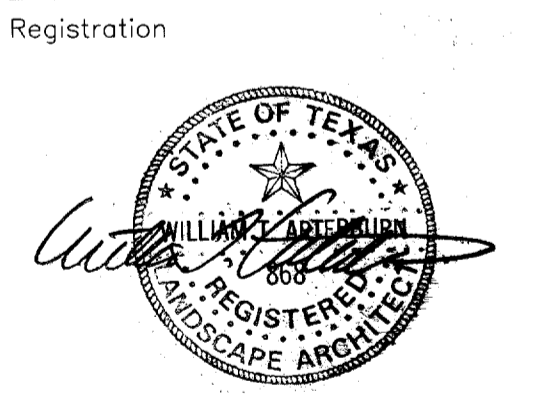

KDH/RFM
Drawn
Checked
97018 **12/12/97**
Project No. Date

Sheet Title
LAYOUT PLAN
Sheet No.
LA-5
C:\PROJECTS\97018\ADDBASE

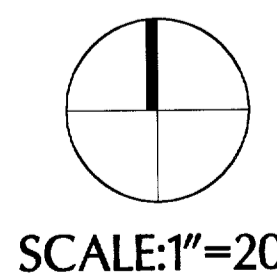

SCALE: 1"=20'

WRITTEN DIMENSIONS PREVAIL OVER SCALED DIMENSIONS.

THIS DRAWING AND THE DESIGN SHOWN IS THE PROPERTY OF THE LANDSCAPE ARCHITECT. THE REPRODUCTION, COPYING, OR USE OF THIS DRAWING WITHOUT WRITTEN CONSENT IS PROHIBITED AND ANY INFREMENT WILL BE SUBJECT TO LEGAL ACTION.
© Copyright 1997 MESA Design Group

Revisions

No.	Date	Item
1	3/10/98	CITY REVISION AS LISTED IN ADDENDUM NO. 1

Registration


DCP
Drawn
DCP
Checked
7059
Project No. 12/12/97
Date

Sheet Title
SITE-ELECTRICAL PLAN

Sheet No.
SE--1



IMPORTANT!!!

- MESA Design Group assumes no responsibility for any excavation or grading not shown on surveys or civil engineer's plans supplied to MESA Design Group.
- All proposed and finished grades provided by MESA Design Group are based on information provided by owner's surveyor and/or civil engineer. Any discrepancies in actual field measurements are to be reported to landscape architect immediately.
- Contractor shall be responsible for making himself familiar with all underground utilities, pipes, structures, and the runs.
- Prior to commencement of landscape construction, all plans, footings, and walls are to be surveyed, laid out, and staked in field for approval by landscape architect. Contractor shall assume responsibility for any demolition, adjustments, or reconstruction resulting from unauthorised construction activities.
- Contractor is responsible for all final quantities drawings and specifications. Any quantities provided by MESA Design Group are provided as a convenience only and shall not be considered absolute. Landscape architect should be notified if any discrepancies occur.

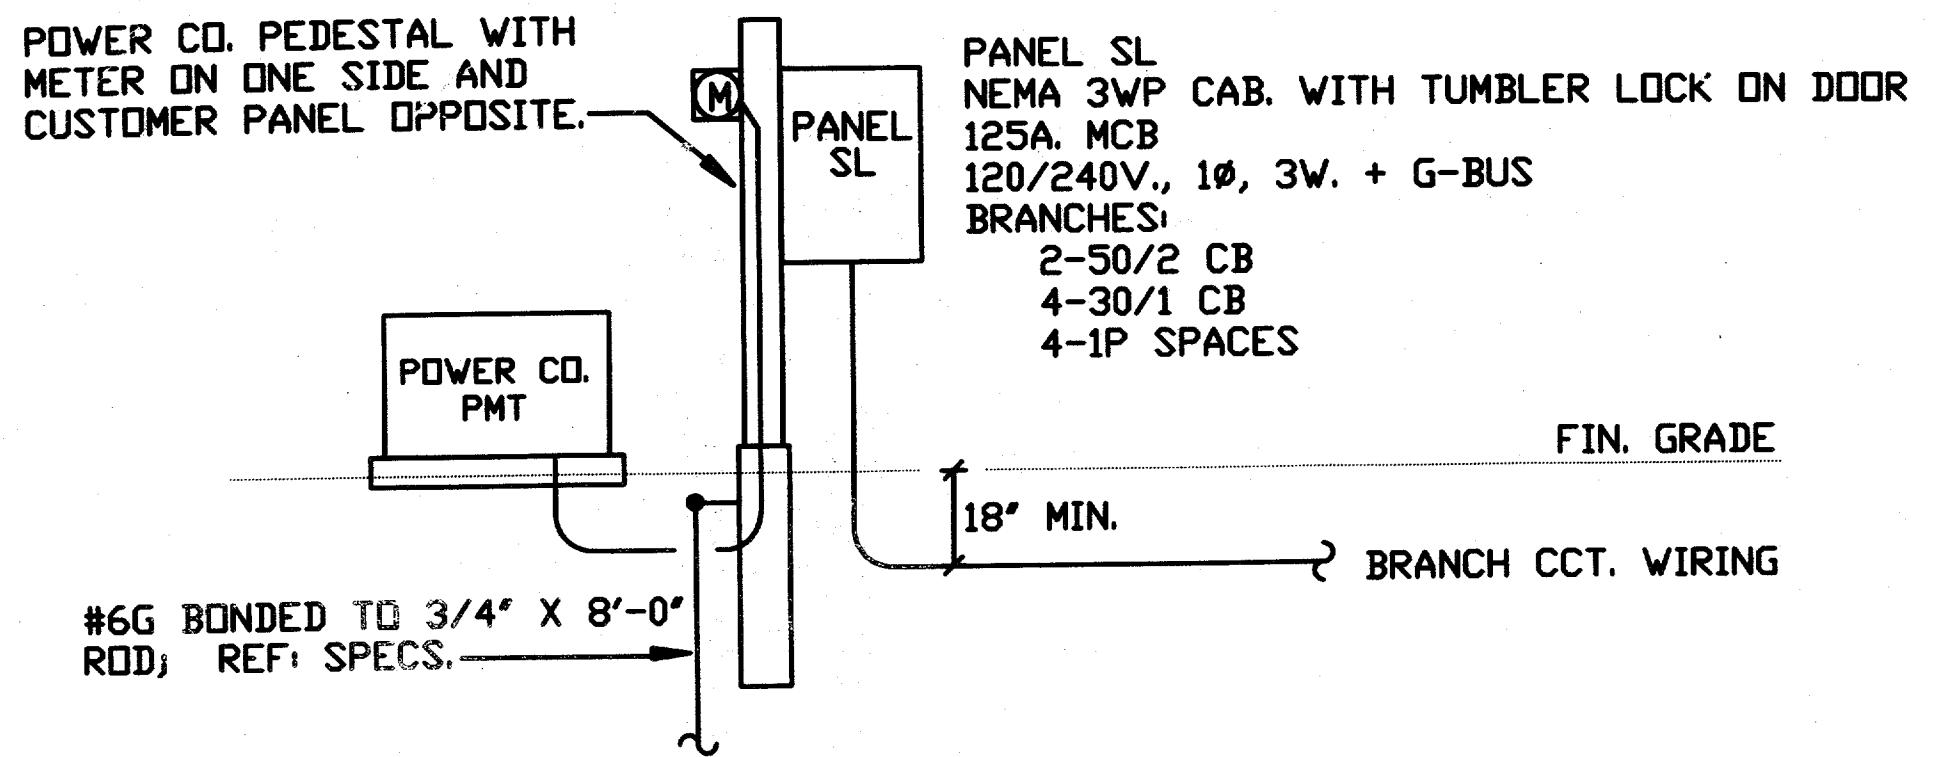


ELECTRICAL SERVICE
NTS

DALLAS AREA
RAPID TRANSIT

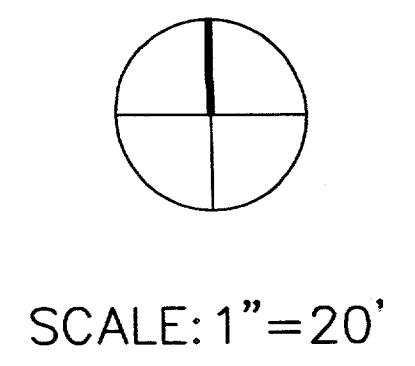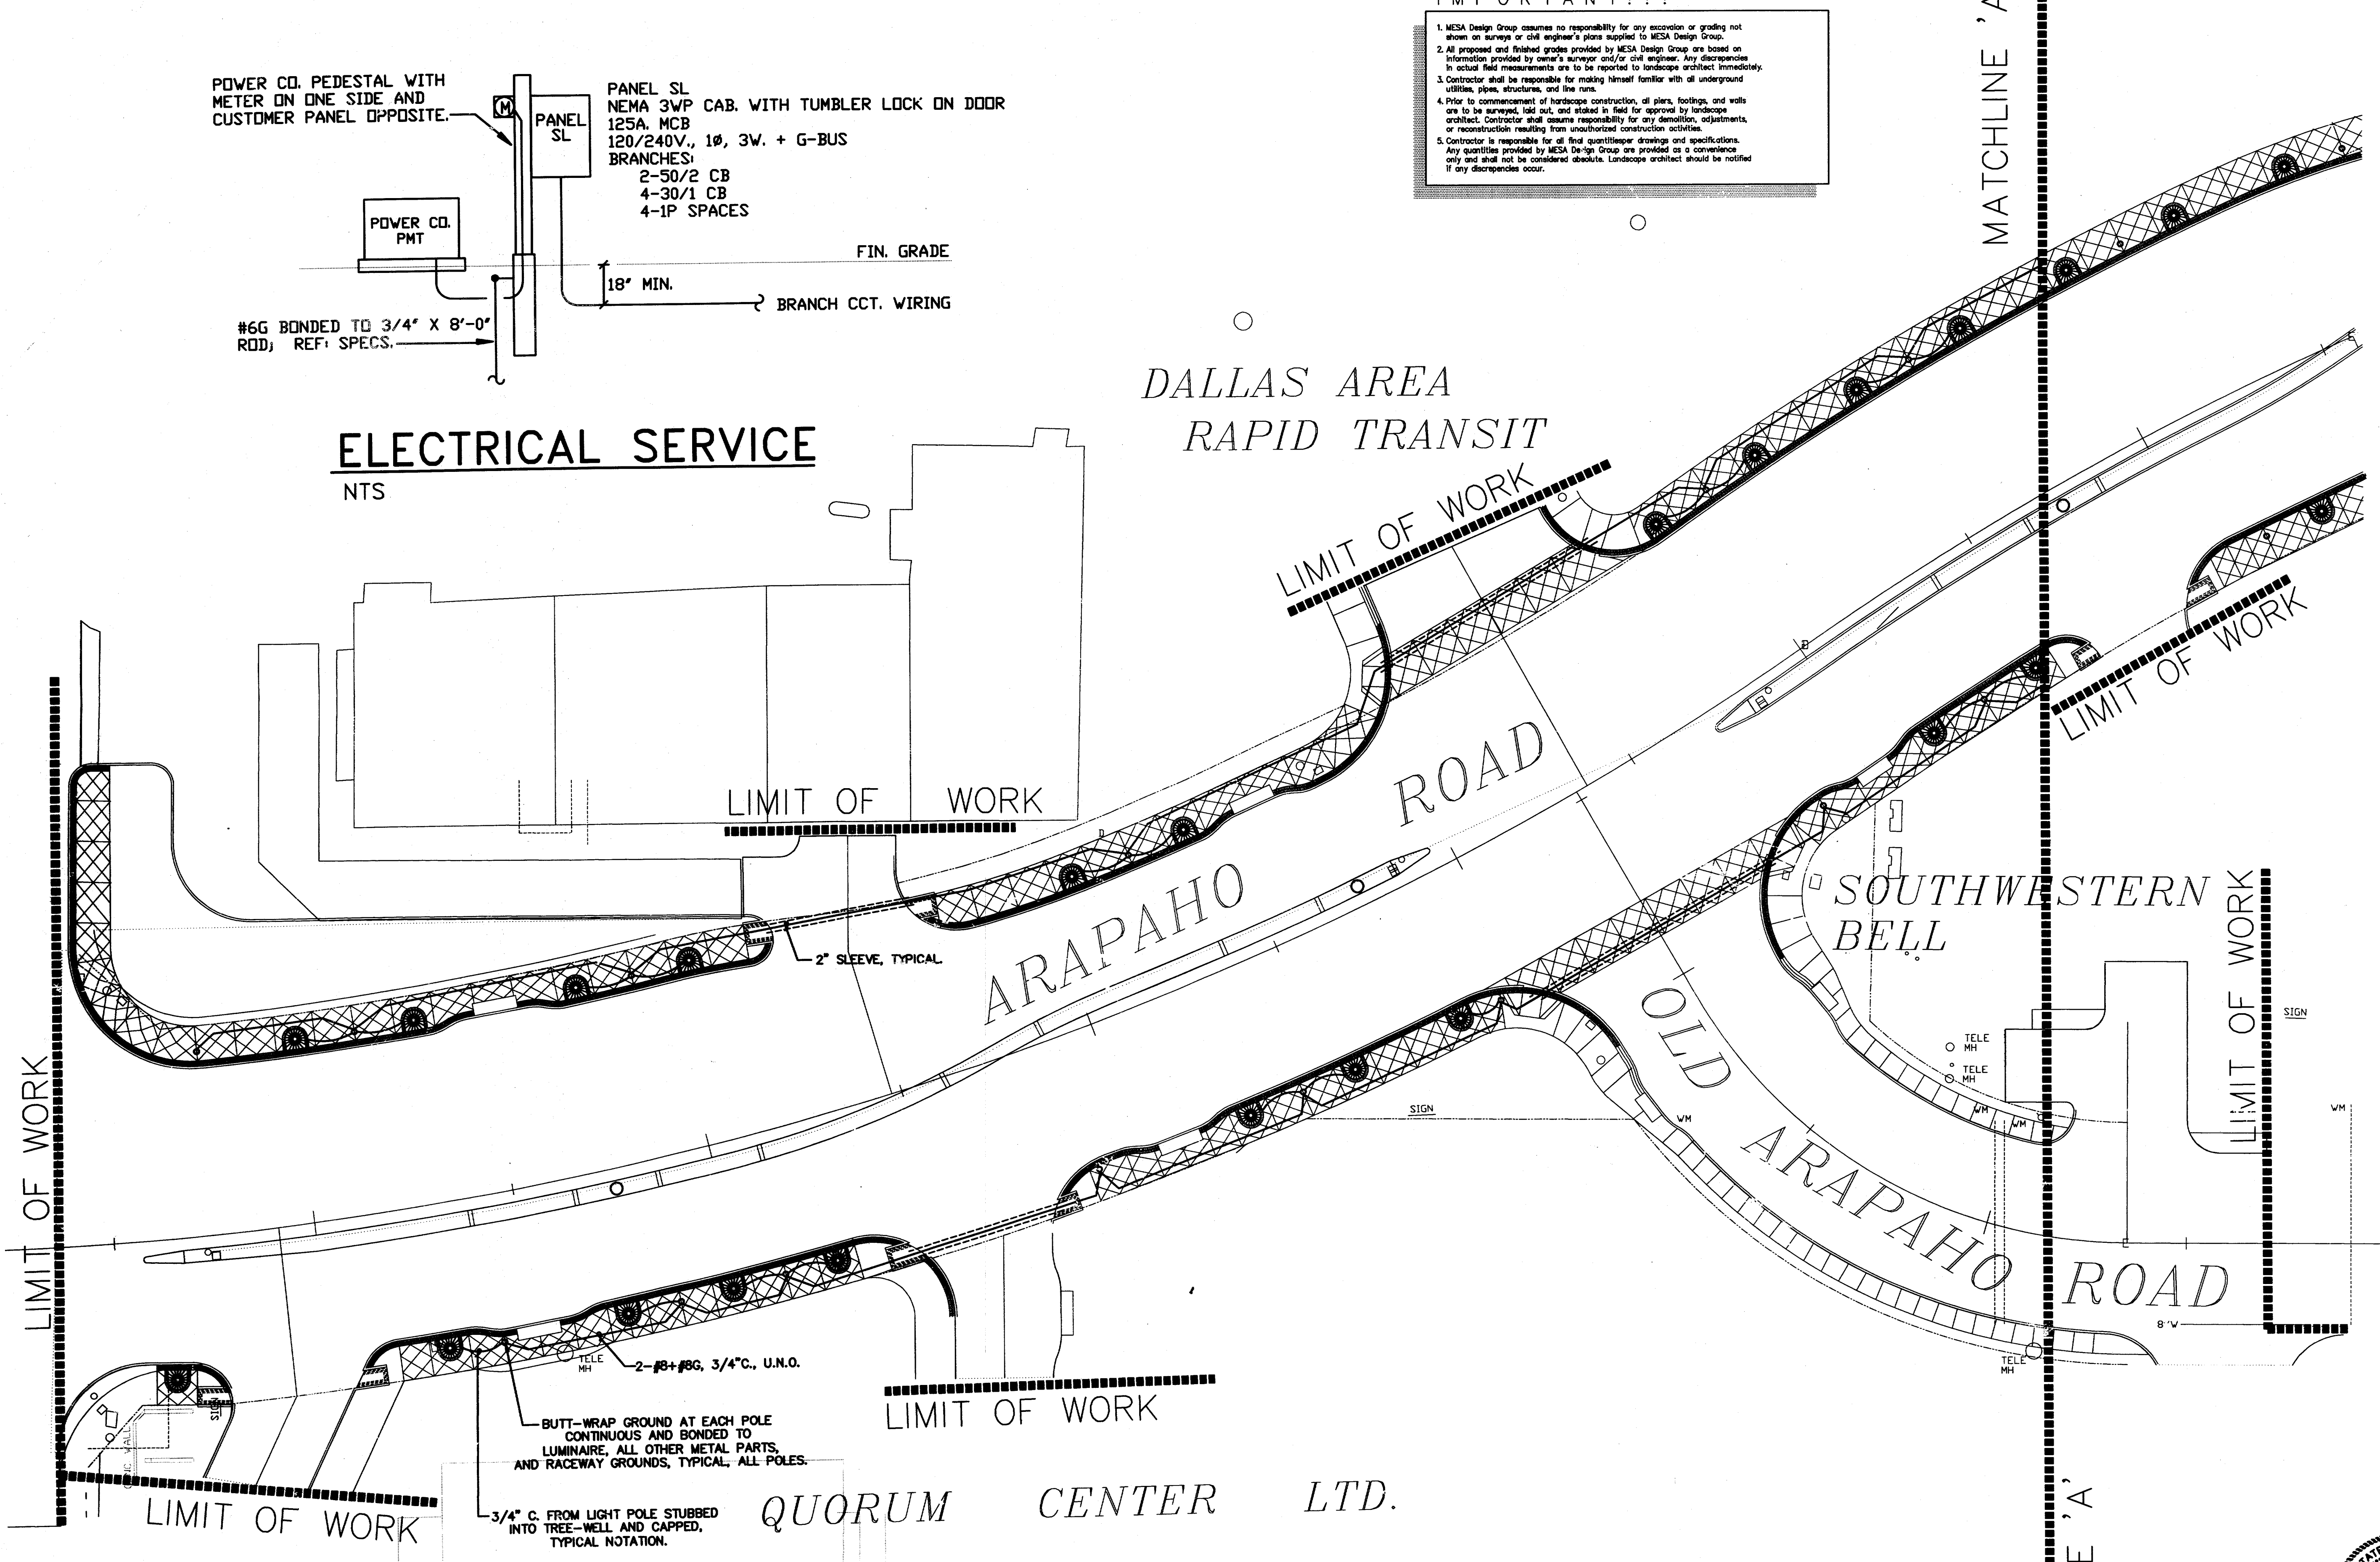

THIS DRAWING AND THE DESIGN SHOWN IS THE PROPERTY OF THE LANDSCAPE ARCHITECT. THE REPRODUCTION, COPYING, OR USE OF THIS DRAWING WITHOUT WRITTEN CONSENT IS PROHIBITED AND ANY INFRINGEMENT WILL BE SUBJECT TO LEGAL ACTION.
© Copyright 1997 MESA Design Group

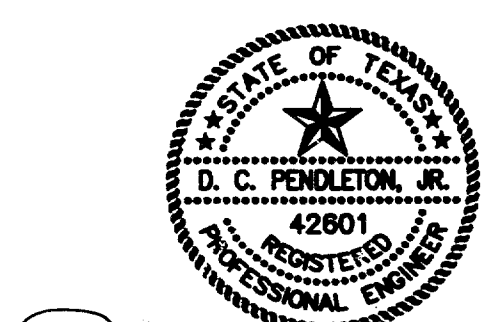

D. C. Pendleton, Jr.


THE CHOICE APPEARING ON THIS DOCUMENT IS VALID IF, AND ONLY IF, ACCOMPANIED BY AN ORIGINAL SIGNATURE OF THE REGISTRANT AND DATE OF EXECUTION. DOCUMENTS NOT BEARING EACH OF THE 3 RE-MENTIONED ITEMS SHALL BE CONSIDERED INCOMPLETE AND SHALL NOT BE USED FOR CONSTRUCTION, PERMIT, OR BIDDING PURPOSES.

PENDLETON ENGINEERS
DESIGN CONSULTANTS
11615 FOREST CENTRAL, STE 101 LBI, DALLAS TEXAS 75243
214 341 2040 FAX: 214 341 4152

IMPORTANT!!!



1. MESA Design Group assumes no responsibility for any section or grading not shown on surveys or civil engineer's plans supplied to MESA Design Group.
2. All proposed and finished grades provided by MESA Design Group are based on information provided by owner's surveyor and/or civil engineer. Any discrepancies in actual field measurements are to be reported to landscape architect immediately.
3. Contractor shall be responsible for making himself familiar with all underground utilities, pipes, structures, and fire lines.
4. Prior to commencement of landscape construction, all plans, footings, and walls are to be surveyed, laid out, and staked in field for approval by landscape architect. Contractor shall assume responsibility for any demolition, adjustments, or reconstruction resulting from unauthorized construction activities.
5. Contractor is responsible for all final quantities drawings and specifications. Any quantities provided by MESA Design Group are provided as a convenience only and shall not be considered absolute. Landscape architect should be notified if any discrepancies occur.

DALLAS AREA RAPID TRANSIT

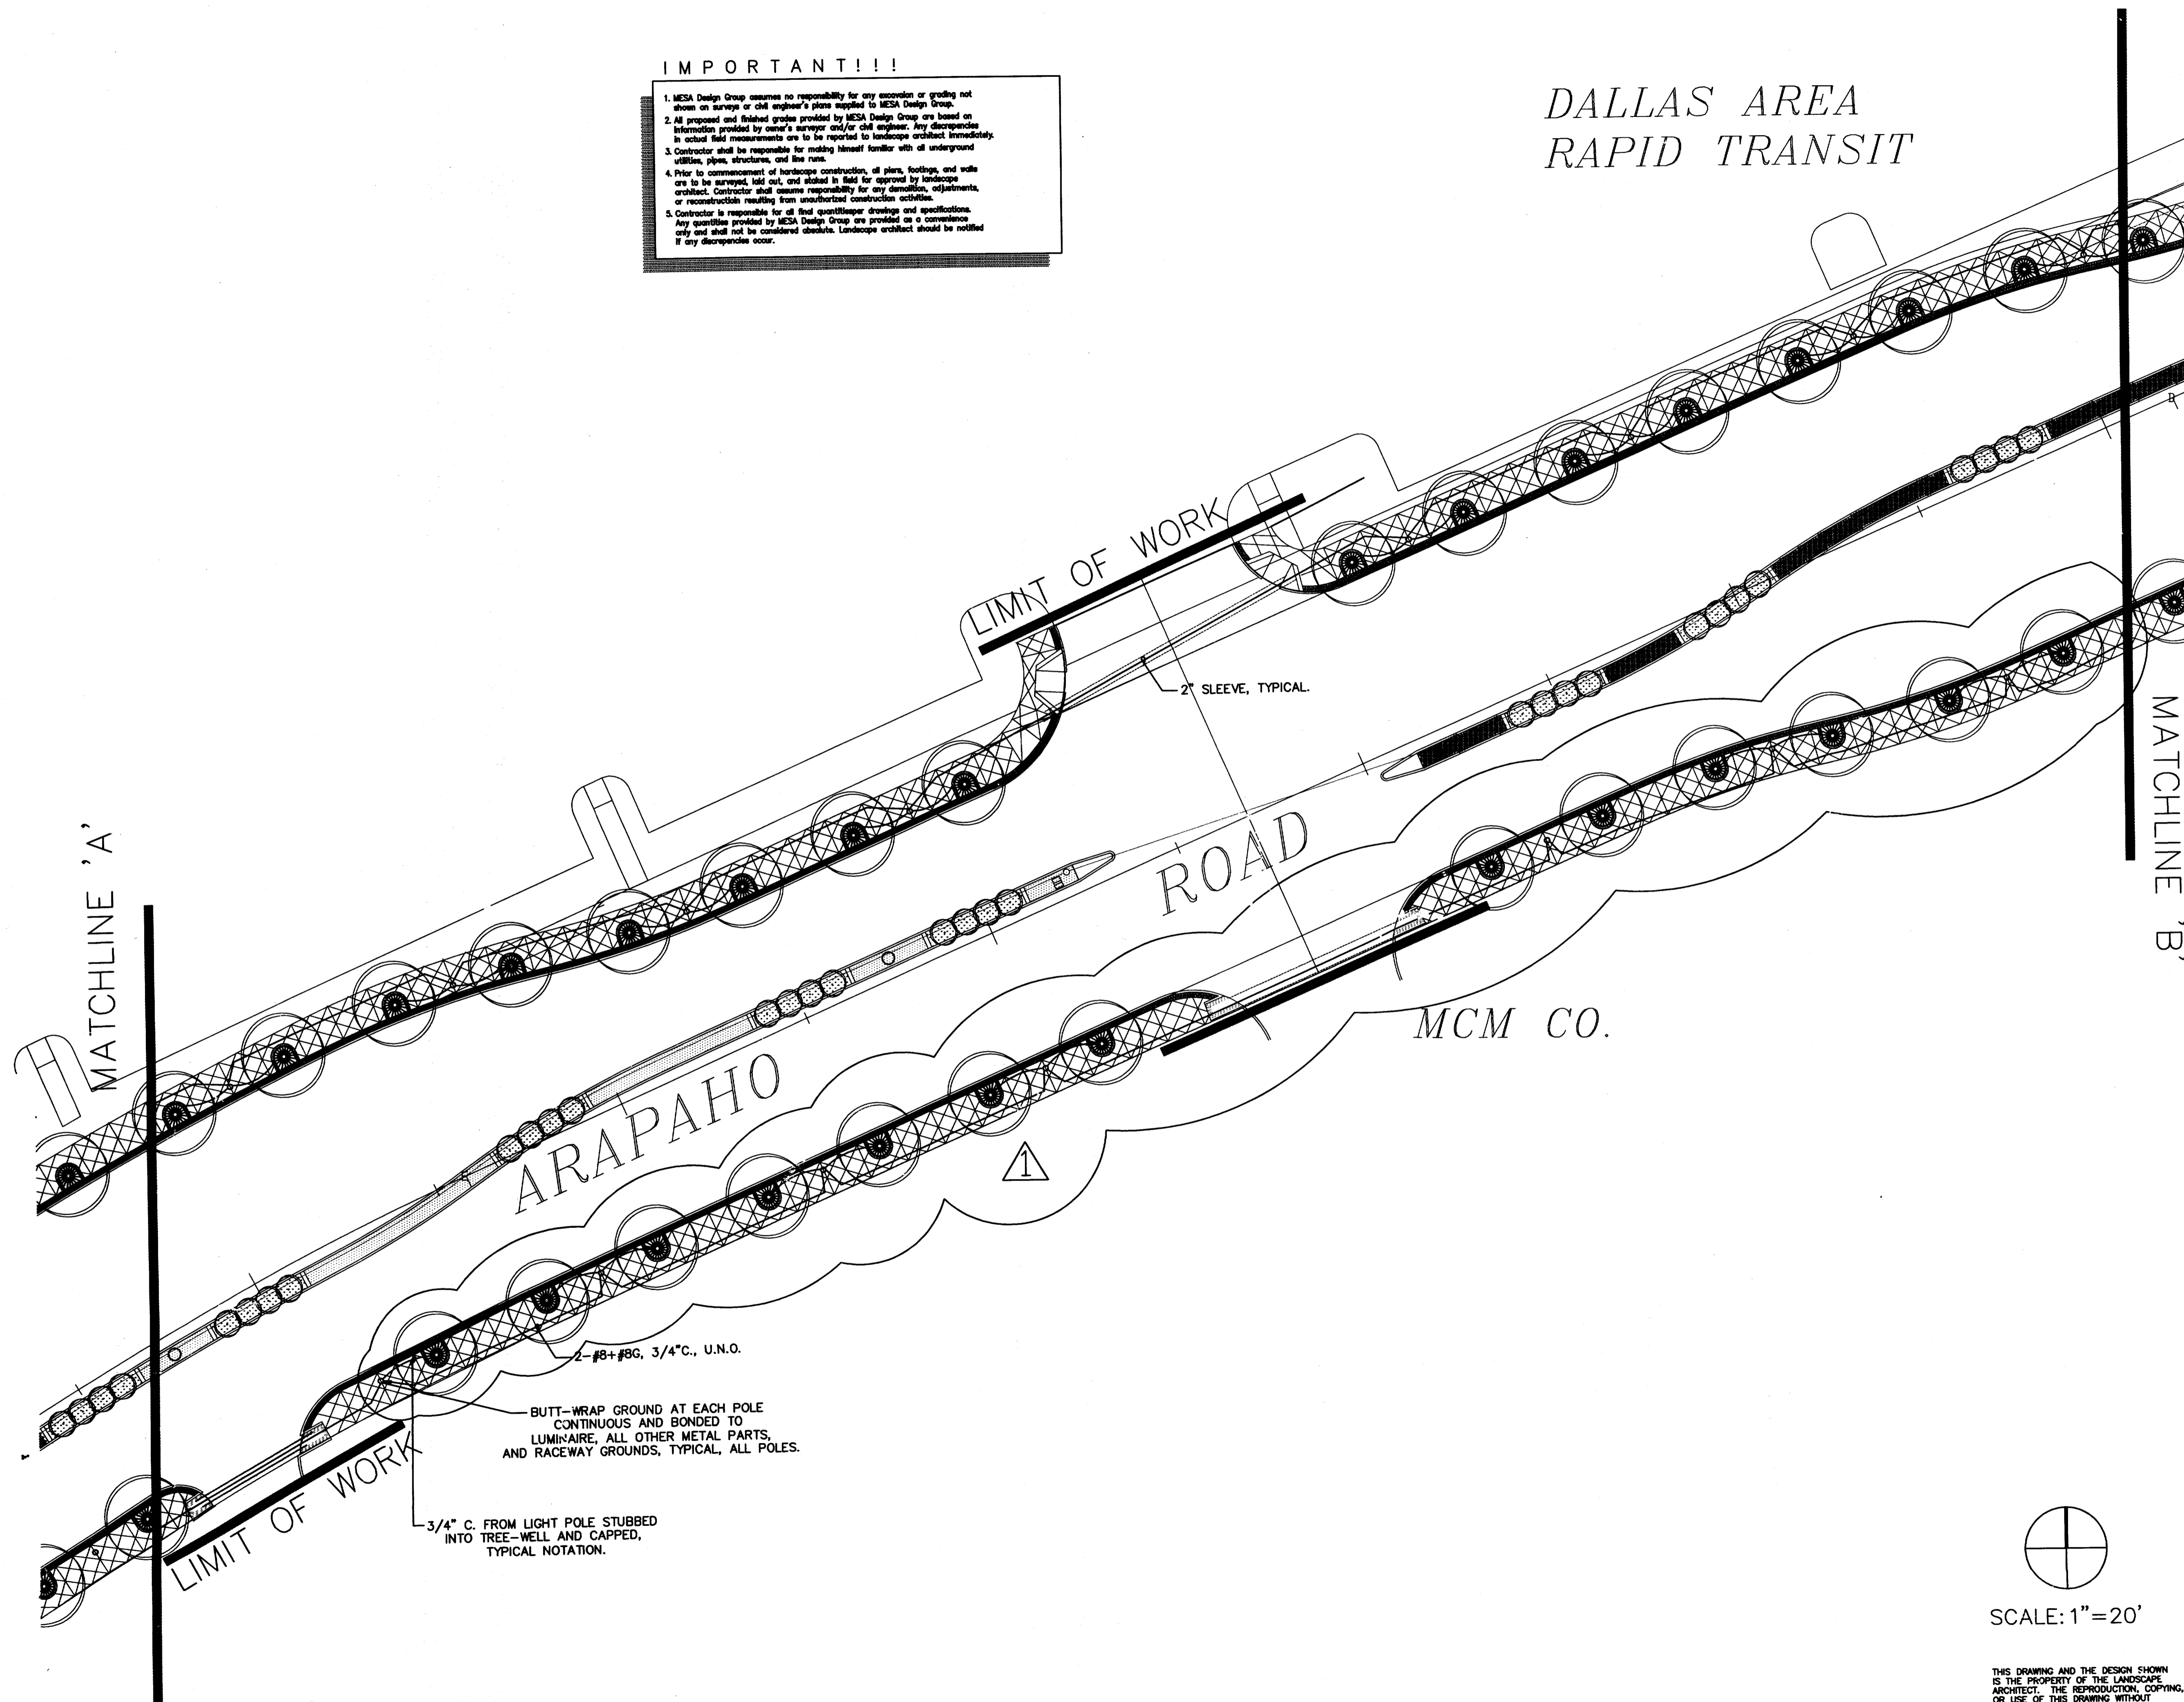

2-#8+#8G, 3/4" C., U.N.O.
BUTT-WRAP GROUND AT EACH POLE CONTINUOUS AND BONDED TO LUMINAIRE, ALL OTHER METAL PARTS, AND RACEWAY GROUNDS, TYPICAL, ALL POLES.

3/4" C. FROM LIGHT POLE STUBBED INTO TREE-WELL AND CAPPED, TYPICAL NOTATION.

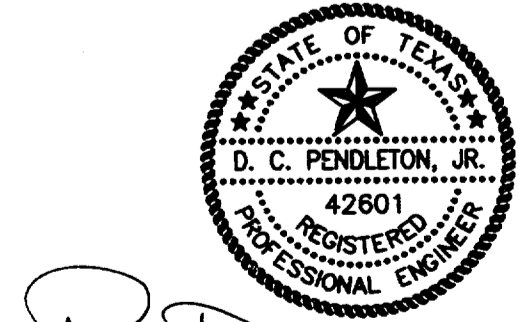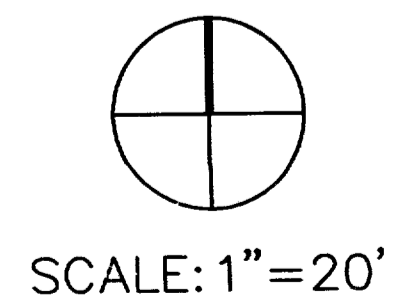

D. C. Pendleton, Jr. 20 MAR 98
THE CADSEAL APPEARING ON THIS DOCUMENT IS VALID, AND ONLY IF ACCOMPANIED BY AN ORIGINAL SIGNATURE OF THE REGISTRANT AND DATE OF EXECUTION. DOCUMENTS MAY BEARING EACH OF THE 3 AFOREMENTIONED ITEMS SHALL BE CONSIDERED INCOMPLETE AND SHALL NOT BE USED FOR CONSTRUCTION, PERMIT, OR BIDDING PURPOSES.

PEROLETON ENGINEERS
DESIGN CONSULTANTS
11815 FOREST CENTRAL, SUITE 101, LBI, DALLAS, TEXAS 75244
214 341 2040 FAX: 214 341 4144

SOUTHWESTERN
BELL

3100 McKinnon Street
Suite 905
Dallas, Texas 75201
(214) 871-0568 Fax: 871-1507

ARAPAHO ROAD
STREETSCAPE
CITY-OF-ADDISON, TEXAS

Revisions		
No.	Date	Item
▲	3/10/98	CITY REVISION AS LISTED IN ADDENDUM NO.5


Registration
Drawn: DCP
Checked: DCP
Project No: 7059
Date: 12/12/97
Sheet Title

SITE-ELECTRICAL PLAN

Sheet No. SE-2

IMPORTANT!!!

1. MESA Design Group assumes no responsibility for any excavation or grading not shown on survey or civil engineer's plans supplied to MESA Design Group.
2. All proposed and finished grades provided by MESA Design Group are based on information provided by owner's surveyor and/or civil engineer. Any discrepancies in actual field measurements are to be reported to landscape architect immediately.
3. Contractor shall be responsible for making himself familiar with all underground utilities, pipes, structures, and line runs.
4. Prior to commencement of hardscape construction, all piers, footings, and walls are to be surveyed, laid out, and staked in field for approval by landscape architect. Contractor shall assume responsibility for any demolition, adjustments, or reconstruction resulting from unauthorized construction activities.
5. Contractor is responsible for all final quantities drawings and specifications. Any quantities provided by MESA Design Group are provided as a convenience only and shall not be considered absolute. Landscape architect should be notified if any discrepancies occur.

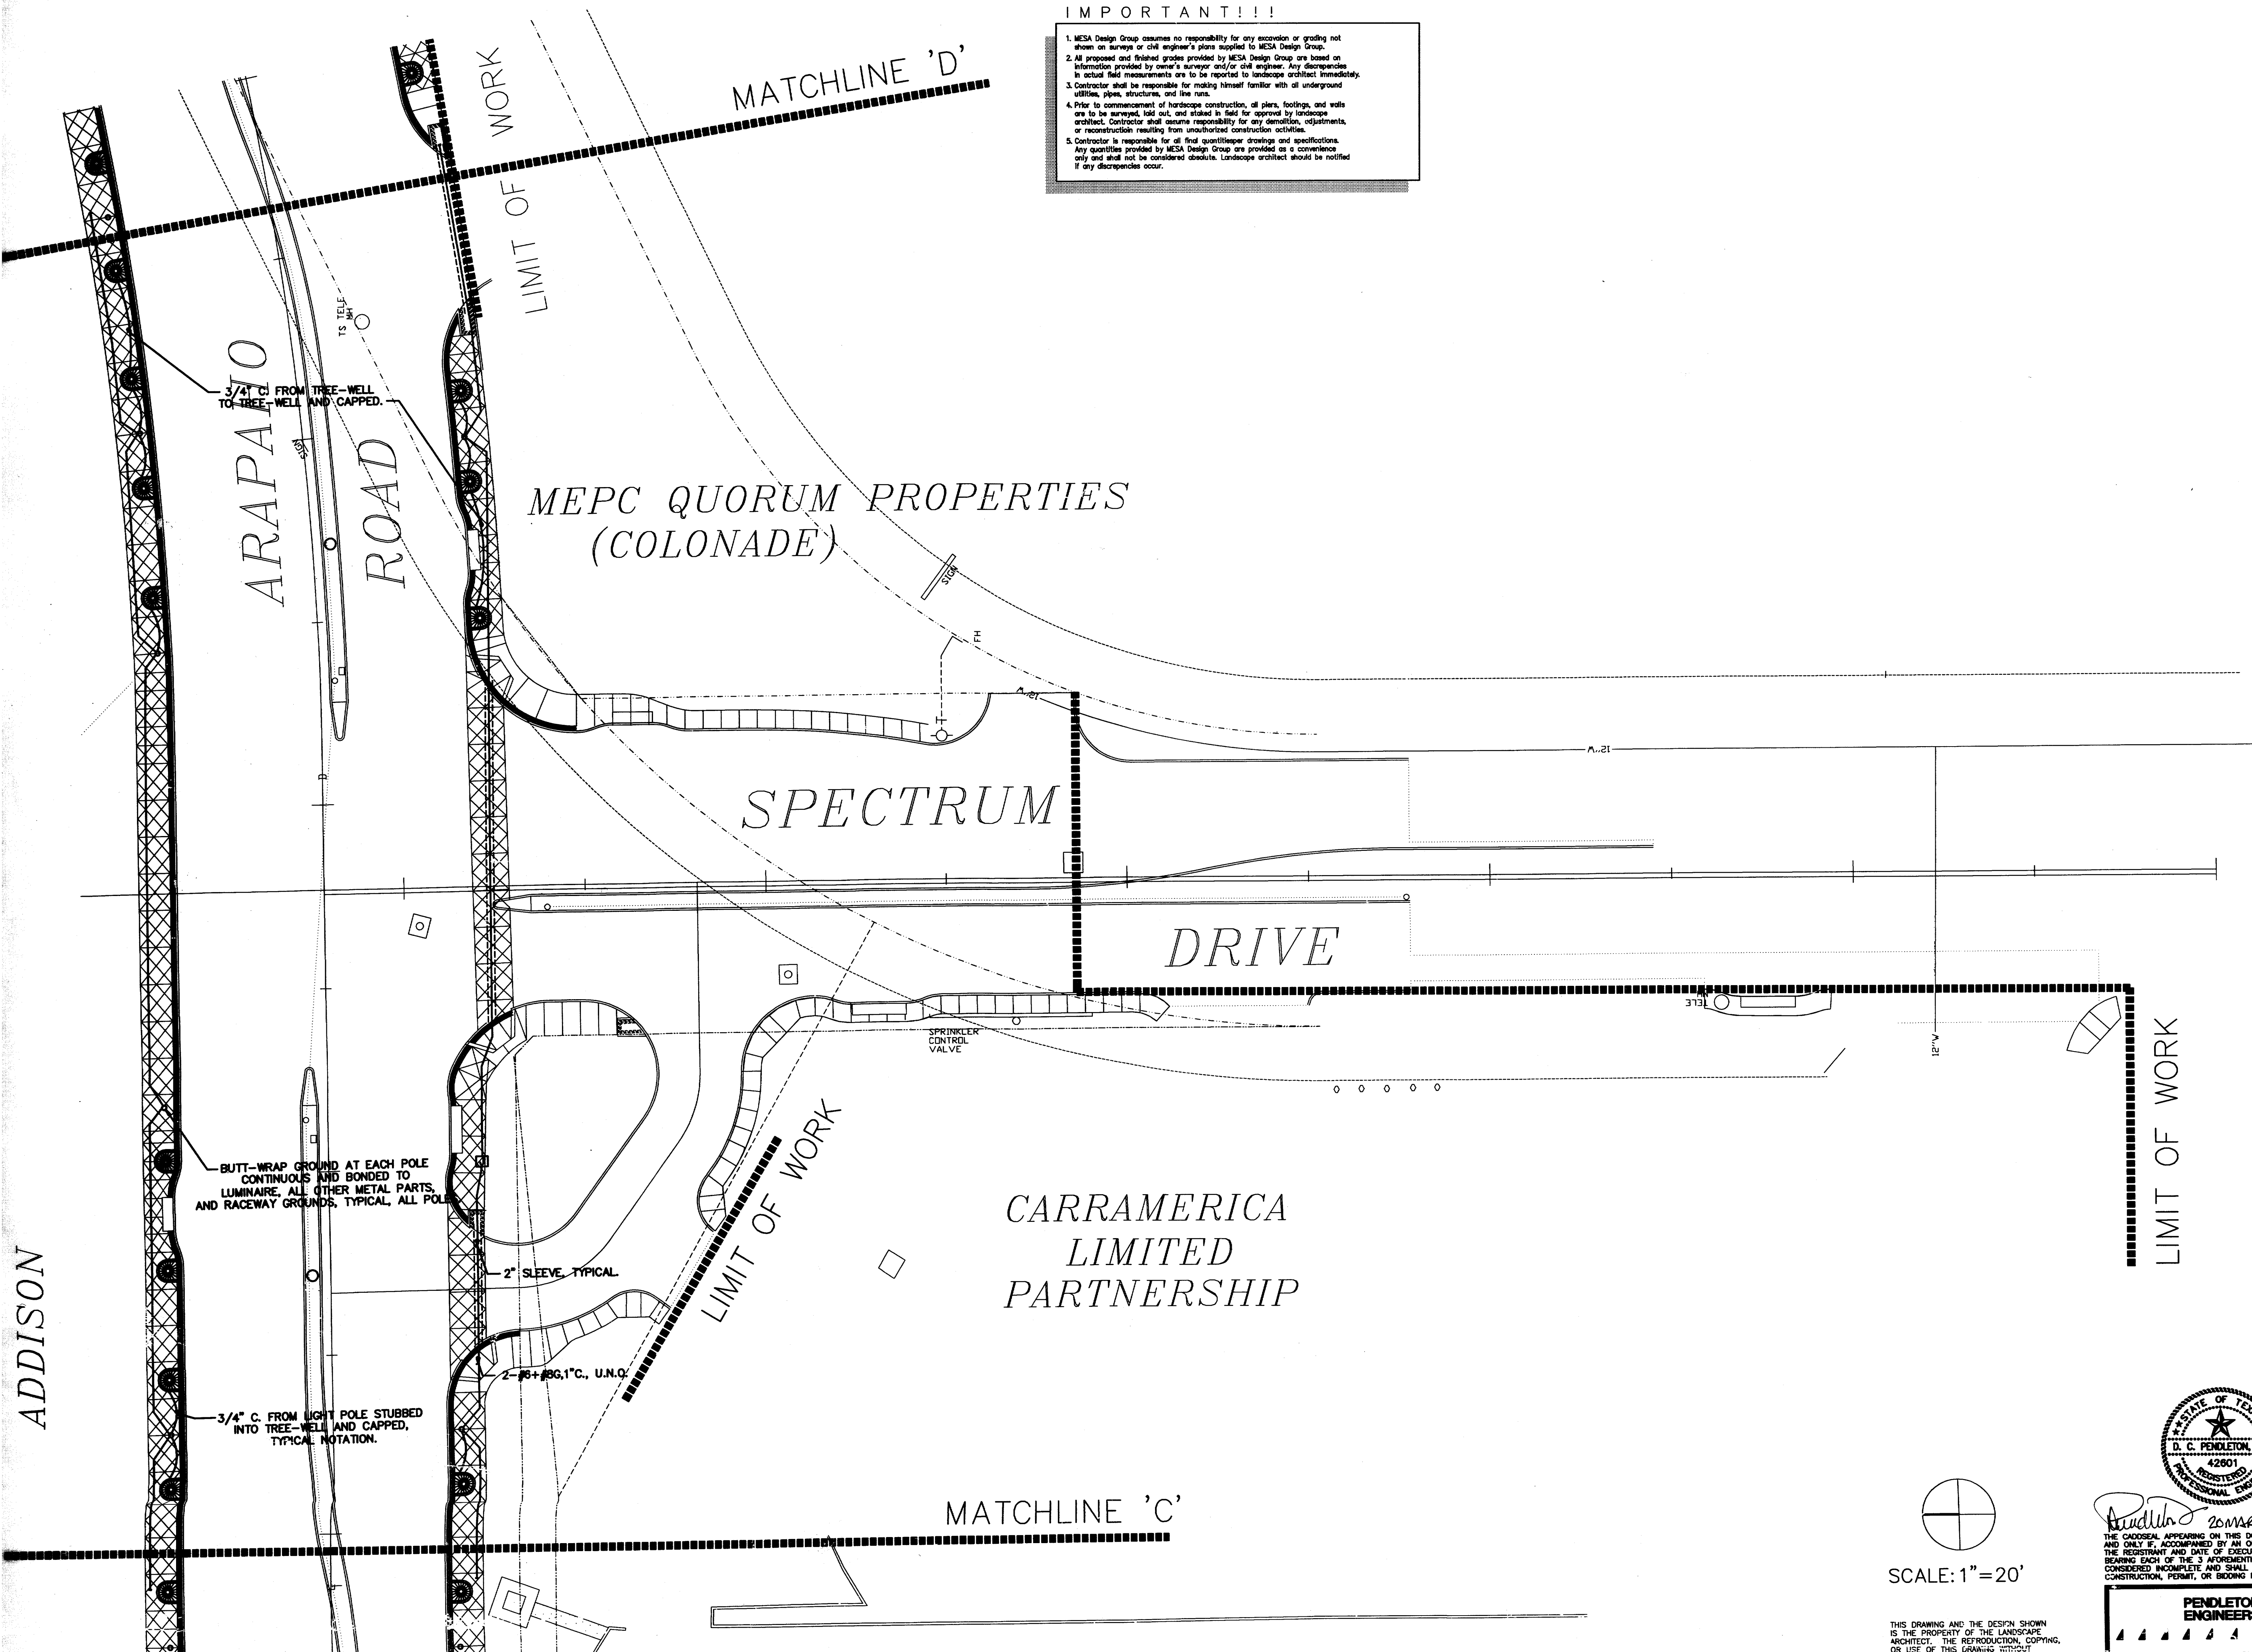

Revisions

No.	Date	Item
▲ 3/10/98		CITY REVISION AS LISTED IN ADDENDUM NO. 5.

Registration


DCP	Drawn
DCP	Checked
7059	12/12/97
Project No.	Date

Sheet Title

SITE-ELECTRICAL PLAN

Sheet No.

SE-4

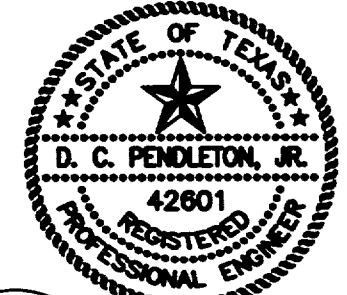

D. C. Pendleton, Jr.
20MS293
THE CADSEAL APPEARING ON THIS DOCUMENT IS VALID IF, AND ONLY IF, ACCOMPANIED BY AN ORIGINAL SIGNATURE OF THE REGISTRANT AND DATE OF EXECUTION. DOCUMENTS NOT BEARING EACH OF THE 3 AFORESAID ITEMS SHALL BE CONSIDERED INCOMPLETE AND SHALL NOT BE USED FOR CONSTRUCTION, PERMIT, OR BIDDING PURPOSES.


SCALE: 1" = 20'

PENDELTON ENGINEERS
DESIGN CONSULTANTS
11815 FOREST LENTAL, SUITE 101 LB1 DALLAS, TEXAS 75244
214 341 2400 FAX: 214 341 4142
Copyright 1997 MESA Design Group

THIS DRAWING AND THE DESIGN SHOWN IS THE PROPERTY OF THE LANDSCAPE ARCHITECT. THE REPRODUCTION, COPYING, OR USE OF THIS DRAWING WITHOUT WRITTEN CONSENT IS PROHIBITED AND ANY INFRINGEMENT WILL BE SUBJECT TO LEGAL ACTION.

IMPORTANT!!!

1. MESA Design Group assumes no responsibility for any excavation or grading not shown on survey or civil engineer's plans supplied to MESA Design Group.
2. All proposed and finished grades provided by MESA Design Group are based on information provided by owner's surveyor and/or civil engineer. Any discrepancies in actual field measurements are to be reported to landscape architect immediately.
3. Contractor shall be responsible for making himself familiar with all underground utilities, pipes, structures, and line runs.
4. Prior to commencement of landscape construction, all piers, footings, and walls are to be surveyed, laid out, and staked in field for approval by landscape architect. Contractor shall assume responsibility for any demolition, adjustments, or reconstruction resulting from unapproved construction activities.
5. Contractor is responsible for all final quantities drawings and specifications. Any quantities provided by MESA Design Group are provided as a convenience only and shall not be considered absolute. Landscape architect should be notified if any discrepancies occur.

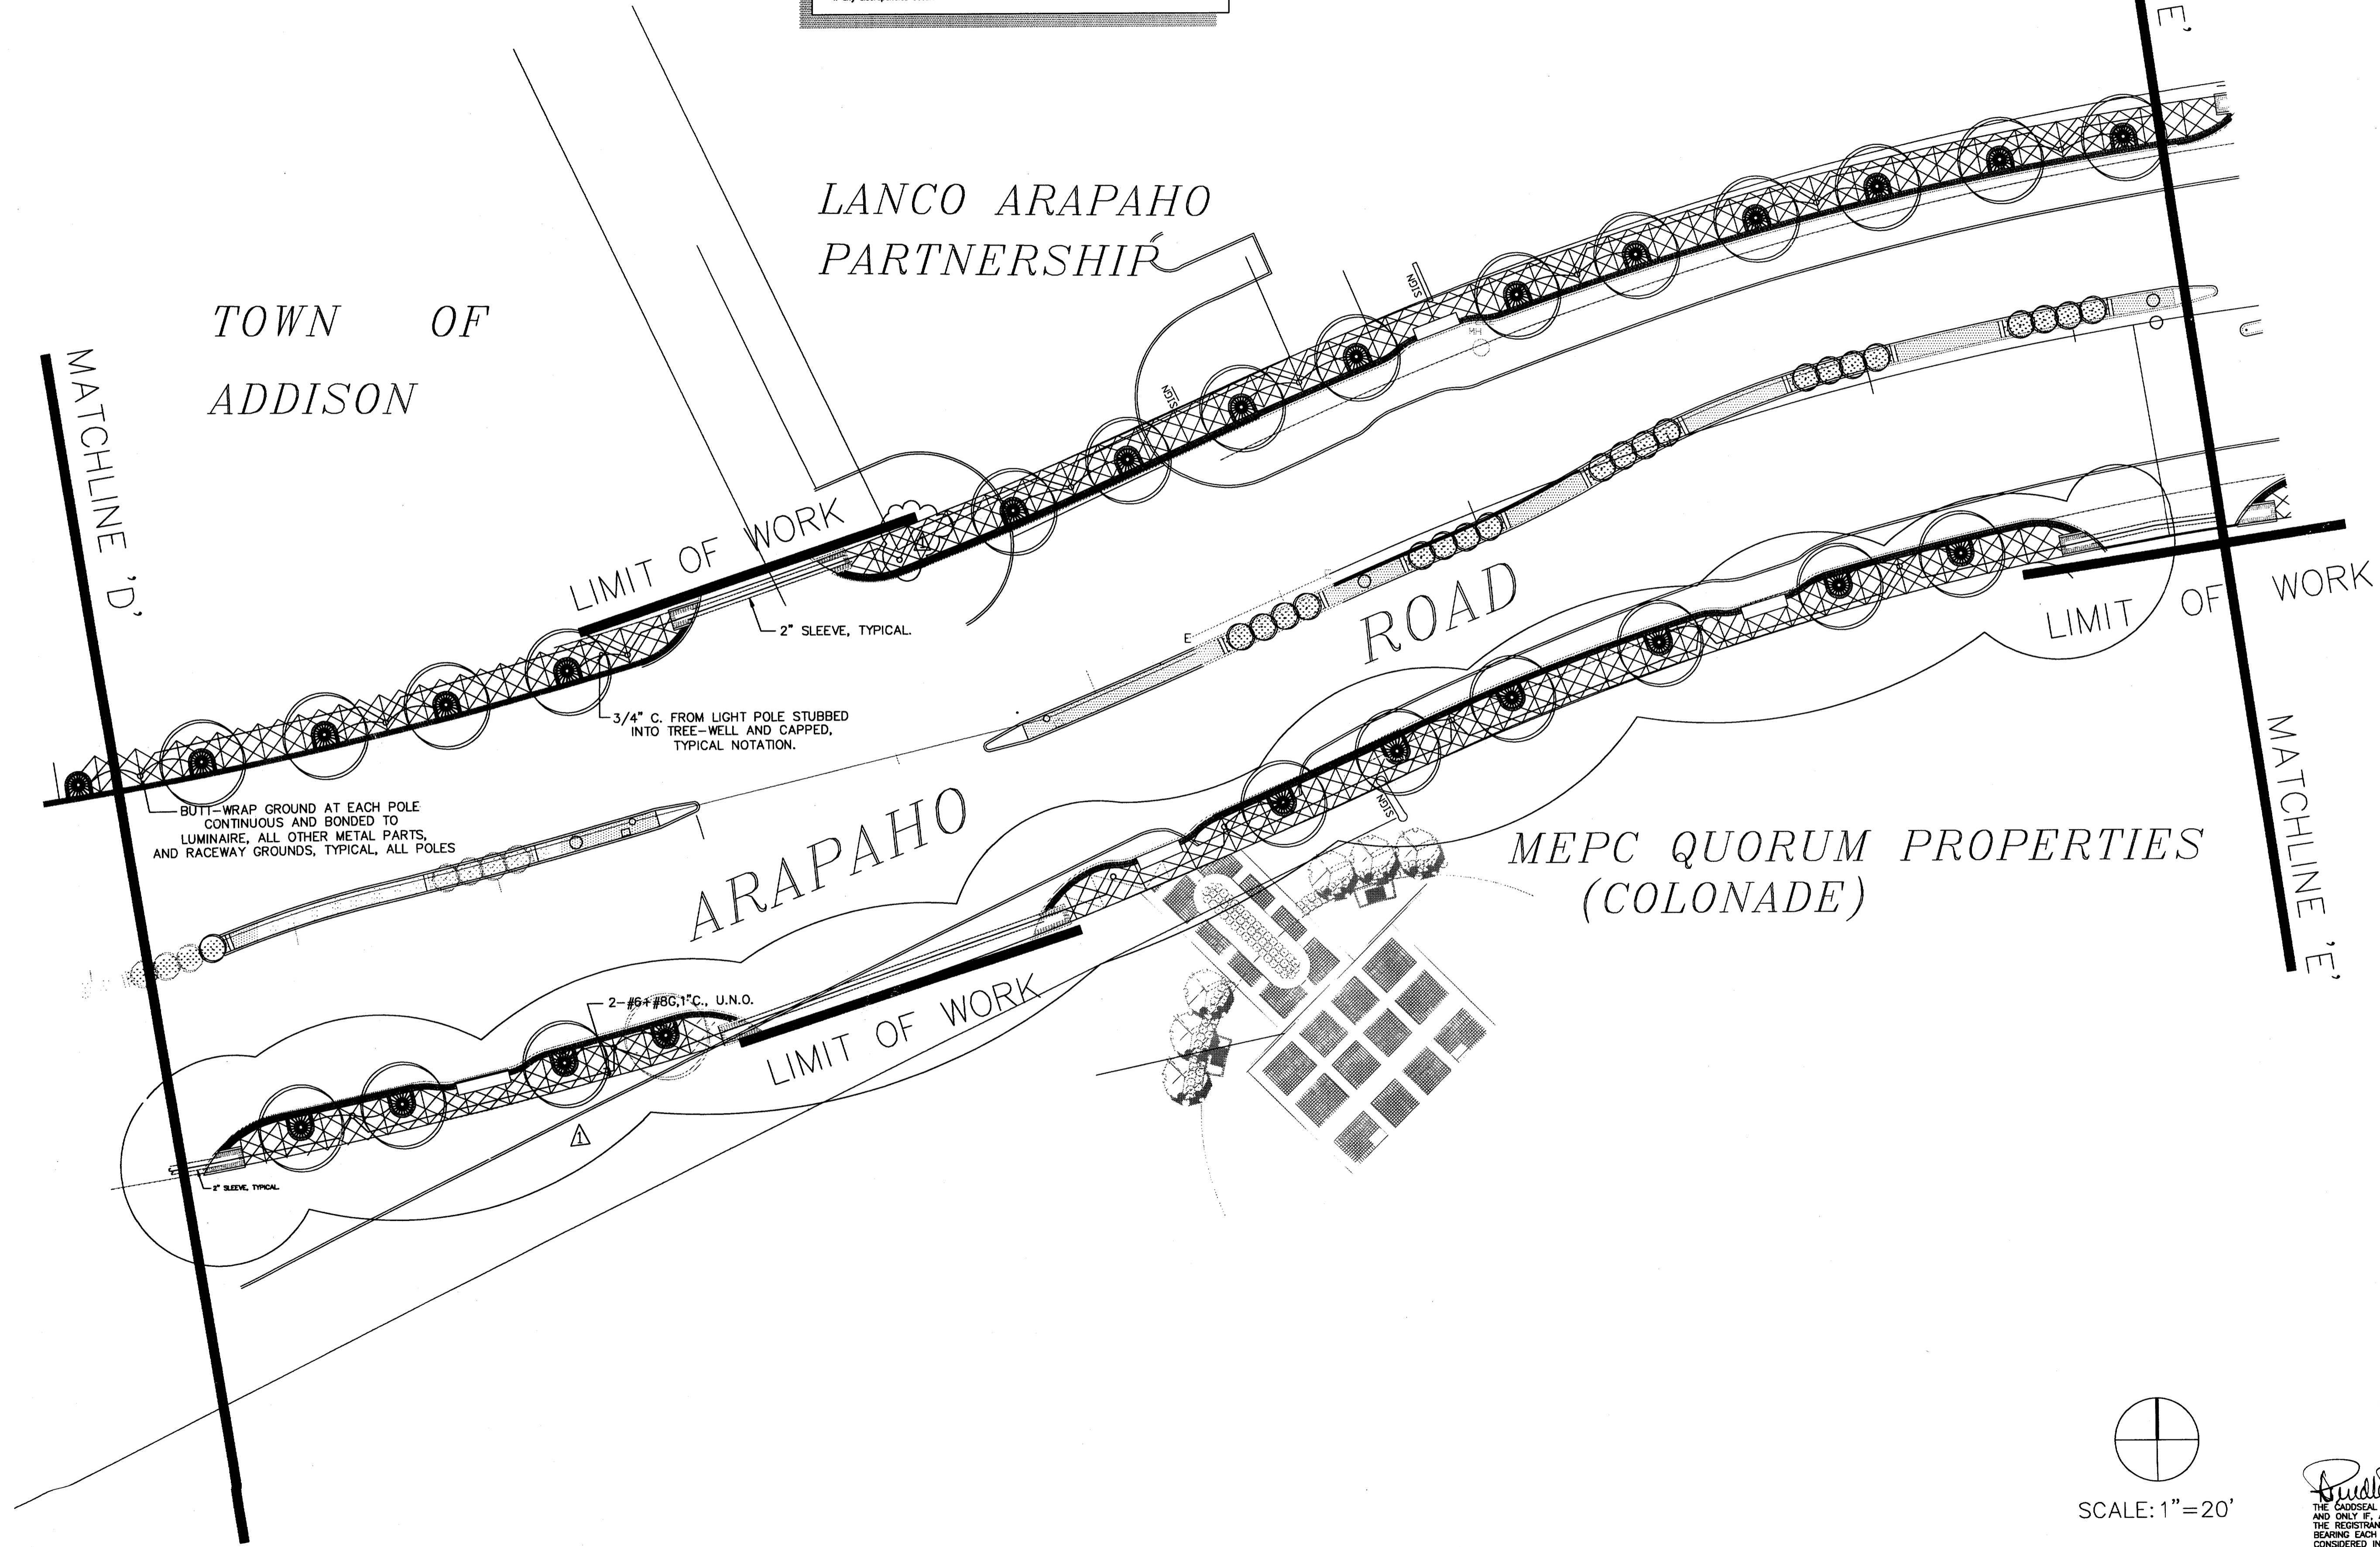

Revisions


No.	Date	Item
1	3/10/98	CITY REVISION AS LISTED IN ADDENDUM NO. 5.

Registration


Drawn: DCP
Checked: DCP
Project No.: 7059 Date: 12/12/97
Sheet Title:

SITE-ELECTRICAL PLAN

Sheet No.: SE-5

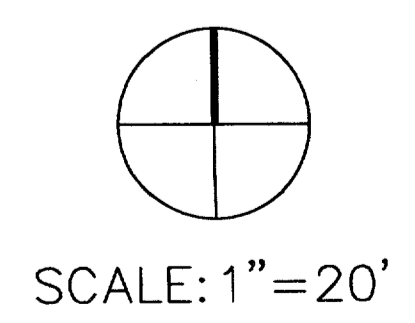

THIS DRAWING AND THE DESIGN SHOWN IS THE PROPERTY OF THE LANDSCAPE ARCHITECT. THE REPRODUCTION, COPYING, OR USE OF THIS DRAWING WITHOUT WRITTEN CONSENT IS PROHIBITED AND ANY INFRINGEMENT WILL BE SUBJECT TO LEGAL ACTION.
© Copyright 1997 MESA Design Group

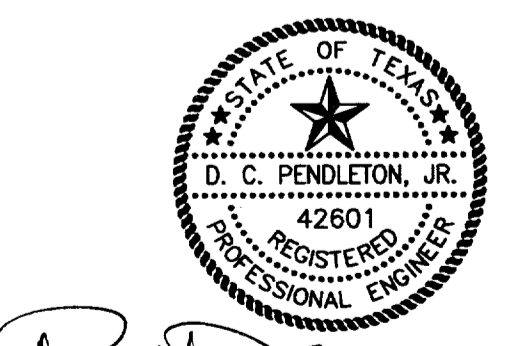

Dudley D. MARGB
THE GADGETS APPEARING ON THIS DOCUMENT IS VALID IF, AND ONLY IF, ACCOMPANIED BY AN ORIGINAL SIGNATURE OF THE REGISTRANT AND DATE OF EXECUTION. DOCUMENTS NOT BEARING EACH OF THE 3 AFOREMENTIONED ITEMS SHALL BE CONSIDERED INCOMPLETE AND SHALL NOT BE USED FOR CONSTRUCTION, PERMIT, OR BIDDING PURPOSES.

PENDLETON ENGINEERS
DESIGN CONSULTANTS
11615 FOREST CENTRAL SITE 101 LB1 DALLAS TEXAS 75243
214 341 2040 FAX: 214 341 4142

IMPORTANT!!!

1. MESA Design Group assumes no responsibility for any excavation or grading not shown on surveys or civil engineer's plans supplied to MESA Design Group.
2. All proposed and finished grades provided by MESA Design Group are based on information provided by owner's surveyor and/or civil engineer. Any discrepancies in actual field measurements are to be reported to landscape architect immediately.
3. Contractor shall be responsible for making himself familiar with all underground utilities, pipes, structures, and line runs.
4. Prior to commencement of landscape construction, all plans, footings, and walls are to be surveyed, laid out, and staked in field for approval by landscape architect. Contractor shall assume responsibility for any demolition, adjustments, or reconstruction resulting from unauthorized construction activities.
5. Contractor is responsible for all final quantities drawings and specifications. Any quantities provided by MESA Design Group are provided as a convenience only and shall not be considered absolute. Landscape architect should be notified if any discrepancies occur.

CHATAHOOCHEE
LEASING CORP.

LANCO ARAPAHO
PARTNERSHIP

LIMIT OF WORK

2" SLEEVE, TYPICAL. 2-#6+8G, 1" C., U.N.O. 3/4" C. FROM LIGHT POLE STUBBED INTO TREE-WELL AND CAPPED, TYPICAL NOTATION.

ARAPAHO ROAD

BUTT-WRAP GROUND AT EACH POLE CONTINUOUS AND BONDED TO LUMINAIRE, ALL OTHER METAL PARTS, AND RACEWAY GROUNDS, TYPICAL, ALL POLES

MEPC QUORUM PROPERTIES
(COLONADE)

LIMIT OF WORK

DALLAS
NORTH

ARAPAHO ROAD

OVERPASS

LIMIT OF WORK

DALLAS
NORTH
TOLLWAY

MATCHLINE 'E'

ARAPAHO ROAD
STREETSCAPE
CITY-OF-ADDISON, TEXAS

Revisions

No.	Date	Item
1	3/10/98	CITY REVISION AS LISTED IN ADDENDUM NO. 5.

Registration


DCP	
Drawn	
DCP	
Checked	
7059	12/12/97
Project No.	Date

Sheet Title

SITE-ELECTRICAL PLAN


Sheet No.

SE-6

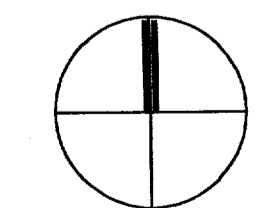

SCALE: 1" = 20'

THIS DRAWING AND THE DESIGN SHOWN IS THE PROPERTY OF THE LANDSCAPE ARCHITECT. THE REPRODUCTION, COPYING, OR USE OF THIS DRAWING WITHOUT WRITTEN CONSENT IS PROHIBITED AND ANY INFRINGEMENT WILL BE SUBJECT TO LEGAL ACTION.
© Copyright 1997 MESA Design Group

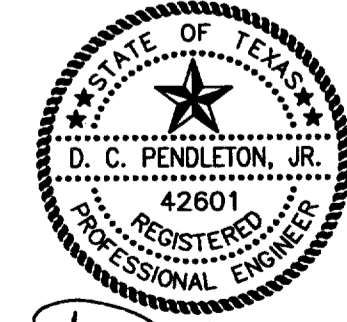

D. C. Pendleton, Jr. 20 MAR 98

THE CADDSAL APPEARING ON THIS DOCUMENT IS VALID IF, AND ONLY IF, ACCOMPANIED BY AN ORIGINAL SIGNATURE OF THE REGISTRANT AND DATE OF EXECUTION. DOCUMENTS NOT BEARING EACH OF THE 3 AFORESAID ITEMS SHALL BE CONSIDERED INCOMPLETE AND SHALL NOT BE USED FOR CONSTRUCTION, PERMIT, OR BIDDING PURPOSES.

PENDLETON ENGINEERS
DESIGN CONSULTANTS
11615 FOREST CENTRAL STE 101 LB1 DALLAS TEXAS 75243
214 341 2040 FAX: 214 341 4142