



CHATAHOOCHEE LEASING CORPORATION

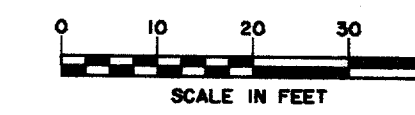


G CURVE DATA
 Δ = 01° 56' 26"
 R = 1000.00'
 T = 16.94'
 L = 33.87'

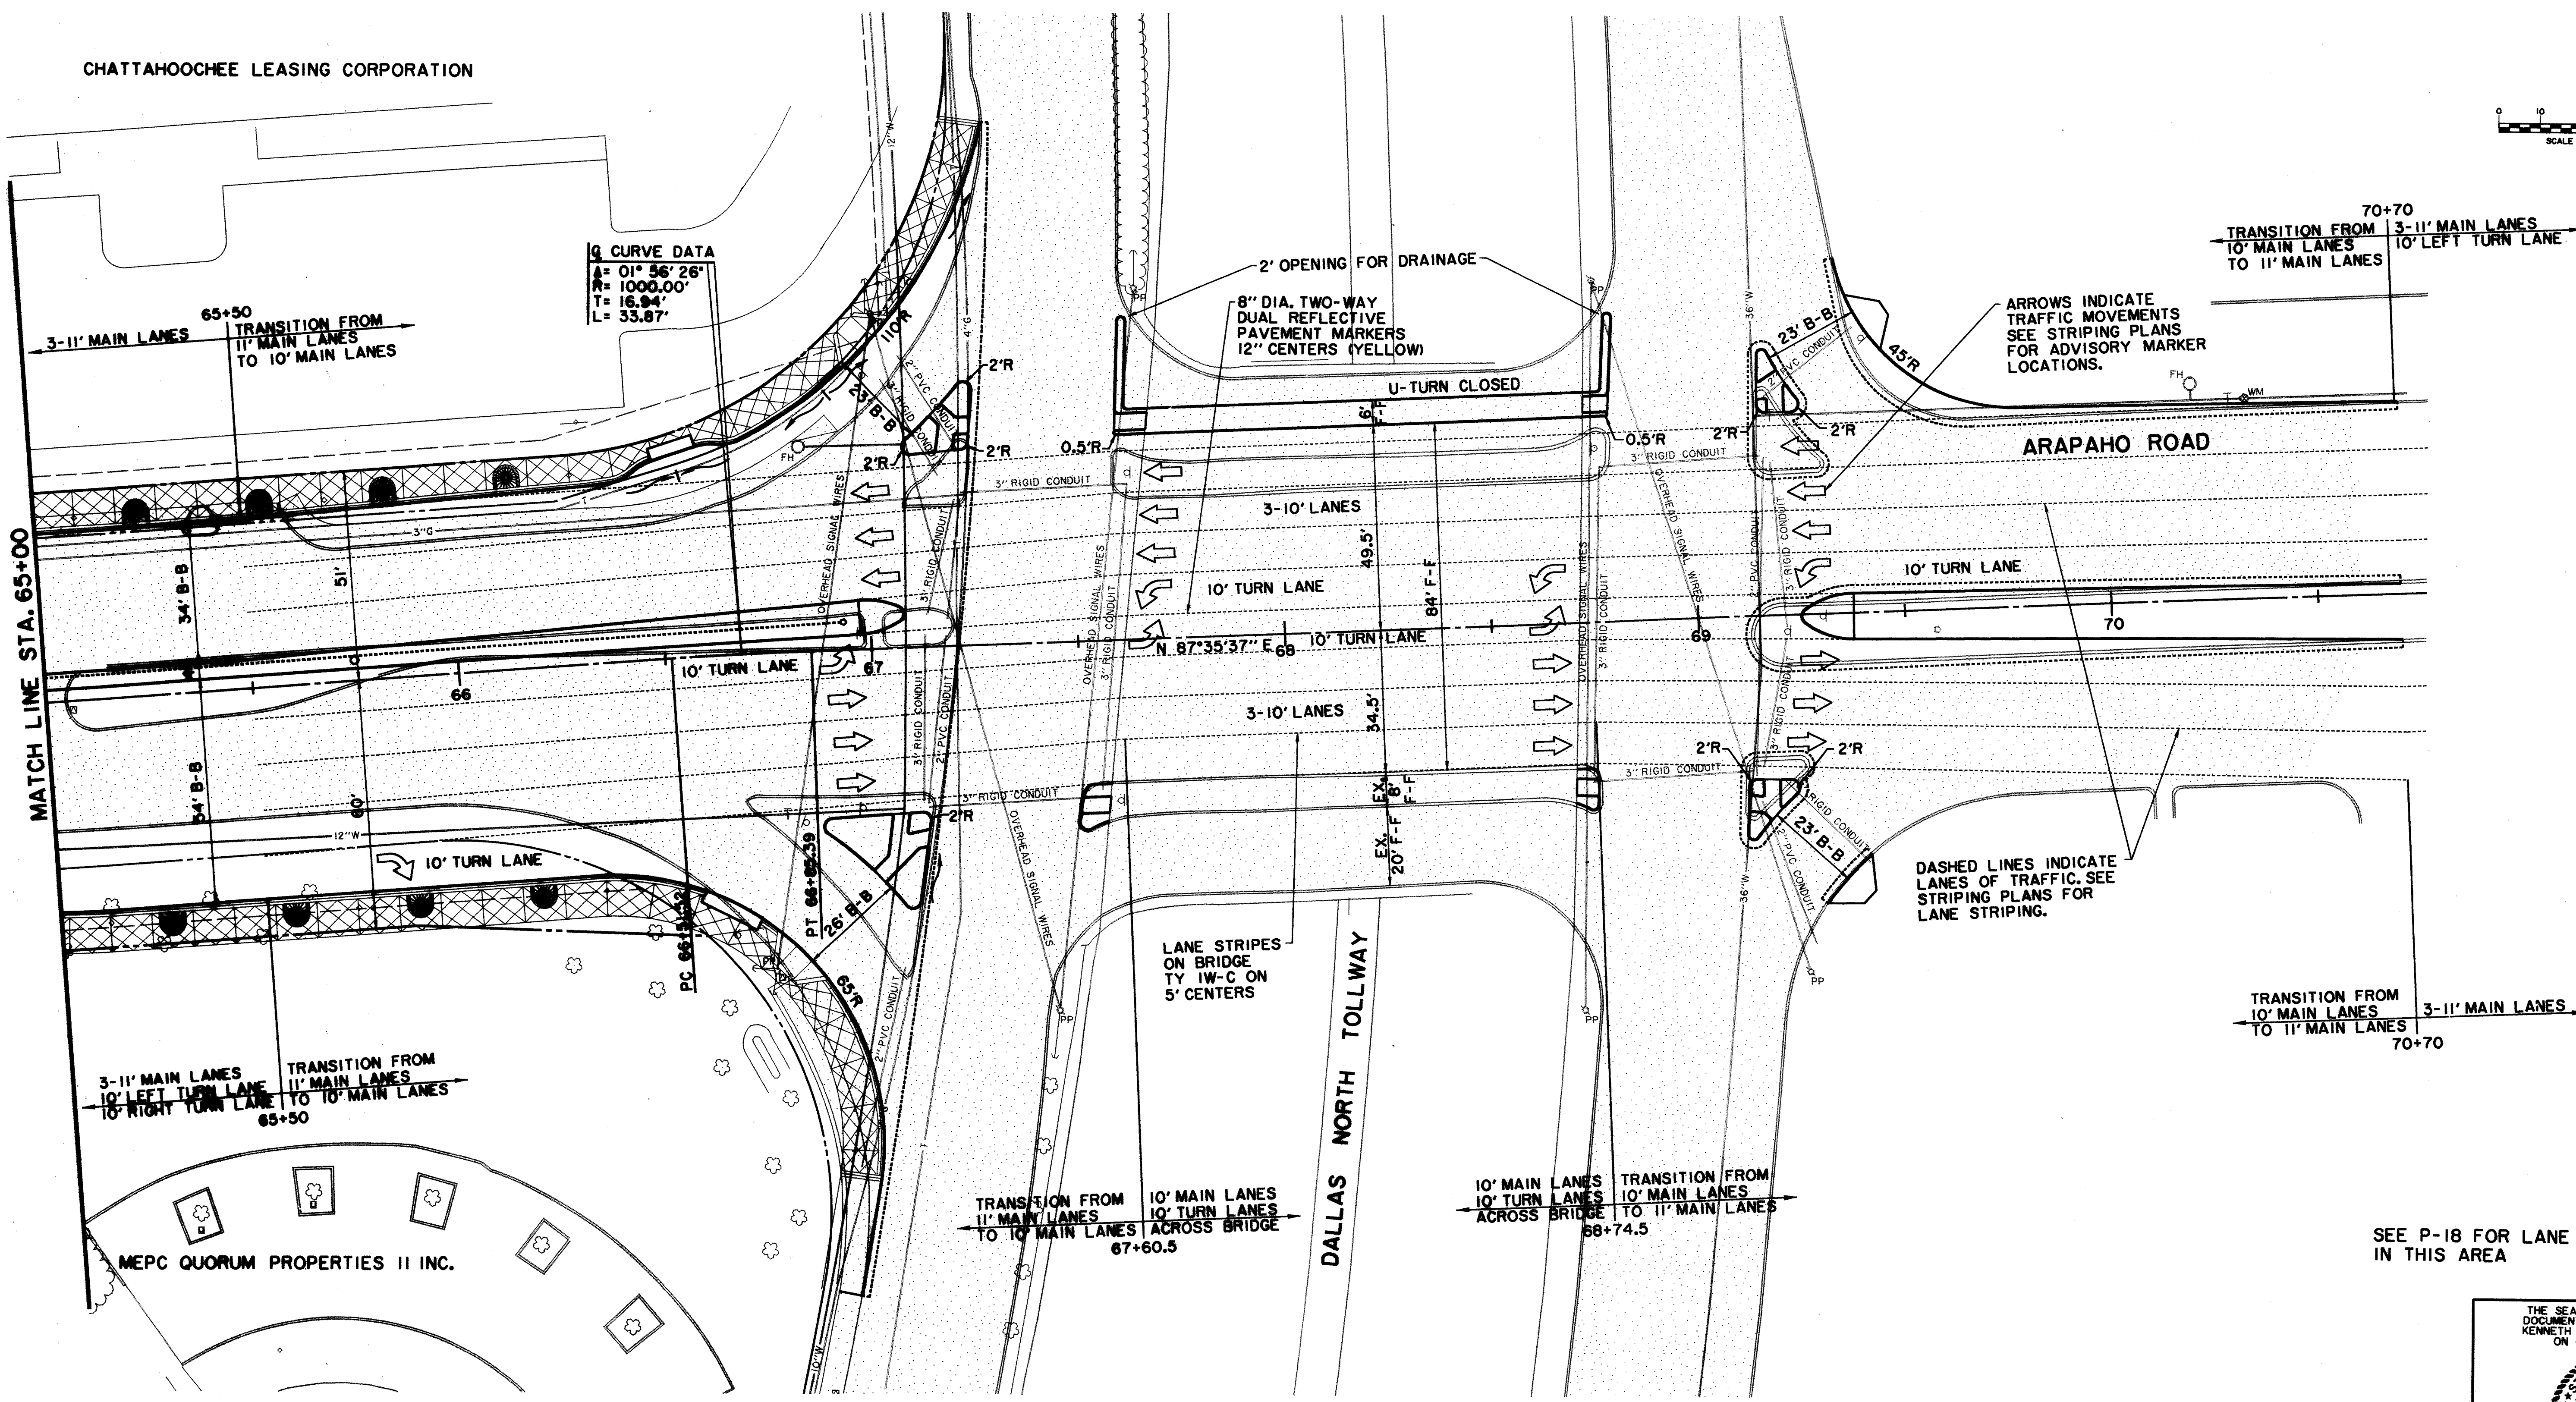

ARROWS INDICATE TRAFFIC MOVEMENTS SEE STRIPING PLANS FOR ADVISORY MARKER LOCATIONS.

DASHED LINES INDICATE LANES OF TRAFFIC. SEE STRIPING PLANS FOR LANE STRIPING.

SEE P-18 FOR LANE STRIPING IN THIS AREA

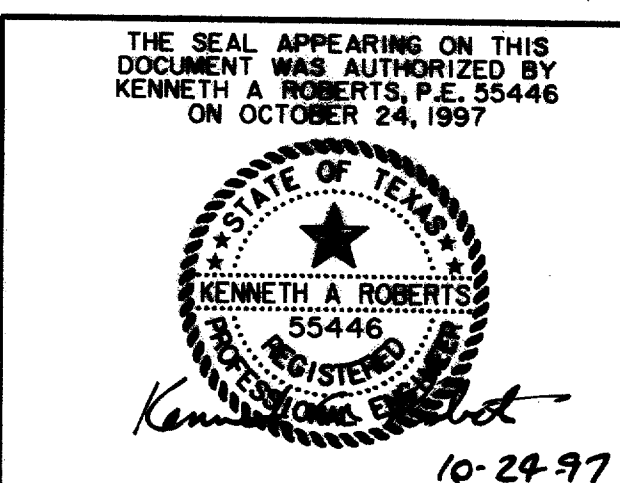

REVISOR 11/13/97

BRIDGE LANE MODIFICATION						
ARAPAHO ROAD						
ADDISON ROAD TO DALLAS NORTH TOLLWAY						
TOWN OF ADDISON, TEXAS						
Hull-Zollars, Inc./Consulting Engineers Dallas, Fort Worth, Houston, Phoenix, Tustin						
DESIGN	DRAWN	APPR.	SCALE	DATE	PROJECT NO.	NO.
HZI	HZI	KAR	1"=20'	OCT 97	1772-01	P-19

RECORD DOCUMENTS 6/9/2000
 THESE RECORD DOCUMENTS HAVE BEEN PREPARED BASED ON INFORMATION PROVIDED BY OTHERS. THE CONSULTANT HAS NOT VERIFIED THE ACCURACY AND/OR COMPLETENESS OF THIS INFORMATION AND SHALL NOT BE RESPONSIBLE FOR ANY ERRORS OR OMISSIONS THAT MAY BE INCORPORATED AS A RESULT OF ERRONEOUS INFORMATION PROVIDED BY OTHERS.