

NOTE: VERIFY LOCATION, HORIZONTAL & VERTICAL, OF ALL UTILITIES PRIOR TO CONSTRUCTION OF STORMWATER INLETS & PIPES

NOTE: VERIFY LOCATION OF EXISTING 24" RCP PRIOR TO CONSTRUCTING LATERALS B-9, B-10 & B-11


THESE RECORD DOCUMENTS HAVE BEEN PREPARED BASED ON INFORMATION PROVIDED BY OTHERS. THE CONSULTANT HAS NOT VERIFIED THE ACCURACY AND/OR COMPLETENESS OF THIS INFORMATION AND SHALL NOT BE RESPONSIBLE FOR ANY ERRORS OR OMISSIONS THAT MAY BE INCORPORATED AS A RESULT OF ERRONEOUS INFORMATION PROVIDED BY OTHERS.

LEGEND

ELECTRIC — OHE —	WATER — W —
⊙ LIGHT POLE	FH ⊙ FIRE HYDRANT
PP ⊙ POWER POLE	WM ⊙ METER
← GUY WIRE	T WATER VALVE
TELEPHONE — T —	MISC.
TELE ⊙ TELEPHONE MANHOLE	X X X 48" RCP R.C.P. REMOVAL
TELE ⊙ TELEPHONE PEDESTAL	— CHAIN LINK FENCE
TS ⊙ TELEPHONE SIGN	— WOOD FENCE
GAS — G —	— EXISTING ASPHALT
GM ⊙ GAS METER	— EXISTING DIRT OR GRAVEL
GS ⊙ GAS SIGN	— EX. CONCRETE
LAND USE	— TREE/TREE LINE
R ⊙ RAILROAD SIGN	— EXISTING CURB
⊙ SIGN	— PROP. CURB
SURVEY	— EX. PROPERTY LINE
I.R. ⊙ FOUND IRON ROD	— PROP. CENTERLINE
⊙ TEMP BENCHMARK	— PROP. R.O.W.
WASTEWATER — WW —	— PROP. INLET
WM ⊙ WASTEWATER MANHOLE	PVMT ⊙ TOP OF PAVEMENT
⊙ CLEANOUT	T.C. ⊙ TOP OF CURB
	C.R. ⊙ CURB RETURN

THE SEAL APPEARING ON THIS DOCUMENT WAS AUTHORIZED BY KENNETH A. ROBERTS, P.E. 55446 ON OCTOBER 24, 1997


THE SEAL APPEARING ON THIS DOCUMENT WAS AUTHORIZED BY KENNETH A. ROBERTS, P.E. 55446 ON OCTOBER 24, 1997

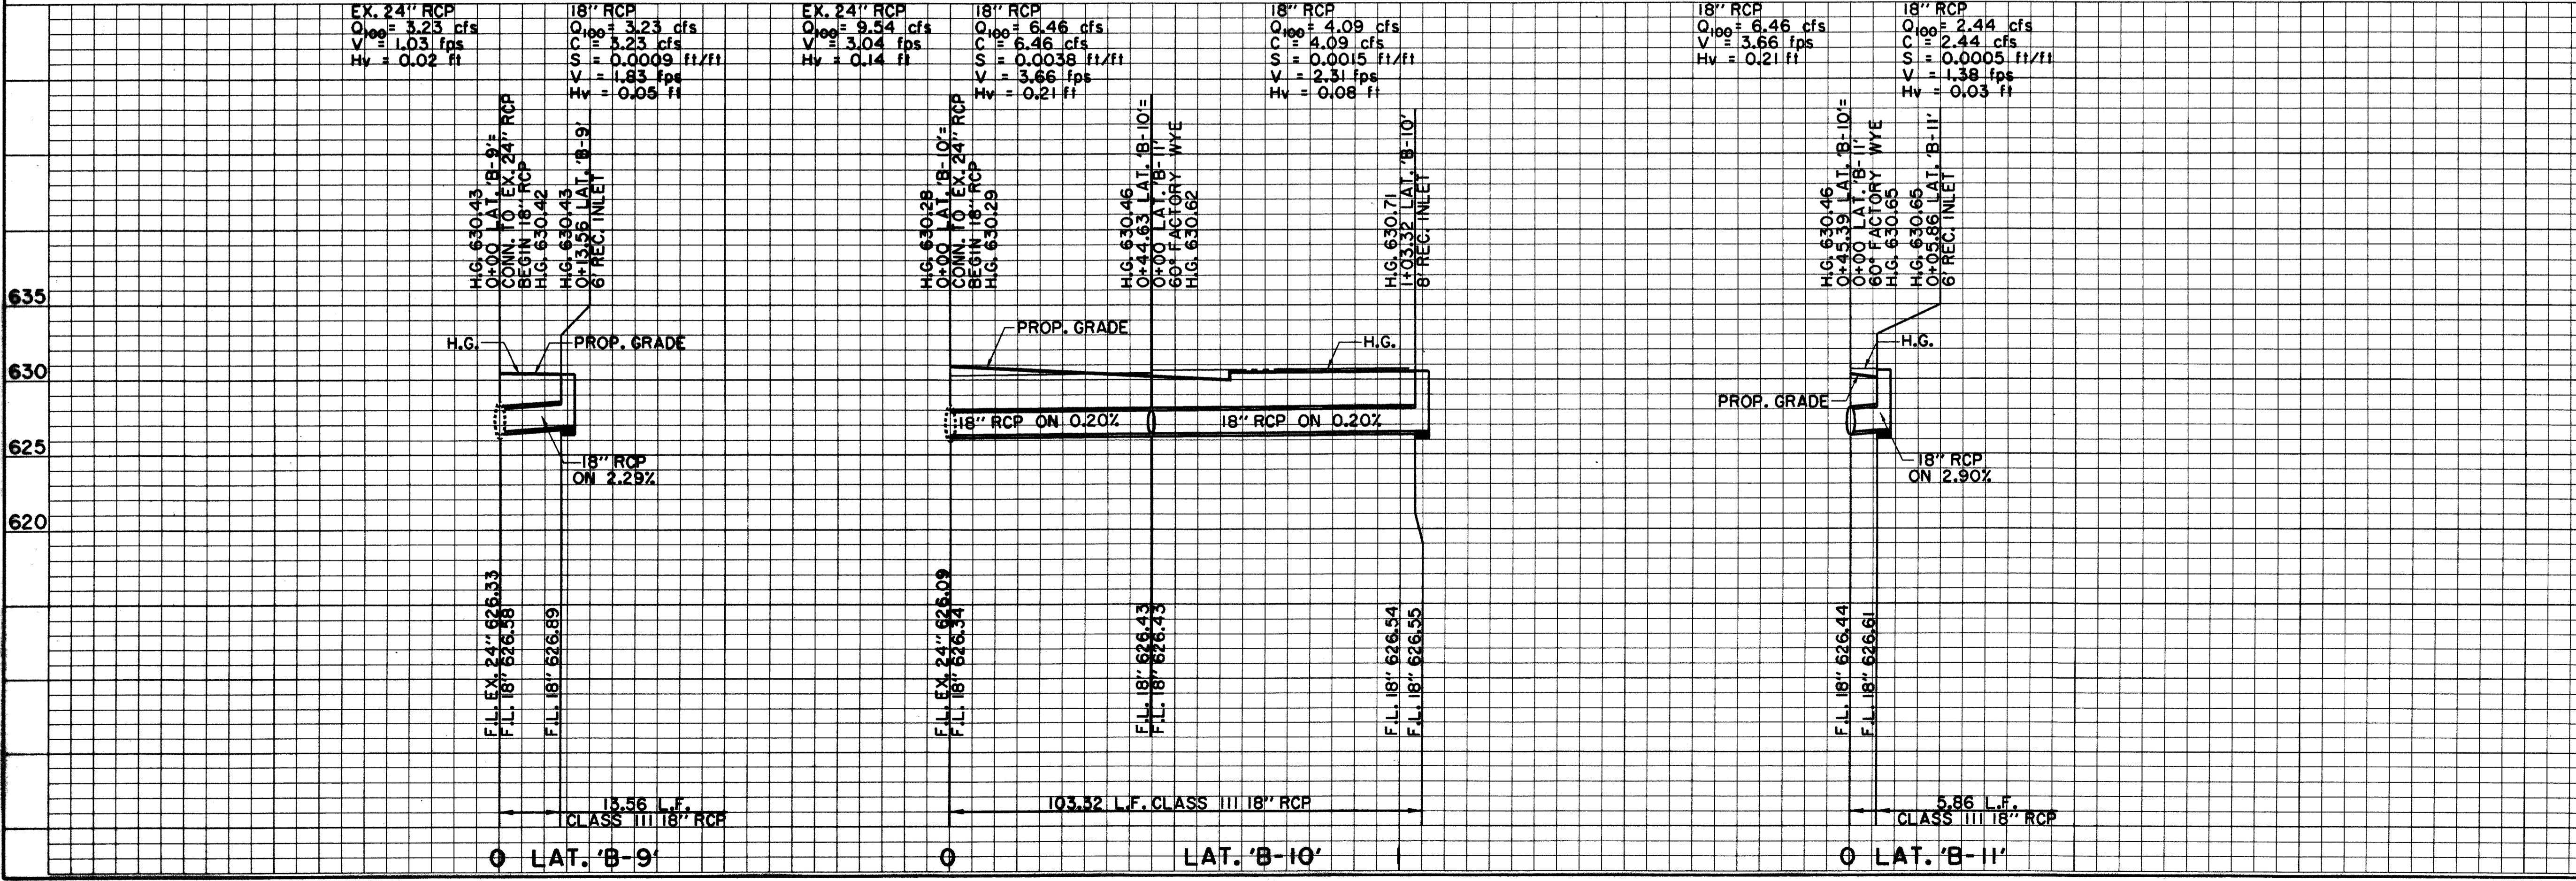

BENCHMARKS:

USC & GS E-921 DISK IN BRICK WALL OF OLD ADDISON SCHOOL HOUSE (MAGIC TIME MACHINE RESTAURANT) ON SOUTH WALL, 4' EAST OF CENTER OF THE ENTRANCE, 4.7' ABOVE THE GROUND. ELEV. 650.61

"I" ON SOUTHEAST CORNER OF CONCRETE WALK AT FRONT ENTRANCE TO 4805 ARAPAHO ROAD. ELEV. 630.61

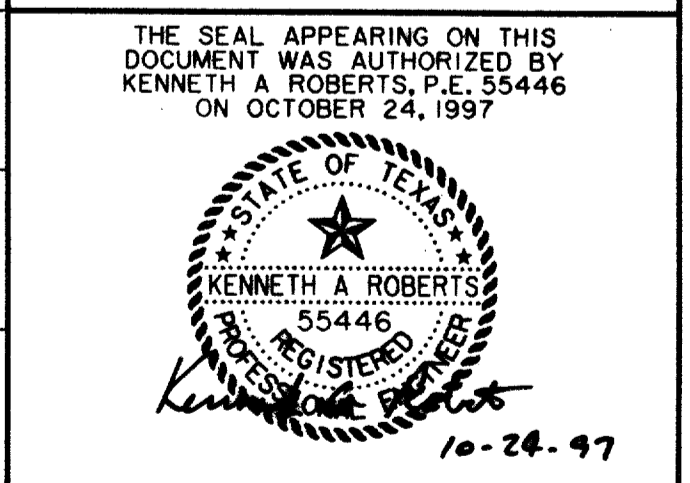

RECORD DOCUMENTS 6/9/2000

STORMWATER PLAN & PROFILE						
ARAPAHO ROAD						
ADDISON ROAD TO DALLAS NORTH TOLLWAY						
TOWN OF ADDISON, TEXAS						
Hutti-Zollars, Inc./Consulting Engineers Dallas, Fort Worth, Houston, Phoenix, Tustin						
DESIGN	DRAWN	APPR.	SCALE	DATE	PROJECT NO.	NO.
HZI	HZI	KAR	H ₁ 1"=20' V ₁ 1"=6'	OCT 97	1772-01	ST-7