


THESE RECORD DOCUMENTS HAVE BEEN PREPARED BASED ON INFORMATION PROVIDED BY OTHERS. THE CONSULTANT HAS NOT VERIFIED THE ACCURACY AND/OR COMPLETENESS OF THIS INFORMATION AND SHALL NOT BE RESPONSIBLE FOR ANY ERRORS OR OMISSIONS THAT MAY BE INCORPORATED AS A RESULT OF ERRONEOUS INFORMATION PROVIDED BY OTHERS.

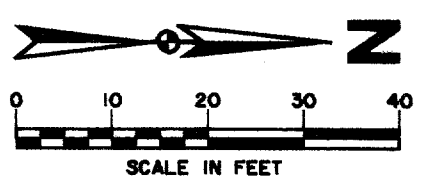

MCM COMPANY

0+91.75 LAT. 'B-19'  
0+00 LAT. 'B-20'  
60° FACTORY WYE

PAV. STA. 51+47.44, 0' RT. PC 51+17.88  
10' REC. INLET  
T.C. 625.97  
F.L. 621.97

0+28.98 LAT. 'B-20'  
END 24" RCP

1+03.84 LAT. 'B-19'  
END 42" RCP & PLUG

0+55.40 LAT. 'B-17'  
PAV. STA. 3+23.50,  
32.0' LT.  
10' REC. INLET  
T.C. 625.61  
F.L. 622.61

0+00 LAT. 'B-17'  
PAV. STA. 3+51.20, 15.0' RT.  
CONN. TO EX. 66" RCP  
BEGIN 18" RCP

0+19.71 LAT. 'B-18'  
PAV. STA. 3+78.86, 32.0' RT.  
10' REC. INLET  
T.C. 625.70  
F.L. 621.70

CARRAMERICA REALTY  
LIMITED PARTNERSHIP

0+00 LAT. 'B-18'  
PAV. STA. 3+78.86, 15.0' RT.  
CONN. TO EX. 60" RCP  
BEGIN 18" RCP

PAV. STA. 51+95.34' LT.  
10' REC. INLET  
T.C. 625.68  
F.L. 621.68

0+81.27 LAT. 'B-21'  
END 24" RCP

0+57.68 LAT. 'B-21'  
END 42" RCP  
BEGIN 24" RCP

0+52.67 LAT. 'B-21'  
0+00 LAT. 'B-19'  
60° FACTORY WYE

0+17.50 LAT. 'B-21'  
PAV. STA. 52+61.69, 34.00' LT.  
P.I.

PAV. STA. 4+86.06, 49.04' LT.  
END LAT. 'B-22'  
PLUG 24" RCP  
F.L. 621.82

LAT. 'B-22'  
15 L.F. 24" RCP  
ON 0.40%

NOTE:  
VERIFY LOCATION OF  
EXISTING 60" & 66" RCP  
PRIOR TO CONSTRUCTING  
LATERALS B-17, B-18, B-19  
B-20, B-21, B-23 & B-24

0+55.14 LAT. 'B-23'  
PAV. STA. 4+96.50, 32.0' LT.  
10' REC. INLET  
T.C. 625.72  
F.L. 621.72  
BEGIN 24" RCP  
LAT. 'B-22'  
F.L. 621.76

0+00 LAT. 'B-23'  
PAV. STA. 5+24.07, 15.0' RT.  
CONN. TO EX. 66" RCP  
BEGIN 24" RCP

0+00 LAT. 'B-21'  
PAV. STA. 4+77.87, 15.0' RT.  
CONN. TO EX. 66" RCP  
BEGIN 42" RCP

0+00 LAT. 'B-24'  
PAV. STA. 5+45.70, 15.0' RT.  
CONN. TO EX. 66" RCP  
BEGIN 18" RCP

0+20.40 LAT. 'B-24'  
PAV. STA. 5+35.50, 32.0' RT.  
10' REC. INLET  
T.C. 625.40  
F.L. 621.40

TOWN OF ADDISON

NOTE:  
VERIFY LOCATION, HORIZONTAL  
& VERTICAL, OF ALL UTILITIES  
PRIOR TO CONSTRUCTION OF  
STORMWATER INLETS & PIPES

MCI BURIED CABLE. CONTACT  
ADRIAN THEBAU 972/554-4127  
48 HOURS PRIOR TO ANY  
CONSTRUCTION IN THIS AREA.

BROOKS BURIED CABLE. CONTACT  
THERESA HARDIN 972/753-1900  
48 HOURS PRIOR TO ANY  
CONSTRUCTION IN THIS AREA

LEGEND

ELECTRIC — OHE	WATER — W
○ LIGHT POLE	○ FIRE HYDRANT
□ POWER POLE	□ METER
— GUY WIRE	— WATER VALVE
TELEPHONE — T	MISC.
● TELEPHONE MANHOLE	X X X R.C.P. REMOVAL
□ TELEPHONE PEDESTAL	— CHAIN LINK FENCE
TS TELEPHONE SIGN	— WOOD FENCE
GAS — G	— EXISTING ASPHALT
GM GAS METER	— EXISTING DIRT OR GRAVEL
GS GAS SIGN	— EX. CONCRETE
LAND USE	— TREE/TREE LINE
R/R RAILROAD SIGN	— EXISTING CURB
TEMP BENCHMARK	— PROP. CURB
I.R. FOUND IRON ROD	— EX. PROPERTY LINE
PROP. BENCHMARK	— PROP. CENTERLINE
WASTEWATER — WW	— PROP. R.O.W.
● WASTEWATER MANHOLE	— PROP. INLET
○ CLEANOUT	— P.V.M.T. TOP OF PAVEMENT
	— T.C. TOP OF CURB
	— C.R. CURB RETURN


BENCHMARKS:  
USC & GS E-921 DISK IN BRICK  
WALL OF OLD ADDISON SCHOOL  
HOUSE (MAGIC TIME MACHINE  
RESTAURANT) ON SOUTH WALL,  
4' EAST OF CENTER OF THE  
ENTRANCE, 4.7' ABOVE THE  
GROUND.  
ELEV. 650.61

"I" ON SOUTHEAST CORNER OF  
CONCRETE WALK AT FRONT  
ENTRANCE TO 4805 ARAPAHO  
ROAD.  
ELEV. 630.61

THE SEAL APPEARING ON THIS  
DOCUMENT WAS AUTHORIZED BY  
KENNETH A. ROBERTS, P.E. 55446  
ON OCTOBER 24, 1997

10-24-97

STORMWATER PLAN & PROFILE LINE 'B-2'					
ARAPAHO ROAD					
ADDISON ROAD TO DALLAS NORTH TOLLWAY					
TOWN OF ADDISON, TEXAS					
Huitt-Zollars, Inc./Consulting Engineers Dallas, Fort Worth, Houston, Phoenix, Tustin					
DESIGN	DRAWN	APPR.	SCALE	DATE	PROJECT NO.
HZI	HZI	KAR	H <sub>1</sub> "=20' V <sub>1</sub> "=6'	OCT 97	1772-01
					NO.
					ST-8

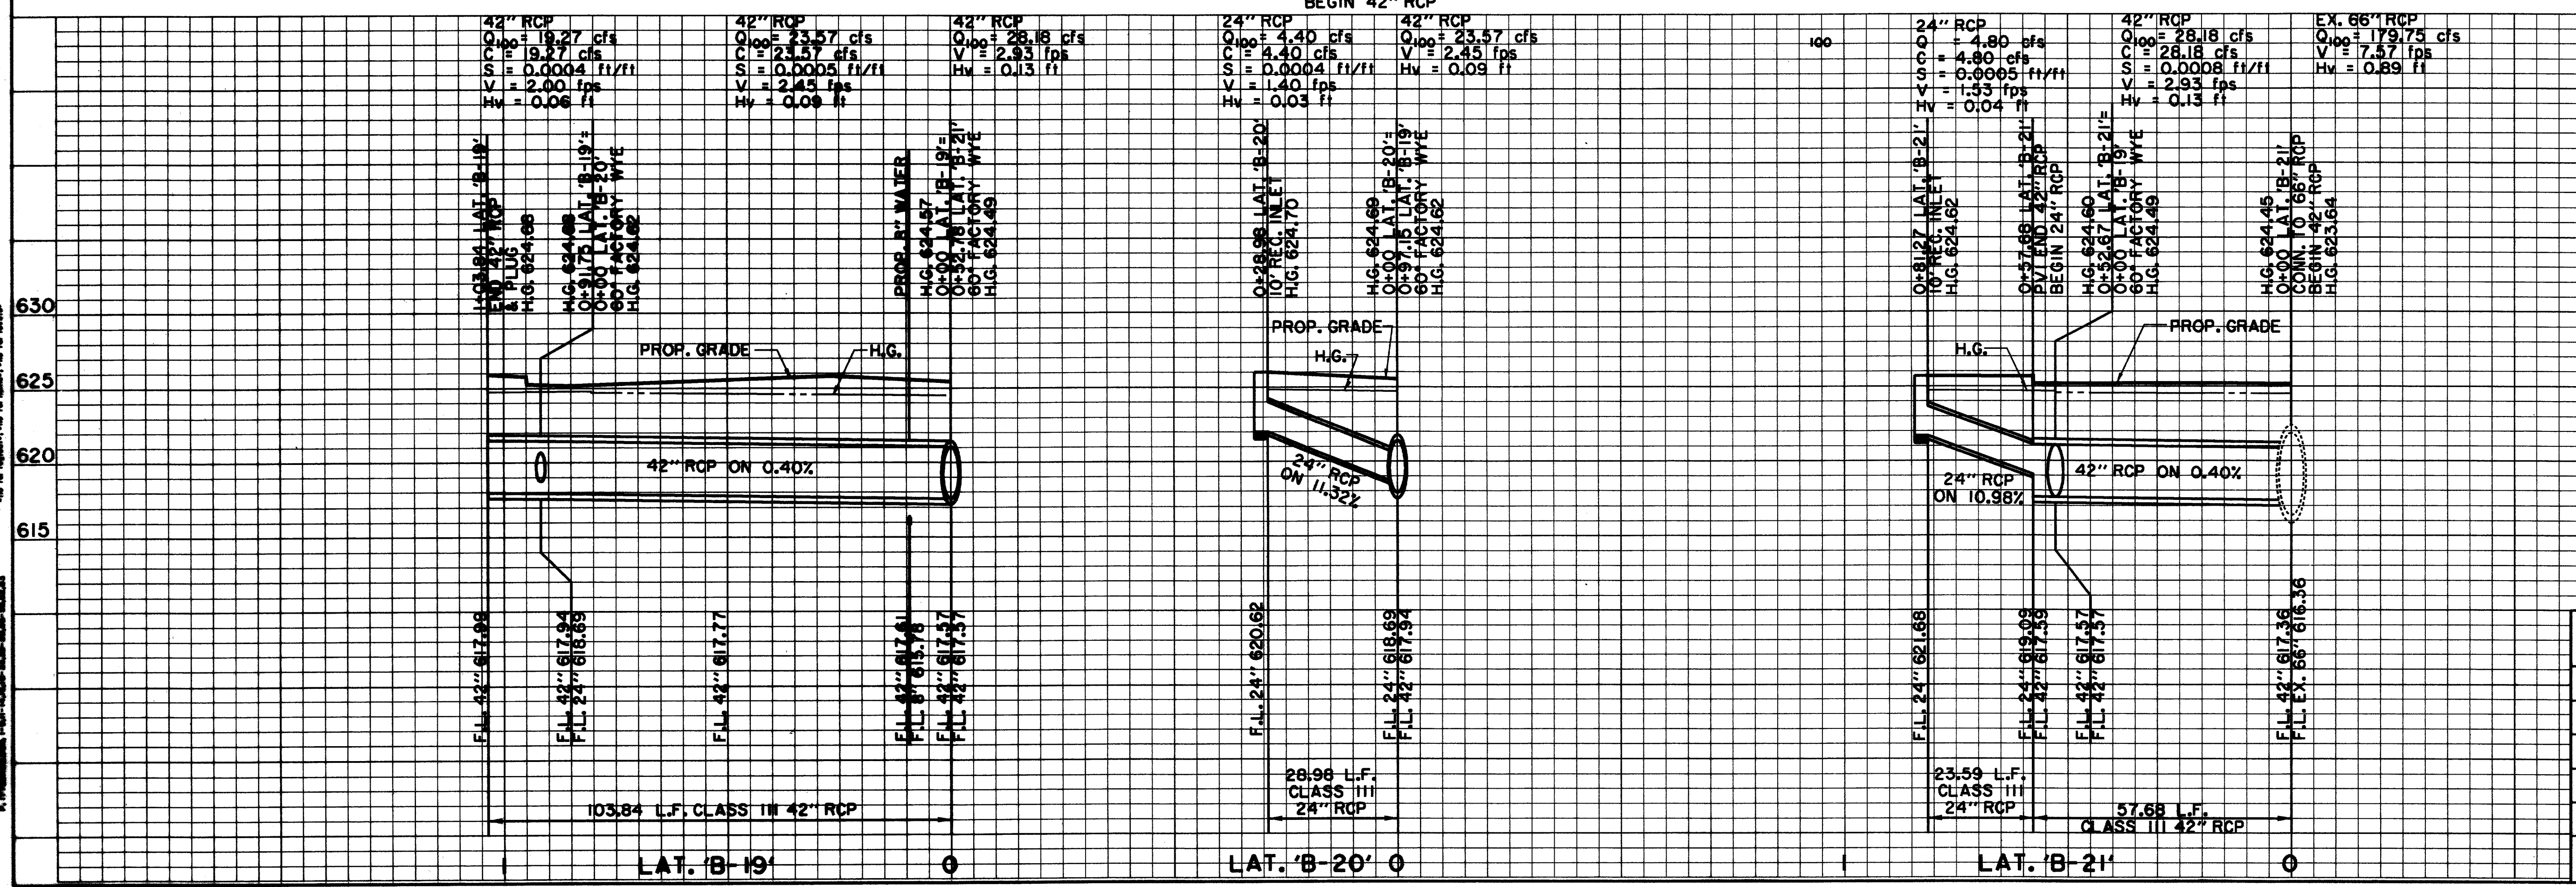

ALL INFORMATION CONTAINED HEREIN IS THE PROPERTY OF HUIIT-ZOLLARS, INC. AND IS TO BE USED ONLY FOR THE PROJECT AND LOCATION SPECIFICALLY IDENTIFIED HEREIN. ANY REUSE OR MODIFICATION OF THIS INFORMATION WITHOUT THE WRITTEN CONSENT OF HUIIT-ZOLLARS, INC. IS STRICTLY PROHIBITED.