


THESE RECORD DOCUMENTS HAVE BEEN PREPARED BASED ON INFORMATION PROVIDED BY OTHERS. THE CONSULTANT HAS NOT VERIFIED THE ACCURACY AND/OR COMPLETENESS OF THIS INFORMATION AND SHALL NOT BE RESPONSIBLE FOR ANY ERRORS OR OMISSIONS THAT MAY BE INCORPORATED AS A RESULT OF ERRONEOUS INFORMATION PROVIDED BY OTHERS.

**LEGEND**

	<b>ELECTRIC</b> — OHE		<b>WATER</b> — W
	○ LIGHT POLE		○ FIRE HYDRANT
	□ POWER POLE		○ METER
	— GUY WIRE		○ WATER VALVE
	<b>TELEPHONE</b> — T		
	○ TELEPHONE MANHOLE		— CHAIN LINK FENCE
	□ TELEPHONE PEDESTAL		— WOOD FENCE
	□ TELEPHONE SIGN		— EXISTING ASPHALT
	<b>GAS</b> — G		— EXISTING DIRT OR GRAVEL
	○ GAS METER		— EX. CONCRETE
	○ GAS SIGN		— TREE/TREE LINE
	<b>LAND USE</b>		— EXISTING CURB
	□ RAILROAD SIGN		— PROP. CURB
	□ SIGN		— EX. PROPERTY LINE
	○ SURVEY FOUND IRON ROD		— PROP. CENTERLINE
	□ TEMP BENCHMARK		— PROP. R.O.W.
	<b>WASTEWATER</b> — WW		— PROP. INLET
	○ WASTEWATER MANHOLE		— PROP. PAVEMENT
	○ CLEANOUT		— TOP OF CURB
			— P.V.M.T.
			— T.C.
			— C.R.

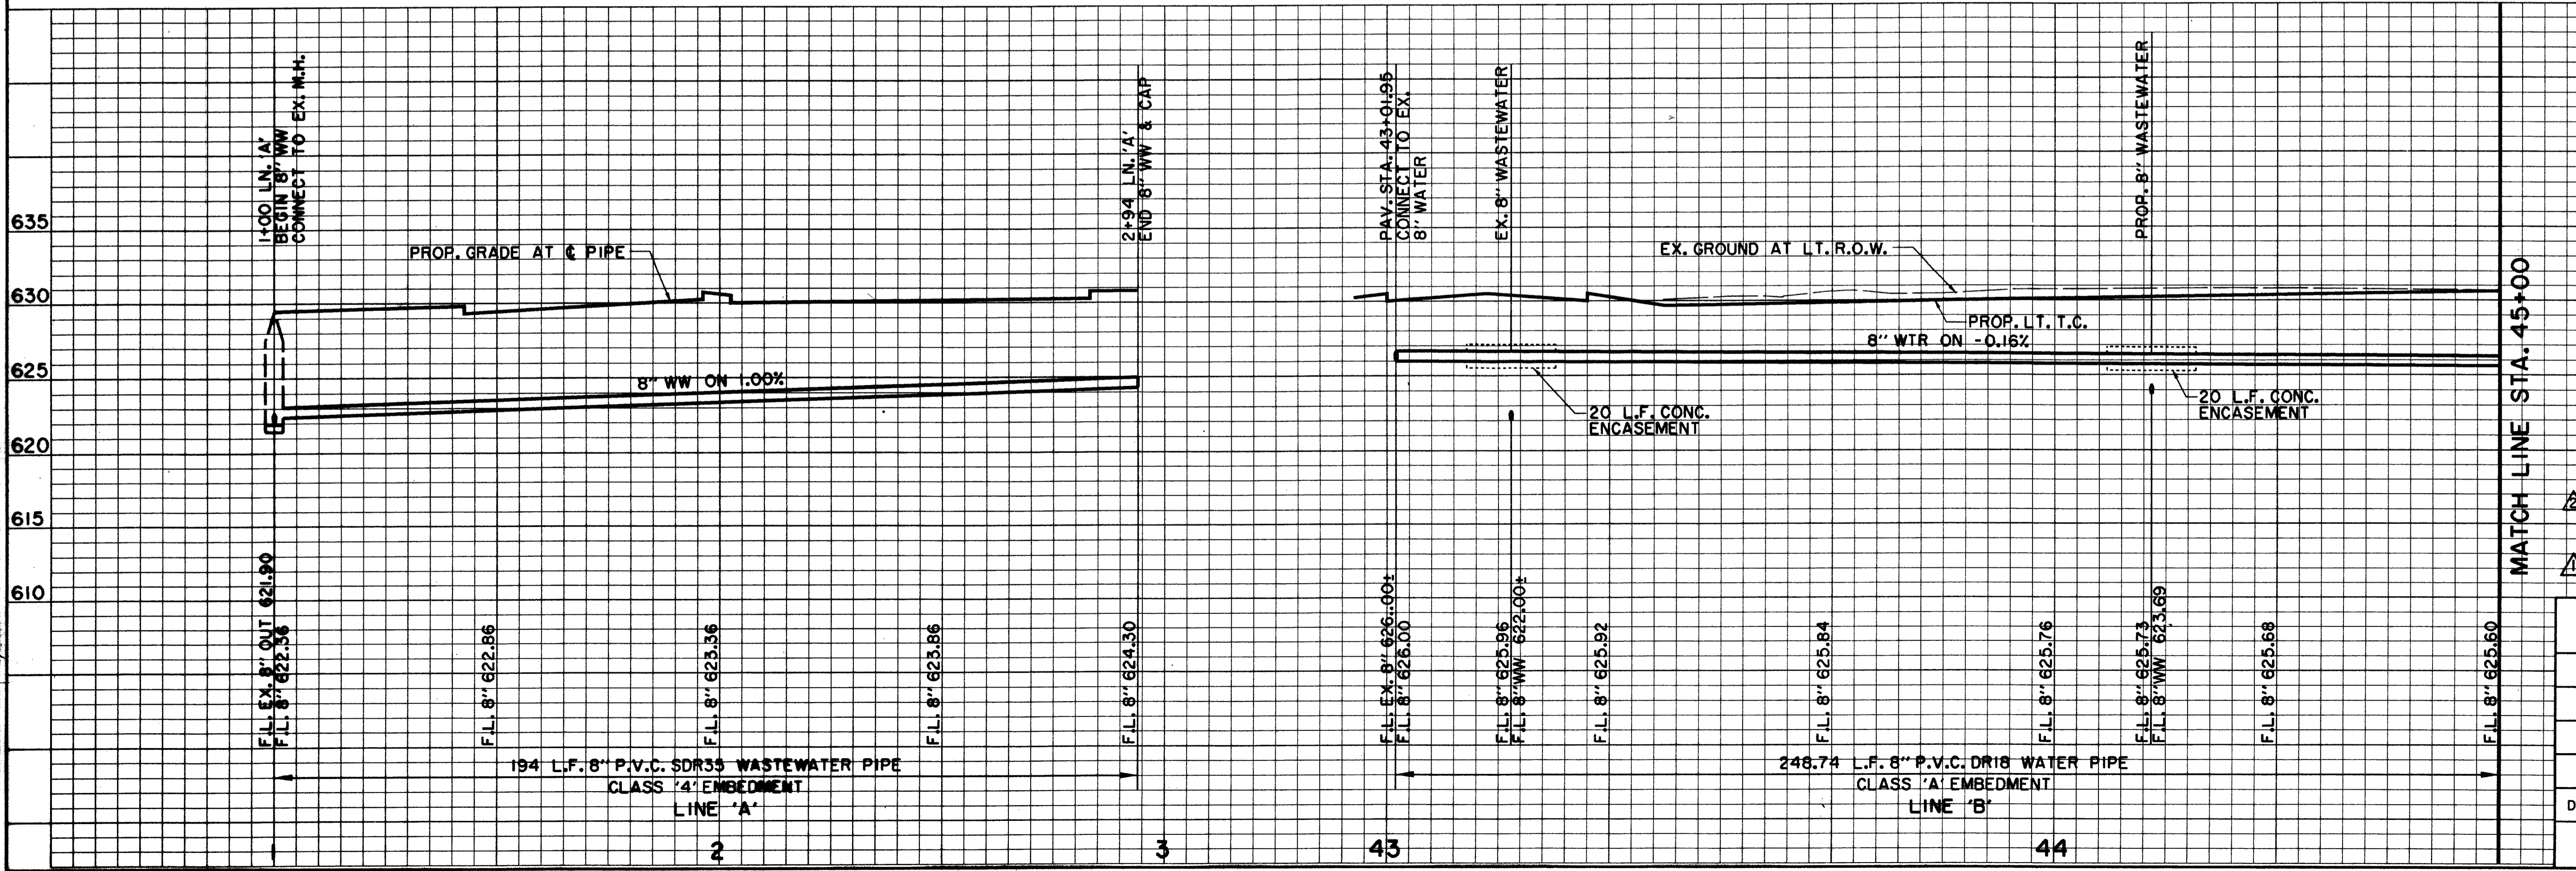

**BENCHMARKS:**  
 USC & GS E-921 DISK IN BRICK WALL OF OLD ADDISON SCHOOL HOUSE (MAGIC TIME MACHINE RESTAURANT) ON SOUTH WALL, 4' EAST OF CENTER OF THE ENTRANCE, 4.7' ABOVE THE GROUND. ELEV. 650.61

635 "I" ON SOUTHEAST CORNER OF CONCRETE WALK AT FRONT ENTRANCE TO 4805 ARAPAHO ROAD. ELEV. 630.61

THE SEAL APPEARING ON THIS DOCUMENT WAS AUTHORIZED BY KENNETH A. ROBERTS, P.E. 55446 ON OCTOBER 24, 1997



WATER & WASTEWATER PLAN & PROFILE						
ADDISON ROAD TO STA. 45+00						
<b>ARAPAHO ROAD</b>						
ADDISON ROAD TO DALLAS NORTH TOLLWAY						
<b>TOWN OF ADDISON, TEXAS</b>						
Huitt-Zollars, Inc./Consulting Engineers Dallas, Fort Worth, Houston, Phoenix, Tustin						
DESIGN	DRAWN	APPR.	SCALE	DATE	PROJECT NO.	NO.
HZI	HZI	KAR	H <sub>1</sub> 1"=20' V <sub>1</sub> 1"=6'	OCT 97	1772-01	W-1

ALL INFORMATION CONTAINED HEREIN IS THE PROPERTY OF HUIIT-ZOLLARS, INC. AND IS TO BE USED ONLY FOR THE PROJECT AND SITE SPECIFICALLY IDENTIFIED HEREIN. ANY REUSE OR MODIFICATION OF THIS INFORMATION WITHOUT THE WRITTEN CONSENT OF HUIIT-ZOLLARS, INC. IS STRICTLY PROHIBITED.