


PHASE 2-B
COMPLETE TURN LANE CONSTRUCTION
AFTER QUORUM DRIVE MAIN LANES
ARE COMPLETE.

MATCH LINE

PHASE 2-A

PHASE 2-B
COMPLETE TURN LANE CONSTRUCTION
AFTER QUORUM DRIVE MAIN LANES
ARE COMPLETE.

RECORD DOCUMENTS 6/9/2000
THESE RECORD DOCUMENTS HAVE BEEN
PREPARED BASED ON INFORMATION
PROVIDED BY OTHERS. THE CONSULTANT
HAS NOT VERIFIED THE ACCURACY AND/
OR COMPLETENESS OF THIS INFORMATION
AND SHALL NOT BE RESPONSIBLE FOR
ANY ERRORS OR OMISSIONS THAT MAY
BE INCORPORATED AS A RESULT OF
ERRONEOUS INFORMATION PROVIDED BY
OTHERS.

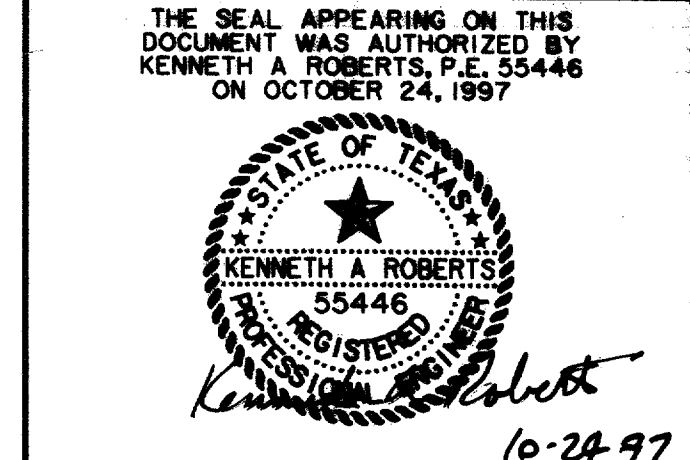

- TEMPORARY DETOUR (ASPHALT)
- UNDER CONSTRUCTION
- COMPLETED CONSTRUCTION
- TRAFFIC FLOW DURING CONSTRUCTION

CONSTRUCTION SEQUENCING PLAN						
PHASE 2						
ARAPAHO ROAD						
ADDISON ROAD TO DALLAS NORTH TOLLWAY						
TOWN OF ADDISON, TEXAS						
<small>Huitt-Zollars, Inc./Consulting Engineers Dallas, Fort Worth, Houston, Phoenix, Tustin</small>						
DESIGN	DRAWN	APPR.	SCALE	DATE	PROJECT NO.	NO.
HZI	HZI	KAR	1"=50'	OCT 97	1772-01	CS-3

ALL INFORMATION ON THIS PLAN IS BASED ON THE RECORD DRAWINGS AND FIELD SURVEY DATA PROVIDED BY THE TOWN OF ADDISON, TEXAS. THE CONSULTANT HAS NOT VERIFIED THE ACCURACY AND/OR COMPLETENESS OF THIS INFORMATION AND SHALL NOT BE RESPONSIBLE FOR ANY ERRORS OR OMISSIONS THAT MAY BE INCORPORATED AS A RESULT OF ERRONEOUS INFORMATION PROVIDED BY OTHERS.