


- C LC-2 1/4" FIBROUS EXPANSION JOINT W/
BACKER ROD AND ELASTOMETRIC CAULKING
- A LC-1 SUSPENDED 8" CONCRETE
W/ SANDBLAST FINISH AND SAW
CUT 1/4" DEEP - SCORE JOINT
- D LC-1 SEE MOUNTING DETAIL
- TREE GRATE (IRONSMTIH)
MODEL: M6059, M6074, M6000/DIF
- A LC-4 BEGA LIGHT POLE BASE
CENTERED ON EXPANSION JOINT AND
IN LINE WITH TREEGRATE OPENINGS.
(SEE FOUNDATION DETAIL)
- 1/4" FIBROUS EXPANSION JOINT W/
BACKER ROD AND SILICON CAULKING
- SAW CUT PATTERN - SCORE JOINTS
- 1/4" FIBROUS EXPANSION JOINT W/
BACKER ROD AND ELASTOMETRIC
CAULKING.
- BRICK PAVER - 4 X 8 X 2 1/4
GLEN GARY AUTUMN HAZE RED
3/8" GROUT JOINTS BETWEEN PAVERS
- 6" CURB (SEE CIVIL)

A TYPICAL ARAPAHO SIDEWALK PLAN DETAIL
3/4" = 1'-0"

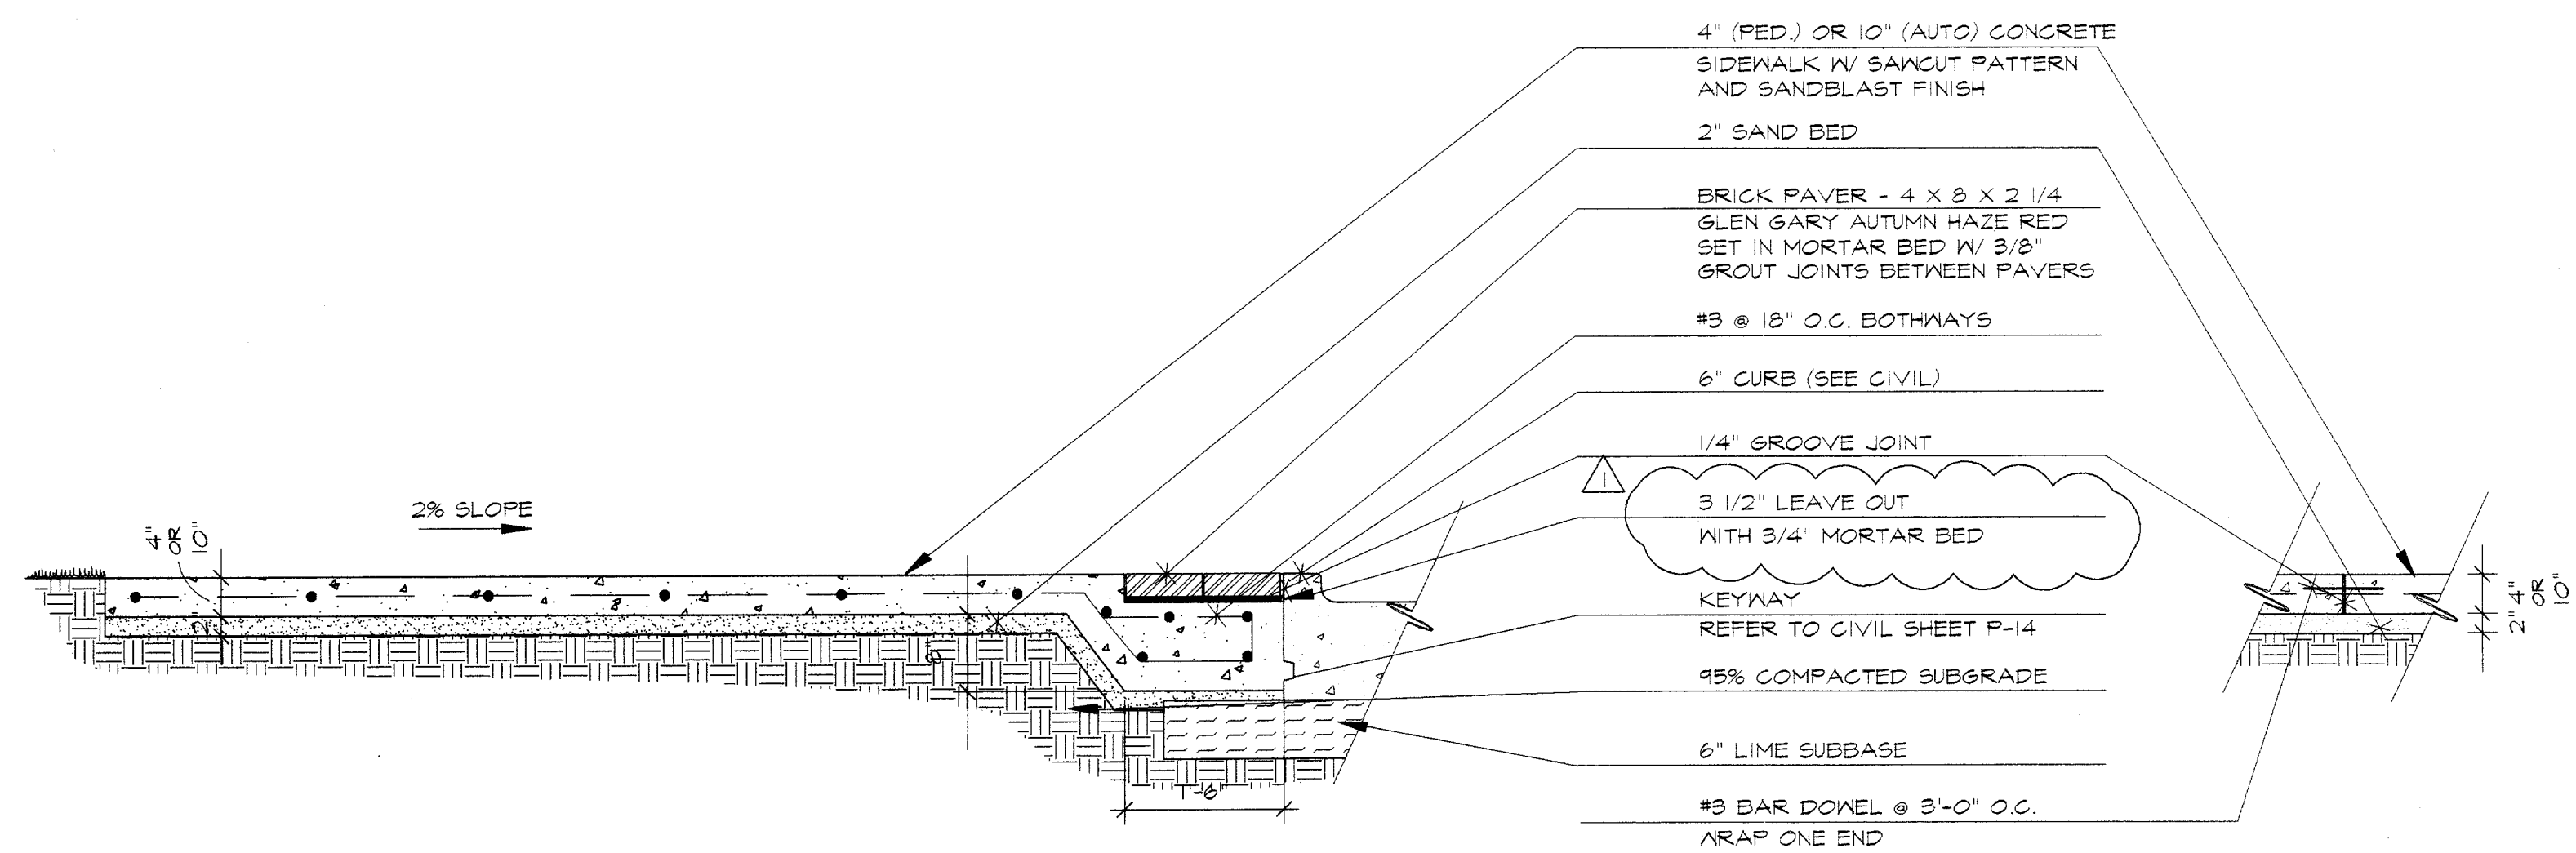

B TYPICAL ARAPAHO SIDEWALK SECTION
3/4" = 1'-0"

C TYPICAL SIDEWALK EXPANSION JOINT
3/4" = 1'-0"


WRITTEN DIMENSIONS PREVAIL OVER
SCALED DIMENSIONS.

IMPORTANT!!!

1. MESA Design Group assumes no responsibility for any excavation or grading not shown on survey or civil engineer's plans supplied to MESA Design Group.
2. All proposed and finished grades provided by MESA Design Group are based on information provided by owner's surveyor and/or civil engineer. Any discrepancies in actual field measurements are to be reported to landscape architect immediately.
3. Contractor shall be responsible for making himself familiar with all underground utilities, pipes, structures, and line runs.
4. Prior to commencement of landscape construction, all pins, footings, and nails are to be surveyed, laid out, and staked in field for approval by landscape architect. Contractor shall assume responsibility for any demolition, adjustments, or reconstruction resulting from unauthorized construction activities.
5. Contractor is responsible for all final quantities, drawings and specifications. Any quantities provided by MESA Design Group are provided as a convenience only and shall not be considered absolute. Landscape architect should be notified if any discrepancies occur.

No.	Date	Item
△	05/10/98	CITY REVISIONS AS LISTED IN ADDENDUM NO. 5.
△	05/18/98	ADDED LOCATION OF BEGA LIGHT BASE

Registration

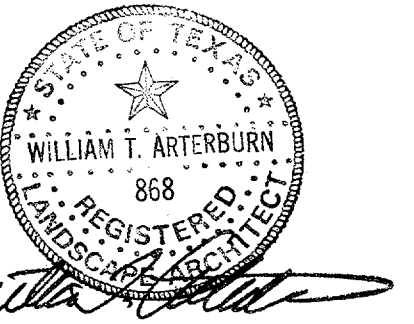

RFM/ISP
Drawn
WGM
Checked
97018
Project No.

05/18/98
Date

Sheet Title

ARAPAHO SIDEWALK
PLAN/SECTIONS

Sheet No.

LC-2