

DALLAS AREA RAPID TRANSIT PROPERTY ACQUISITION

VOL. 910088 PG. 1390

DALLAS AREA RAPID TRANSIT
VOL. 96899 PG. 05197

DALLAS AREA RAPID TRANSIT
VOL. 96169 PG. 04485

JOSEPH H. JONES, BETH BRANDEBERRY,
CAROLYN PERKINS SHIMER MERRITT AND
SAMUEL THOMAS PERKINS, CO-TRUSTEES OF
THE MARY CORFIELD TRUST, THE EVELYN C.
JONES TRUST, THE BETH BRANDEBERRY TRUST
AND THE CORINNE SHIMER TRUST AND
A BEN PINNELL, JR.
VOL. 97109 PG. 03158

MCM COMPANY
VOL. 76212 PG. 3704
VOL. 82179 PG. 1556
VOL. 82179 PG. 1559
VOL. 84008 PG. 1944
VOL. 84153 PG. 0532

INTERNATIONAL GUARANTY CORP.
VOL. 92001 PG. 0617

QUORUM CENTER LTD. P/S
VOL. 42038 PG. 0247

QUORUM CENTRE ADDITION
VOL. 84067 PG. 5718


QUORUM CENTRE ADDITION
VOL. 84067 PG. 5718

QUORUM CENTRE - EAST NO. 2 ADDITION
VOL. 96187 PG. 01867

RECORD DOCUMENTS 6/9/2000

THESE RECORD DOCUMENTS HAVE BEEN PREPARED BASED ON INFORMATION PROVIDED BY OTHERS. THE CONSULTANT HAS NOT VERIFIED THE ACCURACY AND/OR COMPLETENESS OF THIS INFORMATION AND SHALL NOT BE RESPONSIBLE FOR ANY ERRORS OR OMISSIONS THAT MAY BE INCORPORATED AS A RESULT OF ERRONEOUS INFORMATION PROVIDED BY OTHERS.

THE SEAL APPEARING ON THIS DOCUMENT WAS AUTHORIZED BY KENNETH A. ROBERTS, P.E. 55446 ON OCTOBER 24, 1997

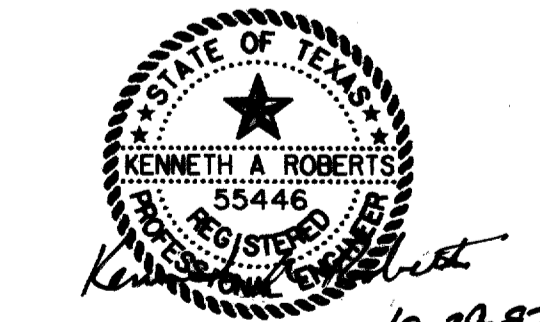

REVISED
1/16/98

RIGHT-OF-WAY MAP

ARAPAHO ROAD

ADDISON ROAD TO DALLAS NORTH TOLLWAY

TOWN OF ADDISON, TEXAS

Hullitt-Zollars, Inc./Consulting Engineers
Dallas, Fort Worth, Houston, Phoenix, Tustin

DESIGN	DRAWN	APPR.	SCALE	DATE	PROJECT NO.	NO.
HZI	HZI	KAR	1"=40'	OCT 97	1772-01	R-1

ADDISON CAR CARE ADDITION
VOL. 87111 PG. 0286

ADDISON ROAD

ARAPAHO ROAD

ARAPAHO ROAD

QUORUM DRIVE 80' R.O.W.

PARCEL 6-1-R BY SHIMK, JACOBS & FINKLEA

EDWARD COOK SURVEY ABSTRACT NO. 362
G.W. FISHER SURVEY ABSTRACT NO. 482

DEDICATED R.O.W. TO TOWN OF ADDISON
VOL. 87111 PG. 0286

LOT 2 BLOCK 1