


PHASE 2 RIGHT TURN WILL OVERLAP WITH PHASE 7
 PHASE 4 RIGHT TURN WILL OVERLAP WITH PHASE 1
 PHASE 6 RIGHT TURN WILL OVERLAP WITH PHASE 3
 PHASE 8 RIGHT TURN WILL OVERLAP WITH PHASE 5

COMPATIBILITY
 LINE

SIGNAL FACES																					
1	2	3	4	5	6	7	8	9	10	11	12	13	14	15	16	17	18	19	20	21	22
R	R	R	R	R	R	R	R	R	R	R	R	R	R	DW	DW	DW	DW	DW	DW	DW	DW
Y	Y	Y	Y	Y	Y	Y	Y	Y	Y	Y	Y	Y	Y	W	W	W	W	W	W	W	W
G	G	G	G	G	G	G	G	G	G	G	G	G	G								
-8				-8	-8	-8	-8			-8	-8	-8									

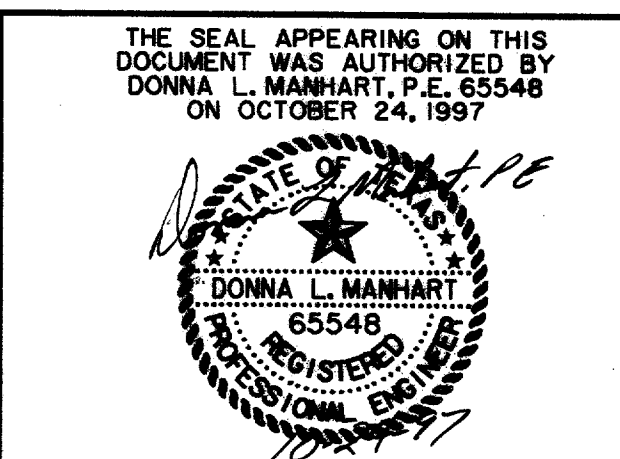

PHASE DIAGRAM
 ARAPAHO ROAD AT EXISTING ARAPAHO ROAD
ARAPAHO ROAD
 ADDISON ROAD TO DALLAS NORTH TOLLWAY
 TOWN OF ADDISON, TEXAS

Huitt-Zollars, Inc./Consulting Engineers
 Dallas, Fort Worth, Houston, Phoenix, Tustin

DESIGN	DRAWN	APPR.	SCALE	DATE	PROJECT NO.	NO.
HZI	HZI	DLM	NTS	OCT 97	1772-01	S-5

RECORD DOCUMENTS 6/9/2000
 THESE RECORD DOCUMENTS HAVE BEEN PREPARED BASED ON INFORMATION PROVIDED BY OTHERS. THE CONSULTANT HAS NOT VERIFIED THE ACCURACY AND/OR COMPLETENESS OF THIS INFORMATION AND SHALL NOT BE RESPONSIBLE FOR ANY ERRORS OR OMISSIONS THAT MAY BE INCORPORATED AS A RESULT OF ERRONEOUS INFORMATION PROVIDED BY OTHERS.