

CHATAHOOCHEE LEASING CORPORATION

0+00 LAT. 'C-26'
PAV. STA. 67+14.39
53.96' LT.
CONN. TO EX. 60" RCP
BEGIN 21" RCP

0+56.12 LAT. 'C-26'
END 21" RCP
PAV. STA. 66+55
47.57' LT.
10' REC. INLET
T.C. 613.40
F.L. 609.40

LAT. 'C-26'
21" RCP

ARAPAHO ROAD

LINE 'C-4'

LAT. 'D-1'
21" RCP


PAV. STA. 66+63.48
59.96' RT.
14' STD. INLET
T.C. 613.65
F.L. 610.15

0+56.90 LAT. 'D-1'
END 21" RCP

0+44.27 LAT. 'D-1'
45' FACTORY BEND

0+42.27 LAT. 'D-10'
PAV. STA. 66+80.15
54.33' RT.
CONN. TO EX. 21" RCP
BEGIN 21" RCP

DALLAS NORTH
TOLLWAY

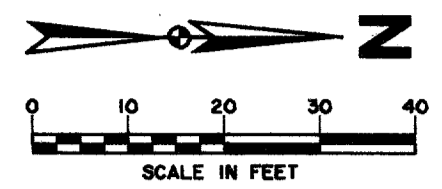

NOTE:
VERIFY LOCATION, HORIZONTAL
& VERTICAL, OF ALL UTILITIES
PRIOR TO CONSTRUCTION OF
STORMWATER INLETS & PIPES

LEGEND

| | | | |
|--|--------------------|--|-------------------------|
| | ELECTRIC — OHE | | WATER — W |
| | LIGHT POLE | | FIRE HYDRANT |
| | POWER POLE | | METER |
| | GUY WIRE | | WATER VALVE |
| | TELEPHONE — T | | MISC. |
| | TELEPHONE MANHOLE | | CHAIN LINK FENCE |
| | TELEPHONE PEDESTAL | | WOOD FENCE |
| | TELEPHONE SIGN | | EXISTING ASPHALT |
| | GAS — G | | EXISTING DIRT OR GRAVEL |
| | GAS METER | | EX. CONCRETE |
| | GAS SIGN | | TREE/TREE LINE |
| | LAND USE | | EXISTING CURB |
| | RAILROAD SIGN | | PROP. CURB |
| | SIGN | | EX. PROPERTY LINE |
| | SURVEY | | PROP. CENTERLINE |
| | FOUND IRON ROD | | PROP. R.O.W. |
| | TEMP BENCHMARK | | PROP. INLET |
| | WASTEWATER — WW | | TOP OF PAVEMENT |
| | WASTEWATER MANHOLE | | TOP OF CURB |
| | CLEANOUT | | CURB RETURN |

RECORD DOCUMENTS 6/9/2000

THESE RECORD DOCUMENTS HAVE BEEN PREPARED BASED ON INFORMATION PROVIDED BY OTHERS. THE CONSULTANT HAS NOT VERIFIED THE ACCURACY AND/OR COMPLETENESS OF THIS INFORMATION AND SHALL NOT BE RESPONSIBLE FOR ANY ERRORS OR OMISSIONS THAT MAY BE INCORPORATED AS A RESULT OF ERRONEOUS INFORMATION PROVIDED BY OTHERS.

LATERALS NOT PROFILED

BENCHMARKS:

USC & GS E-921 DISK IN BRICK WALL OF OLD ADDISON SCHOOL HOUSE (MAGIC TIME MACHINE RESTAURANT) ON SOUTH WALL, 4' EAST OF CENTER OF THE ENTRANCE, 4.7' ABOVE THE GROUND. ELEV. 650.61

'D' ON SOUTHEAST CORNER OF CONCRETE WALK AT FRONT ENTRANCE TO 4805 ARAPAHO ROAD. ELEV. 630.61


625

620

615

610

THE SEAL APPEARING ON THIS DOCUMENT WAS AUTHORIZED BY KENNETH A. ROBERTS, P.E. 55446 ON OCTOBER 24, 1997

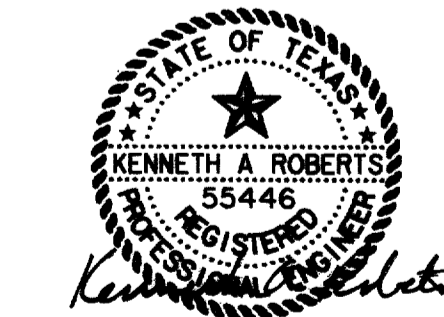

10-24-97

REVISED
11/16/98

STORMWATER PLAN & PROFILE
LINE 'C-4'

ARAPAHO ROAD

ADDISON ROAD TO DALLAS NORTH TOLLWAY

TOWN OF ADDISON, TEXAS

Huitl-Zollars, Inc./Consulting Engineers
Dallas, Fort Worth, Houston, Phoenix, Tustin

| | | | | | | |
|--------|-------|-------|---|--------|-------------|-------|
| DESIGN | DRAWN | APPR. | SCALE | DATE | PROJECT NO. | NO. |
| HZI | HZI | KAR | H _v 1"=20' V _v 1"=6' | OCT 97 | 1772-01 | ST-14 |