


NOTE:
VERIFY LOCATION, HORIZONTAL
& VERTICAL, OF ALL UTILITIES
PRIOR TO CONSTRUCTION OF
STORMWATER INLETS & PIPES

RECORD DOCUMENTS 6/9/2000
THESE RECORD DOCUMENTS HAVE BEEN
PREPARED BASED ON INFORMATION
PROVIDED BY OTHERS. THE CONSULTANT
HAS NOT VERIFIED THE ACCURACY AND/
OR COMPLETENESS OF THIS INFORMATION
AND SHALL NOT BE RESPONSIBLE FOR
ANY ERRORS OR OMISSIONS THAT MAY
BE INCORPORATED AS A RESULT OF
ERRONEOUS INFORMATION PROVIDED BY
OTHERS.

LEGEND

ELECTRIC — ONE	WATER — W
○ LIGHT POLE	FH FIRE HYDRANT
PP POWER POLE	WM METER
— GUY WIRE	T WATER VALVE
TELEPHONE — T	MISC.
● TELEPHONE MANHOLE	48" RCP R.C.P. REMOVAL
○ TELEPHONE PEDESTAL	— CHAIN LINK FENCE
TS TELEPHONE SIGN	— WOOD FENCE
GAS — G	— EXISTING ASPHALT
GM GAS METER	— EXISTING DIRT OR GRAVEL
GS GAS SIGN	— EX. CONCRETE
LAND USE	— TREE/TREE LINE
R.R. RAILROAD SIGN	— EXISTING CURB
⊕ SIGN	— PROP. CURB
SURVEY	— EX. PROPERTY LINE
I.R. FOUND IRON ROD	— PROP. CENTERLINE
⊕ TEMP BENCHMARK	— PROP. R.O.W.
WASTEWATER — WW	— PROP. INLET
WM WASTEWATER MANHOLE	— P.V.M.T. TOP OF PAVEMENT
CO CLEANOUT	— T.C. TOP OF CURB
	— C.R. CURB RETURN

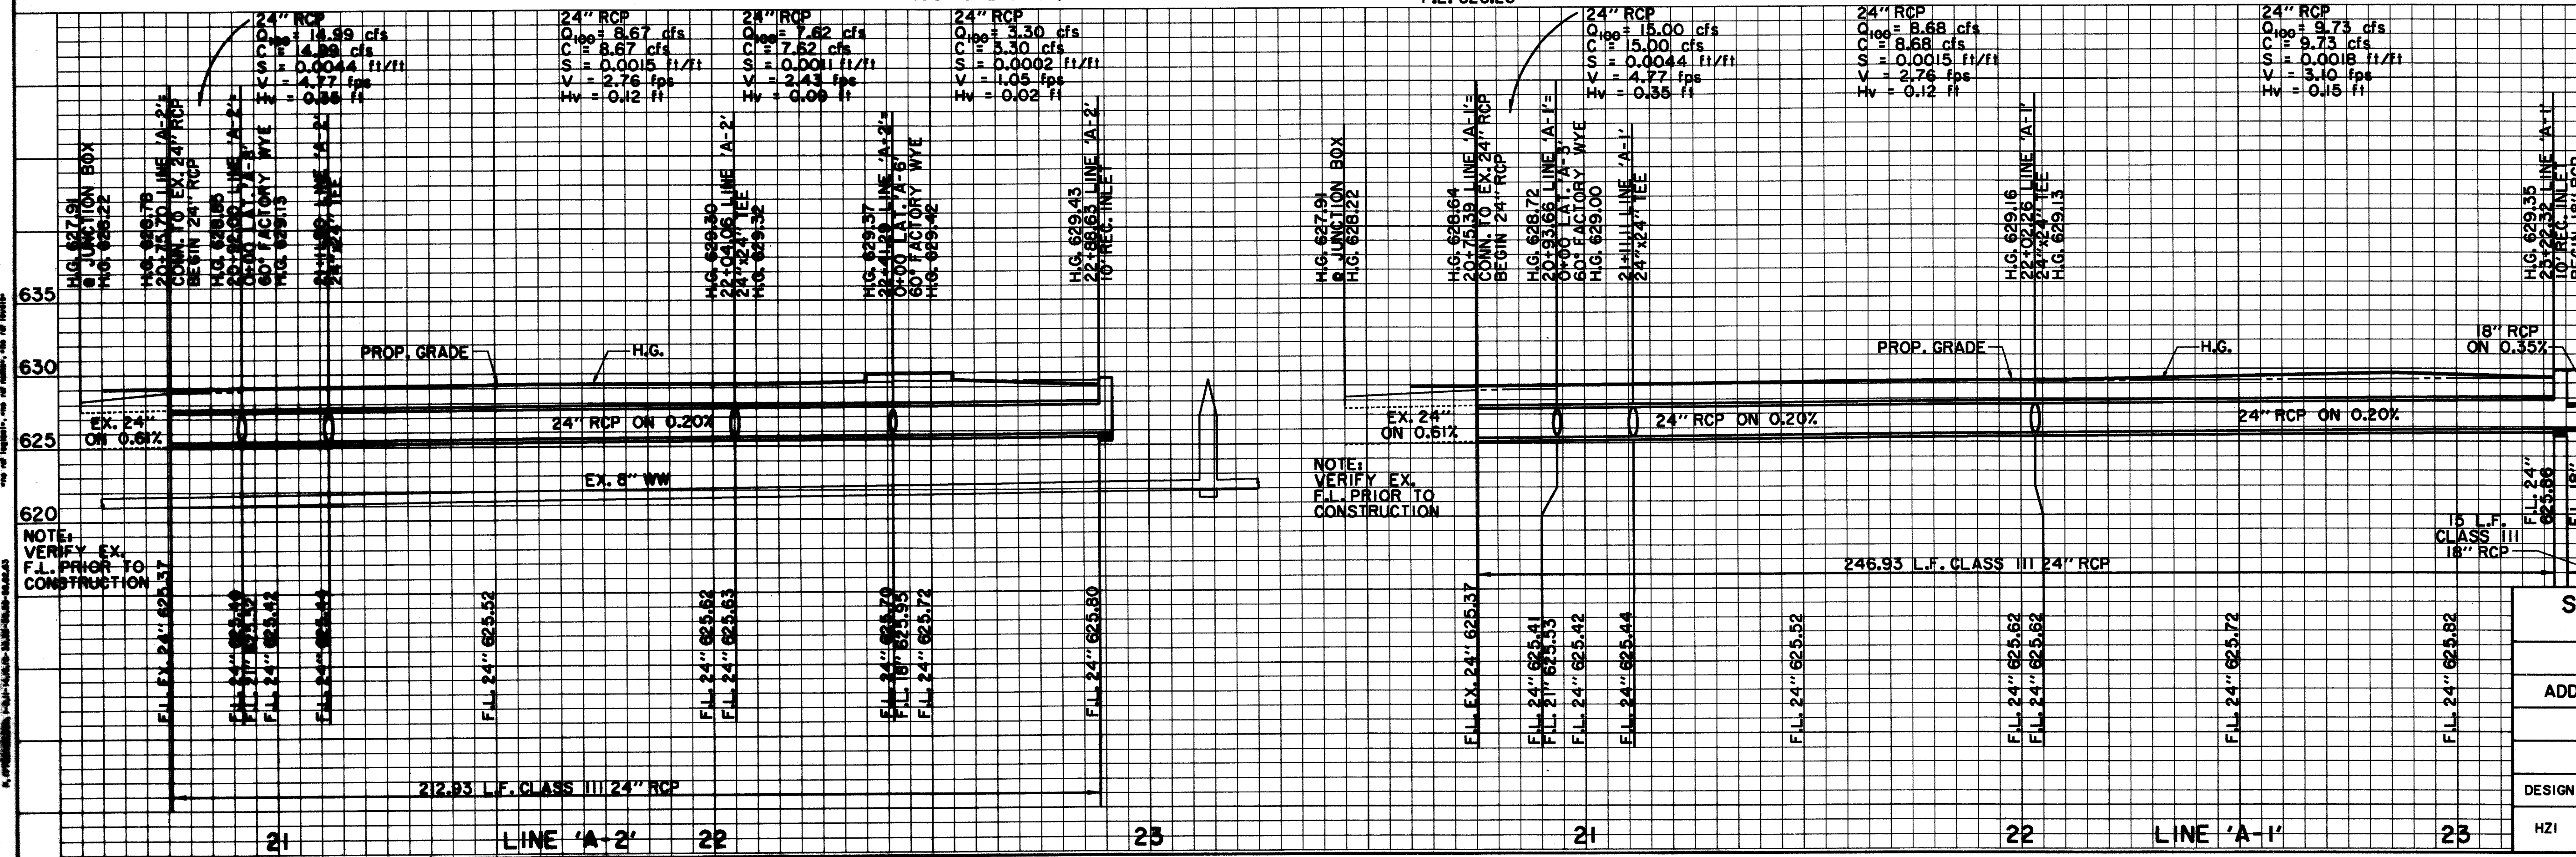

BENCHMARKS:
USC & GS E-921 DISK IN BRICK
WALL OF OLD ADDISON SCHOOL
HOUSE (MAGIC TIME MACHINE
RESTAURANT) ON SOUTH WALL,
4' EAST OF CENTER OF THE
ENTRANCE, 4.7' ABOVE THE
GROUND.
ELEV. 650.61

"□" ON SOUTHEAST CORNER OF
CONCRETE WALK AT FRONT
ENTRANCE TO 4805 ARAPAHO
ROAD.
ELEV. 650.61

THE SEAL APPEARING ON THIS
DOCUMENT WAS AUTHORIZED BY
KENNETH A. ROBERTS, P.E. 55446
ON OCTOBER 24, 1997

10-29-97

STORMWATER PLAN & PROFILE					
LINES 'A-1' & 'A-2'					
ARAPAHO ROAD					
ADDISON ROAD TO DALLAS NORTH TOLLWAY					
TOWN OF ADDISON, TEXAS					
Hull-Zollars, Inc./Consulting Engineers Dallas, Fort Worth, Houston, Phoenix, Tustin					
DESIGN	DRAWN	APPR.	SCALE	DATE	PROJECT NO.
HZ1	HZ1	KAR	1/4"=20' 1/8"=6'	OCT 97	1772-01
					ST-6