


GENERAL NOTES
 REFERENCE T.U. ELECTRIC SPECIFICATION MDD-5
 CITY OF ADDISON TO PROVIDE PAVING STATIONS AND TO PROVIDE PROPOSED FINISHED ELEVATIONS AT MANHOLE AND SWGR LOCATIONS
 LOCATION AND ELEVATIONS OF EXISTING AND PROPOSED FOREIGN UTILITIES IS ESTIMATED. CONTRACTOR TO LOCATE AND VERIFY ALL FOREIGN UTILITIES.

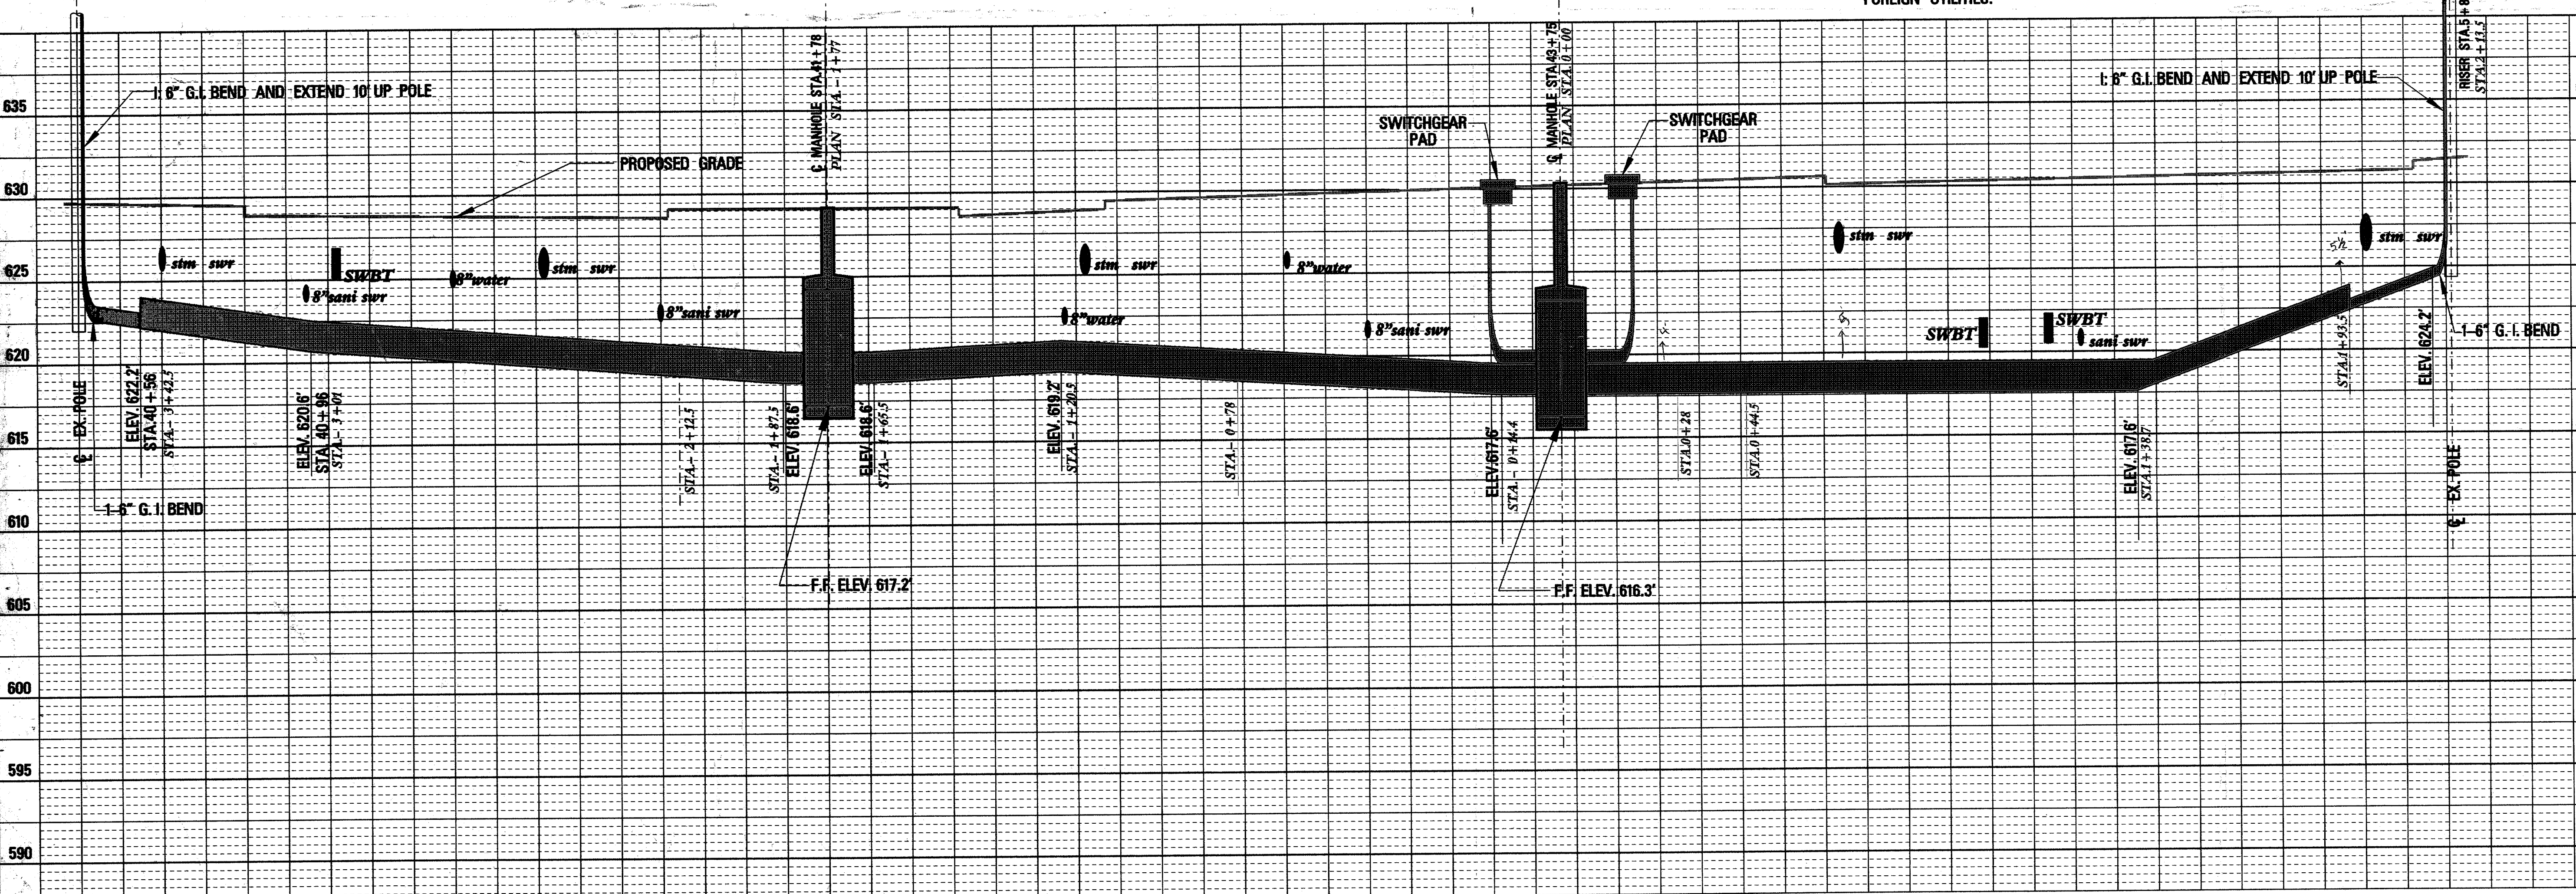

UNIT ID	DWG TYPE	ESTIMATE	W.A.	LIST OF DRAWINGS	APP.	ENG.	CH.	DATE	NO.	DATE	NO.	DATE
				SCALE H 1"=20'-0" V 1"=5'-0"	APP. LJB			DATE 4/22/98				
				ADD: ADDISON ROAD EXPANSION	APP. LJB							
				ARAPAHO RD. AT ADDISON RD.	APP. LJB							
				REVISED DUCT ROUTE FROM STA 42+13								
				TO STA 43+75 AT CUST. REQUEST								
				REVISION DESCRIPTION								

Revised 5-11-98
Johann