

PLANS FOR THE CONSTRUCTION OF
 PAVING, BRIDGE, STORM SEWER, WATER, SANITARY SEWER
 SIGNALIZATION AND STREETScape IMPROVEMENTS FOR

ARAPAHO ROAD - PHASE III

FROM SURVEYOR BOULEVARD TO ADDISON ROAD

STATION 34+07.75 TO STATION 87+88.00 (LENGTH = 5381 FT = 1.02 MILES)

PROJECT RECORD COPY I

TOWN OF
ADDISON

R. SCOTT WHEELER
 MAYOR

DIANE MALLORY GLYNDA TURNER
 JIMMY NIEMANN GREGORY S. HIRSH
 COUNCIL MEMBERS

FREDERICK M. SILVER JOE CHOW
 MAYOR PRO TEMPORE DEPUTY MAYOR PRO TEMPORE

RON WHITEHEAD
 CITY MANAGER


MIKE MURPHY
 DIRECTOR OF PUBLIC WORKS

OWNER:

TOWN OF ADDISON
 DEPARTMENT OF PUBLIC WORKS
 16801 WESTGROVE
 P.O. BOX 144
 ADDISON, TEXAS 75001
 (972) 450-2886

ENGINEER:

HNTB CORPORATION
 5910 WEST PLANO PARKWAY, SUITE 200
 DALLAS, TEXAS 75093
 (972) 661-5626

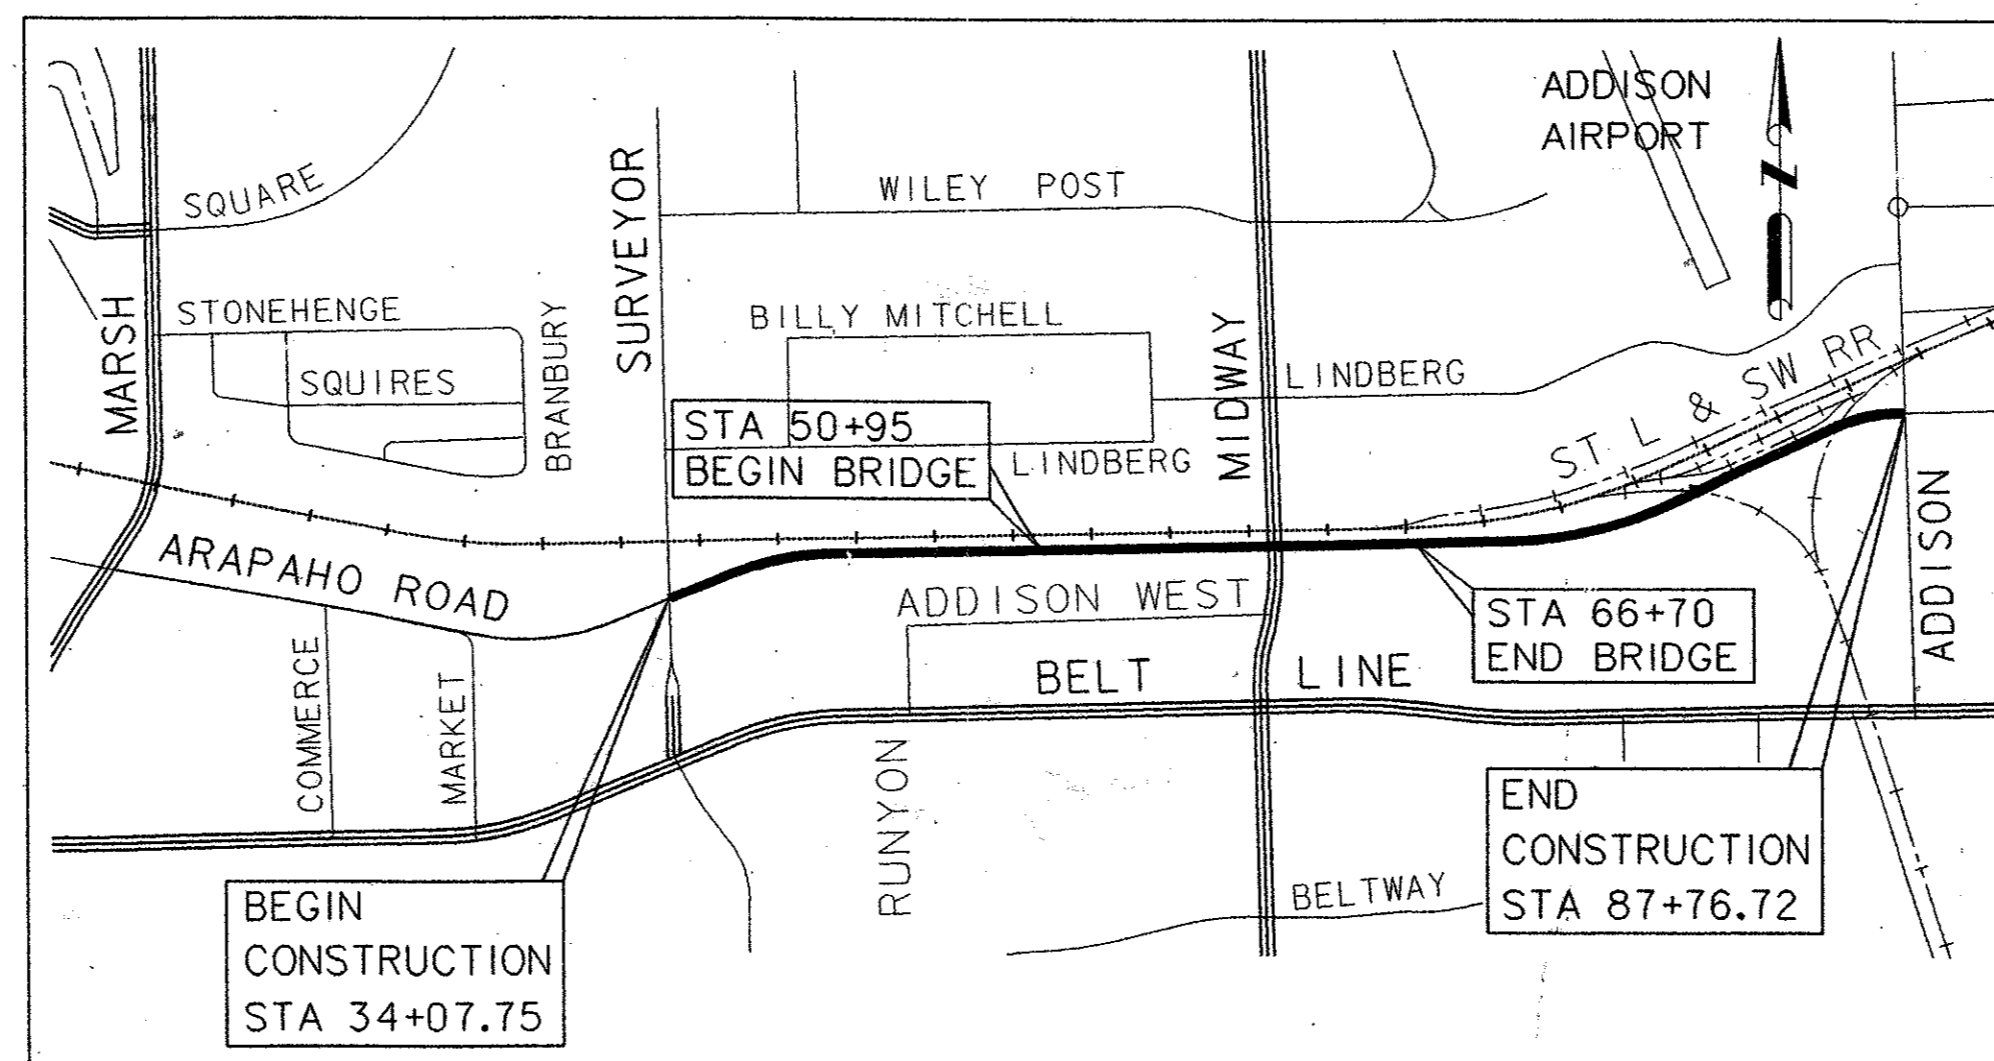

LOCATION MAP
 NOT TO SCALE

