
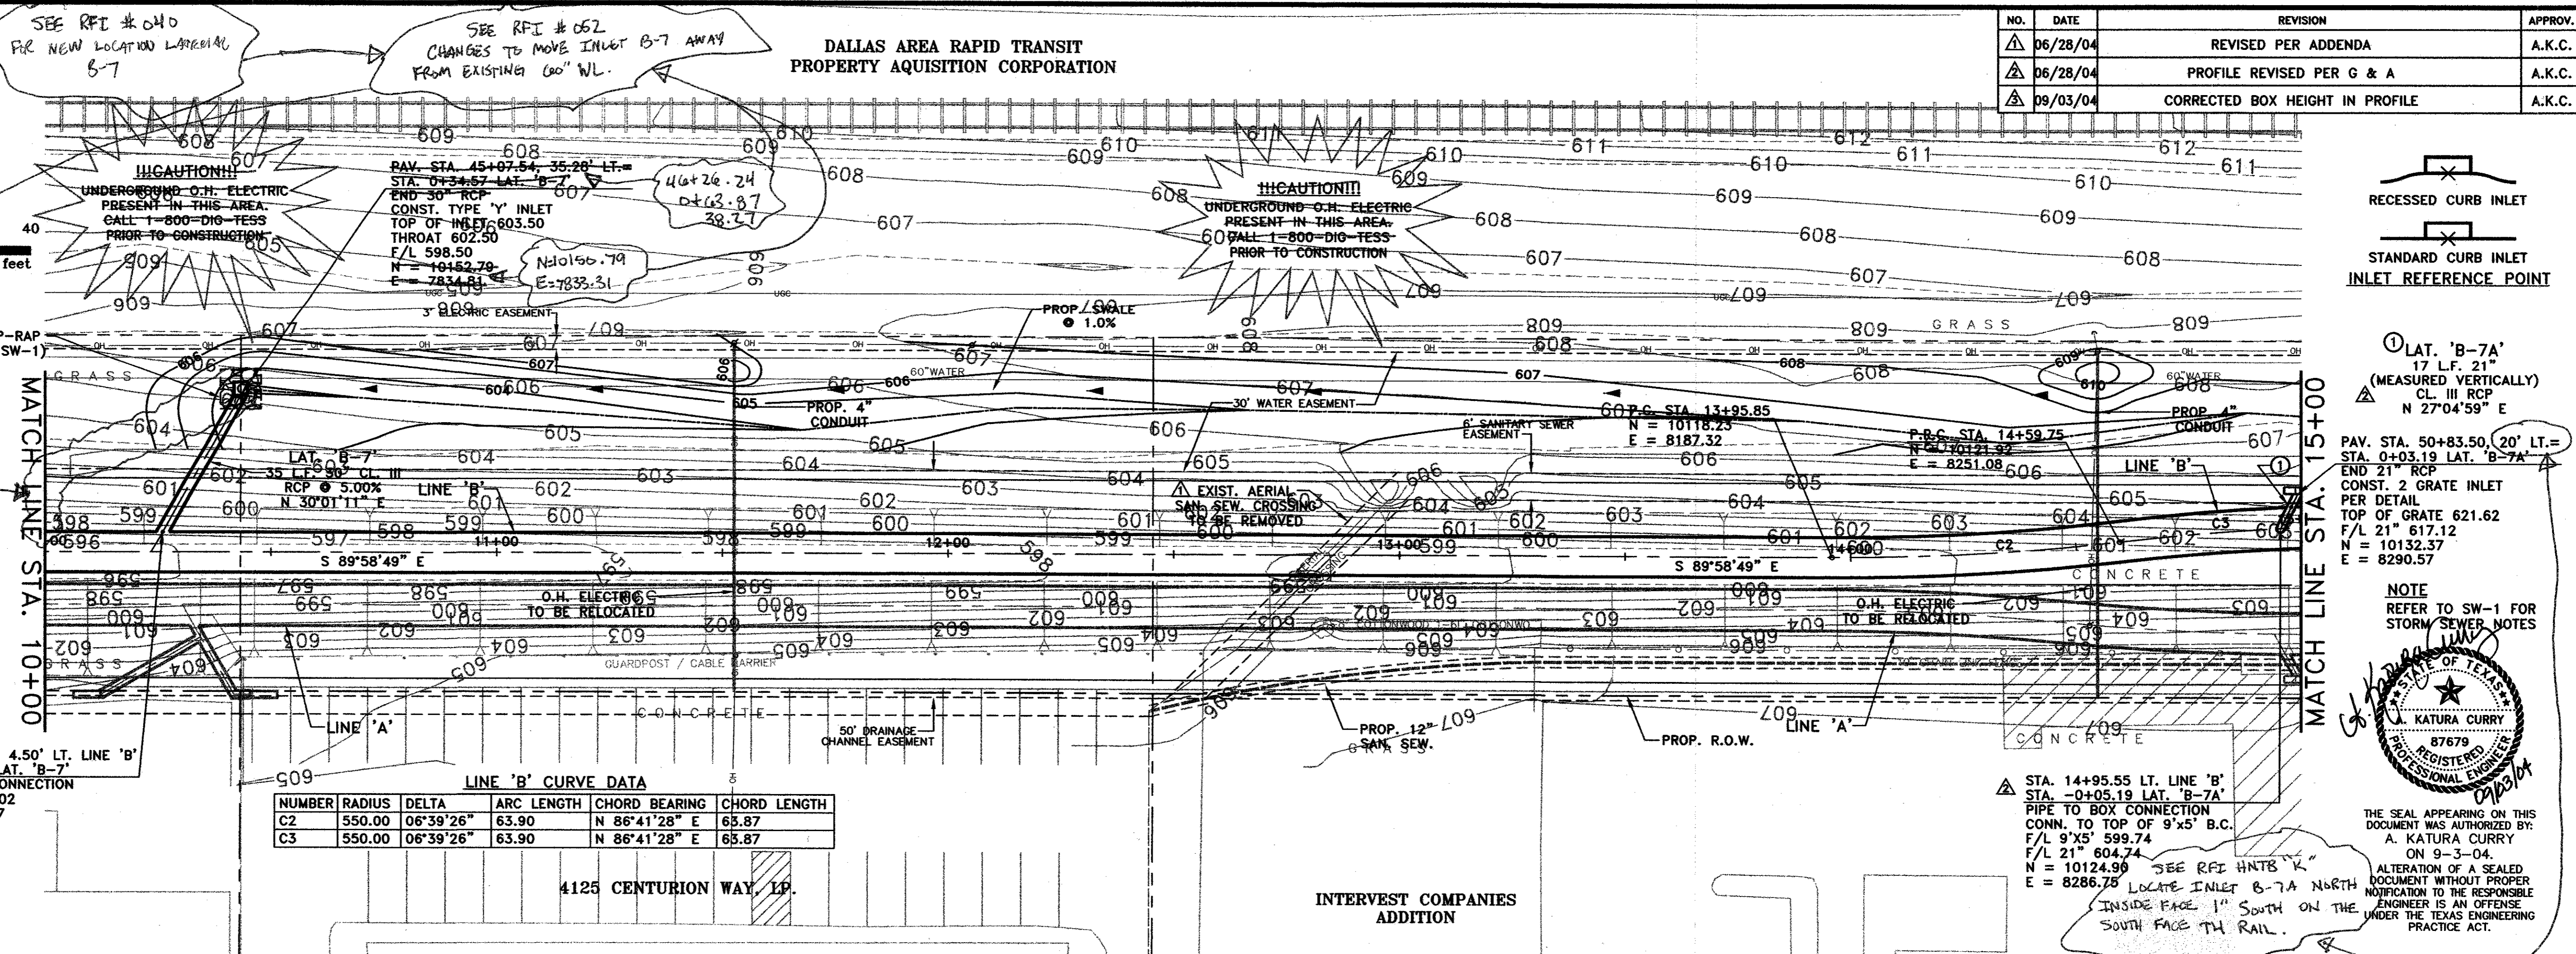


DALLAS AREA RAPID TRANSIT
PROPERTY ACQUISITION CORPORATION

NO.	DATE	REVISION	APPROV.
△	06/28/04	REVISED PER ADDENDA	A.K.C.
△	06/28/04	PROFILE REVISED PER G & A	A.K.C.
△	09/03/04	CORRECTED BOX HEIGHT IN PROFILE	A.K.C.

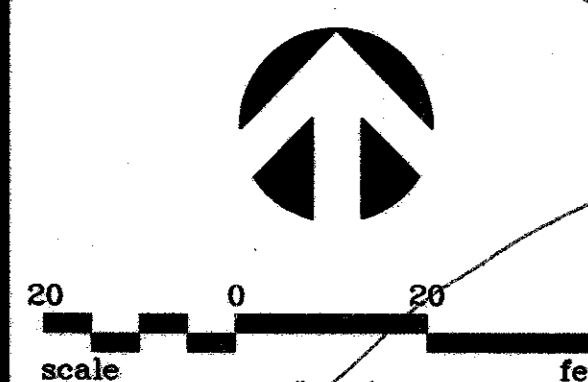

LINE 'B' CURVE DATA


NUMBER	RADIUS	DELTA	ARC LENGTH	CHORD BEARING	CHORD LENGTH
C2	550.00	06°39'26"	63.90	N 86°41'28" E	65.87
C3	550.00	06°39'26"	63.90	N 86°41'28" E	65.87

STA. 10+26.04, 4.50' LT. LINE 'B'
STA. 0+00.00 LAT. 'B-7'
PIPE TO BOX CONNECTION
F/L 9'x5' 596.02
F/L 30" 597.27
N = 10122.86
E = 7817.52

STA. 14+95.55 LT. LINE 'B'
STA. -0+05.19 LAT. 'B-7A'
CONN. TO TOP OF 9'x5' B.C.
F/L 9'x5' 599.74
F/L 21" 604.74
N = 10124.30
E = 8286.75

NOTE
REFER TO SW-1 FOR
STORM SEWER NOTES

THE SEAL APPEARING ON THIS DOCUMENT WAS AUTHORIZED BY:
A. KATURA CURRY
ON 9-3-04.
ALTERATION OF A SEALED DOCUMENT WITHOUT PROPER NOTIFICATION TO THE RESPONSIBLE ENGINEER IS AN OFFENSE UNDER THE TEXAS ENGINEERING PRACTICE ACT.

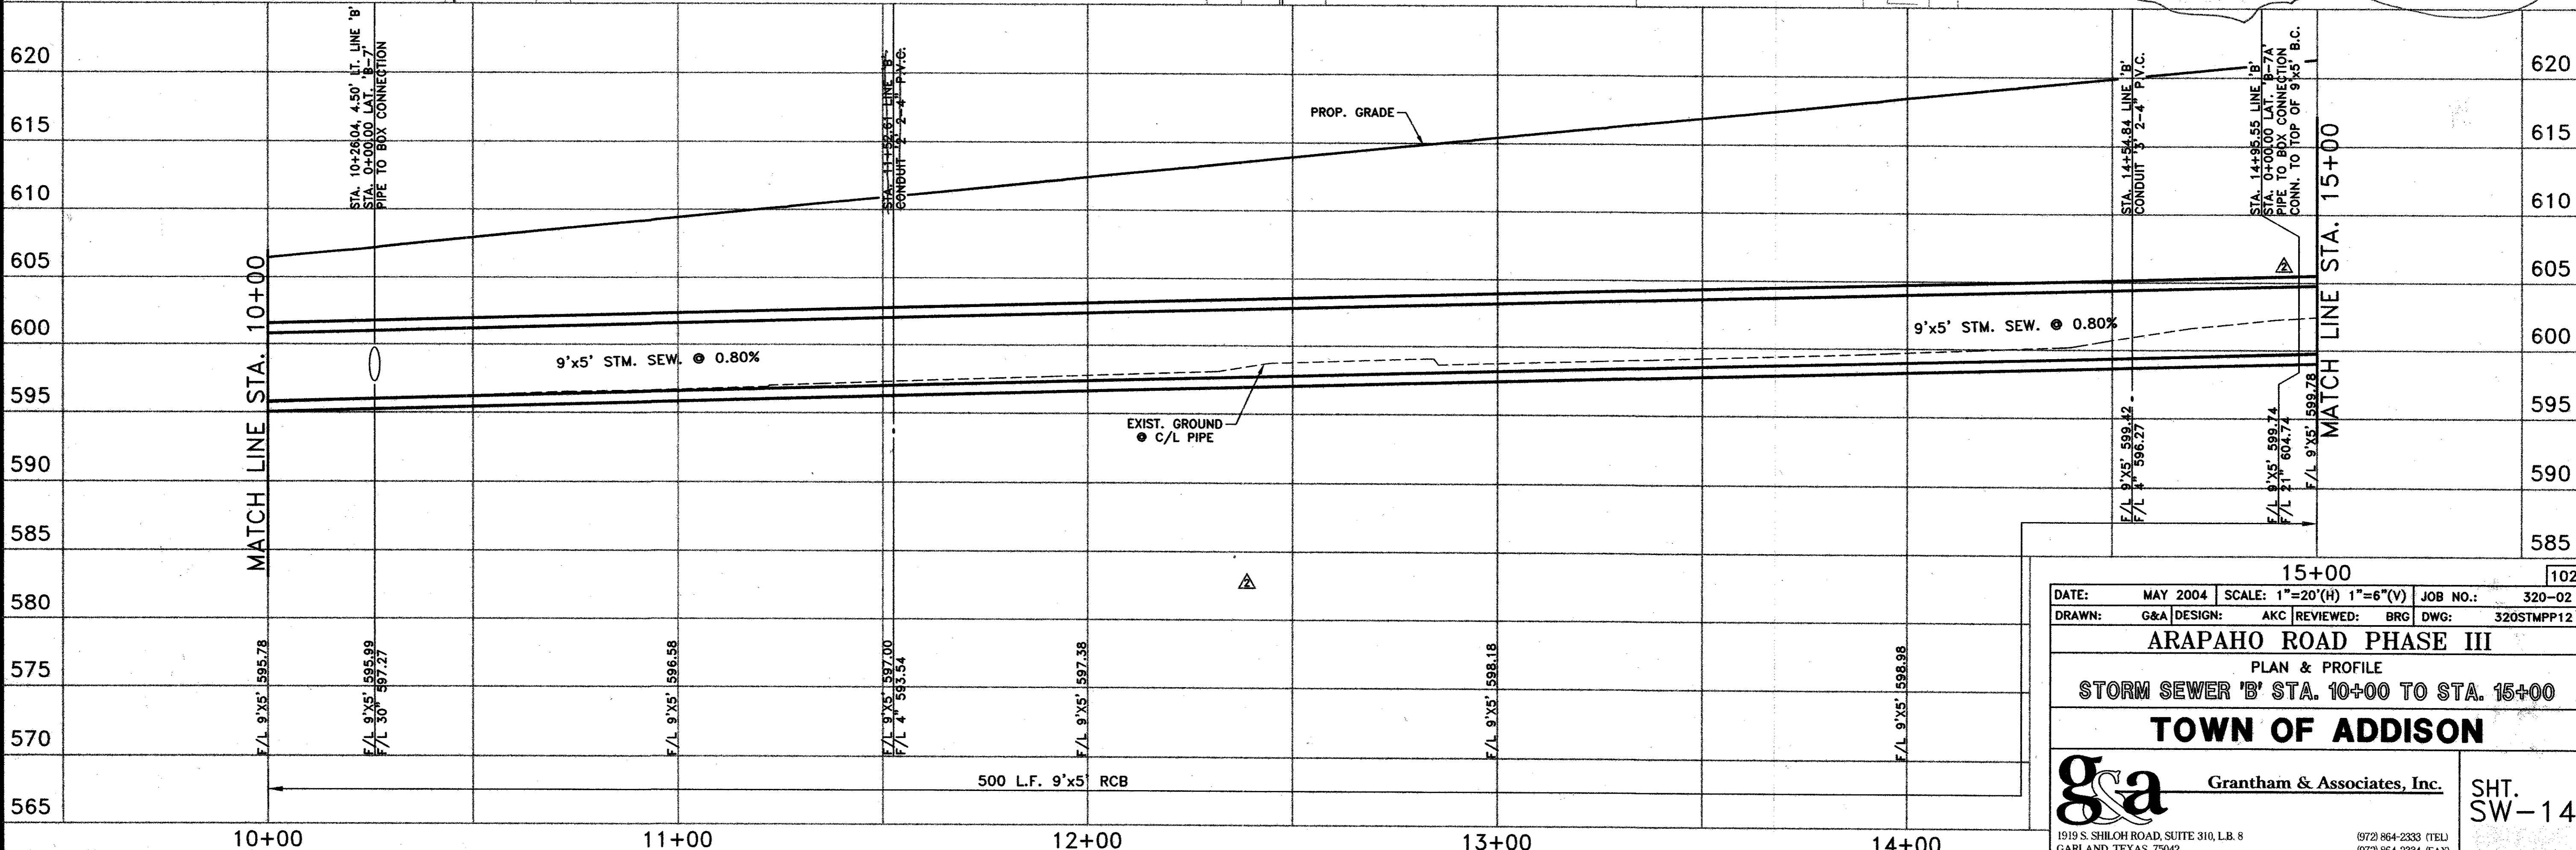

15+00

DATE: MAY 2004 | SCALE: 1"=20'(H) 1"=6'(V) | JOB NO.: 320-02

DRAWN: G&A | DESIGN: AKC | REVIEWED: BRG | DWG: 320STMP12

ARAPAHO ROAD PHASE III
PLAN & PROFILE
STORM SEWER 'B' STA. 10+00 TO STA. 15+00

TOWN OF ADDISON

g&a Grantham & Associates, Inc. SHT. SW-14

1919 S. SHILOH ROAD, SUITE 310, L.B. 8 GARLAND, TEXAS 75042 (972) 864-2333 (TEL) (972) 864-2334 (FAX)