

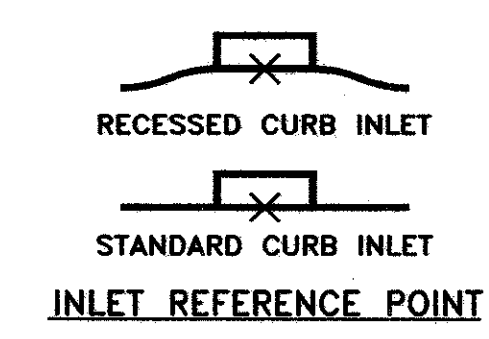
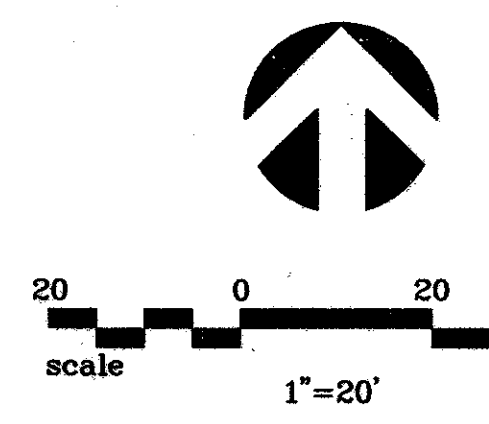
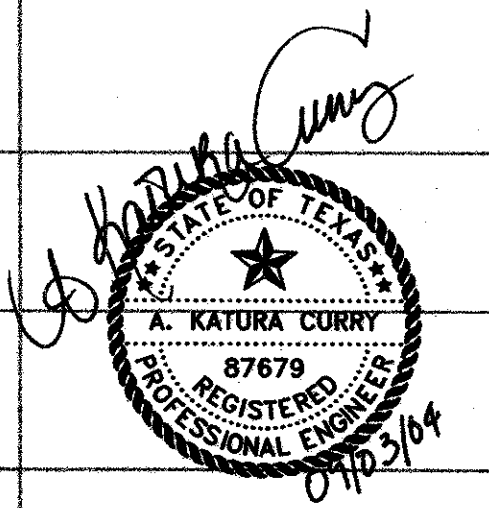


| NO. | DATE | REVISION | APPROV. |
|-----|----------|---------------------------------|---------|
| 1 | 09/03/04 | CORRECTED BOX HEIGHT IN PROFILE | A.K.C. |
| 2 | | | |
| 3 | | | |

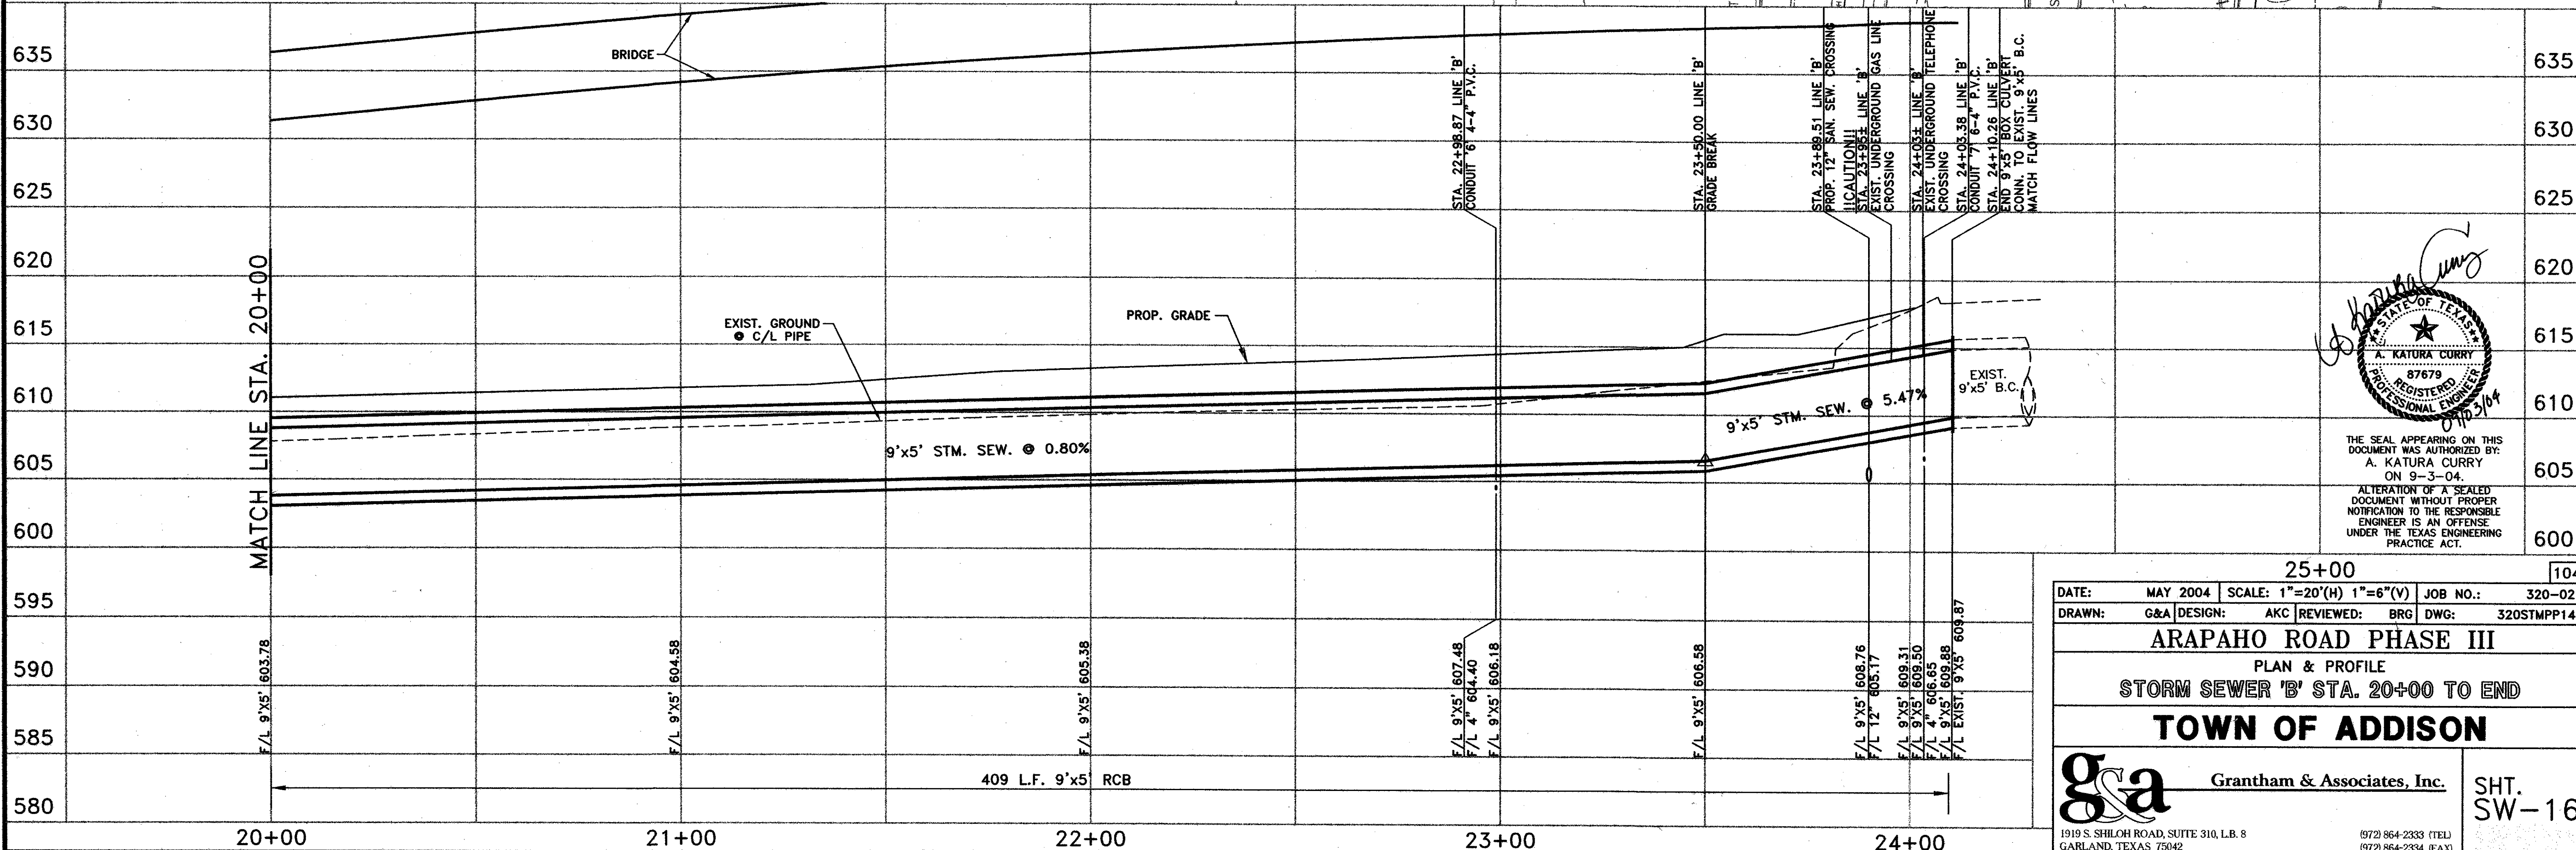

NOTE
REFER TO SW-1 FOR
STORM SEWER NOTES

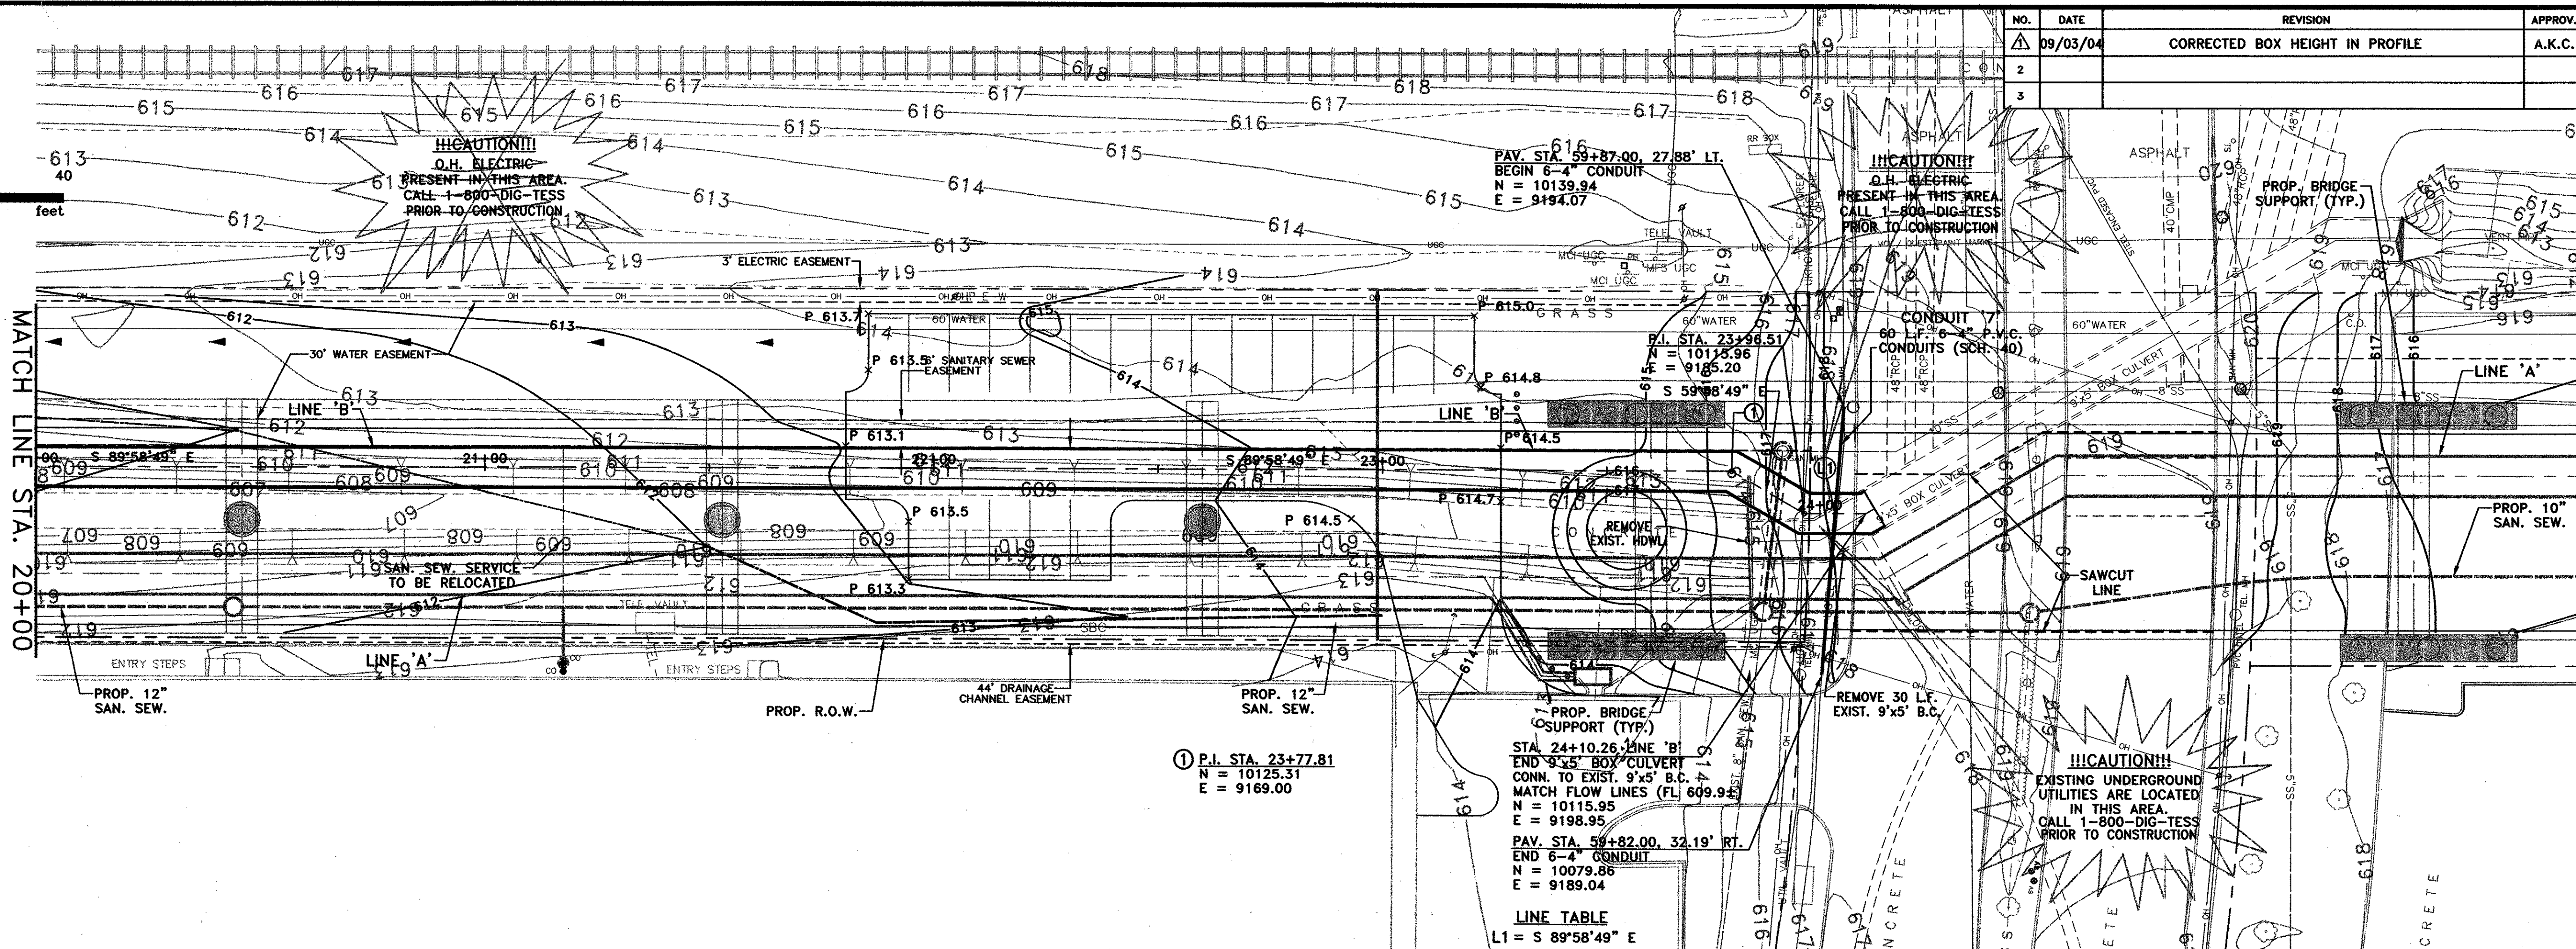

THE SEAL APPEARING ON THIS DOCUMENT WAS AUTHORIZED BY:
A. KATURA CURRY
ON 9-3-04.
ALTERATION OF A SEALED DOCUMENT WITHOUT PROPER NOTIFICATION TO THE RESPONSIBLE ENGINEER IS AN OFFENSE UNDER THE TEXAS ENGINEERING PRACTICE ACT.

| | | | | | |
|---|----------|---------|--------------------|---|--------|
| DATE: | MAY 2004 | SCALE: | 1"=20'(H) 1"=6'(V) | JOB NO.: | 320-02 |
| DRAWN: | G&A | DESIGN: | AKC | REVIEWED: | BRG |
| ARAPAHO ROAD PHASE III | | | | DWG: 320STMP14 | |
| PLAN & PROFILE | | | | | |
| STORM SEWER 'B' STA. 20+00 TO END | | | | | |
| TOWN OF ADDISON | | | | | |
| g&a Grantham & Associates, Inc. | | | | SHT. SW-16 | |
| 1919 S. SHILOH ROAD, SUITE 310, L.B. 8 GARLAND, TEXAS 75042 | | | | (972) 864-2333 (TEL) (972) 864-2334 (FAX) | |