
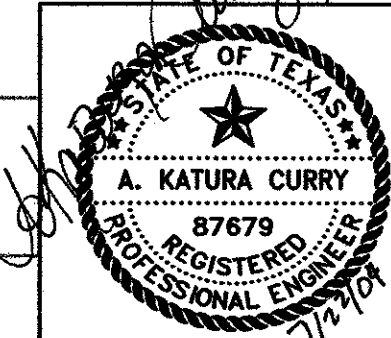
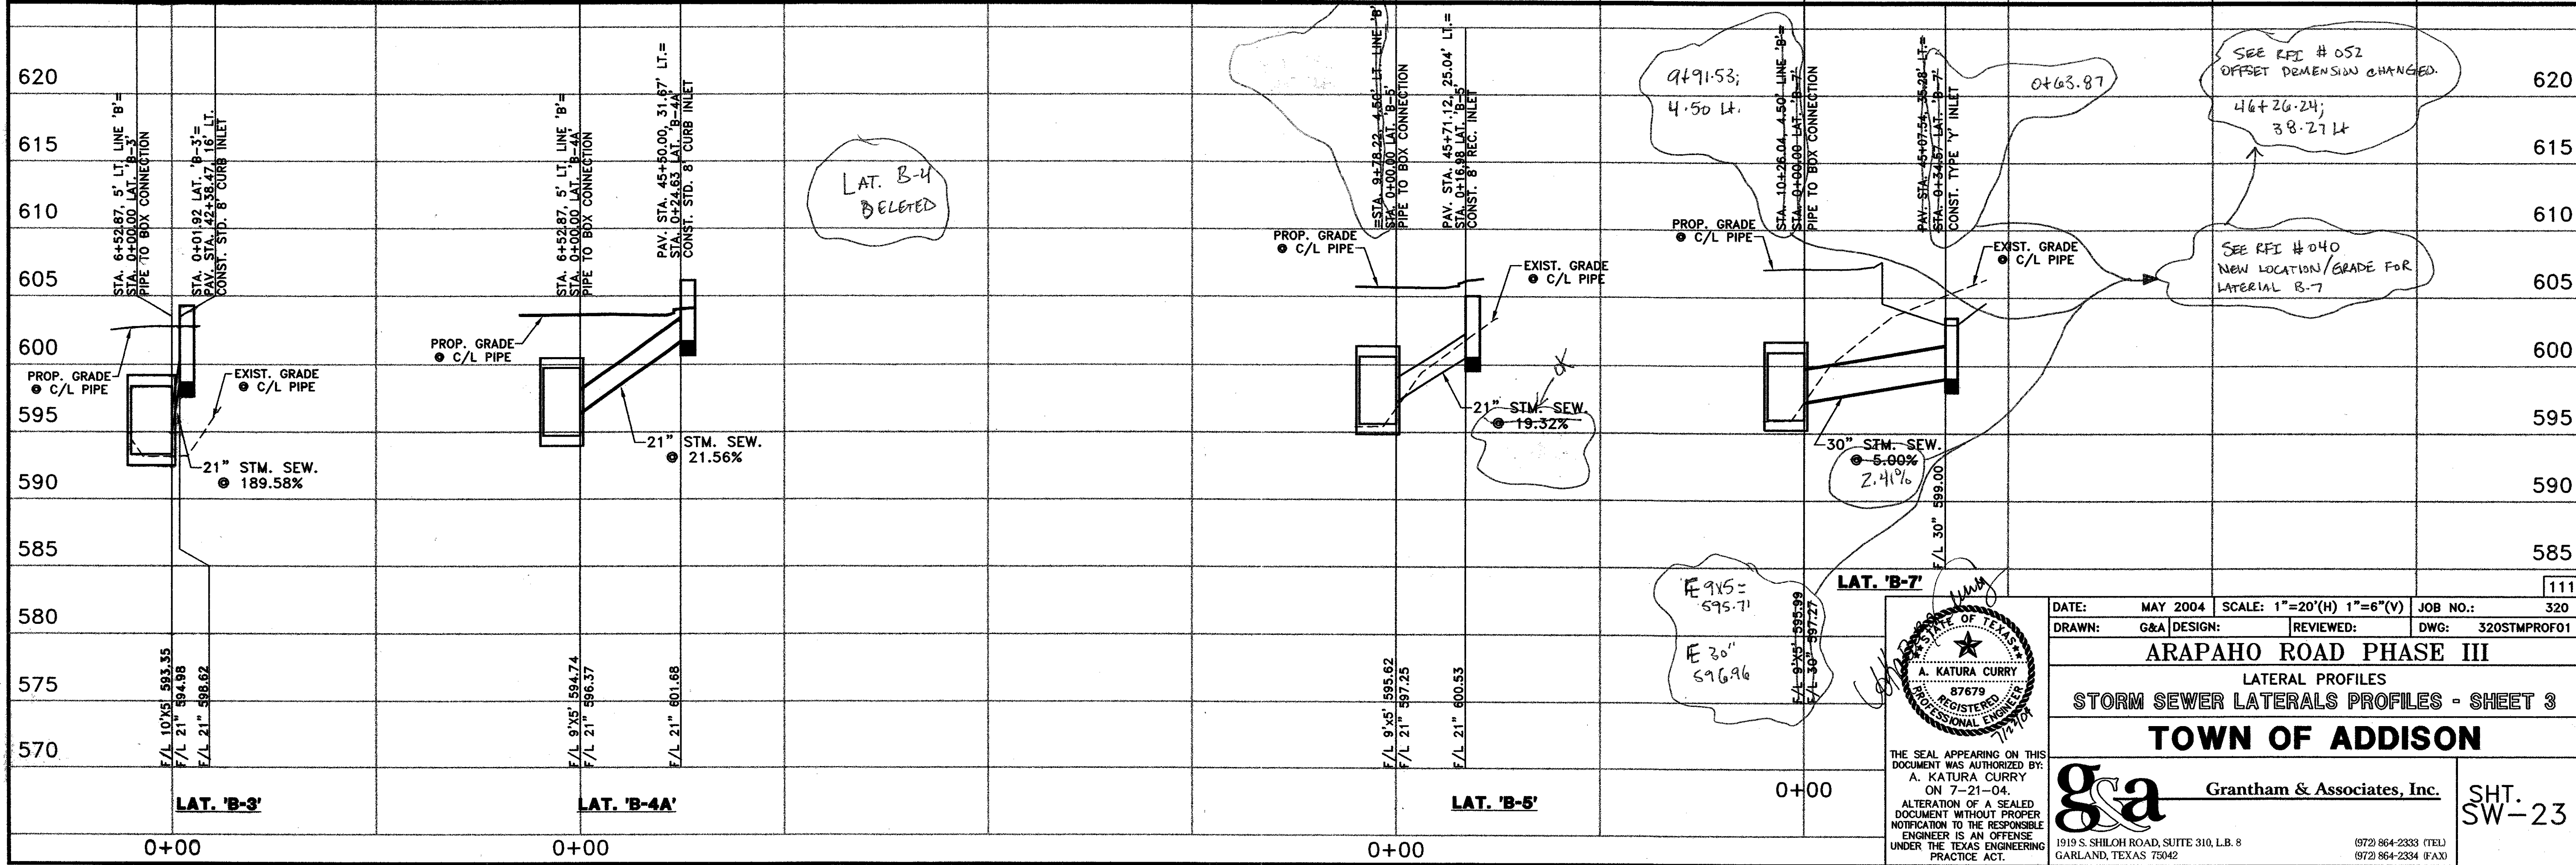


NO.	DATE	REVISION	APPROV.
1			
2			
3			

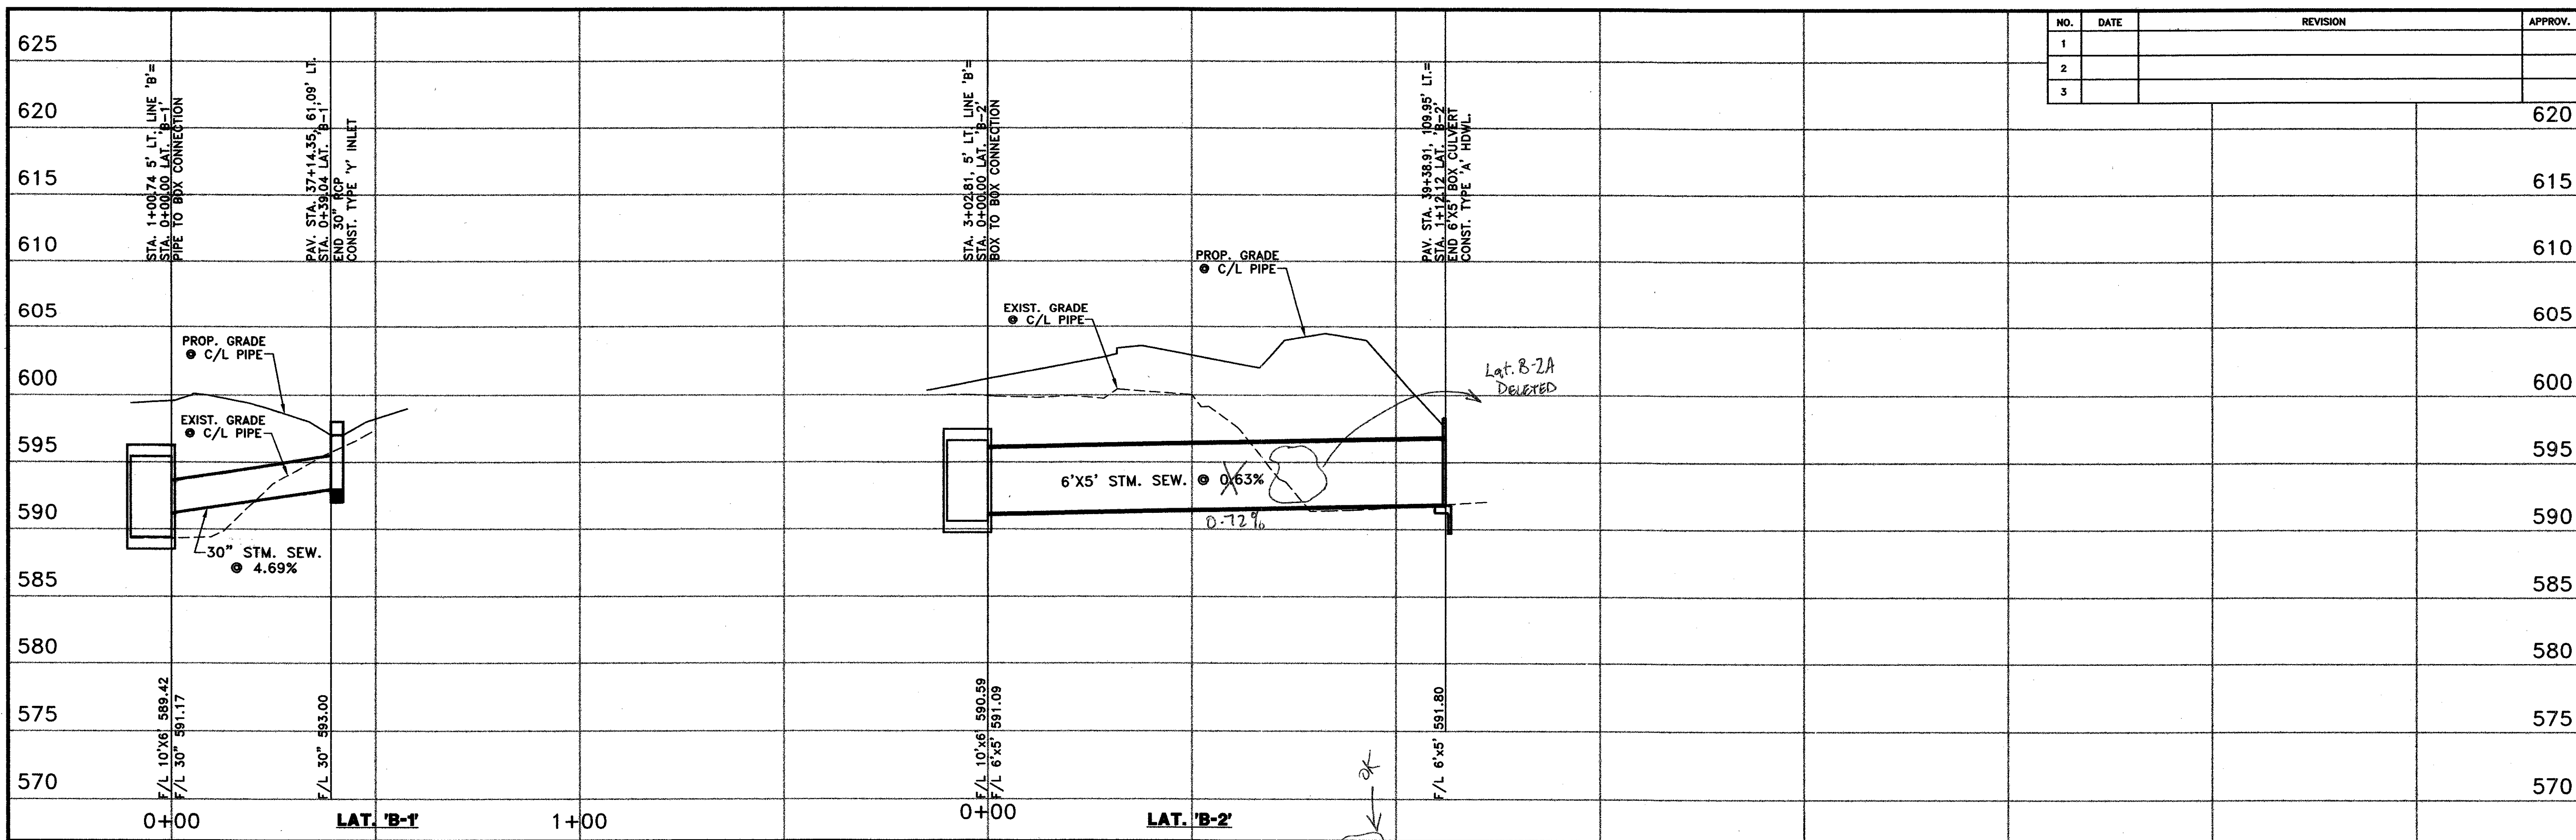

THE SEAL APPEARING ON THIS DOCUMENT WAS AUTHORIZED BY: A. KATURA CURRY ON 7-21-04. ALTERATION OF A SEALED DOCUMENT WITHOUT PROPER NOTIFICATION TO THE RESPONSIBLE ENGINEER IS AN OFFENSE UNDER THE TEXAS ENGINEERING PRACTICE ACT.

DATE: MAY 2004 SCALE: 1"=20'(H) 1"=6"(V) JOB NO.: 320  
 DRAWN: G&A DESIGN: REVIEWED: DWG: 320STMPROF01

**ARAPAHO ROAD PHASE III**  
 LATERAL PROFILES  
 STORM SEWER LATERALS PROFILES - SHEET 3  
**TOWN OF ADDISON**

**g&a** Grantham & Associates, Inc. SHT. SW-23

1919 S. SHILOH ROAD, SUITE 310, L.B. 8 GARLAND, TEXAS 75042 (972) 864-2333 (TEL) (972) 864-2334 (FAX)