


NO.	DATE	REVISION	APPROV.
1			
2			
3			

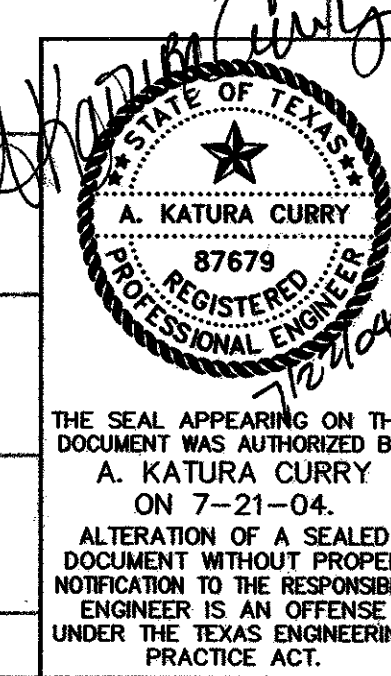

DATE: MAY 2004 SCALE: 1"=20'(H) 1"=6'(V) JOB NO.: 320
 DRAWN: G&A DESIGN: REVIEWED: DWG: 320STMPROF01

ARAPAHO ROAD PHASE III
 LATERAL PROFILES
STORM SEWER LATERALS PROFILES - SHEET 5

TOWN OF ADDISON

g&a Grantham & Associates, Inc. SHT. SW-25

1919 S. SHILOH ROAD, SUITE 310, L.B. 8 GARLAND, TEXAS 75042 (972) 864-2333 (TEL) (972) 864-2334 (FAX)