
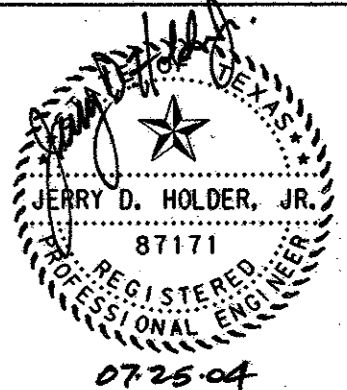
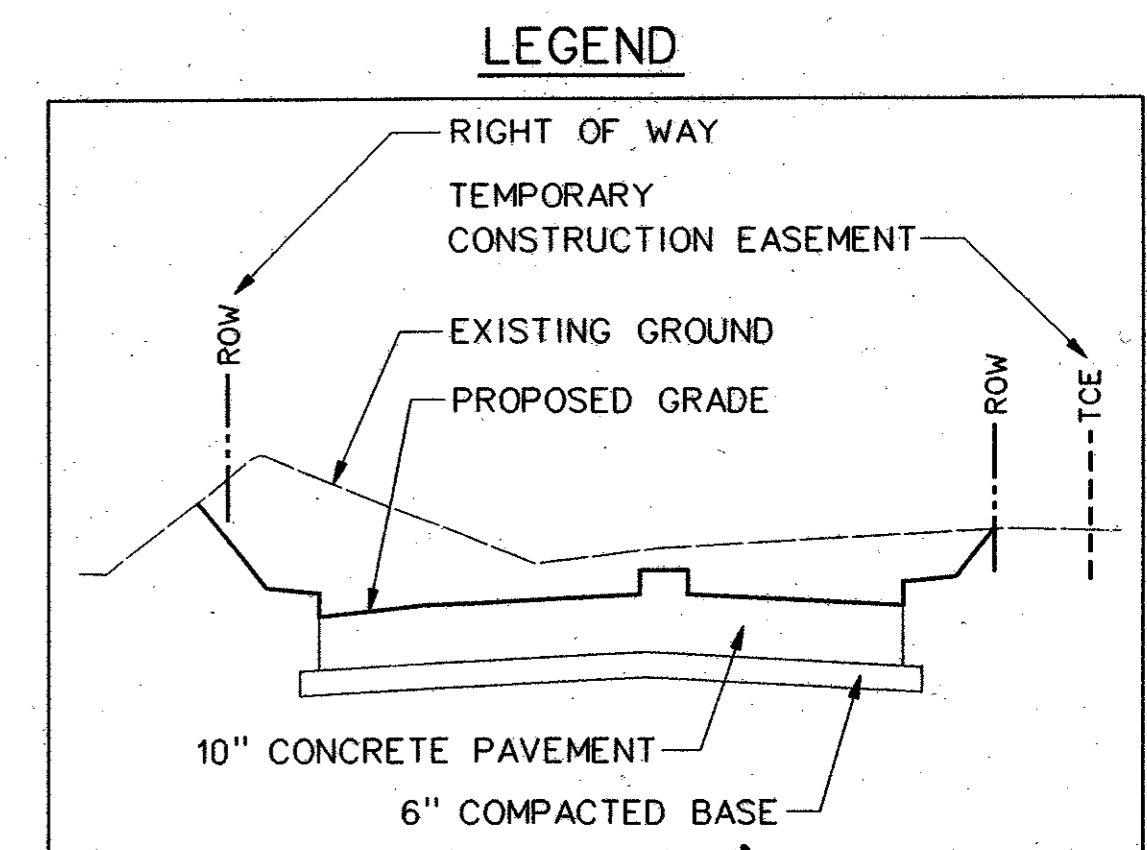
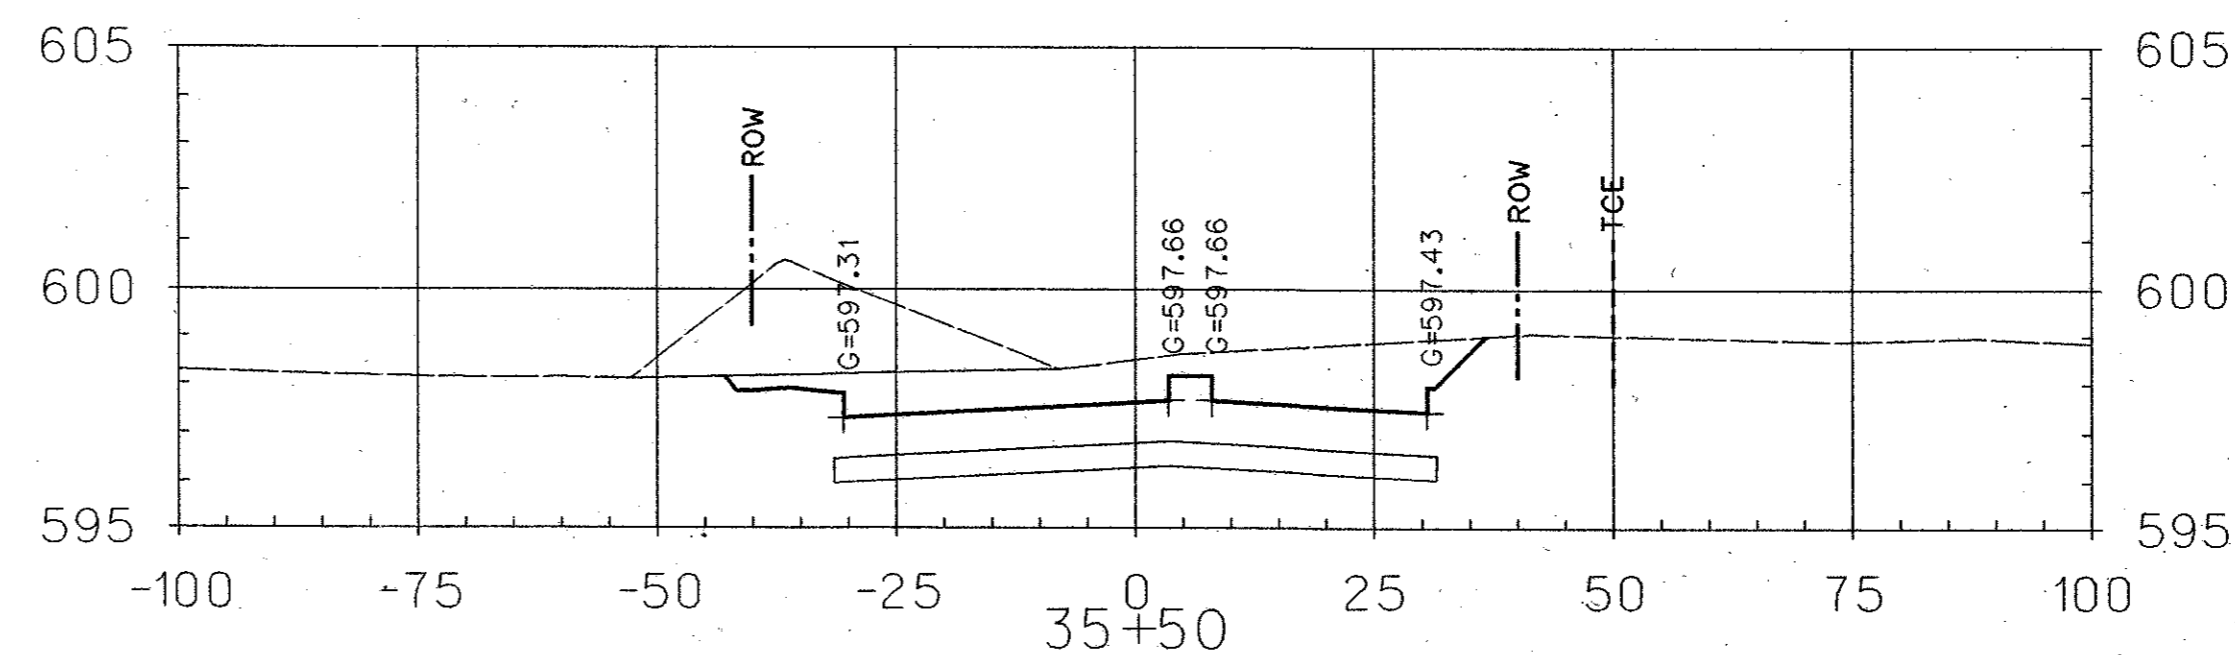
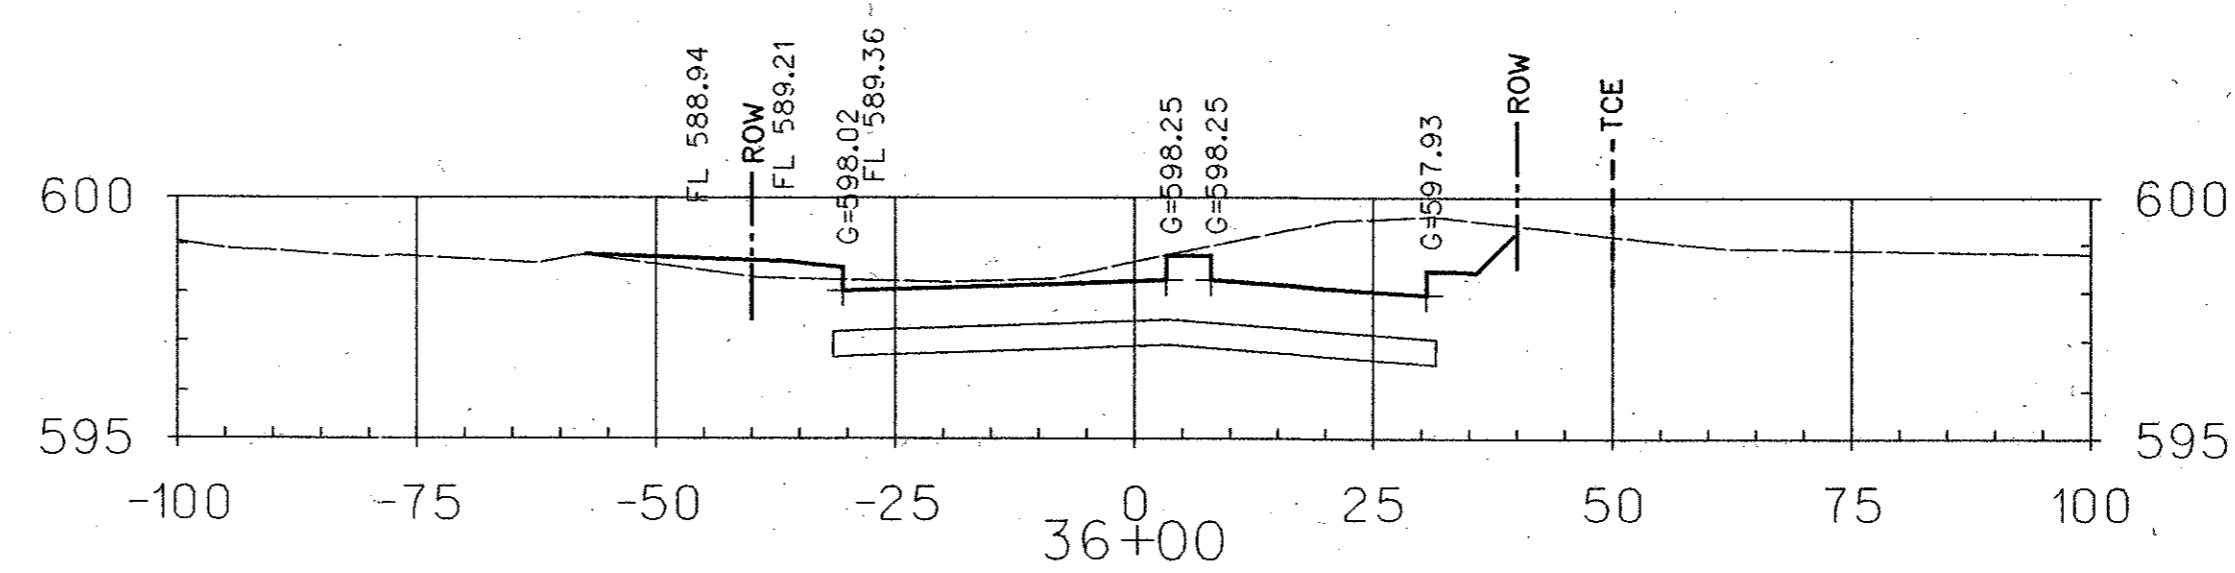
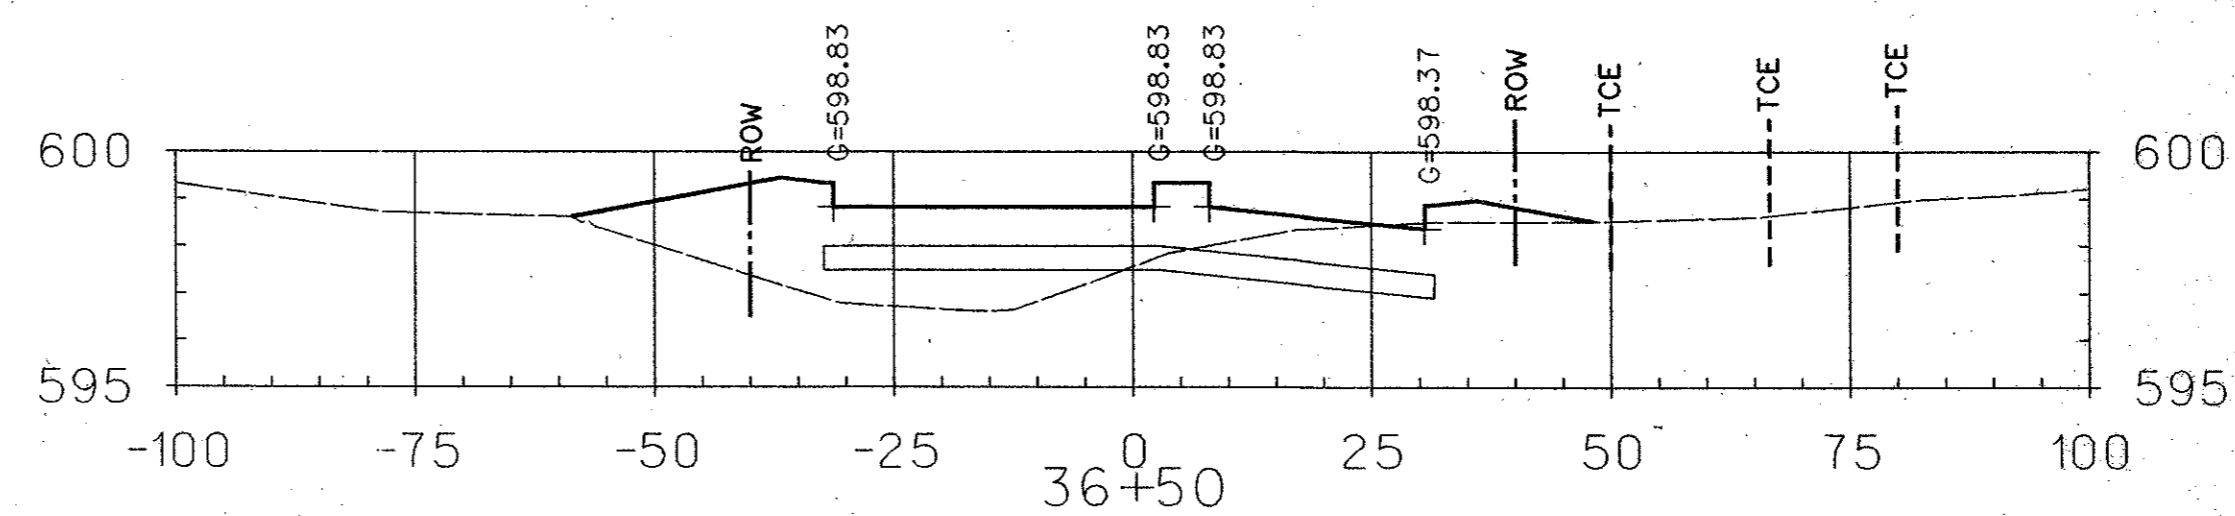
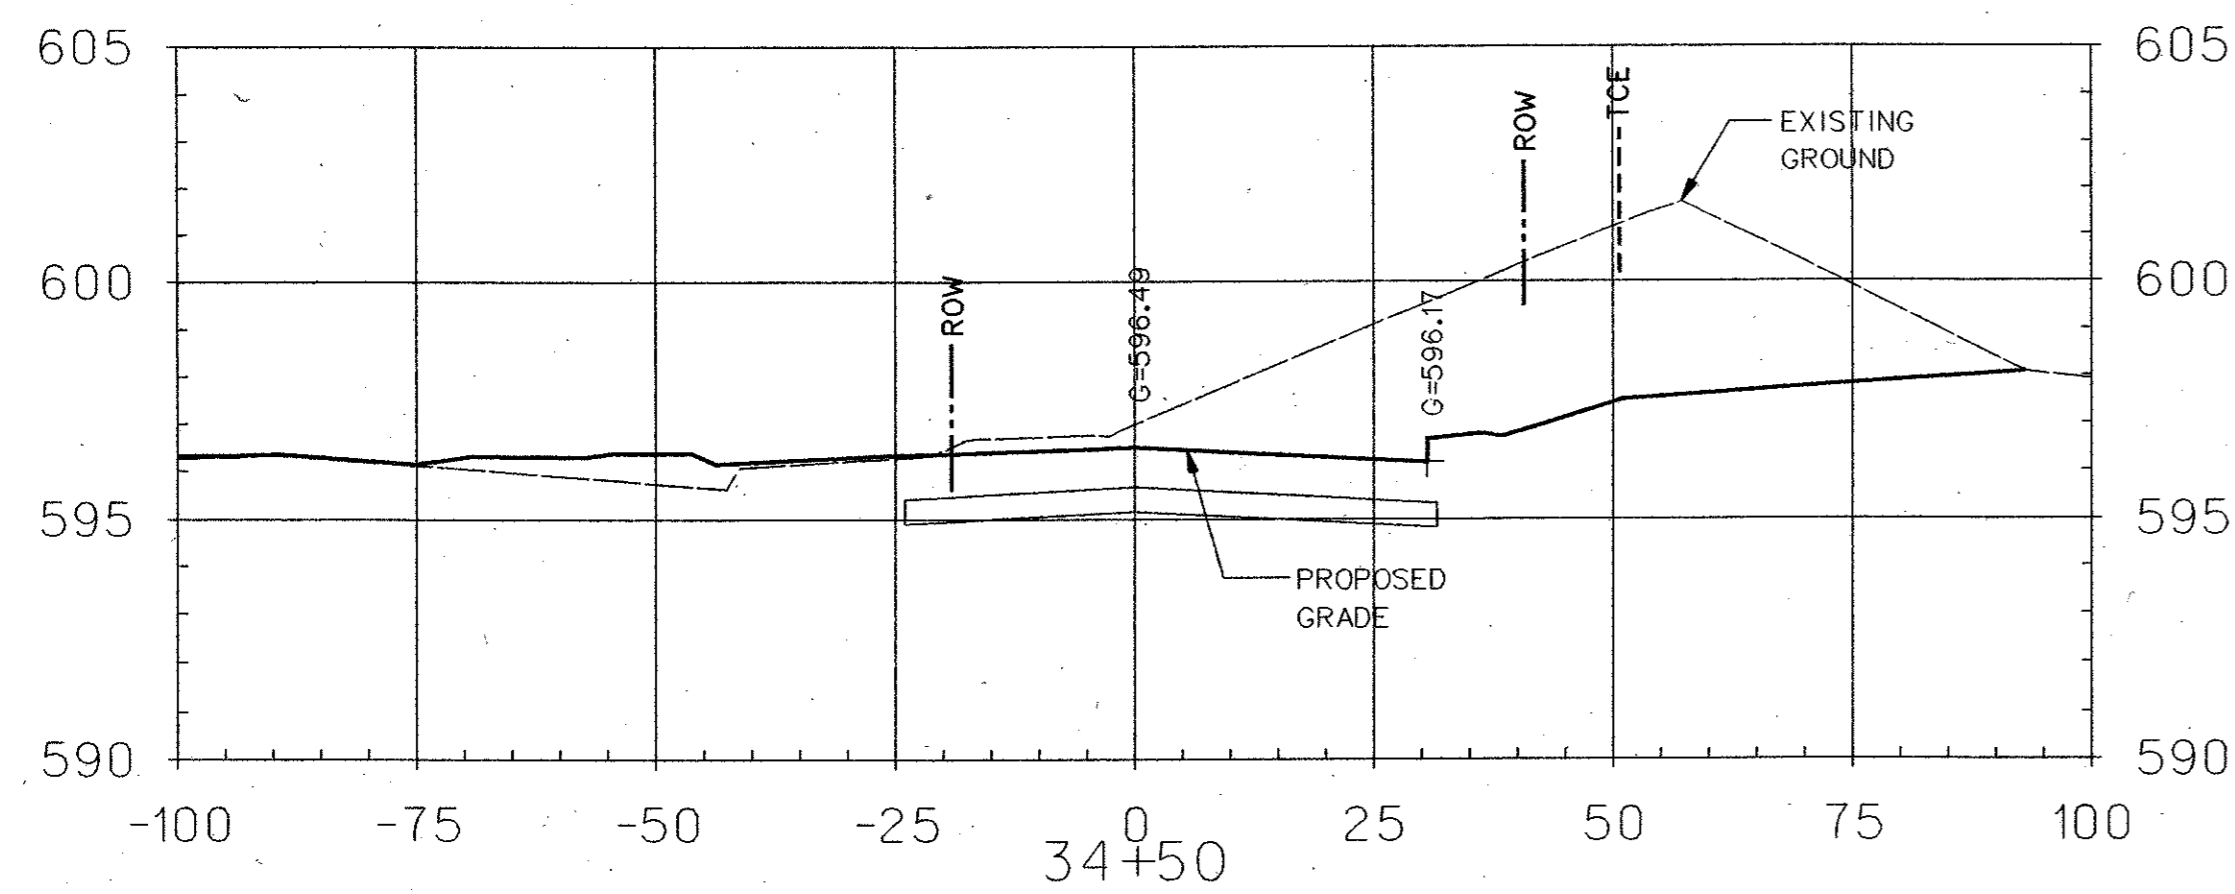


G:\25768-Ph3\h1\Cds\ar3xs01.dgn

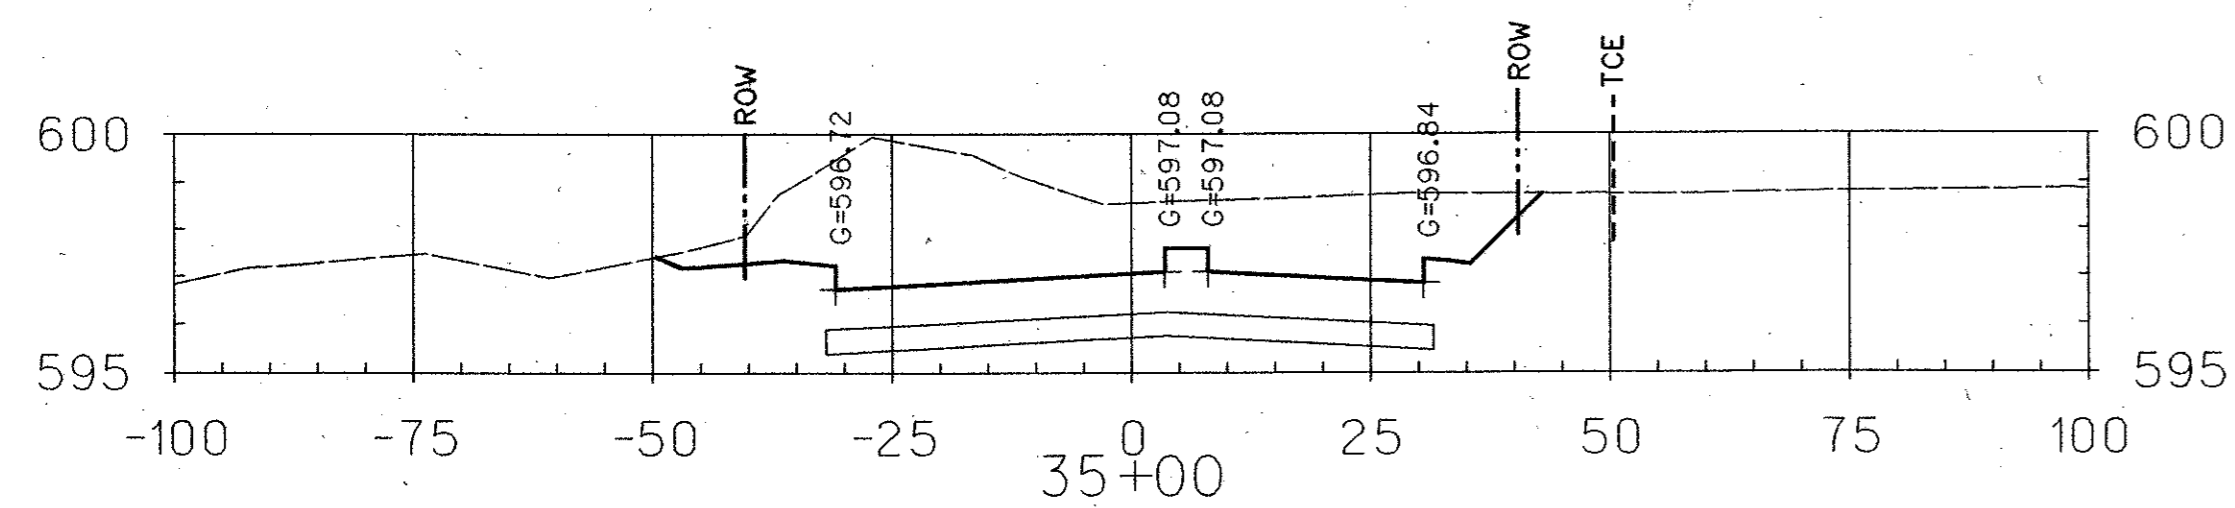

		124	
NO.	DATE	REVISION	APPROV.
<b>HNTB</b> ARCHITECTS ENGINEERS PLANNERS <i>The HNTB Companies</i>			
<b>ARAPAHO ROAD - PHASE III</b>			
SURVEYOR BOULEVARD TO ADDISON ROAD			
CROSS SECTIONS			
SHEET 1 OF 29			
TOWN OF ADDISON, TEXAS			
Design JSN	Drawn GFS	DATE	SCALE
Check JDH	Check JSN	APRIL 04	1" = 20' H 1" = 4' V
		PROJECT NO.	SHEET NO.
		25768	XS-1