
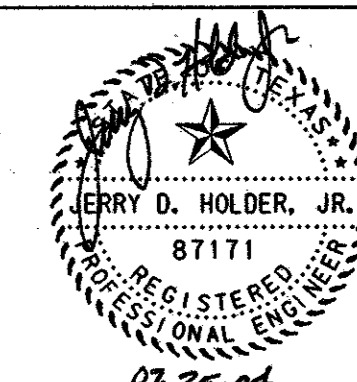
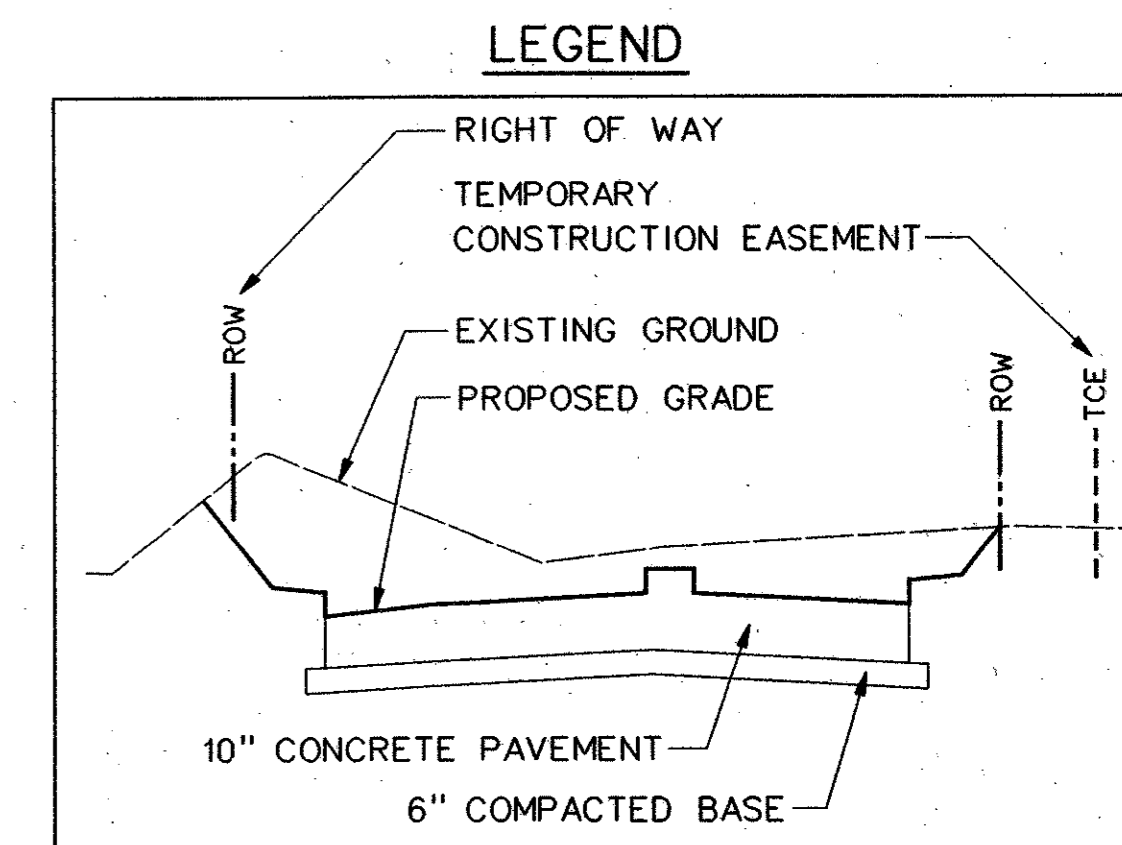
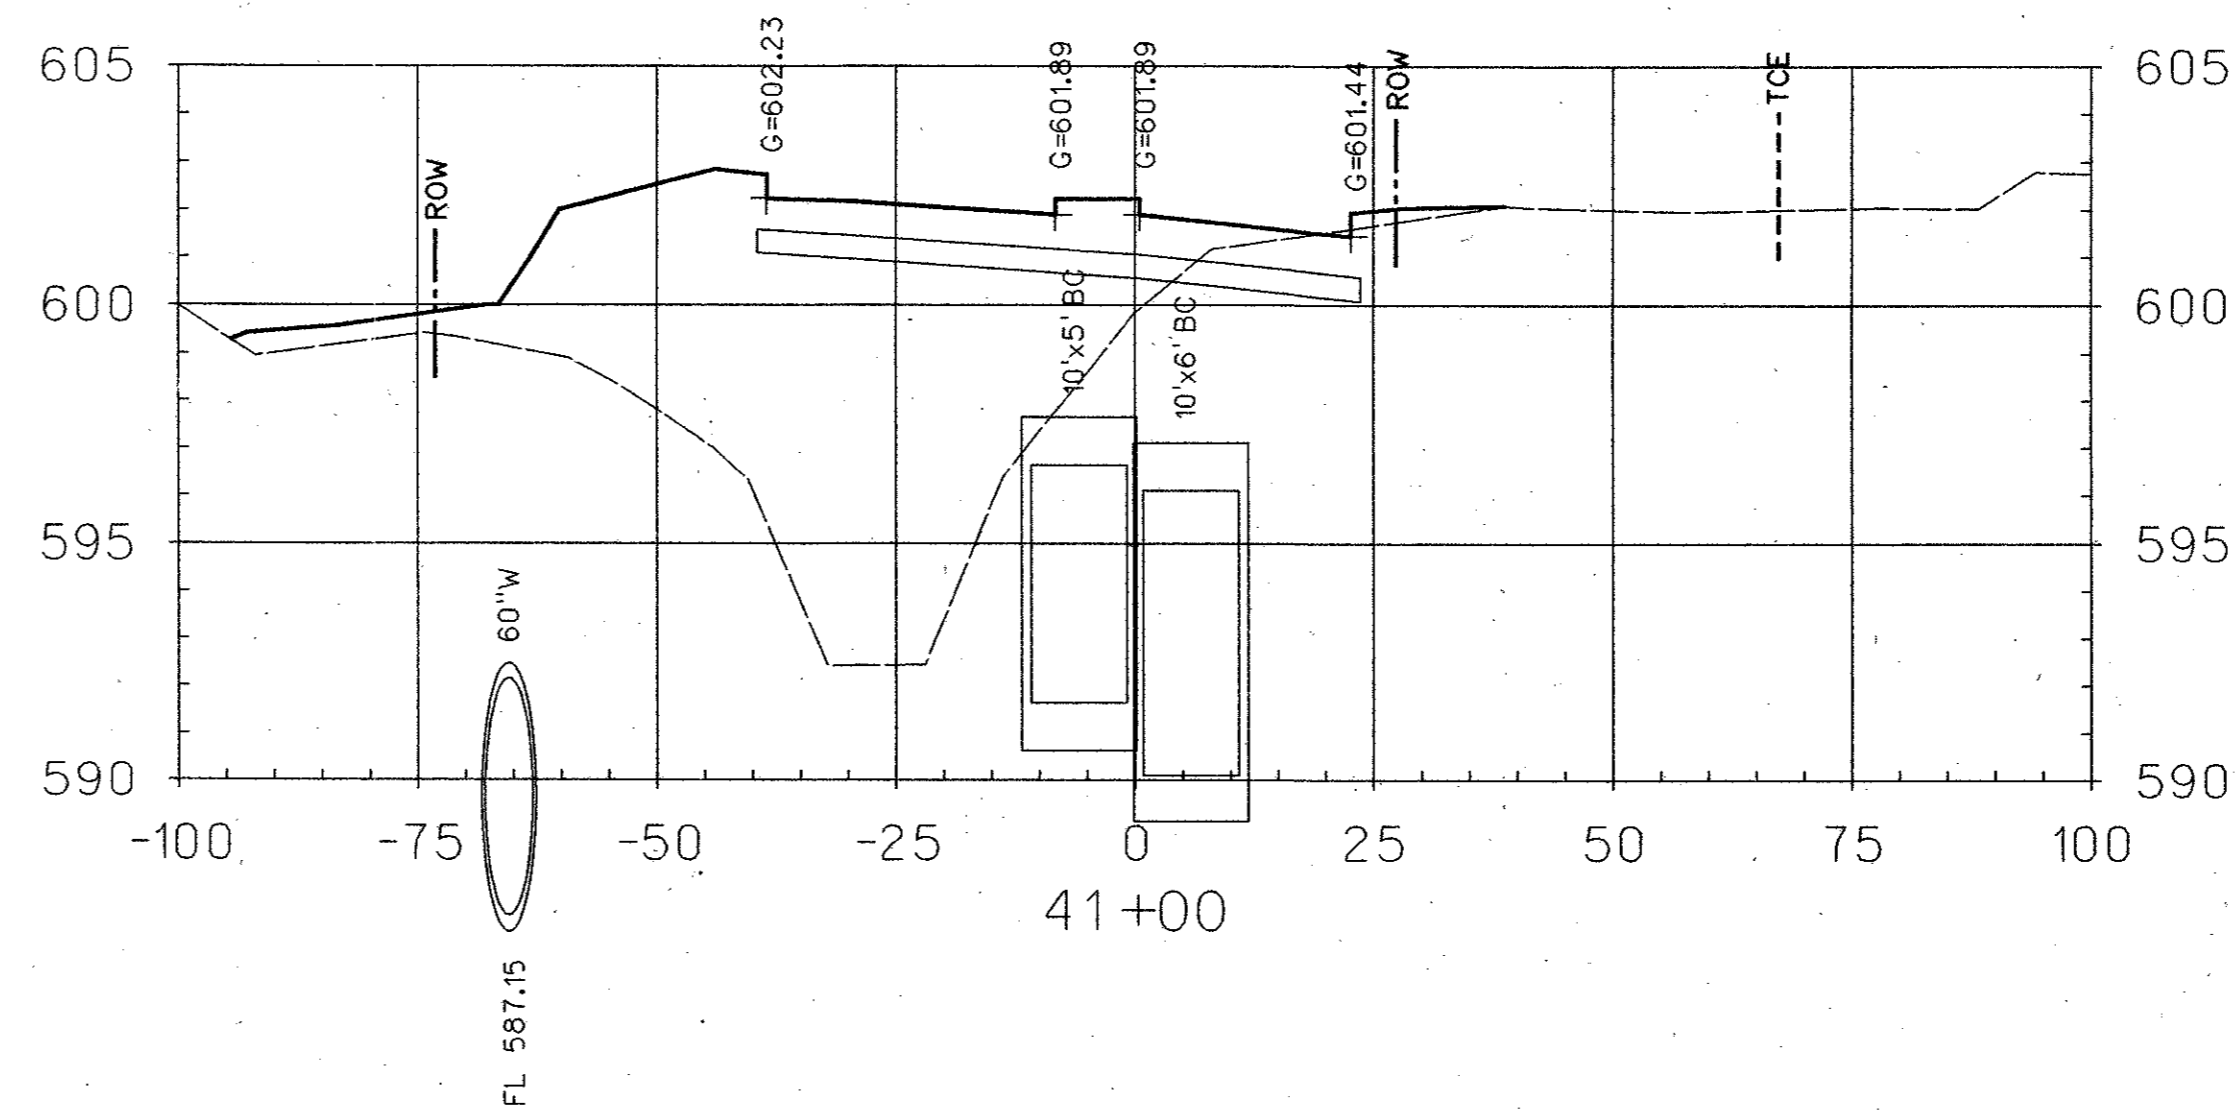
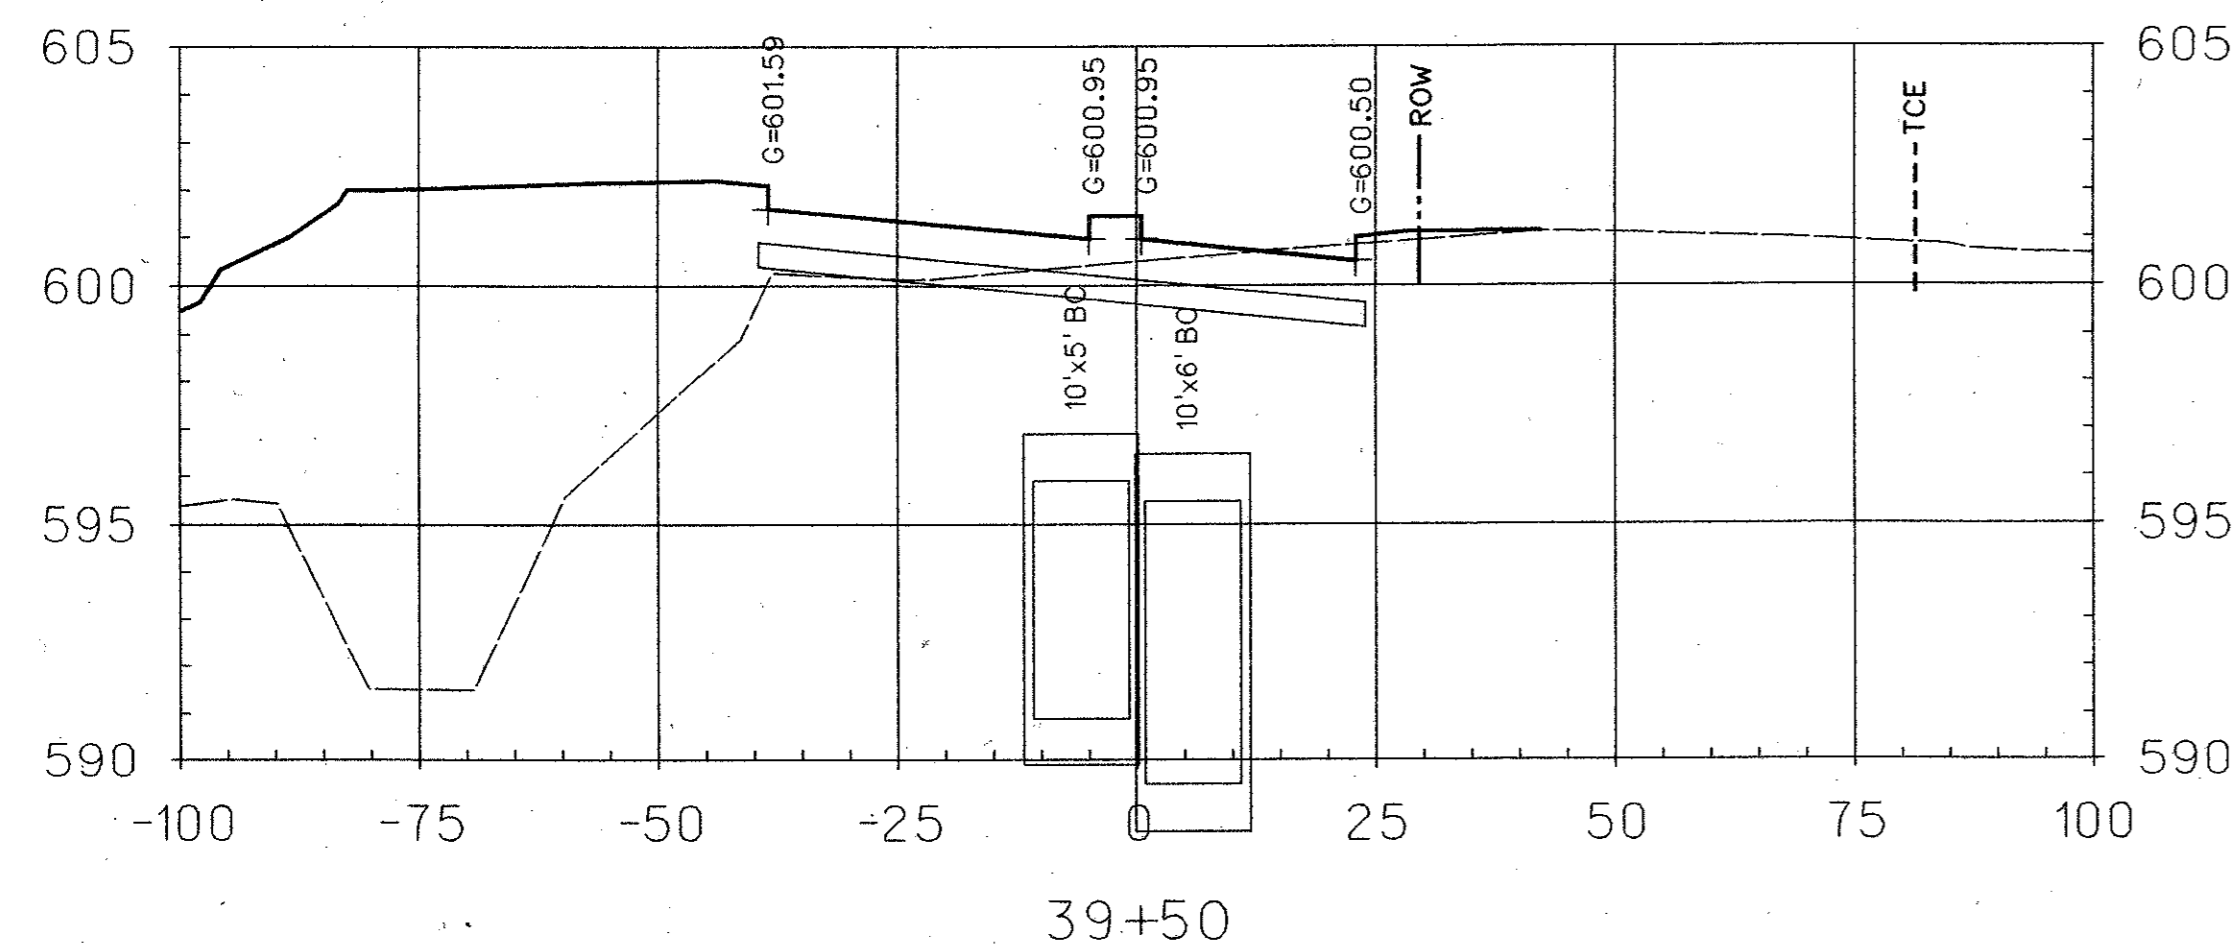
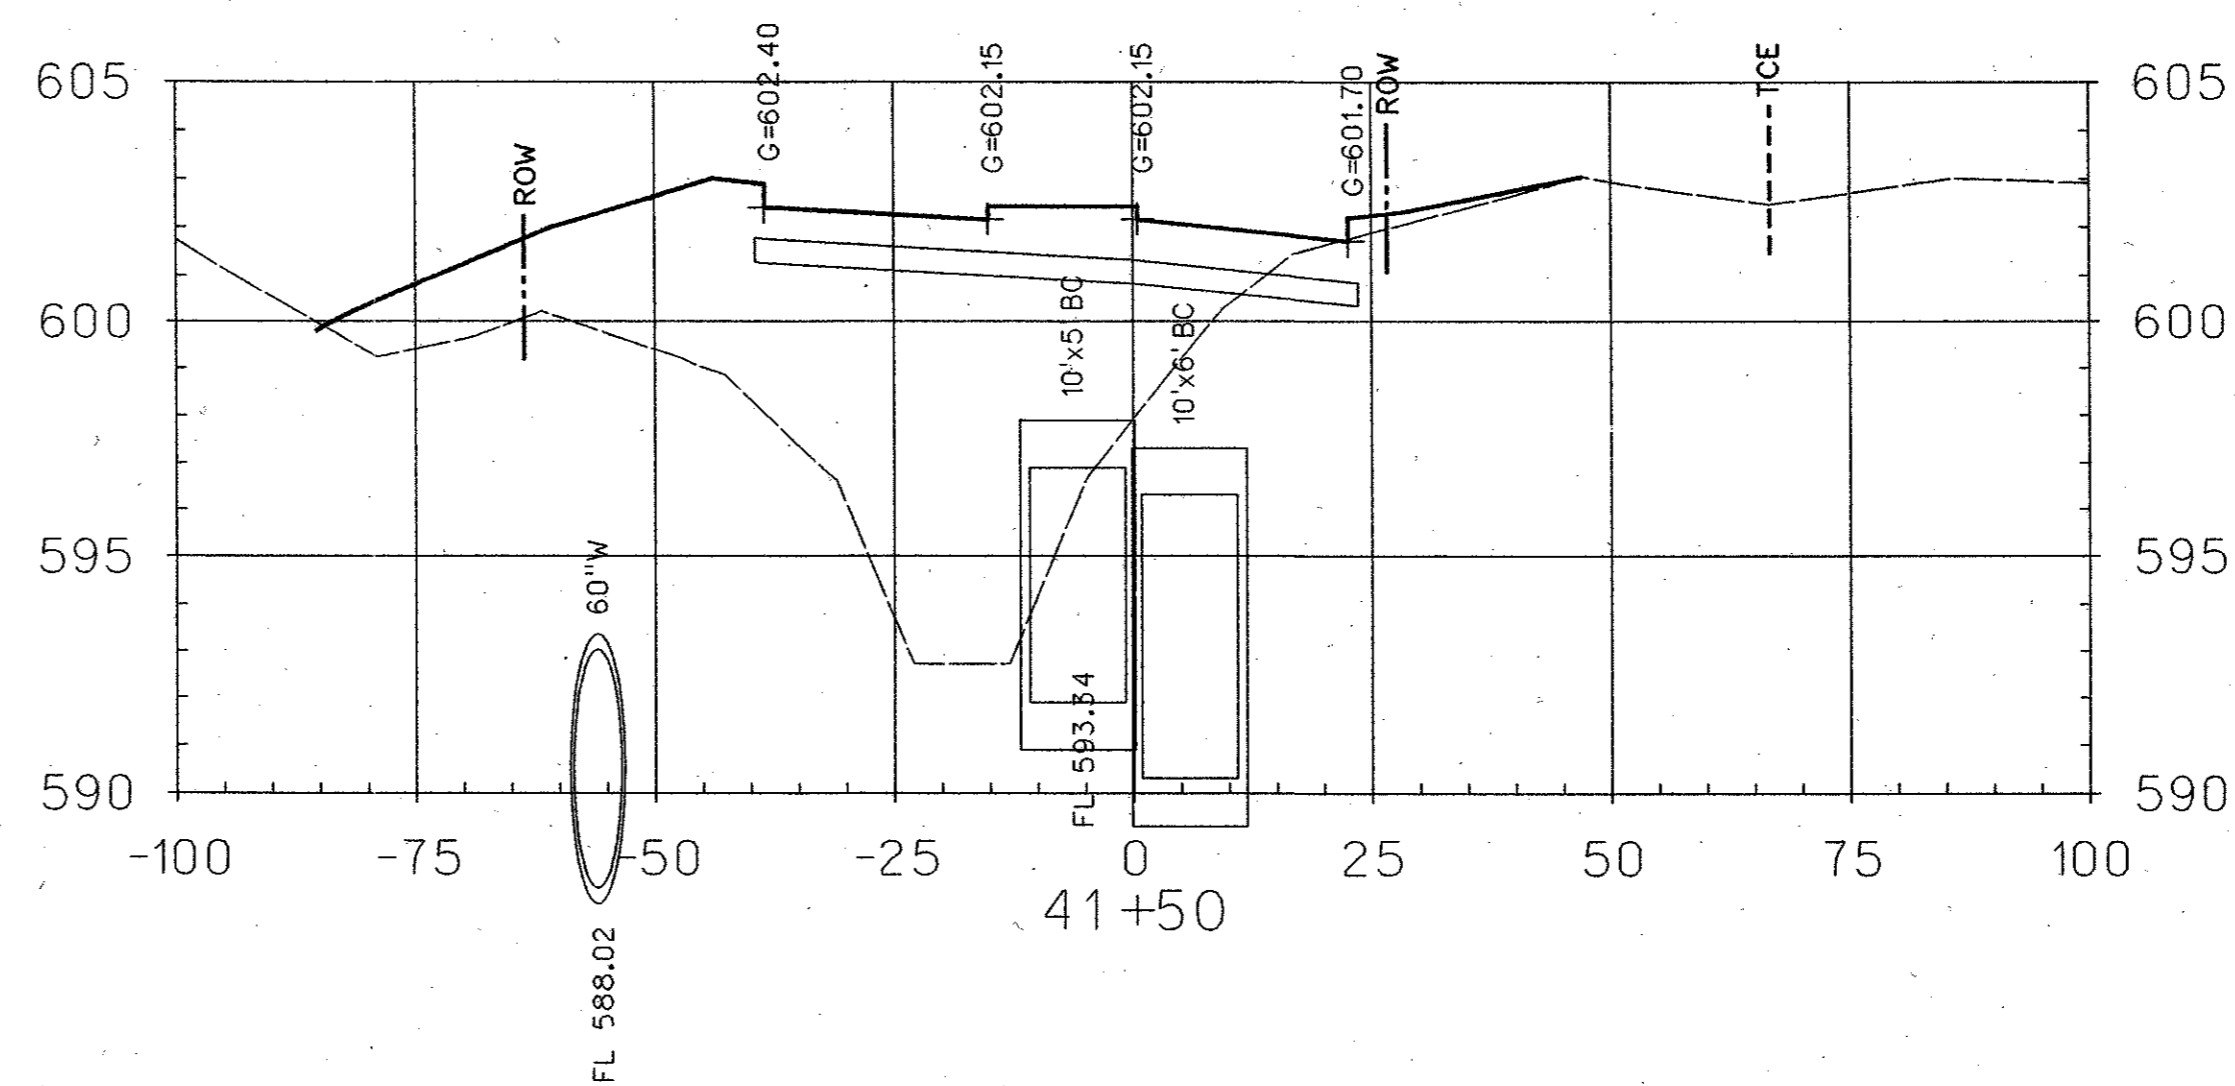
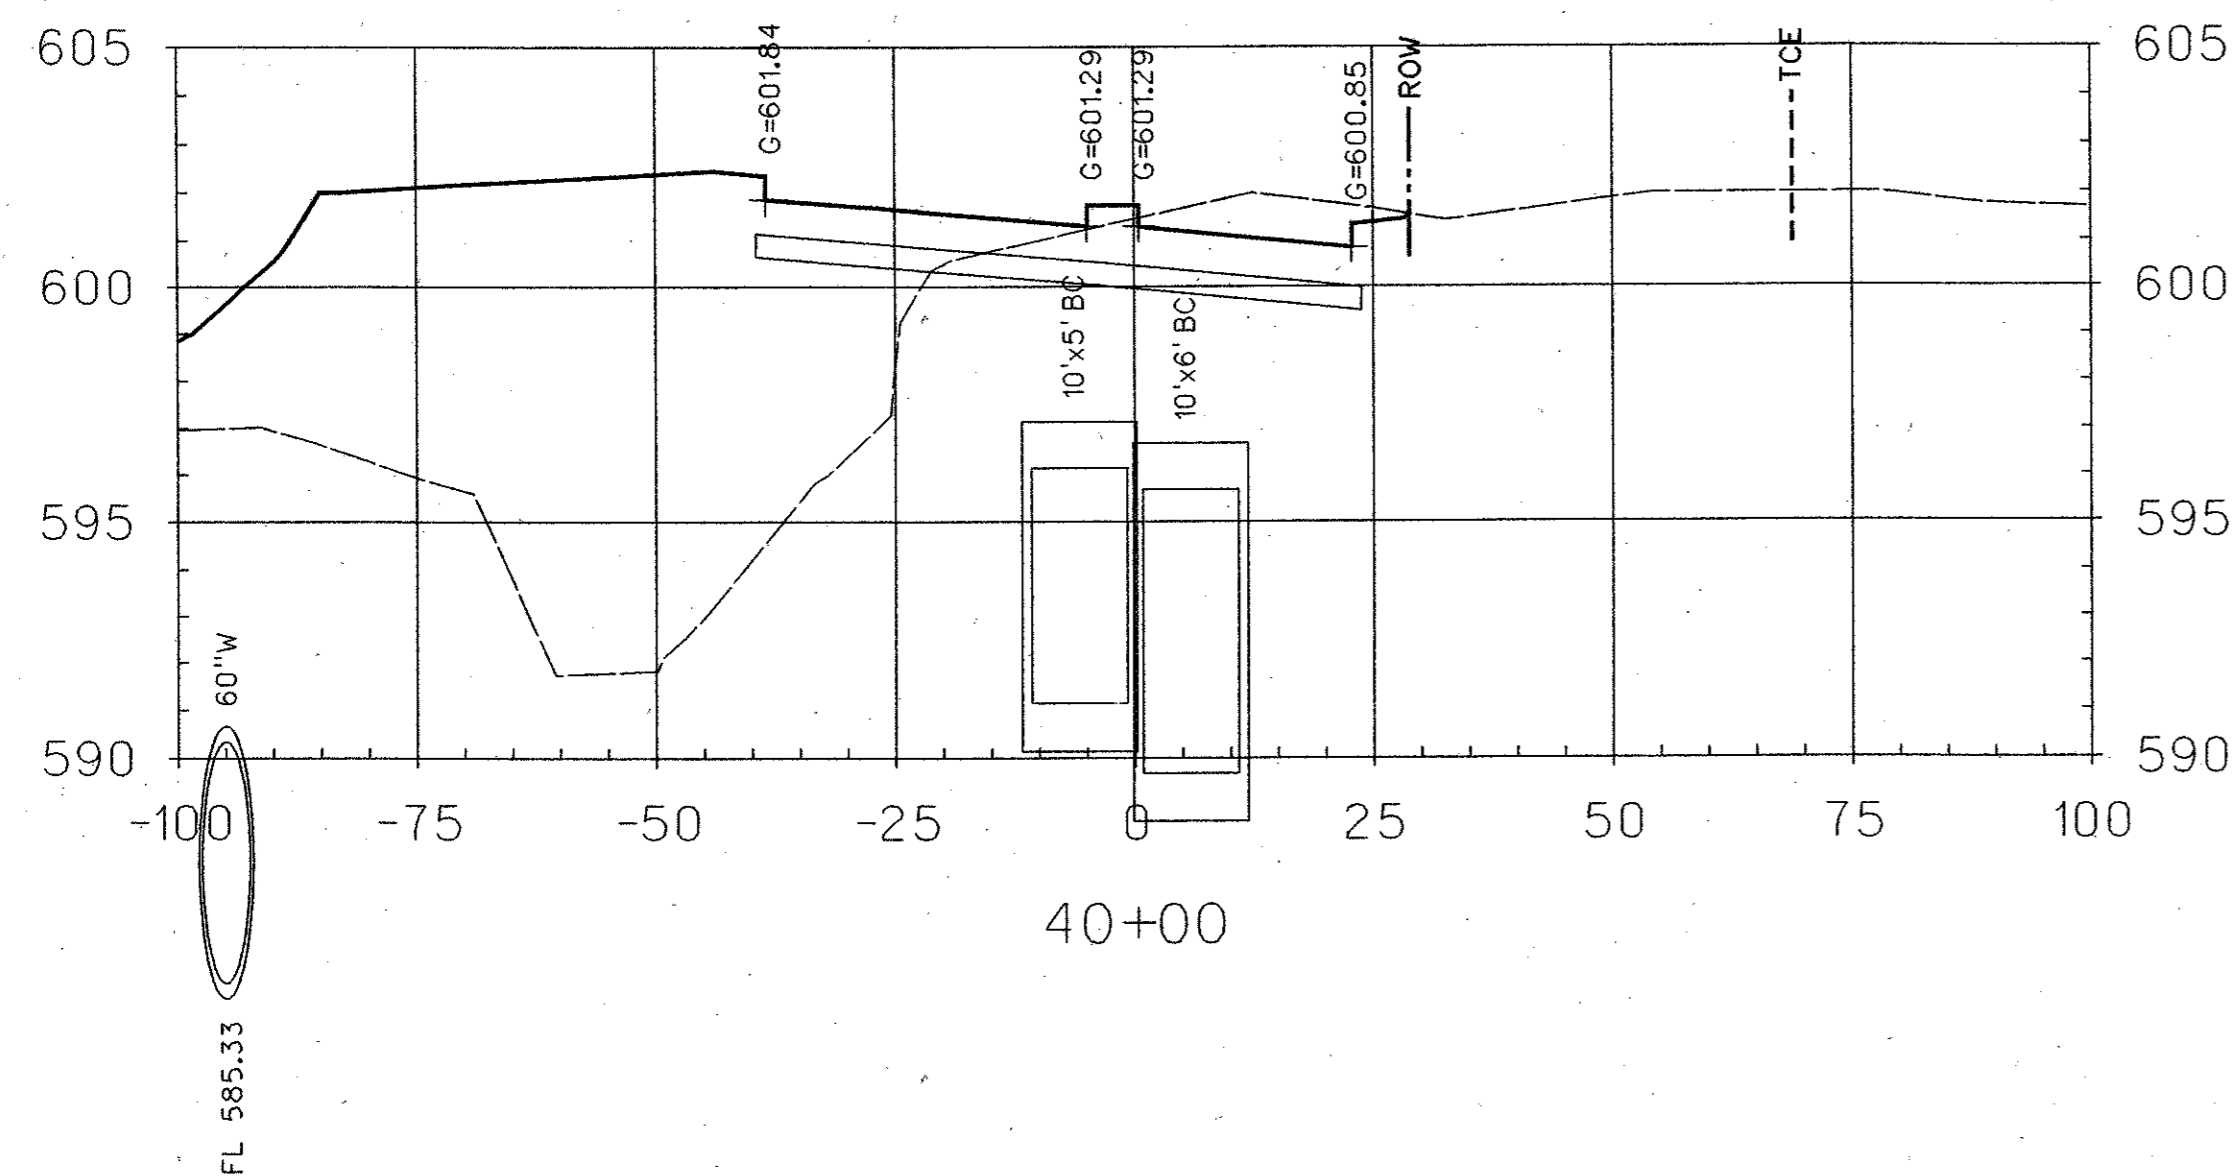
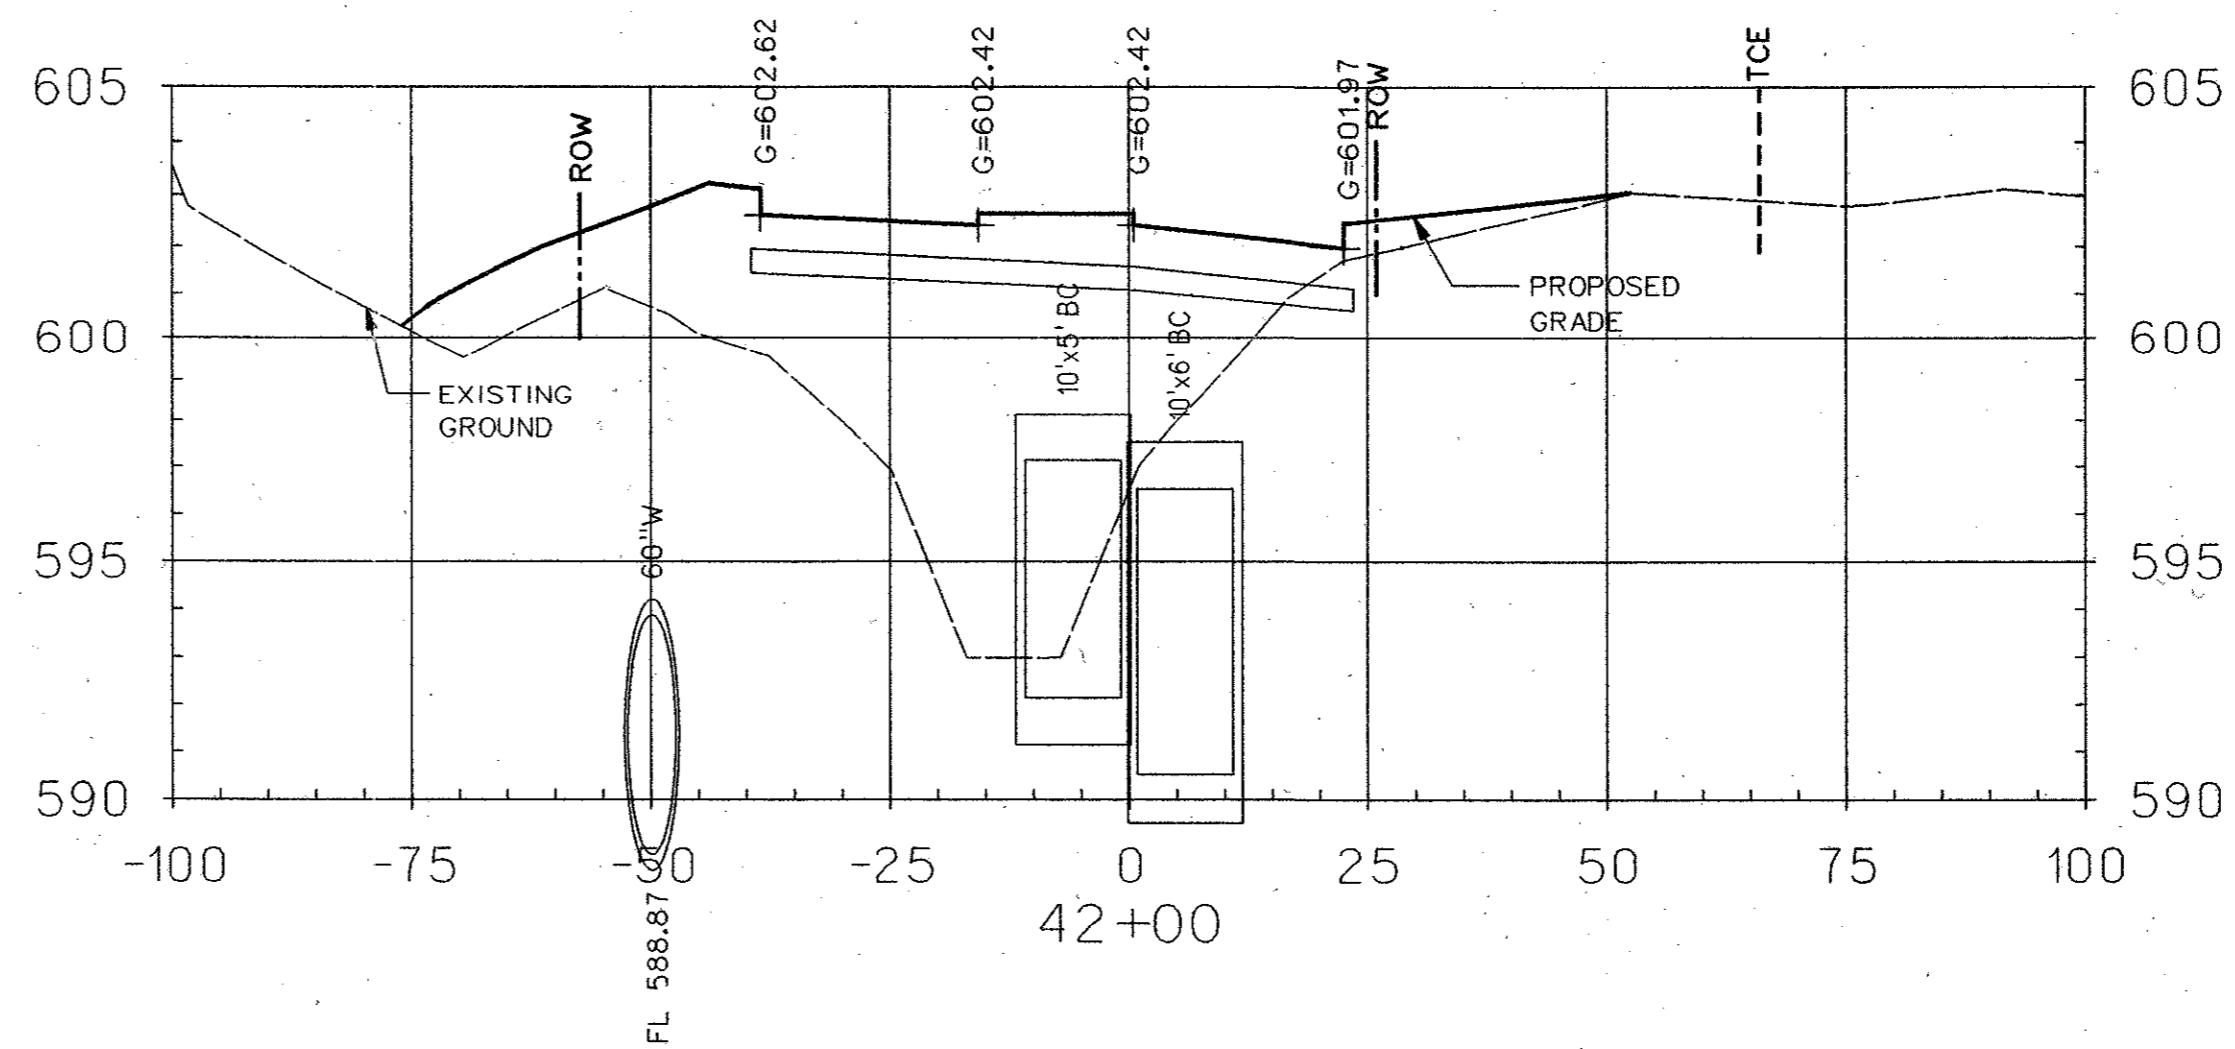


26-JUL-2004 16:05  
G:\25768-p13\m1\cas\ar3\se03.dgn

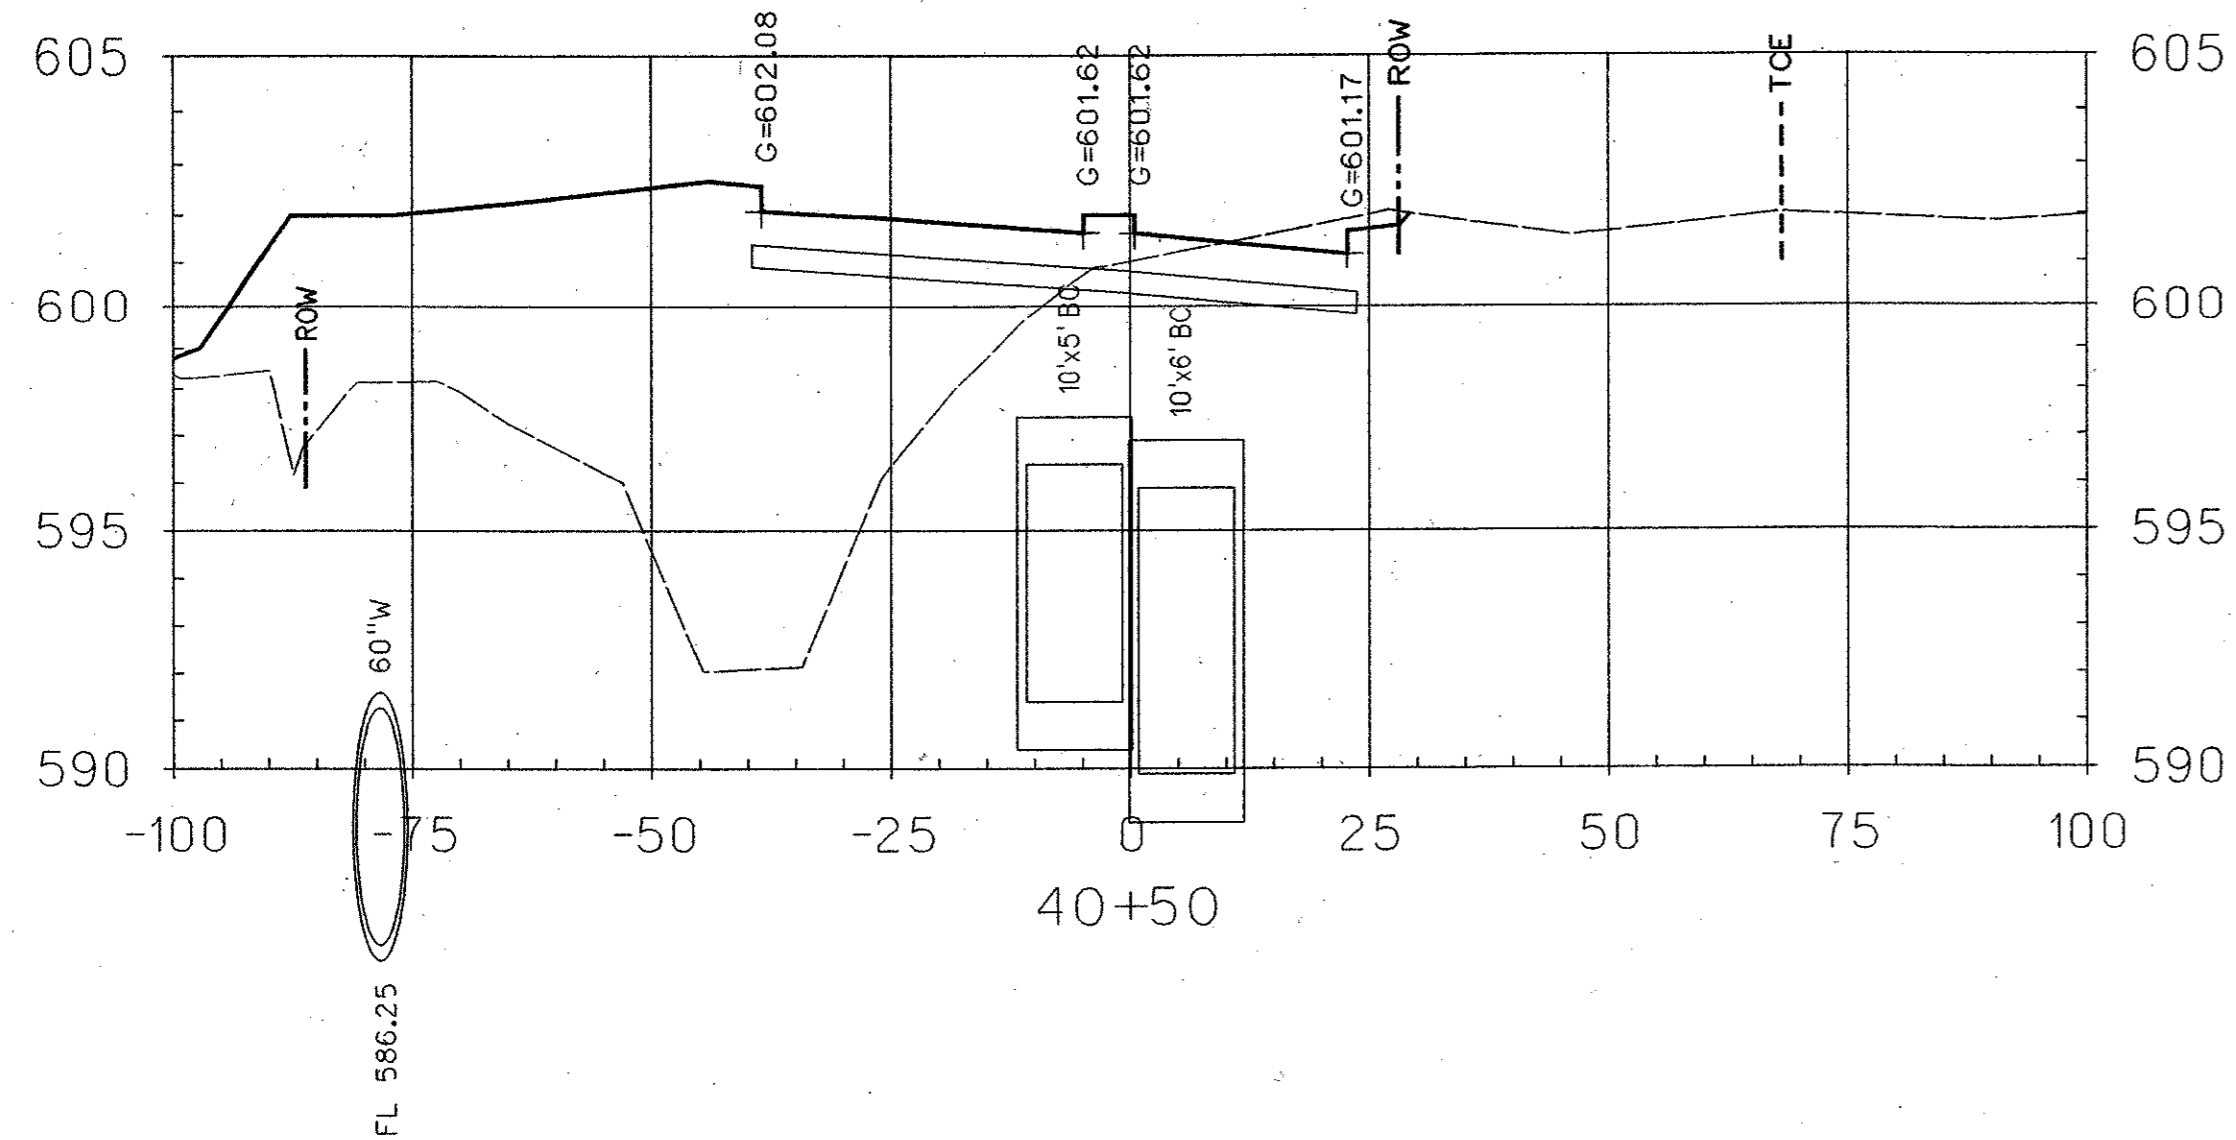

				126
NO.	DATE	REVISION	APPROV.	
<b>HNTB</b> ARCHITECTS ENGINEERS PLANNERS The HNTB Companies				
<b>ARAPAHO ROAD - PHASE III</b>				
SURVEYOR BOULEVARD TO ADDISON ROAD				
CROSS SECTIONS				
SHEET 3 OF 29				
TOWN OF ADDISON, TEXAS				
Design	JSN	Drawn	GFS	DATE
Check	JDH	Check	JSN	APRIL 04
SCALE	PROJECT NO.	SHEET NO.		
1" = 20' H 1" = 4' V	25768	XS-3		