
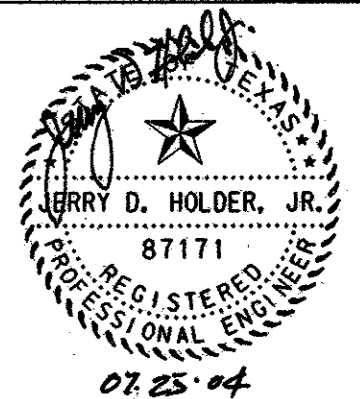
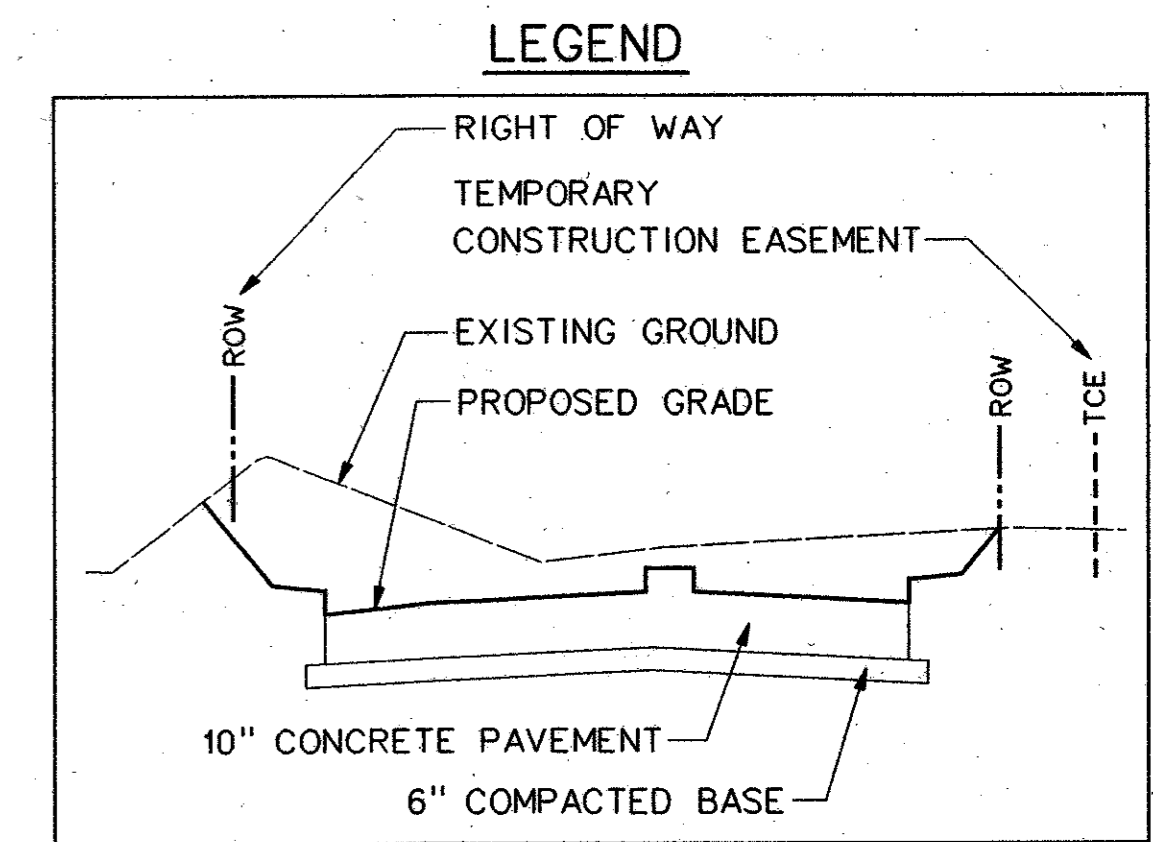
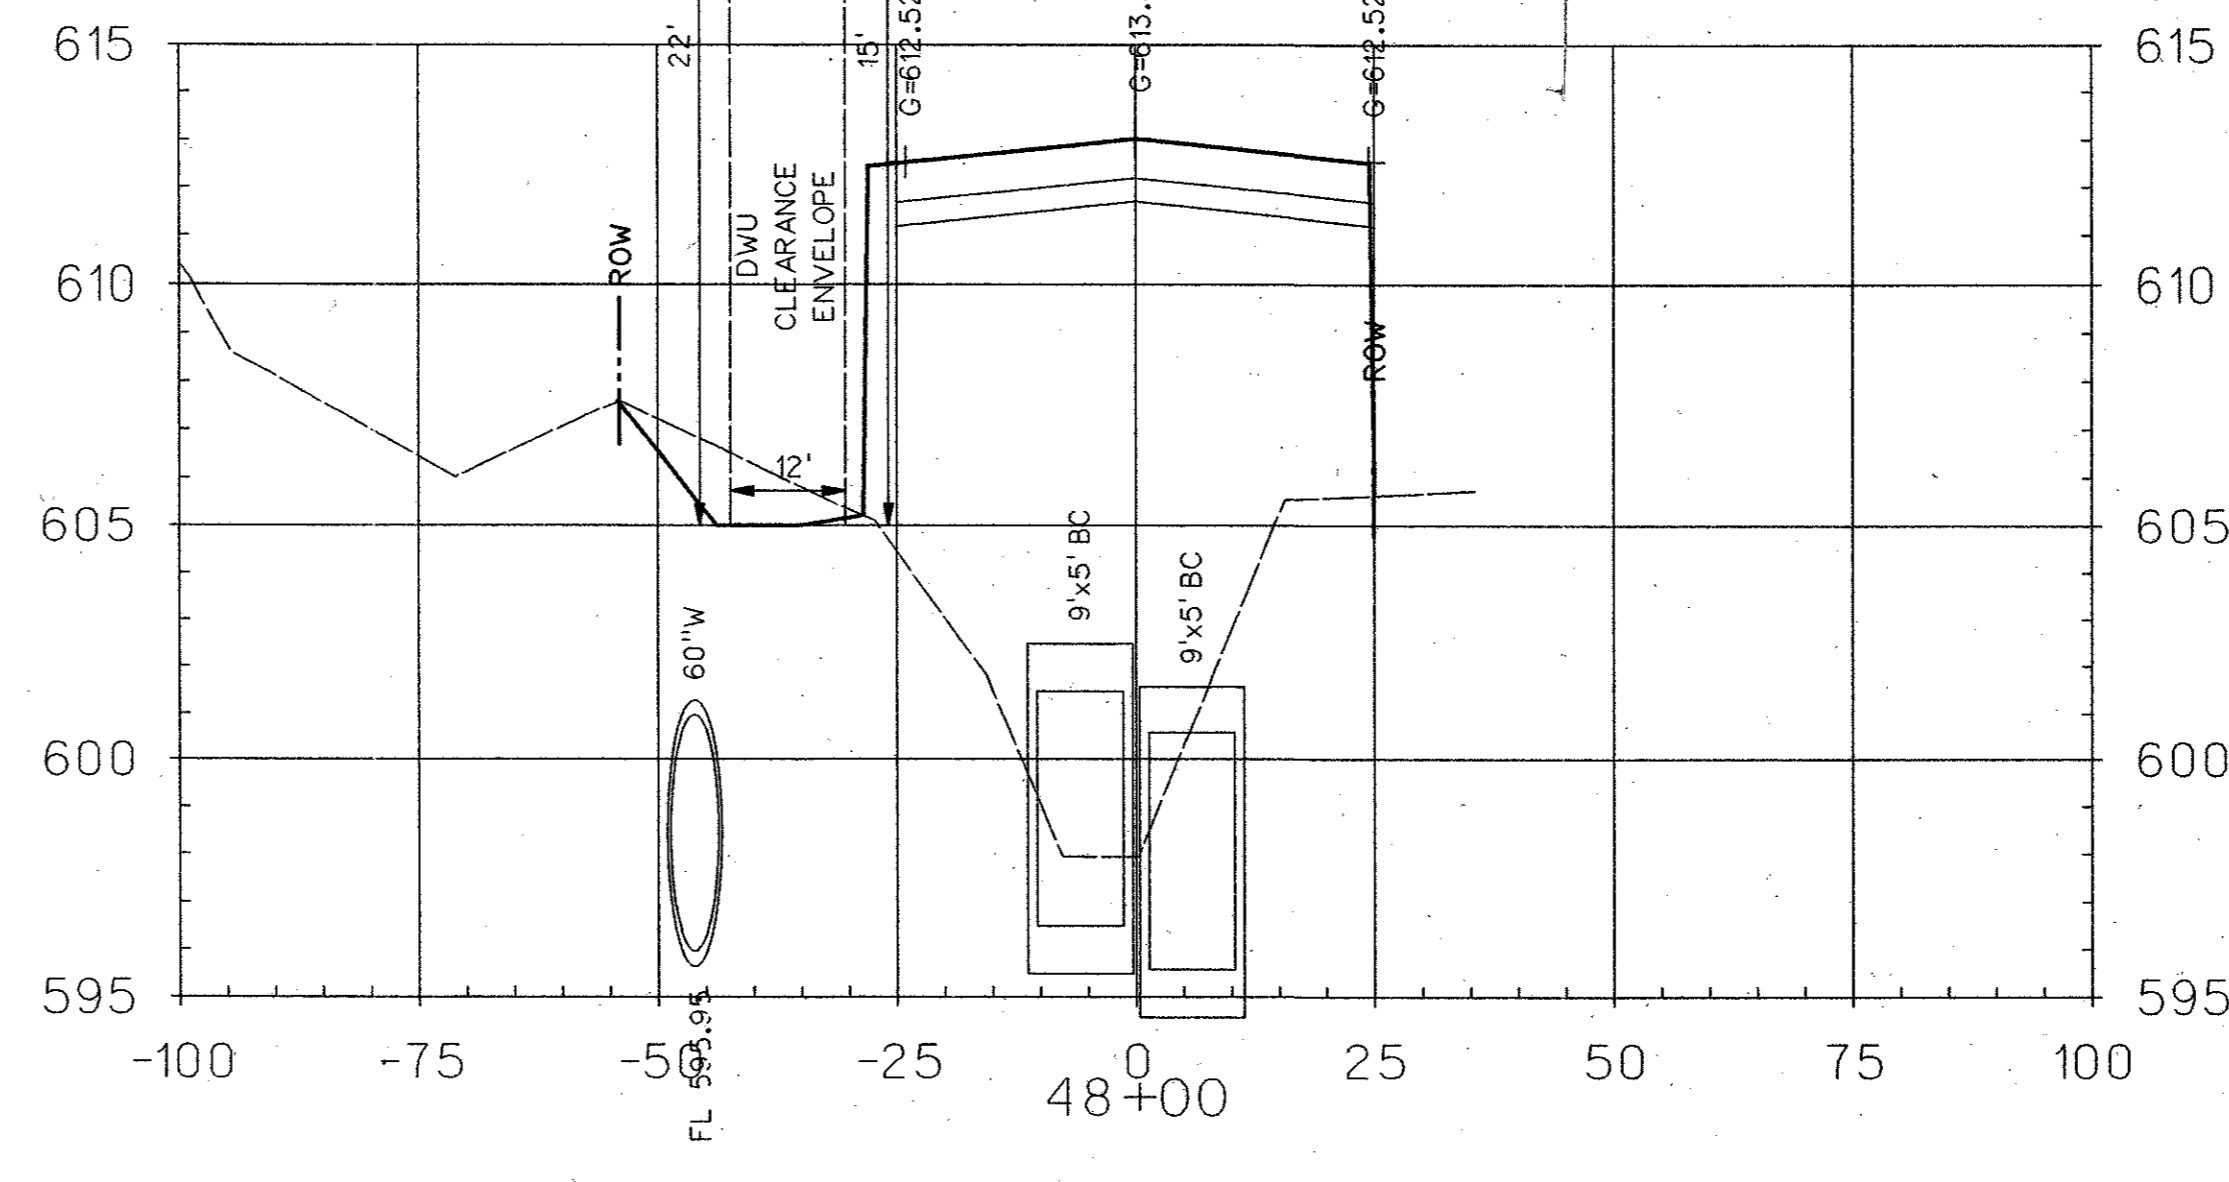
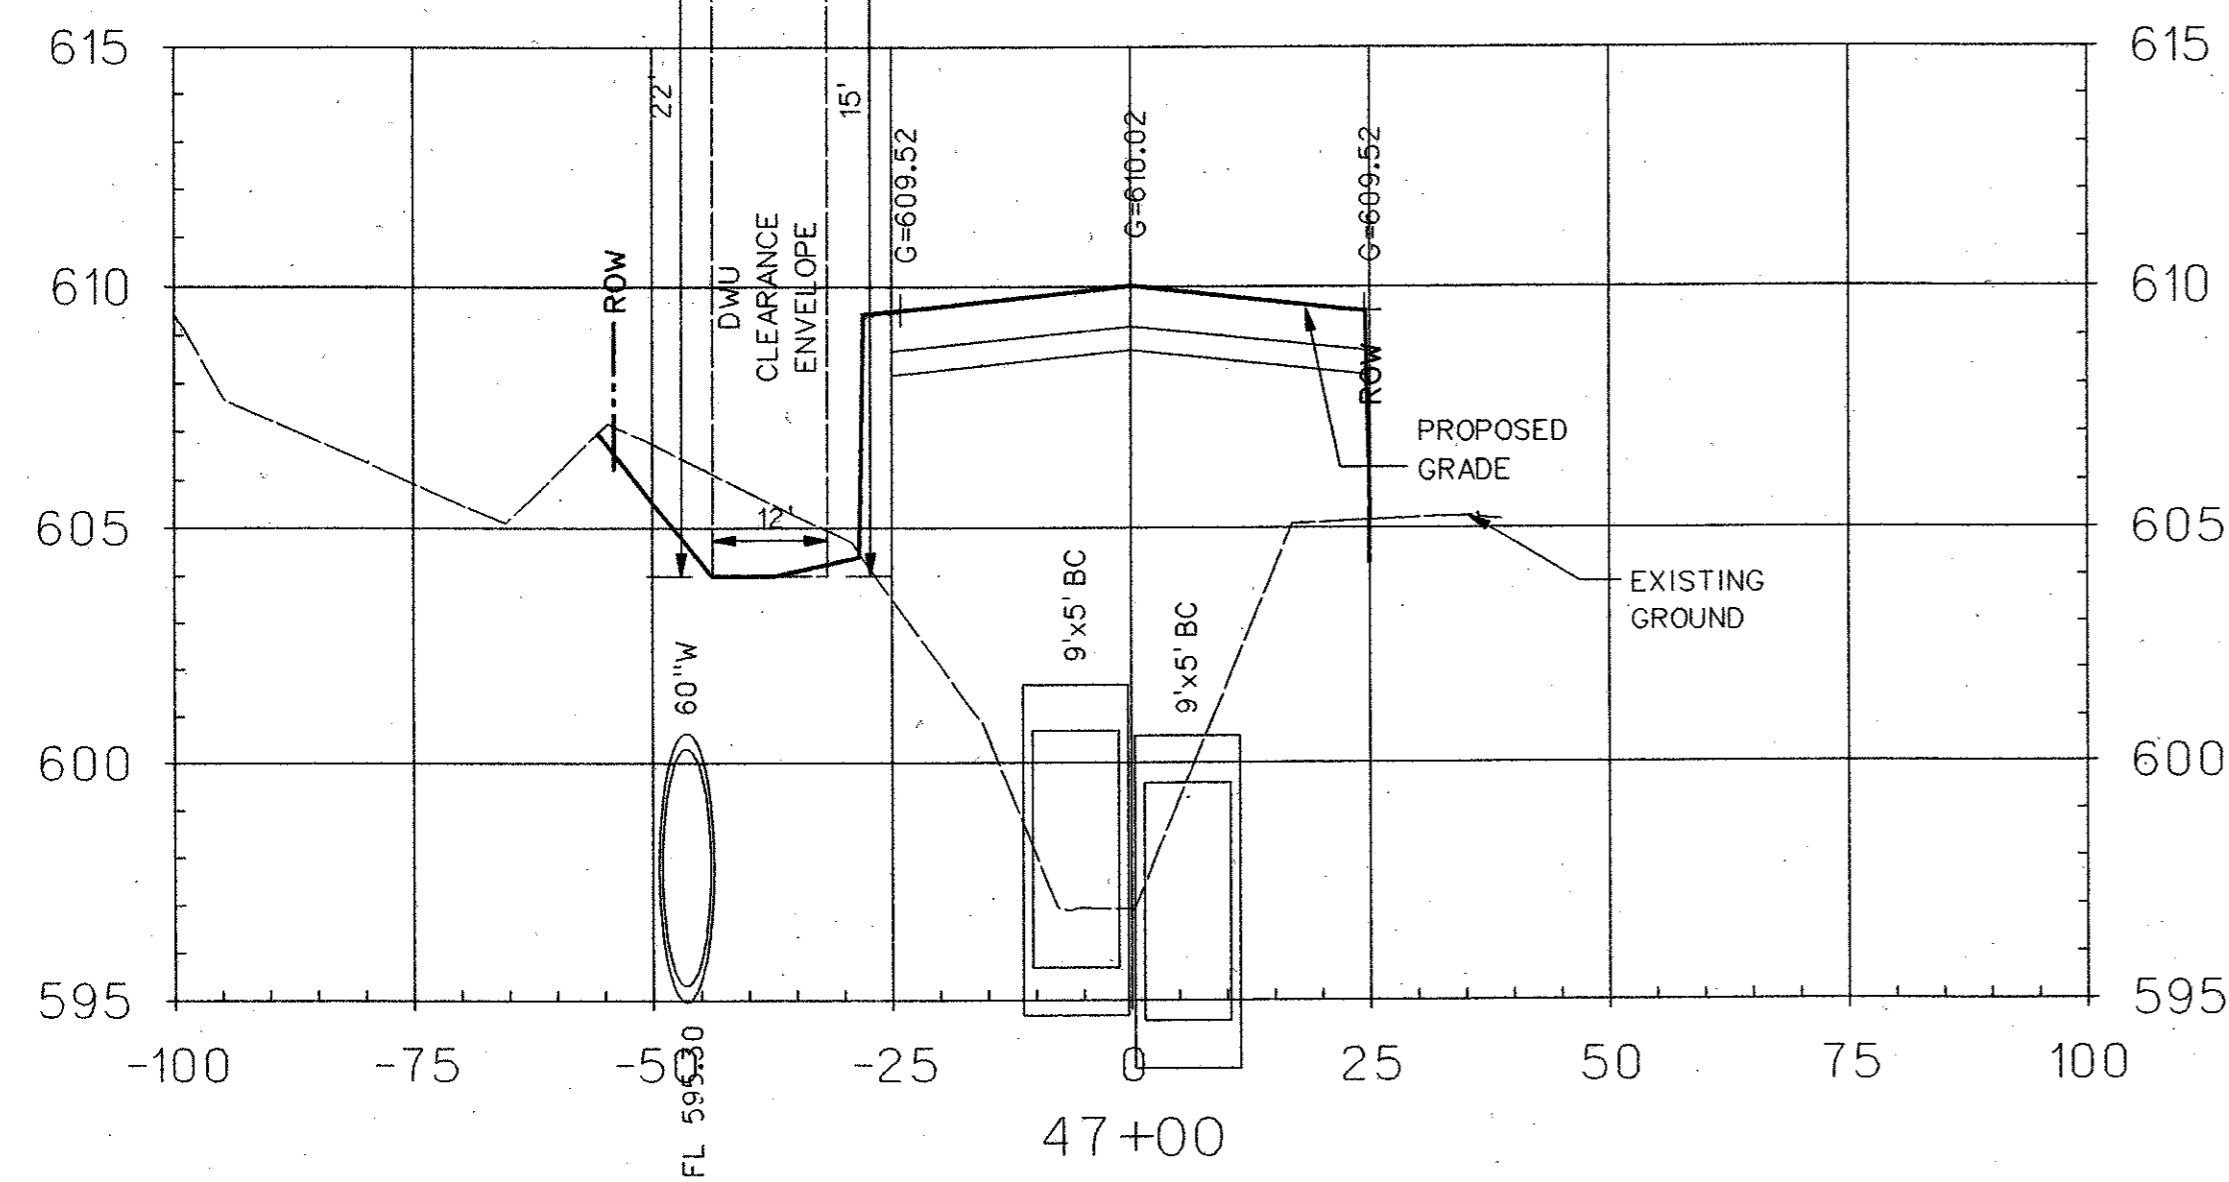
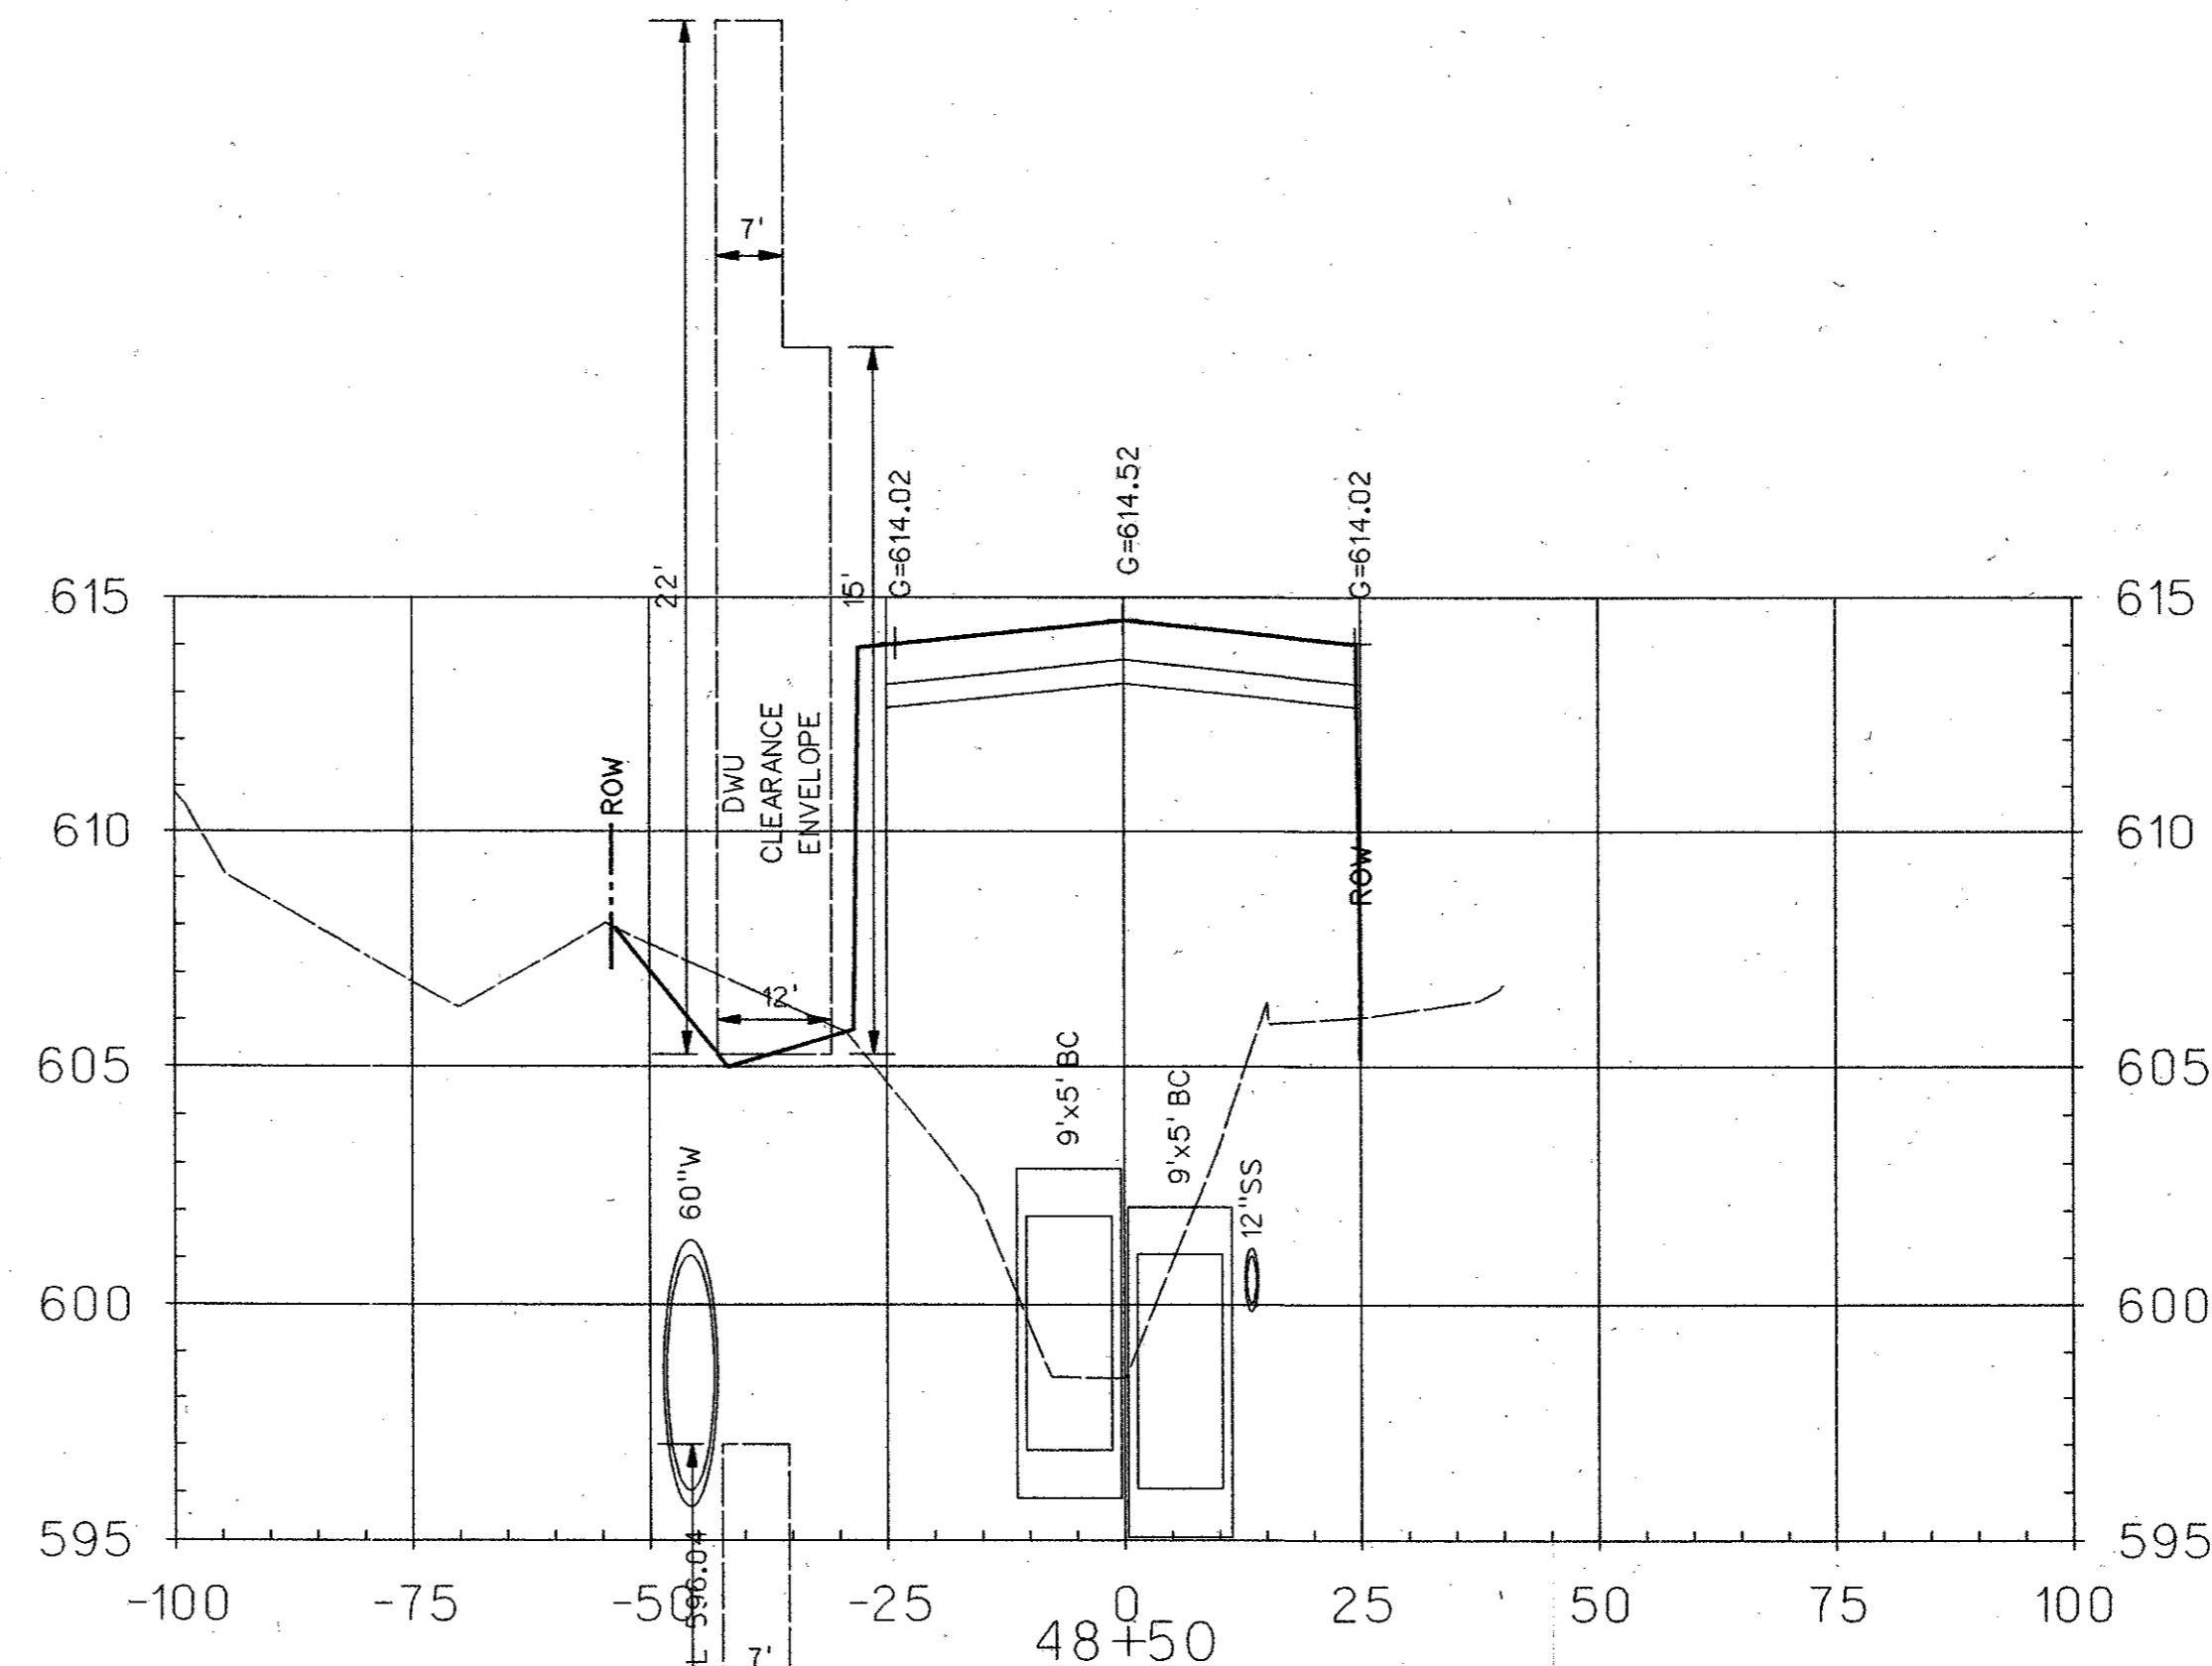


26-JUL-2004 16:06
G:\25168-ph3\h1\cads\ar3\xs06.dgn

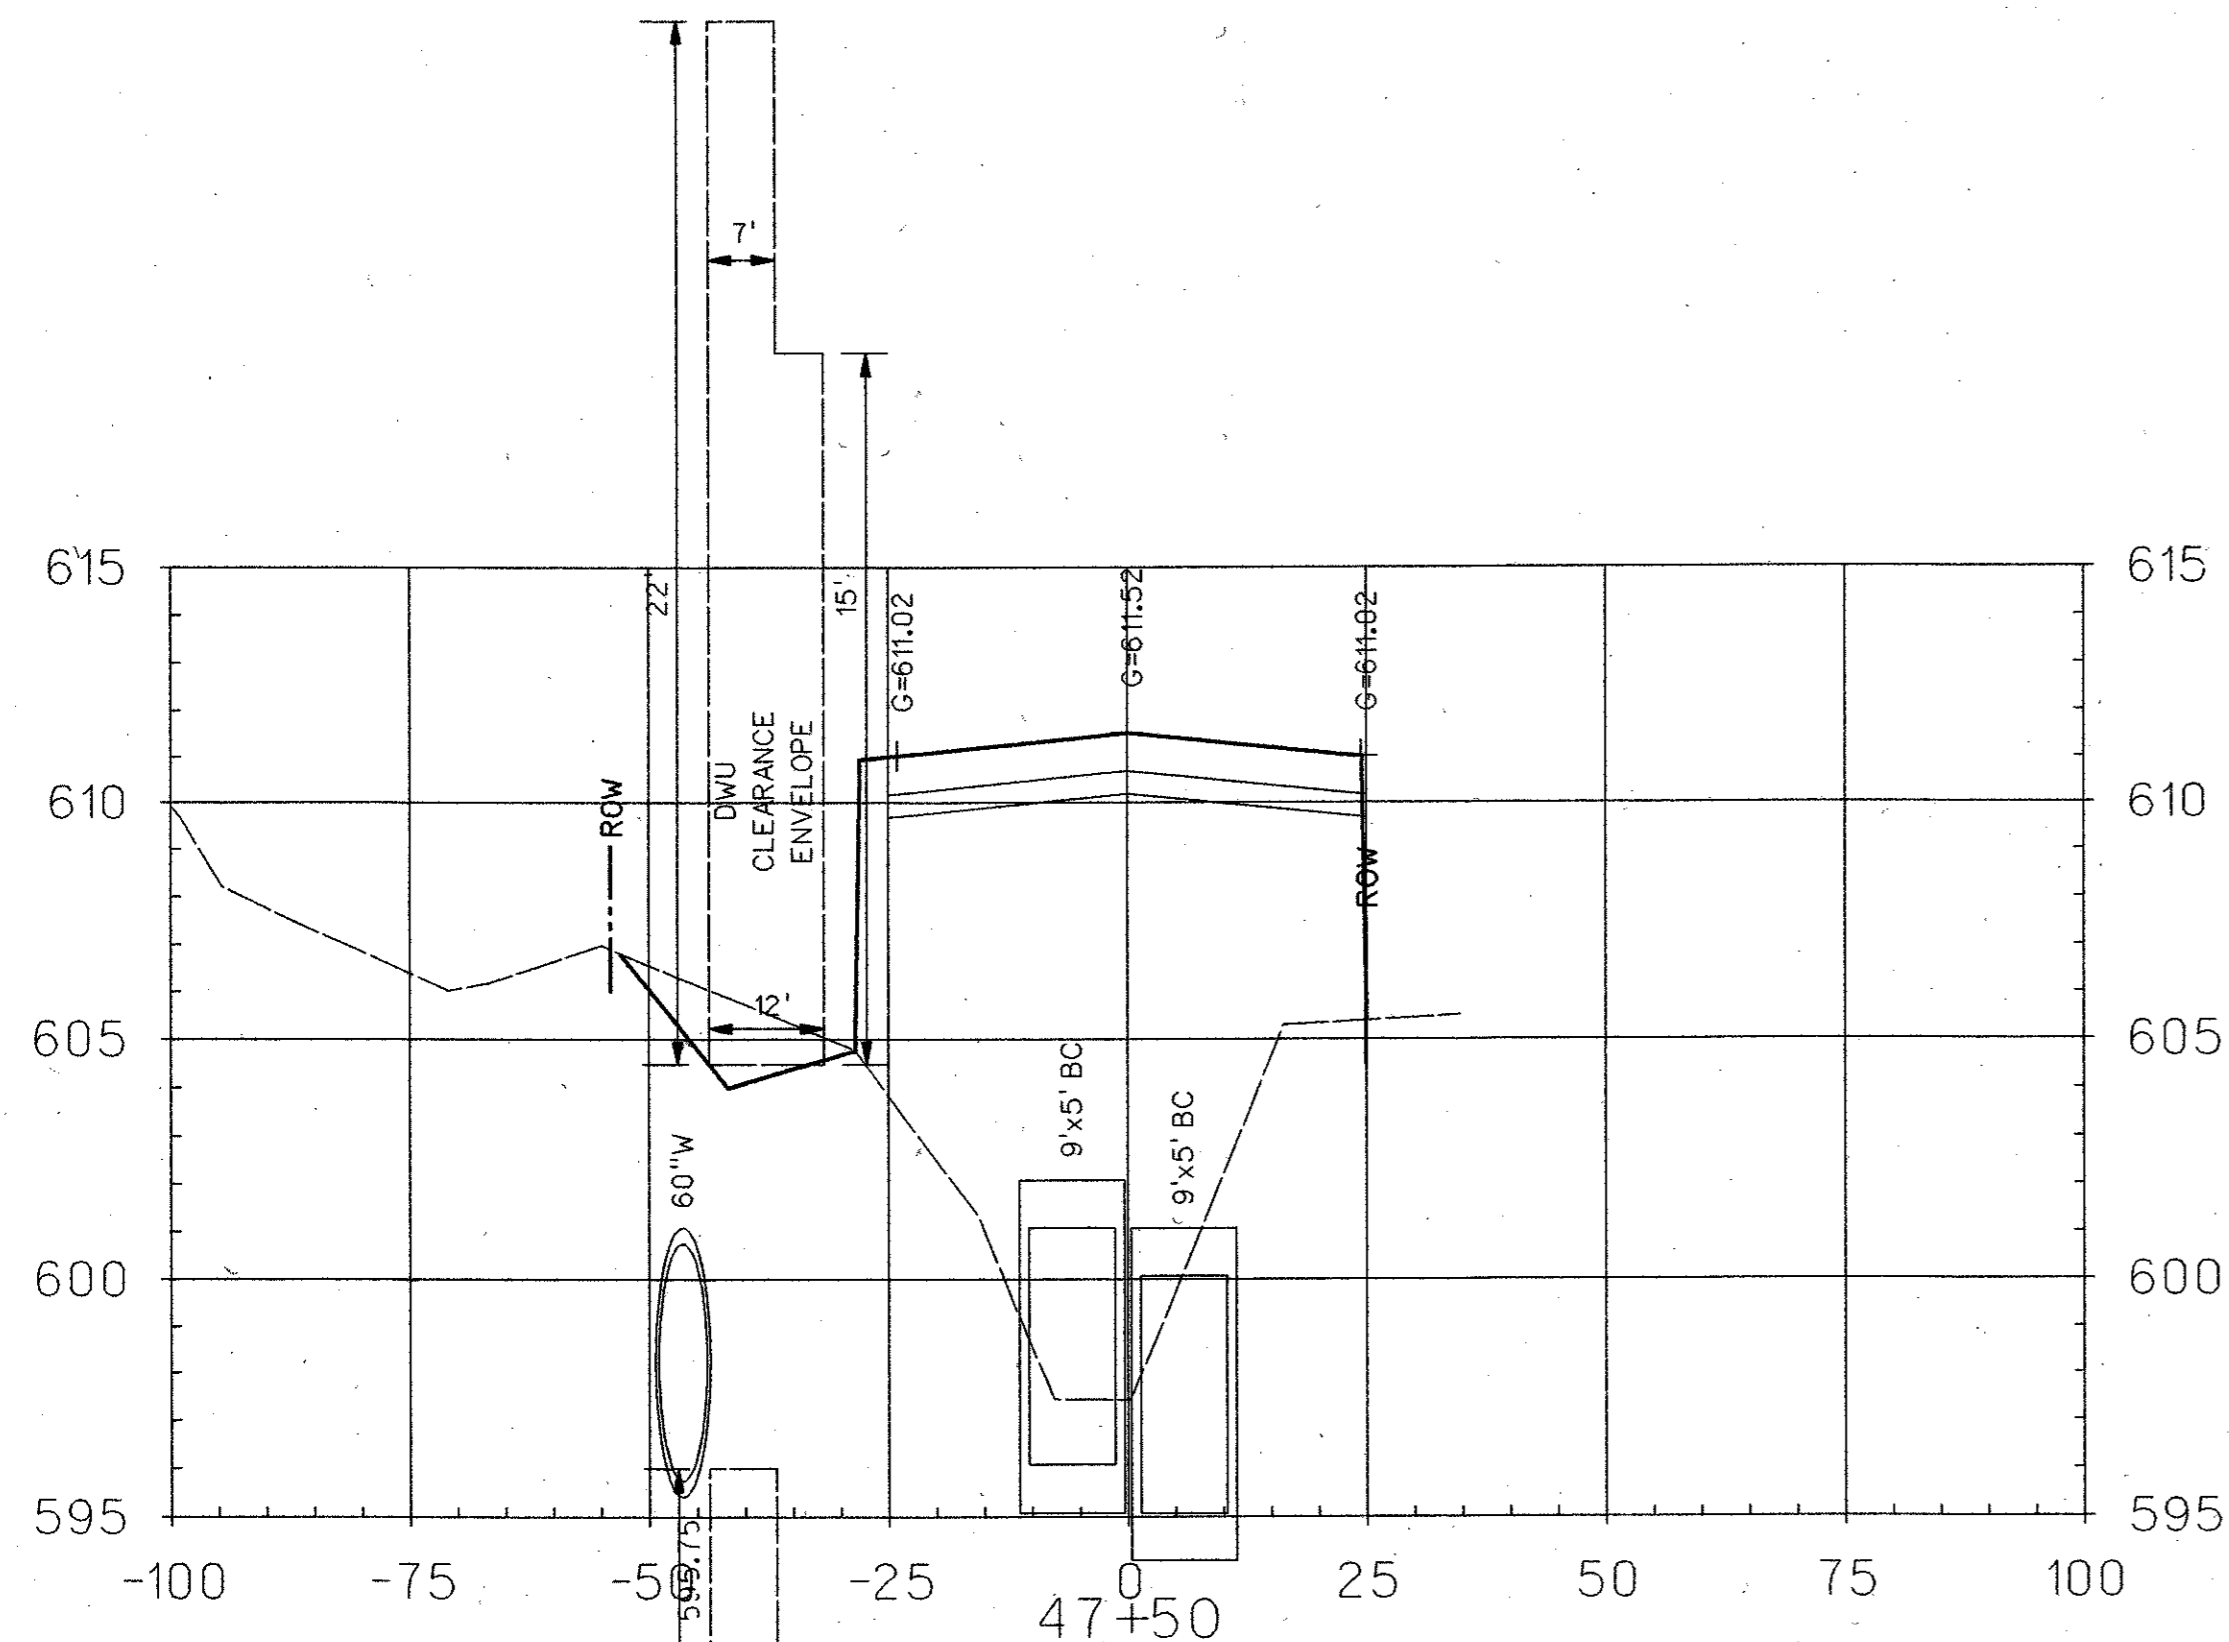

				129
NO.	DATE	REVISION	APPROV.	
HNTB ARCHITECTS ENGINEERS PLANNERS <i>The HNTB Companies</i>				
ARAPAHO ROAD - PHASE III				
SURVEYOR BOULEVARD TO ADDISON ROAD				
CROSS SECTIONS				
SHEET 6 OF 29				
TOWN OF ADDISON, TEXAS				
Design	JSN	Drawn	GFS	DATE
Check	JDH	Check	JSN	APRIL 04
SCALE	1" = 20' H		PROJECT NO.	25768
	1" = 4' V		SHEET NO.	XS-6