

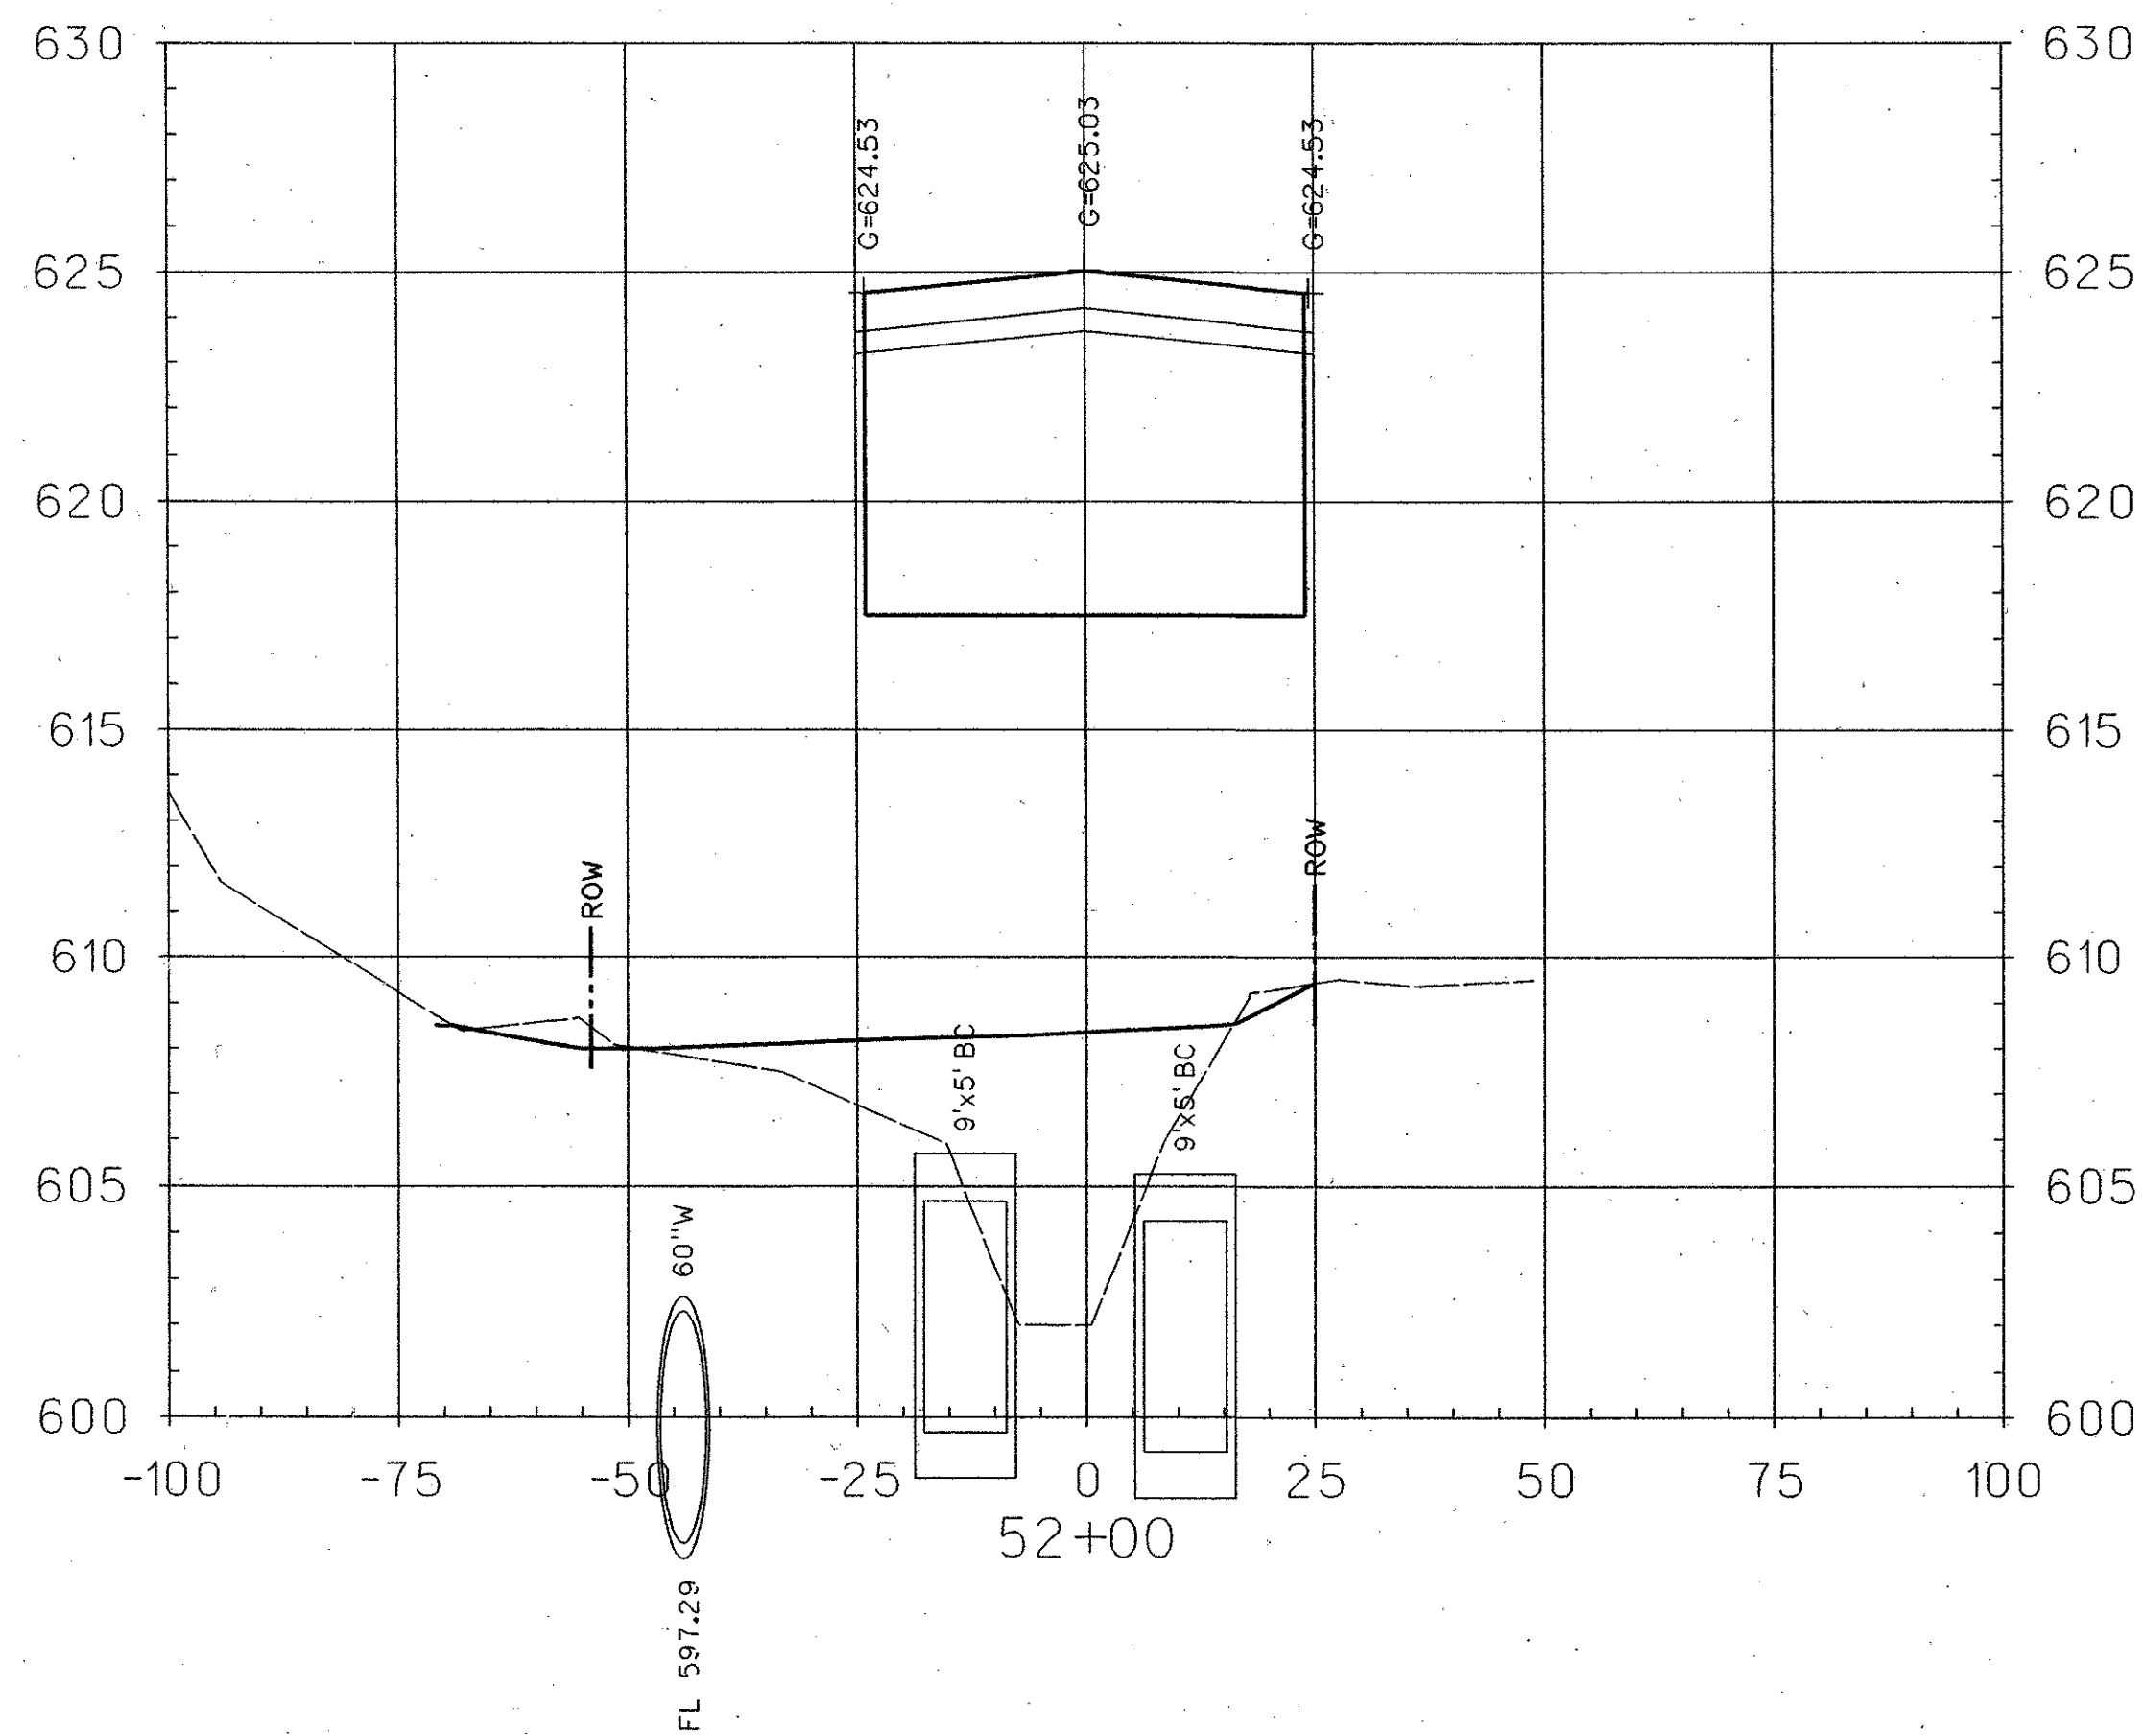
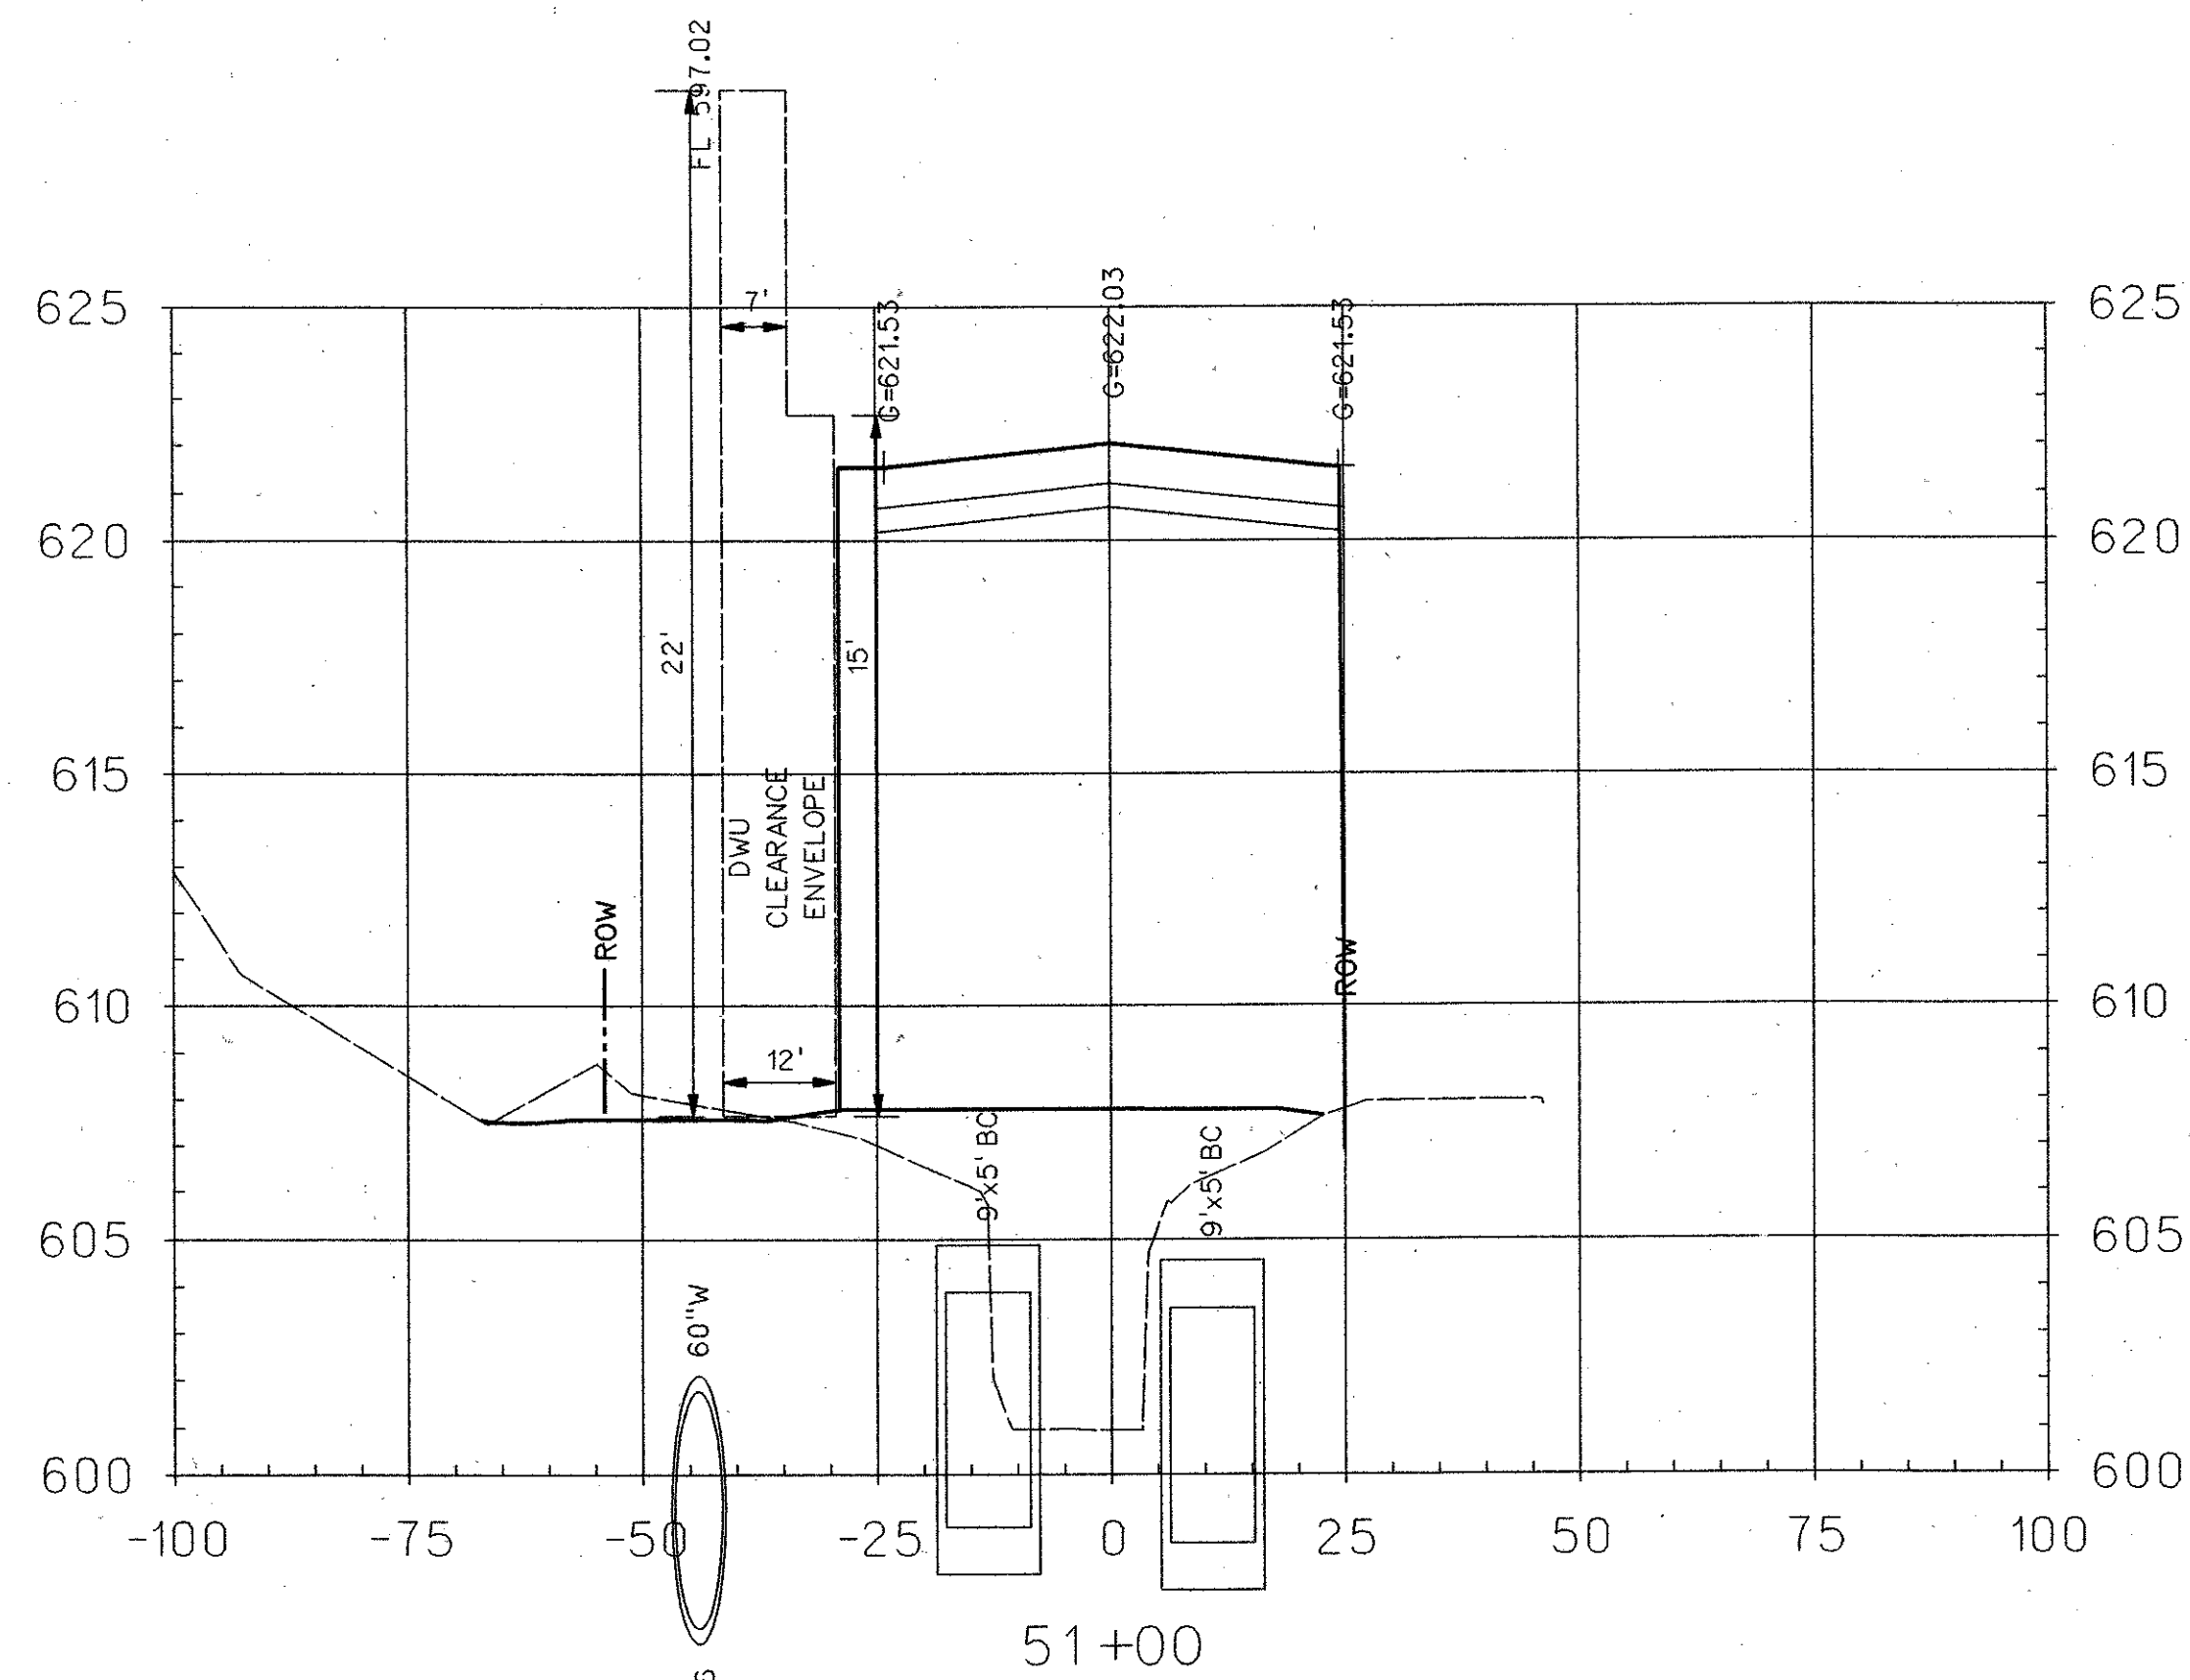
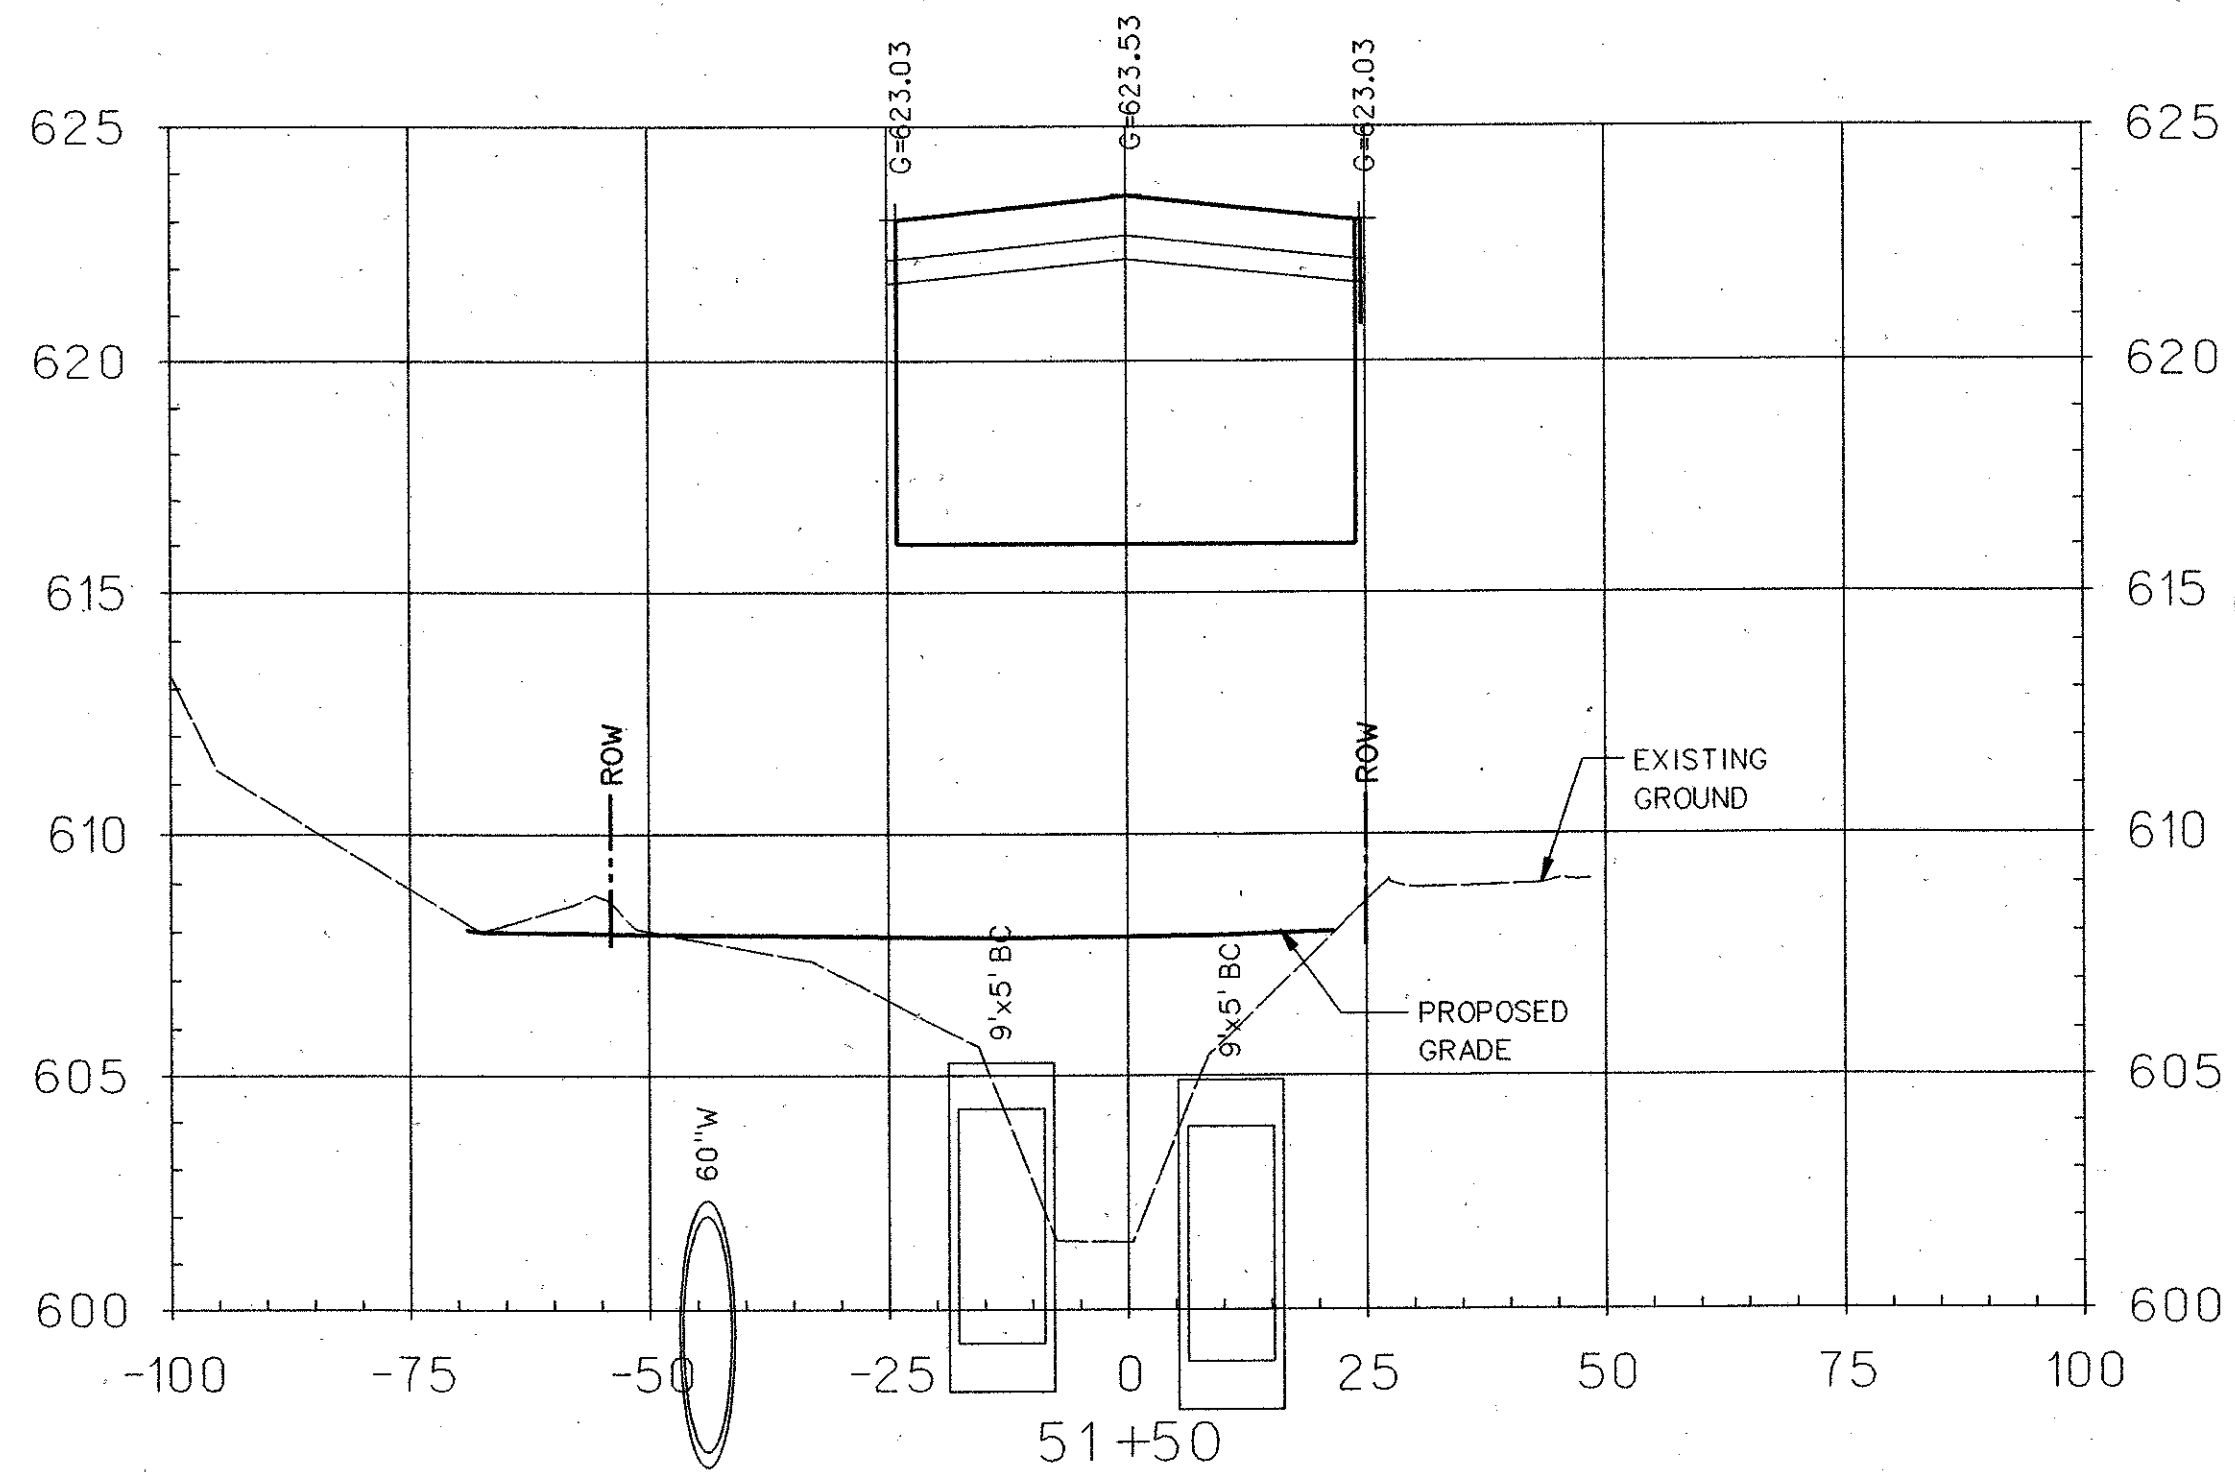


26-JUL-2004 16:06
 G:\25768-ph3\h1\cads\ar3\xs08.dgn

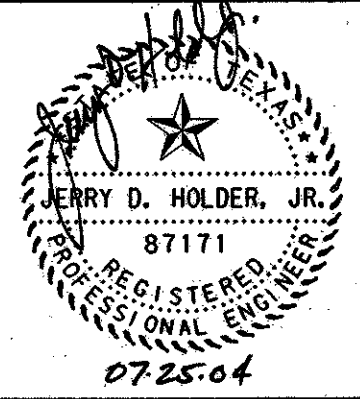

LEGEND

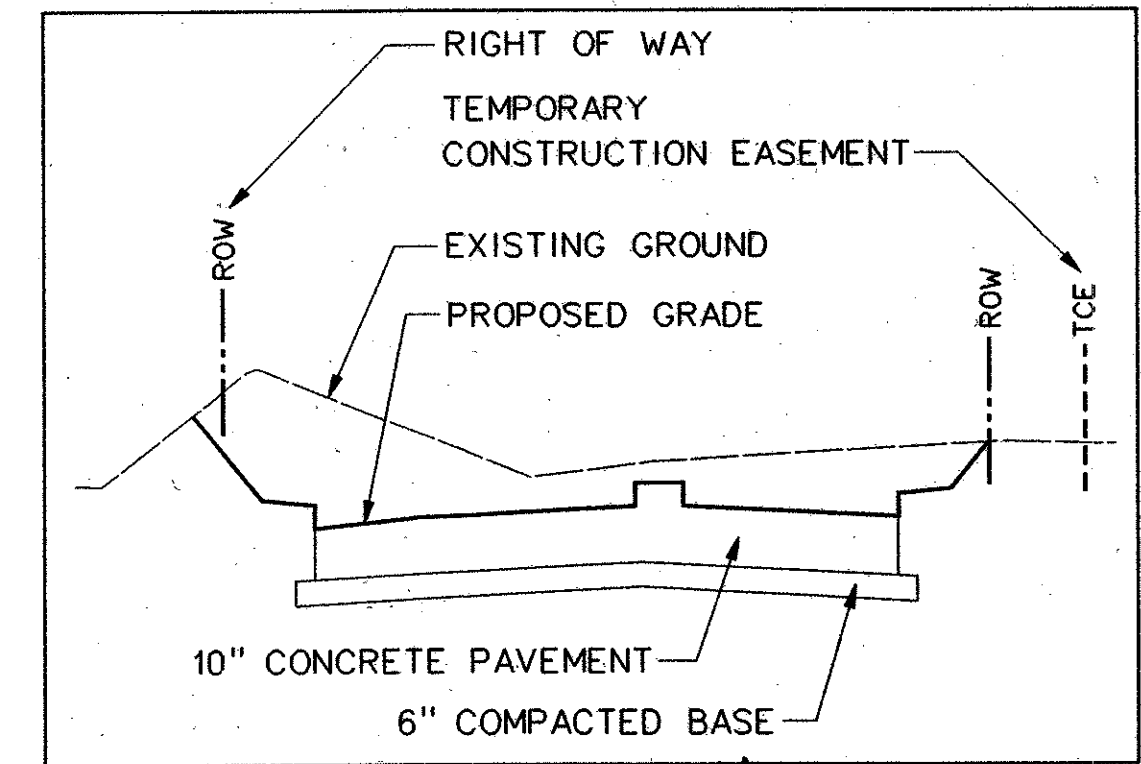

NO.		DATE	REVISION	APPROV.			
HNTB ARCHITECTS ENGINEERS PLANNERS The HNTB Companies							
ARAPAHO ROAD - PHASE III							
SURVEYOR BOULEVARD TO ADDISON ROAD							
CROSS SECTIONS							
SHEET 8 OF 29							
TOWN OF ADDISON, TEXAS							
Design	JSN	Drawn	GFS	DATE	SCALE	PROJECT NO.	SHEET NO.
Check	JDH	Check	JSN	APRIL 04	1" = 20' H 1" = 4' V	25768	XS-8

131