

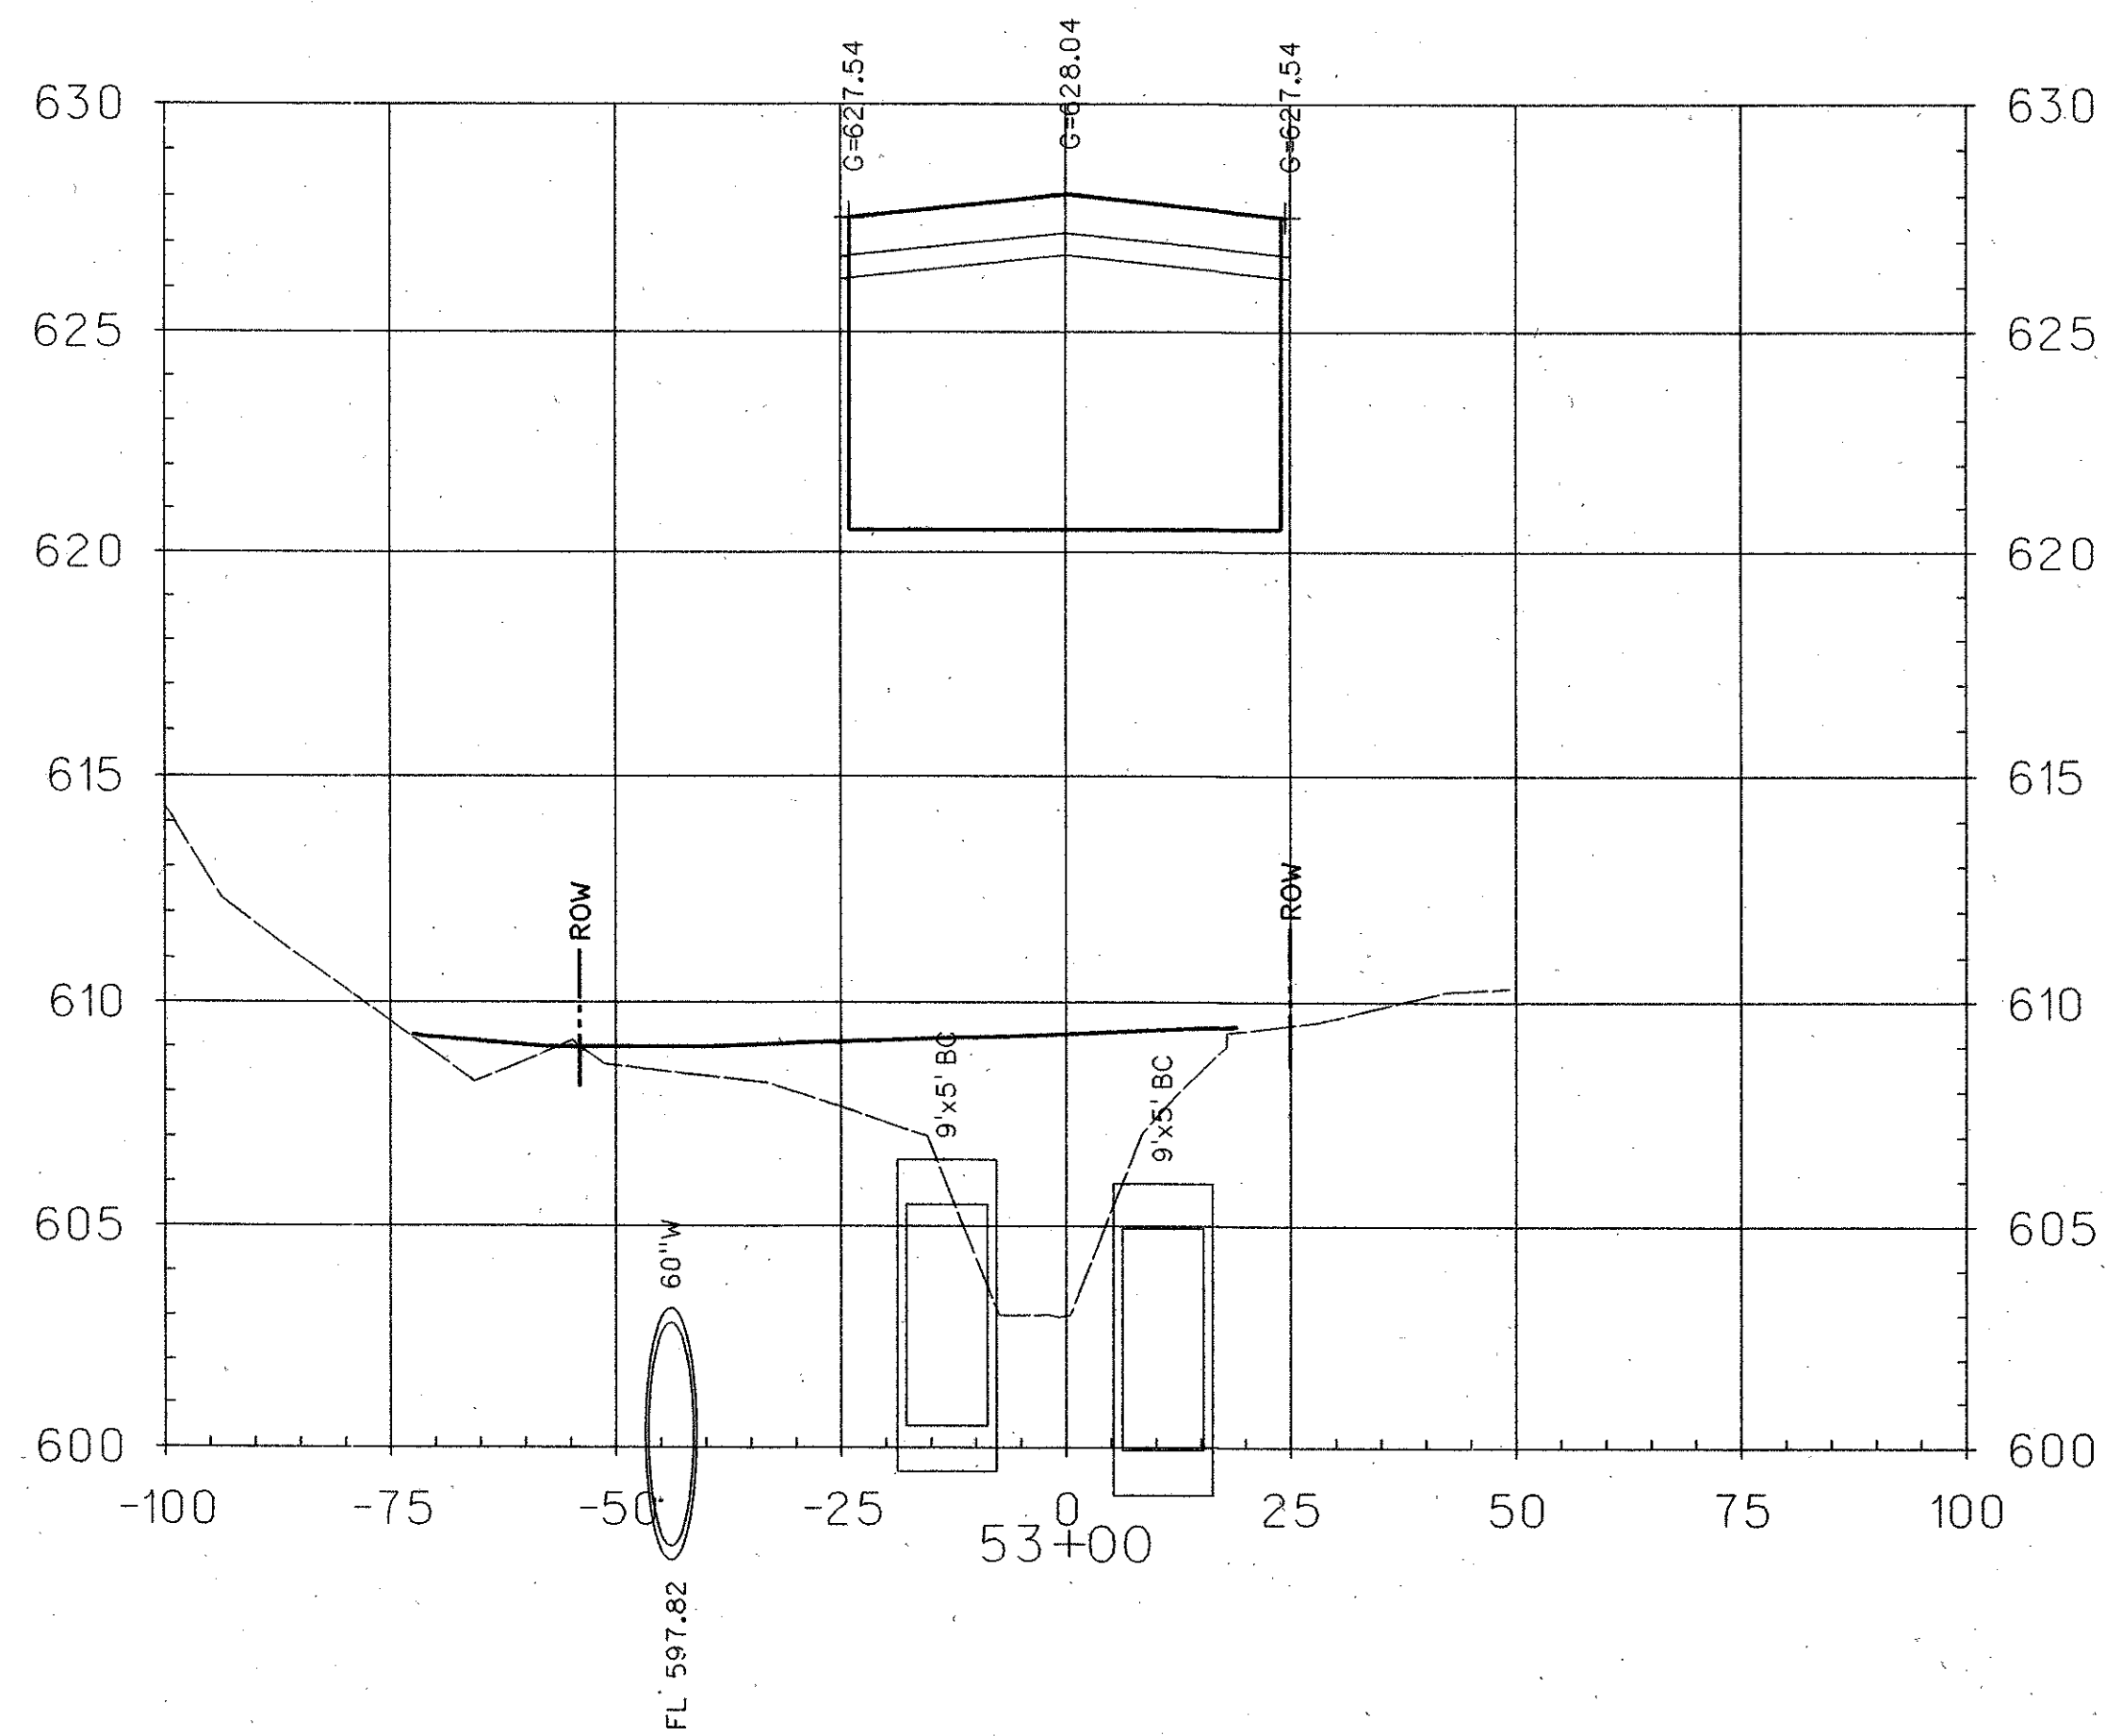
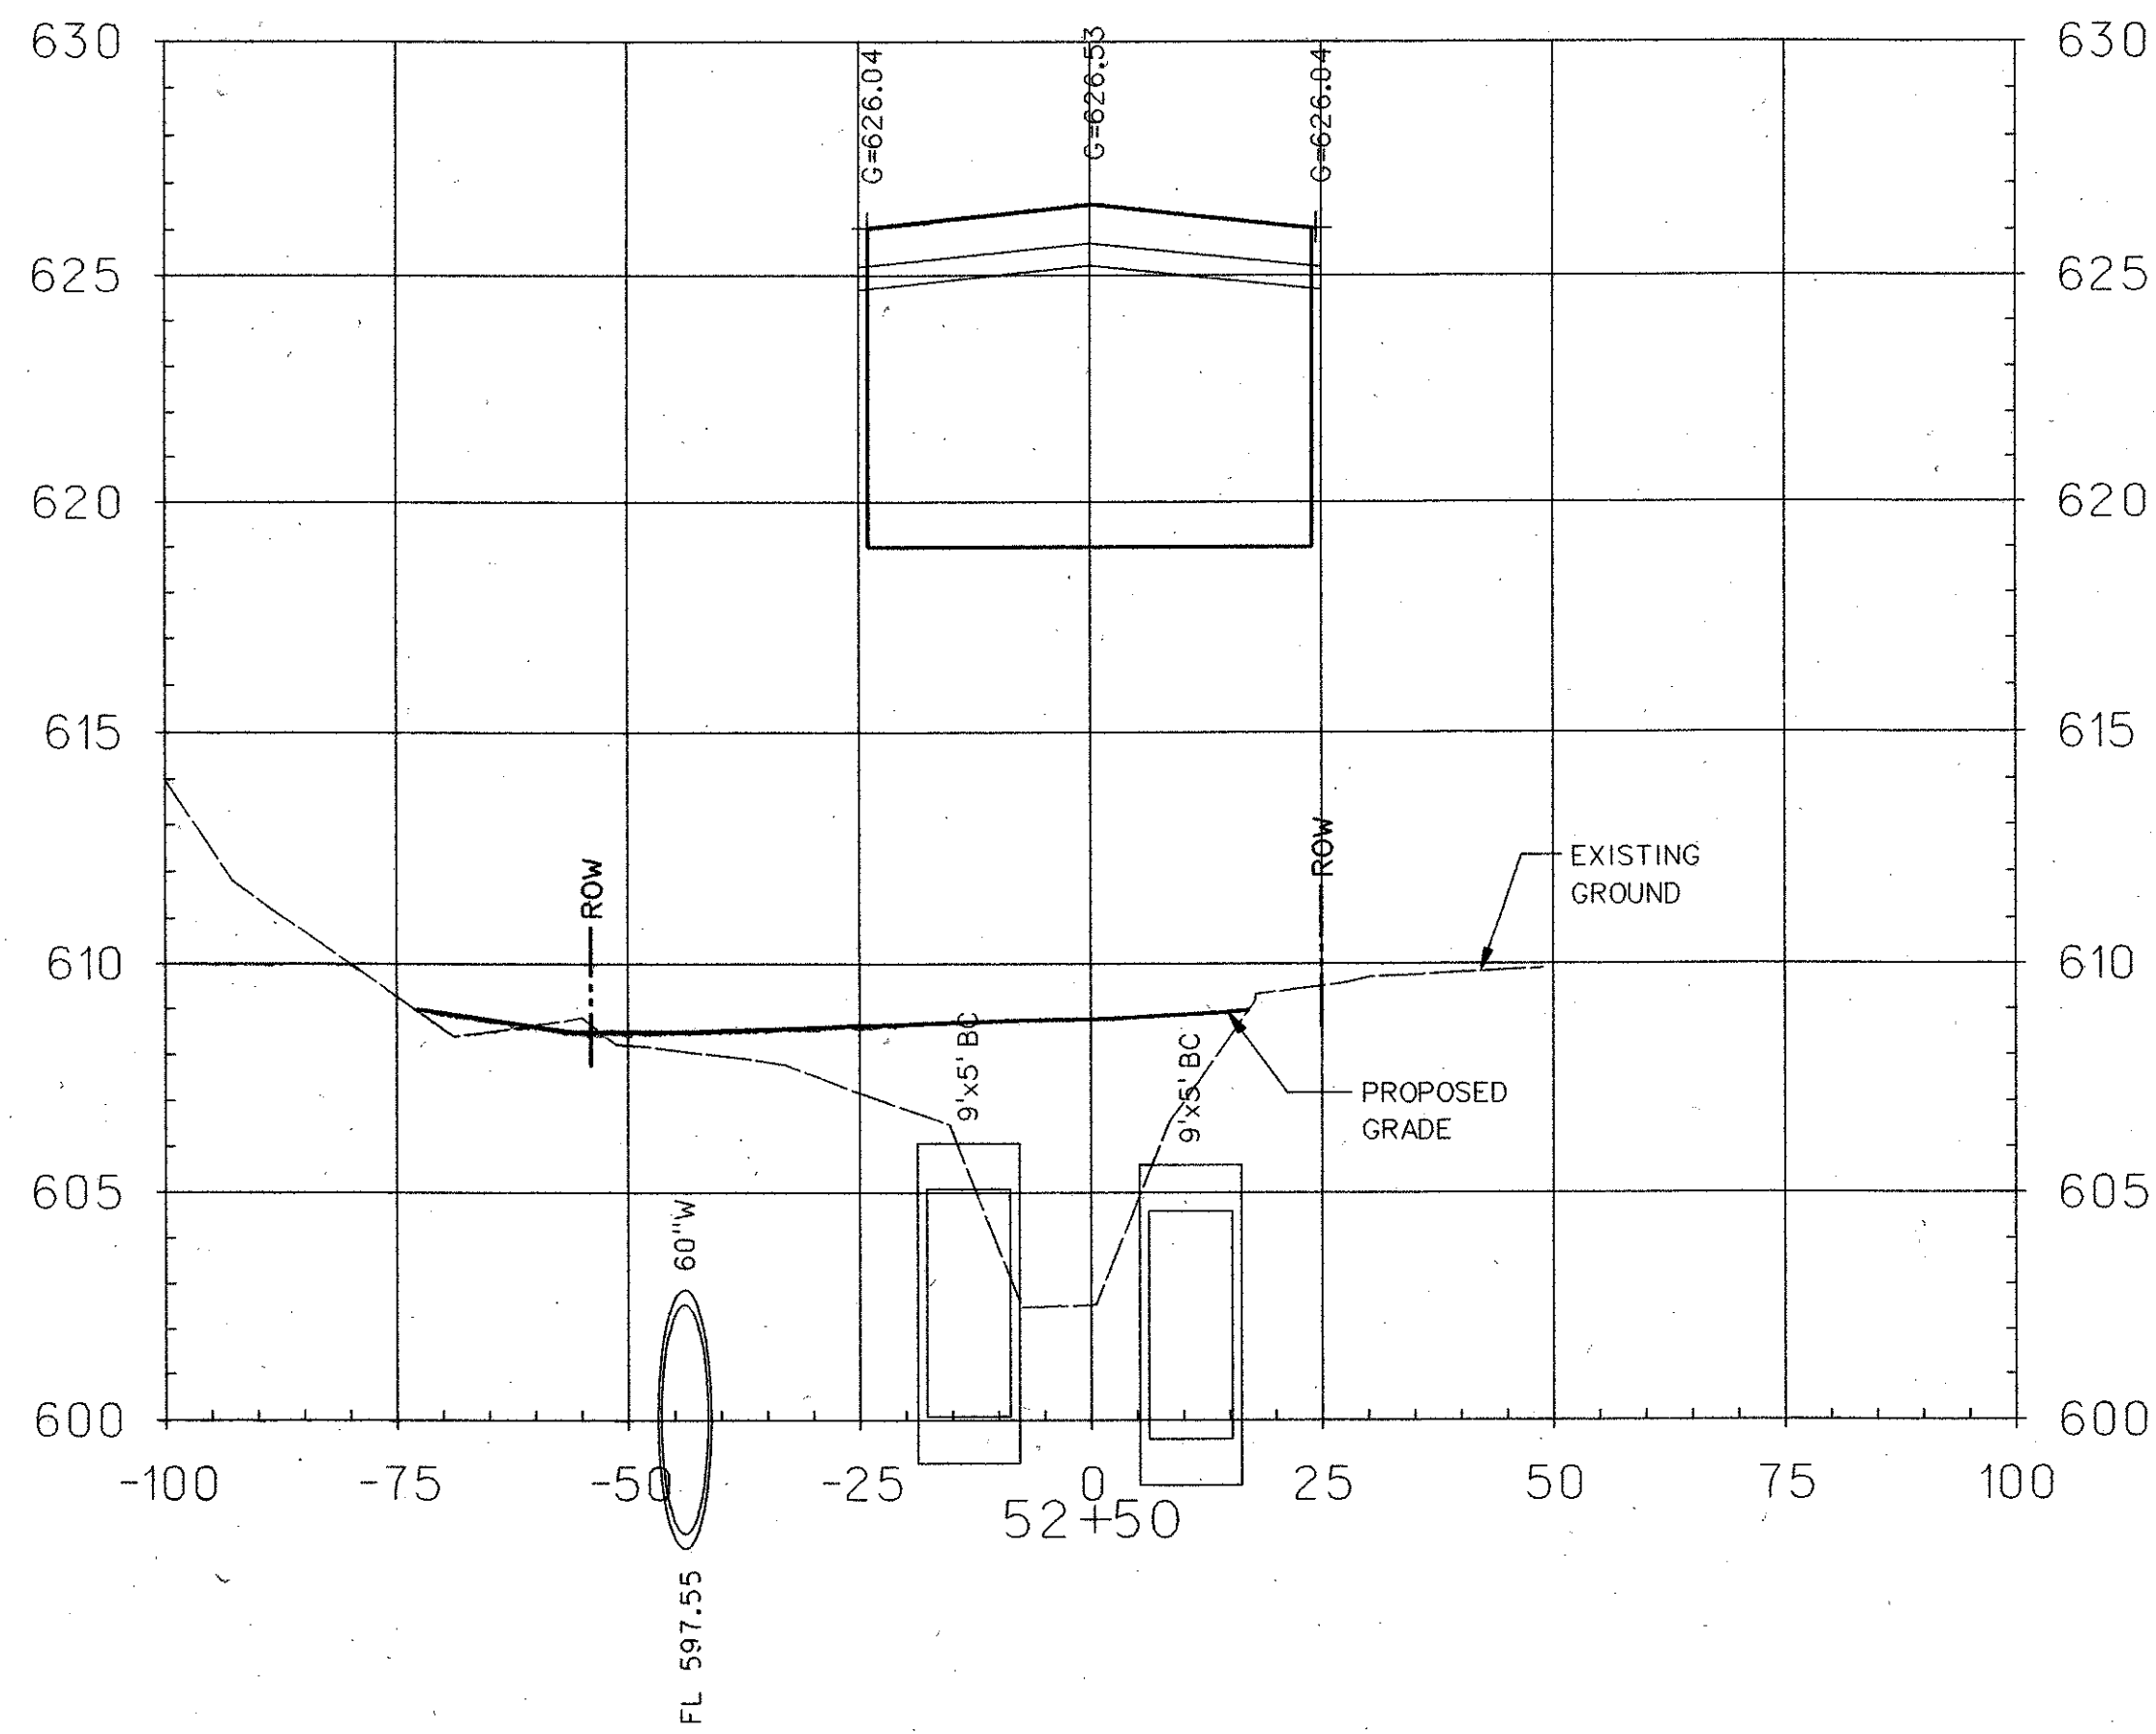


26-JUL-2004 16:06
 G:\25768-ph3\m\cads\ar3\xs09.dgn

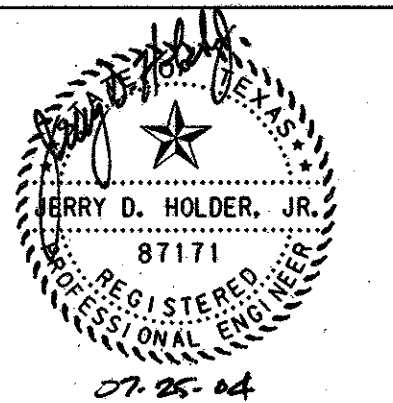

LEGEND

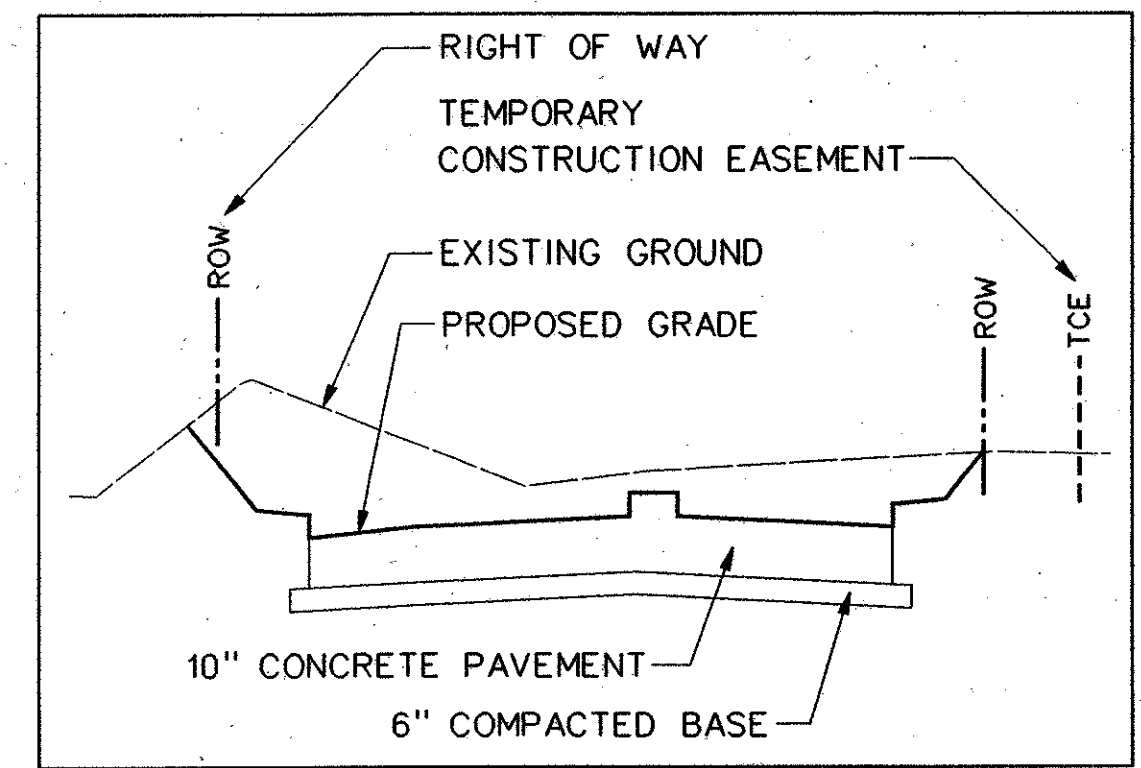

| | | | | | | | |
|---|------|----------|---------|----------|-------------------------|-------------|-----------|
| | | | | 132 | | | |
| NO. | DATE | REVISION | APPROV. | | | | |
| HNTB ARCHITECTS ENGINEERS PLANNERS The HNTB Companies | | | | | | | |
| ARAPAHO ROAD - PHASE III | | | | | | | |
| SURVEYOR BOULEVARD TO ADDISON ROAD | | | | | | | |
| CROSS SECTIONS | | | | | | | |
| SHEET 9 OF 29 | | | | | | | |
| TOWN OF ADDISON, TEXAS | | | | | | | |
| Design | JSN | Drawn | GFS | DATE | SCALE | PROJECT NO. | SHEET NO. |
| Check | JDH | Check | JSN | APRIL 04 | 1" = 20' H 1" = 4' V | 25768 | XS-9 |