

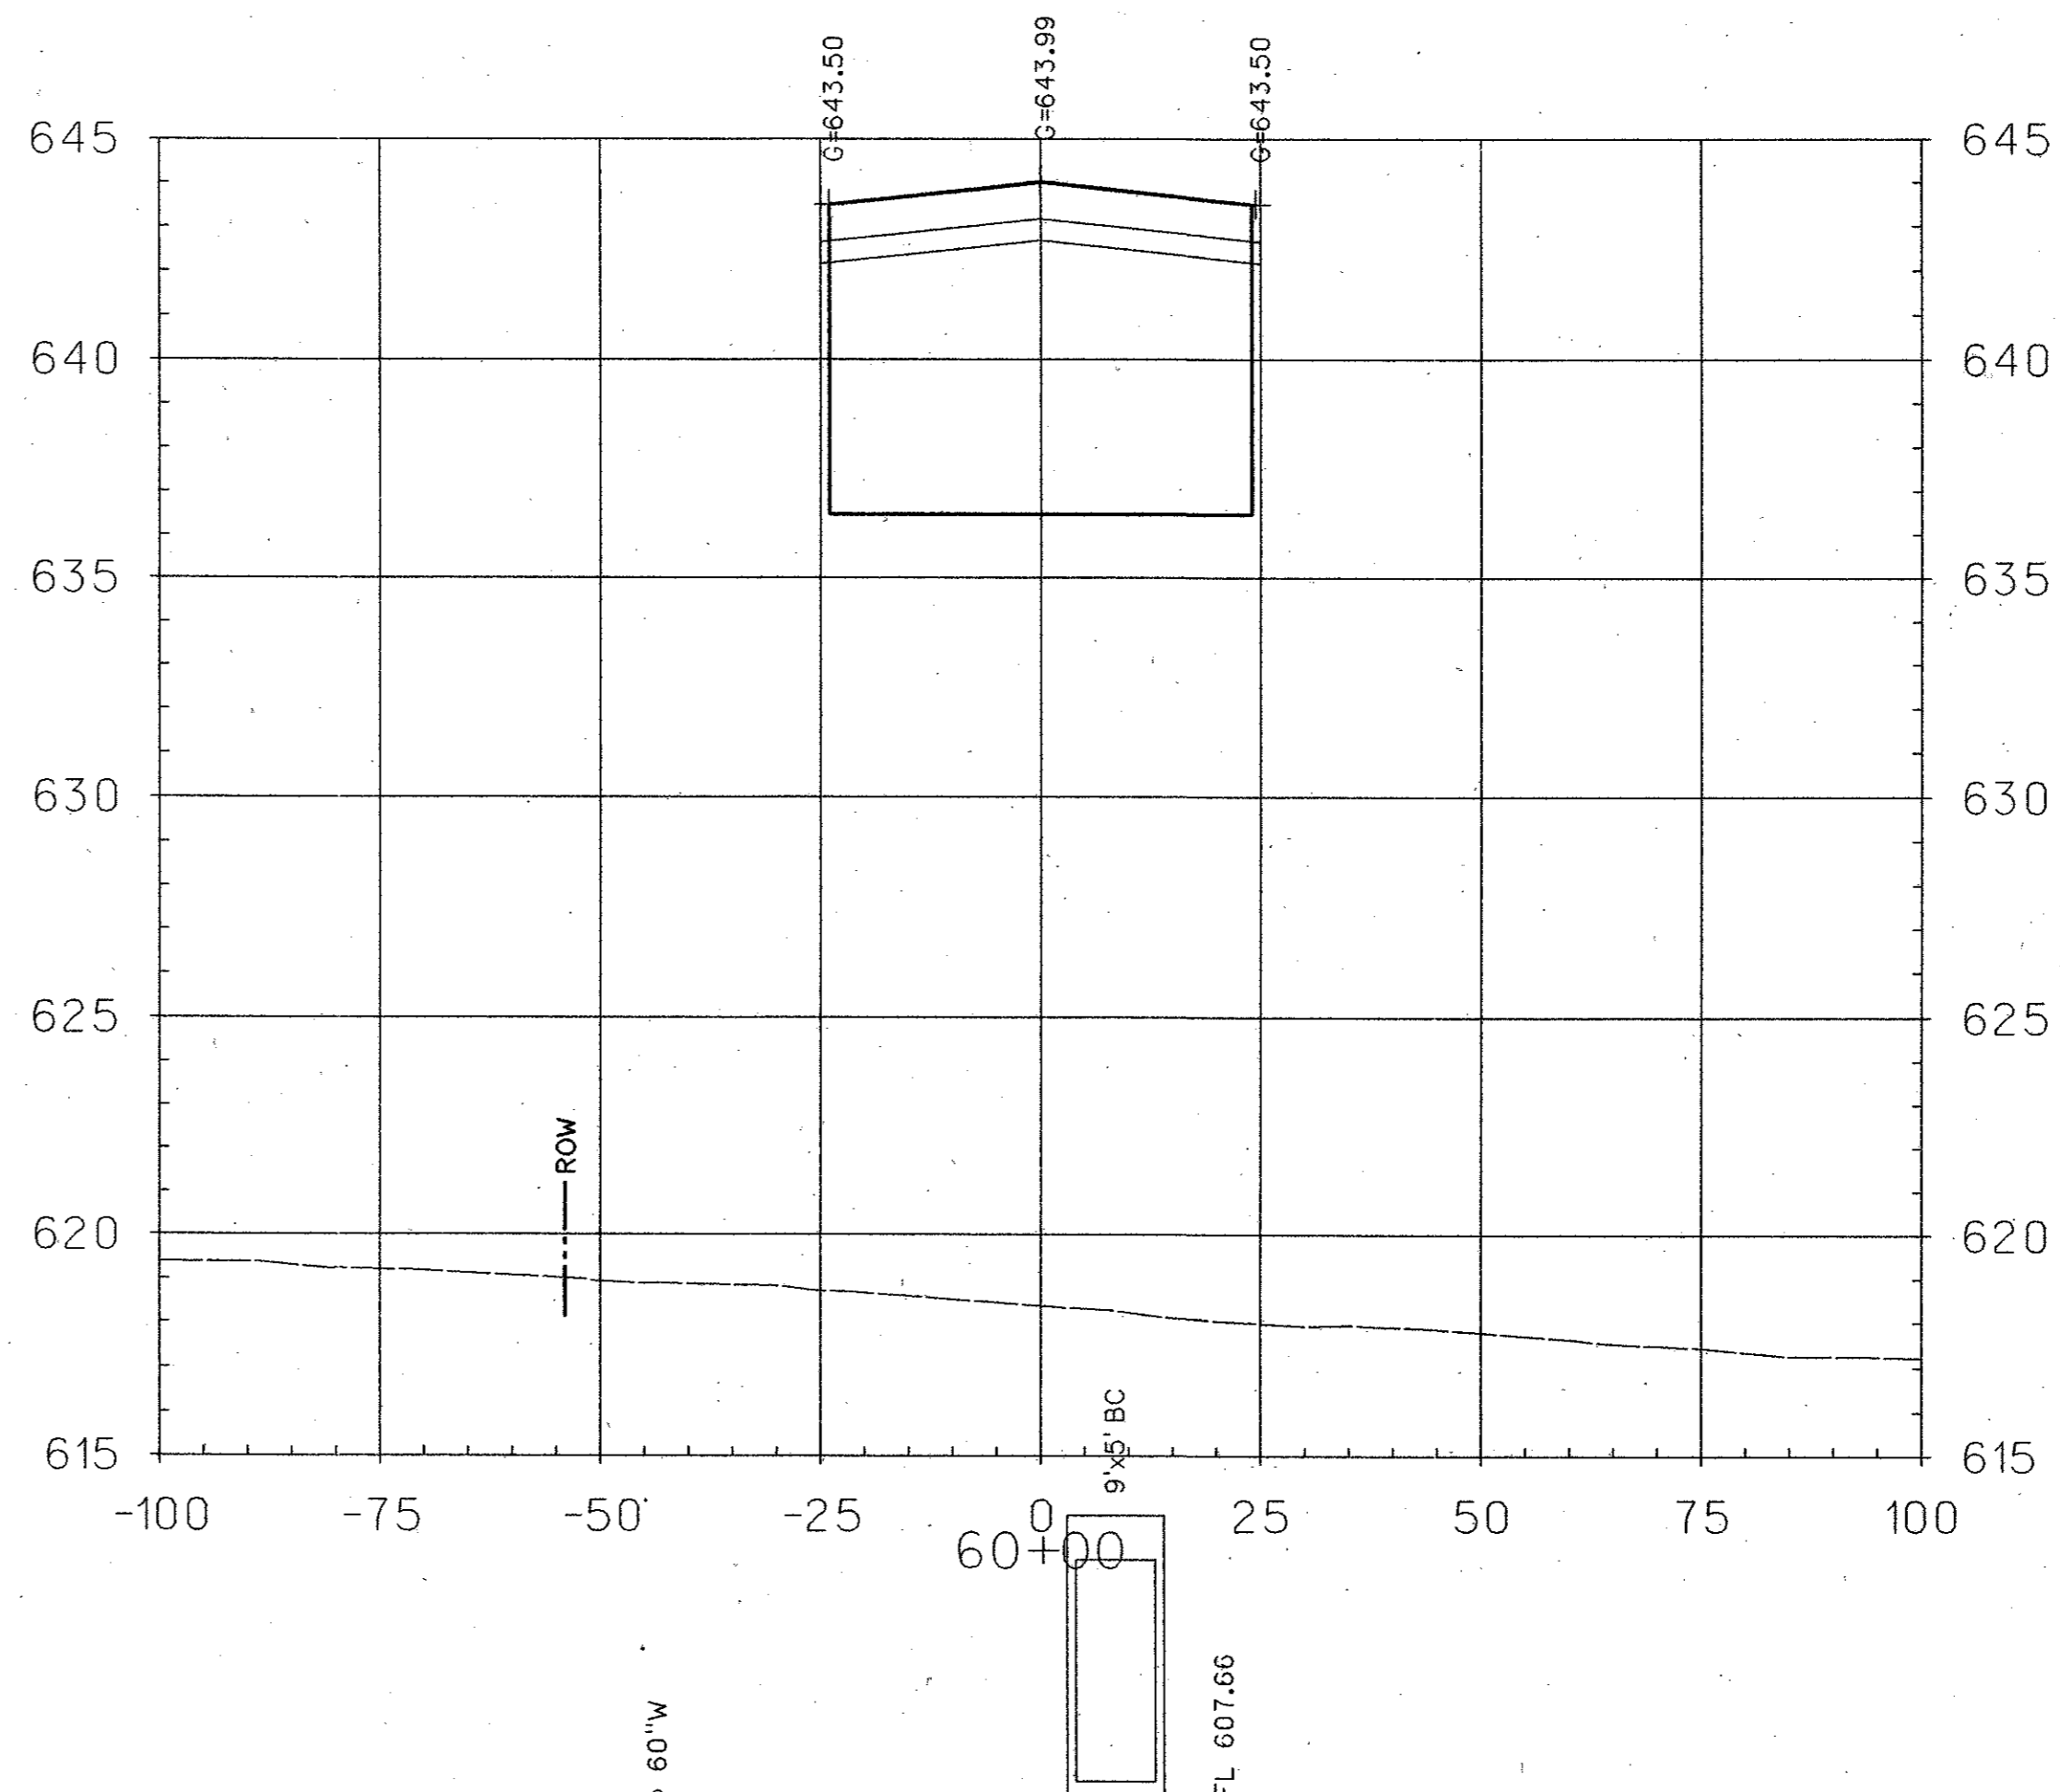
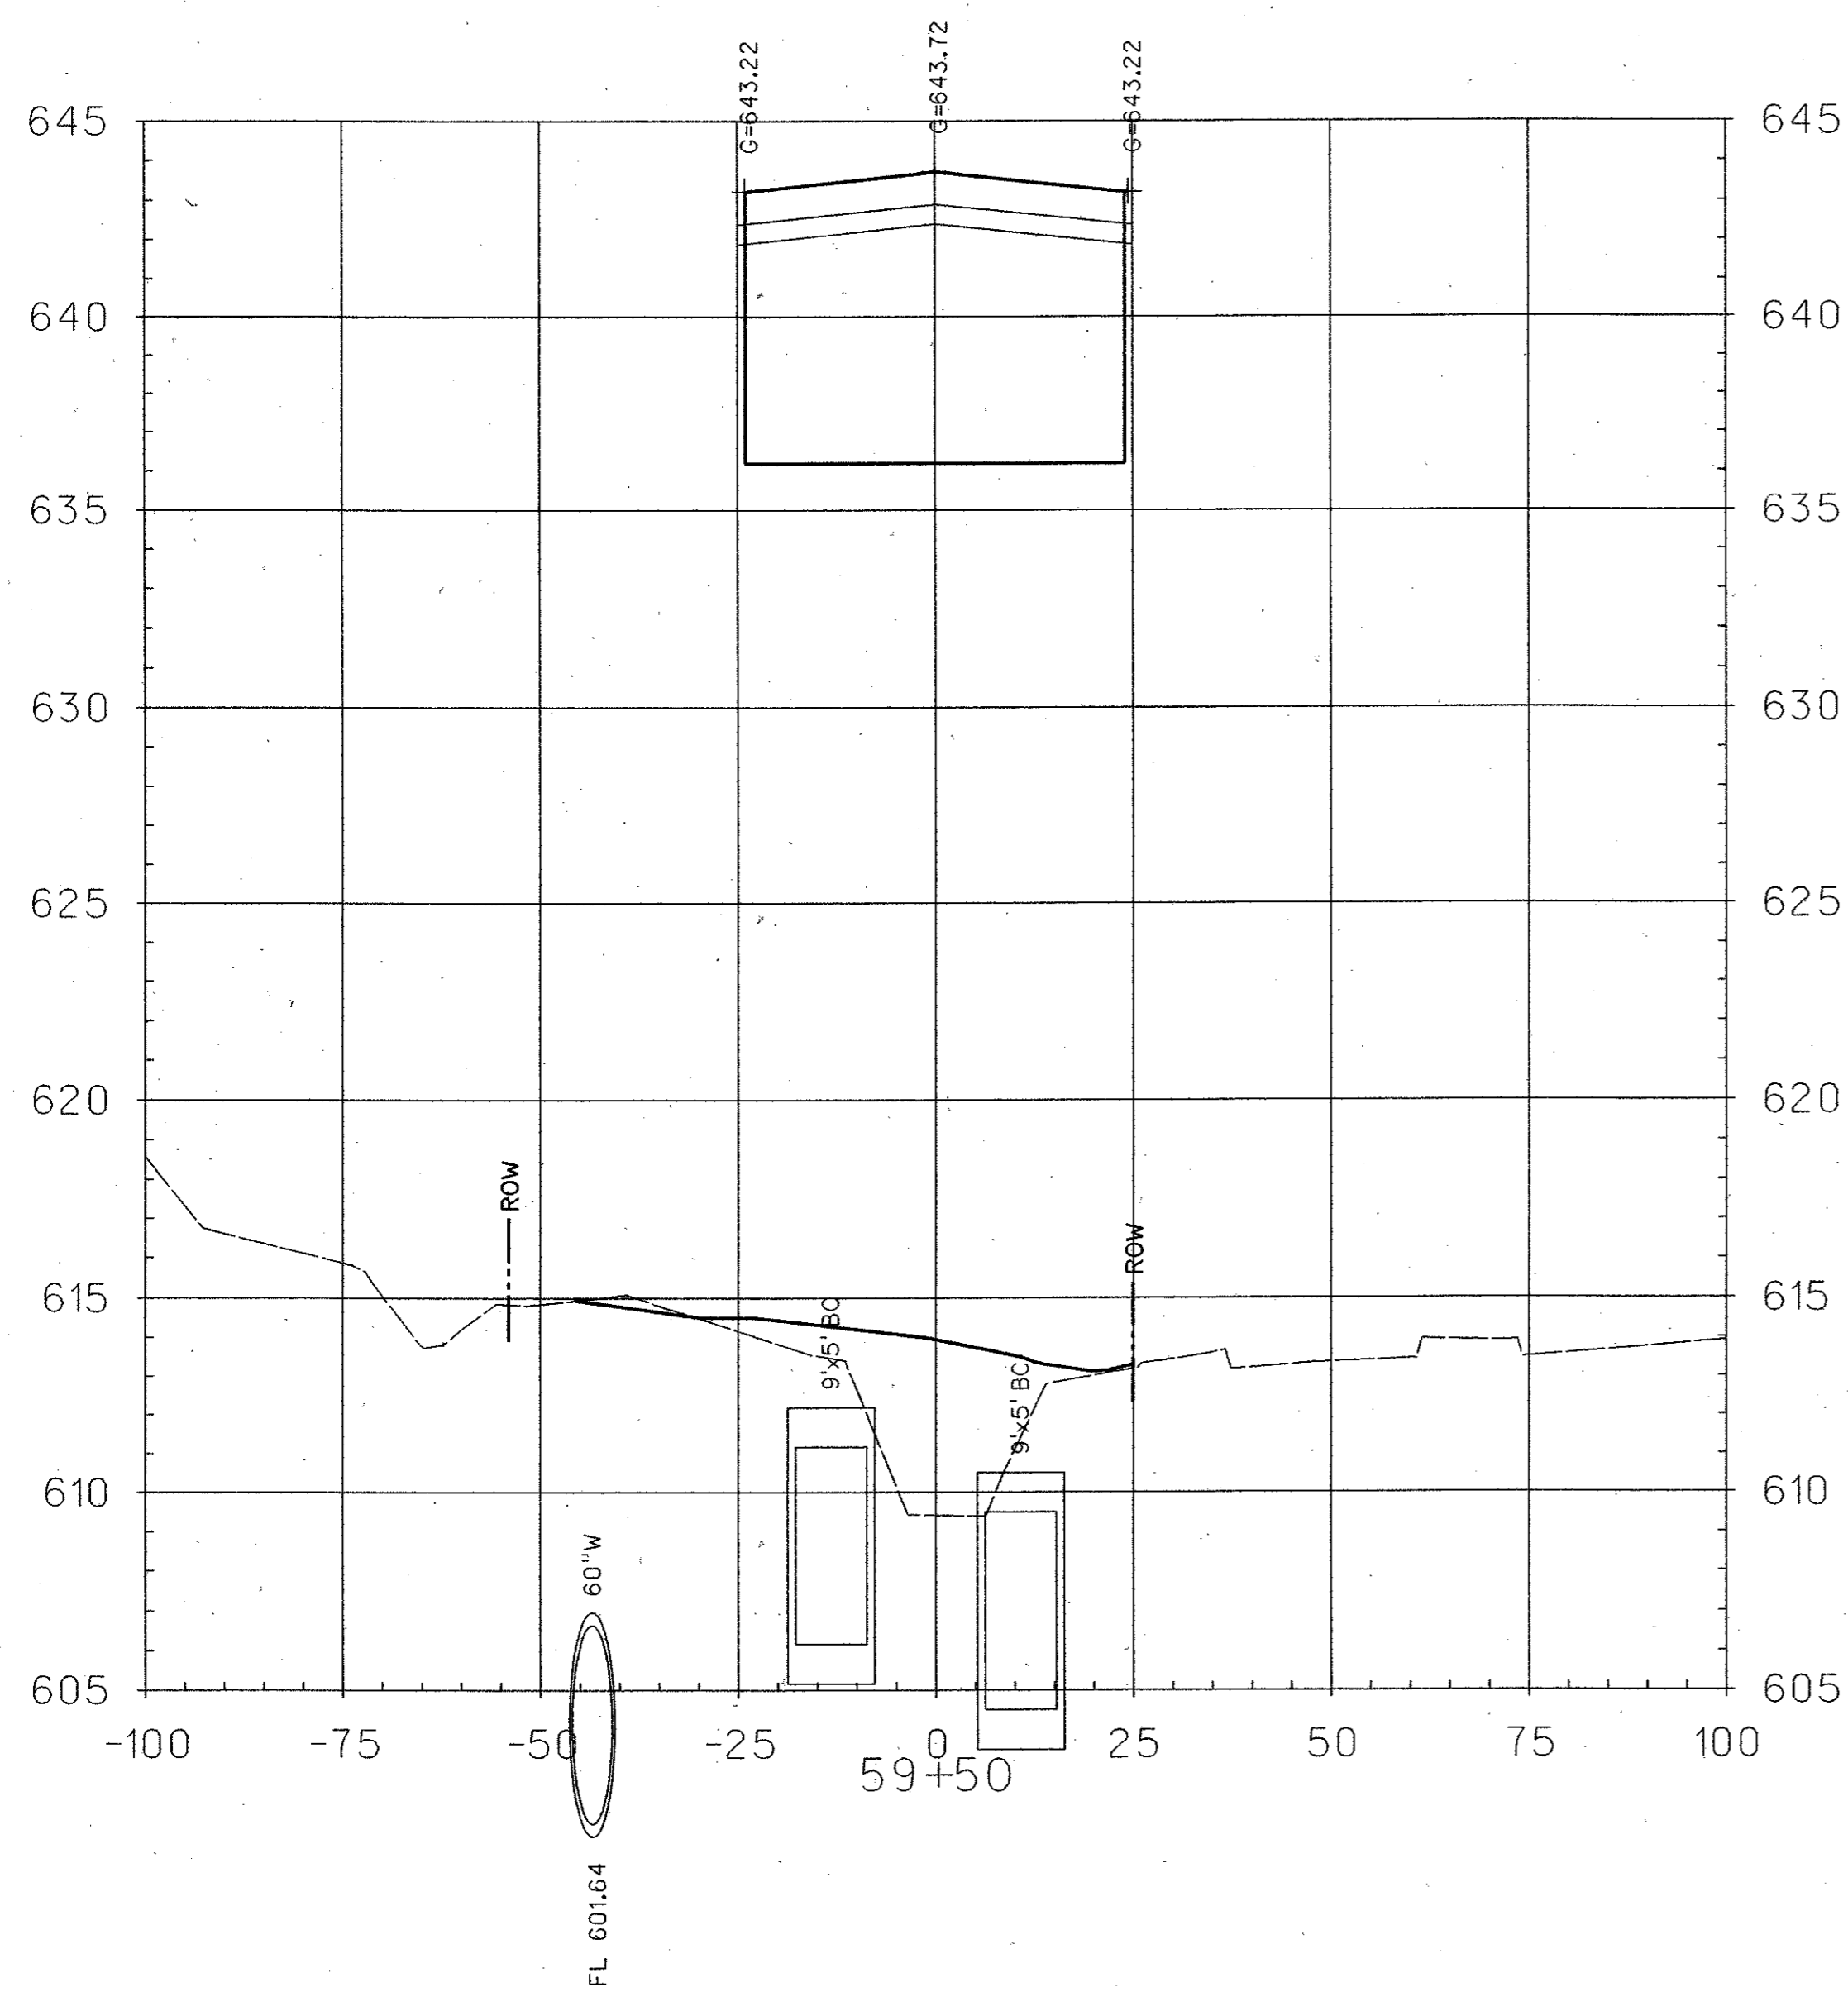


26-JUL-2004 16:07  
 G:\25168-ph3\1\1\Cds\var3\xs16.dgn

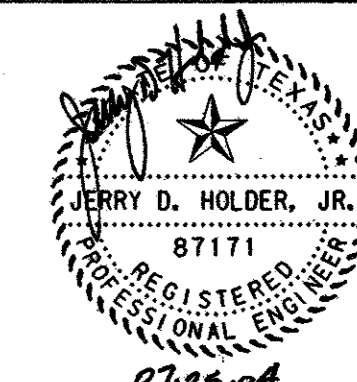

**LEGEND**

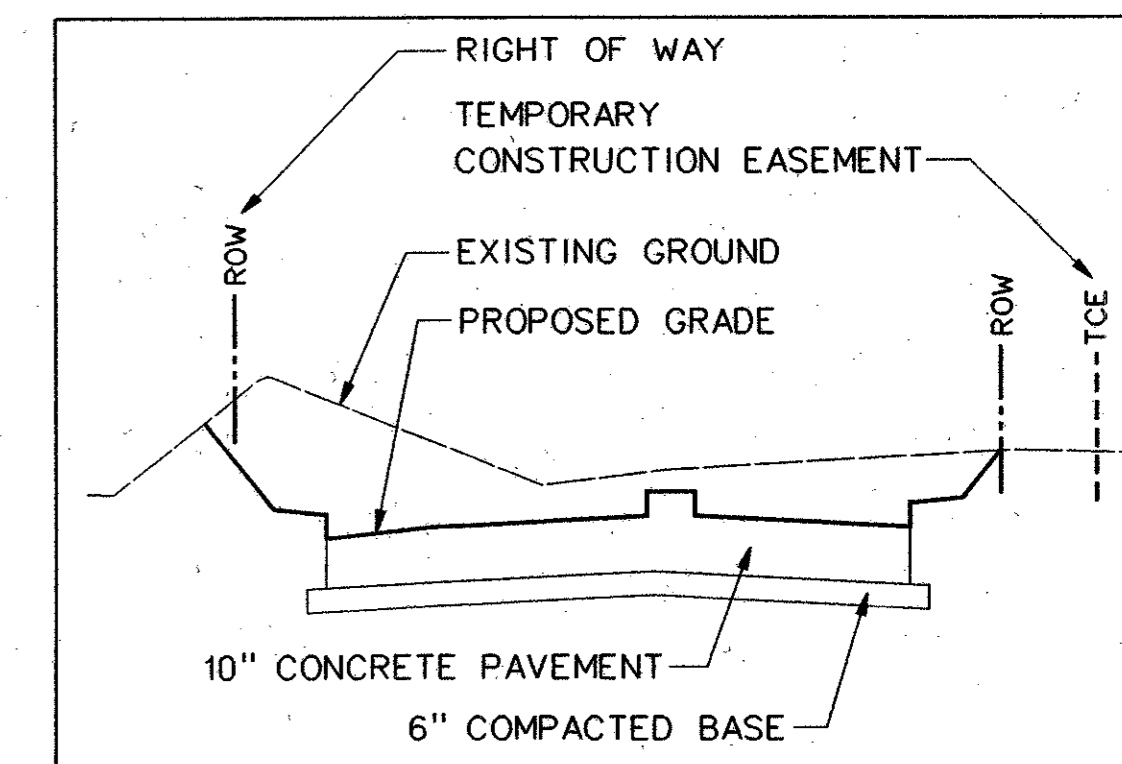

NO.		DATE	REVISION	APPROV.
<b>HNTB</b> ARCHITECTS ENGINEERS PLANNERS The HNTB Companies				
<b>ARAPAHO ROAD - PHASE III</b>				
SURVEYOR BOULEVARD TO ADDISON ROAD				
CROSS SECTIONS				
SHEET 16 OF 29				
TOWN OF ADDISON, TEXAS				
Design	JSN	Drawn	GFS	DATE
Check	JDH	Check	JSN	APRIL 04
SCALE	PROJECT NO.		SHEET NO.	
1" = 20' H 1" = 4' V	25768		XS-16	

139