

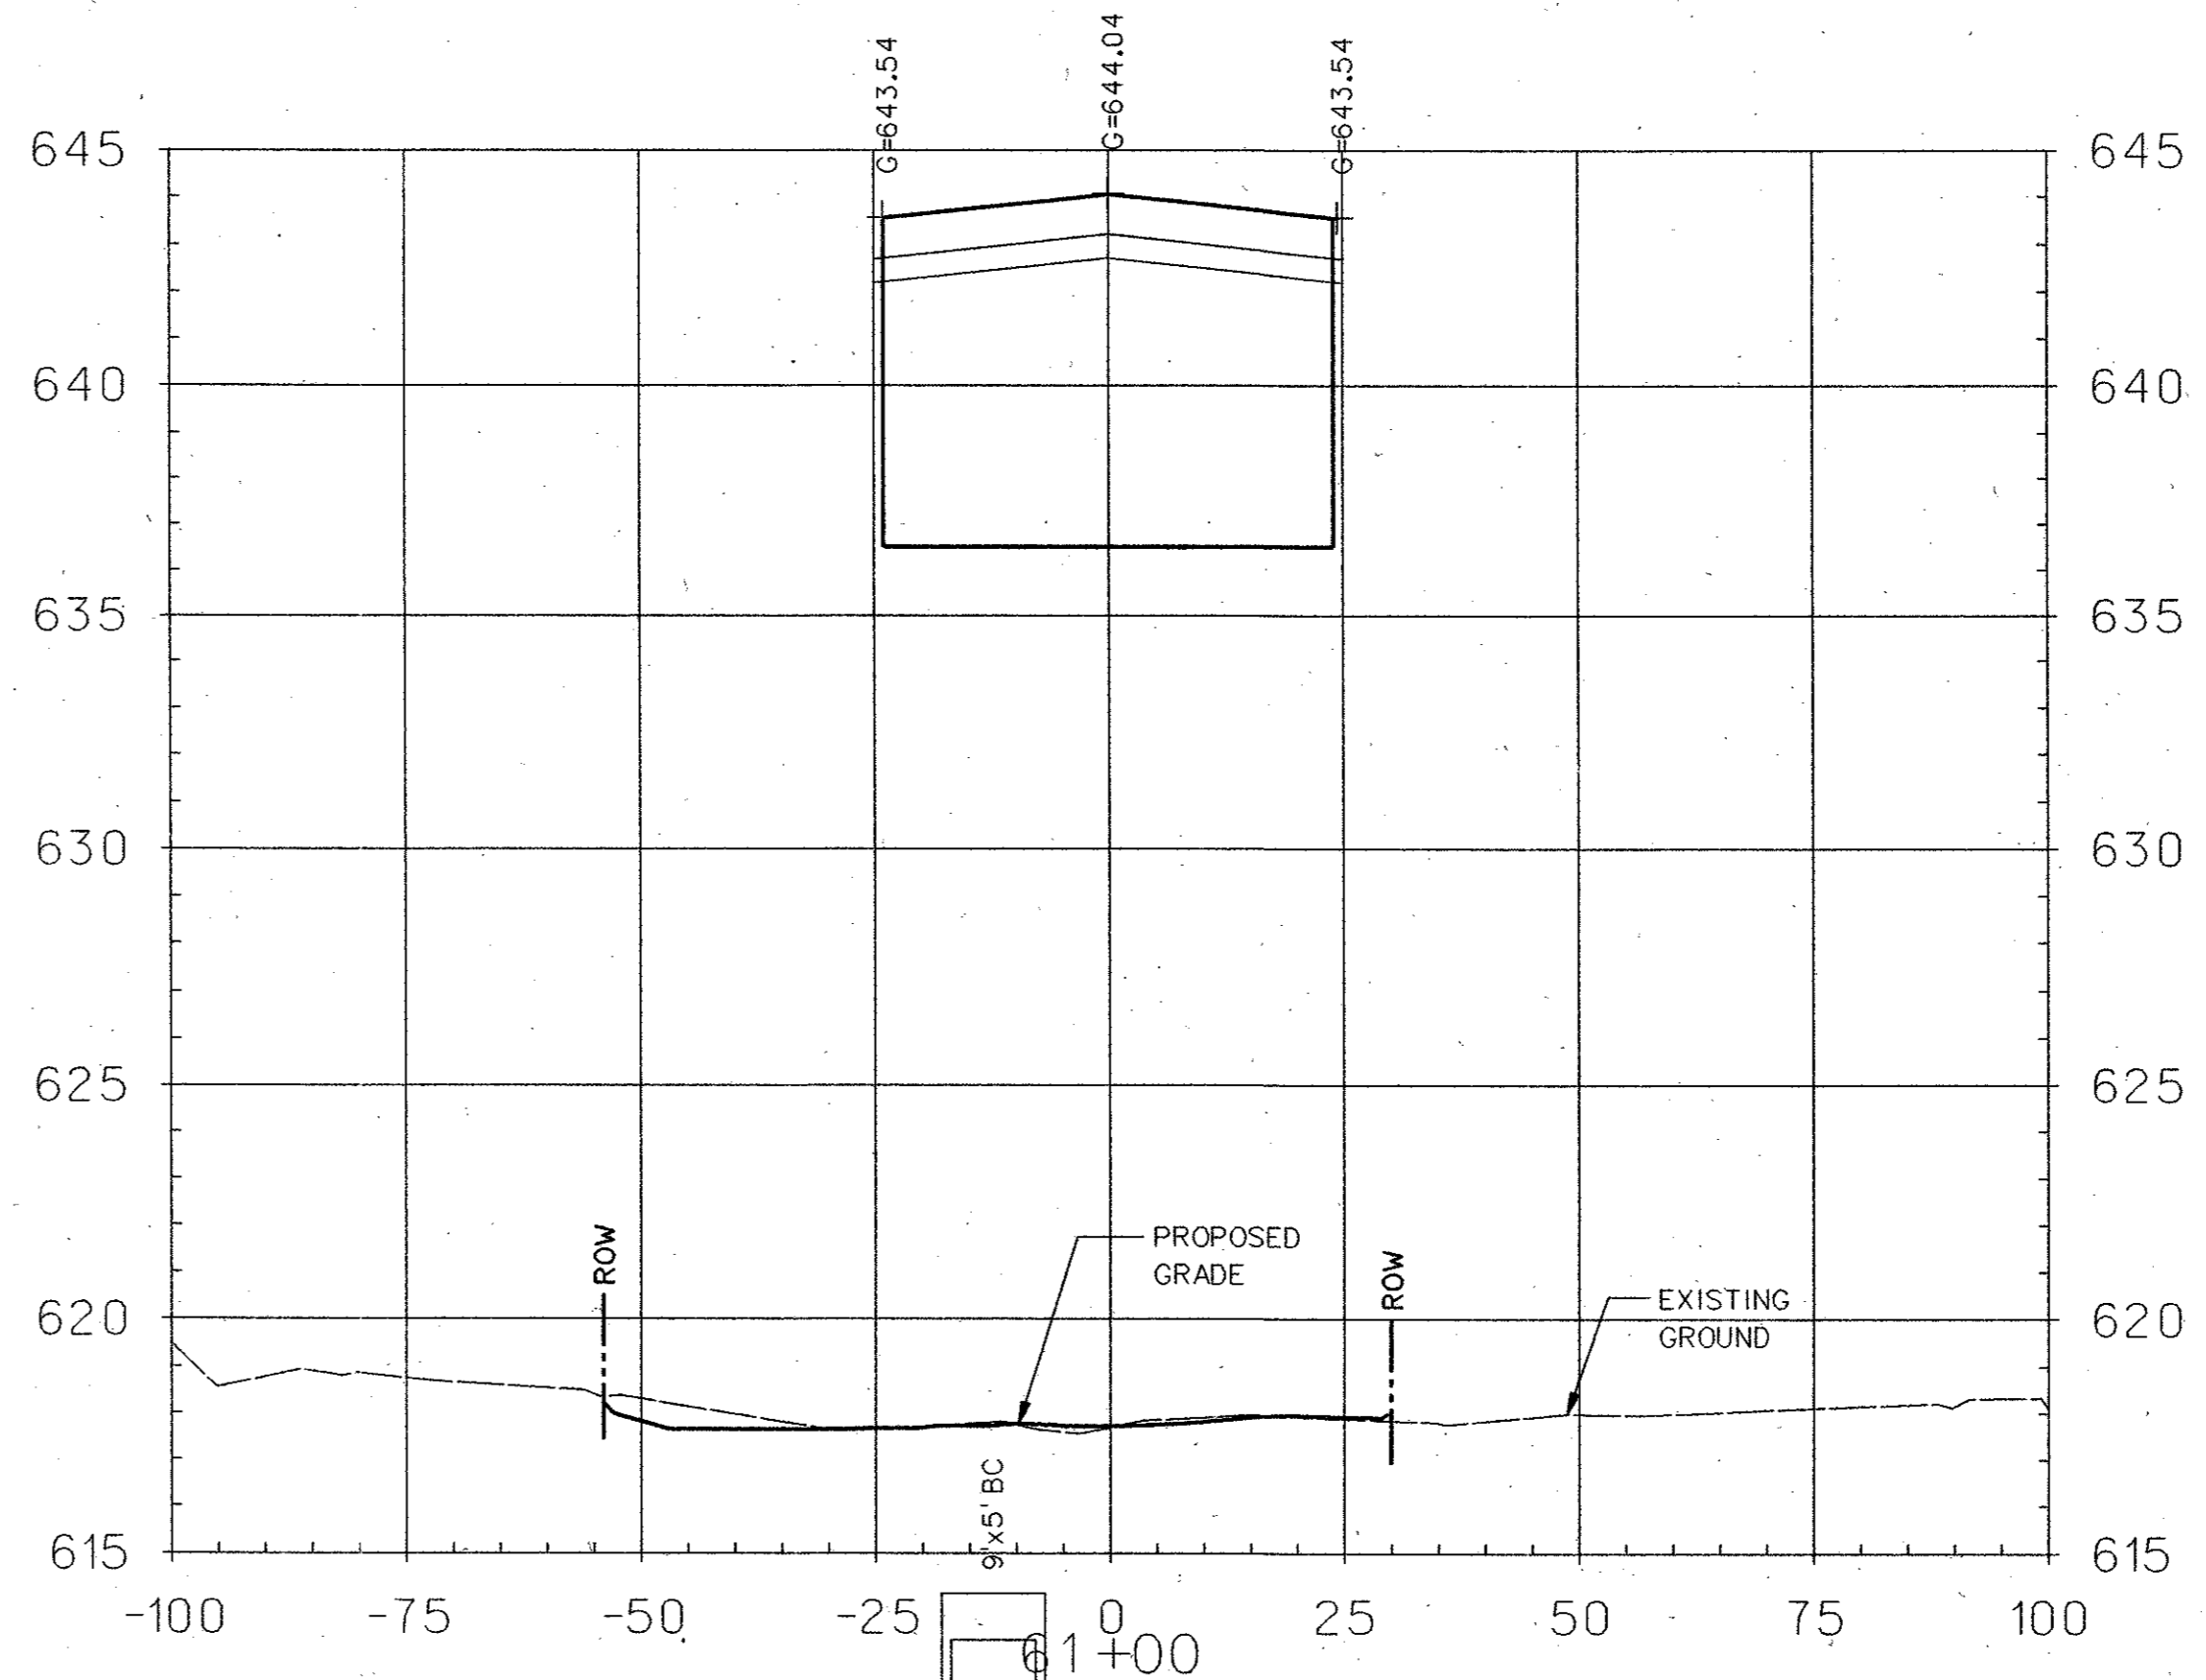
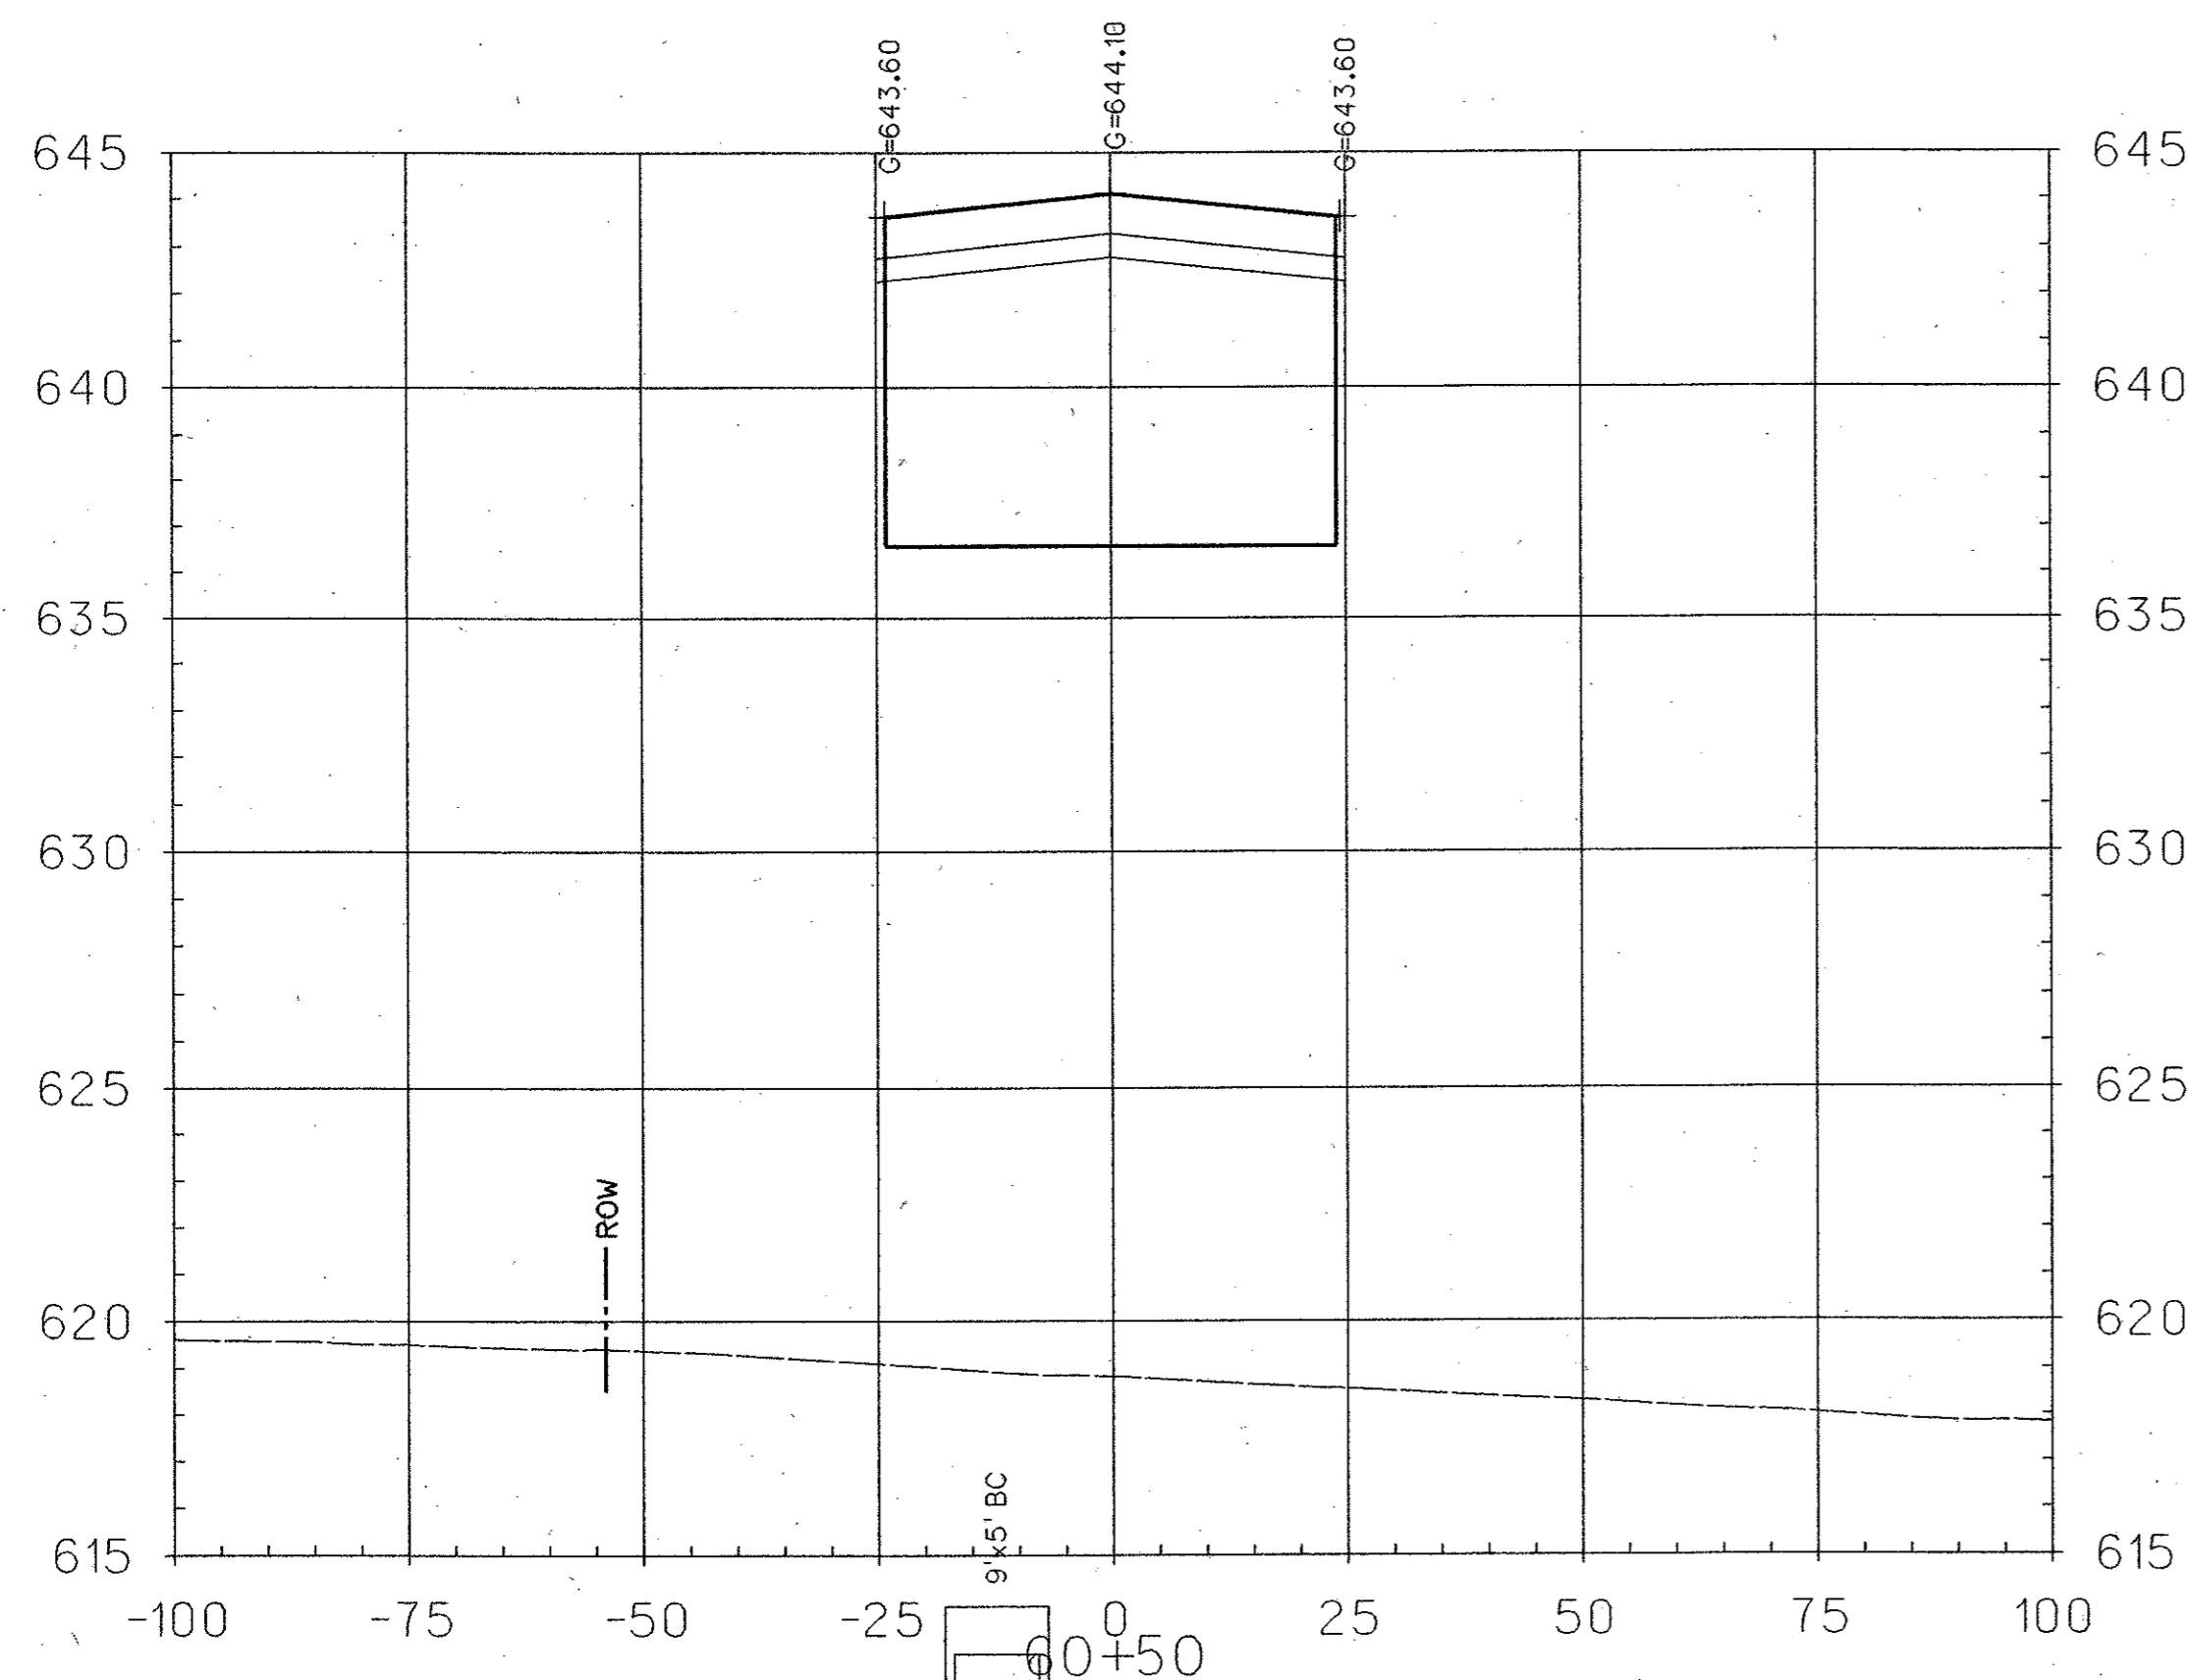


26-JUL-2004 16:33  
 G:\25768-ph3\N1\CDs\ar3xs17.dgn

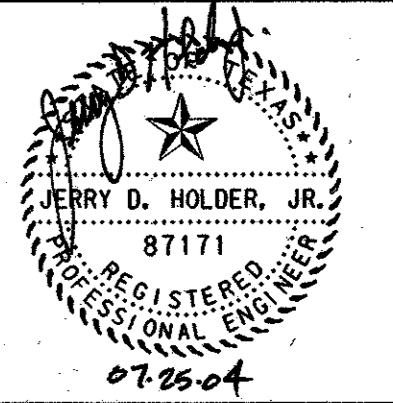

**LEGEND**

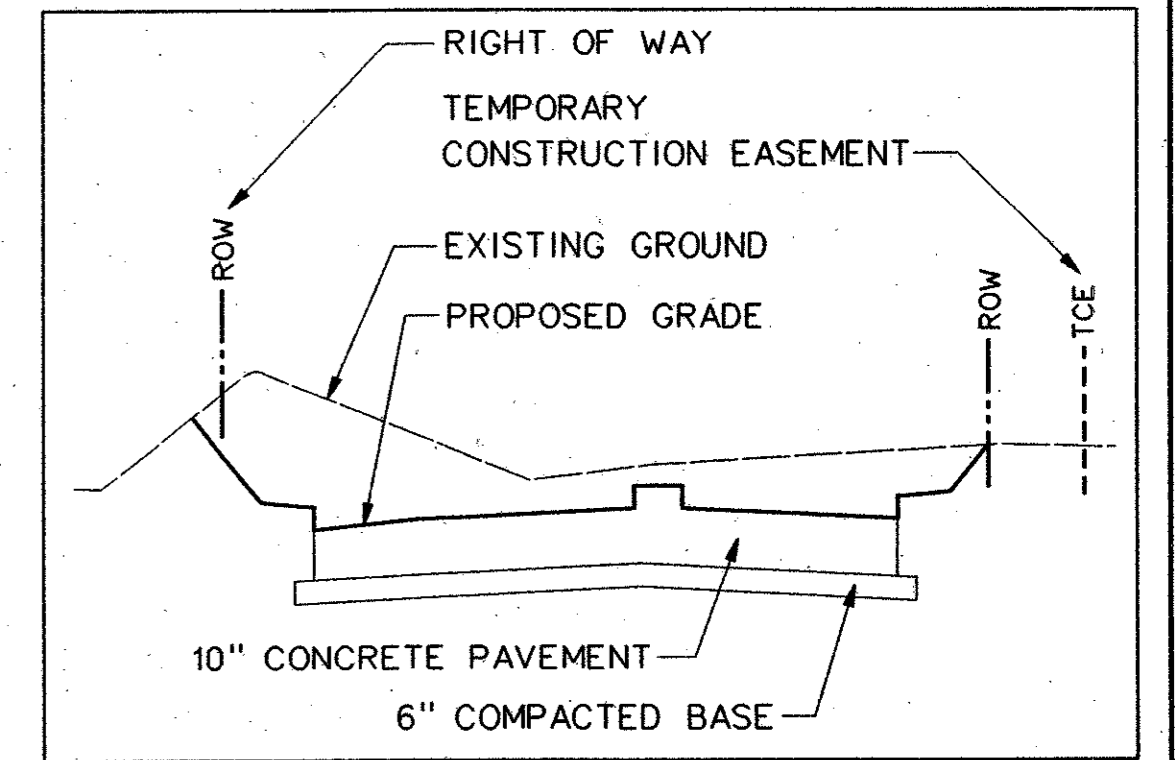

				140
NO.	DATE	REVISION	APPROV.	
<b>HNTB</b> ARCHITECTS ENGINEERS PLANNERS The HNTB Companies				
<b>ARAPAHO ROAD - PHASE III</b>				
SURVEYOR BOULEVARD TO ADDISON ROAD				
CROSS SECTIONS				
SHEET 17 OF 29				
TOWN OF ADDISON, TEXAS				
Design JSN	Drawn GFS	DATE	SCALE	PROJECT NO. SHEET NO.
Check JDH	Check JSN	APRIL 04	1" = 20' H 1" = 4' V	25768 XS-17