

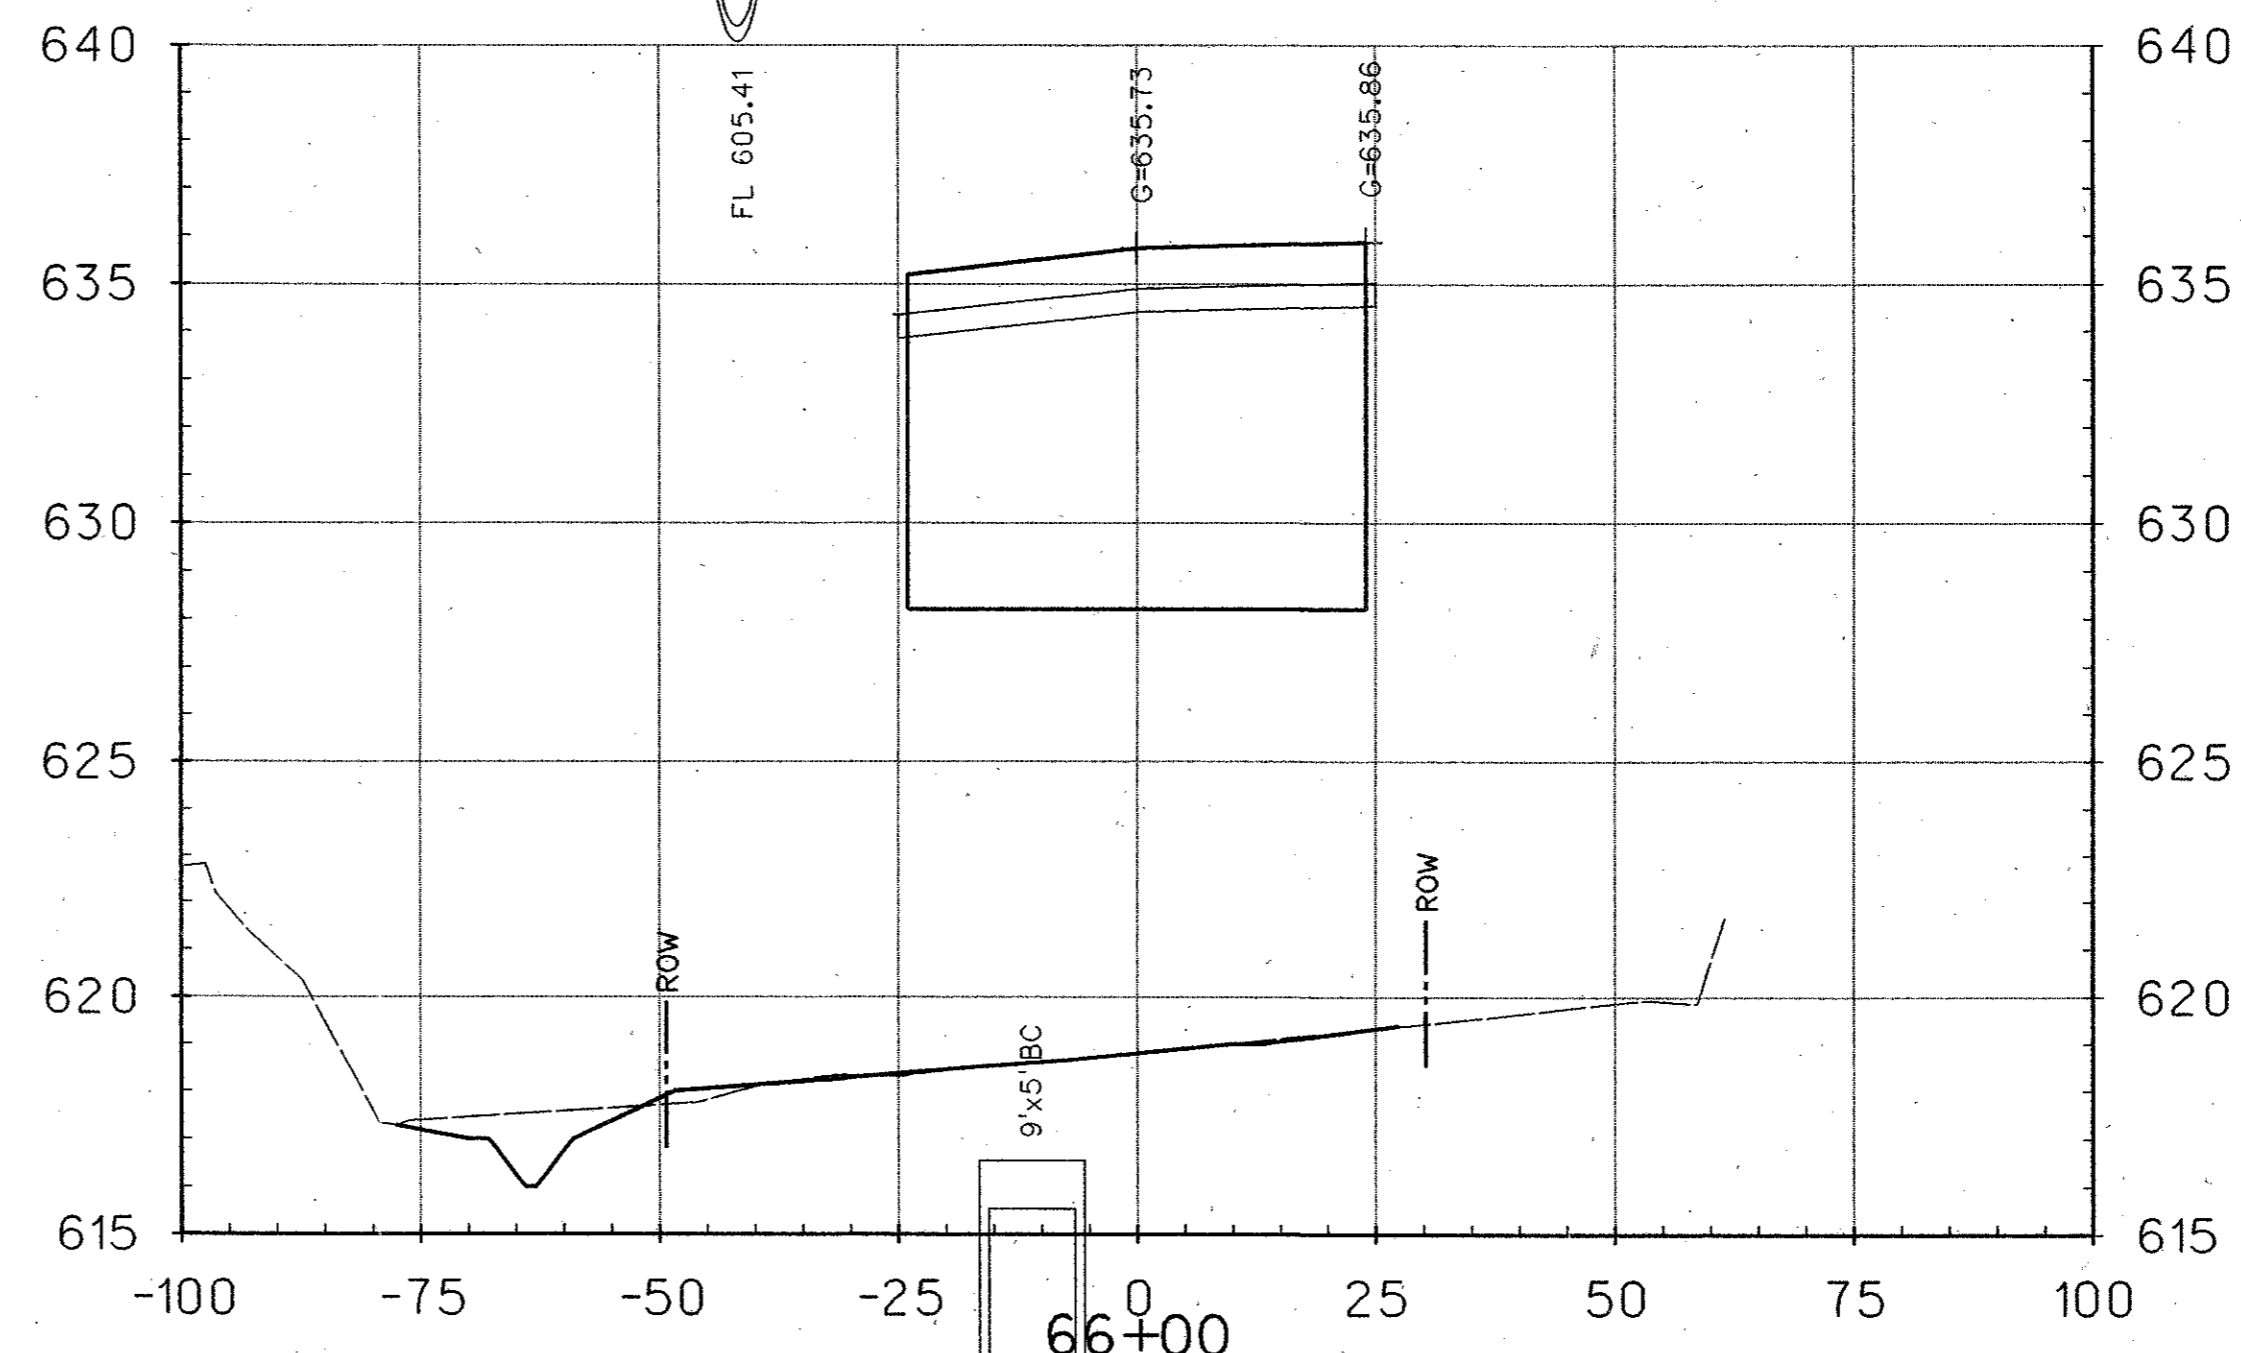
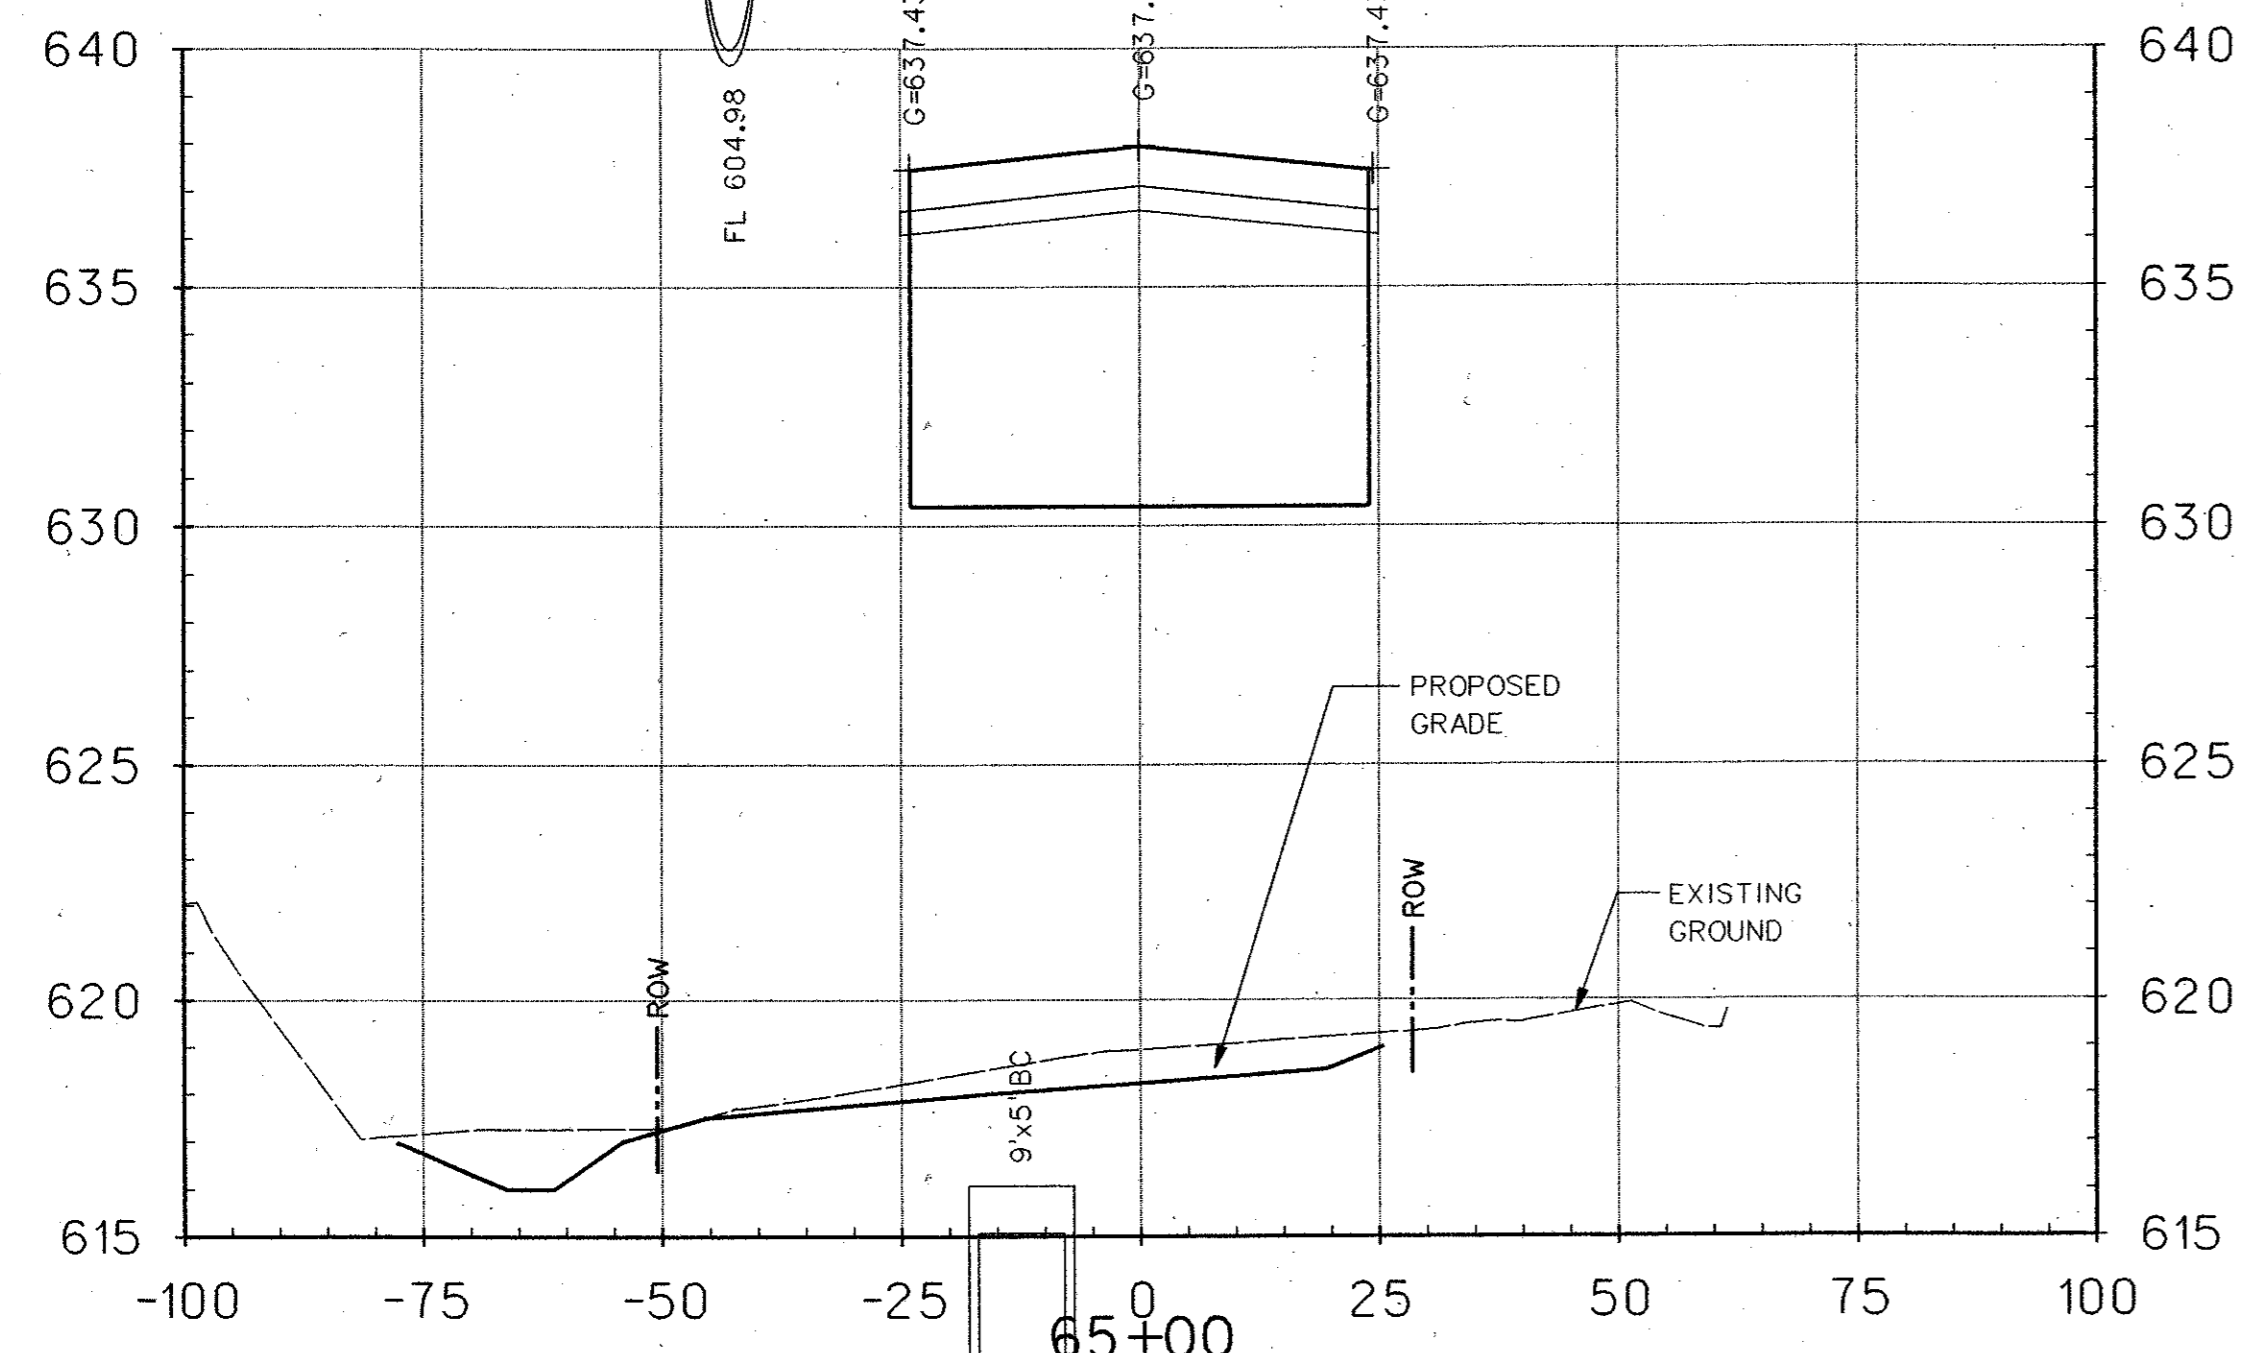
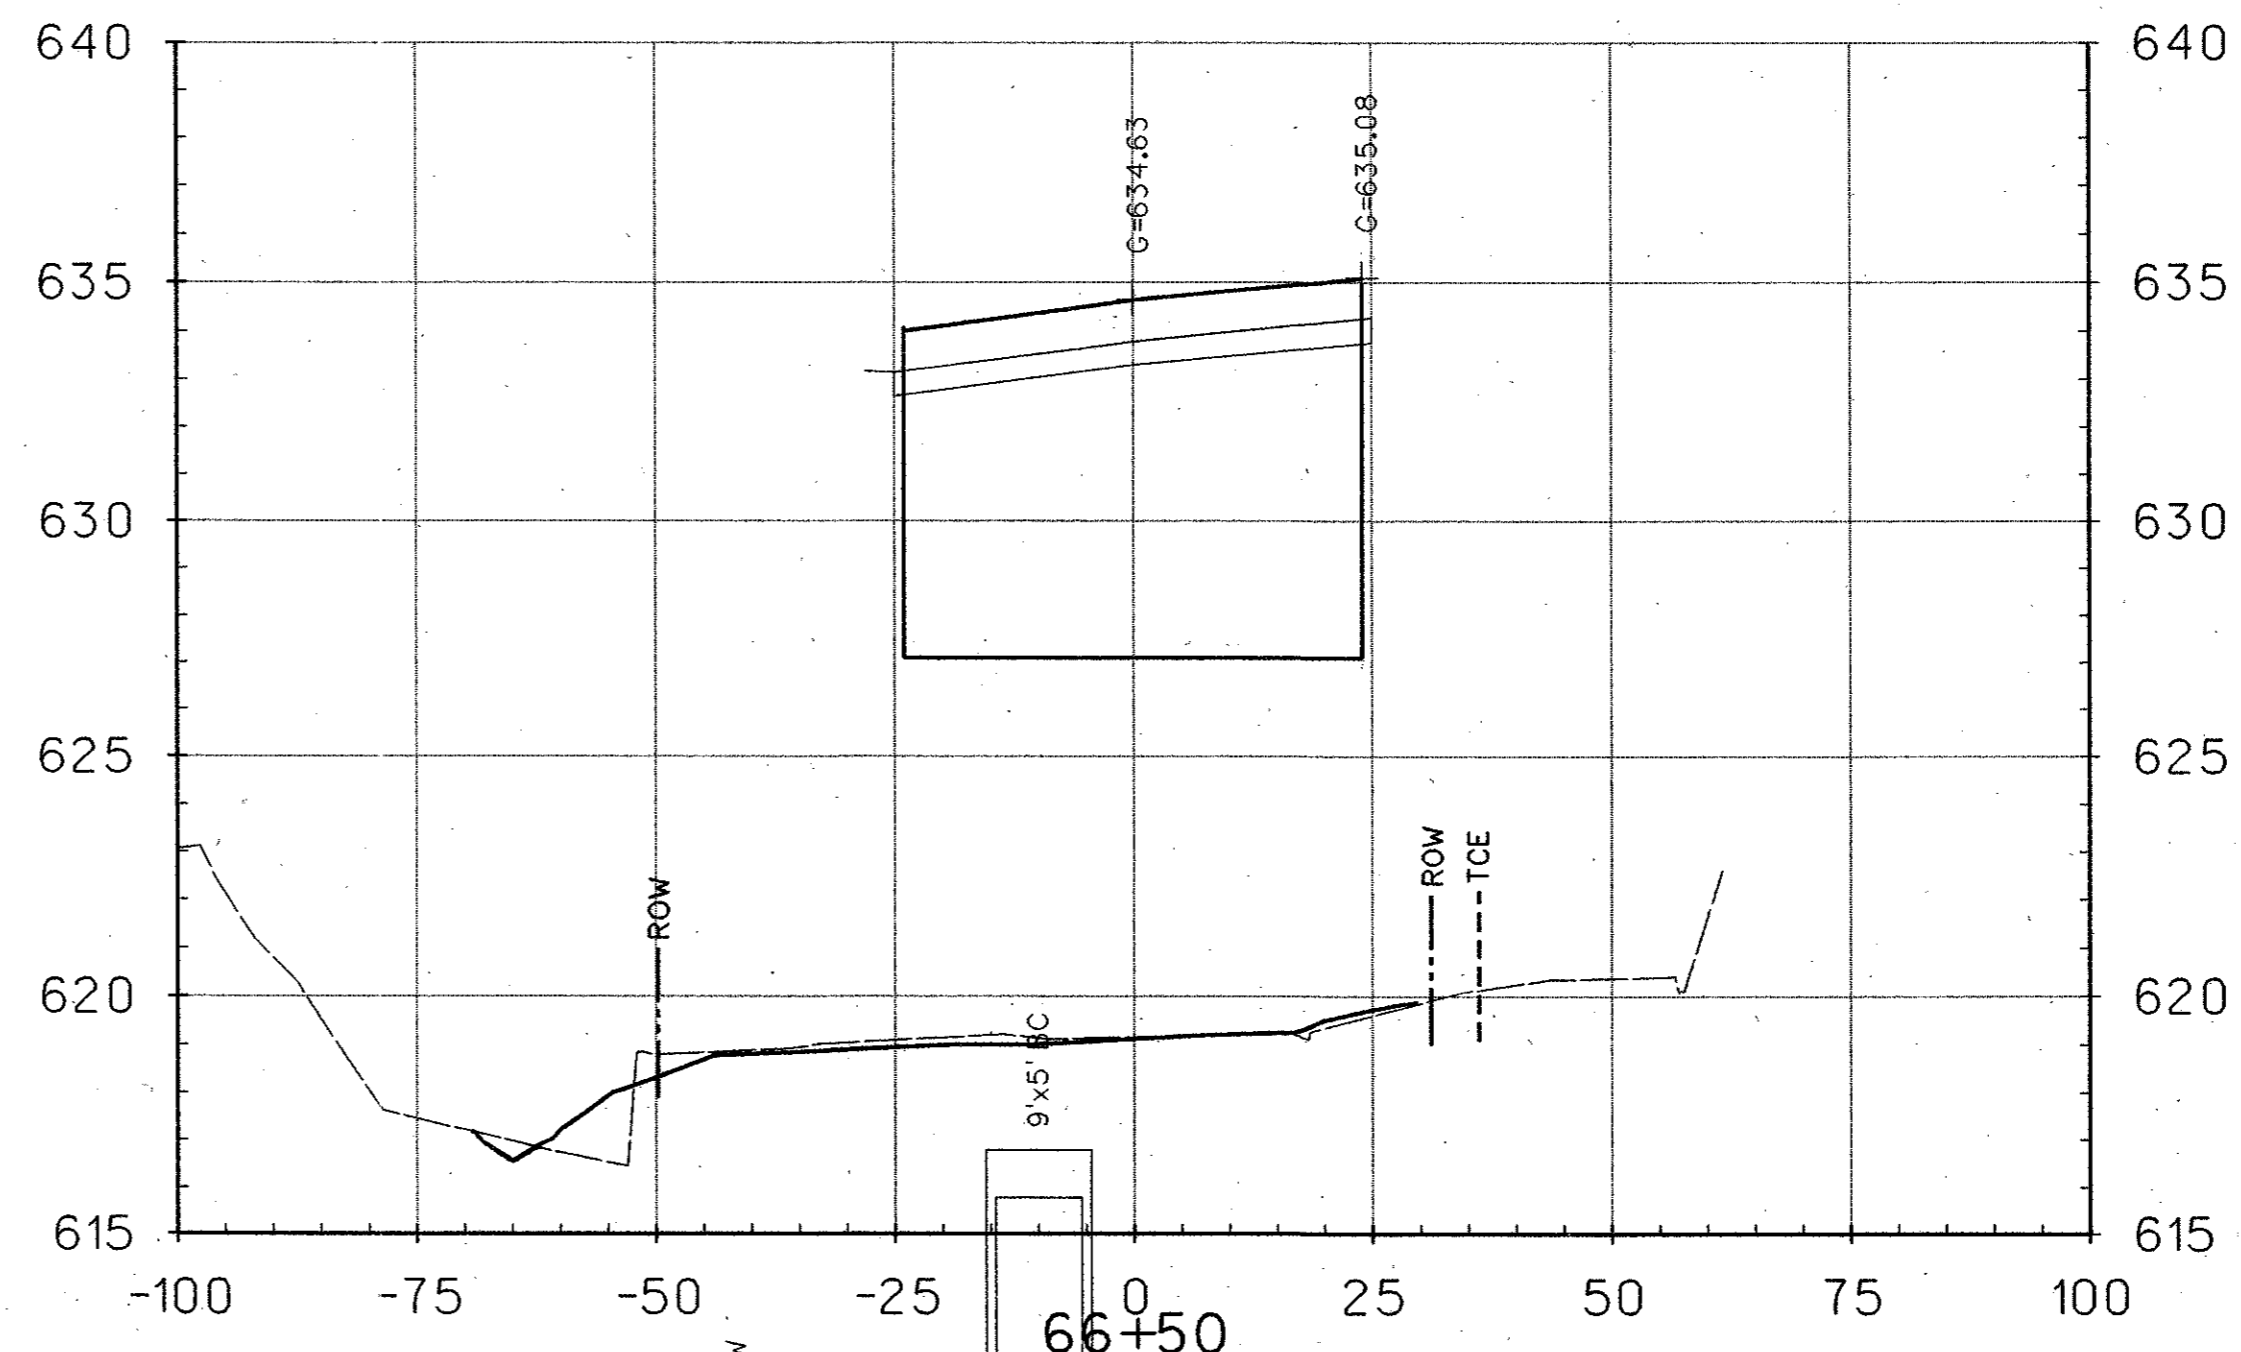
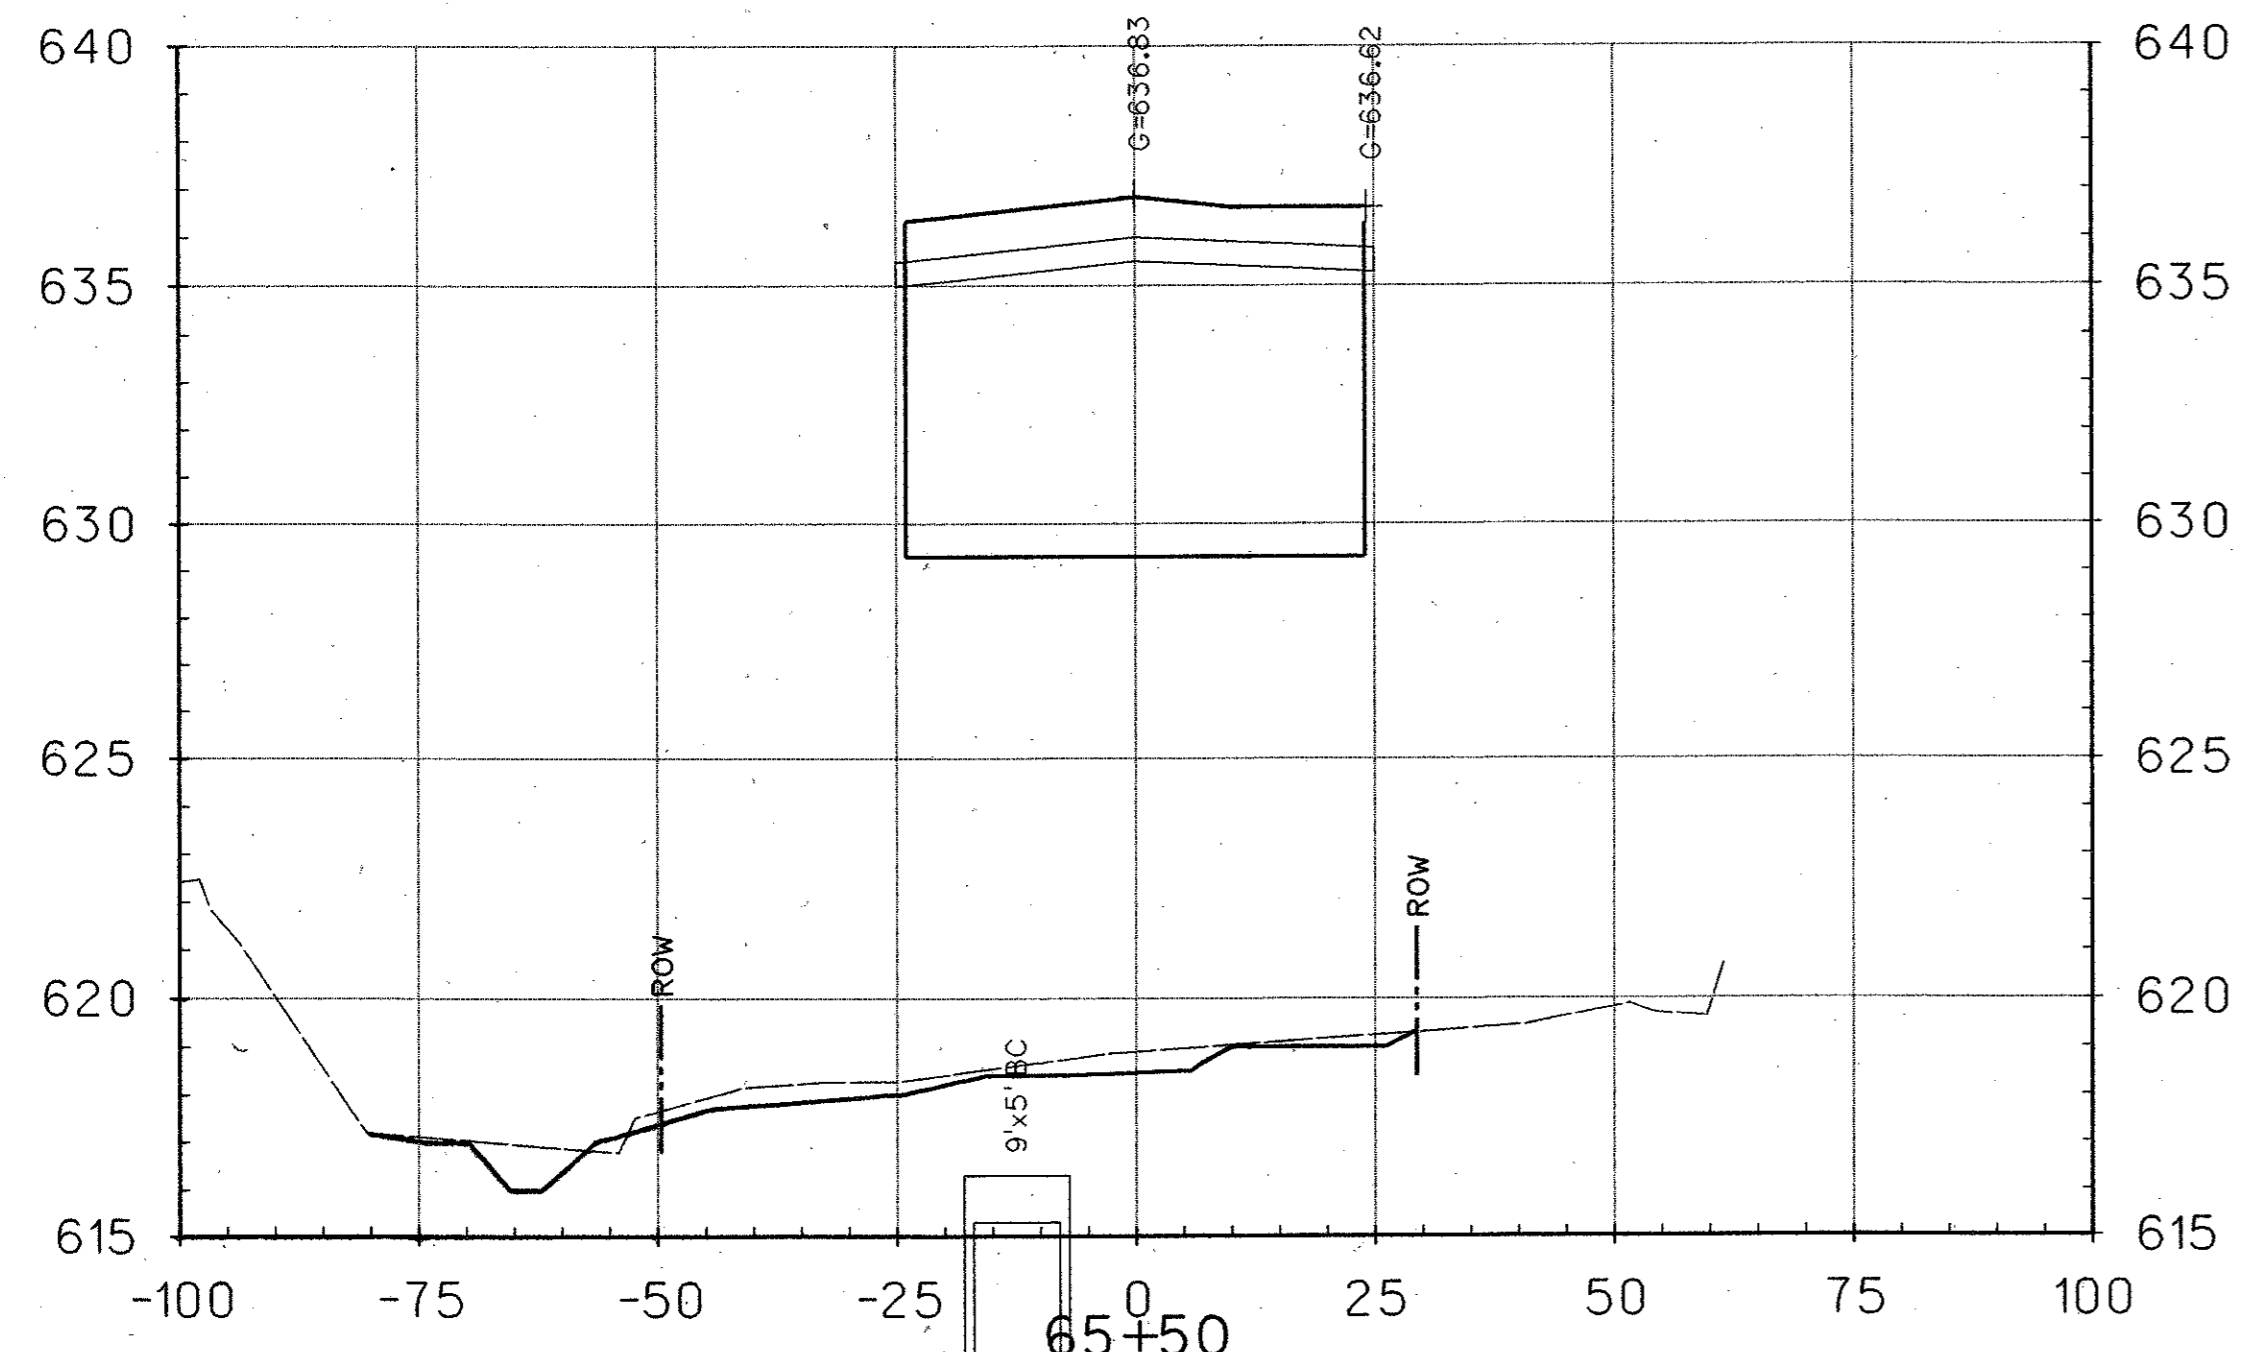


26-JUL-2004 16:34
G:\25768-ph3\m\cads\cr3\xs21.dgn

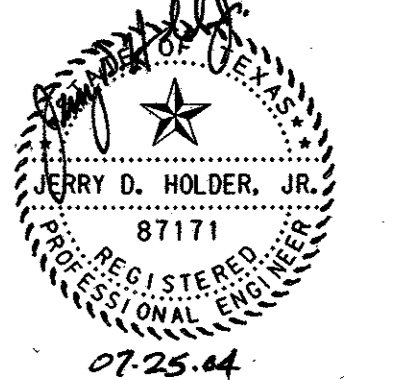

LEGEND

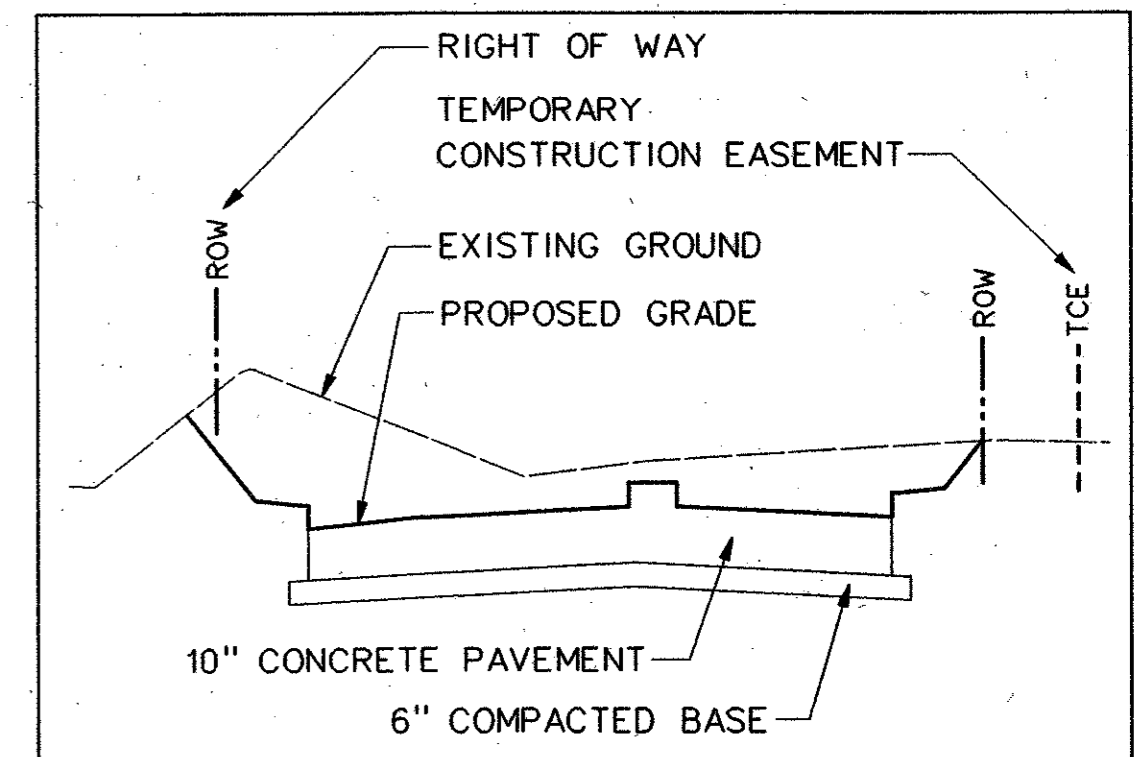

				144
NO.	DATE	REVISION	APPROV.	
HNTB ARCHITECTS ENGINEERS PLANNERS <i>The HNTB Company</i>				
ARAPAHO ROAD - PHASE III				
SURVEYOR BOULEVARD TO ADDISON ROAD				
CROSS SECTIONS				
SHEET 21 OF 29				
TOWN OF ADDISON, TEXAS				
Design JSN	Drawn GFS	DATE	SCALE	PROJECT NO. SHEET NO.
Check JDH	Check JSN	APRIL 04	1" = 20' H 1" = 4' V	25768 XS-21