
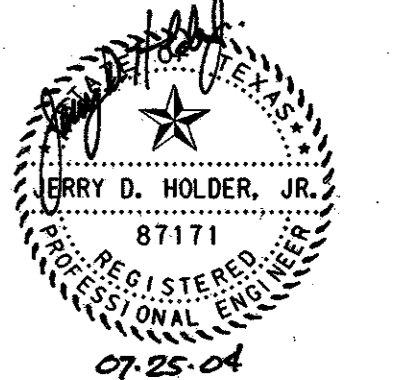
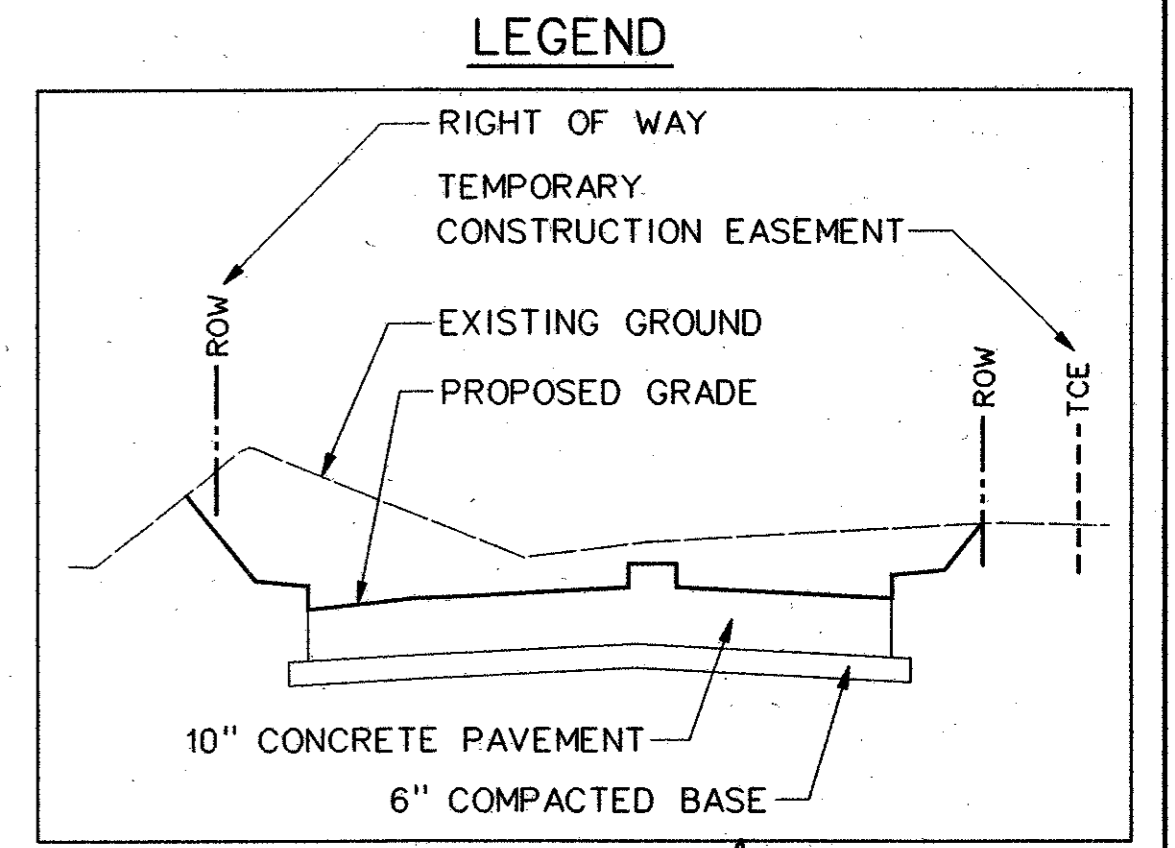
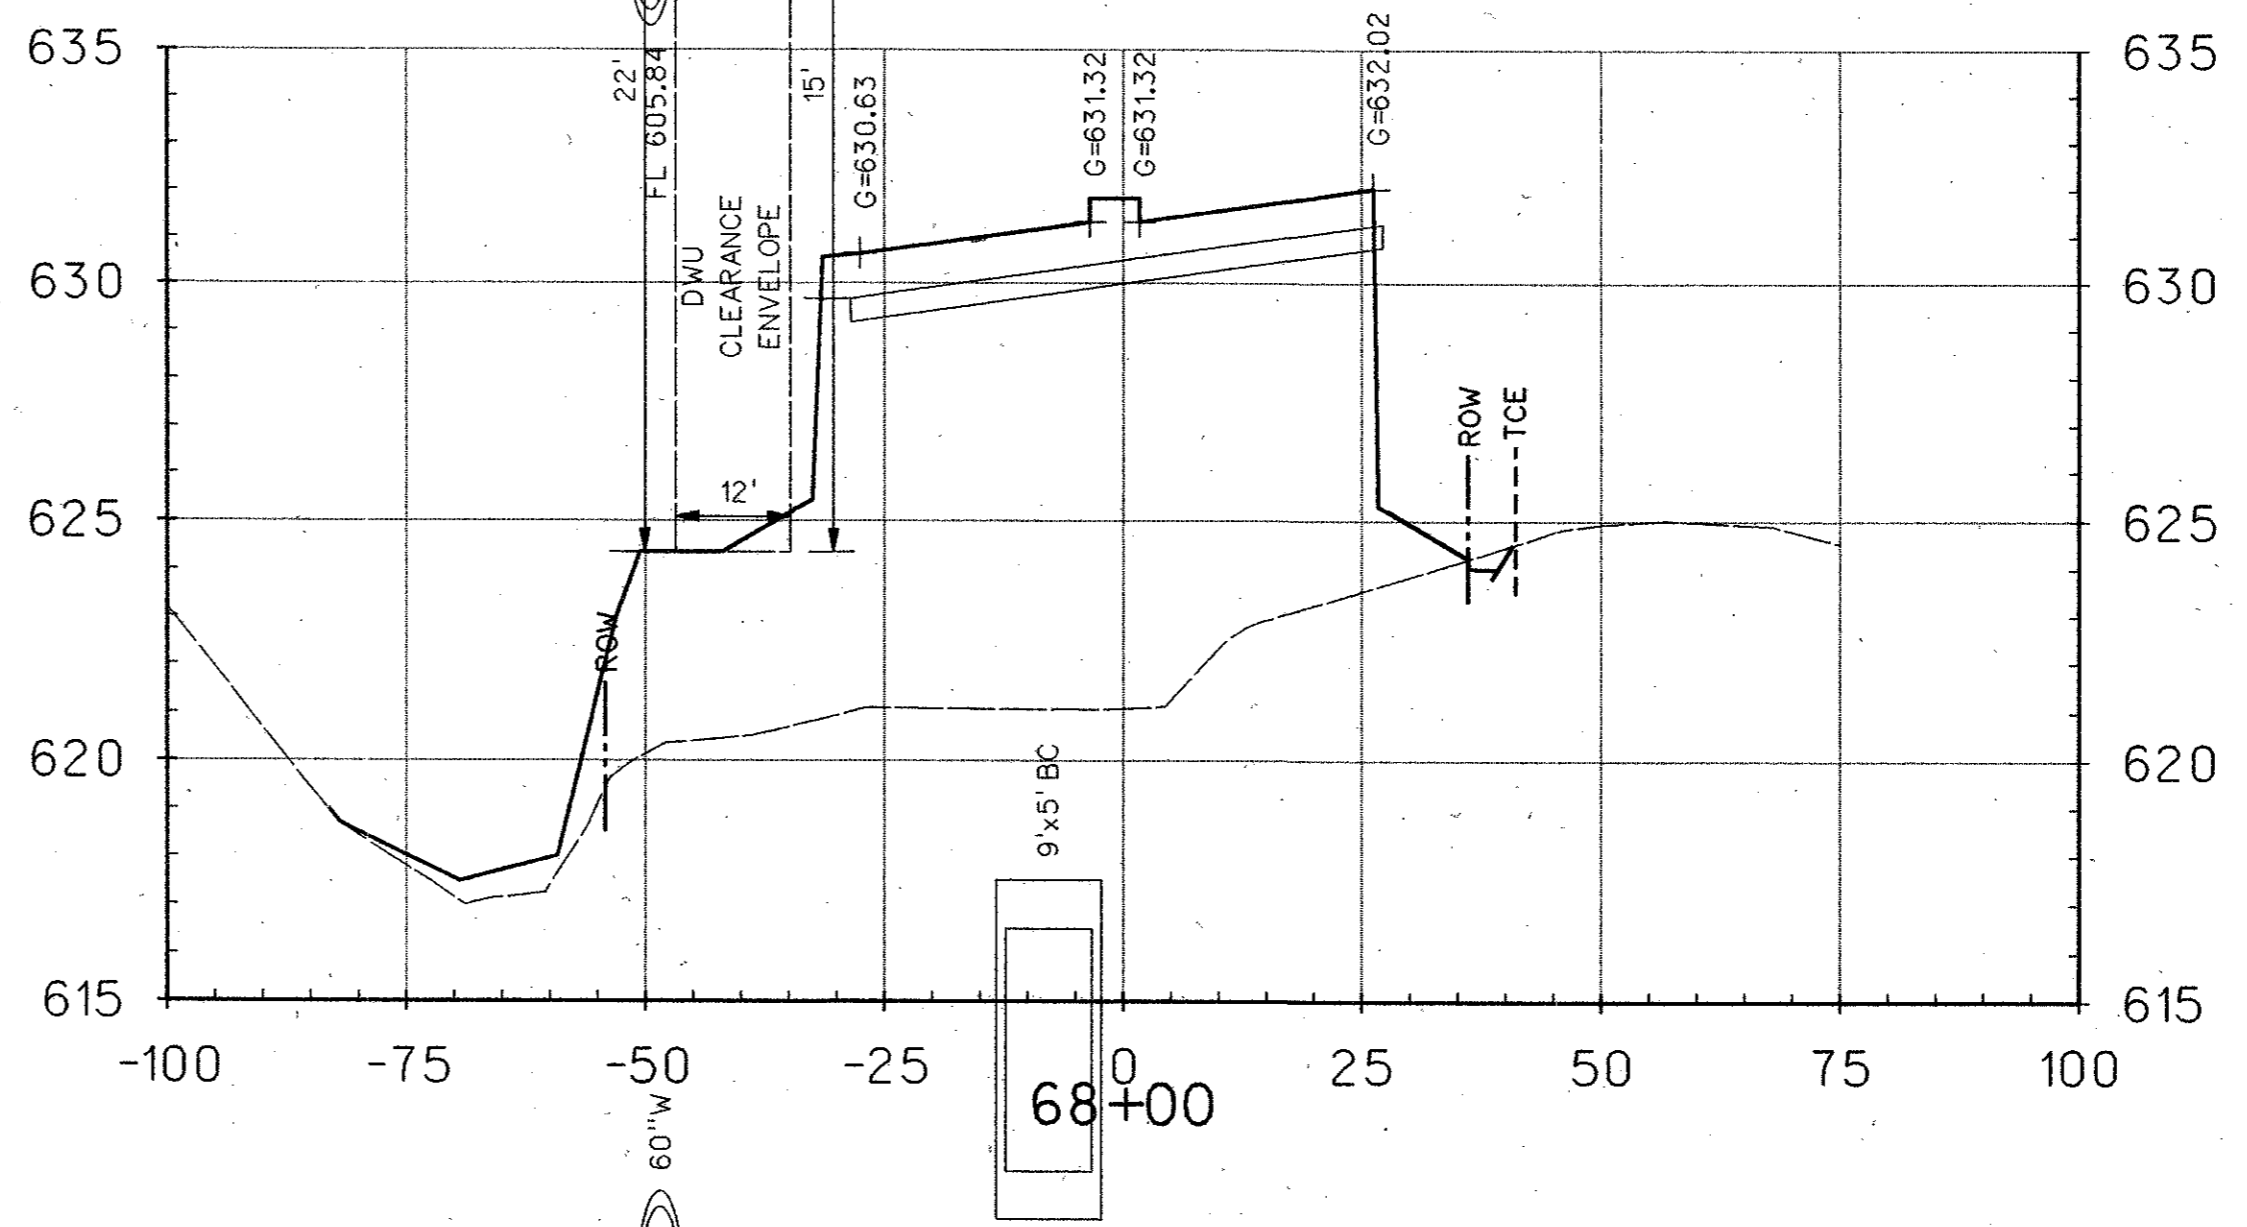
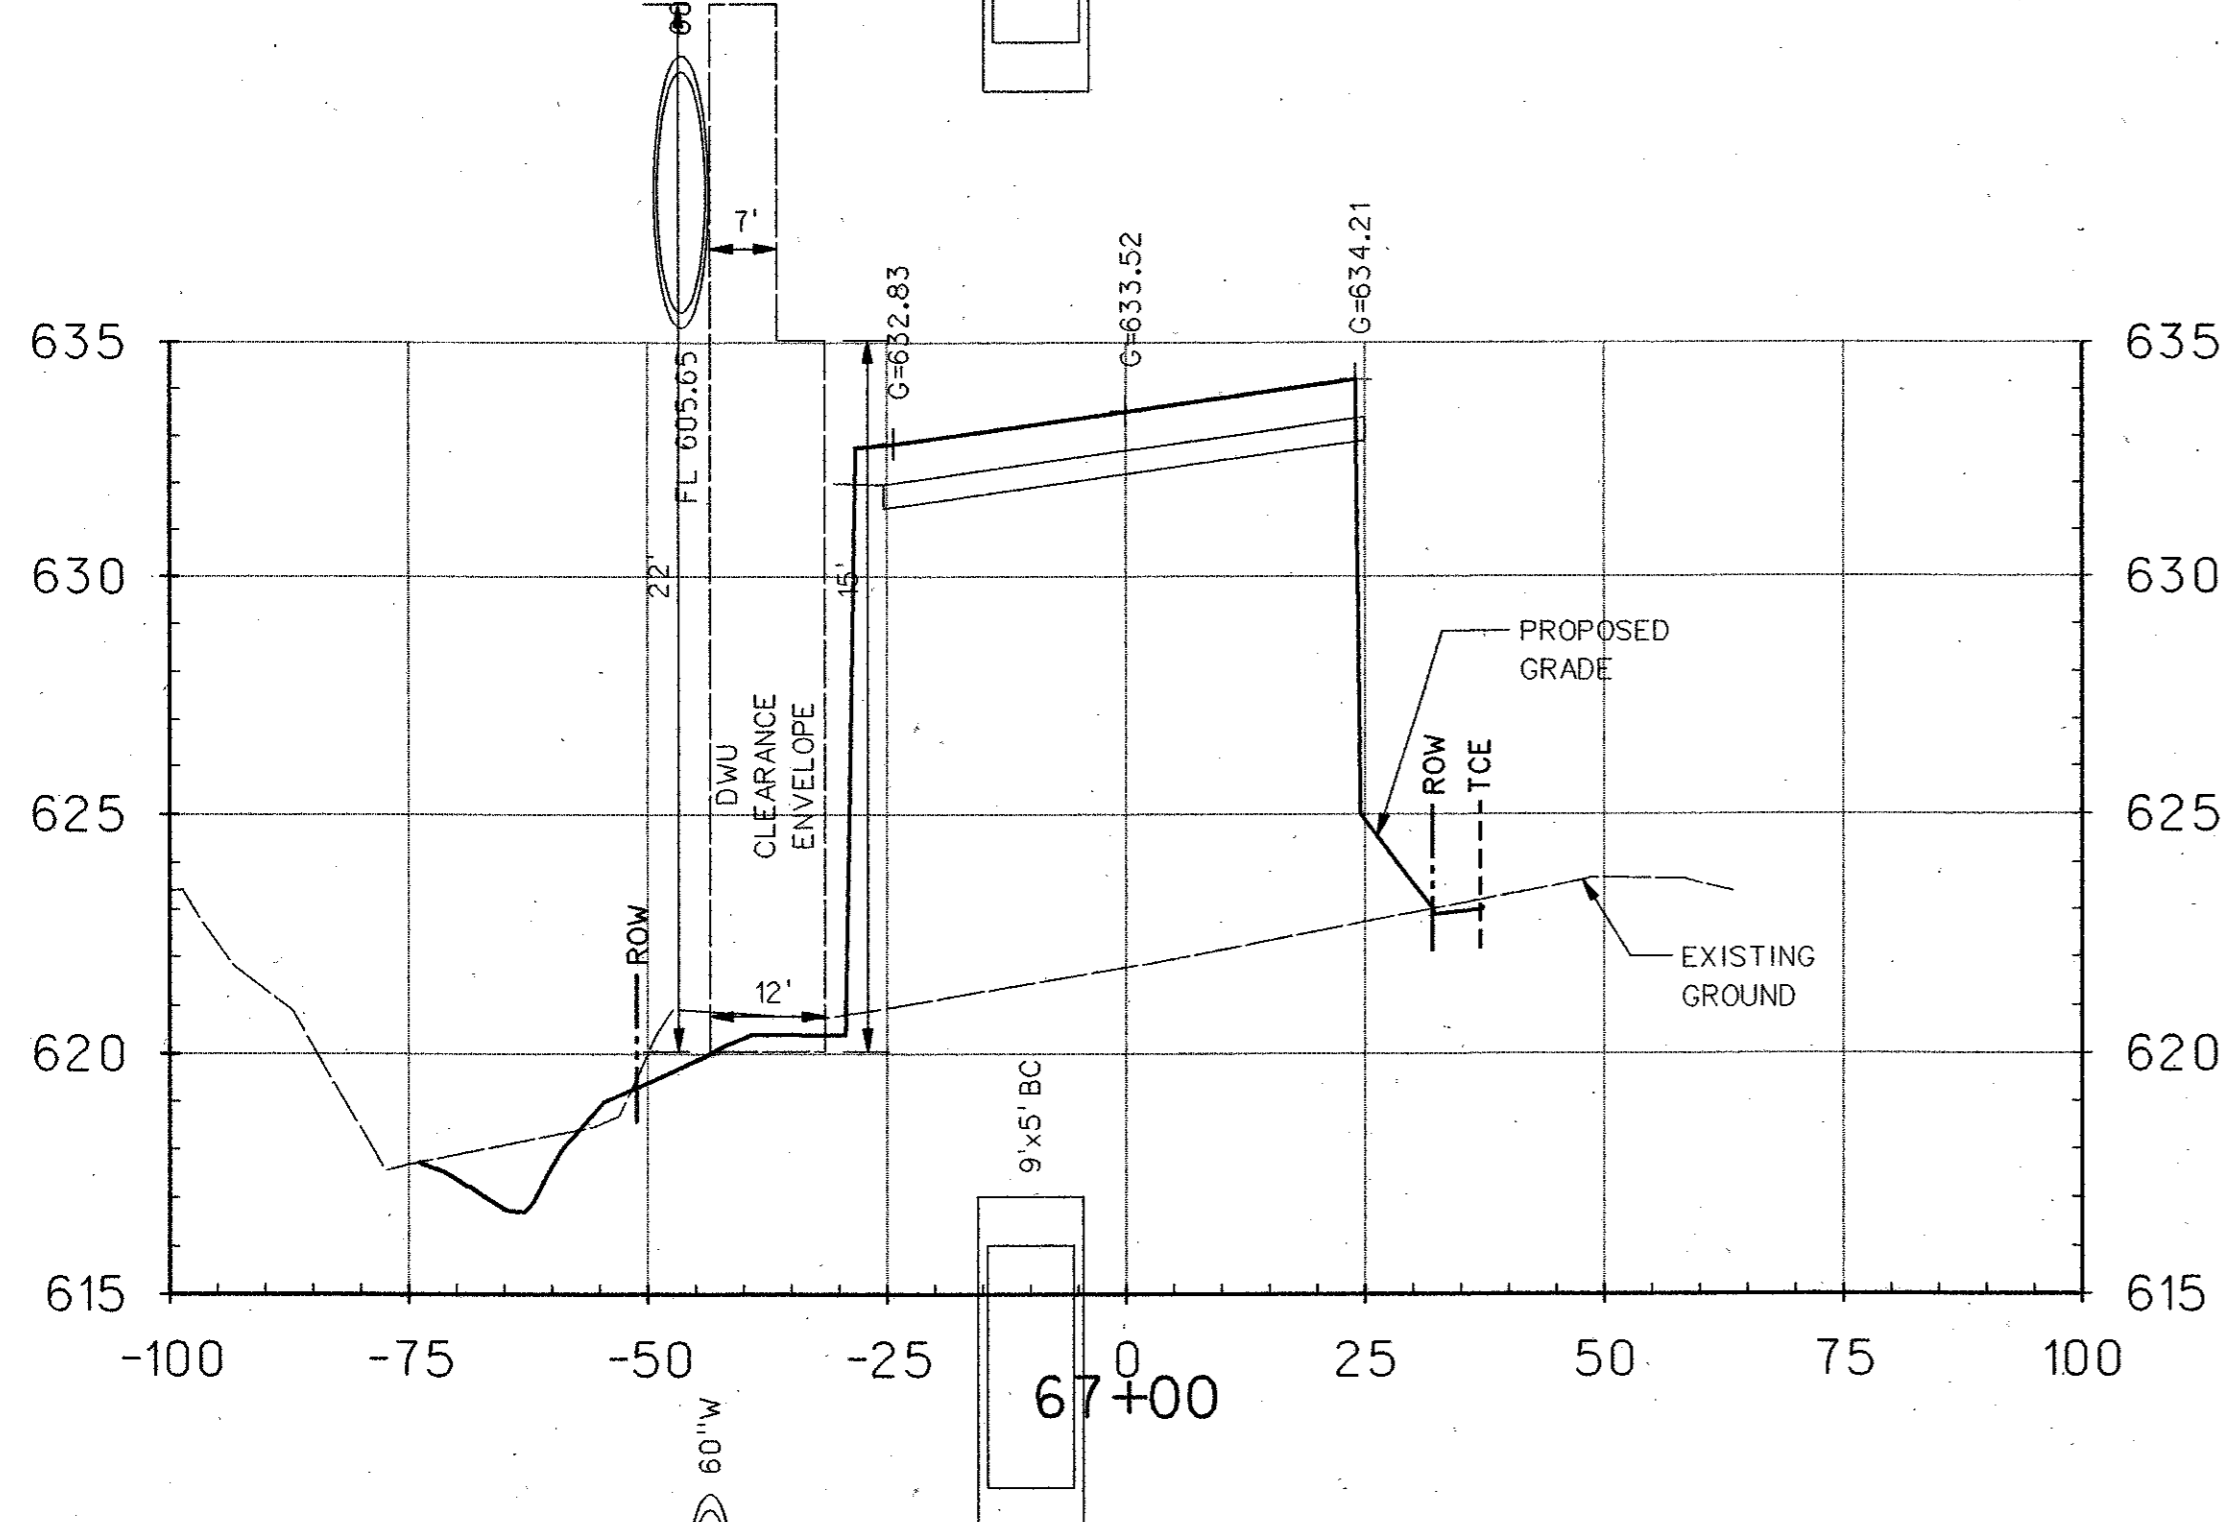
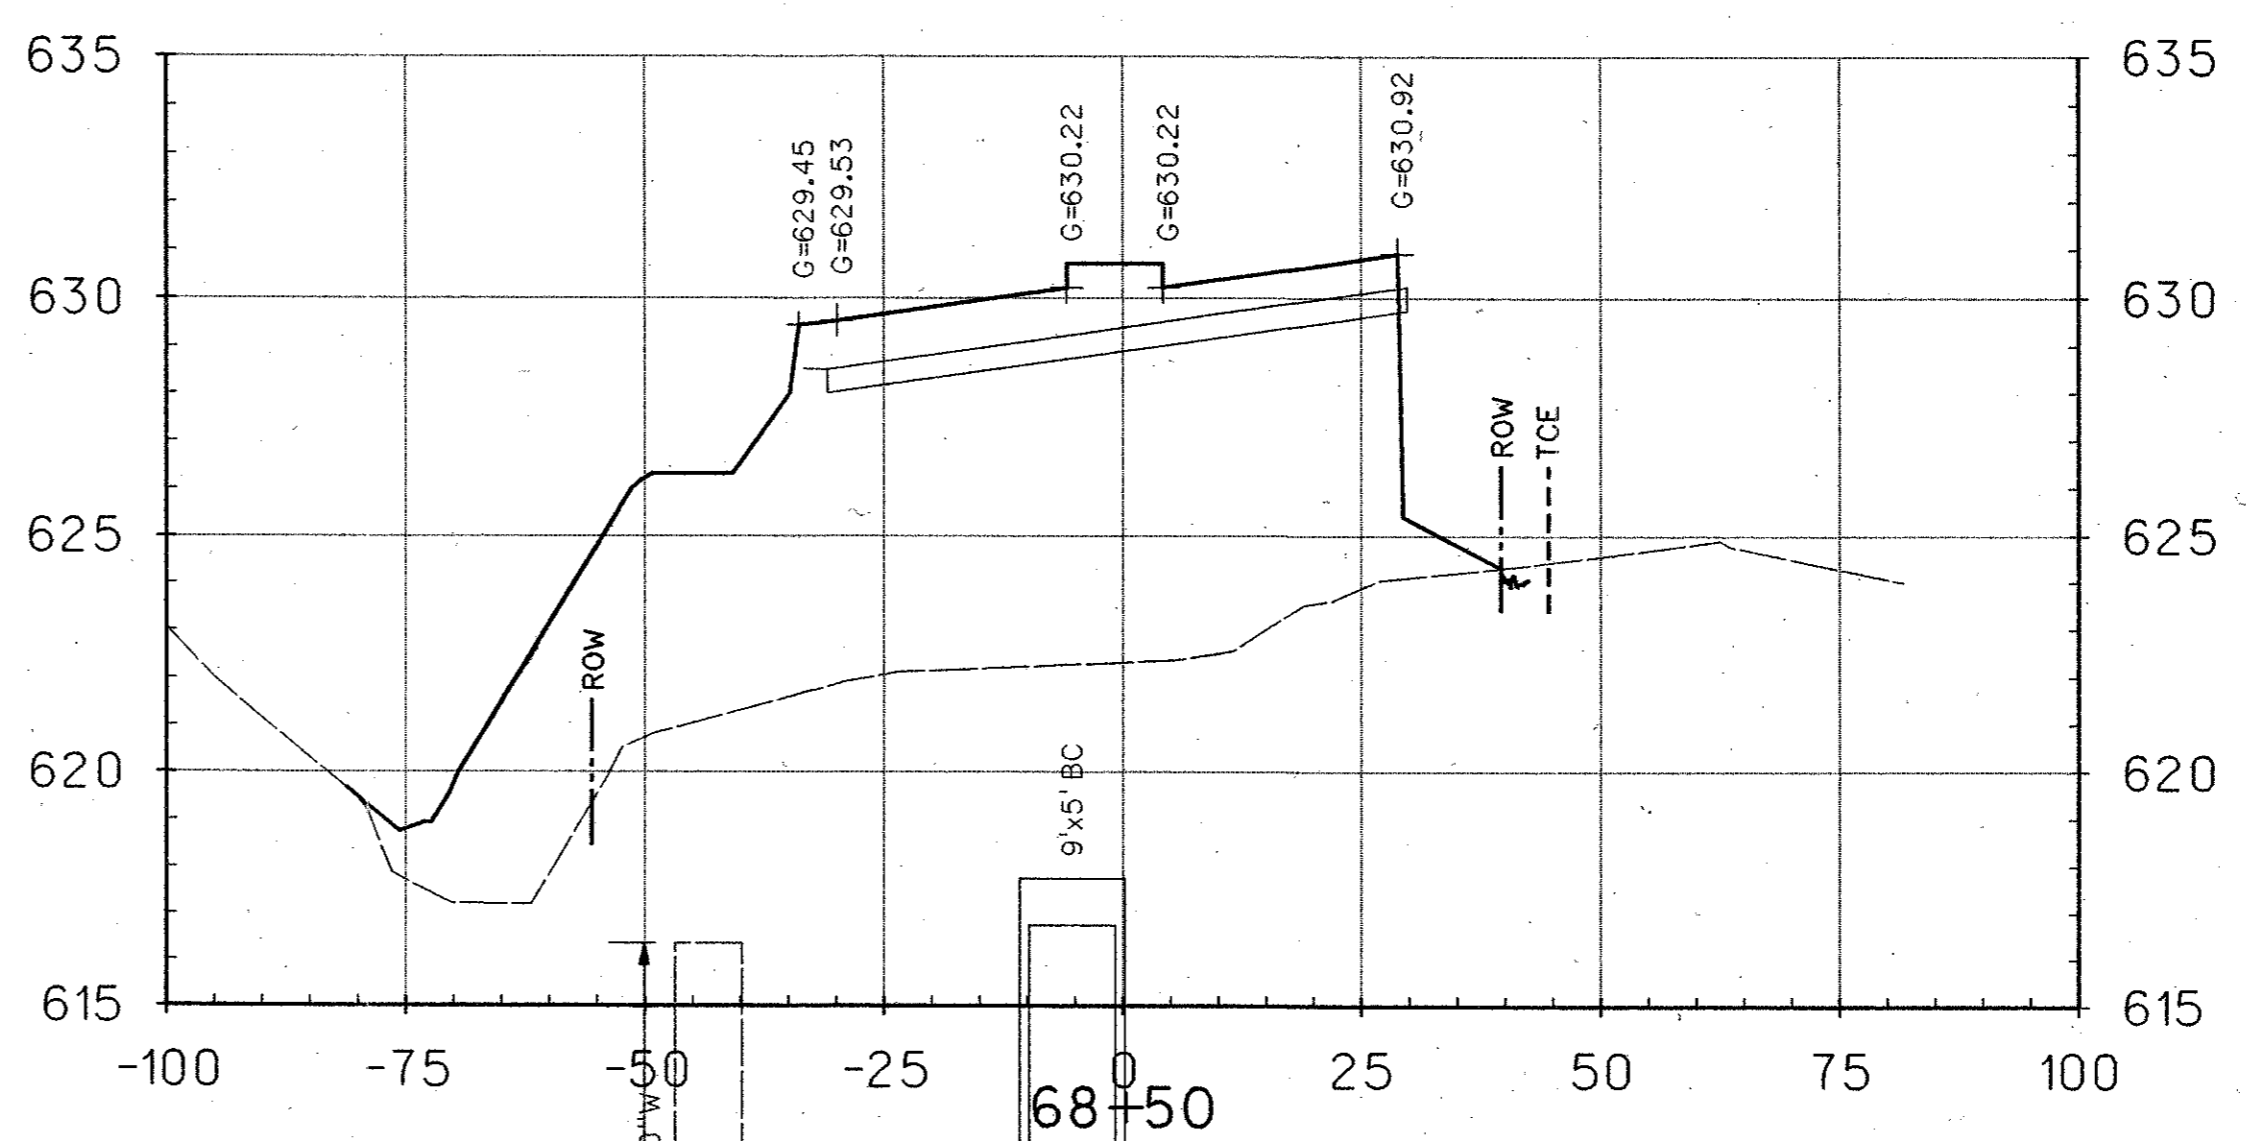


26-JUL-2004 16:34
G:\25766\PH3\1\1\Gds\3\3s22.dgn

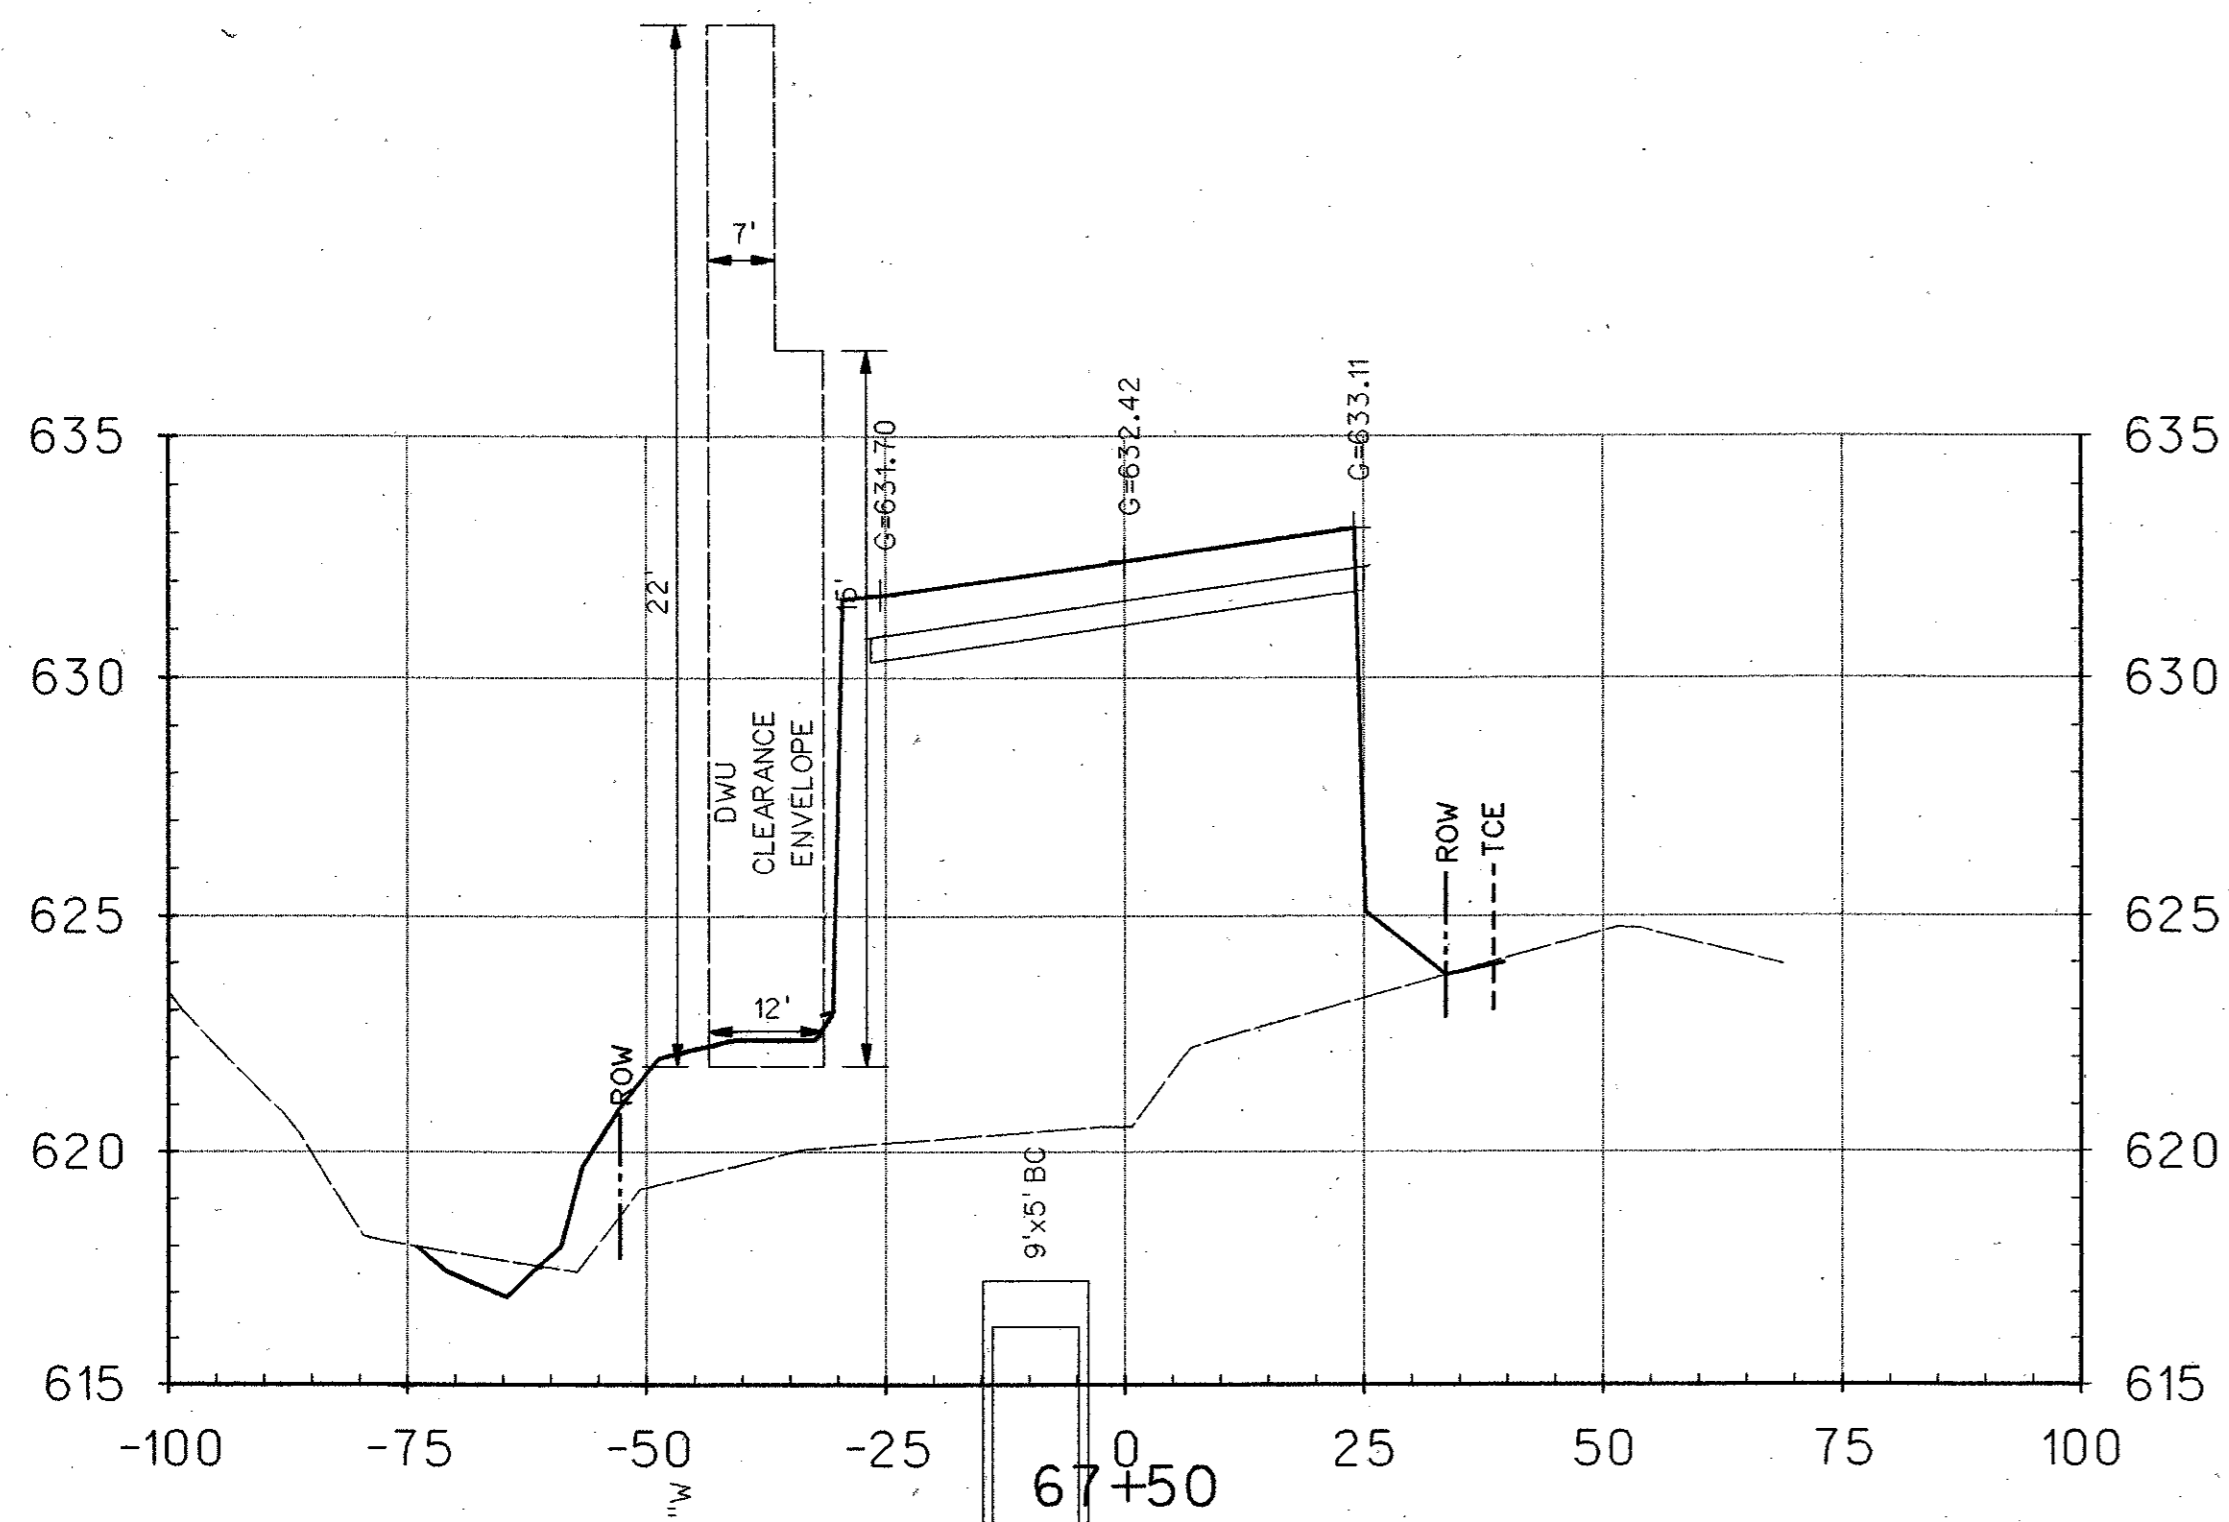

				145
NO.	DATE	REVISION	APPROV.	
HNTB ARCHITECTS ENGINEERS PLANNERS The HNTB Companies				
ARAPAHO ROAD - PHASE III				
SURVEYOR BOULEVARD TO ADDISON ROAD				
CROSS SECTIONS				
SHEET 22 OF 29				
TOWN OF ADDISON, TEXAS				
Design	JSN	Drawn	GFS	DATE
Check	JDH	Check	JSN	APRIL 04
SCALE	PROJECT NO.		SHEET NO.	
1" = 20' H 1" = 4' V	25768		XS-22	