
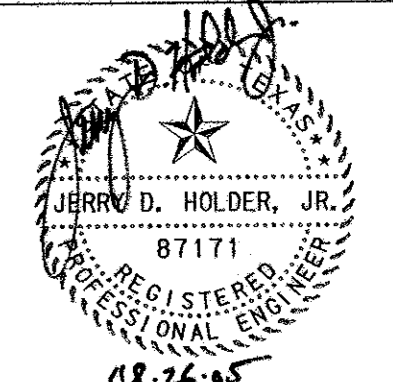
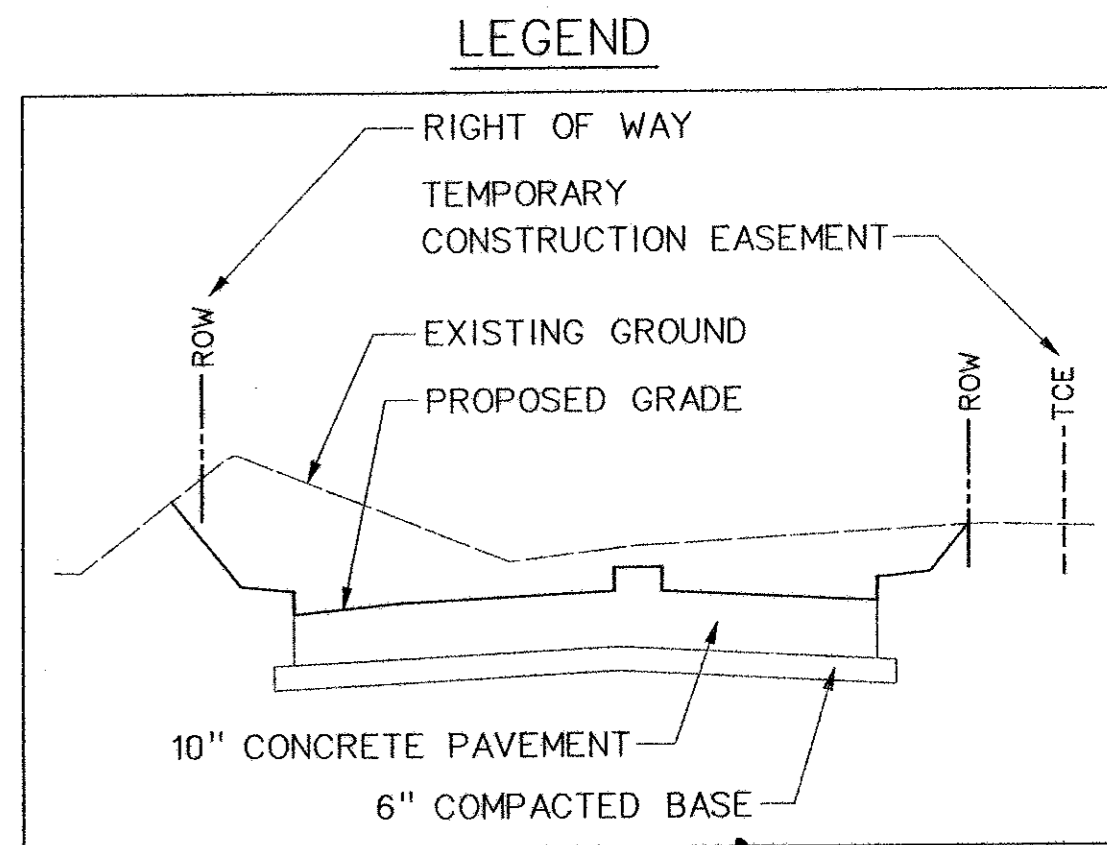
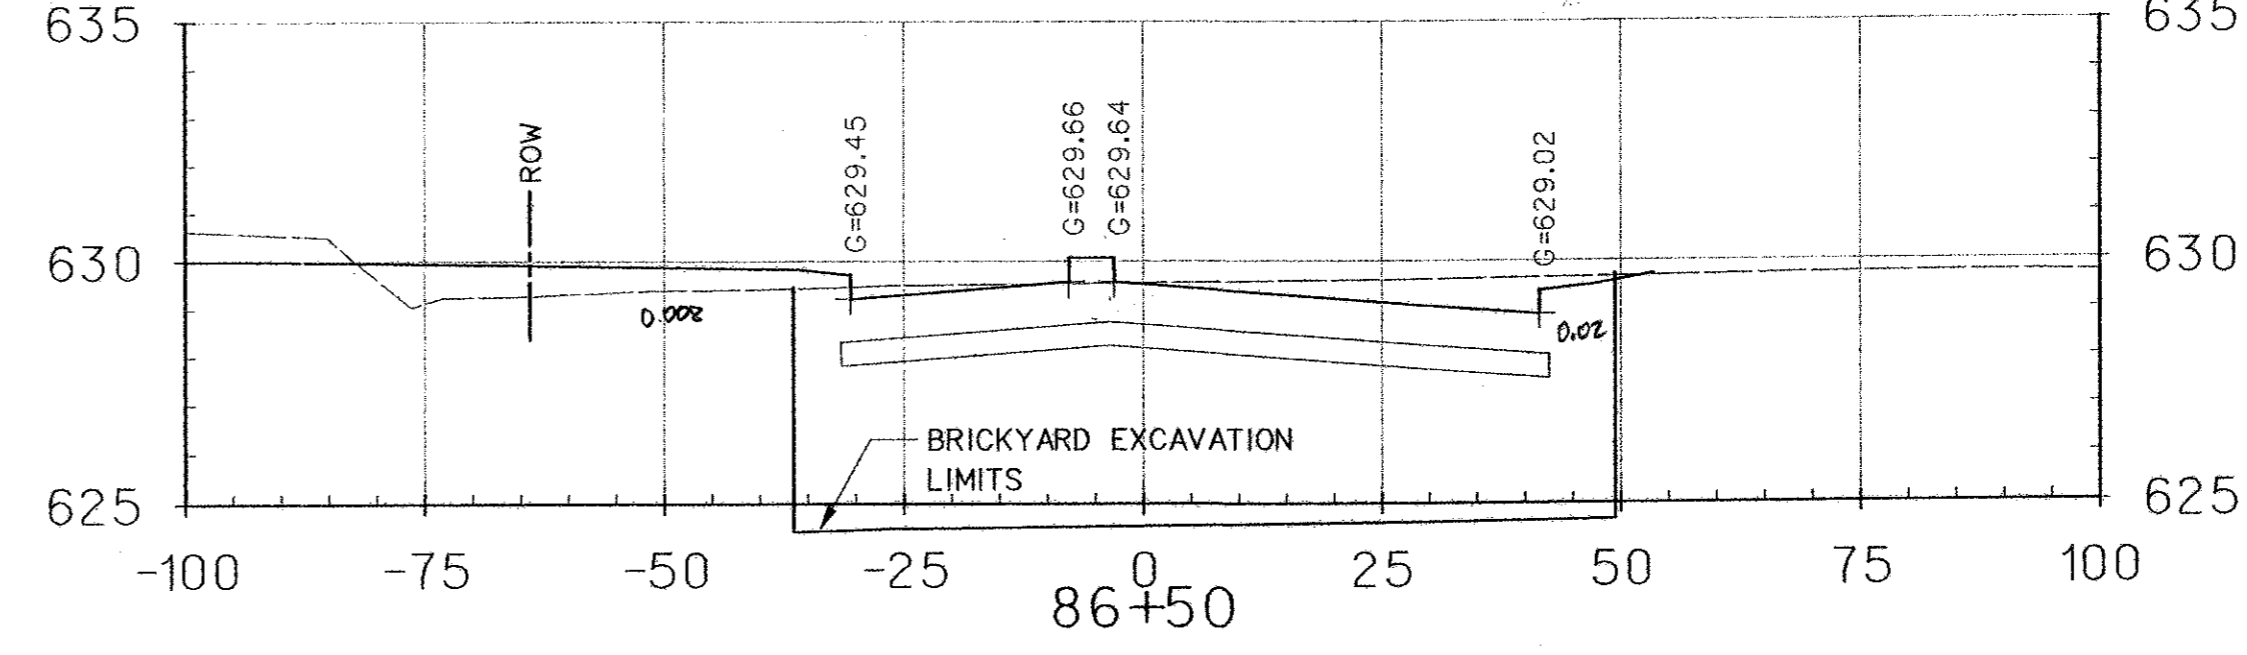
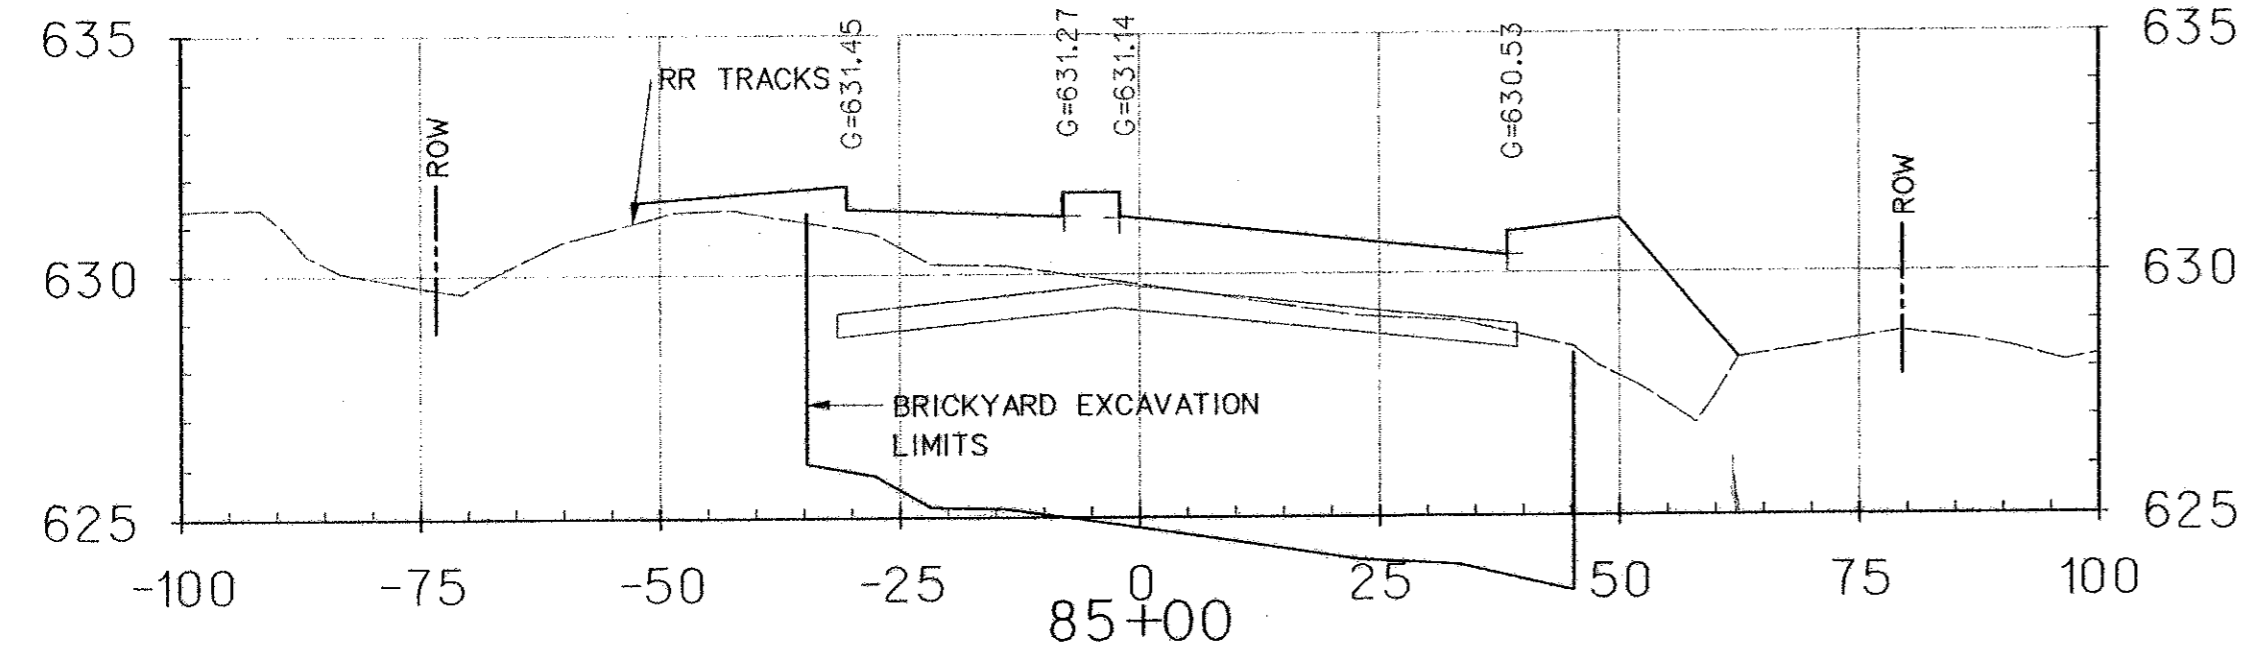
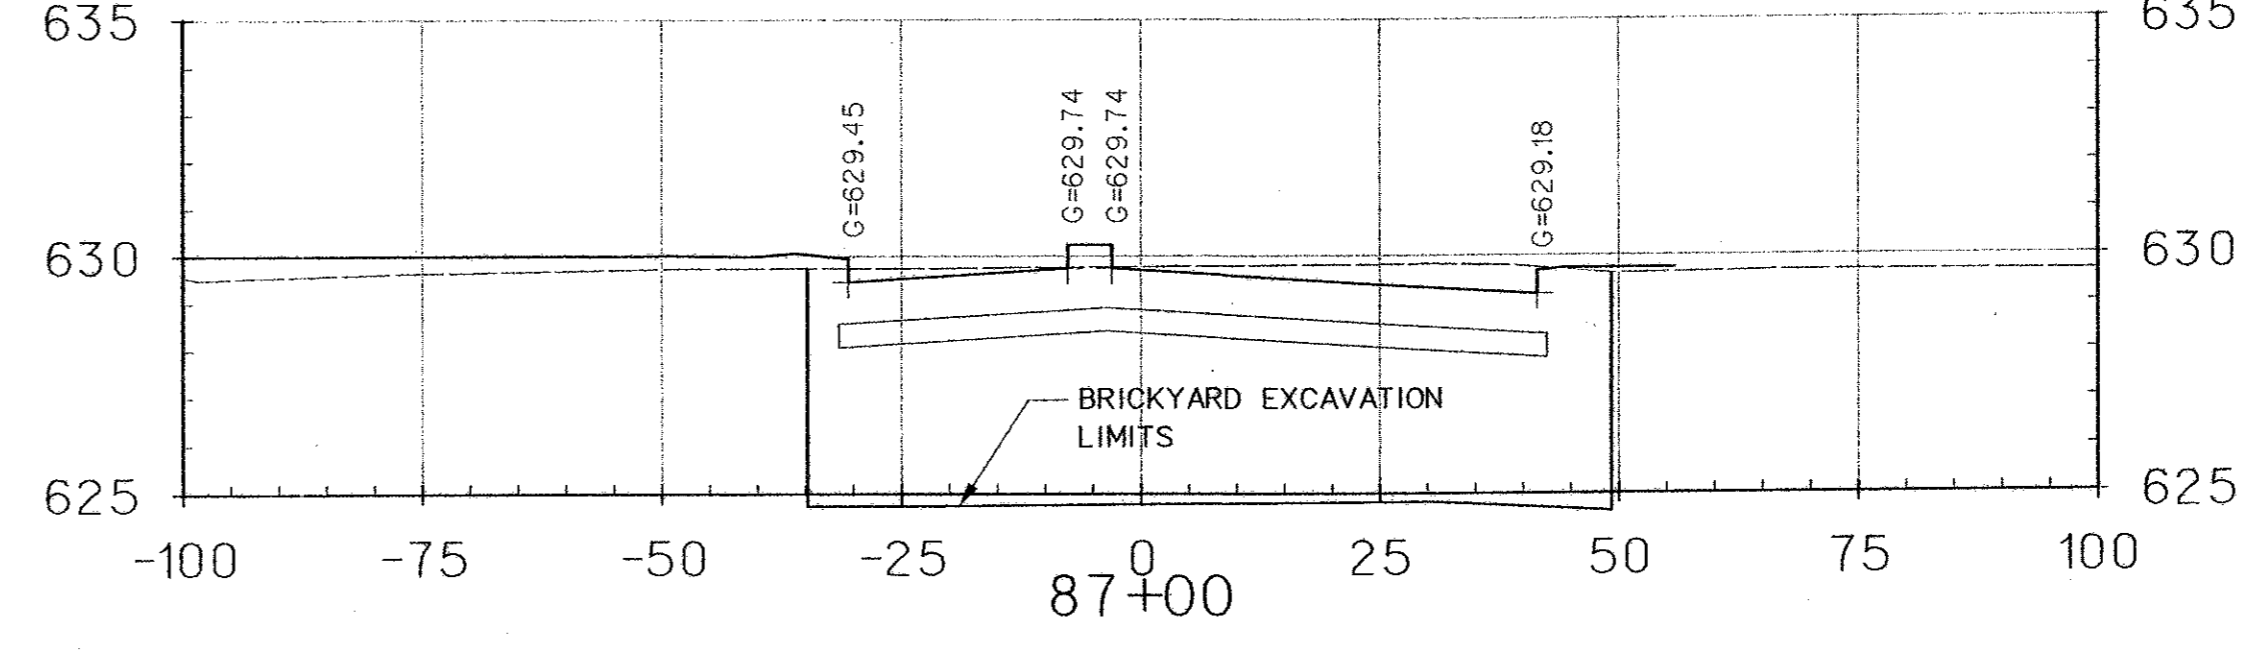
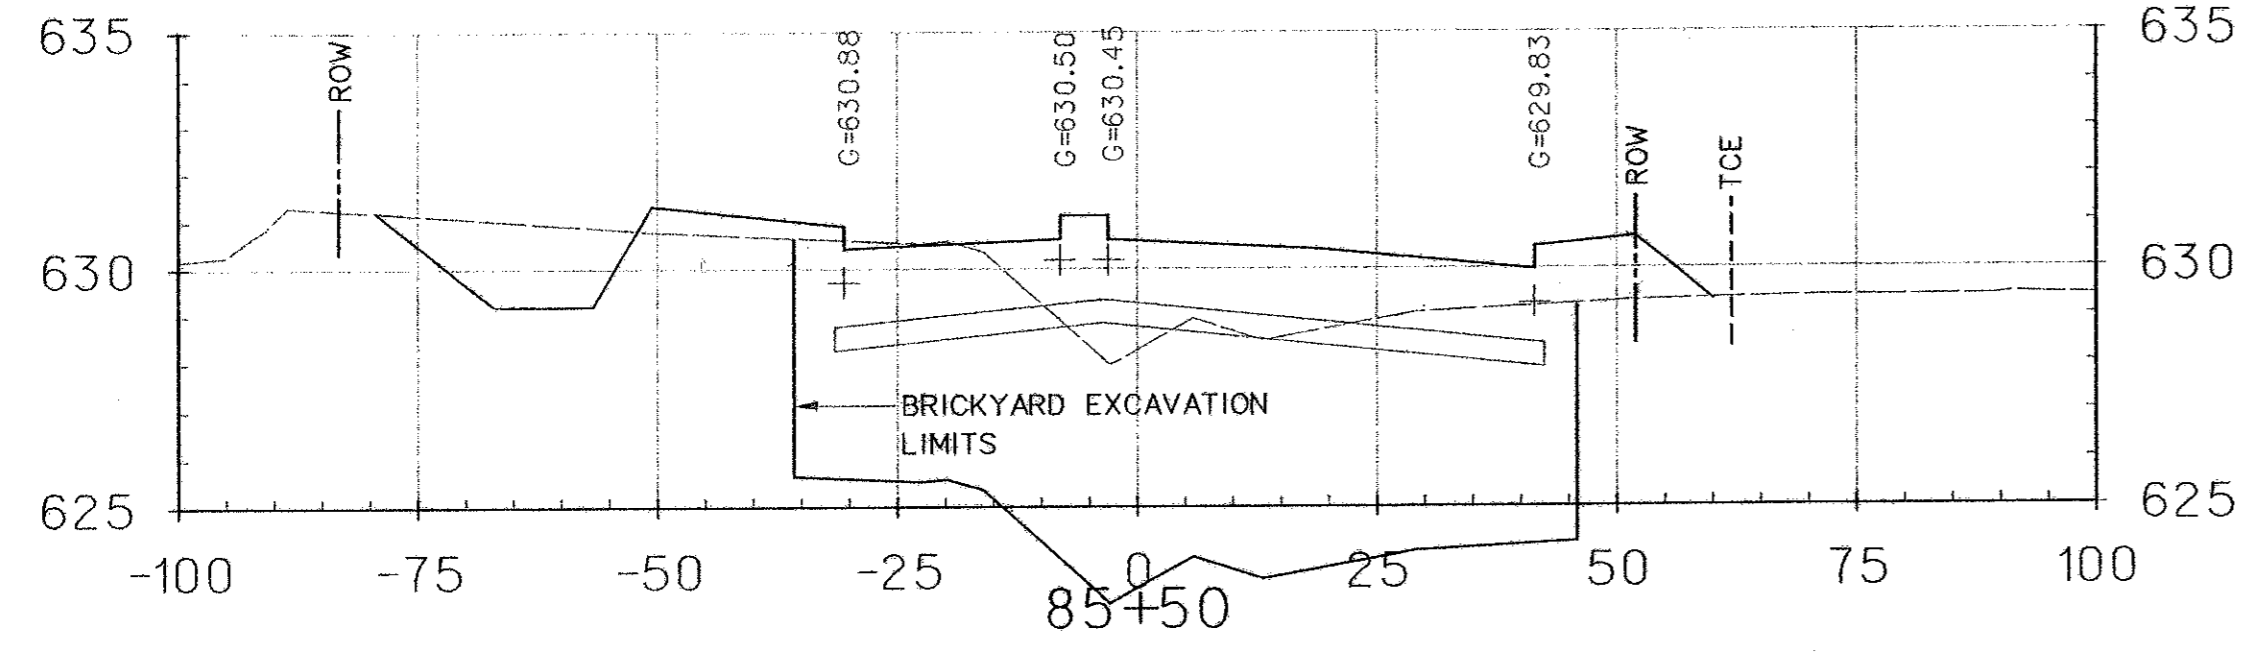
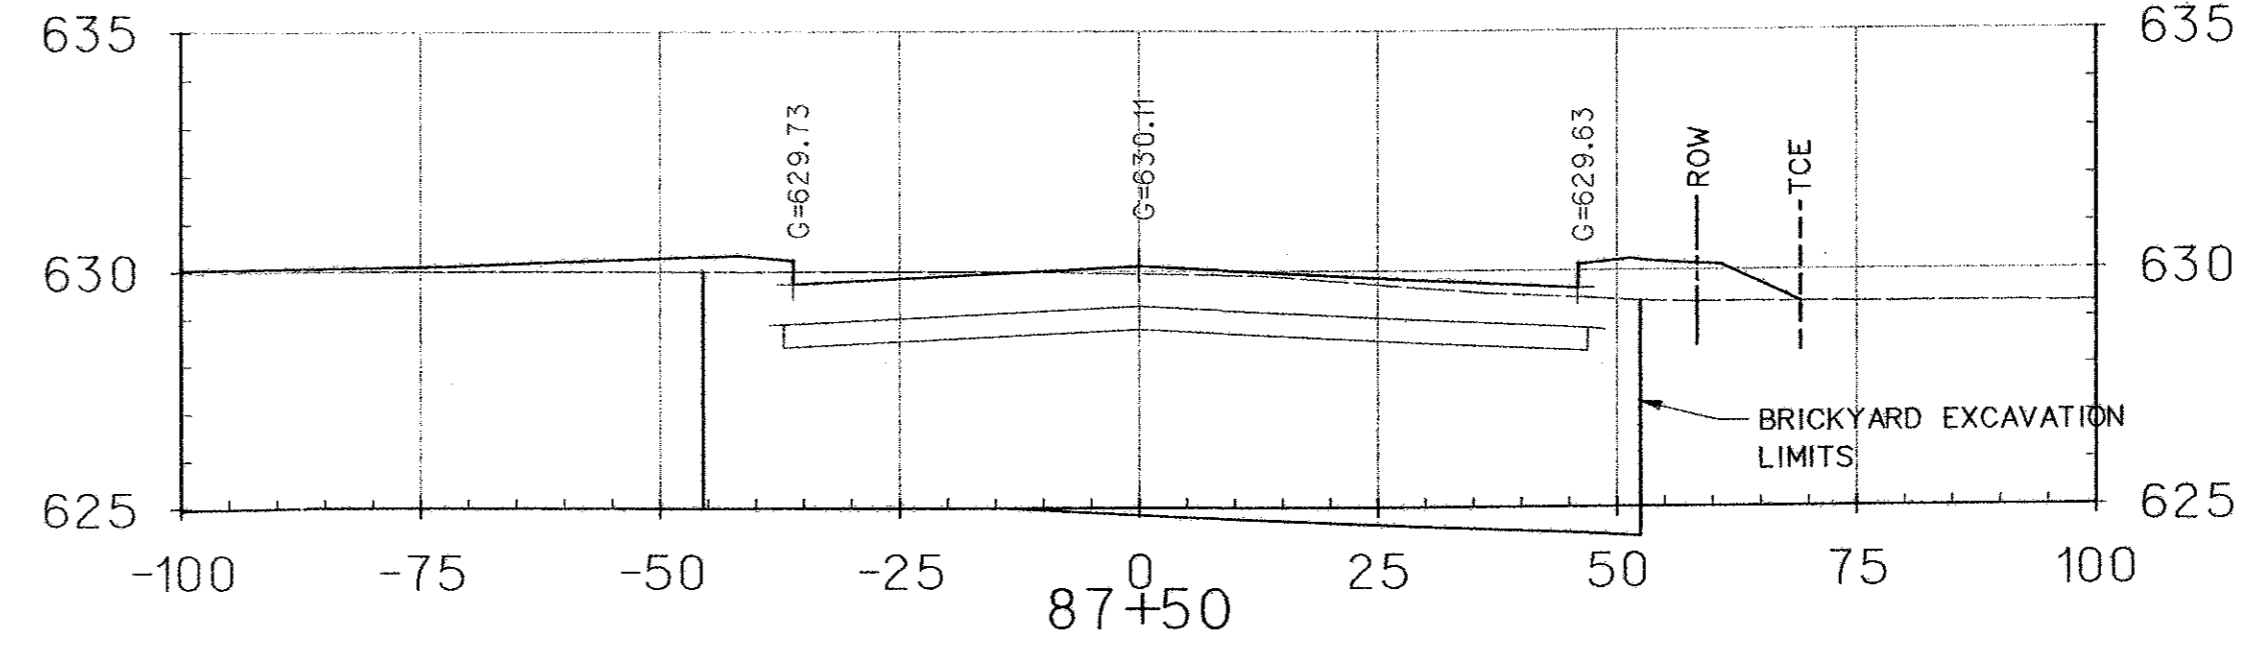


26-AUG-2005 15:56
G:\25768-ph3\h1\cds\or3xs28.dgn

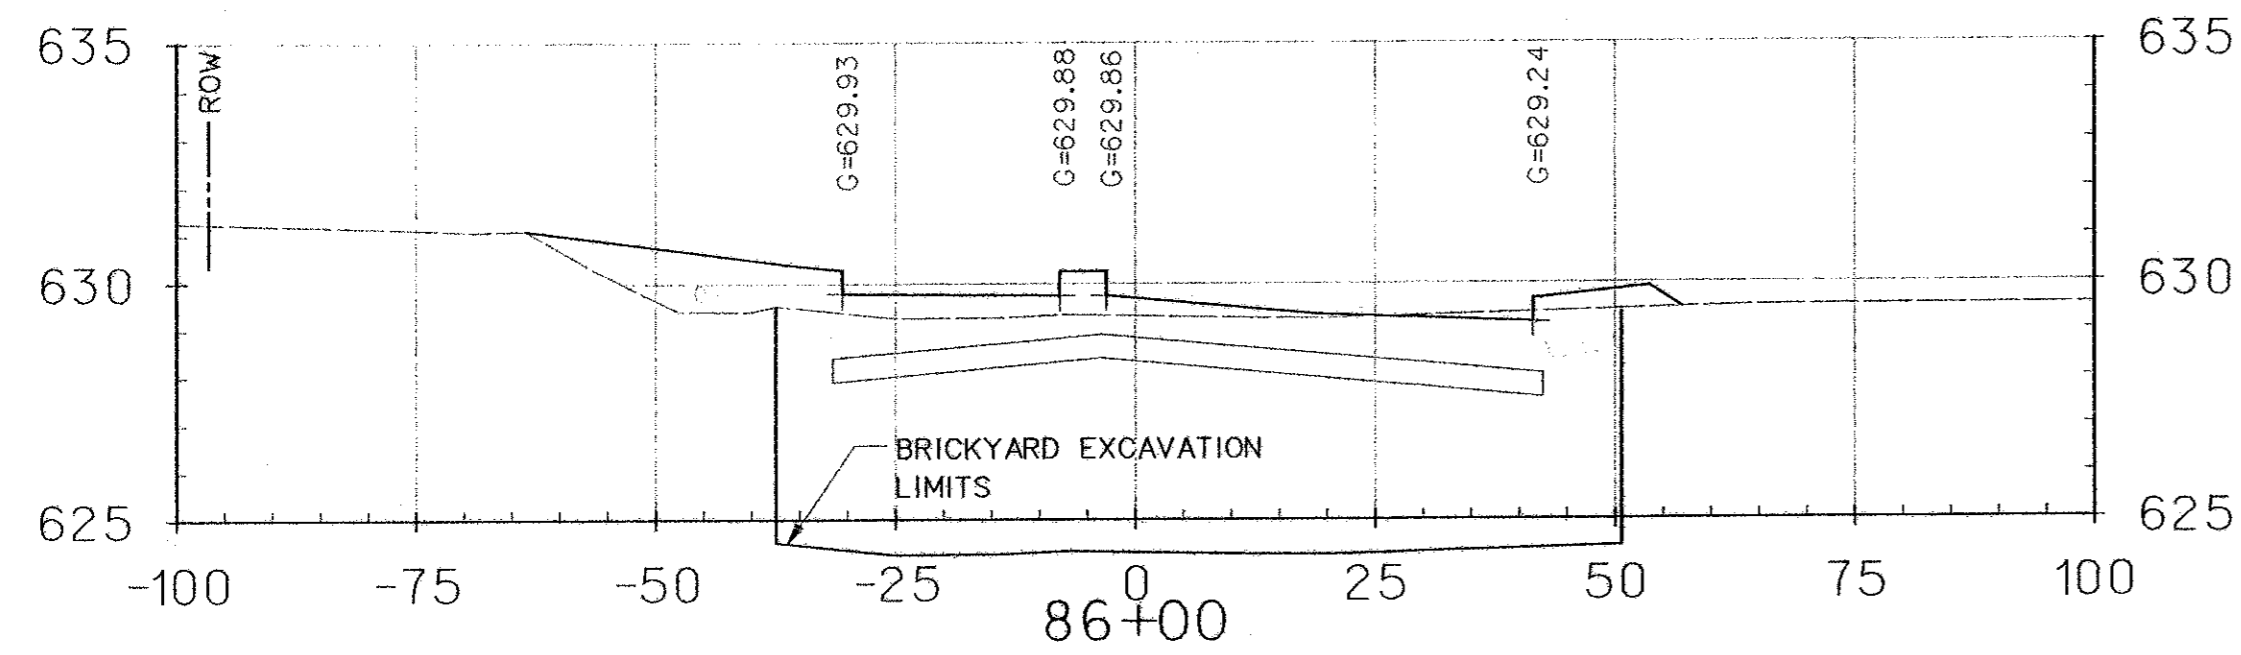

NO.	DATE	REVISION	APPROV.
5	6/3/04	REISSUE SHEET	JSN
6	8/22/05	REVISED CROSS SECTIONS	JDH

151

HNTB ARCHITECTS ENGINEERS PLANNERS
The HNTB Companies

ARAPAHO ROAD - PHASE III
SURVEYOR BOULEVARD TO ADDISON ROAD

CROSS SECTIONS
SHEET 28 OF 29

TOWN OF ADDISON, TEXAS

Design	JSN	Drawn	GFS	DATE	SCALE	PROJECT NO.	SHEET NO.
Check	JDH	Check	JSN	APRIL 04	1" = 20'H 1" = 4' V	25768	XS-28