
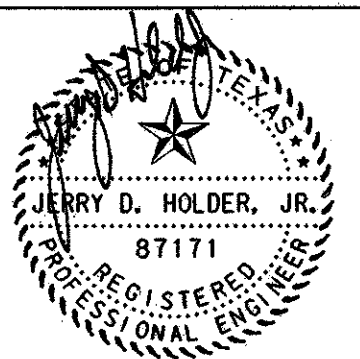


26-JUL-2004 16:37
G:\25768-PH3\H1\Cds\3xs29.dgn

LEGEND

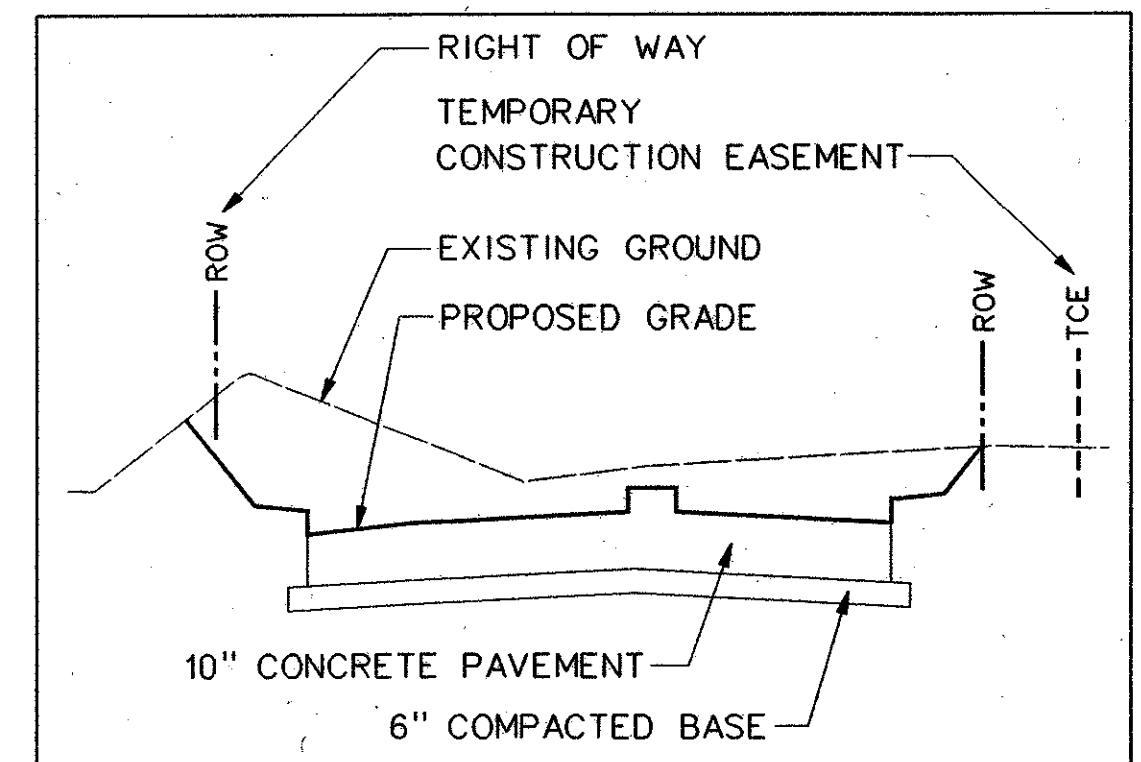

07-25-04

					152
NO.	DATE	REVISION			APPROV.
HNTB ARCHITECTS ENGINEERS PLANNERS <i>The HNTB Companies</i>					
ARAPAHO ROAD - PHASE III					
SURVEYOR BOULEVARD TO ADDISON ROAD					
CROSS SECTIONS					
SHEET 29 OF 29					
TOWN OF ADDISON, TEXAS					
Design JSN	Drawn GFS	DATE	SCALE	PROJECT NO.	SHEET NO.
Check JDH	Check JSN	APRIL 04	1" = 20' H 1" = 4' V	25768	XS-29