
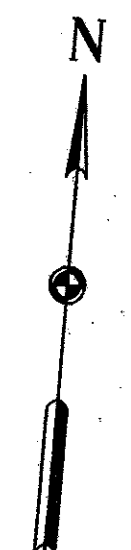






NOTE:

UNDERGROUND UTILITIES EXIST WITHIN AND ADJACENT TO THE LIMITS OF CONSTRUCTION. AN ATTEMPT HAS BEEN MADE TO LOCATE THESE UTILITIES ON THE PLANS. ALL EXISTING UTILITIES MAY NOT BE SHOWN ON THE PLANS, AND THE LOCATION OF THE UTILITIES SHOWN MAY VARY FROM THE LOCATION ON THE PLANS. PRIOR TO THE BEGINNING OF ANY TYPE OF EXCAVATION, THE CONTRACTOR SHALL CONTACT THE UTILITIES INVOLVED AND MAKE ARRANGEMENTS FOR THE LOCATION OF THE UTILITY ON THE GROUND. THE CONTRACTOR SHALL MAINTAIN THE UTILITY LOCATION MARKINGS UNTIL THEY ARE NO LONGER NECESSARY.

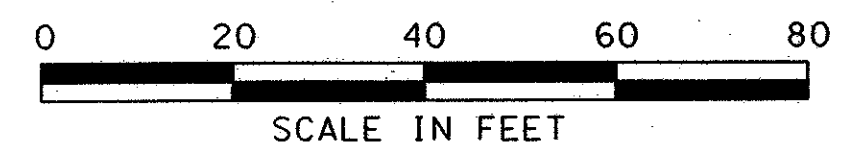

LEGEND

- OH — OVERHEAD LINES
- CO SANITARY SEWER CLEANOUT
- FH FIRE HYDRANT
- ⊕ WV WATER VALVE
- ⊗ WM WATER METER
- ⊗ GM GAS METER

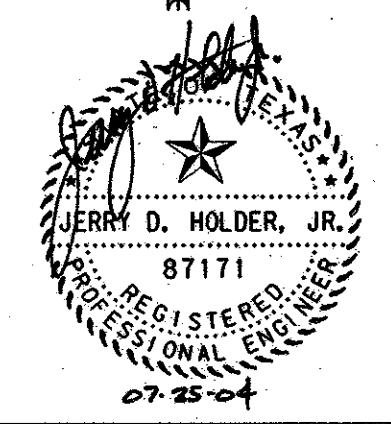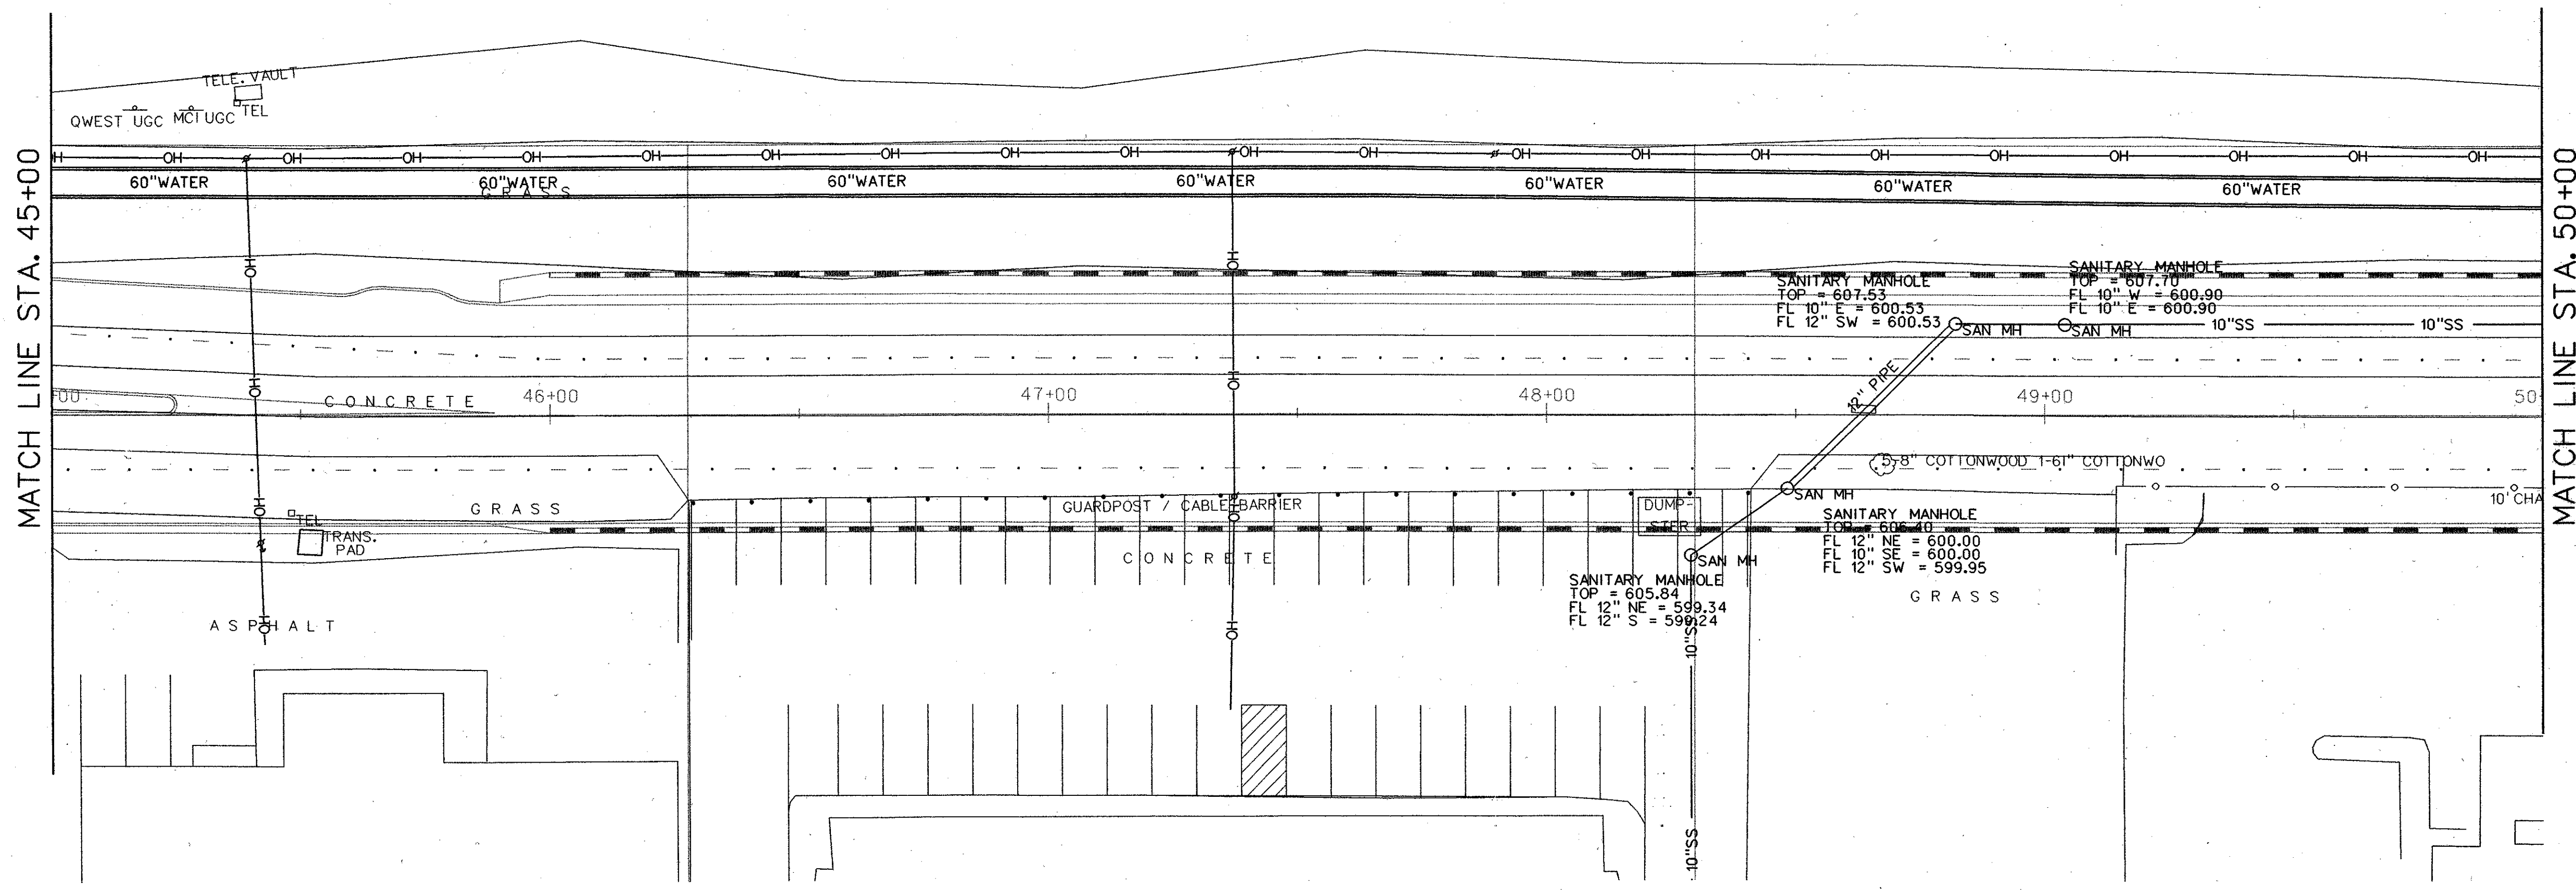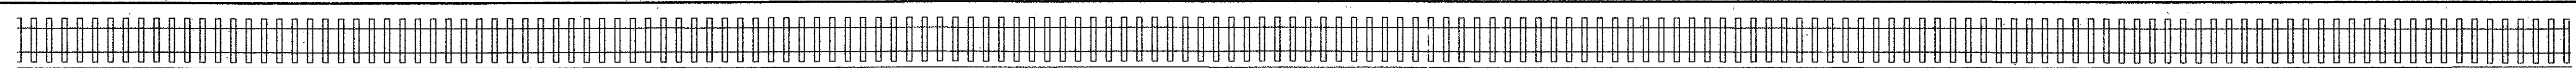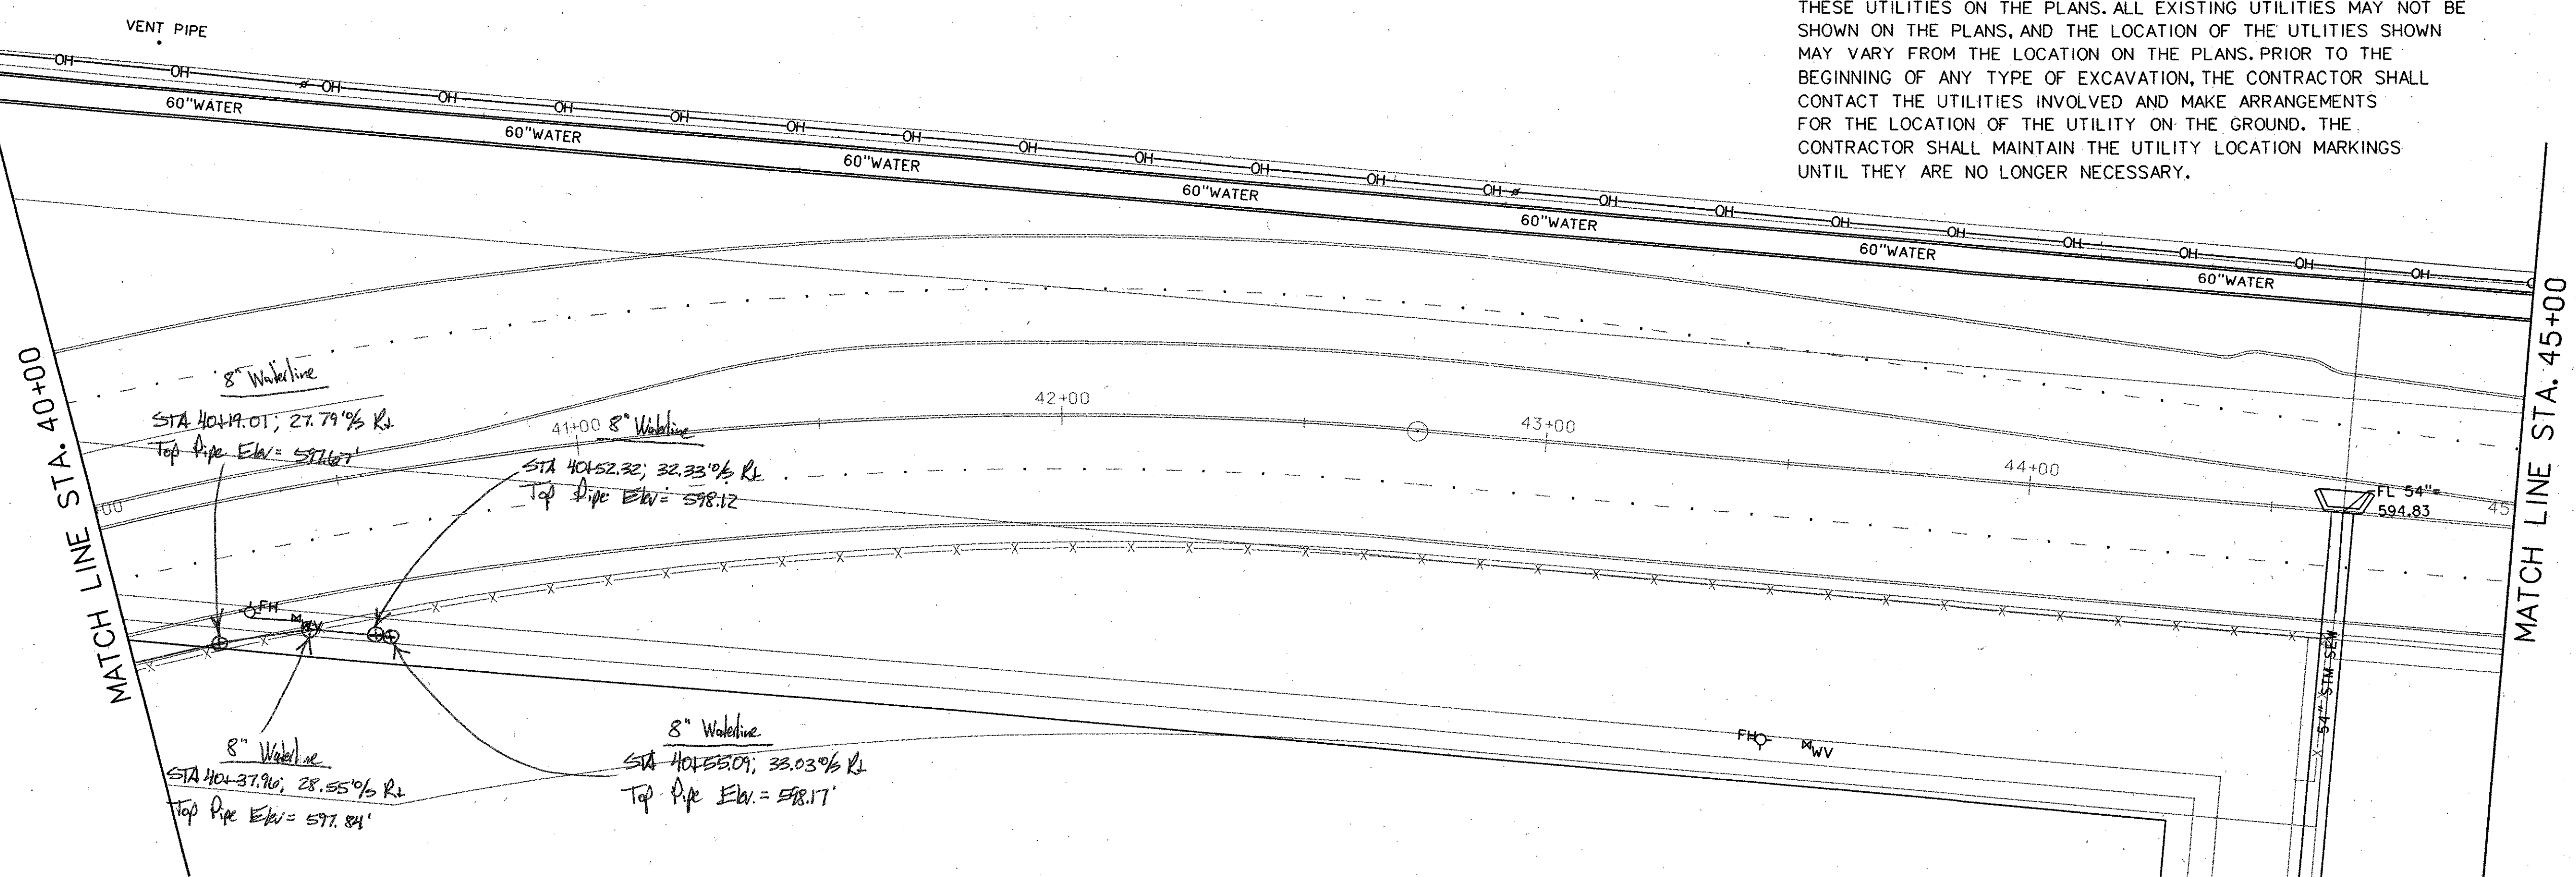

| | | | | | |
|--|-----------|----------|----------|-------------|-----------|
| | | | | 183 | |
| NO. | DATE | REVISION | APPROV. | | |
| HNTB ARCHITECTS ENGINEERS PLANNERS <i>The HNTB Companies</i> | | | | | |
| ARAPAHO ROAD - PHASE III | | | | | |
| SURVEYOR BOULEVARD TO ADDISON ROAD | | | | | |
| EXISTING UTILITY PLAN | | | | | |
| STA 40+00 TO 50+00 | | | | | |
| TOWN OF ADDISON, TEXAS | | | | | |
| Design JSN | Drawn GFS | DATE | SCALE | PROJECT NO. | SHEET NO. |
| Check JDH | Check JSN | APRIL 04 | 1" = 20' | 25768 | U-2 |

29-JUN-2004 13:02 G:\25768-ph3\h1\Cds\3\ut02.dgn