


LEGEND

- PAVEMENT REMOVAL
- BRIDGE REMOVAL
- GRAVEL REMOVAL
- SIDEWALK REMOVAL
- CONCRETE CHANNEL REMOVAL
- PROPOSED
- ROW
- TEMPORARY CONSTRUCTION EASEMENT
- EXISTING EASEMENT
- TEMPORARY CONSTRUCTION FENCE
- LIGHT POLE TO BE REMOVED
- FENCE REMOVAL

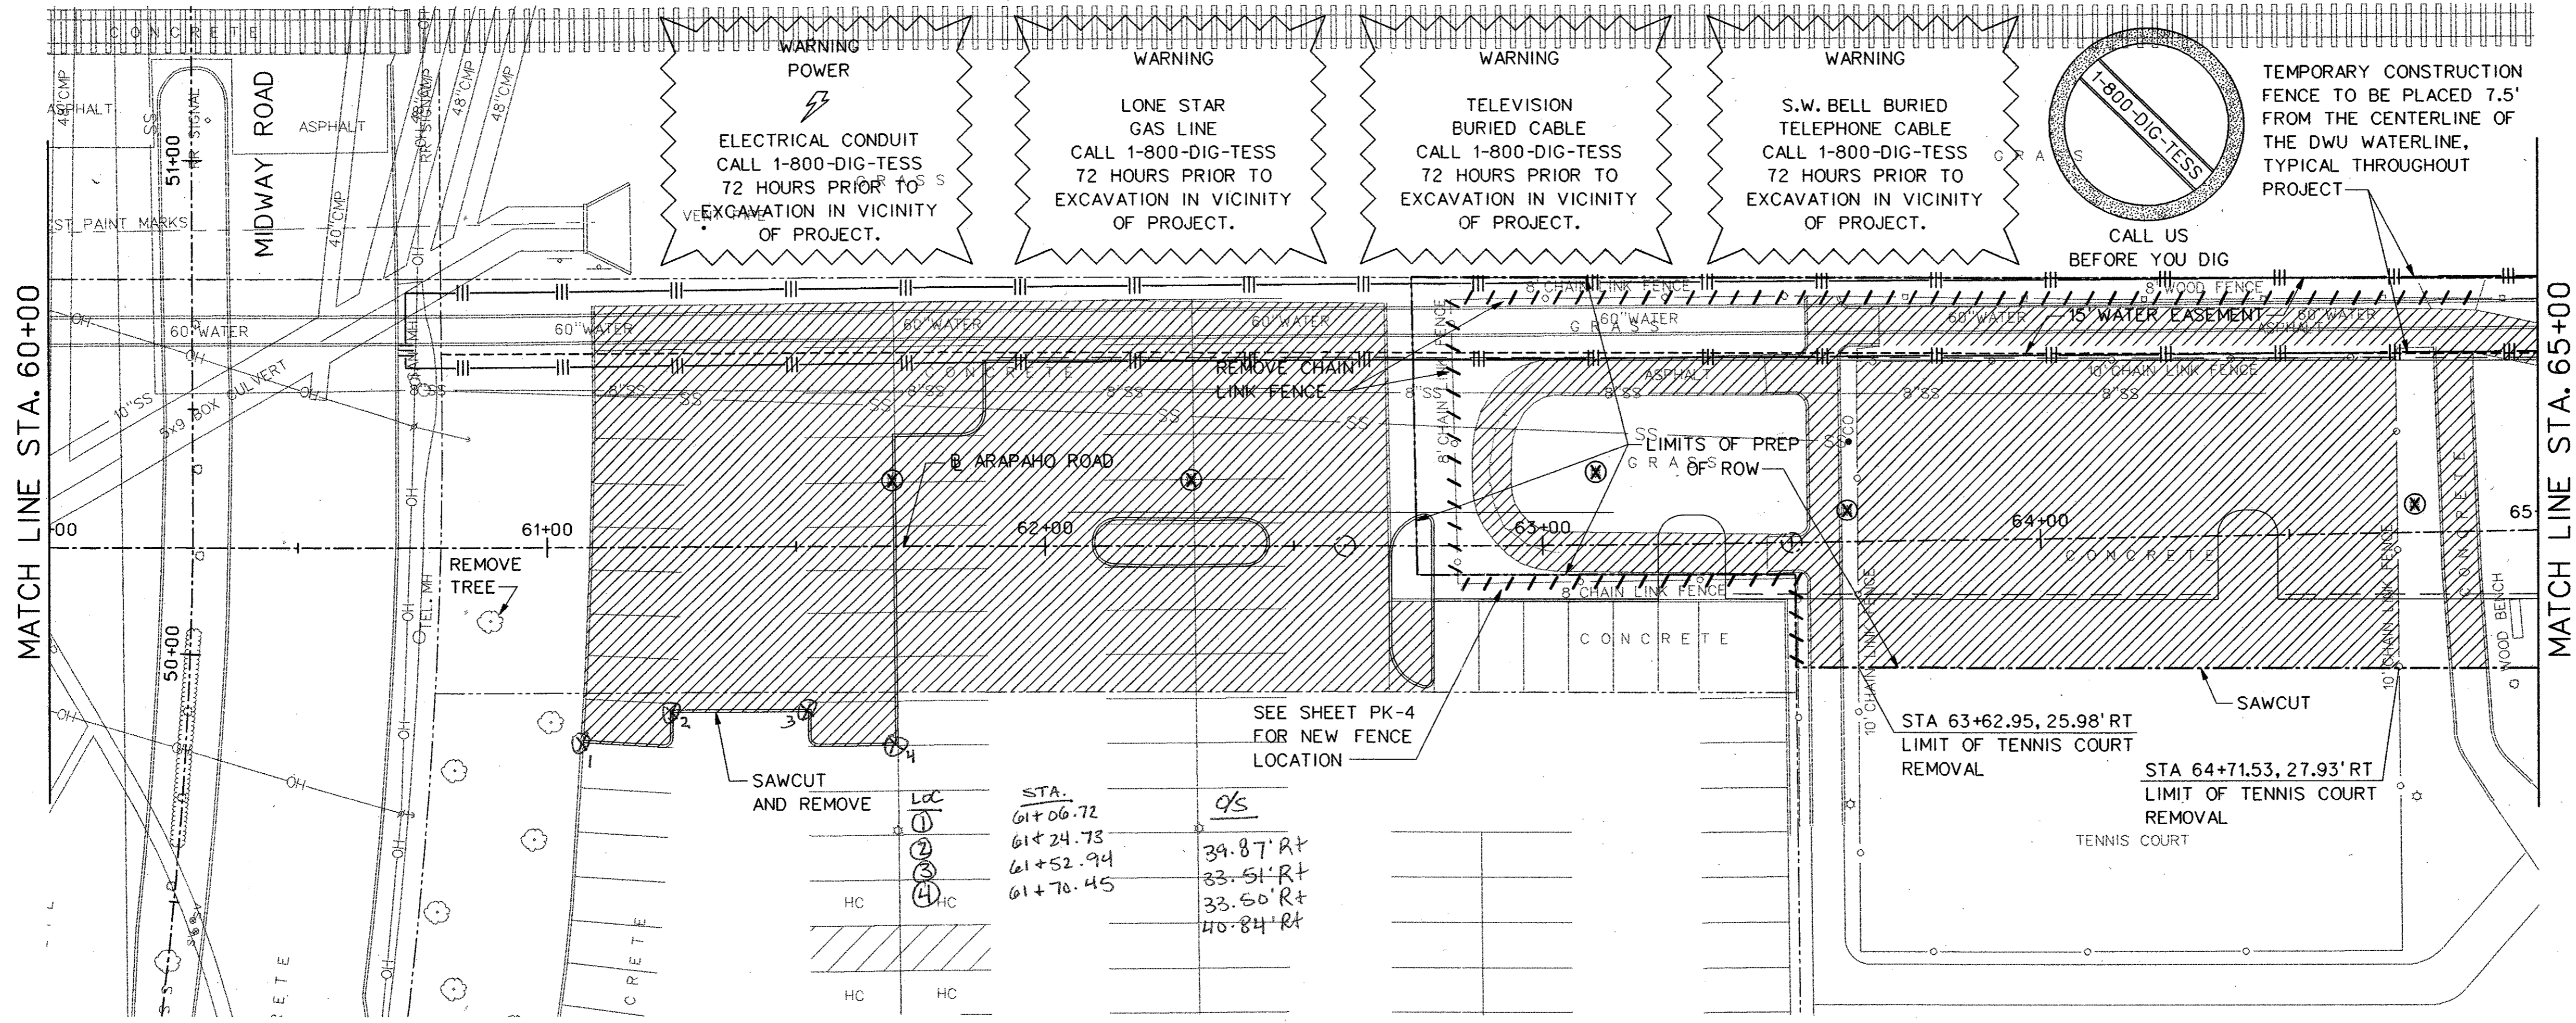


WARNING POWER
ELECTRICAL CONDUIT
CALL 1-800-DIG-TESS
72 HOURS PRIOR TO
EXCAVATION IN VICINITY
OF PROJECT.

WARNING
LONE STAR
GAS LINE
CALL 1-800-DIG-TESS
72 HOURS PRIOR TO
EXCAVATION IN VICINITY
OF PROJECT.

WARNING
TELEVISION
BURIED CABLE
CALL 1-800-DIG-TESS
72 HOURS PRIOR TO
EXCAVATION IN VICINITY
OF PROJECT.

WARNING
S.W. BELL BURIED
TELEPHONE CABLE
CALL 1-800-DIG-TESS
72 HOURS PRIOR TO
EXCAVATION IN VICINITY
OF PROJECT.

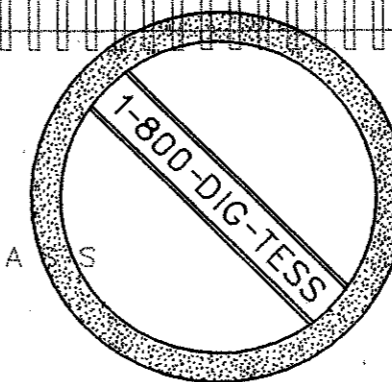

TEMPORARY CONSTRUCTION
FENCE TO BE PLACED 7.5'
FROM THE CENTERLINE OF
THE DWU WATERLINE,
TYPICAL THROUGHOUT
PROJECT


STA.	LOC	Q/S
61+06.72	①	
61+24.73	②	39.87' RT
61+52.94	③	33.51' RT
61+70.45	④	33.60' RT
		40.84' RT

SEE SHEET PK-4
FOR NEW FENCE
LOCATION

STA 63+62.95, 25.98' RT
LIMIT OF TENNIS COURT
REMOVAL

STA 64+71.53, 27.93' RT
LIMIT OF TENNIS COURT
REMOVAL

NOTE: ALL POINTS TO BACK OF CURB

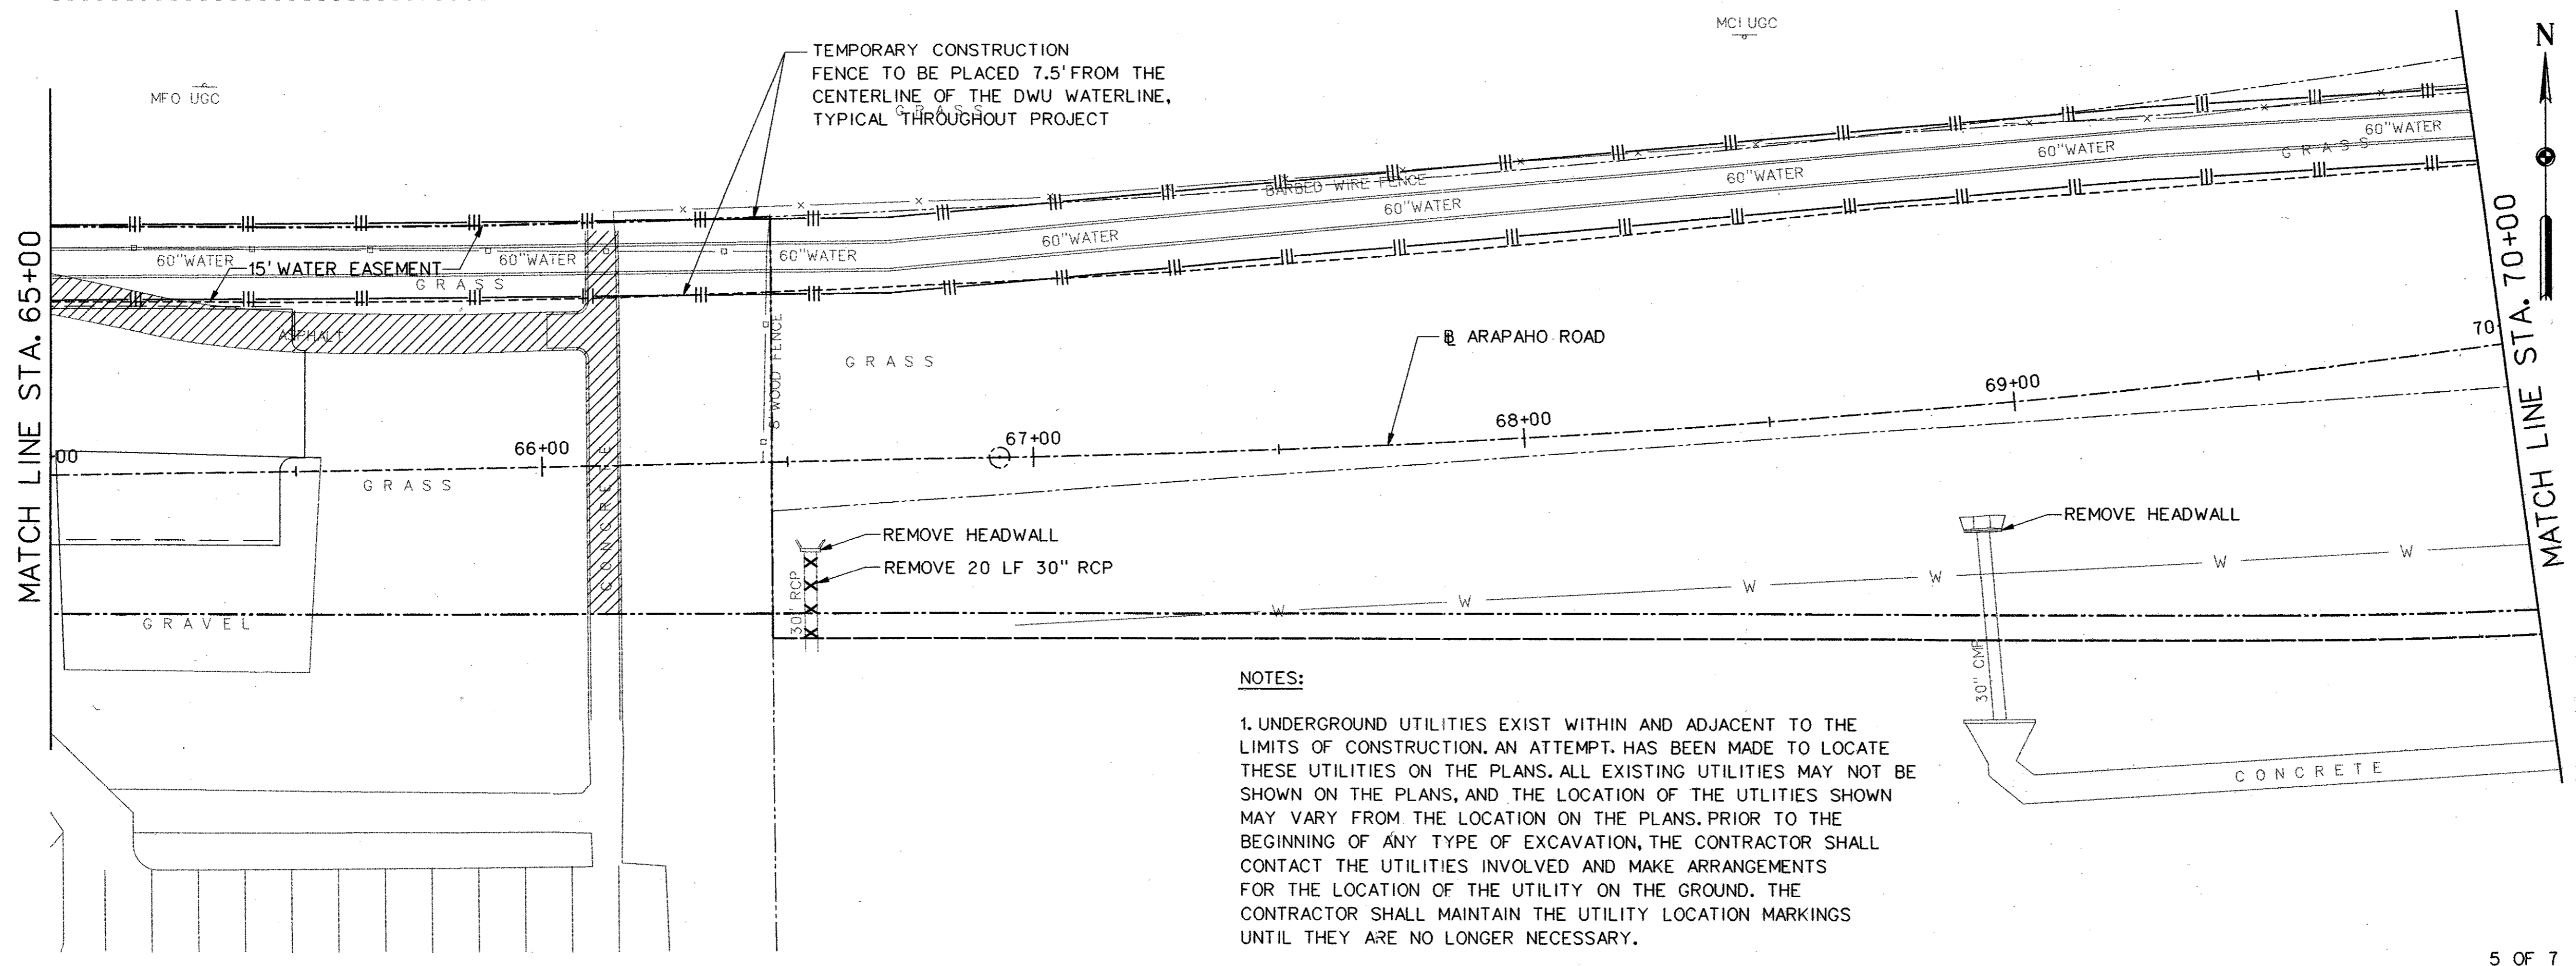


TEMPORARY CONSTRUCTION
FENCE TO BE PLACED 7.5'
FROM THE
CENTERLINE OF THE DWU WATERLINE,
TYPICAL THROUGHOUT PROJECT

REMOVE HEADWALL
REMOVE 20 LF 30" RCP

REMOVE HEADWALL

NOTES:

1. UNDERGROUND UTILITIES EXIST WITHIN AND ADJACENT TO THE LIMITS OF CONSTRUCTION. AN ATTEMPT HAS BEEN MADE TO LOCATE THESE UTILITIES ON THE PLANS. ALL EXISTING UTILITIES MAY NOT BE SHOWN ON THE PLANS, AND THE LOCATION OF THE UTILITIES SHOWN MAY VARY FROM THE LOCATION ON THE PLANS. PRIOR TO THE BEGINNING OF ANY TYPE OF EXCAVATION, THE CONTRACTOR SHALL CONTACT THE UTILITIES INVOLVED AND MAKE ARRANGEMENTS FOR THE LOCATION OF THE UTILITY ON THE GROUND. THE CONTRACTOR SHALL MAINTAIN THE UTILITY LOCATION MARKINGS UNTIL THEY ARE NO LONGER NECESSARY.

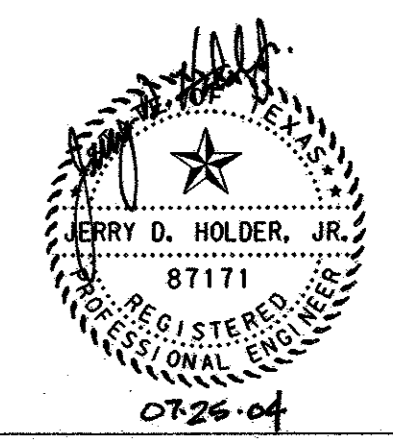

NO.	DATE	REVISION	APPROV.
ARCHITECTS ENGINEERS PLANNERS The HNTB Companies			24
ARAPAHO ROAD - PHASE III SURVEYOR BOULEVARD TO ADDISON ROAD REMOVAL PLAN STA 60+00 TO STA 70+00 TOWN OF ADDISON, TEXAS			
Design JSN	Drawn GFS	DATE	SCALE PROJECT NO. SHEET NO.
Check JDH	Check JSN	APRIL 04	1" = 20' 25768 R-5