

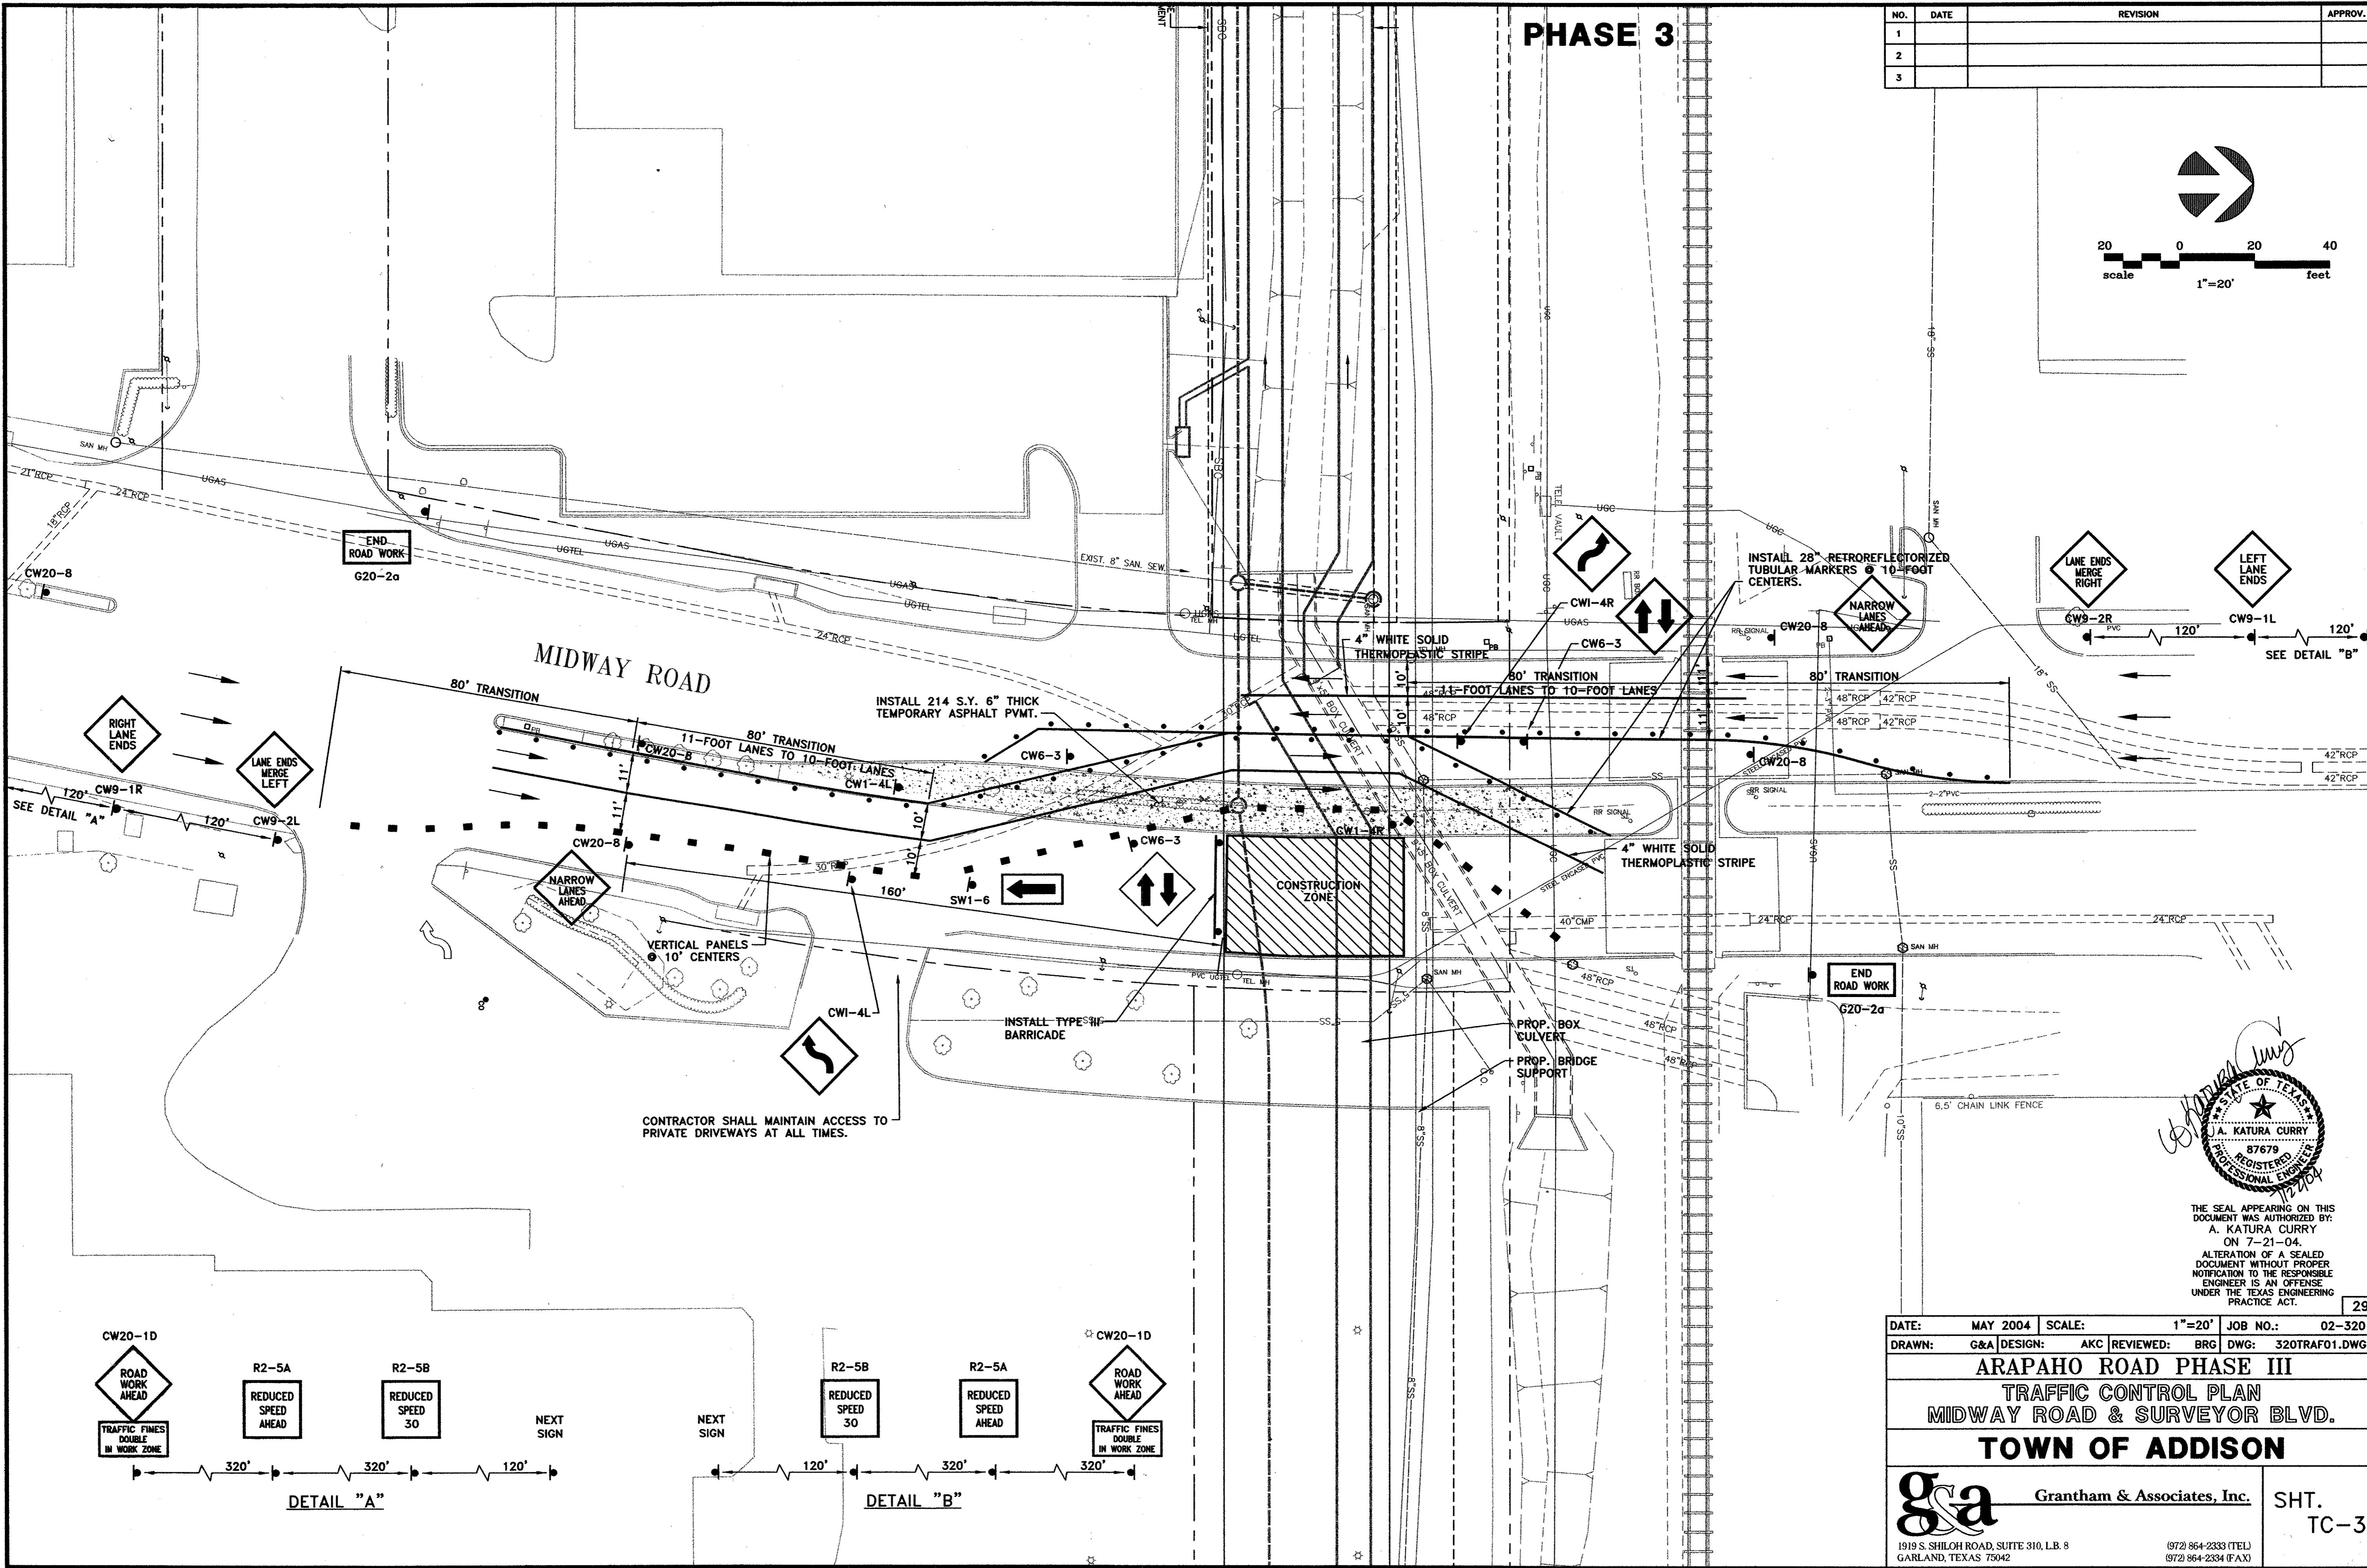


PHASE 3

NO.	DATE	REVISION	APPROV.
1			
2			
3			

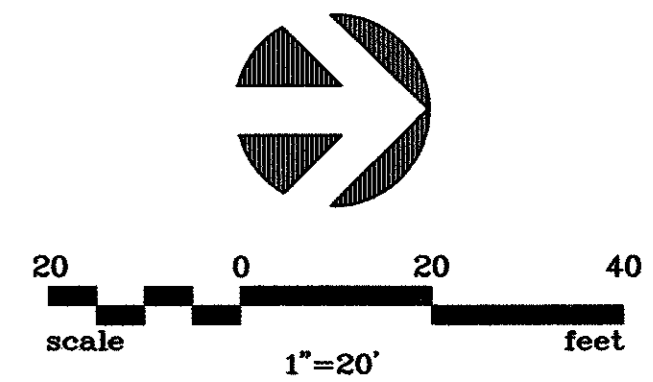

CONTRACTOR SHALL MAINTAIN ACCESS TO PRIVATE DRIVEWAYS AT ALL TIMES.

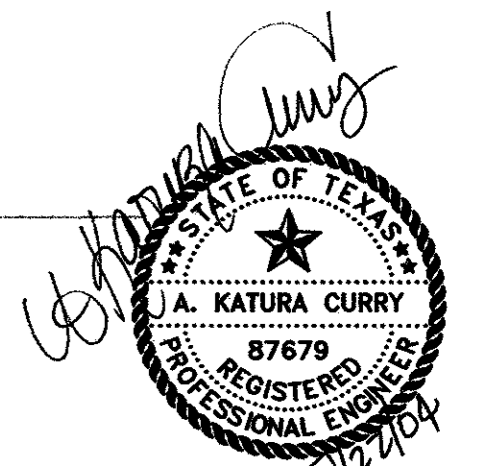

THE SEAL APPEARING ON THIS DOCUMENT WAS AUTHORIZED BY:
 A. KATURA CURRY
 ON 7-21-04.
 ALTERATION OF A SEALED DOCUMENT WITHOUT PROPER NOTIFICATION TO THE RESPONSIBLE ENGINEER IS AN OFFENSE UNDER THE TEXAS ENGINEERING PRACTICE ACT.

DATE: MAY 2004	SCALE: 1"=20'	JOB NO.: 02-320
DRAWN: G&A	DESIGN: AKC	REVIEWED: BRG
DWG: 320TRAFO1.DWG		

ARAPAHO ROAD PHASE III TRAFFIC CONTROL PLAN MIDWAY ROAD & SURVEYOR BLVD.

TOWN OF ADDISON

g&a Grantham & Associates, Inc. SHT. TC-3

1919 S. SHILOH ROAD, SUITE 310, LB. 8 GARLAND, TEXAS 75042 (972) 864-2333 (TEL) (972) 864-2304 (FAX)

