


ELEVATION
(LOOKING NORTH)

GENERAL NOTES:

1. FOR RELEVANT RAIL DIMENSIONS, SEE PEDESTRIAN RAIL SHEETS AND T4(S) MOD SHEETS.
2. FOR RAIL PAINT SCHEMES, SEE SURFACE FINISHES FOR STRUCTURES SHEET.

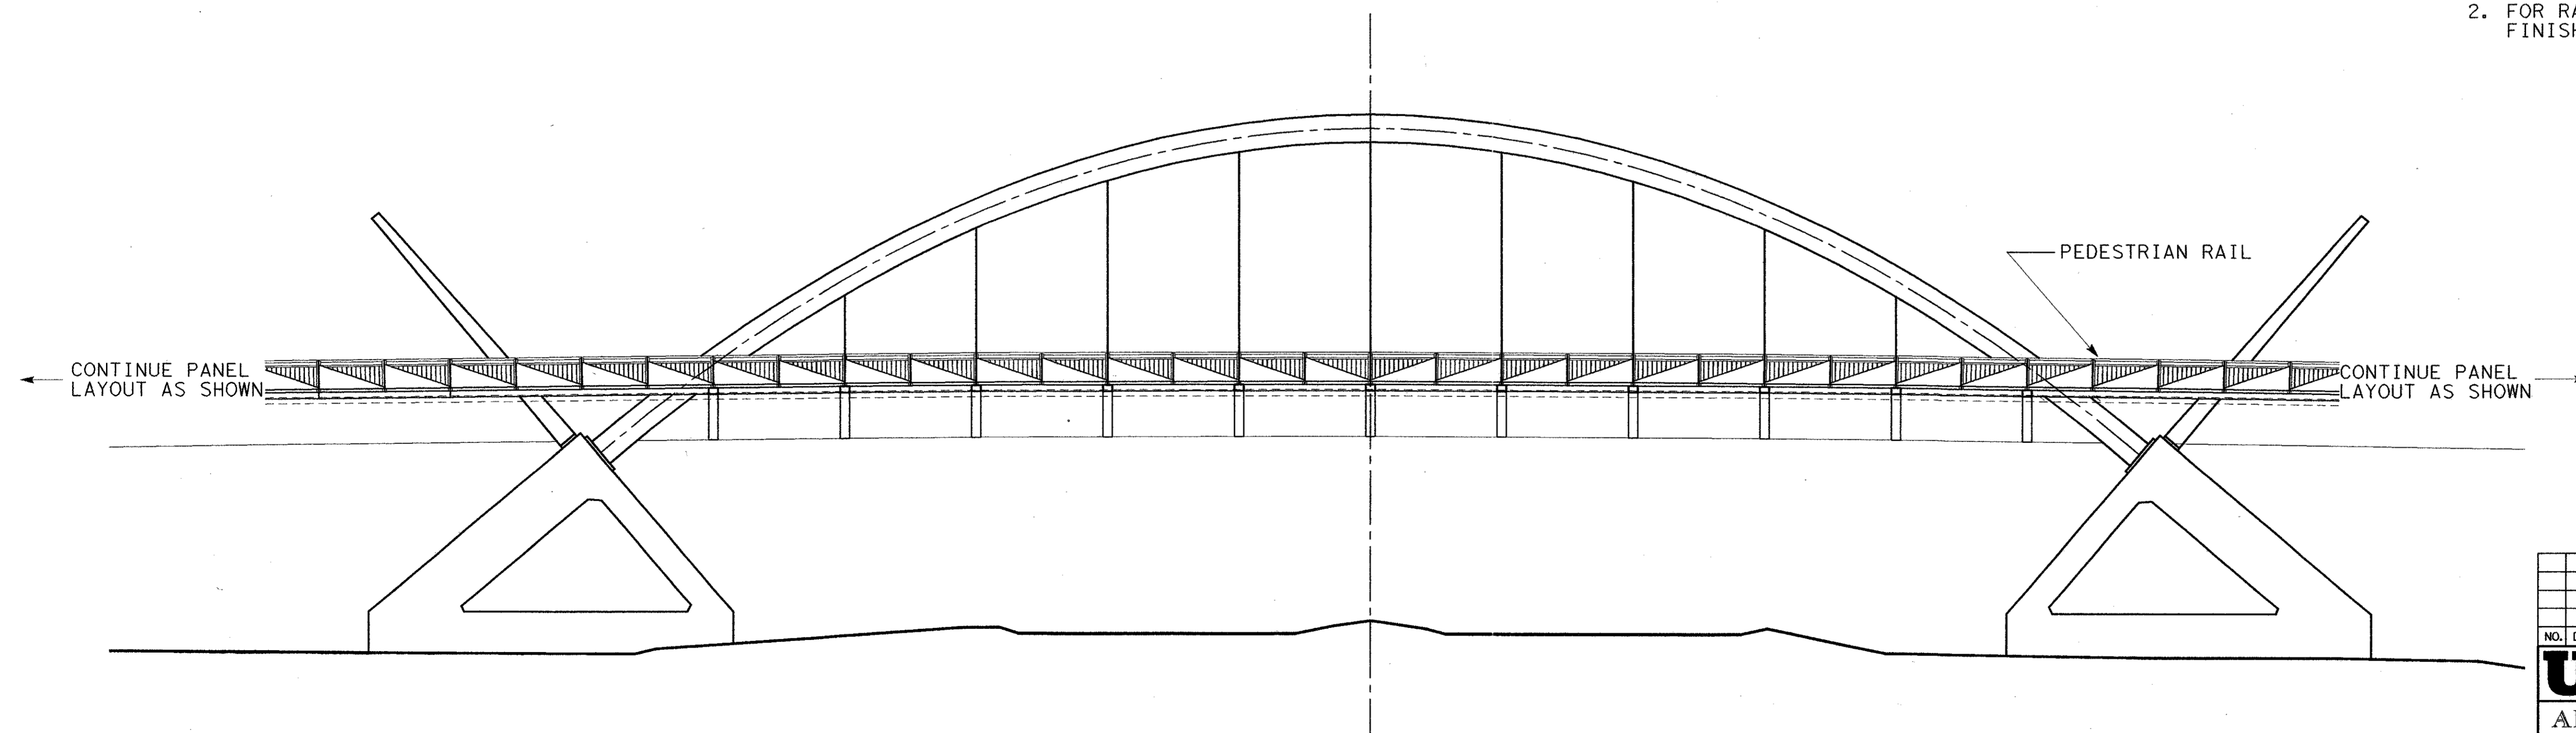

ELEVATION
(LOOKING SOUTH)



NO.		DATE	REVISION	APPROV.	299
URS GREYSTONE CENTRE 3010 LBJ FREEWAY, SUITE 1300 DALLAS, TX 75234					
ARAPAHO ROAD - PHASE III SURVEYOR BOULEVARD TO ADDISON ROAD					
BRIDGE RAIL LAYOUT					
TOWN OF ADDISON, TEXAS					
Design	Drawn	DATE	SCALE	PROJECT NO.	SHEET NO.
Check	Check	05-07-04		25768	BR-61