
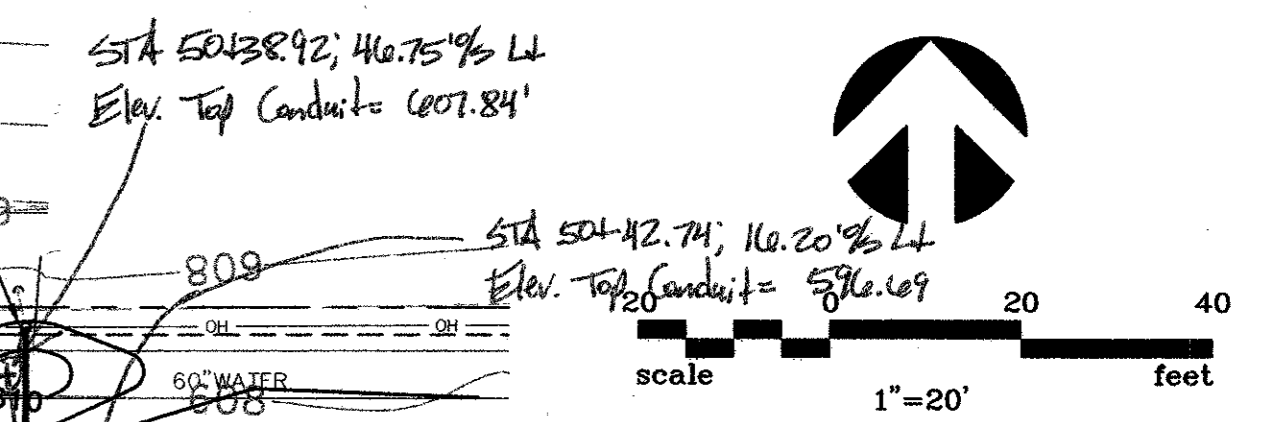




NO.	DATE	REVISION	APPROV.
1	06/28/04	REVISED PER ADDENDA	A.K.C.
2	06/28/04	REVISED PER G & A	A.K.C.
3	09/03/04	REVISED CONDUITS, ADDED GRATE SLOT INLETS	A.K.C.

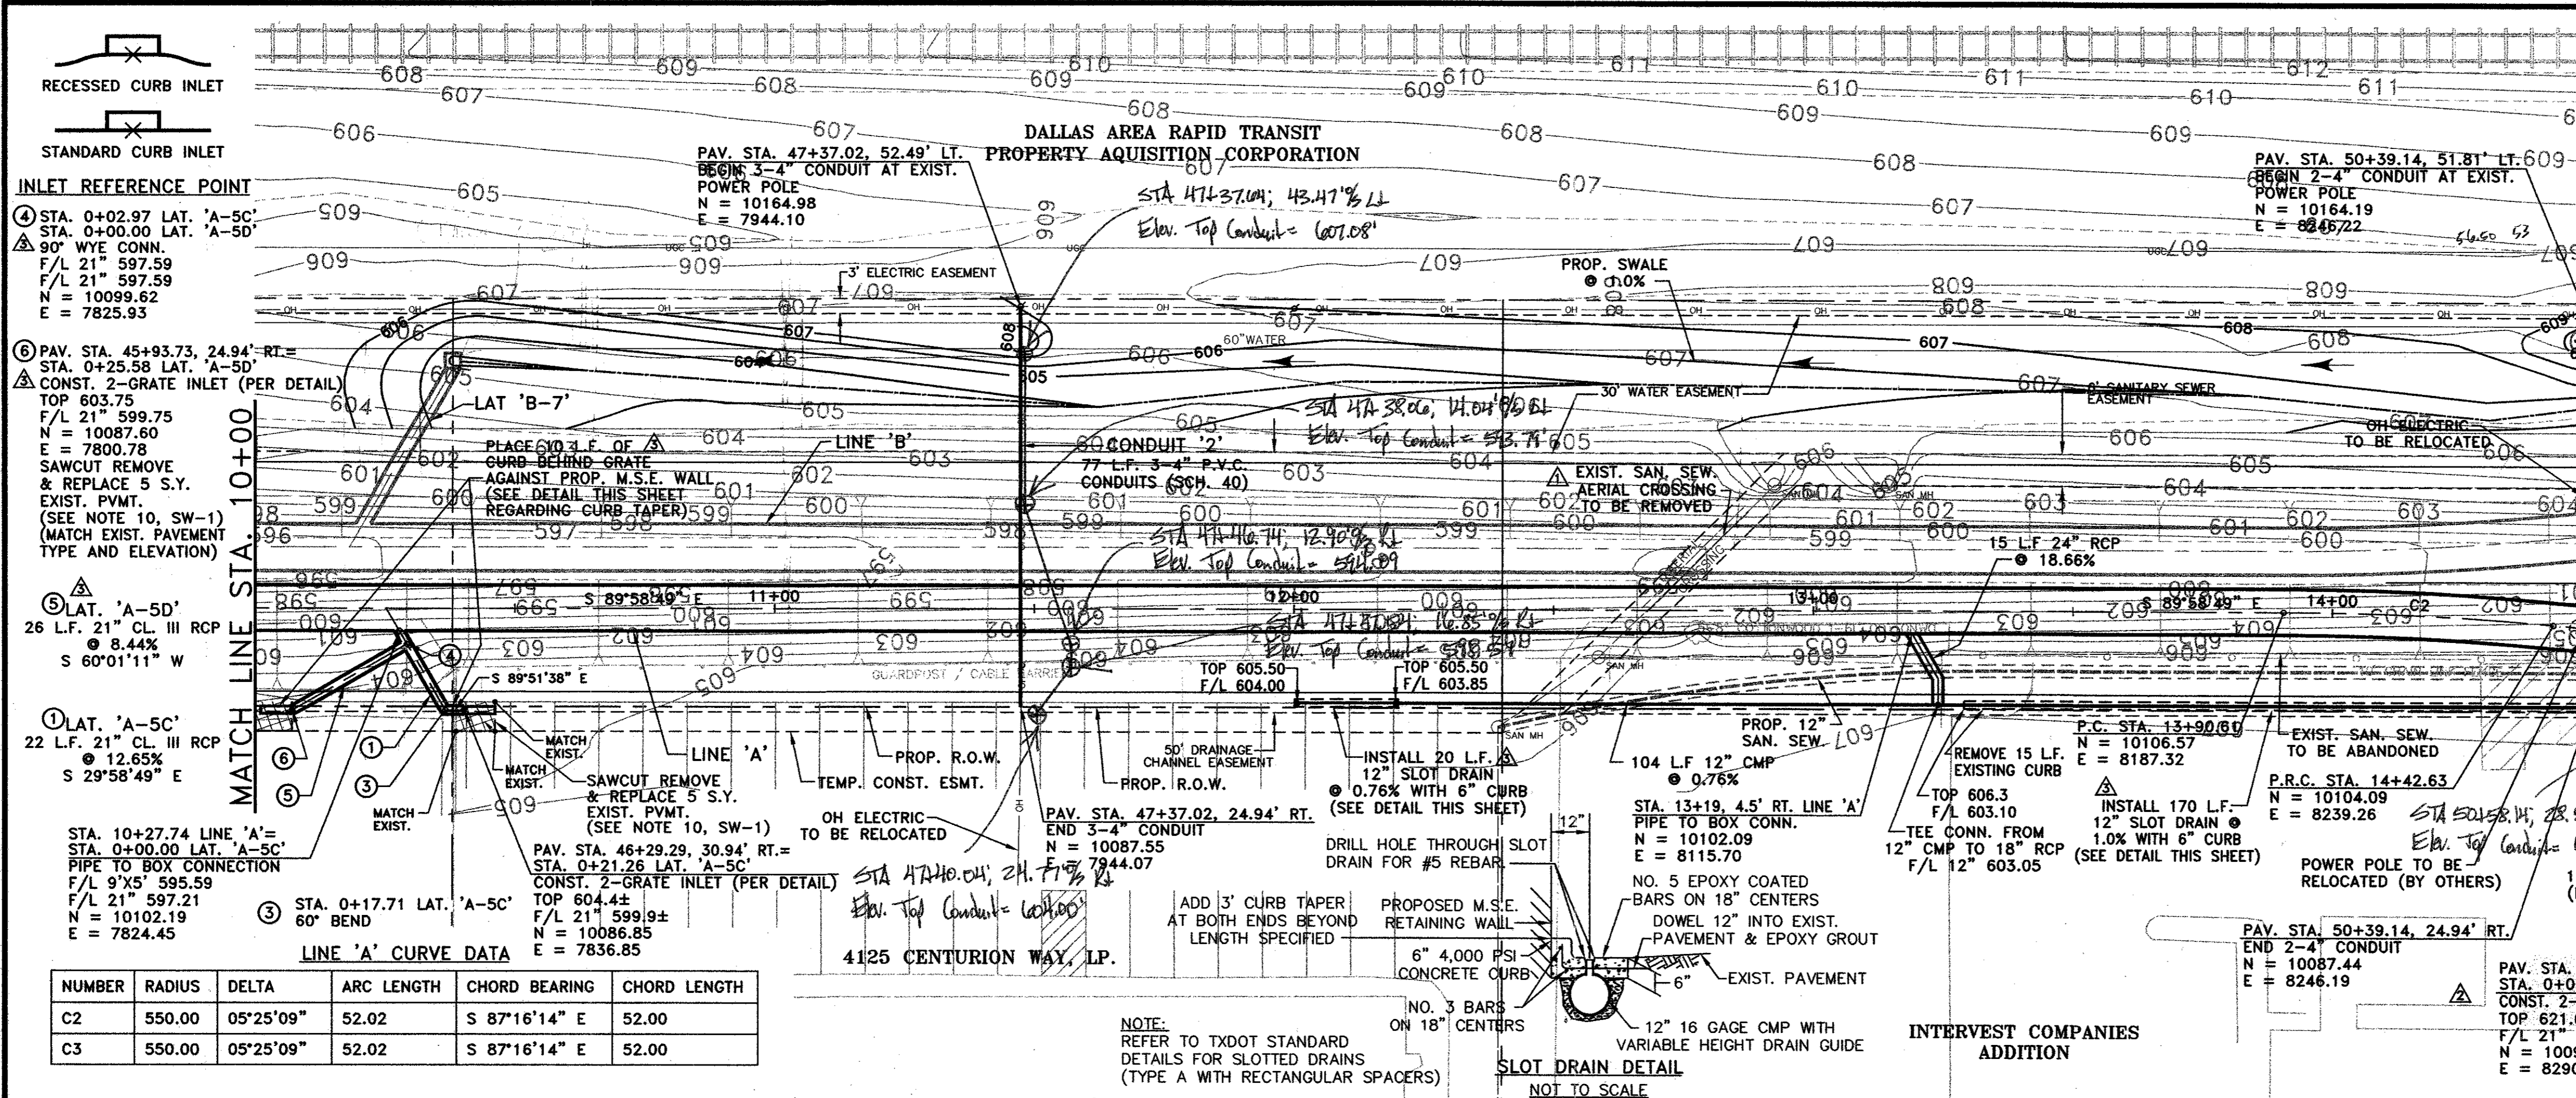

LINE 'A' CURVE DATA

NUMBER	RADIUS	DELTA	ARC LENGTH	CHORD BEARING	CHORD LENGTH
C2	550.00	05°25'09"	52.02	S 87°16'14" E	52.00
C3	550.00	05°25'09"	52.02	S 87°16'14" E	52.00

NOTE:
REFER TO TXDOT STANDARD
DETAILS FOR SLOTTED DRAINS
(TYPE A WITH RECTANGULAR SPACERS)

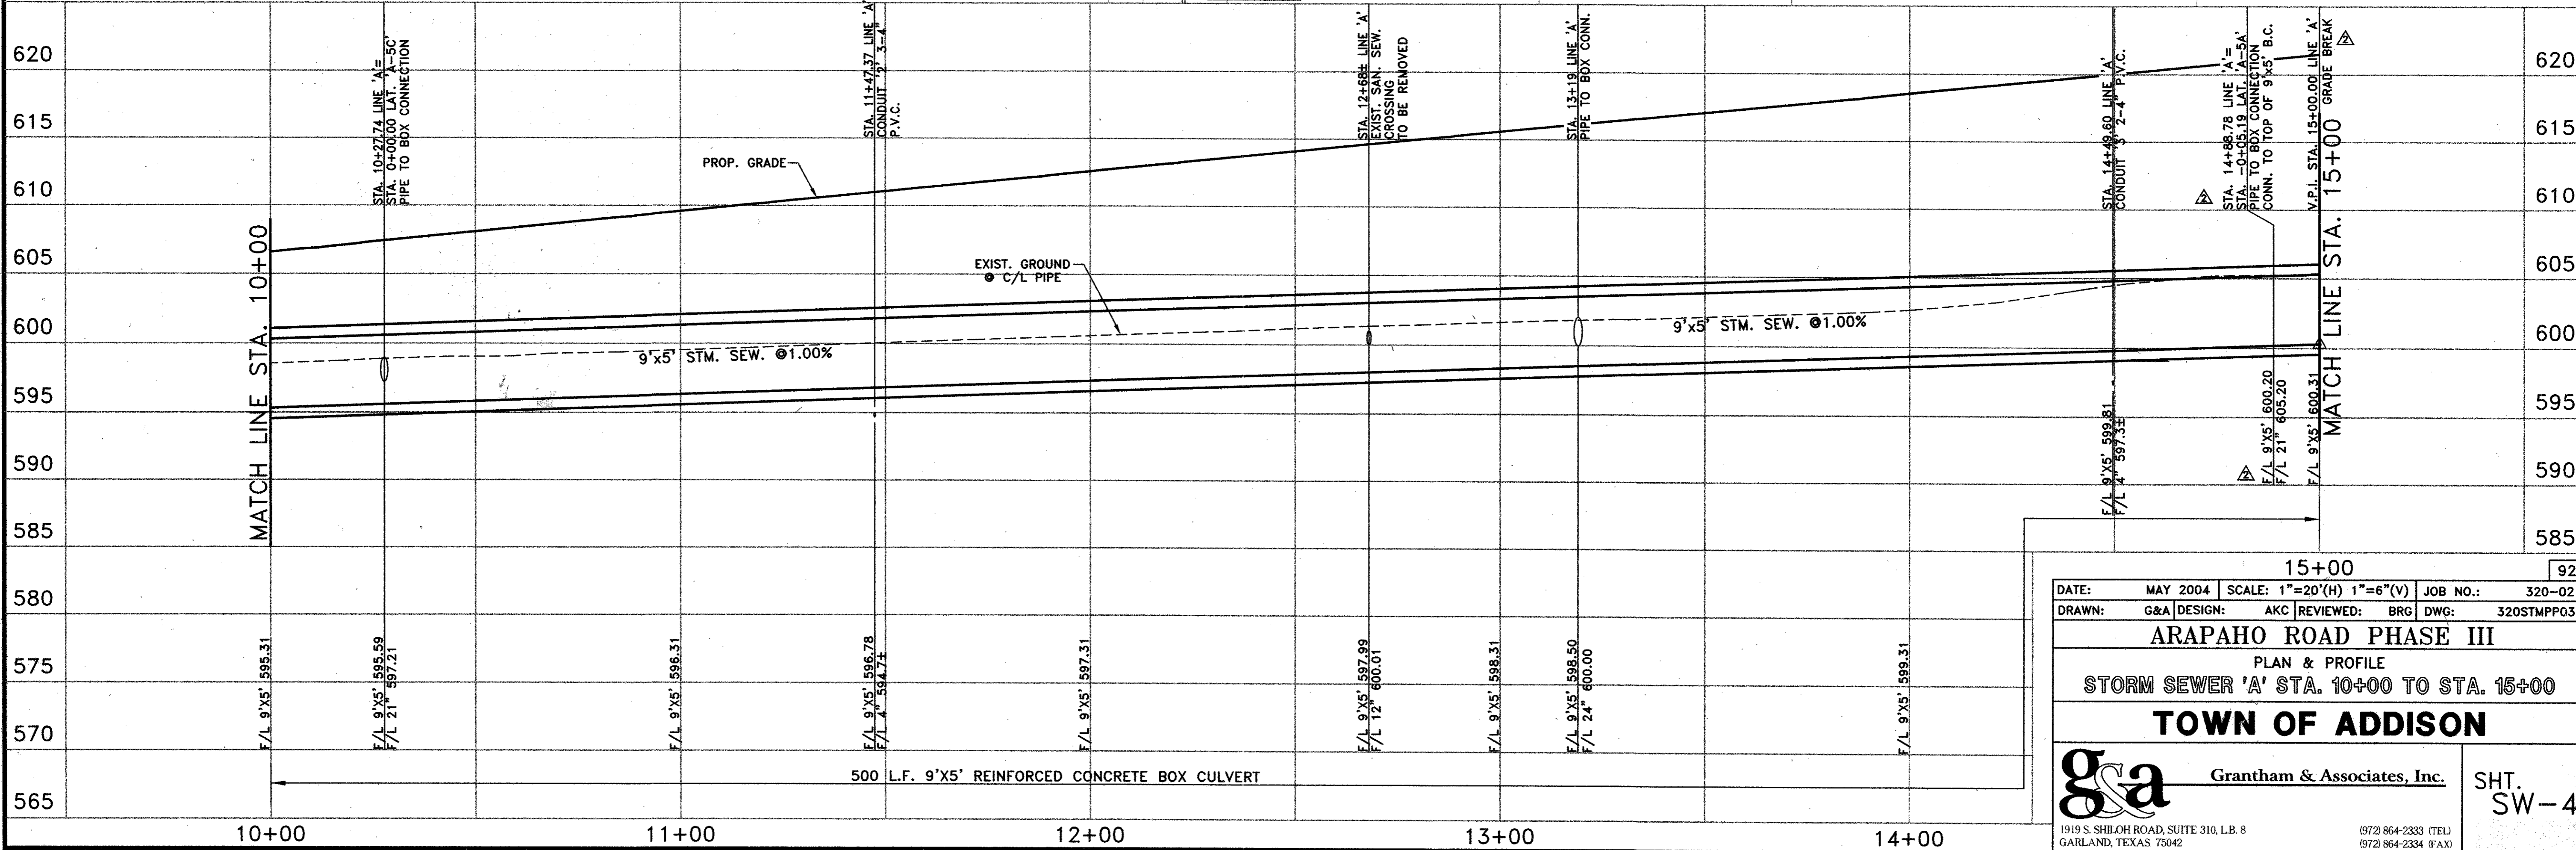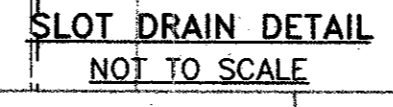

15+00 92

DATE:	MAY 2004	SCALE:	1"=20'(H) 1"=6'(V)	JOB NO.:	320-02
DRAWN:	G&A	DESIGN:	AKC	REVIEWED:	BRG
		DWG:	320STMP03		

ARAPAHO ROAD PHASE III
PLAN & PROFILE
STORM SEWER 'A' STA. 10+00 TO STA. 15+00

TOWN OF ADDISON

g&a Grantham & Associates, Inc. SHT. SW-4

1919 S. SHILOH ROAD, SUITE 310, L.B. 8 GARLAND, TEXAS 75042 (972) 864-2333 (TEL) (972) 864-2334 (FAX)