

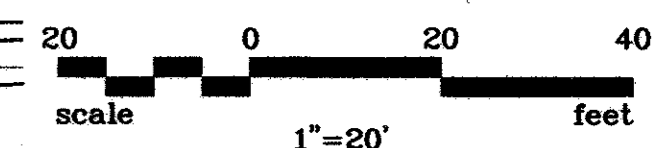
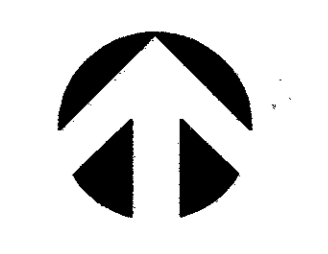


NO.	DATE	REVISION	APPROV.
1	5/24/04	ADJUSTED EXISTING GROUND LINE	AKC
2	9/01/04	ADDED GRATE INLETS	AKC
3			

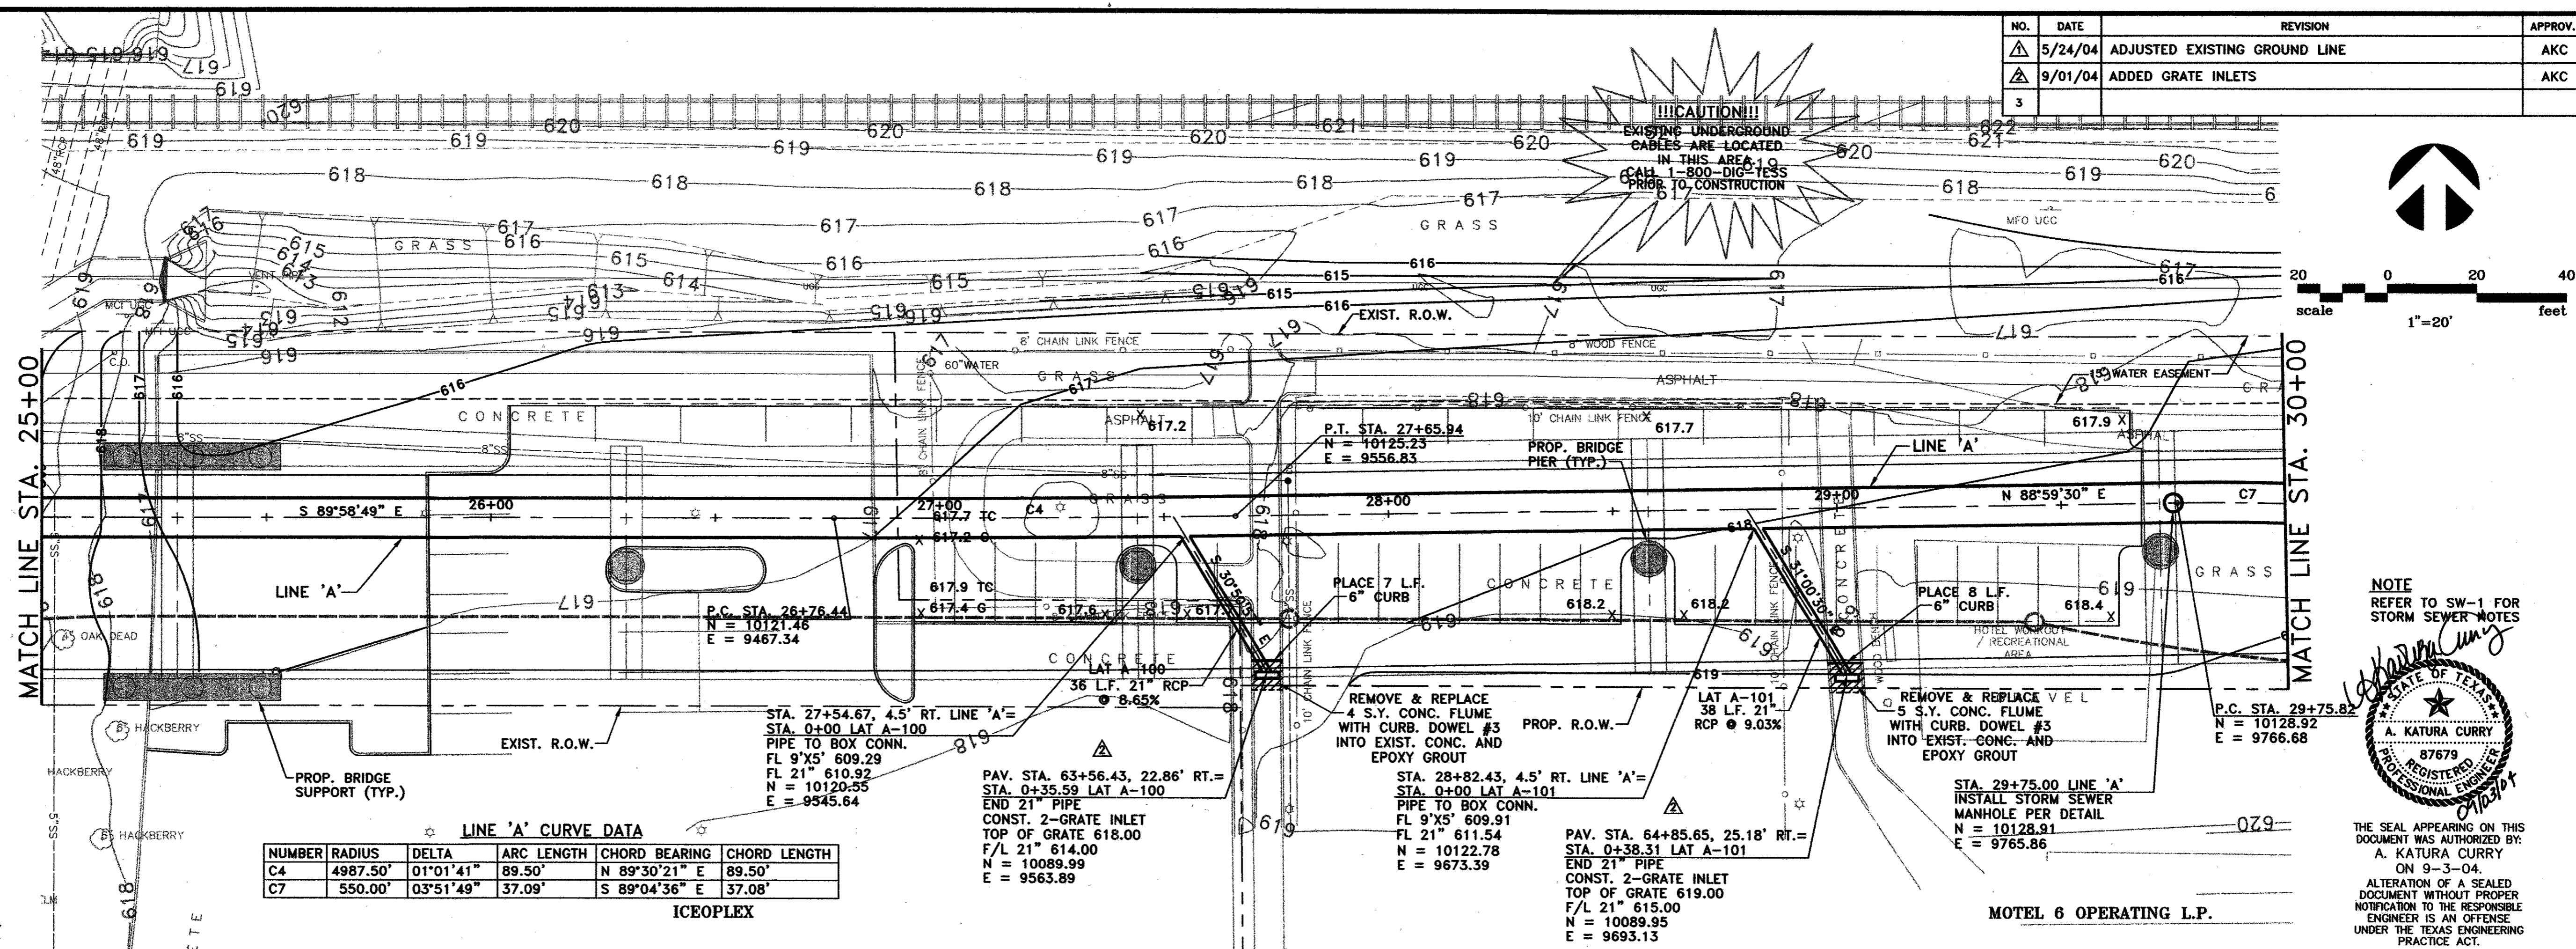

NOTE  
REFER TO SW-1 FOR  
STORM SEWER NOTES


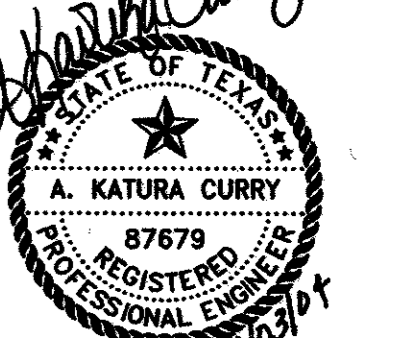


THE SEAL APPEARING ON THIS DOCUMENT WAS AUTHORIZED BY:  
A. KATURA CURRY  
ON 9-3-04.  
ALTERATION OF A SEALED DOCUMENT WITHOUT PROPER NOTIFICATION TO THE RESPONSIBLE ENGINEER IS AN OFFENSE UNDER THE TEXAS ENGINEERING PRACTICE ACT.

LINE 'A' CURVE DATA

NUMBER	RADIUS	DELTA	ARC LENGTH	CHORD BEARING	CHORD LENGTH
C4	4987.50'	01°01'41"	89.50'	N 89°30'21" E	89.50'
C7	550.00'	03°51'49"	37.09'	S 89°04'36" E	37.08'

ICEOPLEX

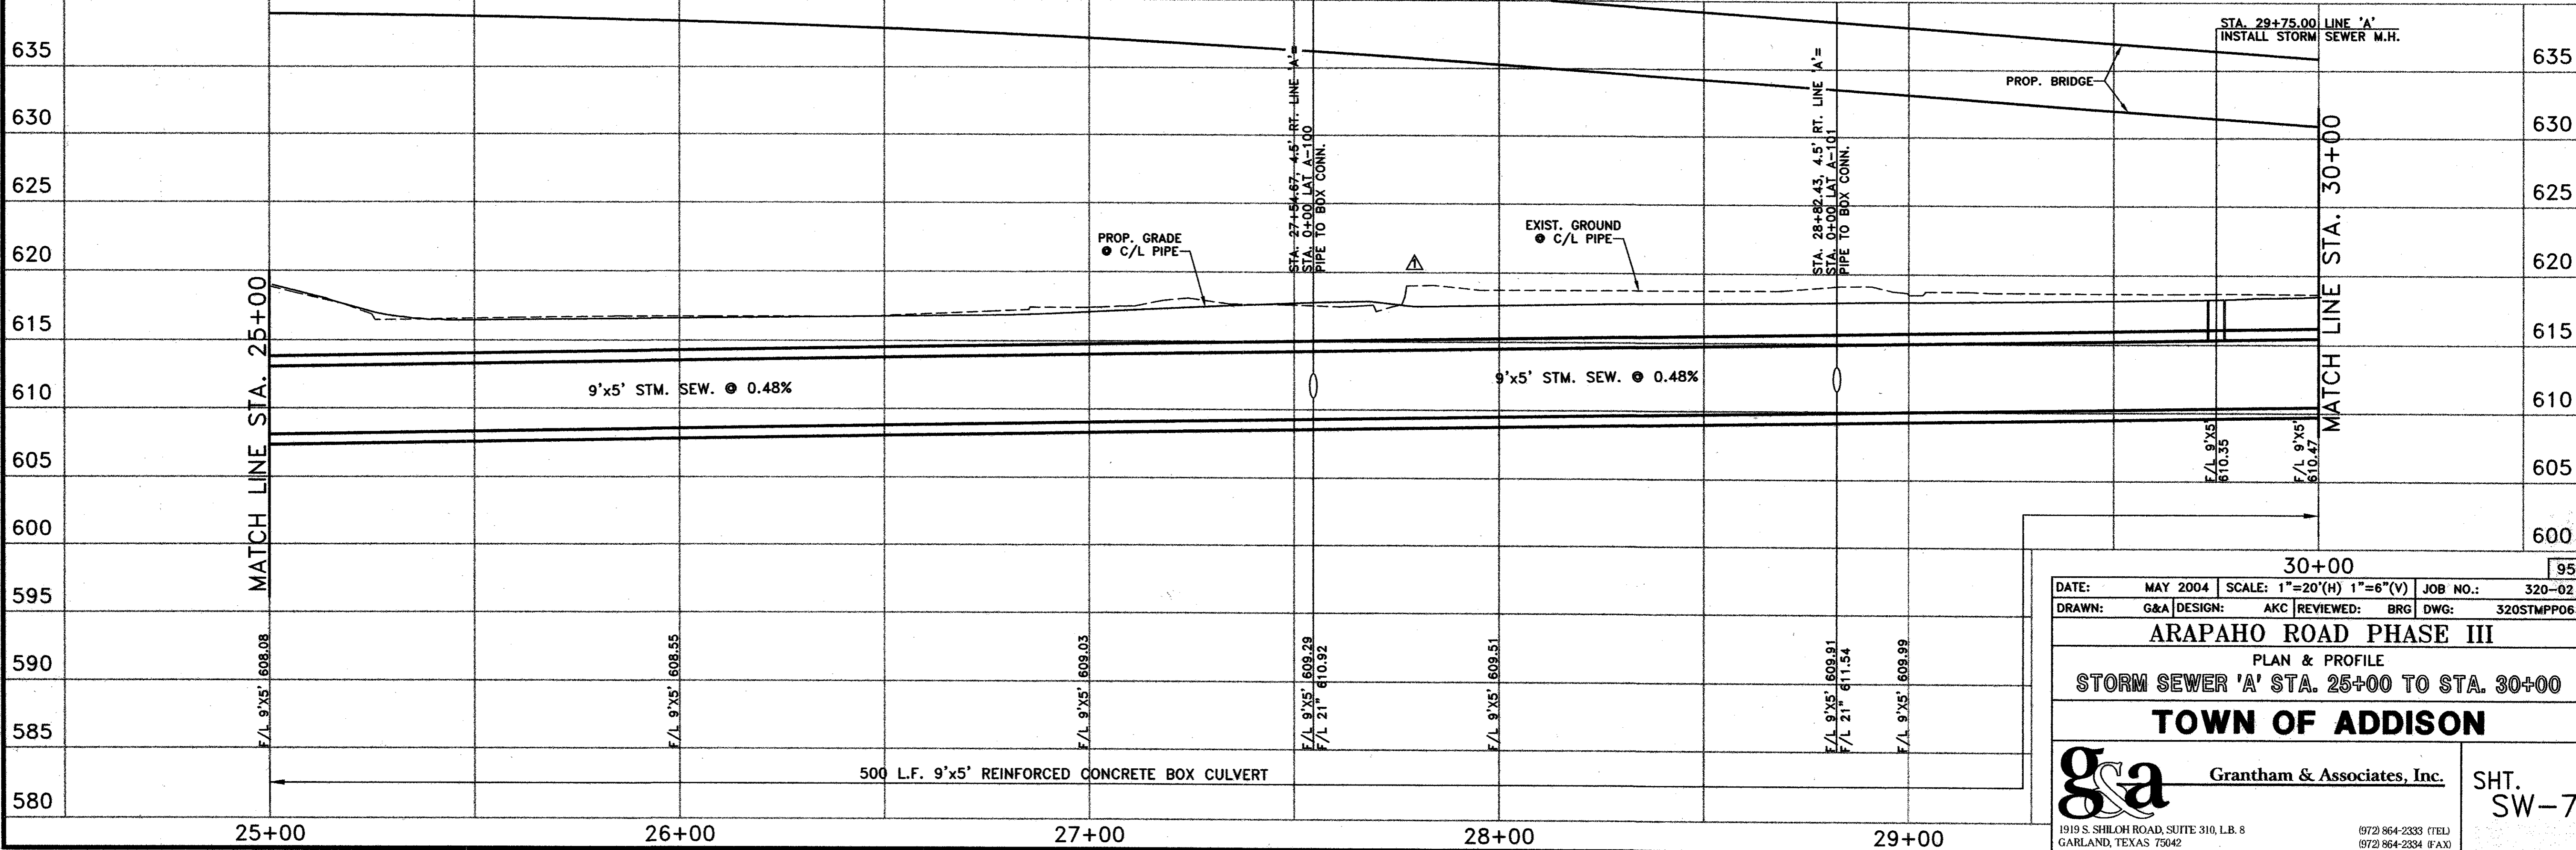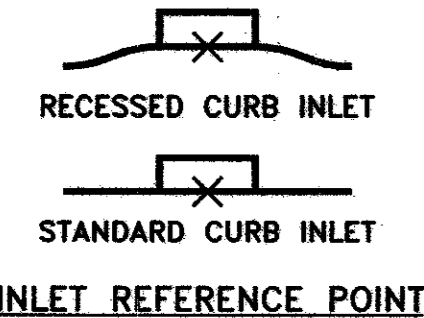

30+00 95

DATE:	MAY 2004	SCALE:	1"=20'(H) 1"=6'(V)	JOB NO.:	320-02
DRAWN:	G&A	DESIGN:	AKC	REVIEWED:	BRG
		DWG:	320STMP06		

**ARAPAHO ROAD PHASE III**  
PLAN & PROFILE  
STORM SEWER 'A' STA. 25+00 TO STA. 30+00  
**TOWN OF ADDISON**

**g&a** Grantham & Associates, Inc.

1919 S. SHILOH ROAD, SUITE 310, L.B. 8 GARLAND, TEXAS 75042 (972) 864-2333 (TEL) (972) 864-2334 (FAX)

SHT. SW-7