





LINE 'A' CURVE DATA:

NUMBER	RADIUS	DELTA	ARC LENGTH	CHORD BEARING	CHORD LENGTH
C12	350.00	43°29'50"	265.71	N 89°20'11" E	259.37

LAT. 'A-13' CURVE DATA:


NUMBER	RADIUS	DELTA	ARC LENGTH	CHORD BEARING	CHORD LENGTH
C1	100.00	13°33'44"	23.67	N 14°22'08" E	23.62

NO.	DATE	REVISION	APPROV.
1	06/28/04	REVISED PER ADDENDA	A.K.C.
2			
3			

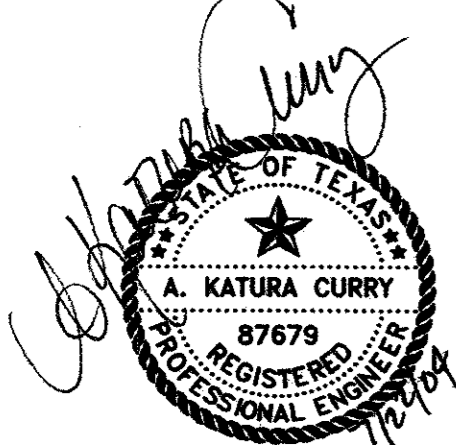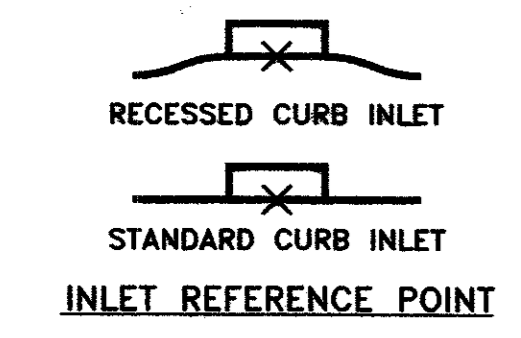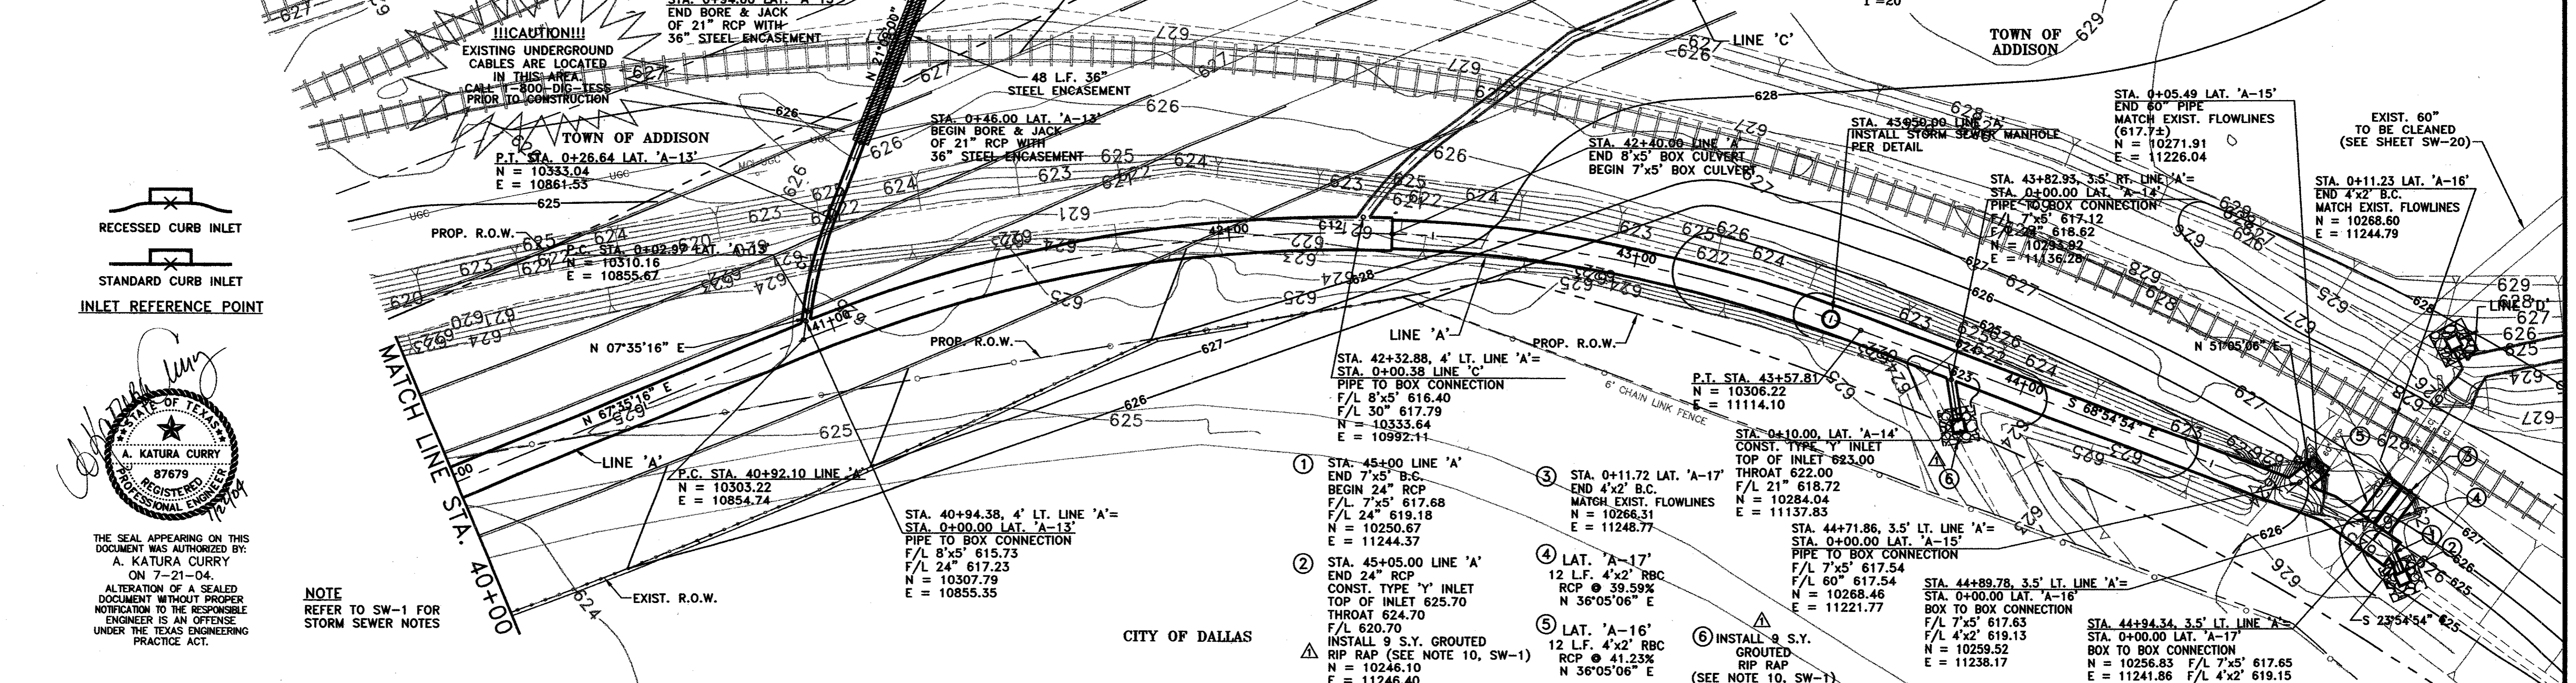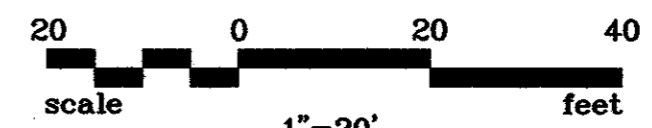

THE SEAL APPEARING ON THIS DOCUMENT WAS AUTHORIZED BY: A. KATURA CURRY ON 7-21-04. ALTERATION OF A SEALED DOCUMENT WITHOUT PROPER NOTIFICATION TO THE RESPONSIBLE ENGINEER IS AN OFFENSE UNDER THE TEXAS ENGINEERING PRACTICE ACT.

NOTE REFER TO SW-1 FOR STORM SEWER NOTES

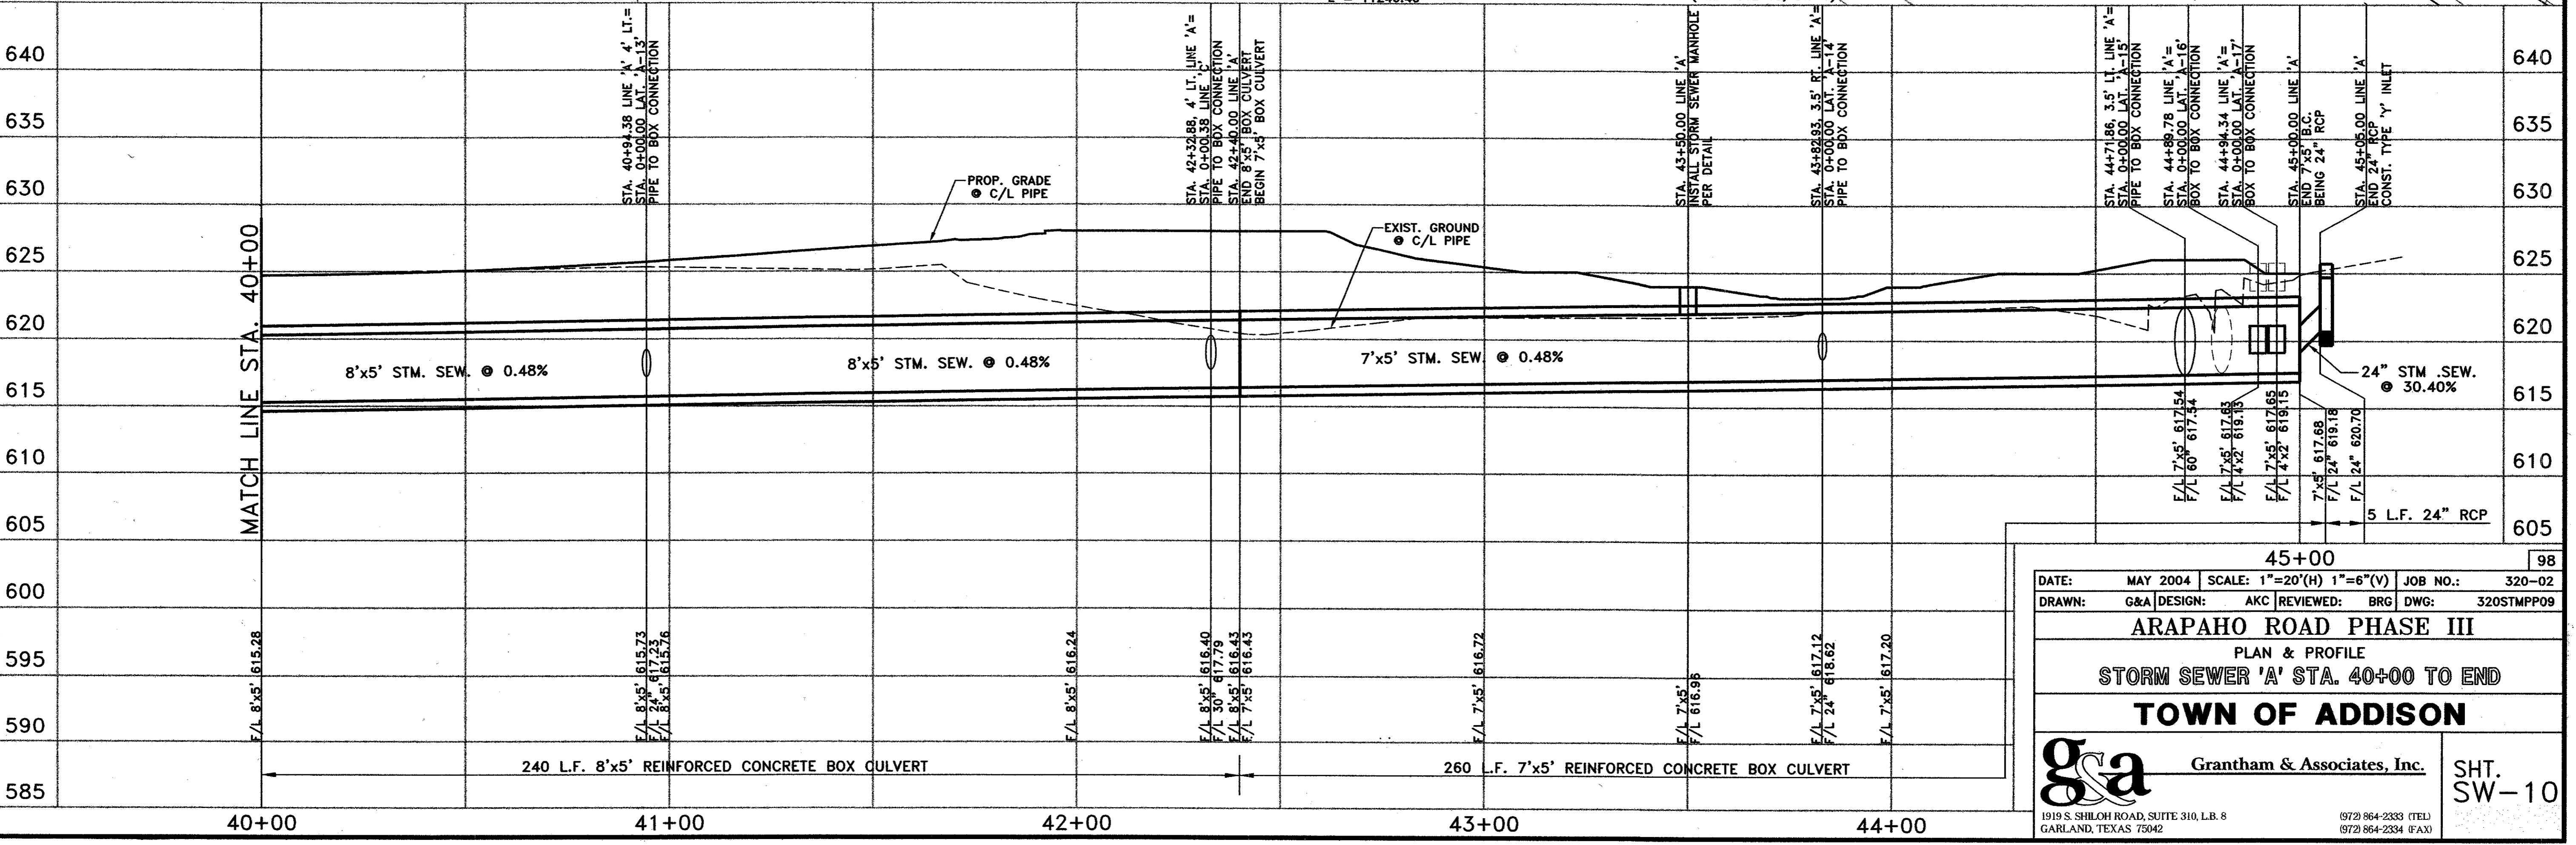

45+00 98

DATE: MAY 2004 SCALE: 1"=20'(H) 1"=6"(V) JOB NO.: 320-02
 DRAWN: G&A DESIGN: AKC REVIEWED: BRG DWG: 320TMPPO9

ARAPAHO ROAD PHASE III
 PLAN & PROFILE
STORM SEWER 'A' STA. 40+00 TO END

TOWN OF ADDISON

g&a Grantham & Associates, Inc. SHT. SW-10
 1919 S. SHILOH ROAD, SUITE 310, L.B. 8 GARLAND, TEXAS 75042 (972) 864-2333 (TEL) (972) 864-2334 (FAX)