




See REF #131
 ① Move Lights at 21' LT, 20' LT, 19' LT, 18' LT, and 17' LT to 16' LT.
 ② Move Lights at 14' RT to 13' RT.

LEGEND:

- TYPE A-1: NORTH ARCH FLOOD
- TYPE A-2: SOUTH ARCH FLOOD
- △ TYPE B: DIAPHRAGM LED
- TYPE C: PEDESTRIAN HANDRAIL LED
- TYPE D: DECK UNDERSIDE FLOOD
- GROUND BOX
- JUNCTION BOX
- TYPE F: NORTH AND SOUTH ROADWAY LIGHTS (20')
- TYPE G: NORTH ROADWAY LIGHTS (35')
- RMC CONDUIT - SIZE PER CONDUIT & CABLE SCHEDULE
- PVC CONDUIT - SIZE PER CONDUIT & CABLE SCHEDULE
- ==== 2" PVC SCH 80 CONDUIT SLEEVE
- PS "X": PEDESTAL SERVICE "X"
- FUSED DISCONNECT SWITCH

GENERAL NOTES:

1. PROVIDE LUMINAIRES, POLES, BASES, CONCRETE FOUNDATIONS AND CIRCUITRY AT EACH LOCATION SHOWN. REFER TO ILLUMINATION SUMMARY AND CONDUIT & CABLE SCHEDULE FOR ADDITIONAL INFORMATION.
2. SEE LIGHT POLE DETAILS IN STRUCTURAL SECTION PLANS.
3. ALL SPLICES SHALL BE MADE IN THE POLE BASE, FIXTURE BASE, IN THE GROUND BOX, OR JUNCTION BOX.
4. ALL METAL CONDUITS, METAL ENCLOSURES, BOXES, POLE BASES AND LUMINAIRE HOUSING SHALL BE GROUNDED.
5. ALL EXISTING UTILITY LOCATIONS ARE APPROXIMATE, CONTRACTOR SHALL VERIFY EXACT LOCATIONS.
6. ALL STATION AND OFFSETS ARE FROM CENTERLINE OF ARAPAHO ROAD, AND ASSOCIATED MARKINGS.
7. ALL STREET POLES SHALL BE CONTINUOUSLY GROUNDED TO THE ELECTRICAL SERVICE GROUND CONDUCTOR SYSTEM.

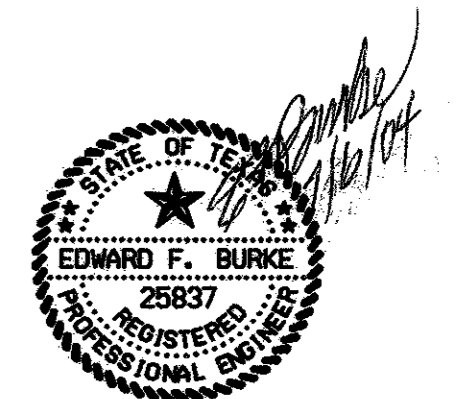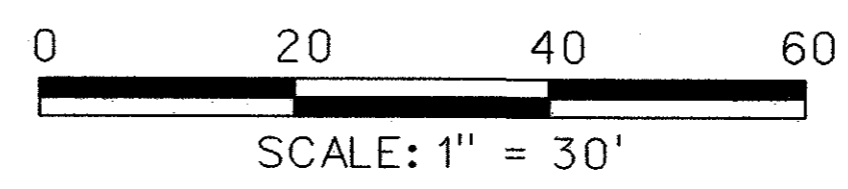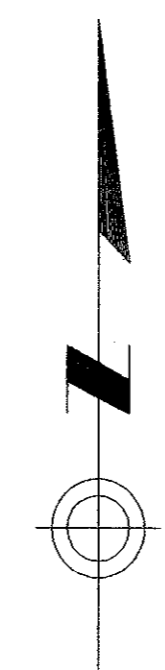

				325	
NO.	DATE	REVISION	APPROV.		
URS GREYSTONE CENTRE 3000 LBJ FREEWAY, SUITE 1500 DALLAS, TX 75234					
ARAPAHO ROAD - PHASE III					
SURVEYOR BOULEVARD TO ADDISON ROAD					
BRIDGE LIGHTING PLAN 240 AND 120 V					
SHEET 4 OF 4					
TOWN OF ADDISON, TEXAS					
Design	EFB	Drawn	DT	DATE	SCALE
Check	Check	05-07-04	25768	BL-4	

7/1/2004 3:32:29 PM

\\urs-sd1\dal\data\projects\arapaho_road_bridg\road\proj\ar3\bl04e.dgn