


LEGEND:

- GROUND BOX
- TYPE C: PEDESTRIAN HANDRAIL LED
- CONDUIT: SEE CONDUIT SCHEDULE FOR SIZE
- ▶ FUSED DISCONNECT SWITCH

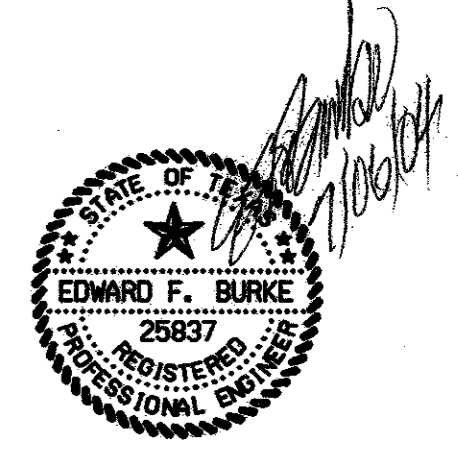

				339	
1	05/24/04	ADDENDUM CHANGES		CRH	
NO.	DATE	REVISION		APPROV.	
URS GREYSTONE CENTRE 3010 LBJ FREEWAY, SUITE 1500 DALLAS, TX 75234					
ARAPAHO ROAD - PHASE III SURVEYOR BOULEVARD TO ADDISON ROAD					
WIRING DIAGRAM TYPE "C" LED DRIVERS					
TOWN OF ADDISON, TEXAS					
Design	EFB	Drawn	DT	DATE	SCALE
Check	Check			05-07-04	
				PROJECT NO.	SHEET NO.
				25768	BL - 18

7/1/2004 3:32:25 PM

I:\rsd\del1\data\projects\arapaho_road_brl\lodge\cadd\from_cust\in\05-06-04\ar3240v4c4_leds1.cui+.dgn