

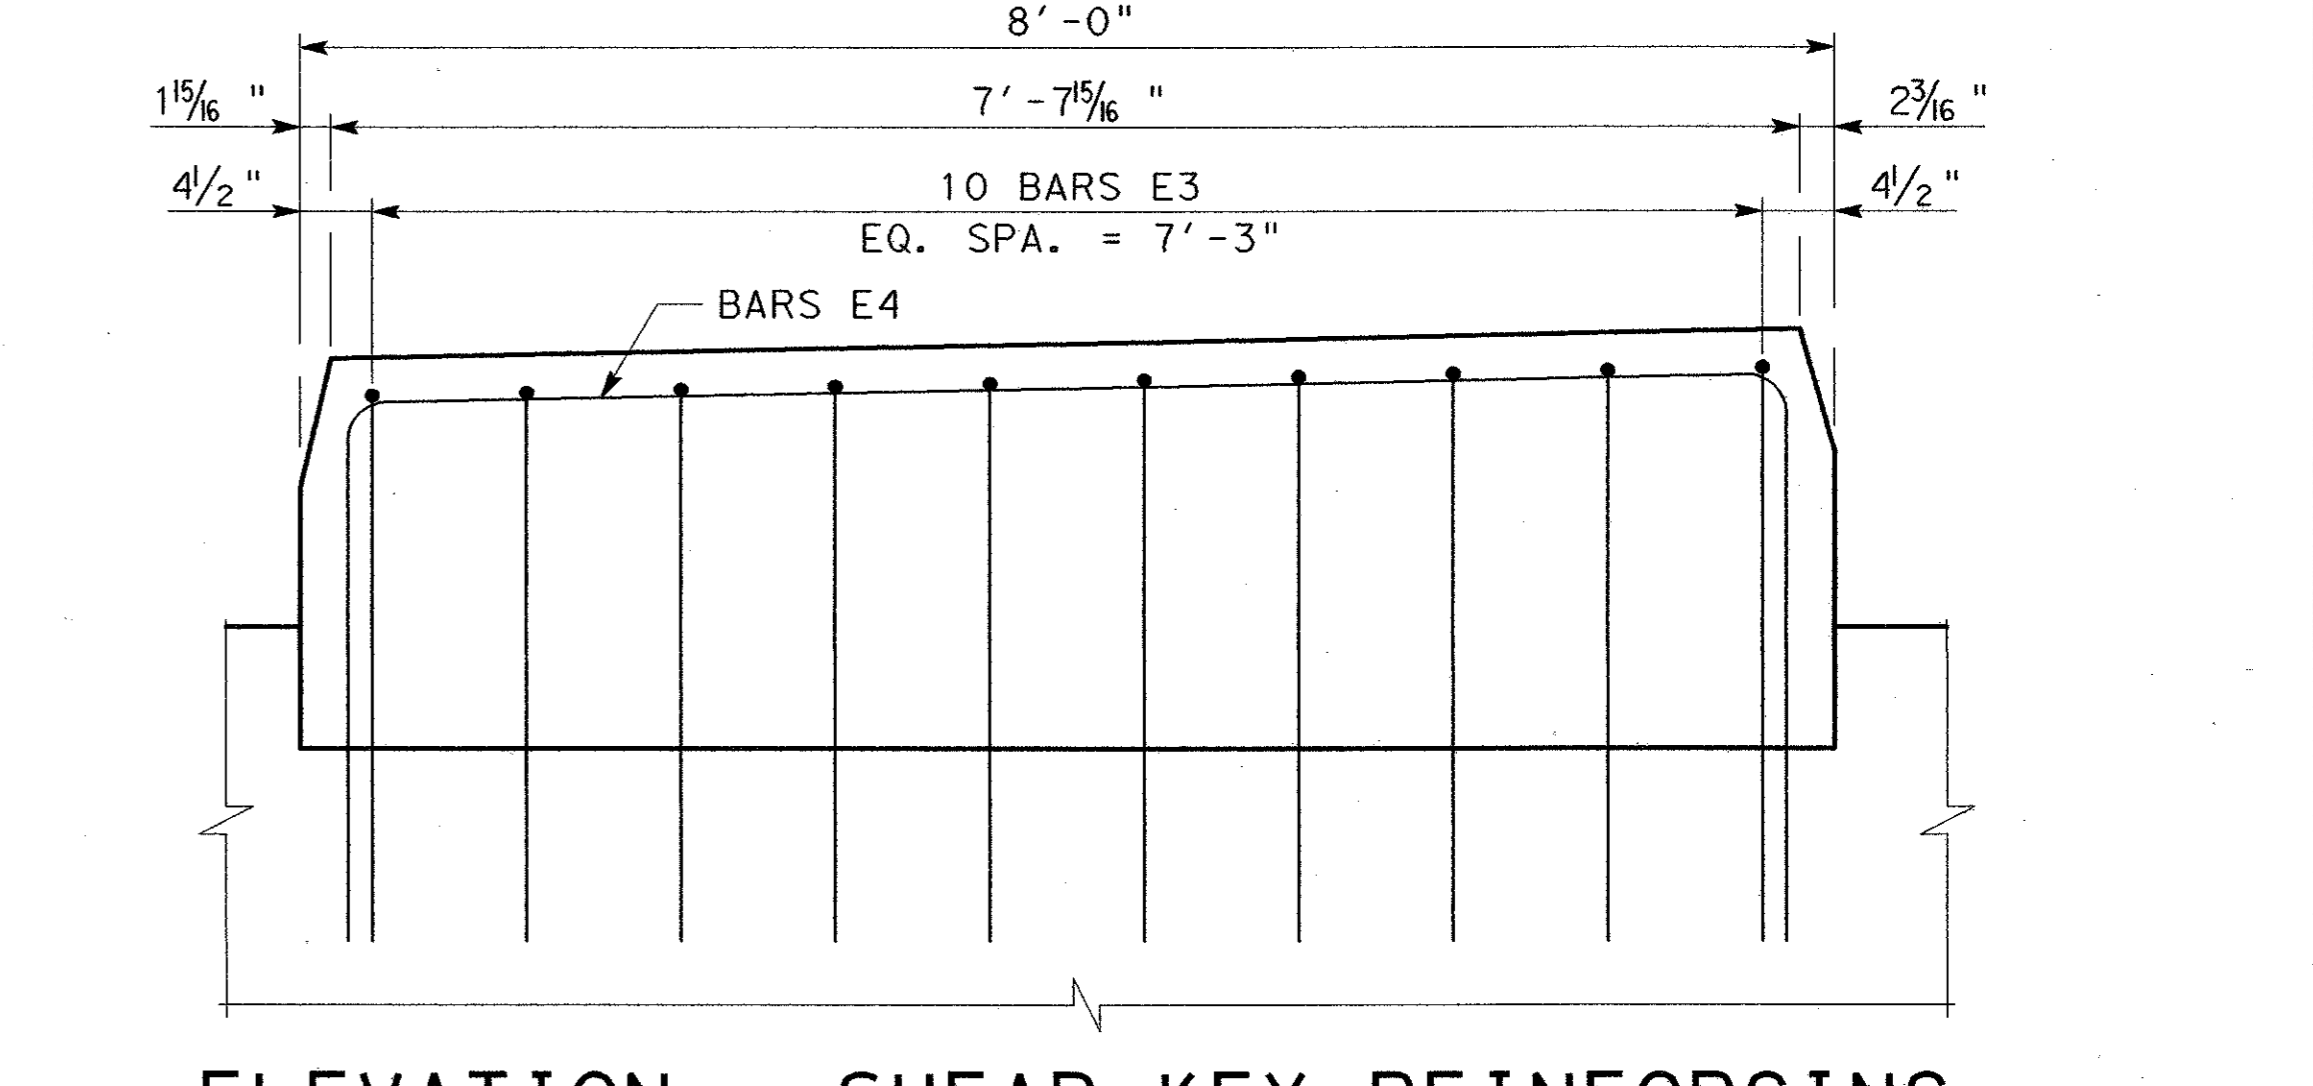
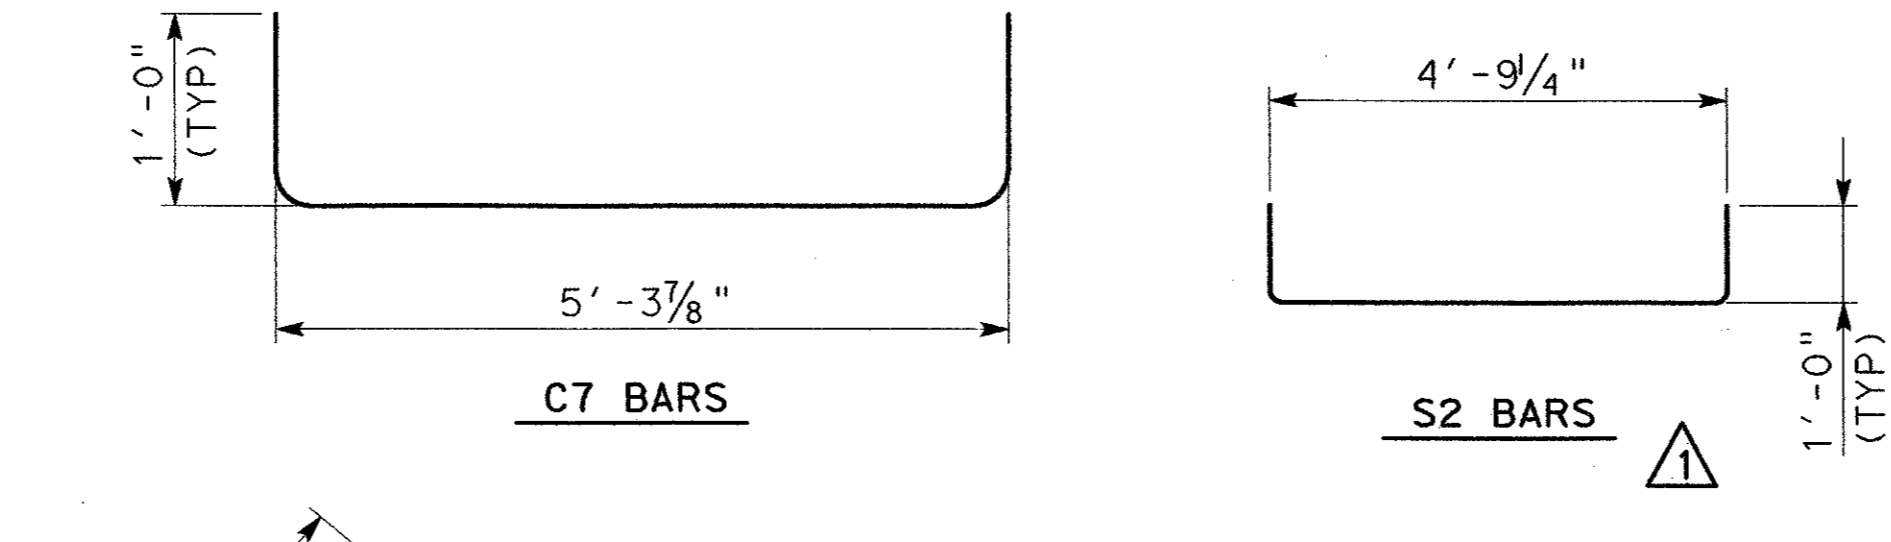
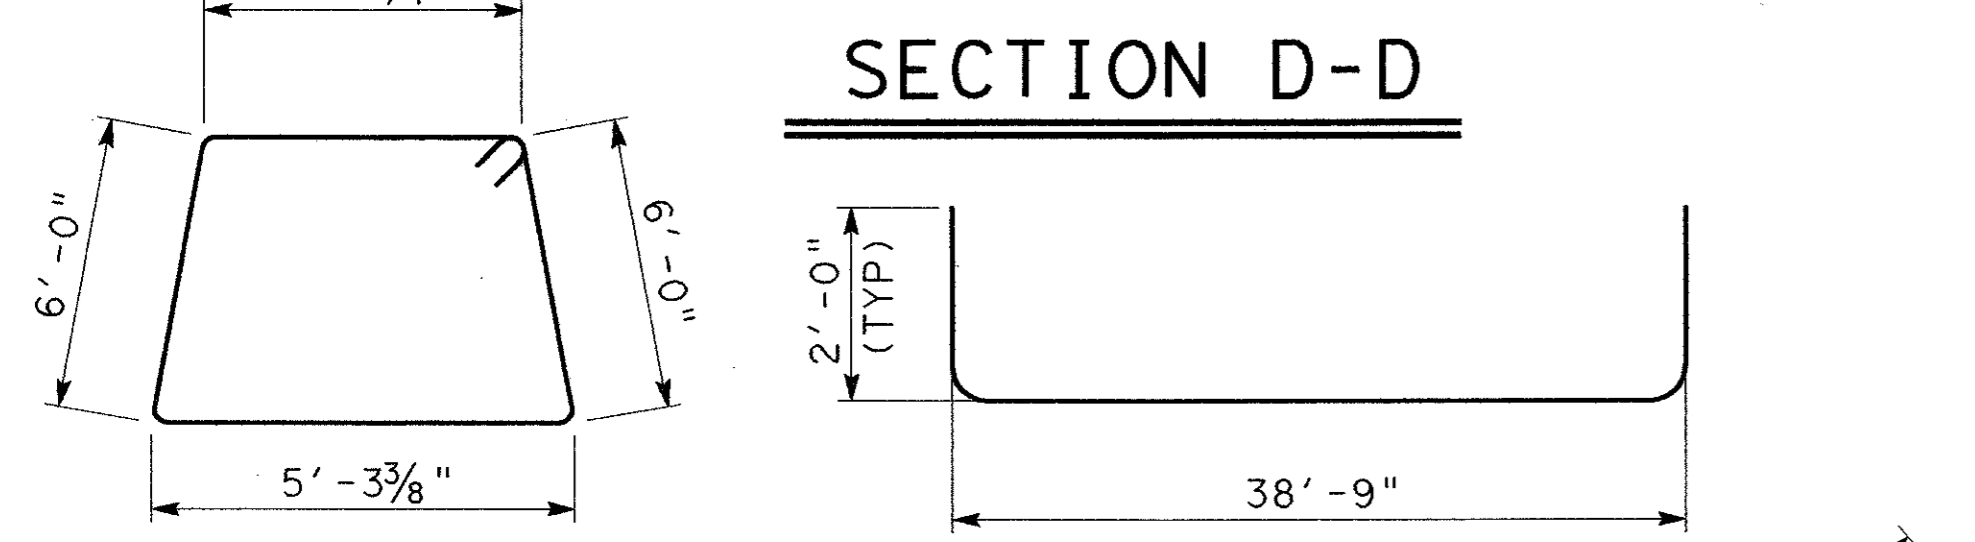


**SECTION C-C**


**PLAN - SHEAR KEY REINFORCING**

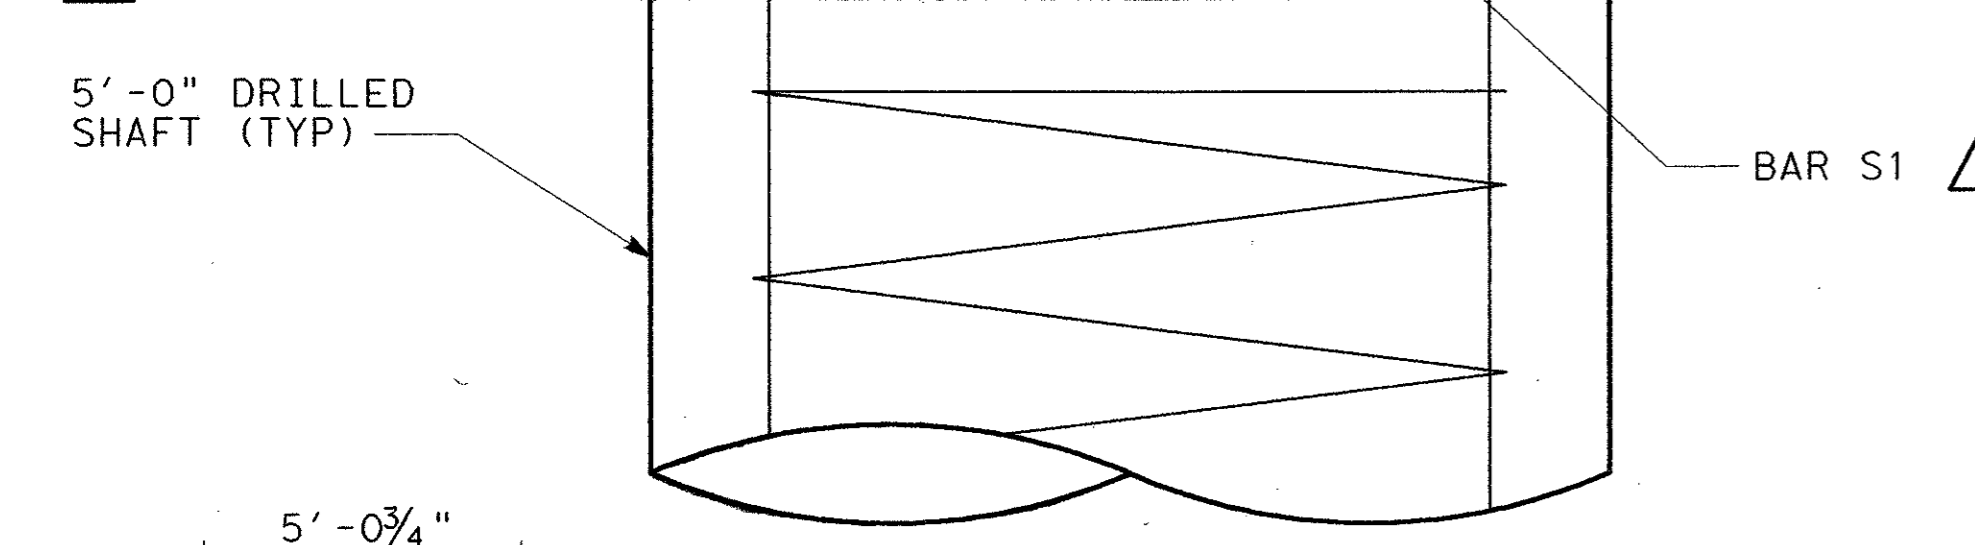


**ELEVATION - SHEAR KEY REINFORCING**

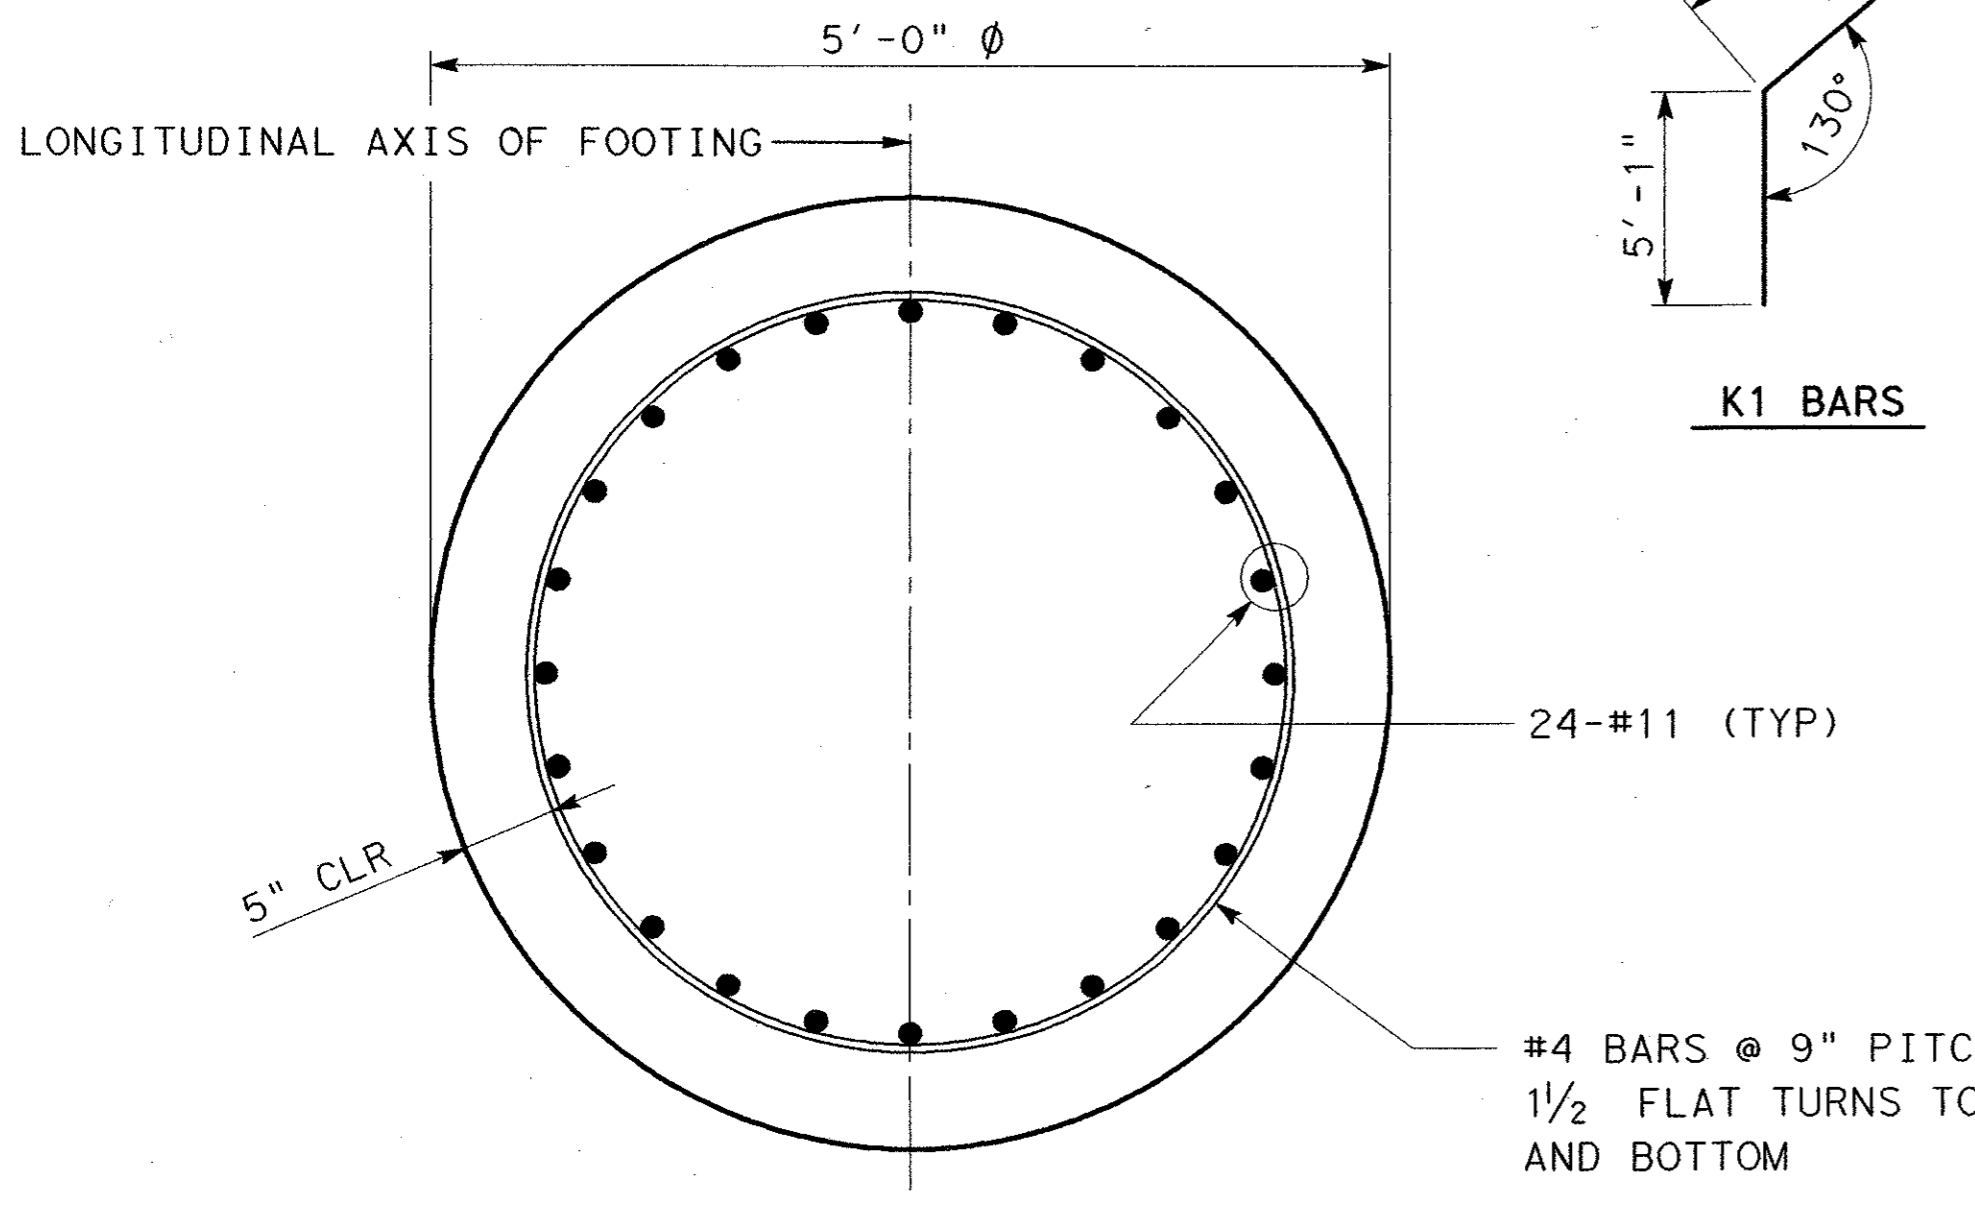

**SECTION E-E**

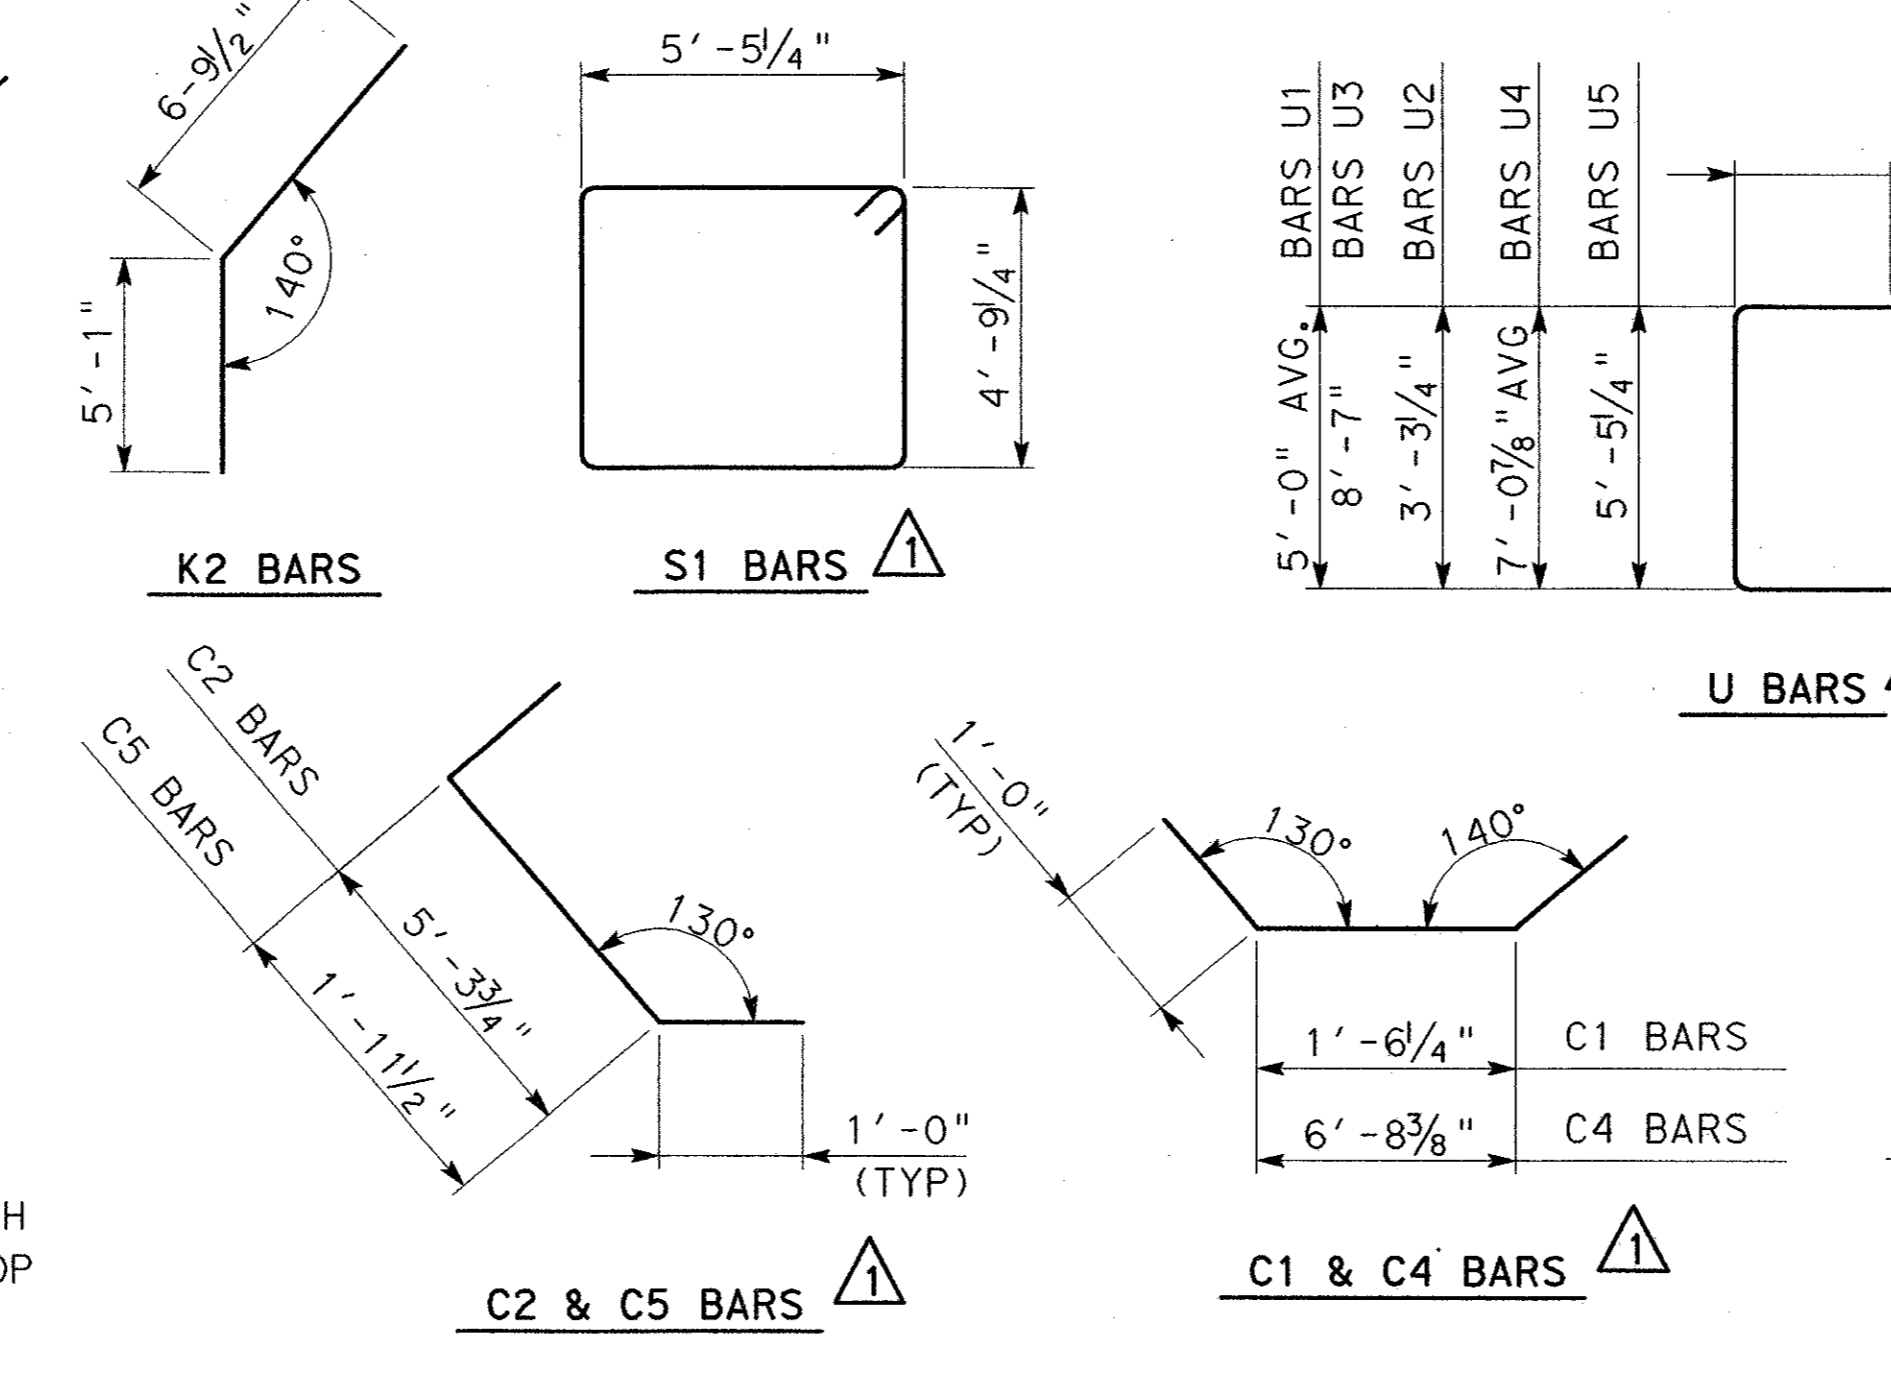

**REINFORCING BAR BEND DETAILS**

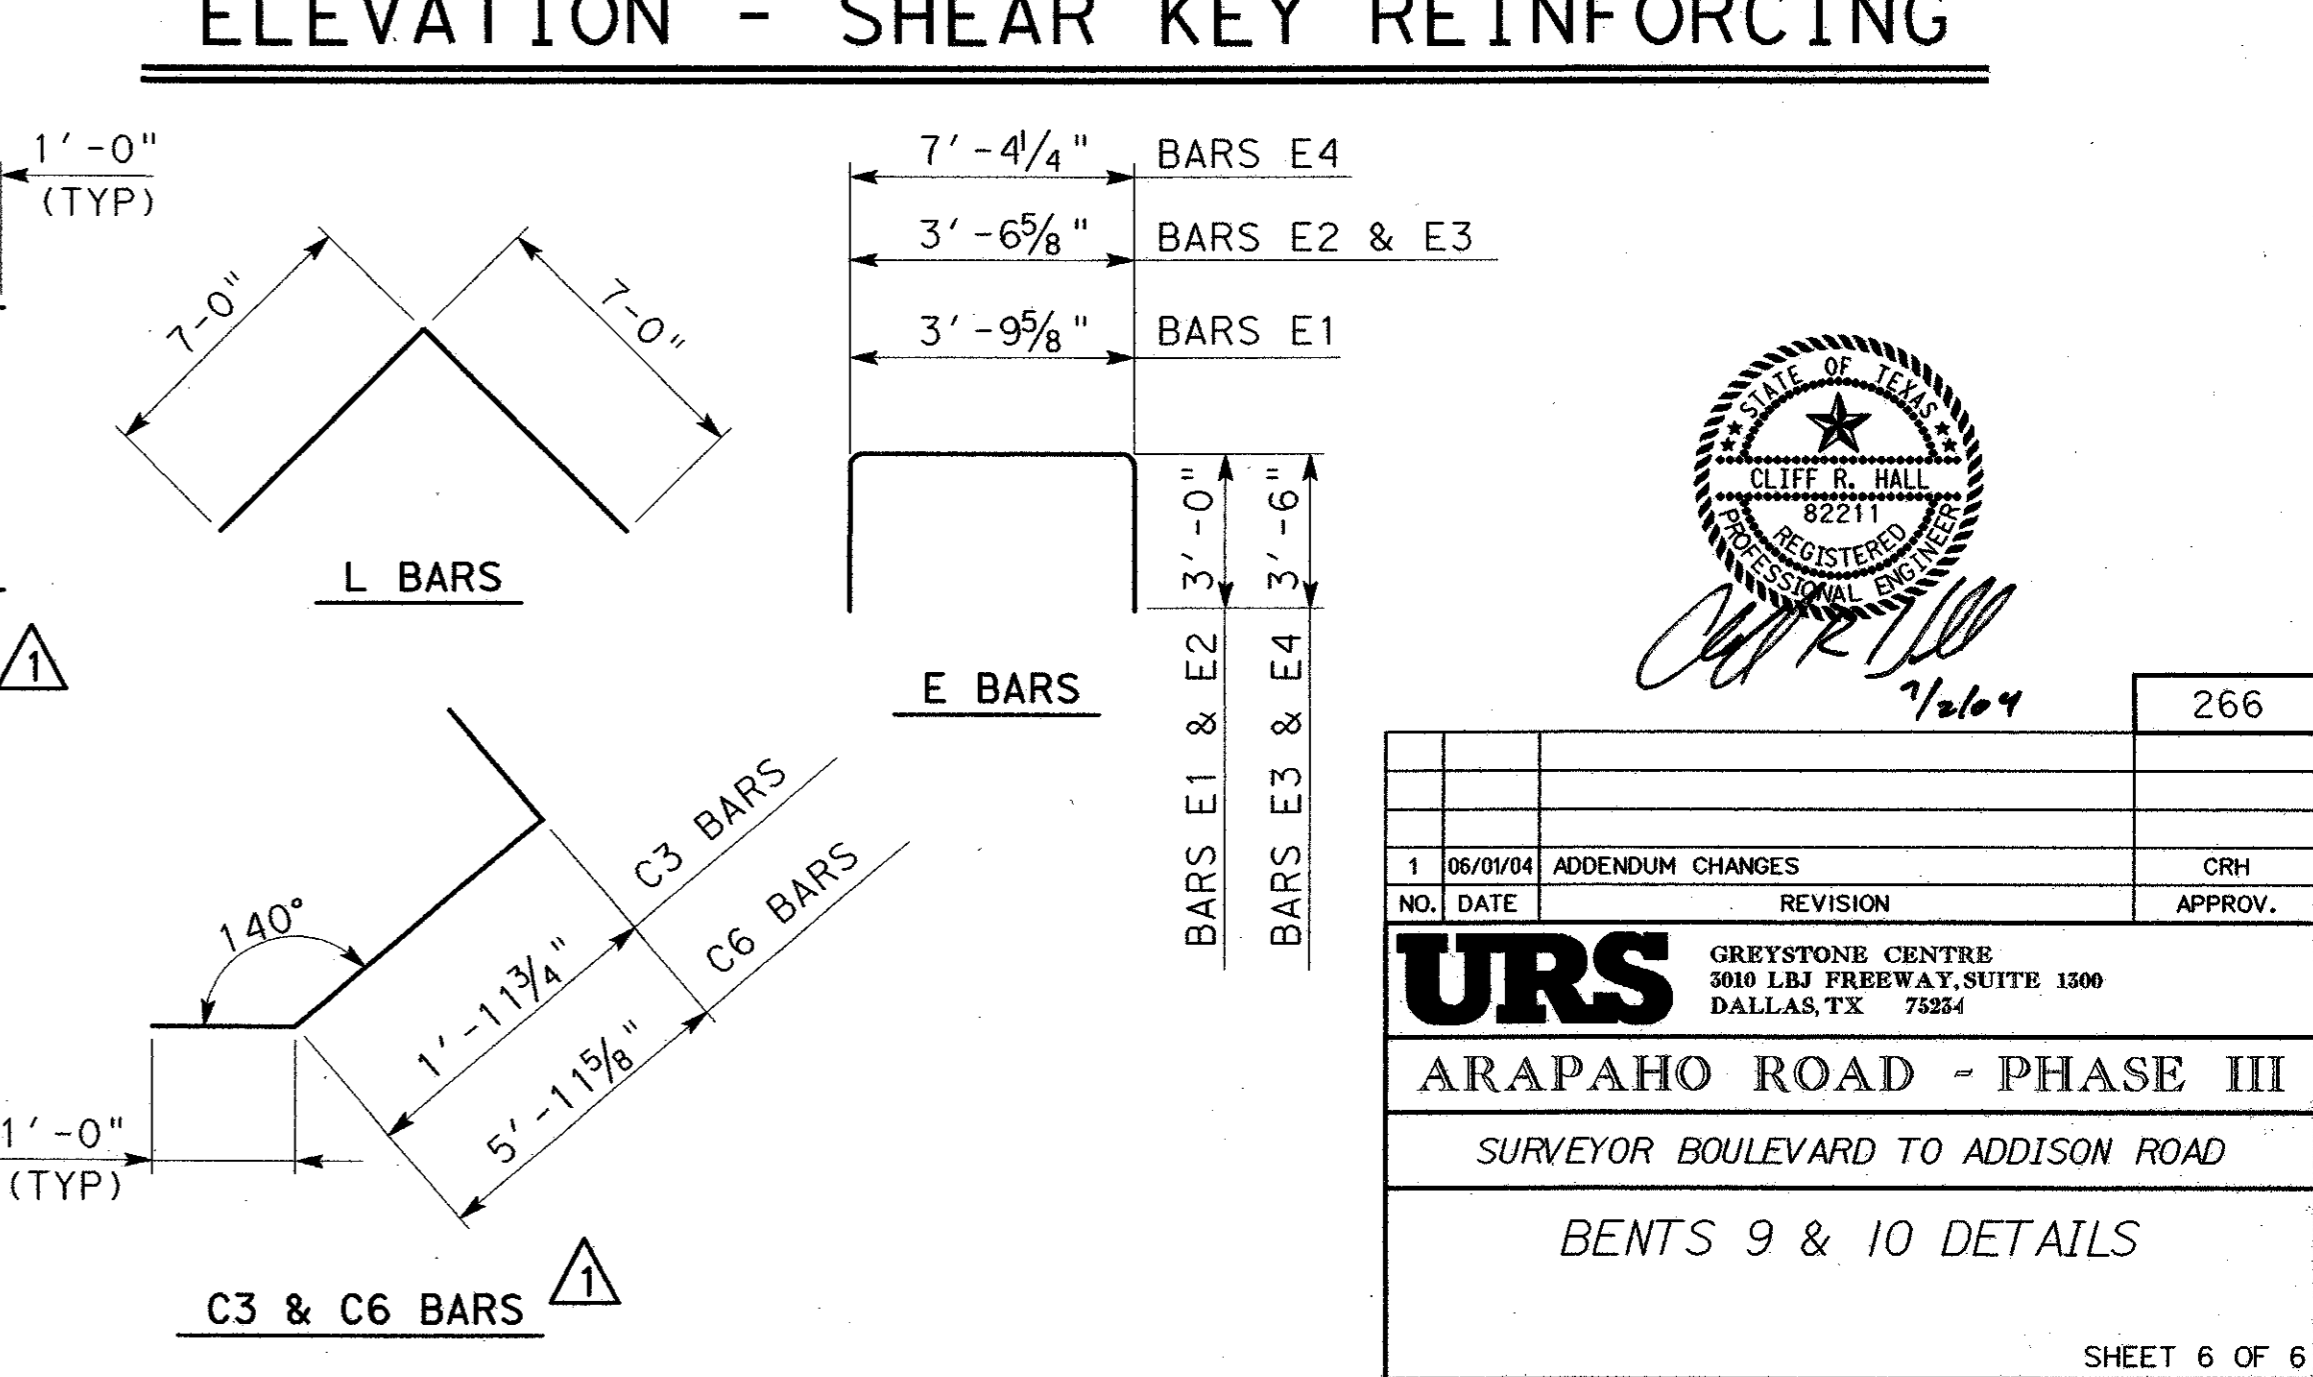

NO.		DATE	ADDENDUM CHANGES	REVISION	CRH	APPROV.
1		06/01/04				
DESIGN		DRAWN	RJB	DATE	SCALE	PROJECT NO. SHEET NO.
Check		Check		05-07-04	NONE	25768 BR-28

**URS**  
 GREYSTONE CENTRE  
 3010 LBJ FREEWAY, SUITE 1300  
 DALLAS, TX 75254

**ARAPAHO ROAD - PHASE III**  
 SURVEYOR BOULEVARD TO ADDISON ROAD

**BENTS 9 & 10 DETAILS**

TOWN OF ADDISON, TEXAS

SHEET 6 OF 6

7/22/2004 3:31:42 PM

U:\sda\lde\l\proj\arapaho\proj\arapaho\_r\road\_bridges\cadd\from\_tampo\05-24-04-ar3pd0406.dgn