


SECTION D-D



SECTION E-E

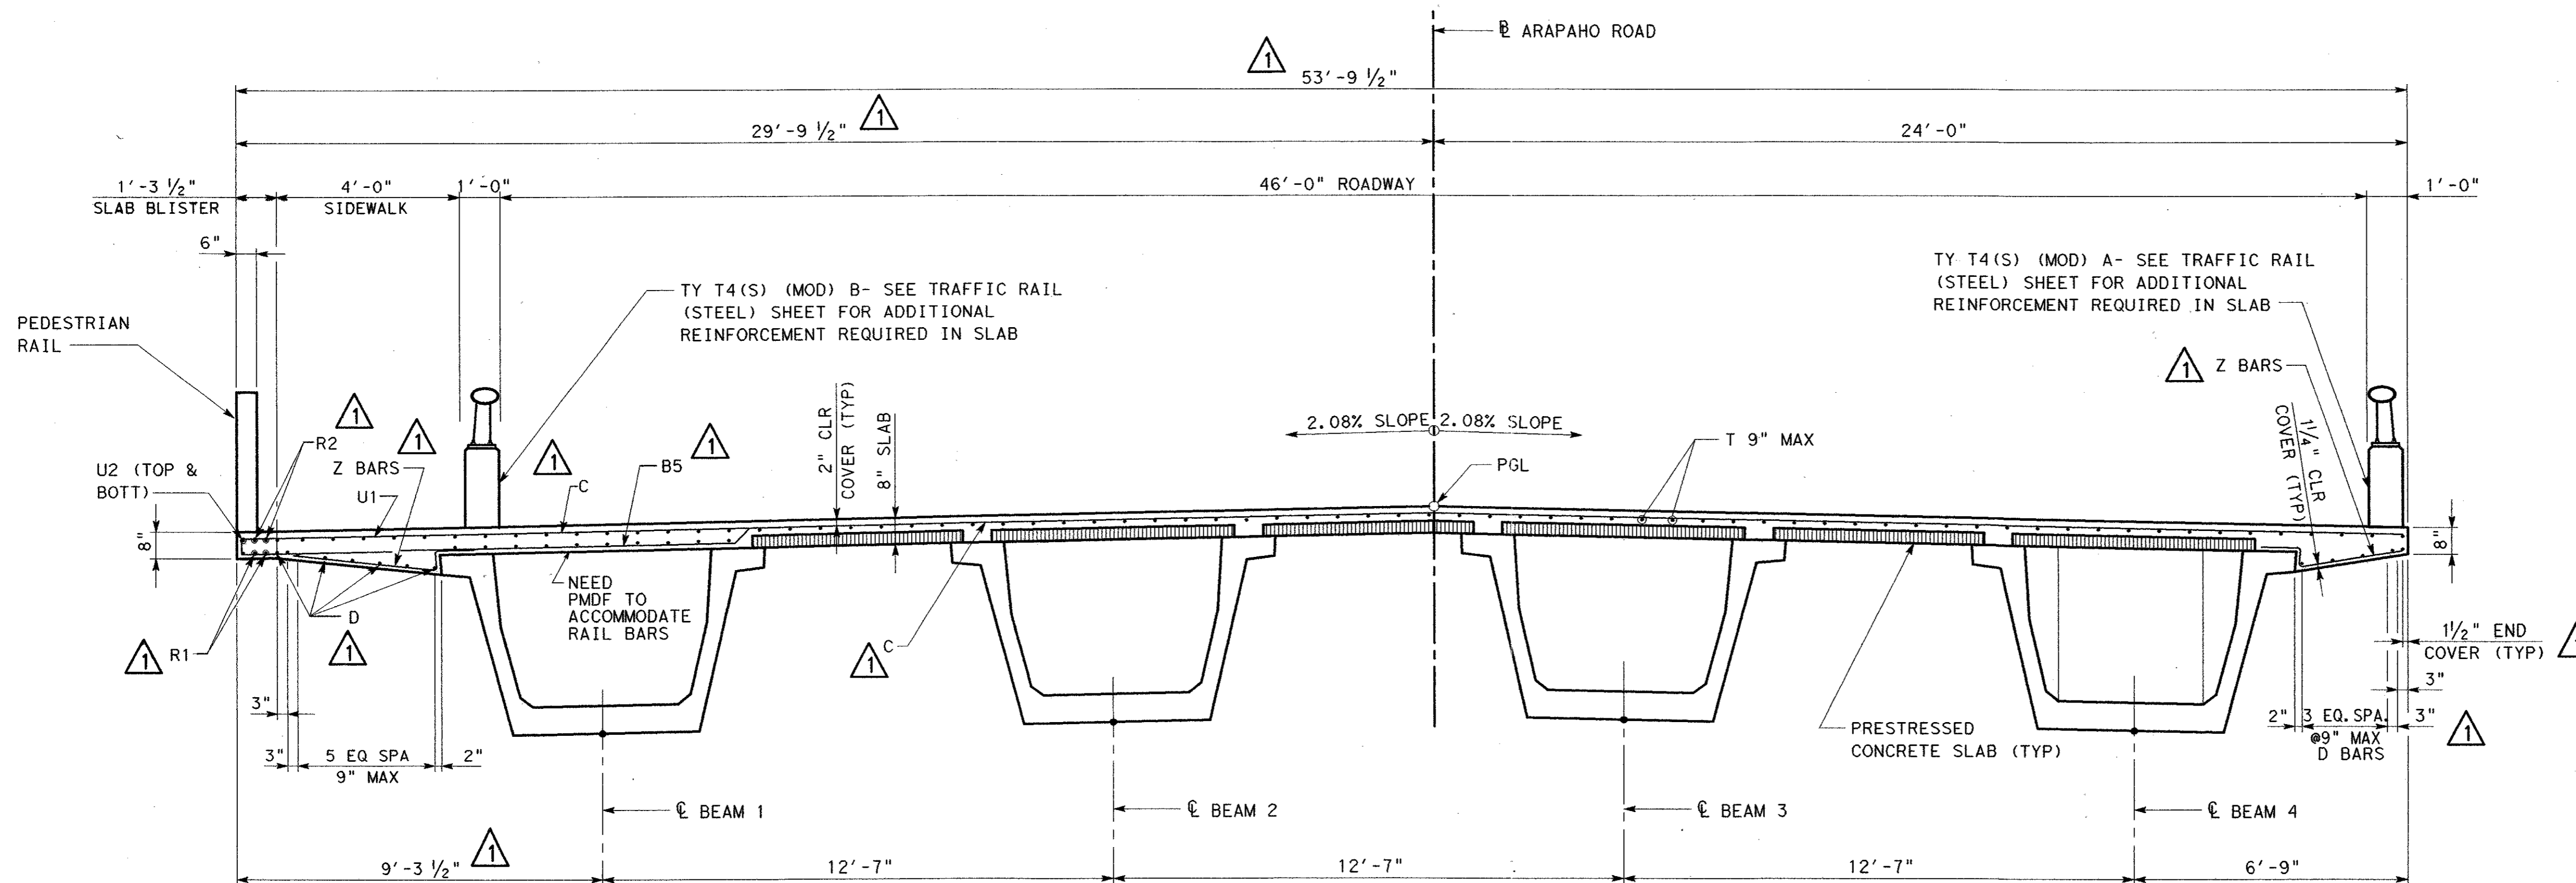

295	
1	05/24/04
ADDENDUM CHANGES	CRH
NO.	DATE
REVISION	APPROV.
URS	
GREYSTONE CENTRE 3010 LBJ FREEWAY, SUITE 1300 DALLAS, TX 75234	
ARAPAHO ROAD - PHASE III	
SURVEYOR BOULEVARD TO ADDISON ROAD	
SLAB DETAILS	
SHEET 4 OF 4	
TOWN OF ADDISON, TEXAS	
Design	Drawn
Check	Check
DATE	SCALE
PROJECT NO.	SHEET NO.
25768	BR-57

7/2/2004 10:33:04 AM

I:\projects\addison\road_bridges\road_structures\slab_details\slab3-4s0301.dgn