


GENERAL NOTES:

1. CONTRACTOR TO REMOVE ALL EXISTING PARKING STRIPES LOCATED WITH IN THE PROJECT LIMITS
2. CONTRACTOR TO STRIPE PROPOSED PARKING LOT AS SHOWN ON PLANS, NO PAVEMENT RECONSTRUCTION FOR NEW PARKING LOT.

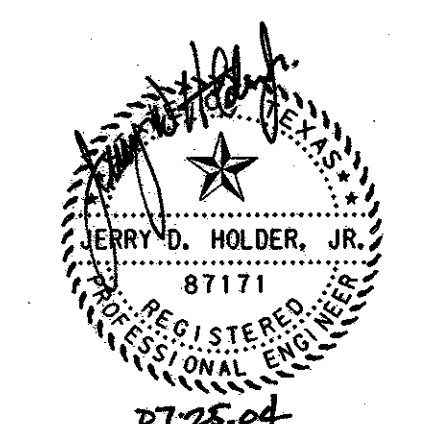

				56
NO.	DATE	REVISION	APPROV.	
HNTB ARCHITECTS ENGINEERS PLANNERS The HNTB Companies ARAPAHO ROAD - PHASE III SURVEYOR BOULEVARD TO ADDISON ROAD PARKING LAYOUT 4125 CENTURIAN WAY TOWN OF ADDISON, TEXAS				
Design JSN	Drawn GFS	DATE	SCALE	PROJECT NO. SHEET NO.
Check JDH	Check JSN	APRIL 04	H: 1" = 10'	25768 PK-1

29-JUN-2004 12:29 G:\25768-ph3\h1\cds\var3pk01.dgn