


SEE PFI #623
 INSTALL CURB AND GUTTER AT TIE-IN
 TO EXISTING PARKING LOT PER INTEGRAL
 CURB AND GUTTER WITH LONGITUDINAL BUTT
 JOINT DETAILS AS SHOWN ON SHEET #65.

NOTE:
 1. SEE REMOVAL PLANS FOR DEMOLITION
 IN THIS AREA.
 2. SEE SHEET G-3 FOR PARKING GRADING
 PLAN.

LEGEND

- PROPOSED SOLID 4" WHITE STRIPE
- x- PROPOSED CHAIN LINK FENCE
- WHEEL STOP
- PROPOSED PARKING LOT PAVEMENT

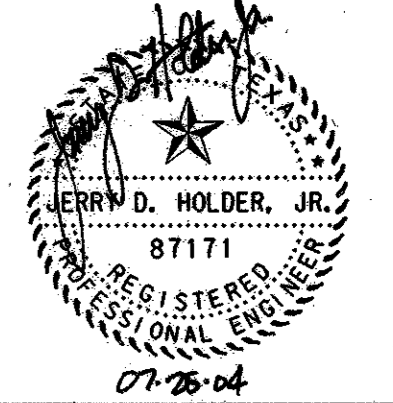

NO.	DATE	REVISION	APPROV.
HNTB ARCHITECTS ENGINEERS PLANNERS The HNTB Companies			
ARAPAHO ROAD - PHASE III			
SURVEYOR BOULEVARD TO ADDISON ROAD			
PARKING LAYOUT THE RINK			
TOWN OF ADDISON, TEXAS			
Design JSN	Drawn GFS	DATE	SCALE
Check JDH	Check JSN	APRIL 04	H: 1"= 20'
PROJECT NO.	SHEET NO.		
25768	PK-4		

29-JUN-2004 12:30
 G:\25768-ph3\h1\Cad\ar3pk04.dgn