
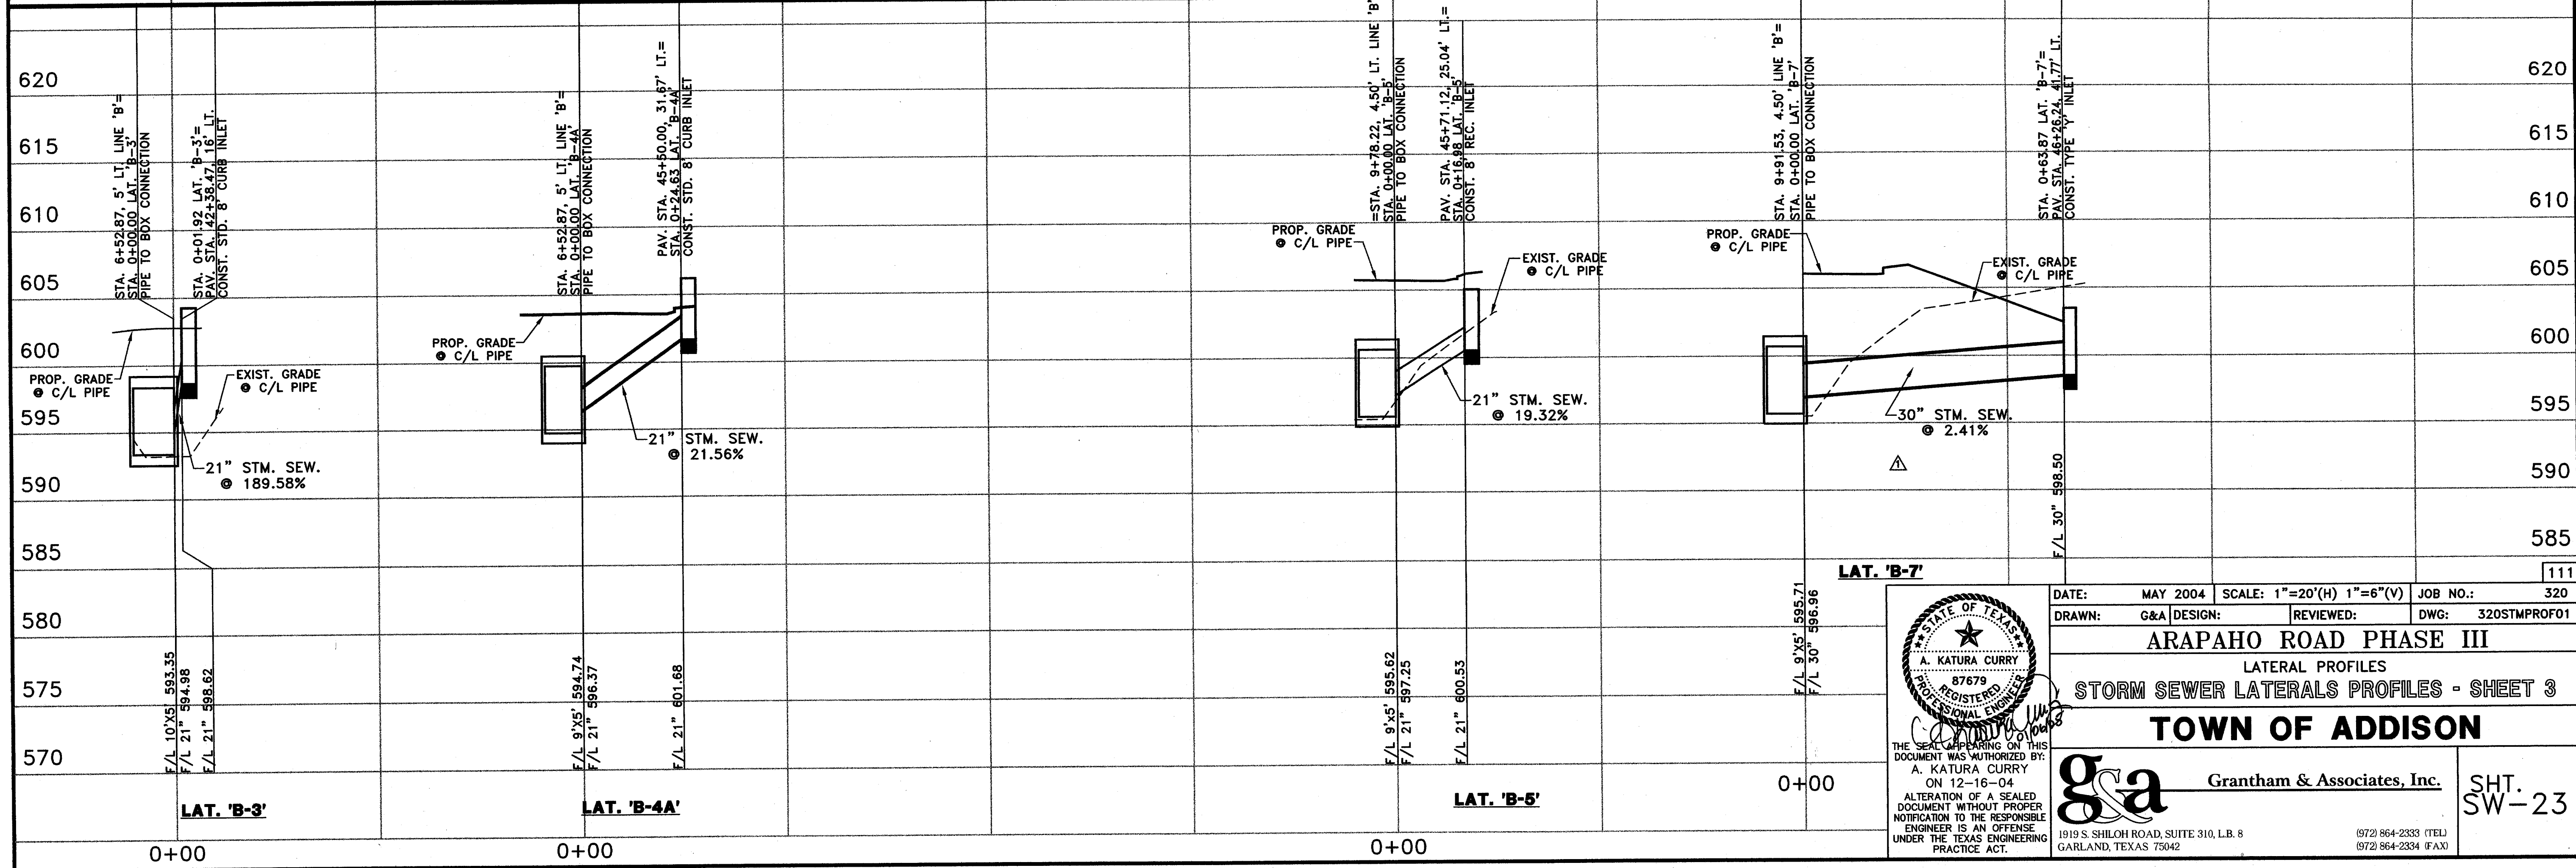


NO.	DATE	REVISION	APPROV.
1	12/15/04	REVISED PER RFI #40	
2			
3			

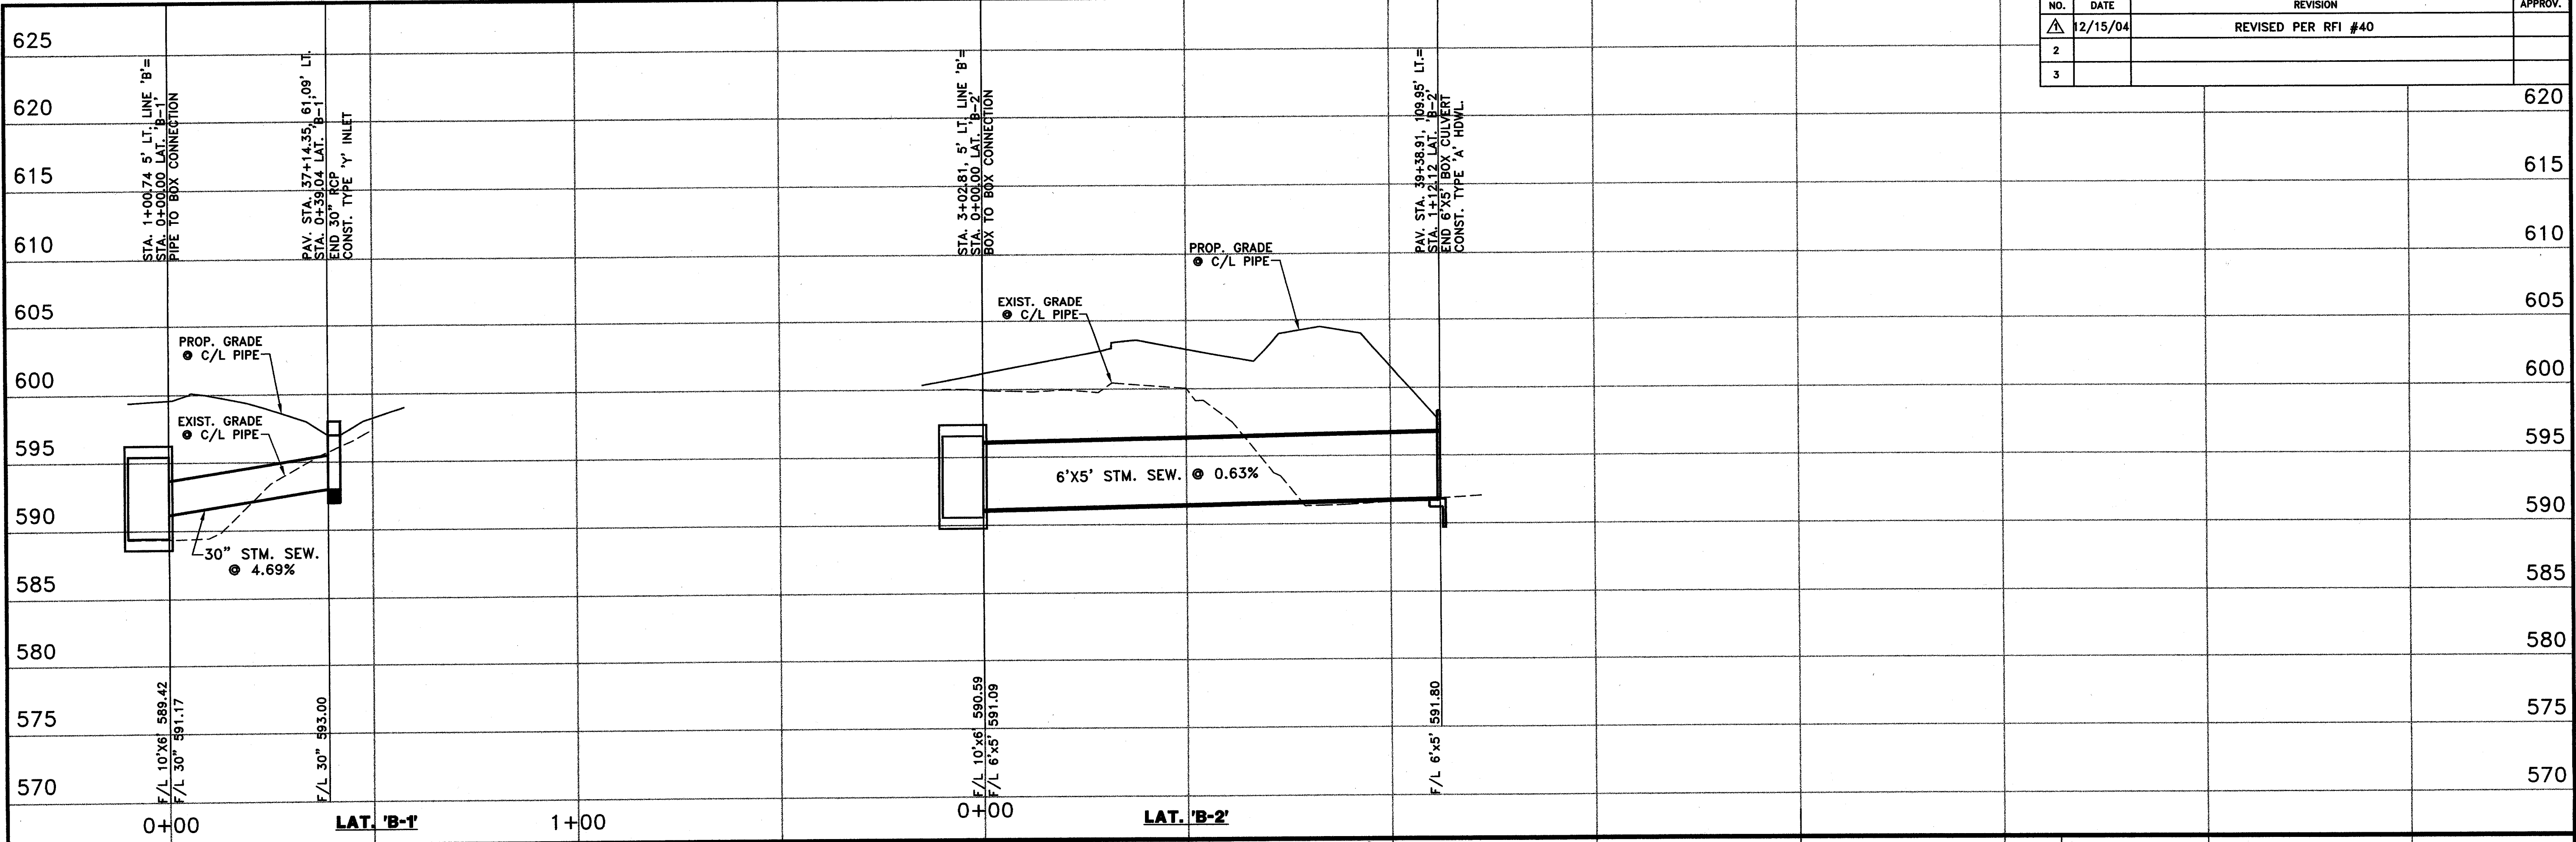

THE SEAL APPEARING ON THIS DOCUMENT WAS AUTHORIZED BY:
 A. KATURA CURRY
 ON 12-16-04
 ALTERATION OF A SEALED DOCUMENT WITHOUT PROPER NOTIFICATION TO THE RESPONSIBLE ENGINEER IS AN OFFENSE UNDER THE TEXAS ENGINEERING PRACTICE ACT.

DATE: MAY 2004 SCALE: 1"=20'(H) 1"=6"(V) JOB NO.: 320
 DRAWN: G&A DESIGN: REVIEWED: DWG: 320STMPROF01

ARAPAHO ROAD PHASE III
 LATERAL PROFILES
STORM SEWER LATERALS PROFILES - SHEET 3

TOWN OF ADDISON

g&a Grantham & Associates, Inc. **SHT. SW-23**
 1919 S. SHILOH ROAD, SUITE 310, L.B. 8 GARLAND, TEXAS 75042 (972) 864-2333 (TEL) (972) 864-2334 (FAX)