



NO.	DATE	REVISION	APPROV.
1	06/28/04	REVISED PROFILE PER G & A	A.K.C.
2	09/03/04	ADDED INLET, LATERAL, & SLOT DRAIN	A.K.C.

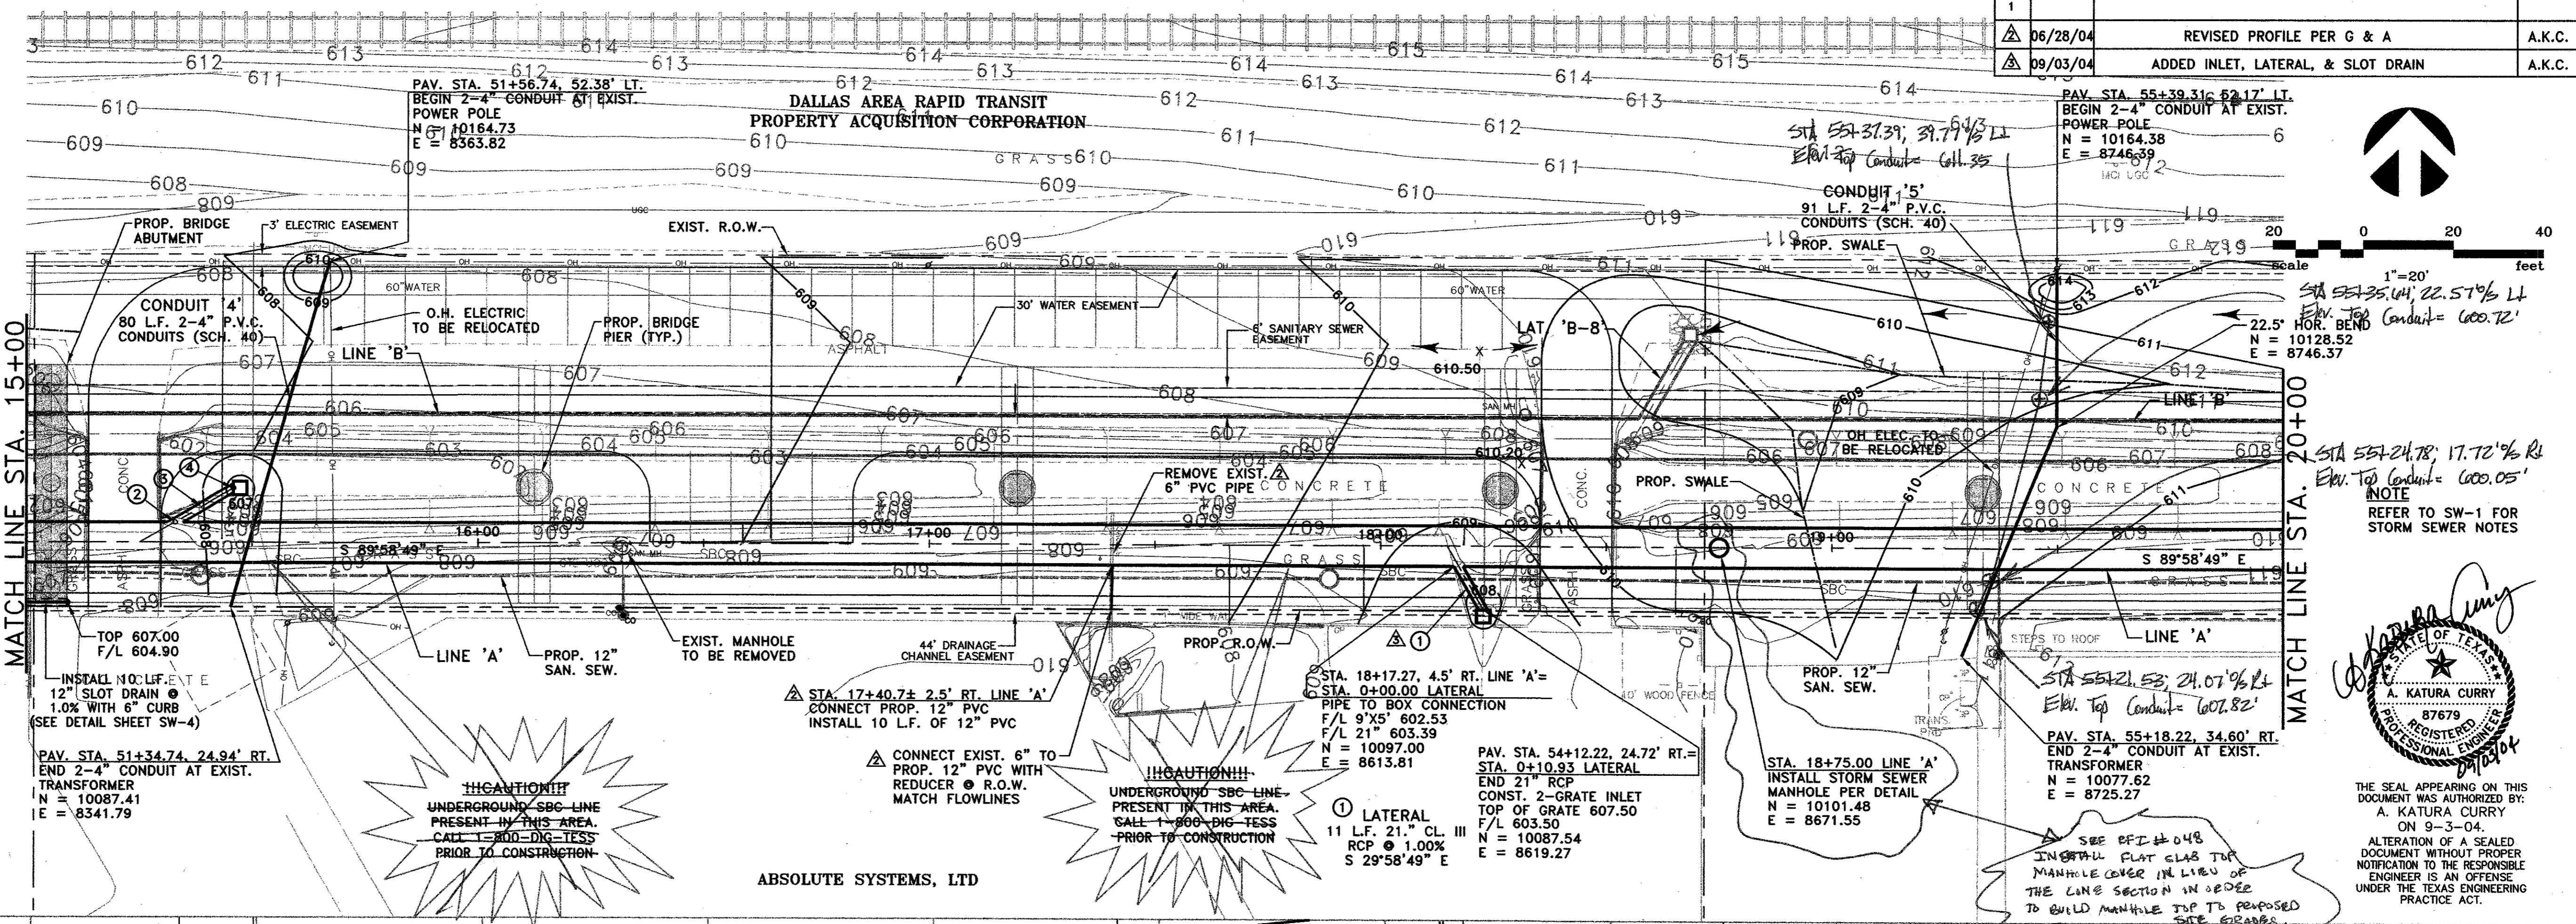


- ② STA. 15+32.93, 4.5' LT. LINE 'A' = STA. 0+00.00 LATERAL 'A' PIPE TO BOX CONNECTION  
F/L 9'x5' 600.54  
F/L 21' 602.16  
N = 10106.10  
E = 8329.48
- ③ LATERAL 'A'  
15 L.F. 21" CL. III  
RCP @ 5.64%  
N 60°01'11" E
- ④ PAV. STA. 51+35.32, 1.20' LT. = STA. 0+14.90 LATERAL 'A' END 21" RCP CONST. TYPE 'Y' INLET TOP OF INLET 608.00 THROAT 607.00 F/L 603.00  
N = 10113.55  
E = 8342.38

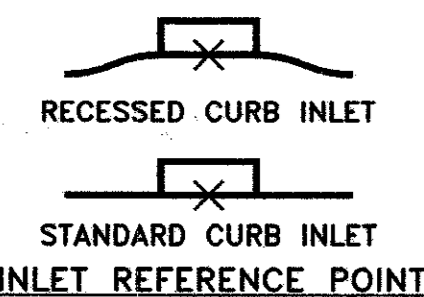


**CAUTION!!!**  
UNDERGROUND SBC LINE PRESENT IN THIS AREA. CALL 1-800-DIG-TESS PRIOR TO CONSTRUCTION.

**CAUTION!!!**  
UNDERGROUND SBC LINE PRESENT IN THIS AREA. CALL 1-800-DIG-TESS PRIOR TO CONSTRUCTION.

ABSOLUTE SYSTEMS, LTD

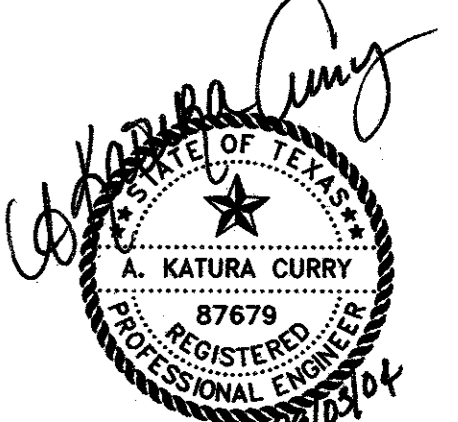

THE SEAL APPEARING ON THIS DOCUMENT WAS AUTHORIZED BY: A. KATURA CURRY ON 9-3-04. ALTERATION OF A SEALED DOCUMENT WITHOUT PROPER NOTIFICATION TO THE RESPONSIBLE ENGINEER IS AN OFFENSE UNDER THE TEXAS ENGINEERING PRACTICE ACT.

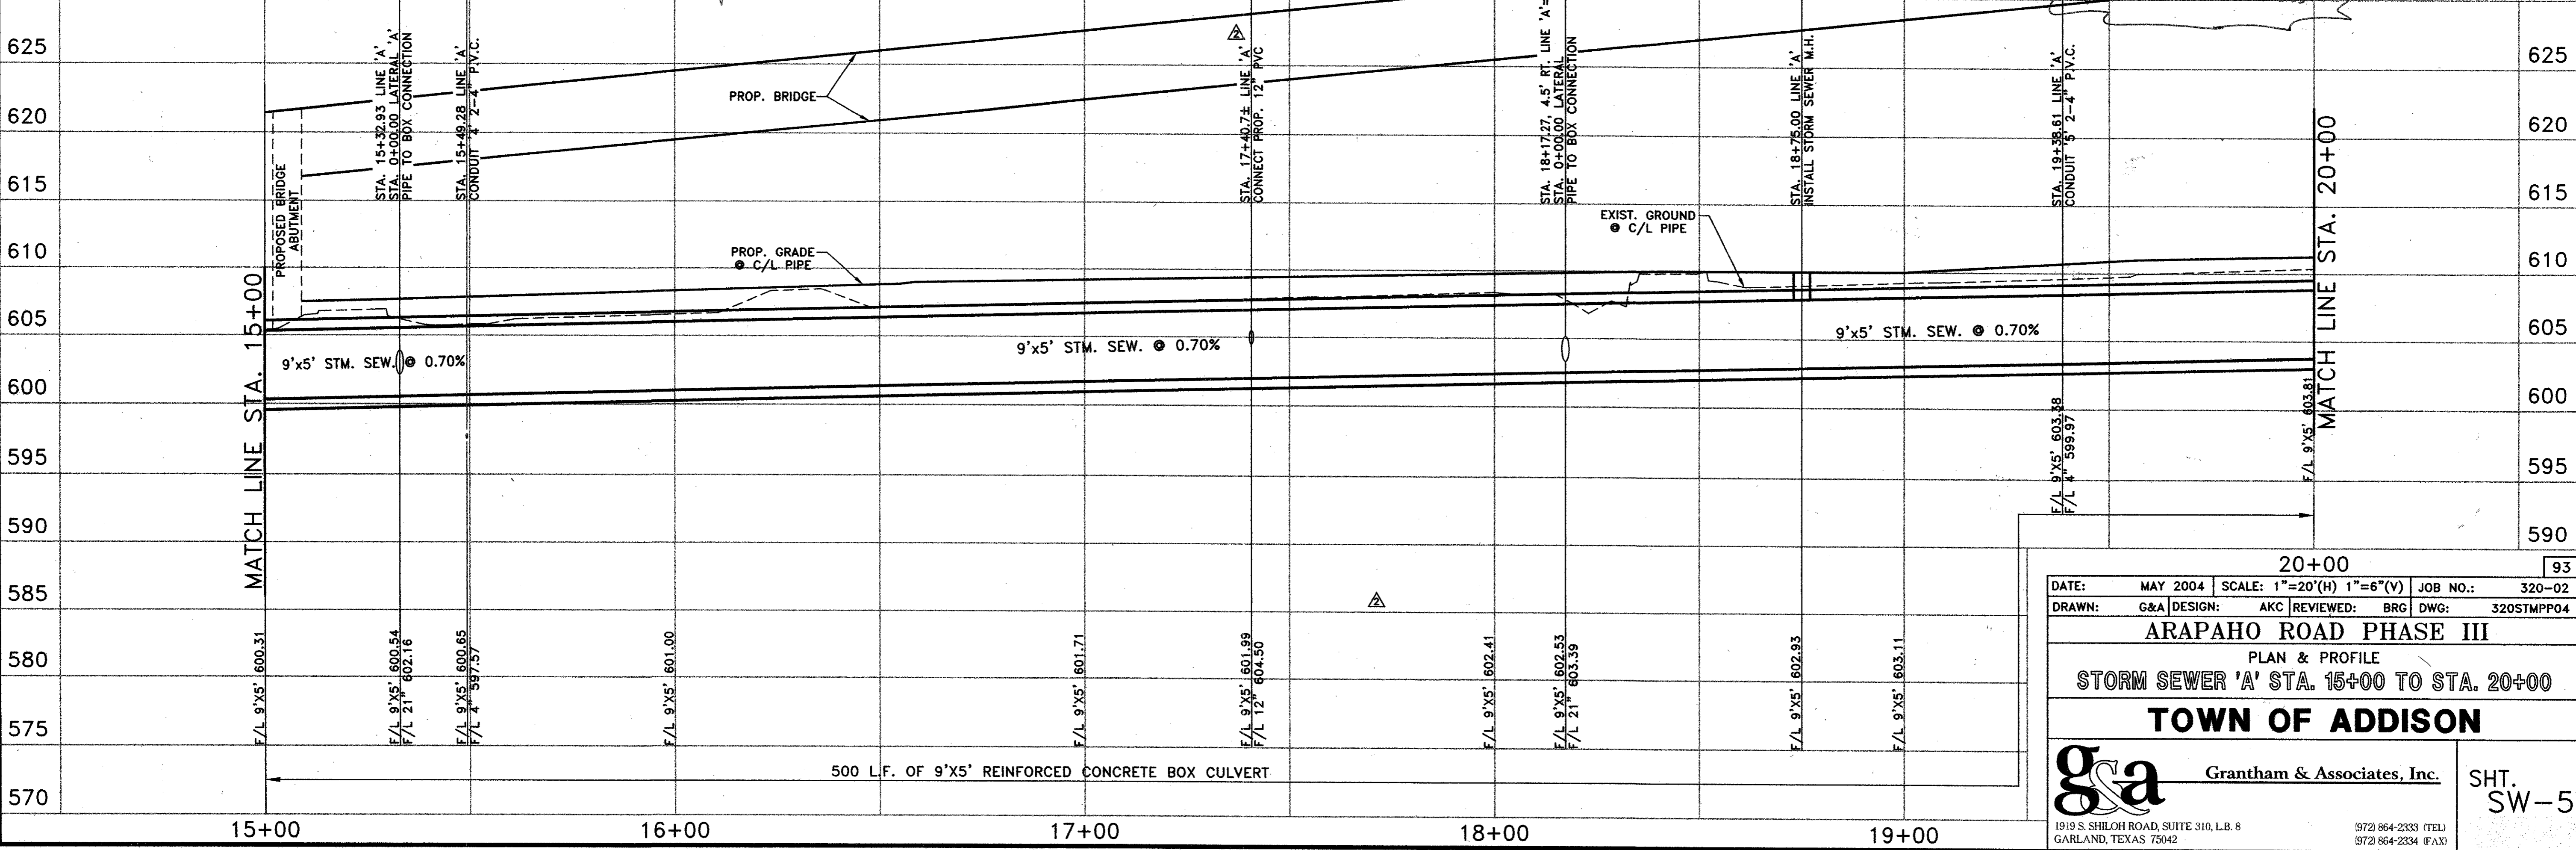

20+00 93

DATE: MAY 2004 SCALE: 1"=20'(H) 1"=6'(V) JOB NO.: 320-02  
 DRAWN: G&A DESIGN: AKC REVIEWED: BRG DWG: 320STMP04

**ARAPAHO ROAD PHASE III**  
 PLAN & PROFILE  
**STORM SEWER 'A' STA. 15+00 TO STA. 20+00**  
**TOWN OF ADDISON**

**g&a** Grantham & Associates, Inc. SHT. SW-5  
 1919 S. SHILOH ROAD, SUITE 310, L.B. 8 GARLAND, TEXAS 75042 (972) 864-2333 (TEL) (972) 864-2334 (FAX)