


Revised CD 1/13/05
 FF-18.pdf

FF-18



ELECTRIC DELIVERY

SCALE	LIST OF DRAWINGS	W.R.	DWG TYPE	UNIT ID
WR 2041434	ARAPAHO RD AT MIDWAY RD RELOCATE OR CROSSINGS TO UNDERGROUND			
DATE: 1/10/2004	APP.	ENG.	CH.	APP.
OWN: JED	APP.	W.R.	NO.	DATE
REVISION DESCRIPTION	APP.	CH.	APP.	APP.

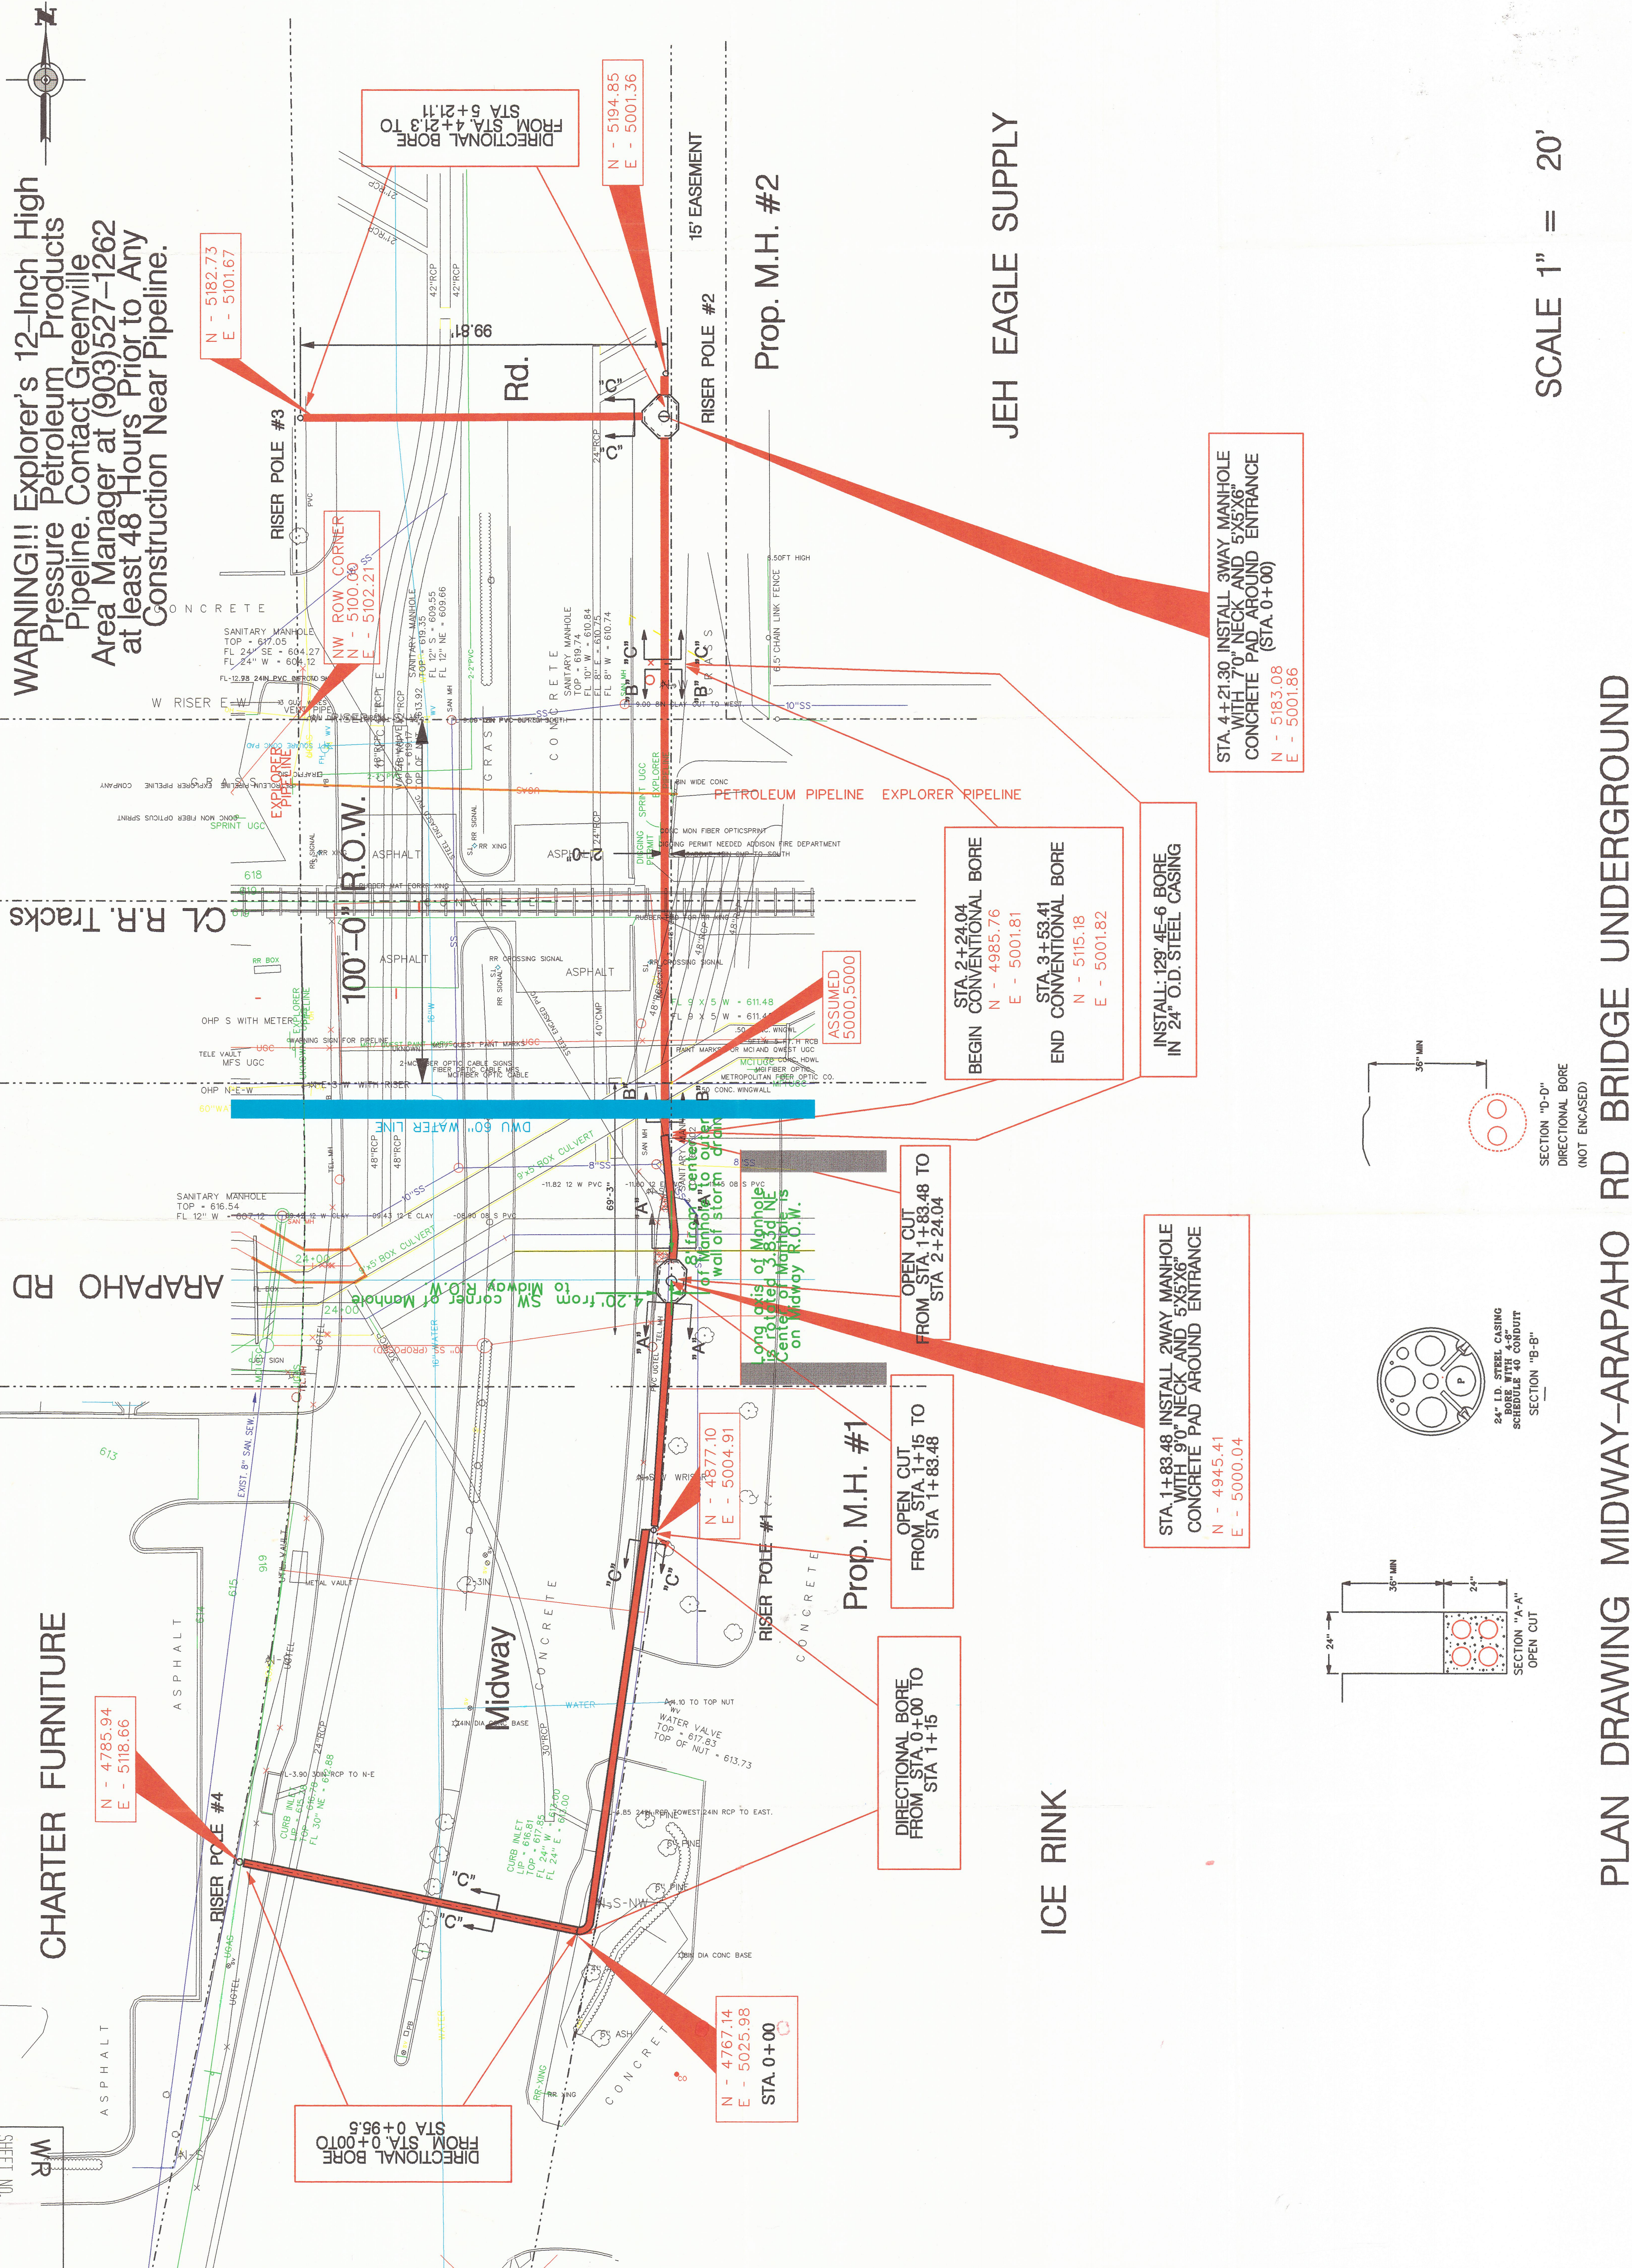

WARNING!!! Explorer's 12-Inch High Pressure Petroleum Products Pipeline. Contact Greenville Area Manager at (903)527-1262 at least 48 Hours Prior to Any Construction Near Pipeline.

CL R.R. Tracks

ARAPAHO RD

CHARTER FURNITURE

ICE RINK

N - 5182.73
E - 5101.67

NW ROW CORNER
N - 5100.00
E - 5102.21

N - 5194.85
E - 5001.36

N - 4777.10
E - 5004.91

N - 4767.14
E - 5025.98
STA. 0+00

DIRECTIONAL BORE FROM STA. 0+00 TO STA. 0+95.5

DIRECTIONAL BORE FROM STA. 0+00 TO STA. 1+15

OPEN CUT FROM STA. 1+15 TO STA. 1+83.48

OPEN CUT FROM STA. 1+83.48 TO STA. 2+24.04

STA. 2+24.04
BEGIN CONVENTIONAL BORE
N - 4985.76
E - 5001.81

STA. 3+53.41
END CONVENTIONAL BORE
N - 5115.18
E - 5001.82



STA. 1+83.48. INSTALL 2WAY MANHOLE WITH 90" NECK AND 5'X5'X6" CONCRETE PAD AROUND ENTRANCE
N - 4945.41
E - 5000.04

INSTALL: 128' 4E-6 BORE IN 24" O.D. STEEL CASING

STA. 4+21.30. INSTALL 3WAY MANHOLE WITH 70" NECK AND 5'X5'X6" CONCRETE PAD AROUND ENTRANCE
N - 5183.08
E - 5001.86

JEH EAGLE SUPPLY

SCALE 1" = 20'

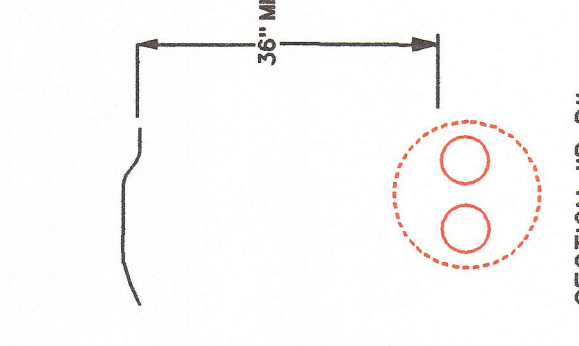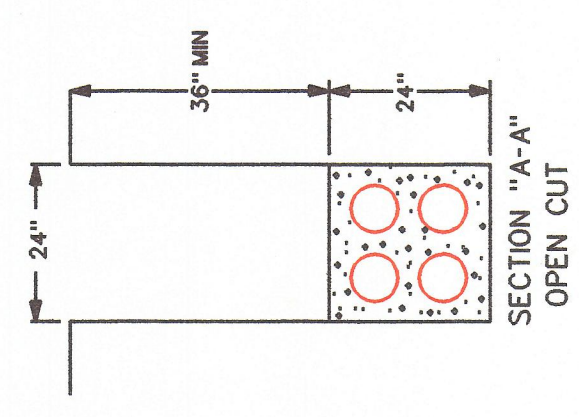

PLAN DRAWING MIDWAY-ARAPAHO RD BRIDGE UNDERGROUND

Revised
1-12-05

SHEET NO.
E


PROFILE DRAWING MIDWAY-ARAPAHO RD BRIDGE UNDERGROUND



CD

DATE	DWN.	CH.	ENG.	APP.	APP.	W.A.	NO.	DATE	REVISION DESCRIPTION	DRAWN	APP.	APP.

E 2041434
SHEET NO.

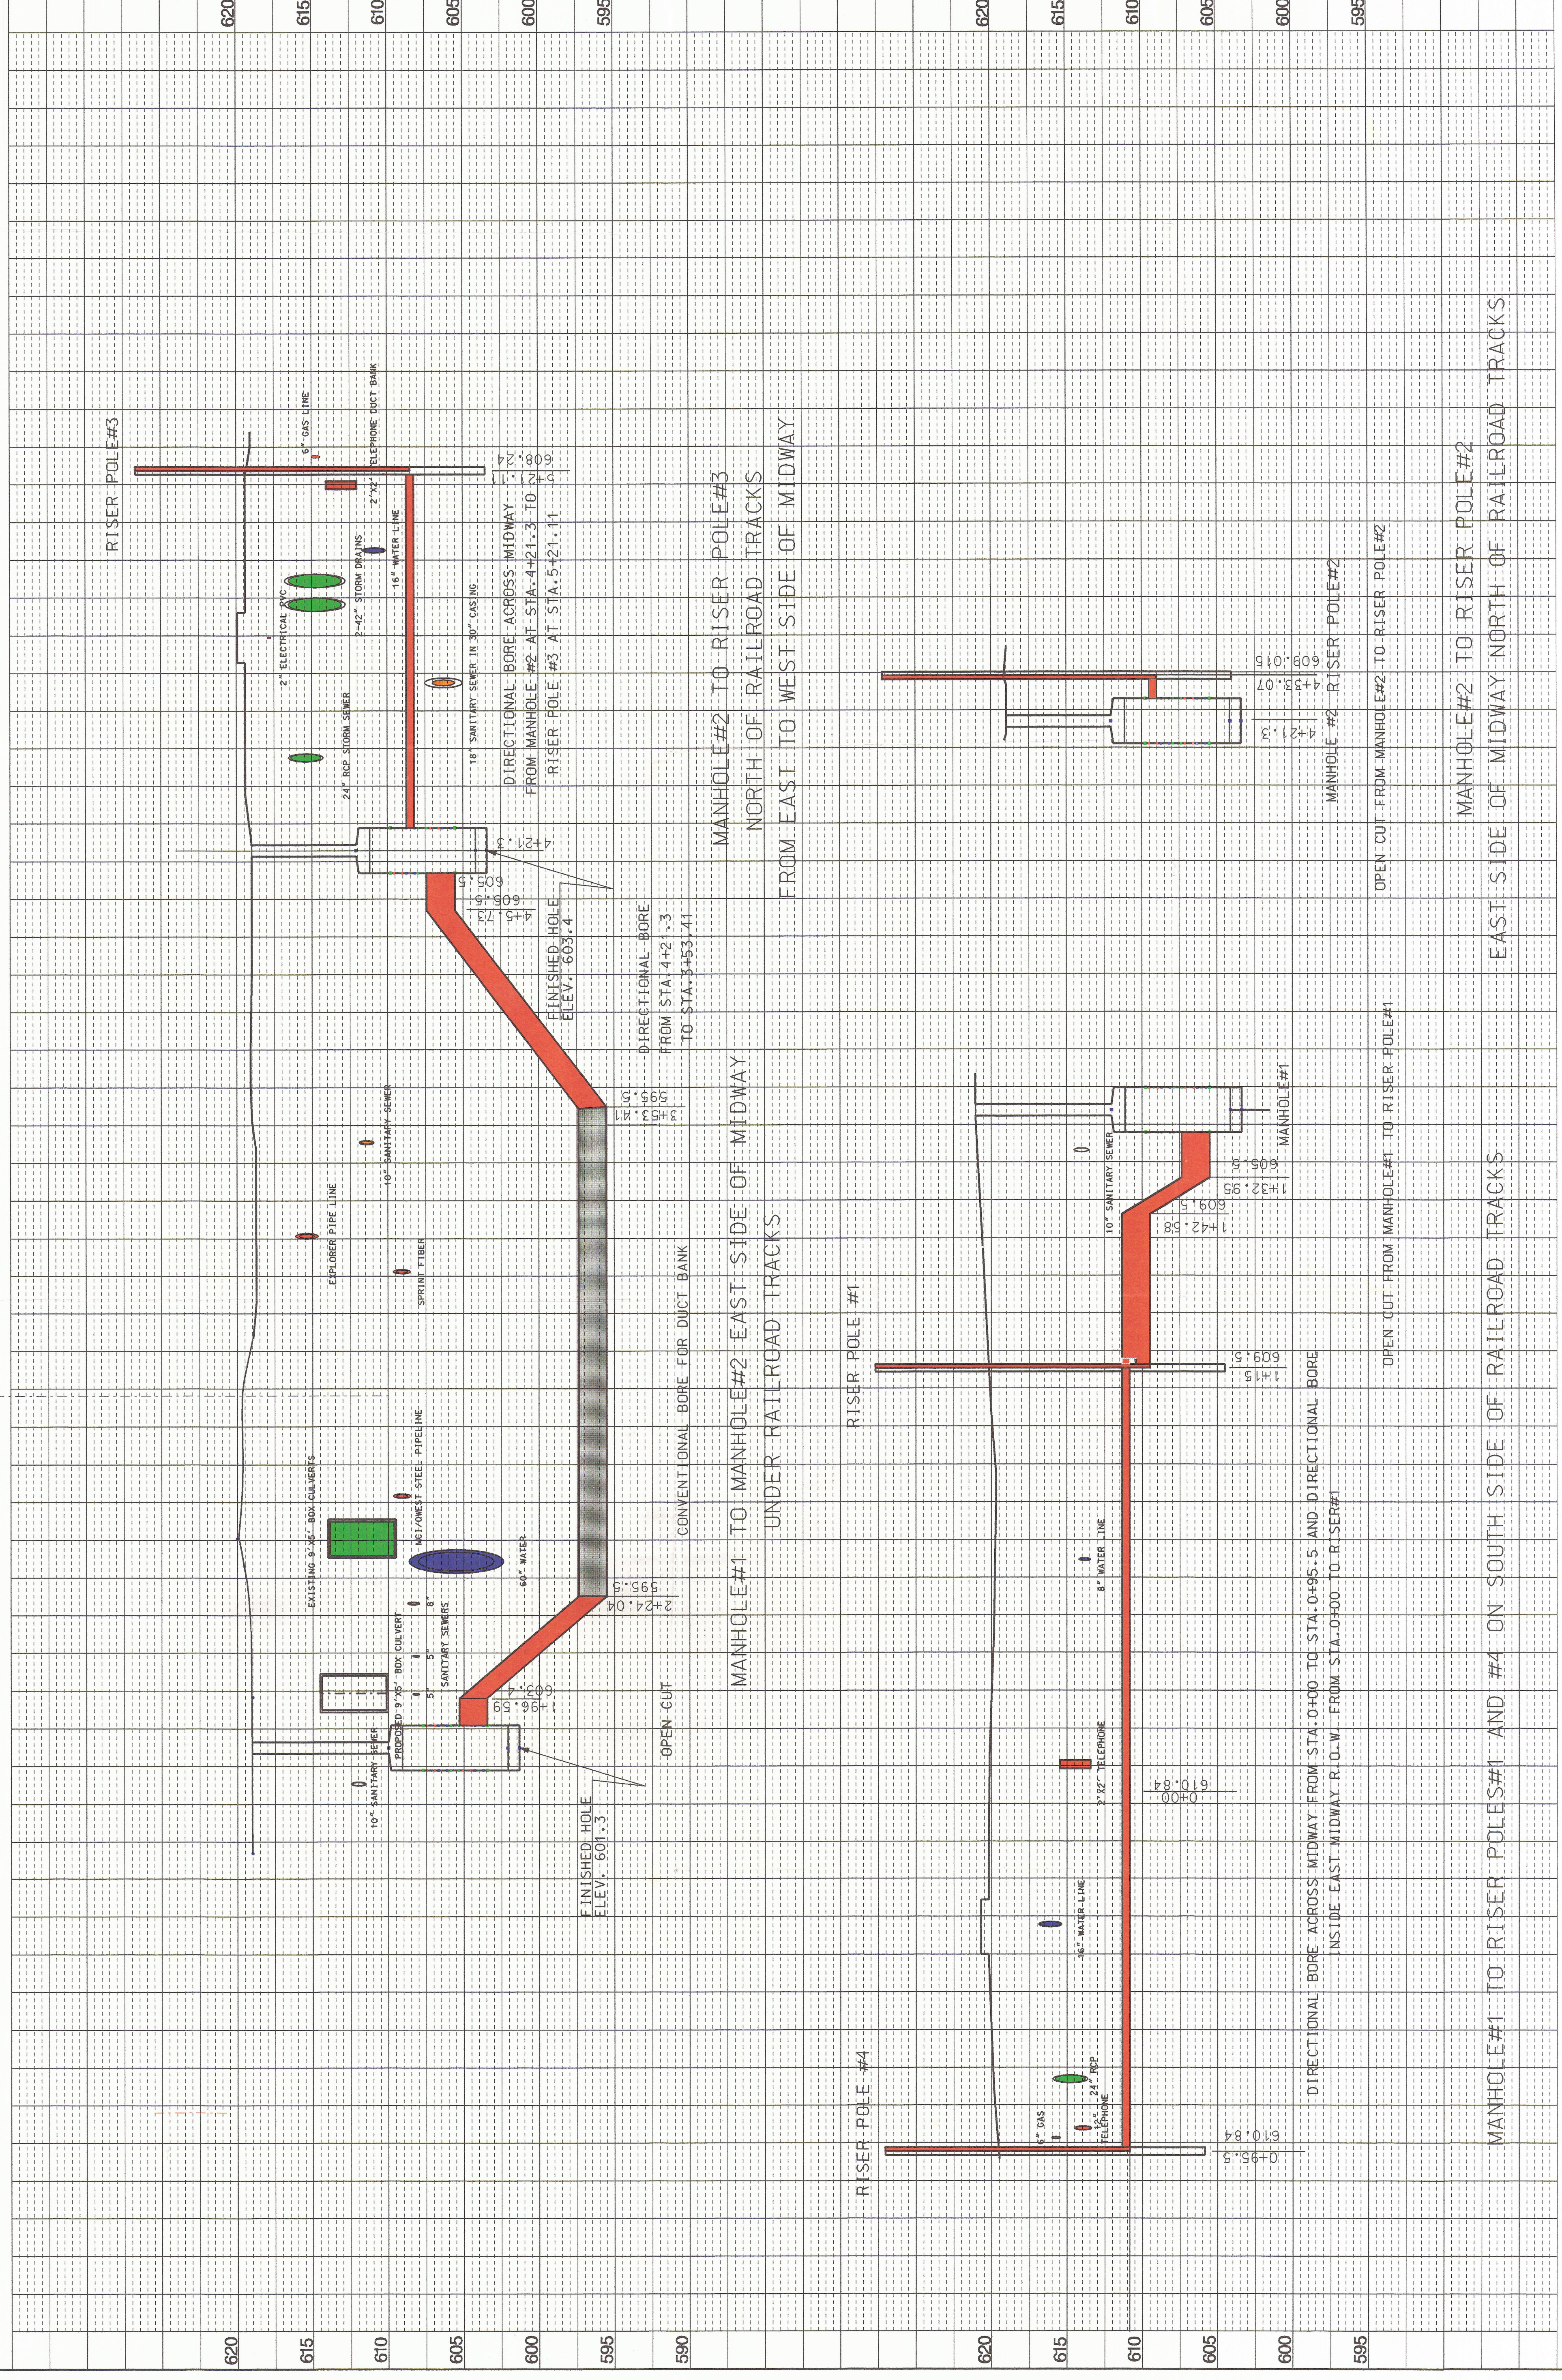

SCALE	1" = 20' H	1" = 5' V	LIST OF DRAWINGS	W.A.	ESTIMATE	DWG TYPE	UNIT ID
595							
600							
605							
610							
615							
620							

TO UNDERGROUND
RELOCATE OH CROSSINGS
ARAPAHO RD AT MIDWAY RD