

Revised
1-12-05


DATE	DWN.	CH.	ENG.	APP.	APP.	W.A.	NO.	DATE	REVISION DESCRIPTION	DRAWN/H.	APP.	APP.
	TO UNDERGROUND											
SCALE	ARAPAHO RD AT MIDWAY RD											
	RELOCATE OH CROSSINGS											
LIST OF DRAWINGS												
600	1" = 20' H											
605	1" = 5' V											
610	W.A.											
615	ESTIMATE											
620	DWG TYPE											
620	UNIT ID											



CD

PROFILE DRAWING MIDWAY-ARAPAHO RD BRIDGE UNDERGROUND

SHEET NO.
E

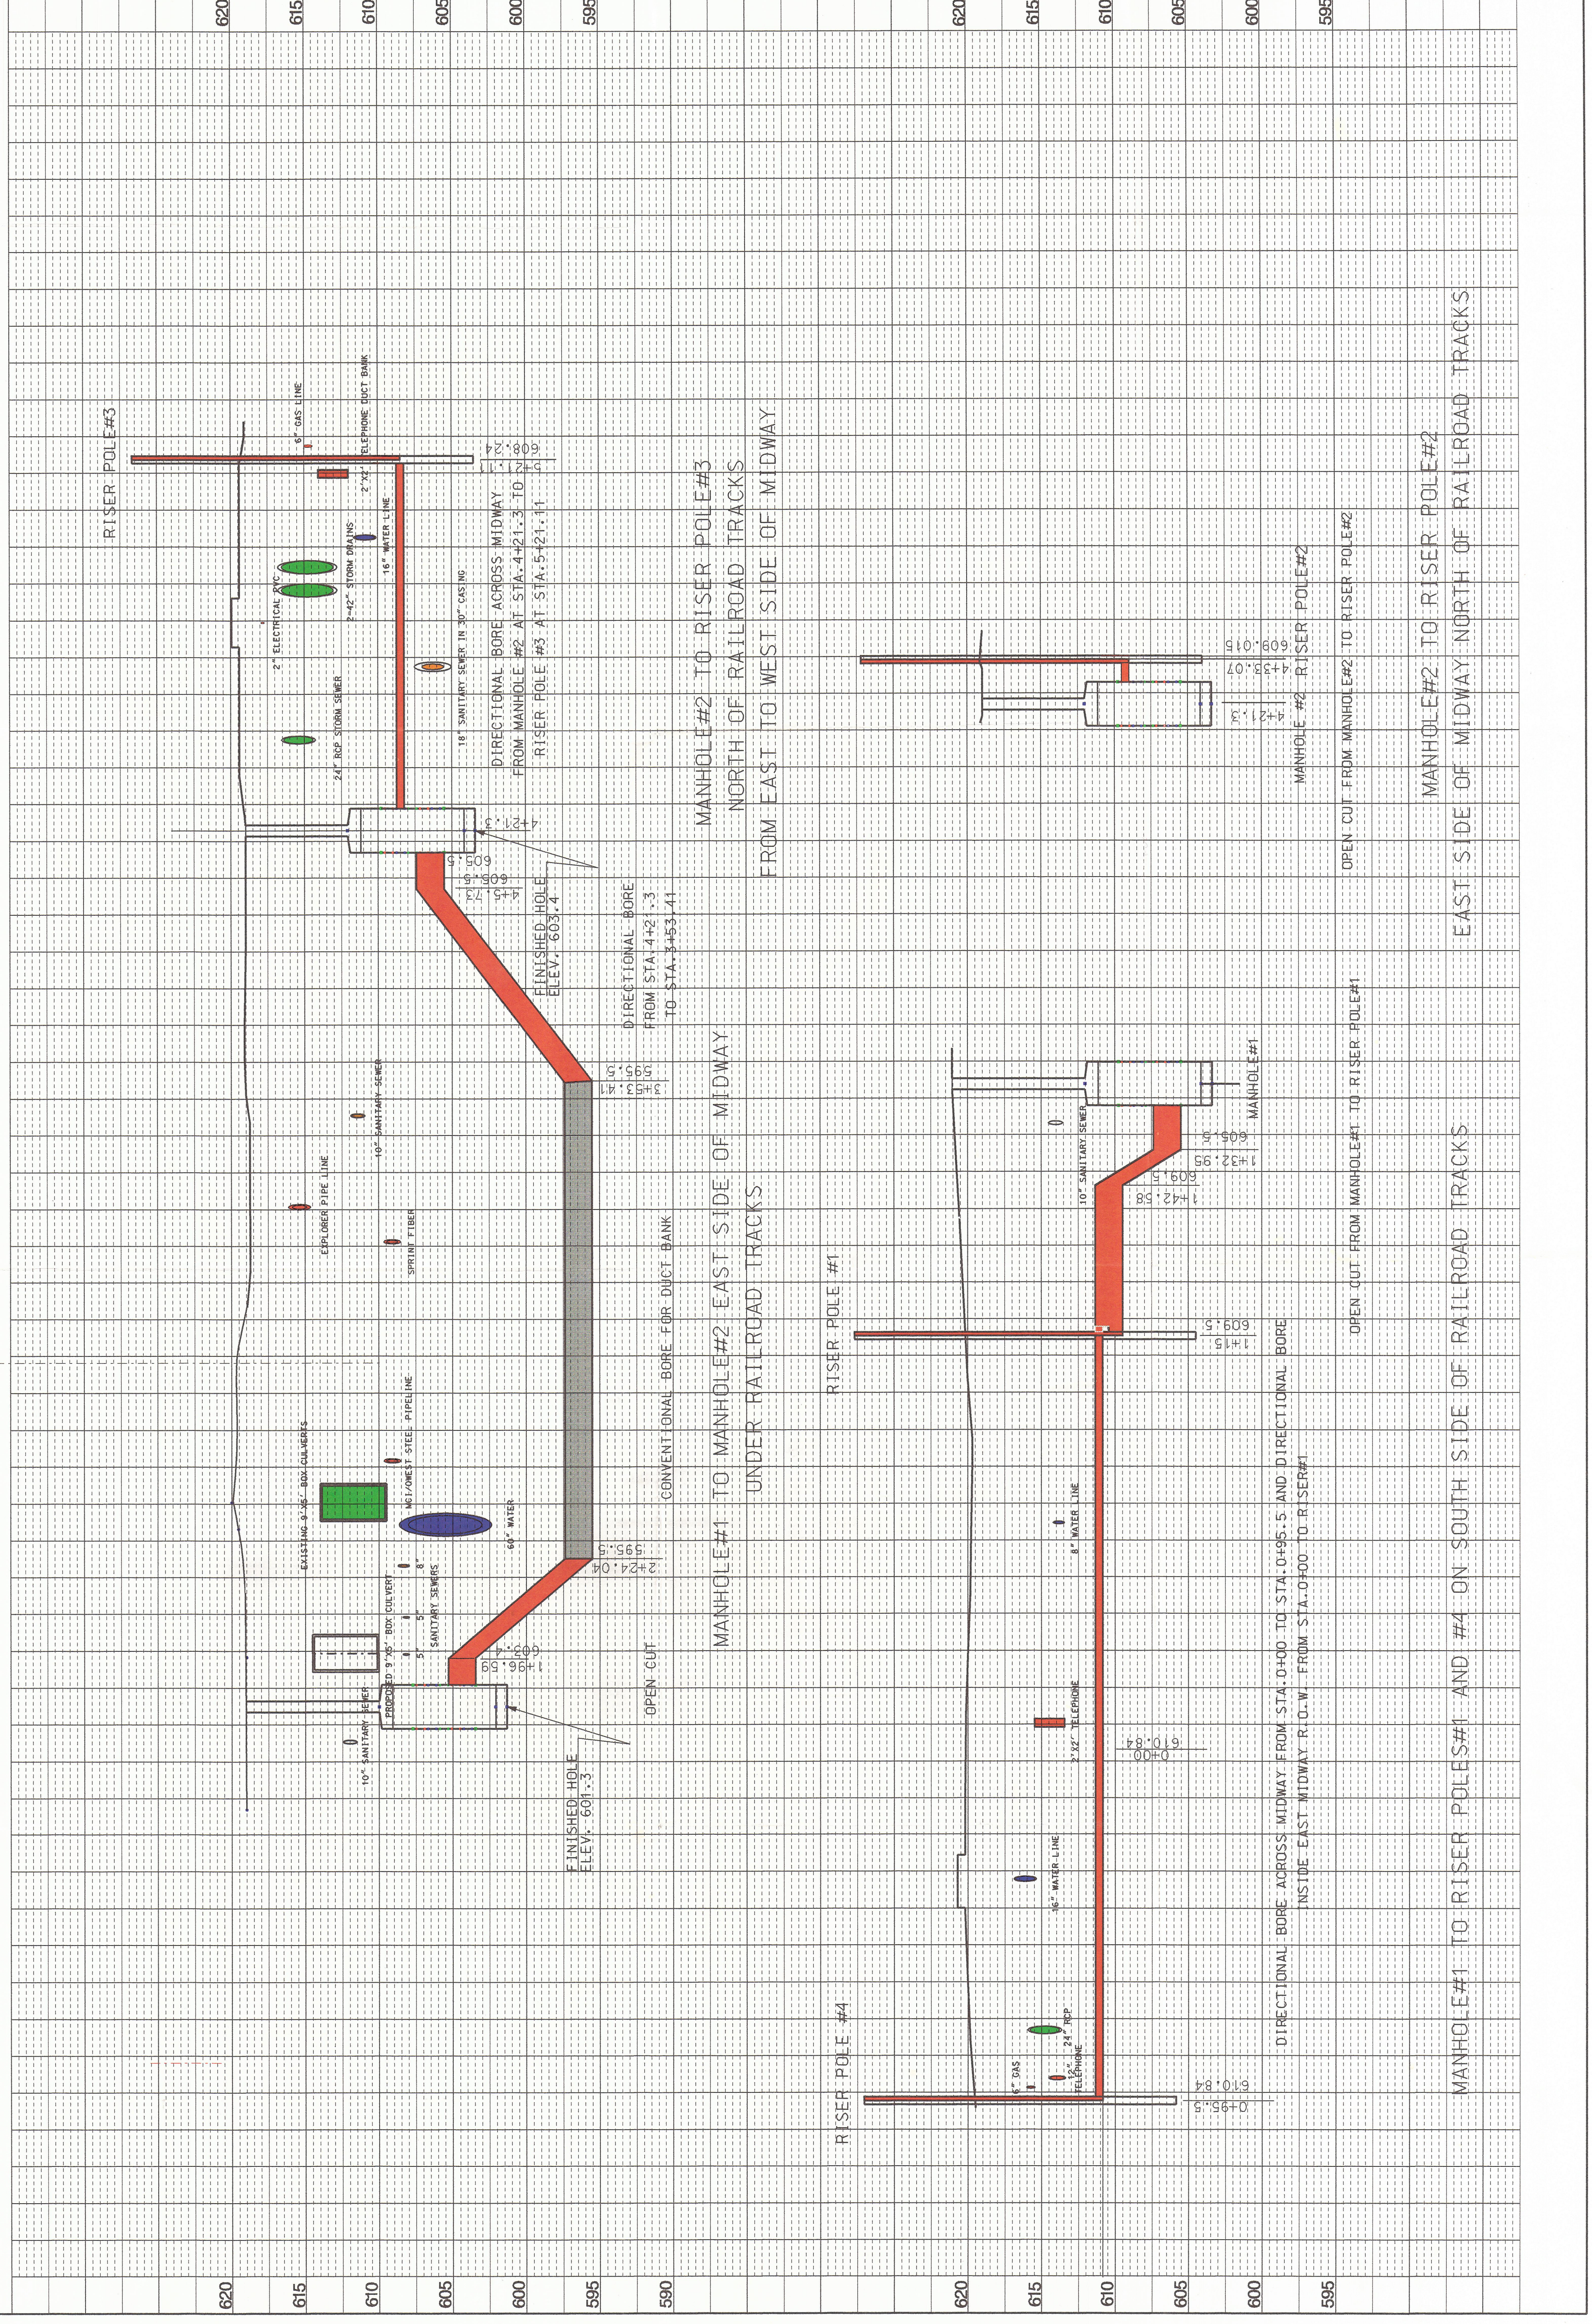

E 2041434
SHEET NO.