

NO.	DATE	REVISION	APPROV.
1			
2			
3			

NOTE: REFER TO SW-1 FOR STORM SEWER NOTES

INLET REFERENCE POINT

RECESSED CURB INLET


STANDARD CURB INLET

1" = 20' scale

↑

DATE: MAY 200
 DRAWN: G&A DESI
 AREA: STORM
 TO: **g&a**

1919 S. SHILOH ROAD, SUITE 100
 CARLAND, TEXAS 75042

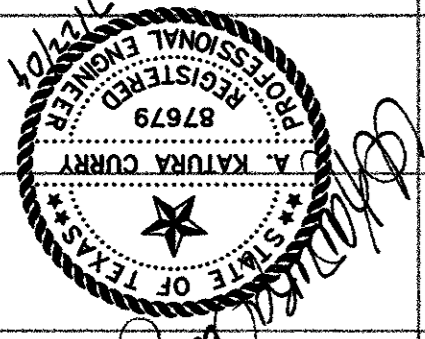

VOID