


THE SEAL APPEARING ON THIS DOCUMENT WAS AUTHORIZED BY: **A. KATURA CURRY**
 ON 7-21-04
 ALTERATION OF A SEALED DOCUMENT WITHOUT PROPER NOTIFICATION TO THE RESPONSIBLE ENGINEER IS AN OFFENSE UNDER THE TEXAS ENGINEERING PRACTICE ACT.

REGISTERED PROFESSIONAL ENGINEER
 STATE OF TEXAS
 87679
A. KATURA CURRY

DATE: MAY 2004
 DRAWN: G&A DESIG
ARAI
 4 U
TOI

GARLAND, TEXAS 75042
 1919 S. SHILOH ROAD, SUITE 31
G&A

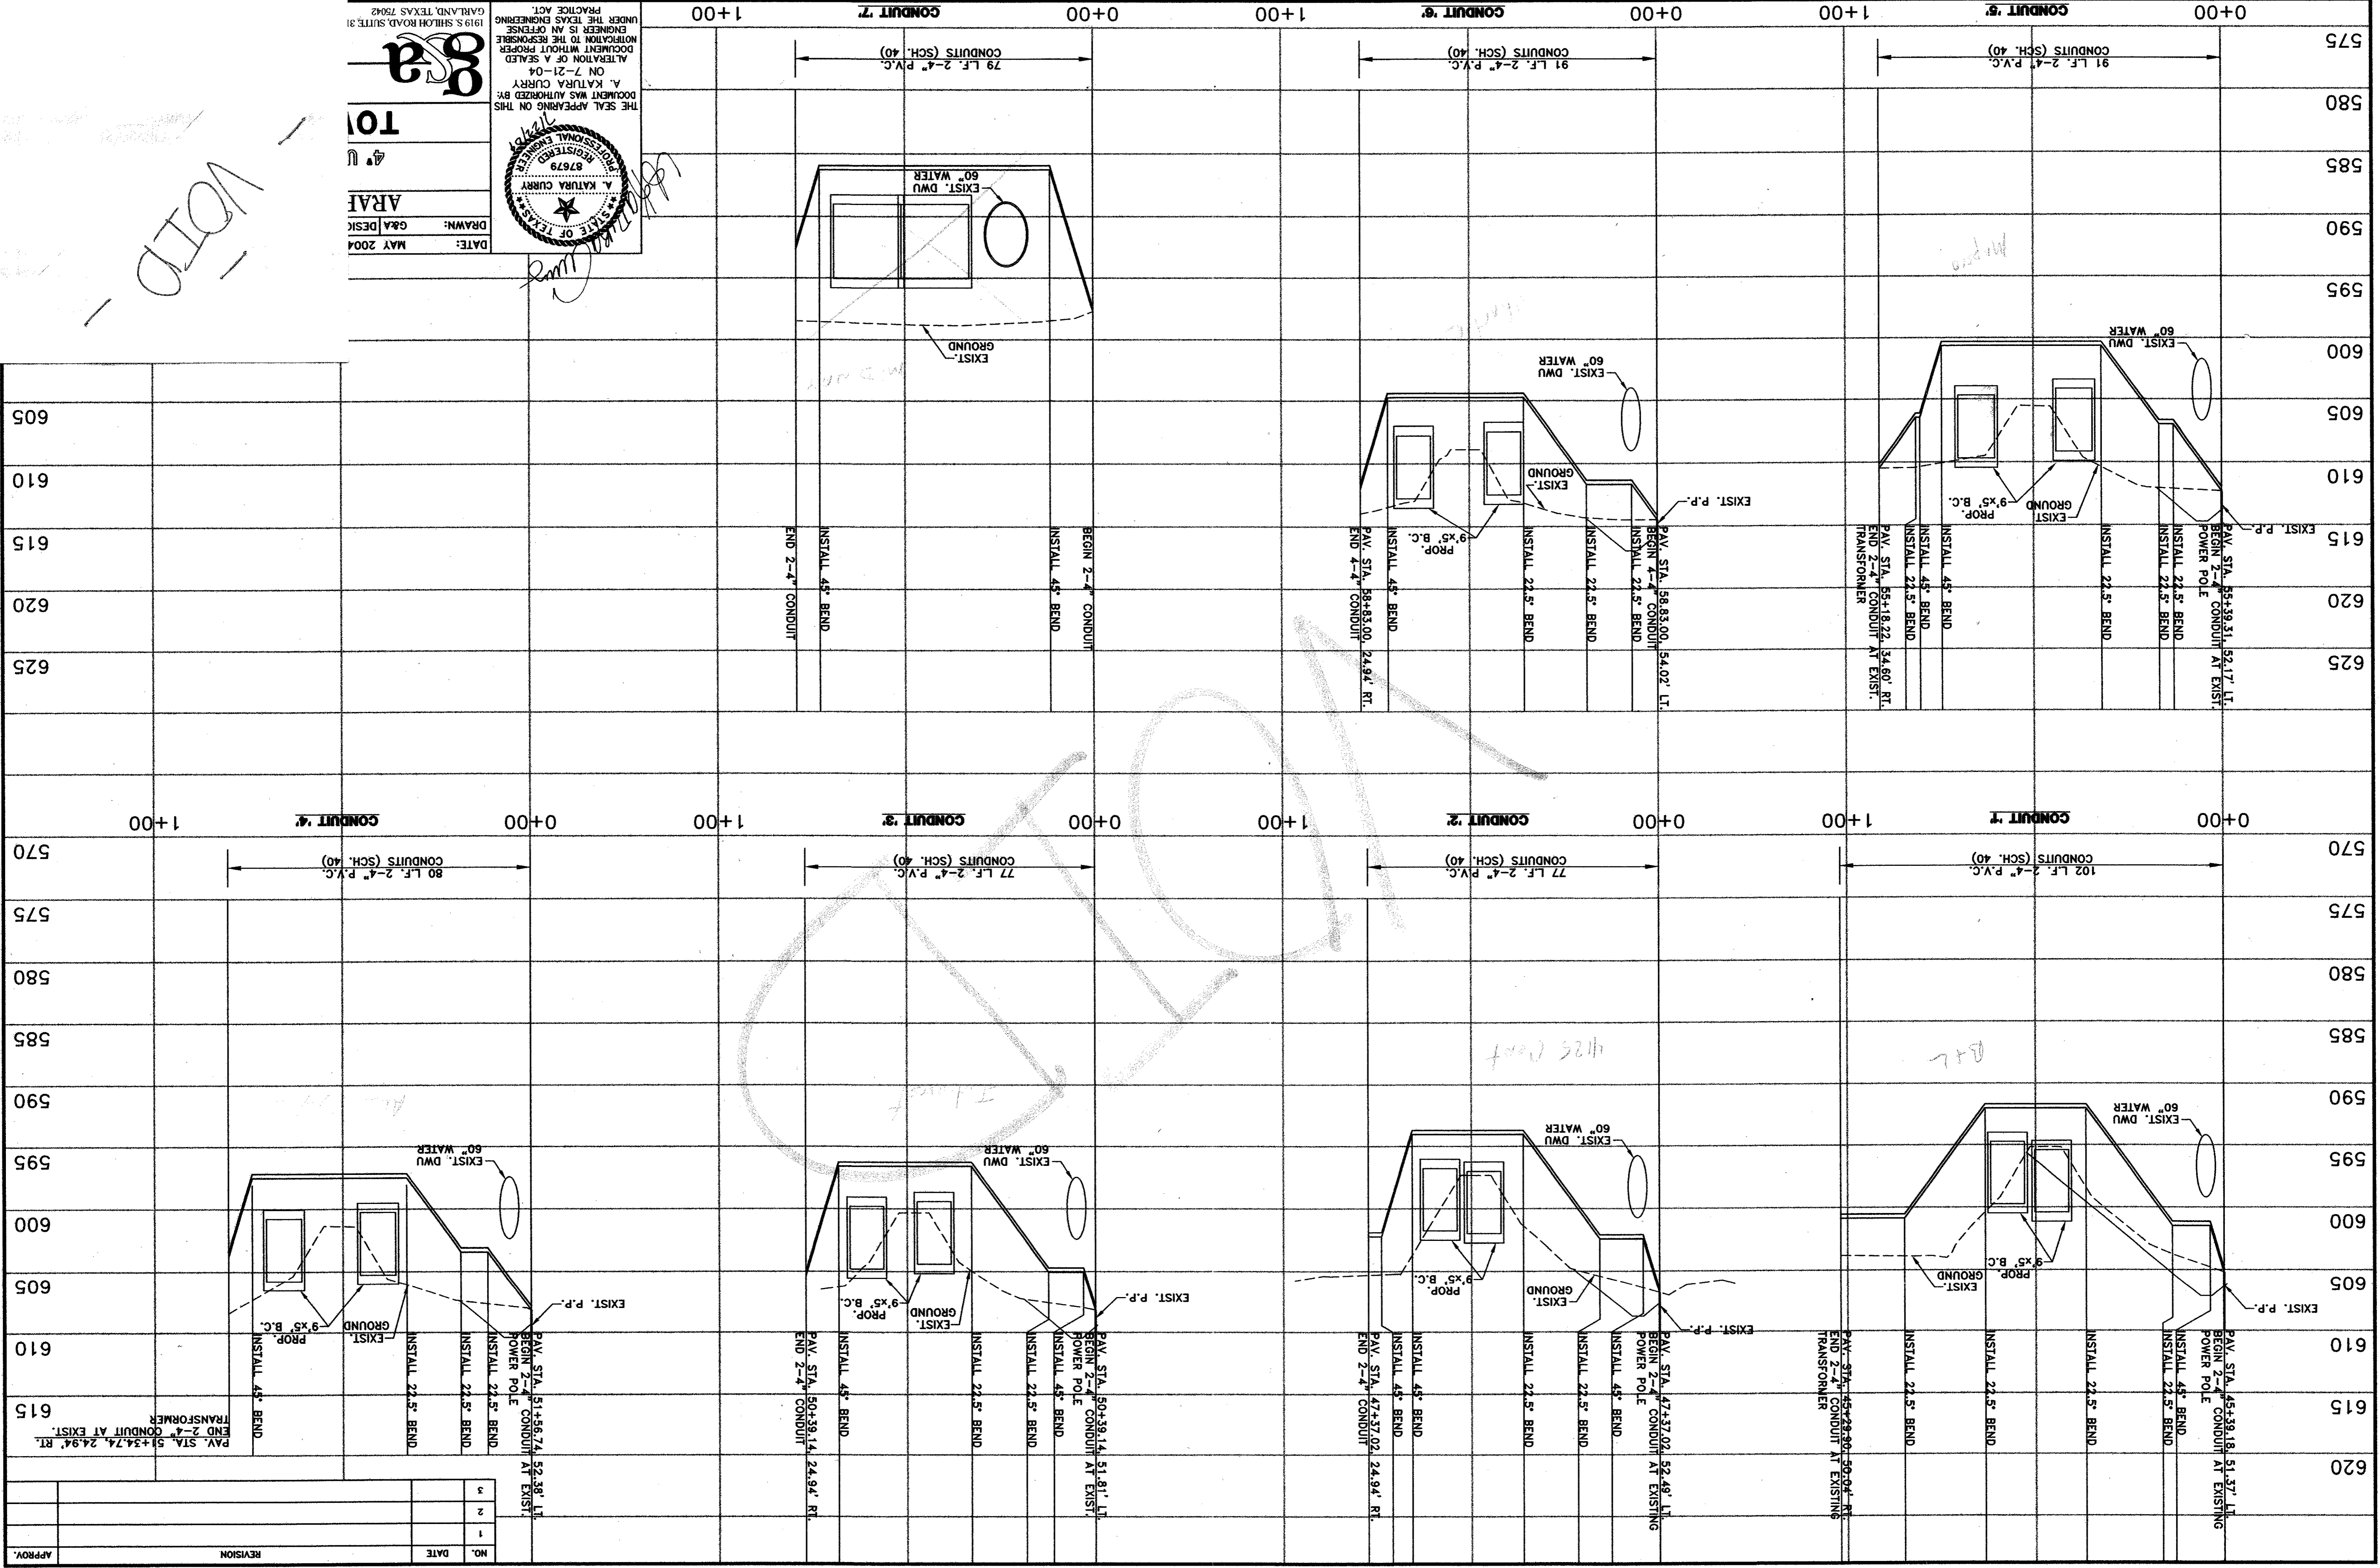

NO.	DATE	REVISION
3		
2		
1		

APPROV. _____

VOTED

DUPLICATE

DLT

4125 (cont)

Water

Water

Water