




SURVEYOR BLVD JOINT LAYOUT

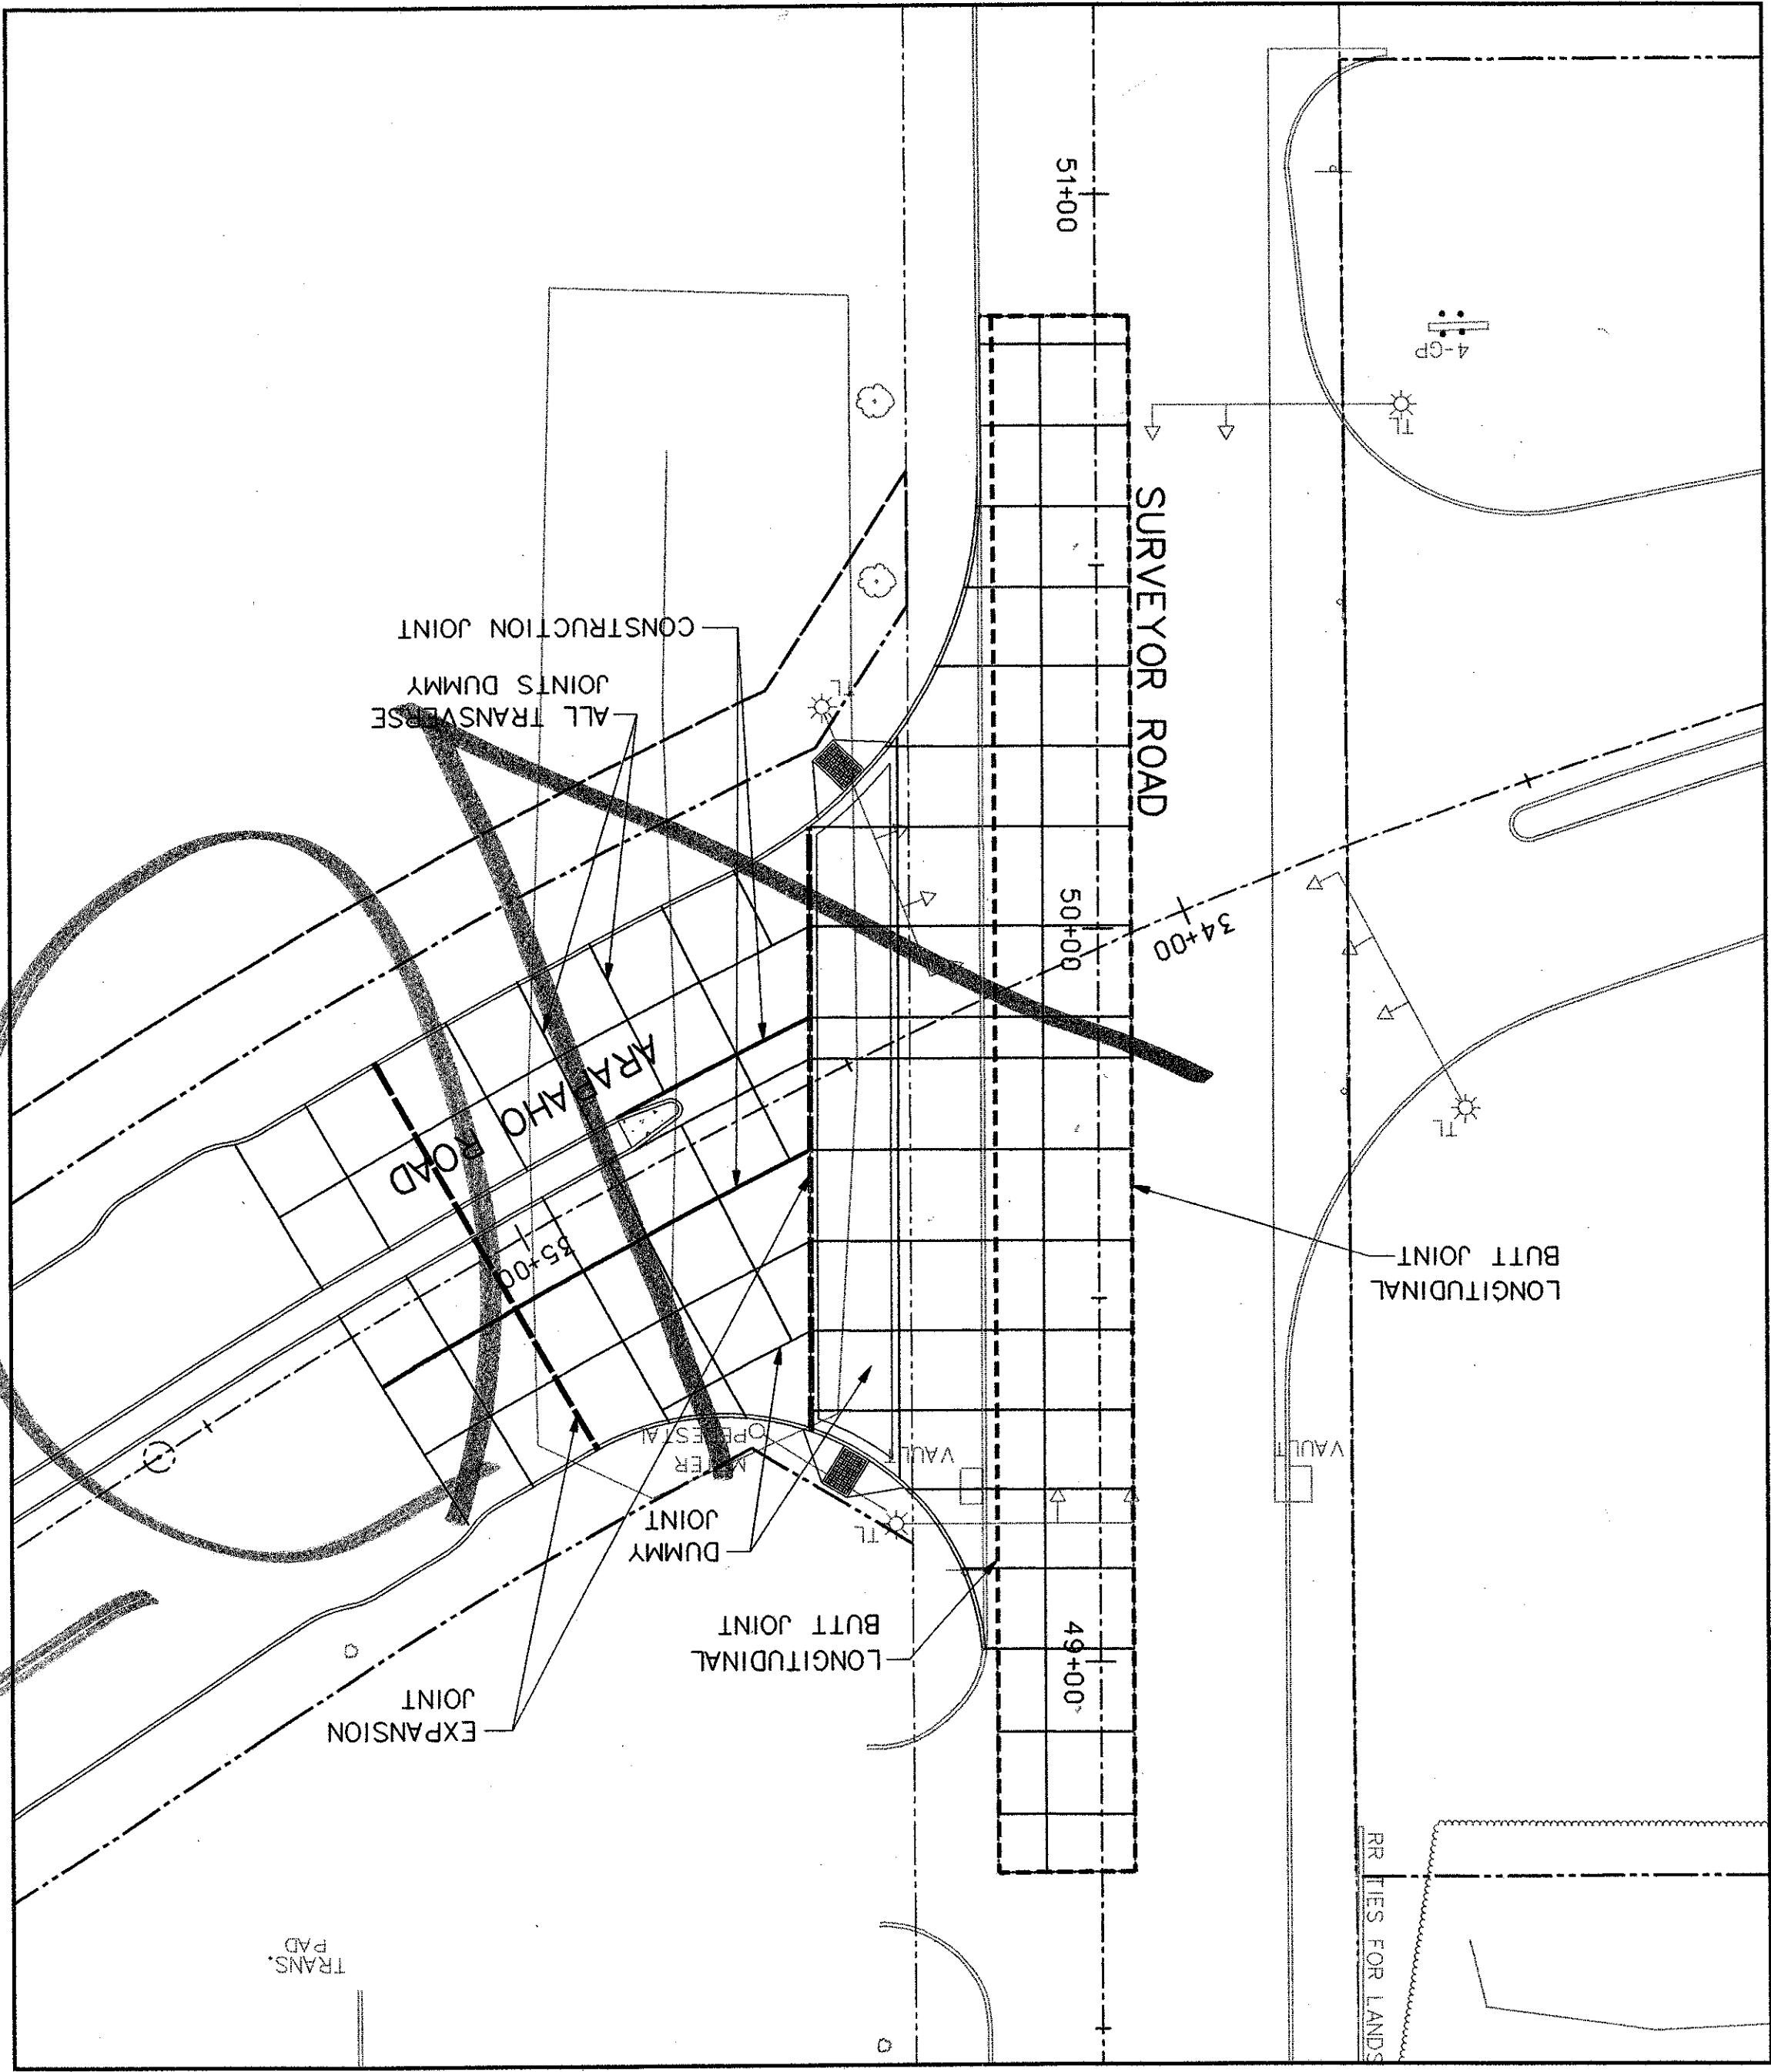

ADDISON ROAD JOINT LAYOUT

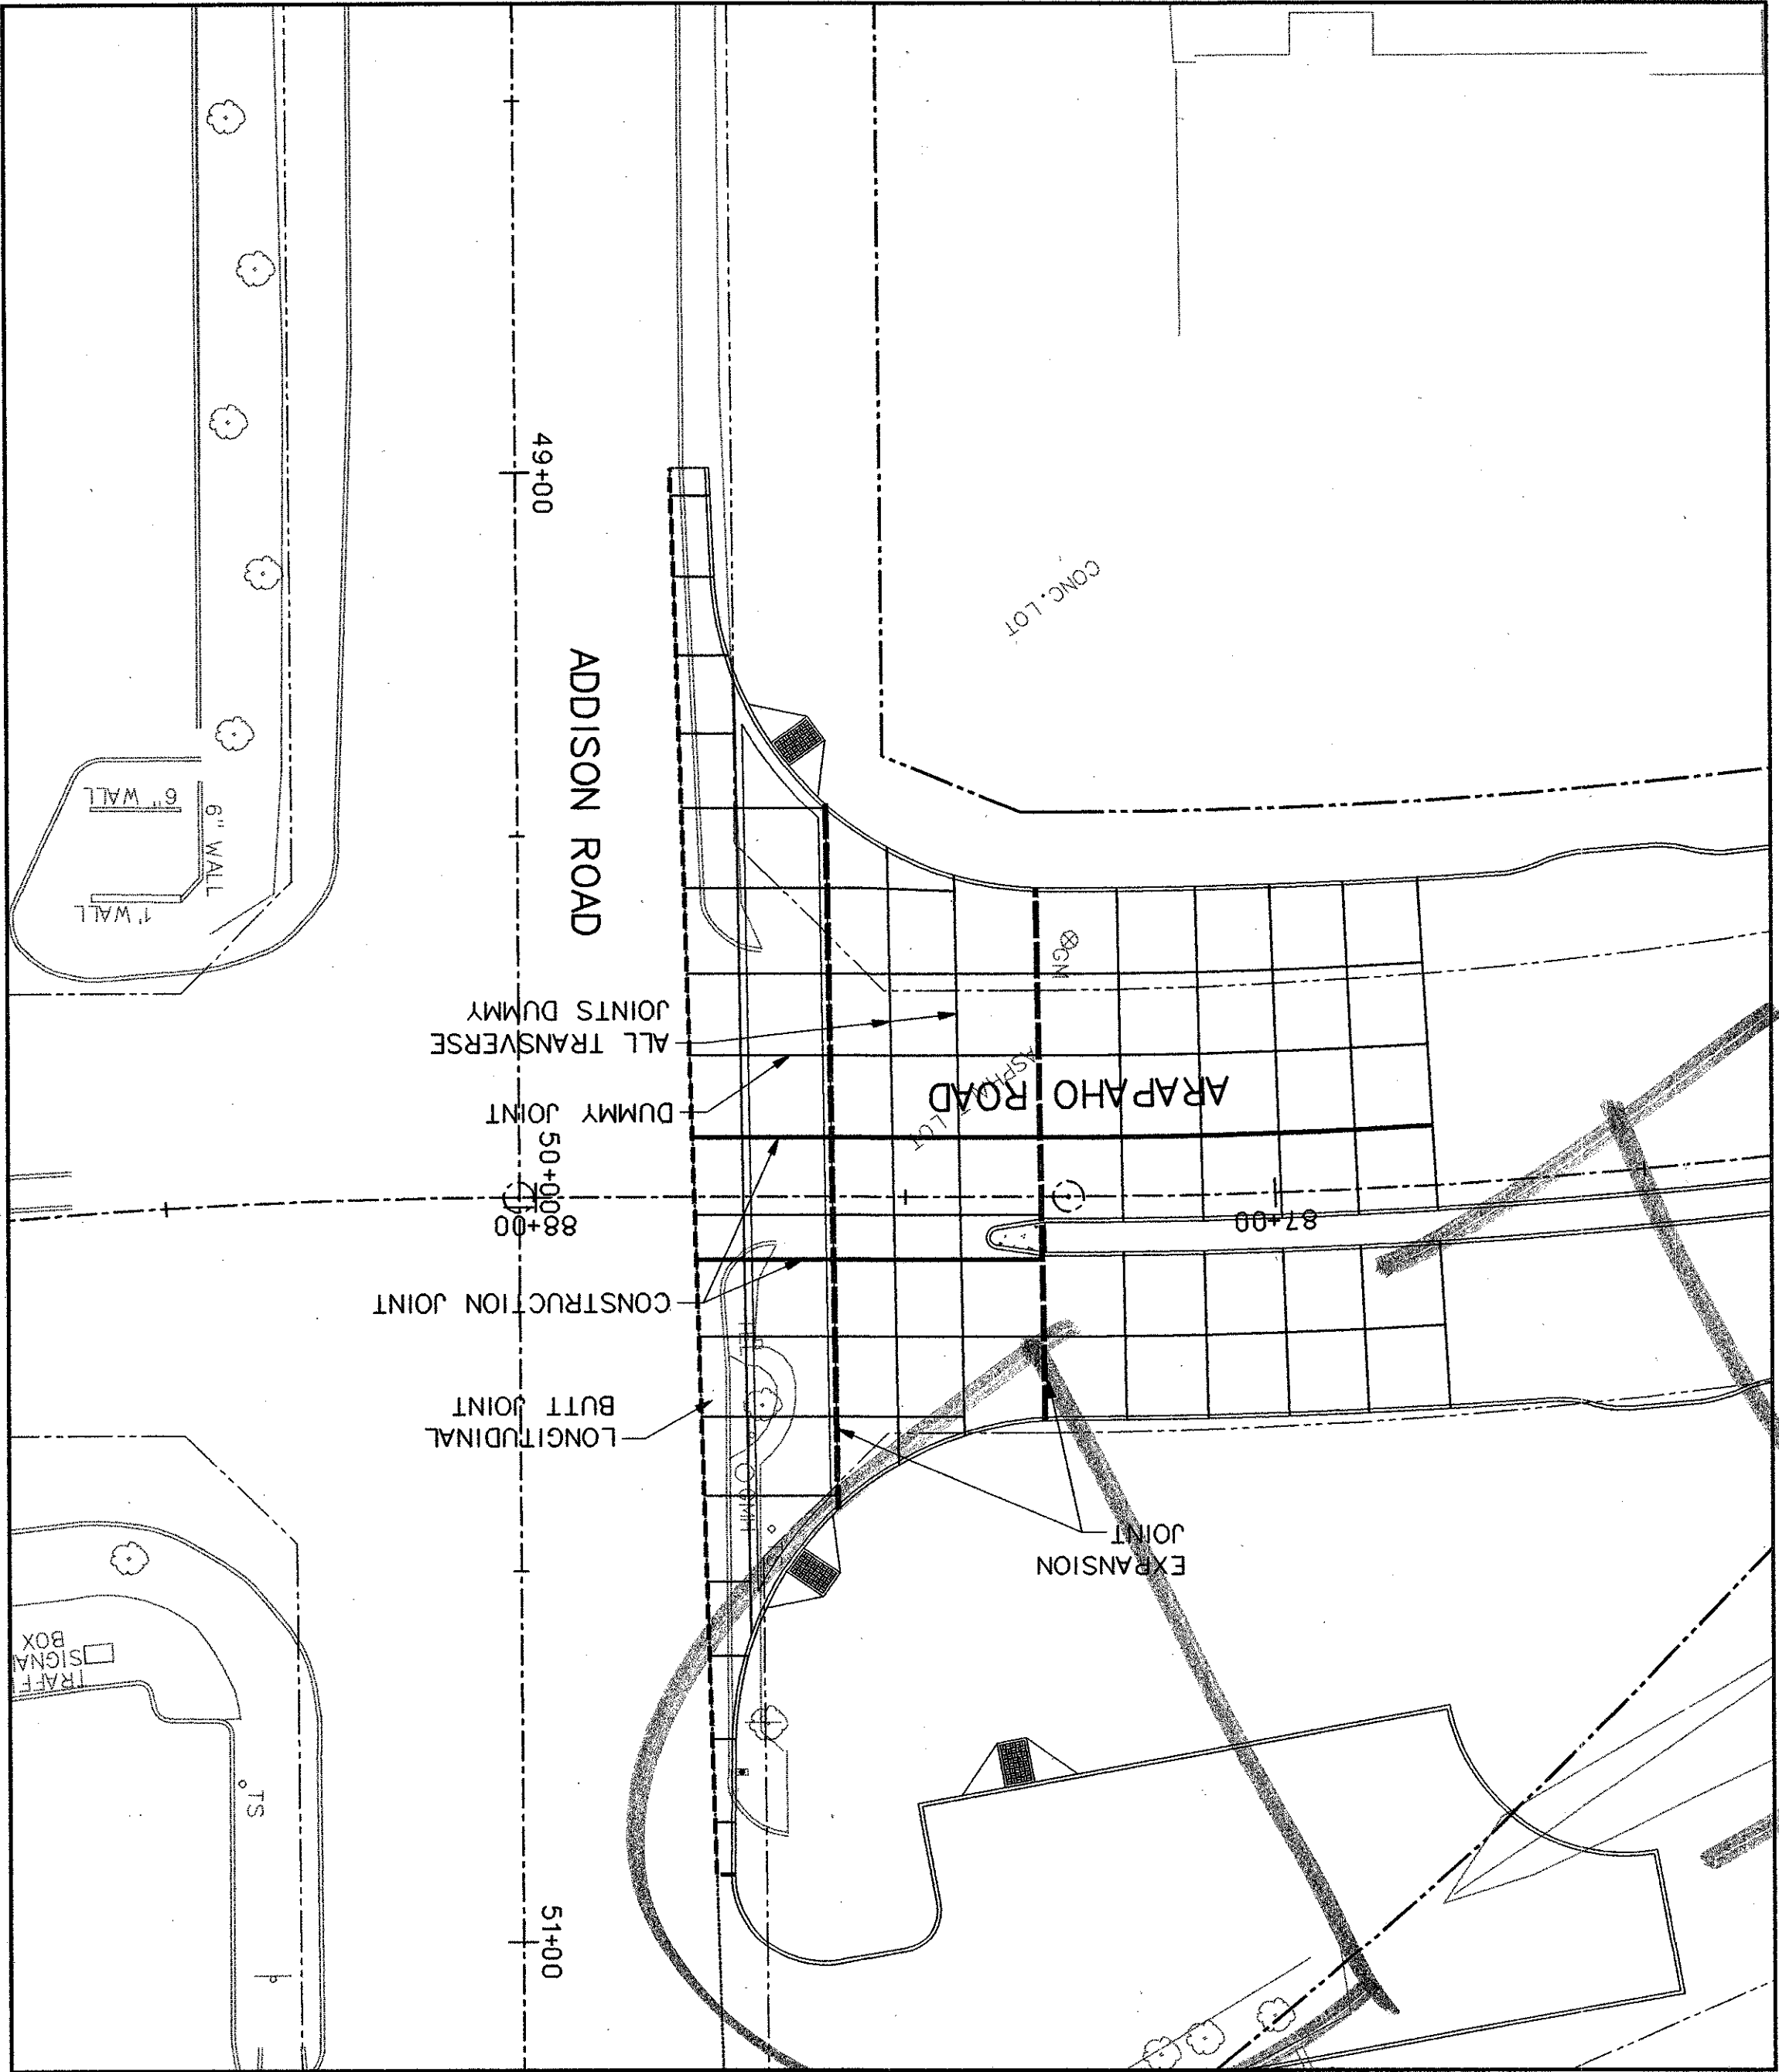

- LEGEND:
- LONGITUDINAL BUTT JOINT
  - \_\_\_\_\_ CONSTRUCTION JOINT
  - \_\_\_\_\_ DUMMY JOINT
  - EXPANSION JOINT

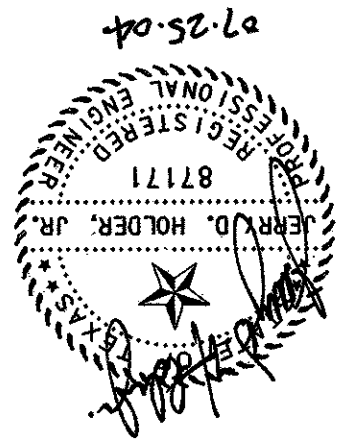

07-25-04

VOID

- NOTE:
1. JOINTS ON 11' CENTERS.
  2. REFERENCE SHEET DT-01, HARDSCAPE DETAILS FOR DETAILS ON BRICK PAVERS.

